

O.D.O.T. DISTRICT 2 SURVEY OFFICE (USE ONLY)

PERSONNEL

REFERENCE NO. 8

SHEET OF

NOTES NIESE

DATE 11/20/23

ROUTE SR 25

H.C. NIESE

WEATHER CLEAR

COUNTY WOOD

R.C. ASTON

TEMP. 37°

TOWNSHIP PORTAGE

DWG BY BARRIERE

PID 92133

SECTION 13

T 4 N R 10 E

TYPE MONUMENT MONBOX W/ 1" IPIN

ON SURFACE - BELOW ON

OFFSET $\varnothing$ PAVEMENT 30' RT LT : RT


 TO EDGE PAVEMENT

STATION: 212+84.79

HORIZ.DATUM: NAD83(11)/WOOD LDP GEOID: 18


GRID: NORTHING: 596252.573 EASTING: 1652424.557

LDP: NORTHING: 418095.210 EASTING: 163947.099

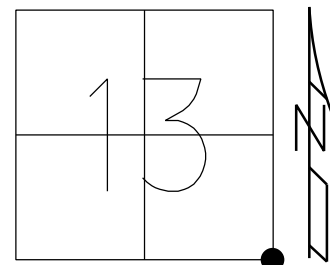

RECORD: P.I.
STA.482+71.65

FD BRASS MON
FD P.K./WASHER
4/12/01, TMR
SET P.K./WASHER
10-31-01, SAH
TIES DID NOT "x"
D.N.F.
5-30-18, JFO
FD BRASS DISK
4" DOWN
REF8
3-17-22, JFO
FD NEW MONBOX
W/ 1" IPIN
CHECKED W/ GPS
DID NOT PULL TIES
NEWREF8
11/20/23, TDN

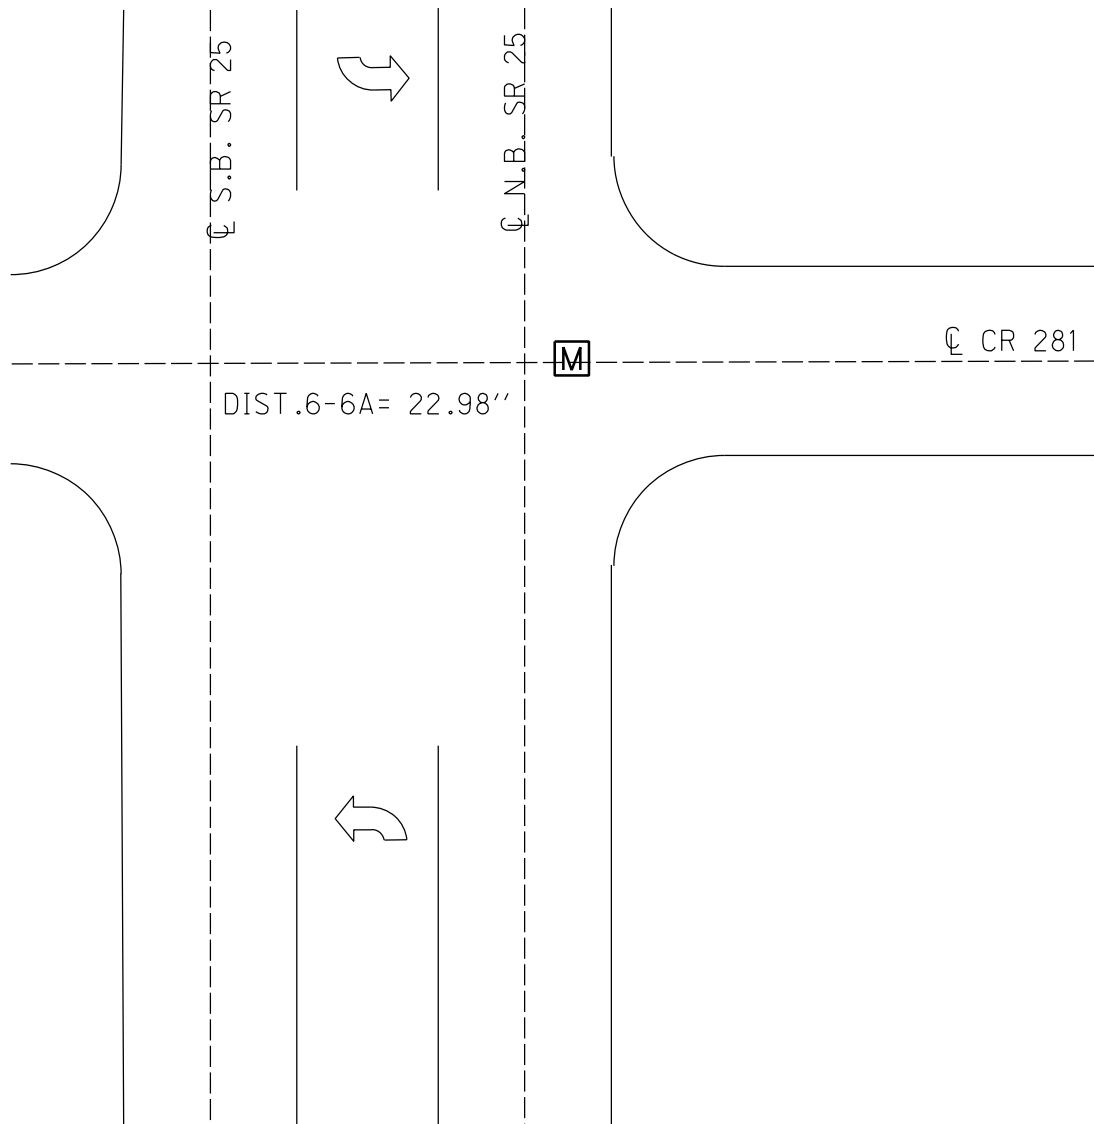

O.D.O.T. DISTRICT 2 SURVEY OFFICE (USE ONLY)

PERSONNEL

REFERENCE NO. 8

SHEET 18 OF 36

NOTES HUSS

DATE 4/12/01

ROUTE SR 25

H.C. ROUSOS

WEATHER CLOUDY/WINDY

COUNTY WOOD

R.C. VAN DUSEN

TEMP. 72°

TOWNSHIP LIBERTY

SECTION 13

DWG BY MILLER

PID NO PID

T 4 N R 10 E

TYPE MONUMENT PK/WASHER

ON SURFACE - ~~BELOW~~ ON


OFFSET CL PAVEMENT 1.4' LT : RT

9.2' TO RT EDGE PAVEMENT


STATION: 140+35

HORIZ.DATUM: _____ GEOID: _____

GRID: NORTHING: _____ EASTING: _____

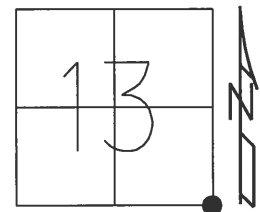

RECORD:
STA. 482+71.65
FD BRASS MON
FD P.K./WASHER
4/12/01, TMR
SET P.K./WASHER
10-31-01, SAH
TIES DID NOT "x"
D.N.F.
5-30-18, JFO

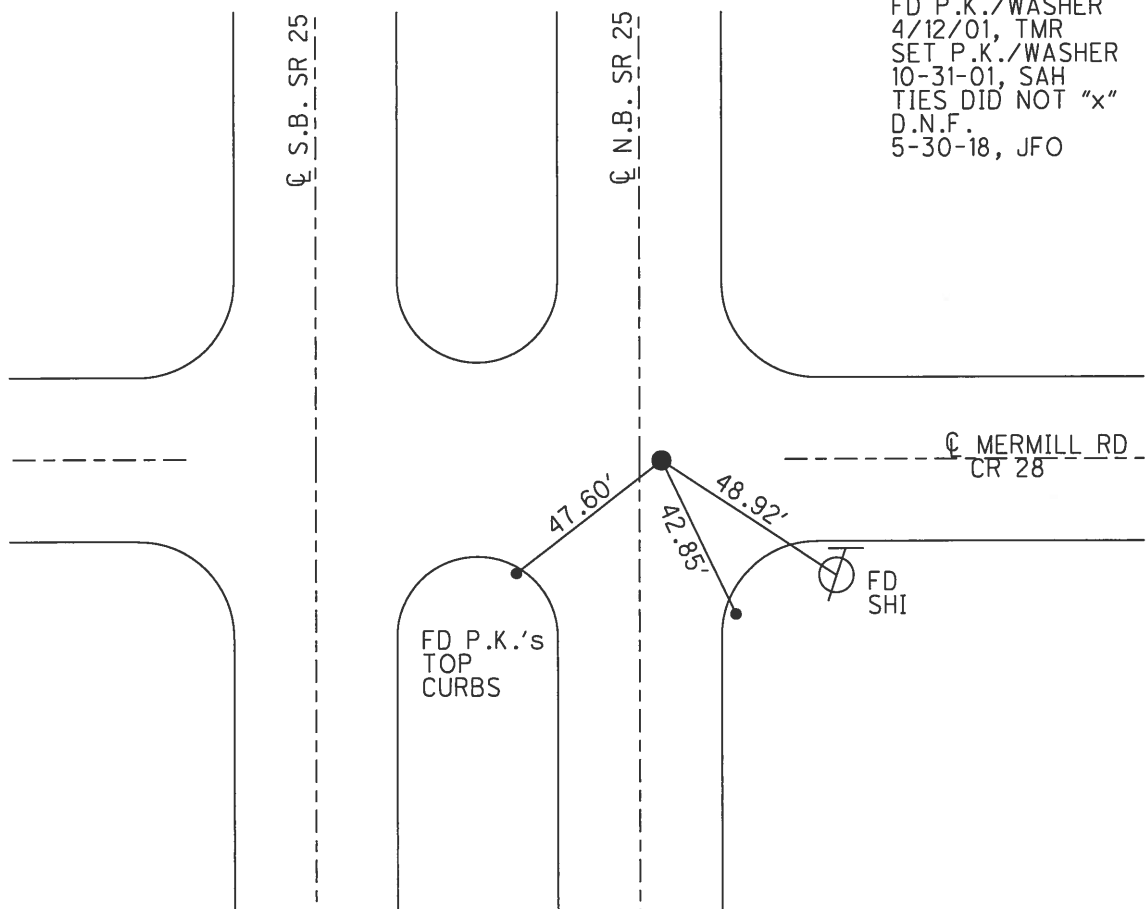

O.D.O.T. DISTRICT 2 SURVEY OFFICE

PERSONNEL

REFERENCE NO. 8

SHEET 11 OF 23

NOTES Huss

H.C. Rousas

R.C. Van Dusen

DATE 4-12-01

WEATHER Pt Cldy-Windy

TEMP. 72°F

ROUTE SR-25

COUNTY Wood

TOWNSHIP Liberty

SECTION 13

T 4 N R 10 E


TYPE MONUMENT PK/w

ON SURFACE - ~~BELOW~~ Surface

~~LEFT~~ - PAV'T. - RIGHT 104' Rt.

9.2 TO RT. EDGE PAVEMENT

S.L.M. 240+35

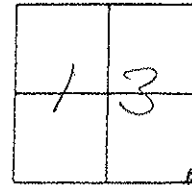

Record:
Brass Mon.
Sta 482+71.65

Set PK/w
10-31-01
SAH

Fd 7" T.O.C.

Fd PK
T.O.C.

Set N/S 1/2" 5" Ornamental

Set N/S 1/2" 12" Pin

4

Part. Merrill Rd.

4 Part.
Merrill Rd.

45.47'

40.30' 56.31'

56.89'

47.60'

42.85'

48.92'

Fd PK
in T.O.C.

Set
PK in
T.O.C.

Set N/S 1/2" w/s T.P.

4 Part.
S.B. SR-25

4 Part.
N.B. SR-25

O.D.O.T. DISTRICT 2 SURVEY OFFICE

PERSONNEL

REFERENCE NO. 8

SHEET 11 OF 23

NOTES HOFFMAN

H.C. LOHRKE

R.C. BARANISEL

DATE 3-26-91

WEATHER OVERCAST

TEMP. 55°

ROUTE SR 25

COUNTY WOOD

TOWNSHIP LIBERTY

SECTION 13

T 4 N R 10 E



TYPE MONUMENT P.K. / WASHER

ON SURFACE - ~~BELOW~~ YES

~~LEFT - C~~ PAV'T. - RIGHT 1.4'

9.2 TO RT EDGE PAVEMENT

S.L.M. 240 + 35

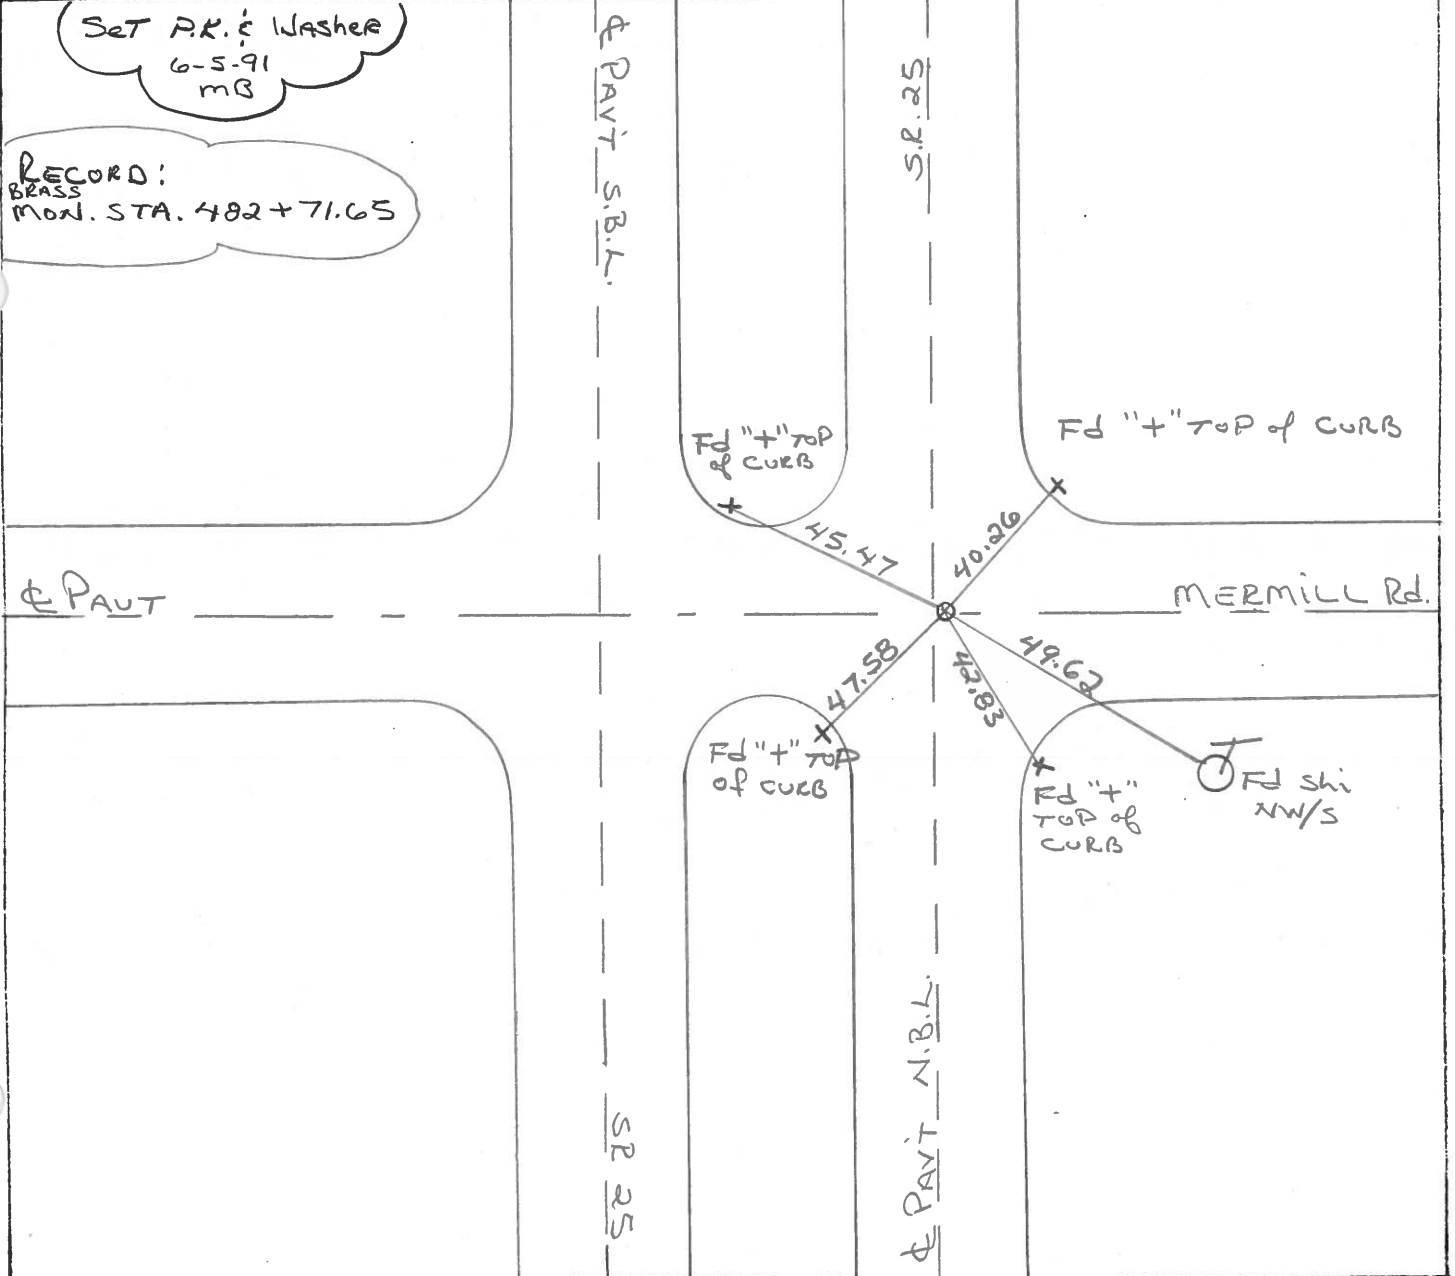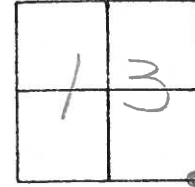

County Wood S.R. -U.S. 25

Date 6-10-81

Township Liberty

Weather cloudy


Section 13

Temp. +70°

T4N, R10E

Personnel HOFFMAN
HOUSEHOLDER

8

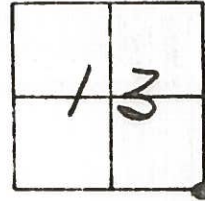


Fd. BRASS MON. @ SURFACE
1.5' E. of & PAUT of N.B. LANES
10.5' TO E. Edge PAUT.

SLM 241+06

Set P.K. / WASHER
11-9-82
SWA

MON. STA. 482+71.65
- REC. -

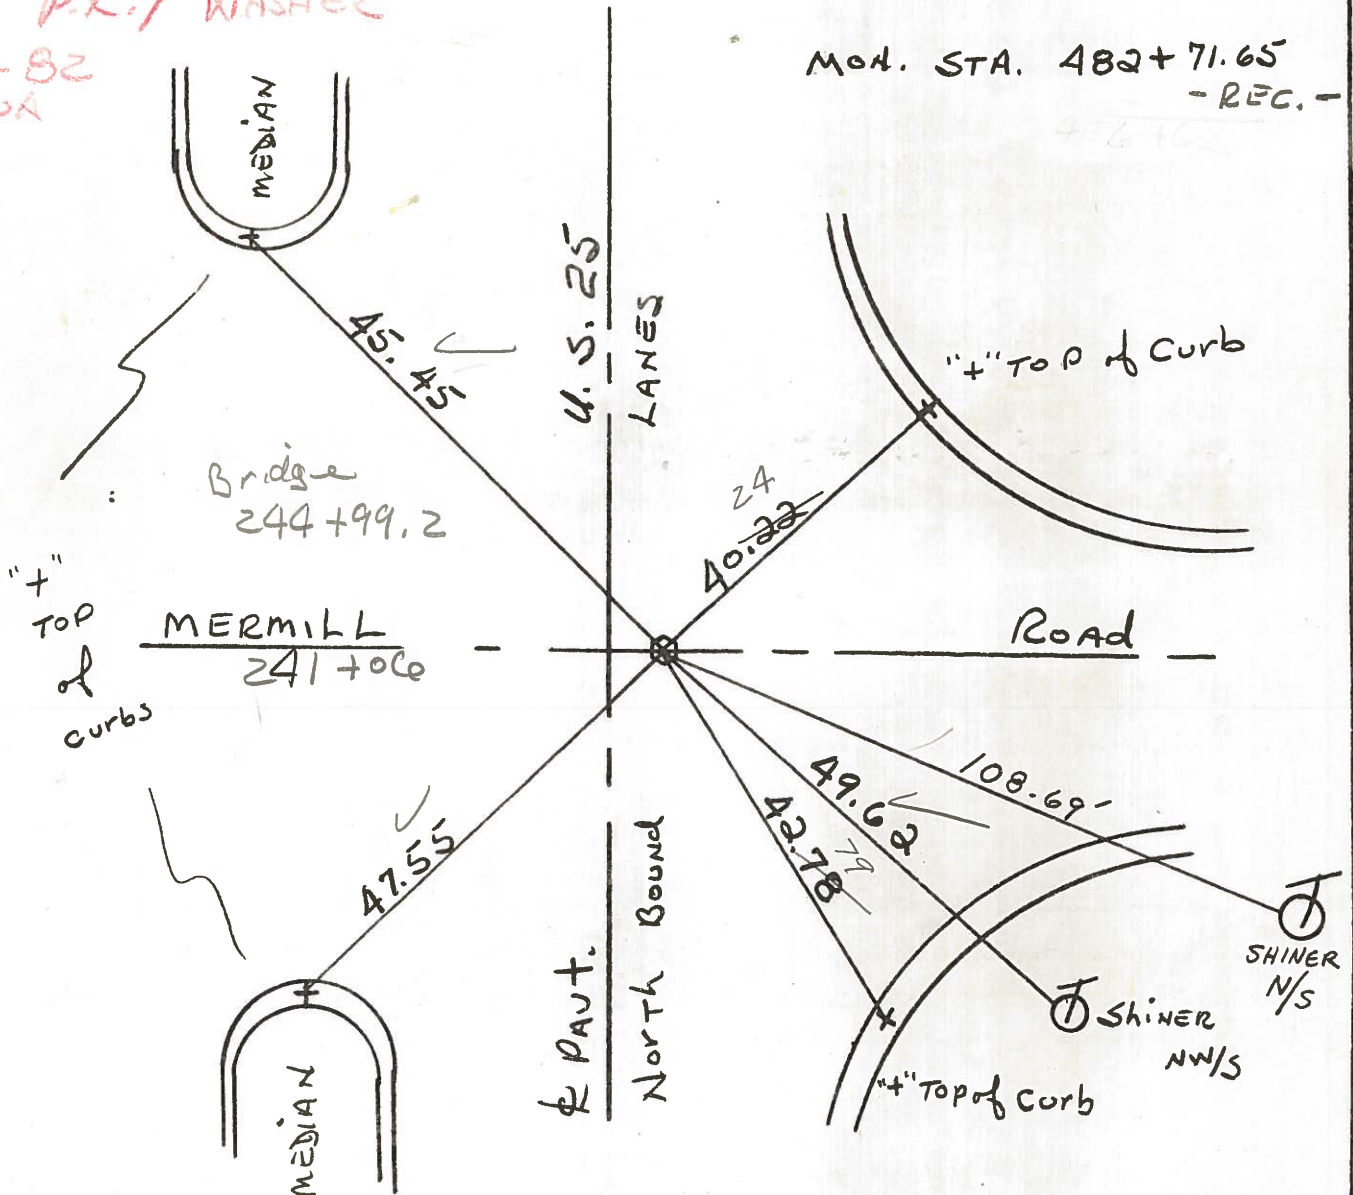

County Wood S.R. -U.S. 25

Township Liberty

Section 13

T4N, R10E

Personnel HOFFMAN


HOUSEHOLDER

8

Date 6-10-81

Weather cloudy


Temp. +70°

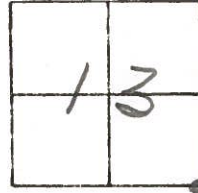

Fd. BRASS MON. @ SURFACE
1.5' E. of $\frac{1}{2}$ PAUT of N.B. LANES
10.5' TO E. Edge PAUT.

SET P.K./WASHER
11/9/82
J.W.H.

MON. STA. 482+71.65
- REC. -

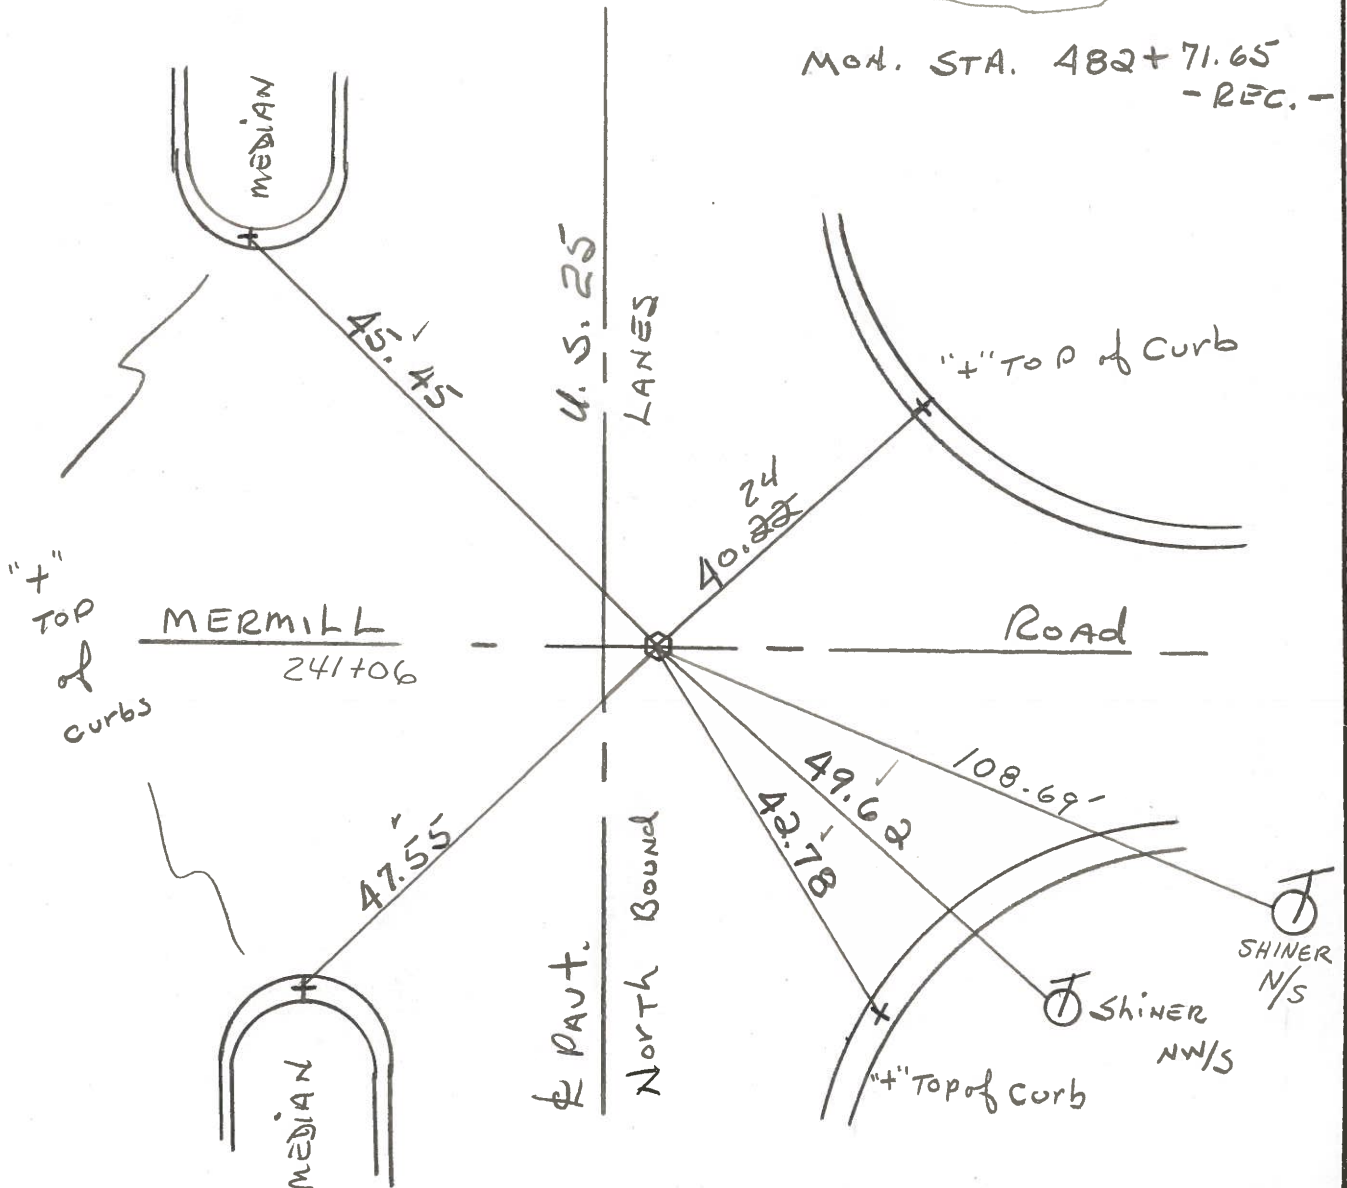

Q.D.O.T. DISTRICT 2 SURVEY OFFICE

SHEET

OF

County WOOD ^{U.S.} S.R. 25

Township LIBERTY

Section 13

T4N, R10E

Personnel BURNSIDE


SMITH

BOWERS


Date 7-6-71

Weather CLEAR

Temp. 82°

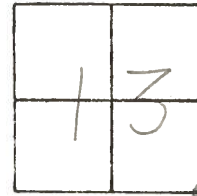

#8

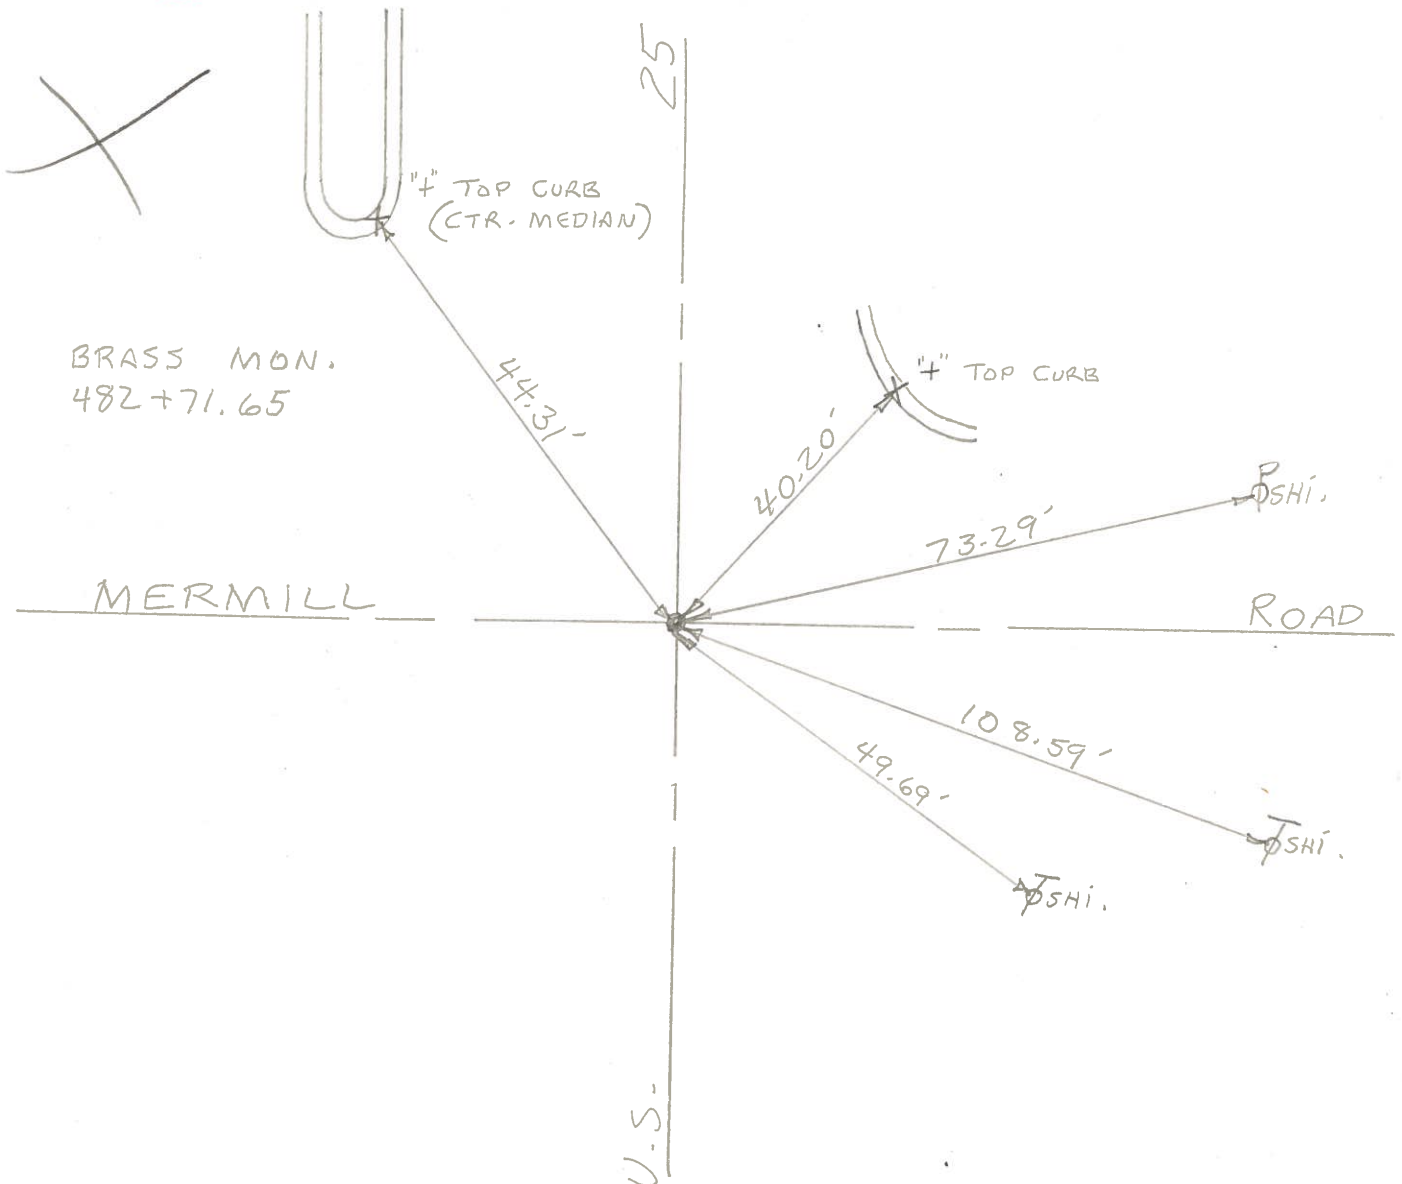

PERSONNEL

TITLE

PERSONNEL

TITLE

COUNTY

Wood

DATE

4-5-60

S. R.

U.S. #25

WEATHER

SEC.

TEMP.

DESCRIPTION

LEFT

CENTER LINE

RIGHT

JOB NO.

22.84 South of Point #234	Shiner in End Post N.E.	64.73
Sta. 429+39.2	Shiner in P.P. W.S.W.	41.24
N.W. cor. sec. 30. Portage	Shiner in T.P. N.E. 67.20	66.92
Twp.	X on E. pt. Hdwl. N.W.	63.82
Brass plate in &	Conc. P/W mon. S.E. 53.10	52.90
Pavement. S.R. #281	Shiner in End Post S.E.	49.75
(6-A) #233	Shiner in Twin T. Pole S.S.E.	91.81
(6)		
Sta. 429+61.95 22.84 North #233	Shiner in t.P. N.E.	50.34
S.E. cor. sec. 24 Liberty	Shiner in P.P. S.W.	49.35
Twp.	X on E. pt. Hdwl. W.N.W.	51.20
Brass plate & of pavement.	Conc. P/W mon. S.E. 70.20	69.80
OK 12-9-57 S.R. #281	Shiner in End Post S.E.	66.15
(6) #234	Shiner in End Post N.E.	48.18
(6-A)		
Sta. 455+74.5	Shiner in T.P. S.S.E.	79.20
E. 1/4 post sec. 24 Liberty	Shiner in T.P. 79.20 N.N.E.	81.40
Twp.	Shiner in P.P. W.N.W.	77.30
Brass plug, top of	Shiner in P.P. W.N.W.	38.00
plate gone	Wedge part. 5.9 Edge part. 14.6	51.89
(7) #235	Shiner in End Post N.N.E.	52.00
	Shiner in End Post N.E.	40.70
		40.60
Sta. 482+71.65	Shiner in P.P. N.W.	55.20
S.E. cor. sec. 13 Liberty	Shiner in P.P. E.N.E.	73.20
Twp. McMill Rd.	S.E. cor. brick chimney of gas	101.10
Brass plate in & part.	walnut station N.W.	101.10
(8) #236	Shiner 10' Ash N.N.W.	68.30
	Shiner T. Pole S.E.	49.60