

O.D.O.T. DISTRICT 2 SURVEY OFFICE (USE ONLY)

PERSONNEL

REFERENCE NO. 9

SHEET OF

NOTES NIESE
H.C. NIESE
R.C. ASTON

DATE 11/20/23
WEATHER CLEAR
TEMP. 37°

ROUTE SR 25
COUNTY WOOD
TOWNSHIP PORTAGE
SECTION 18

DWG BY BARRIERE PID 92133

T 4 N R 11 E

TYPE MONUMENT MONBOX W/ 1" IPIN

ON SURFACE - BELOW ON

OFFSET $\varnothing$ PAVEMENT 28' RT LT : RT


 TO EDGE PAVEMENT

STATION: 264+67

HORIZ.DATUM: NAD83(11)/WOOD LDP GEOID: 18

GRID: NORTHING: 598685.769 EASTING: 1652458.121

LDP: NORTHING: 420528.826 EASTING: 163948.578

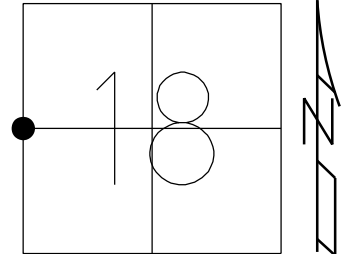

RECORD:
STA. 507+07
FD BRASS MON
FD P.K./WASHER
4/12/01, TMR
SET P.K./WASHER
10-31-01, SAH
FD P.K./WASHER
(SHOT AS REFA9)
5-30-18, JFO
DRAWING CORRECTED
11/16/23, TDN
FD MONBOX
W/ 1" IPIN
CHECKED W/ GPS
NEWREF9
11/15/23, TDN

****NOTE****
POINT WAS ADJUSTED PER
WOO-25-0.75, PID 92133
PLANS. SEE PLANS FOR
PRIOR COORDINATES
AND INFORMATION.
**** ****

$\varnothing$ S.B. SR 25

$\varnothing$ N.B. SR 25

FD MONBOX
W/ 1" IPIN



DIST. 9-A9=0.7'

****NOTE****
A9 IS 0.7' WEST OF PIN
INSIDE MONBOX.
**** ****

O.D.O.T. DISTRICT 2 SURVEY OFFICE (USE ONLY)

PERSONNEL

REFERENCE NO. 9

SHEET 19 OF 36

NOTES RHOADES

DATE 5/30/18

ROUTE SR 25

H.C. O'DONNELL

WEATHER CLOUDY

COUNTY WOOD

R.C. TRENKA

TEMP. 82°

TOWNSHIP LIBERTY

SECTION 13

DWG BY NIESE

PID NO PID

T 4 N R 10 E

TYPE MONUMENT P.K./WASHER

ON SURFACE - ~~BELOW~~ ON

OFFSET $\mathcal{C}$ PAVEMENT ON ~~LT~~ : RT

11.3' TO LT EDGE PAVEMENT


STATION: 264+67

HORIZ.DATUM: NAD83(2011)

GEOID: NAVD88 2012A

GRID: NORTHING: 598685.850

EASTING: 1652457.455

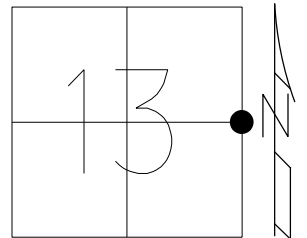

RECORD:
STA.507+07
FD BRASS MON
FD P.K./WASHER
4/12/01, TMR
SET P.K./WASHER
10-31-01, SAH
FD P.K./WASHER
(SHOT AS REFA9)
5-30-18, JFO
DRAWING CORRECTED
11/16/23, TDN

$\mathcal{C}$ S.B. SR 25

$\mathcal{C}$ N.B. SR 25



FD
"+"
CBS

28.40'

9A

86.18'




DIST.9-9A= 0.7'

SEE VERSION UPDATED ON 11/16/23

O.D.O.T. DISTRICT 2 SURVEY OFFICE (USE ONLY)

PERSONNEL	REFERENCE NO. <u>9</u>	SHEET <u>19</u> OF <u>36</u>
NOTES <u>RHOADES</u>	DATE <u>5/30/18</u>	ROUTE <u>SR 25</u>
H.C. <u>O'DONNELL</u>	WEATHER <u>CLOUDY</u>	COUNTY <u>WOOD</u>
R.C. <u>TRENKA</u>	TEMP. <u>82°</u>	TOWNSHIP <u>LIBERTY</u>
		SECTION <u>13</u>
DWG BY <u>MILLER</u>	PID <u>NO PID</u>	T <u>4</u> N R <u>10</u> E
TYPE MONUMENT <u>P.K.NAIL</u>		
ON SURFACE - BELOW <u>ON</u>		
OFFSET <u>CL</u> PAVEMENT <u>0.3'</u> LT : RT		
<u>11.3'</u> TO <u>LT</u> EDGE PAVEMENT		
STATION: <u>264+67</u>		
HORIZ.DATUM: <u>NAD83(2011)</u>	GEOID: <u>NAVD88 2012A</u>	
GRID: NORTHING: <u>598685.796</u>	EASTING: <u>1652458.149</u>	

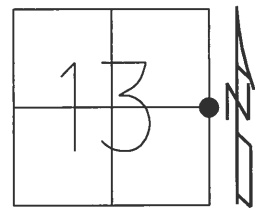

RECORD:
STA.507+07
FD BRASS MON
FD P.K./WASHER
4/12/01, TMR
SET P.K./WASHER
10-31-01, SAH
FD P.K.NAIL
REF9
5-30-18, JFO

CL S.B. SR 25

CL N.B. SR 25

FD
"+"
CBS

29.04'

9A

85.84'

FD
SHI

DIST.9-9A= 0.7'

O.D.O.T. DISTRICT 2 SURVEY OFFICE

PERSONNEL

REFERENCE NO. 9-10

SHEET 12 OF 23

NOTES Huss

H.C. Rousos

R.C. Dan Dusen

DATE 4-12-01

WEATHER Pt Cldy-Windy

TEMP. 47.2°F

ROUTE SR-25

COUNTY Wood

TOWNSHIP Liberty

SECTION 13

T 4 N R 10 E


TYPE MONUMENT (A) PK/W (B) PK/W

ON SURFACE - ~~BRASS~~ Surface

~~LEFT~~ - E PAV'T. - RIGHT (A) 0.3' (B) 0.2'

11.3 TO LT EDGE PAVEMENT

S.L.M. (A) 264+67 (B) 266+92

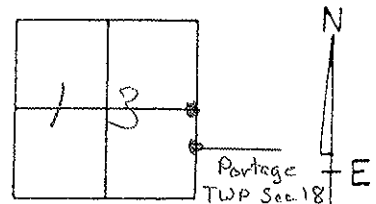

Record:

(A) BRASS MONUMENT
Sta. 507+07.0

(B) BRASS MONUMENT
Sta. 509+31.4

Fd W/shi
E/S 14"

94.55'

Fd PK/W
in fence Post

Set PK/W
Both Points
10-31-01
SAH

Set N/shi
Brace Post

(B)

77.35'

41.15'

53.22'

Fd N/shi

224.55'

(A)

28.43'
(Rec)

Fd "x" top
South side
C.B.

W
SR-25
N.B.

86.17'

Set N/shi
w/s P.P.

83.07'

Fd Watch
2' up w/s
N.M. #5
post

O.D.O.T. DISTRICT 2 SURVEY OFFICE

PERSONNEL

REFERENCE NO. 9 F 10

SHEET 12 OF 23

NOTES HOFFMAN

H.C. LOENHKE

R.C. BARAHISEL

DATE 3-26-91

WEATHER OVERCAST

TEMP. 55°

ROUTE SR 25

COUNTY WOOD

TOWNSHIP LIBERTY

SECTION 13

T 4 N R 10 E


TYPE MONUMENT P.K./washer - P.K./washer

ON SURFACE - BELOW YES YES

LEFT - C PAV'T. - RIGHT 0.3 - 0.2

11.3 TO LT EDGE PAVEMENT

S.L.M. "A" = 264 + 67

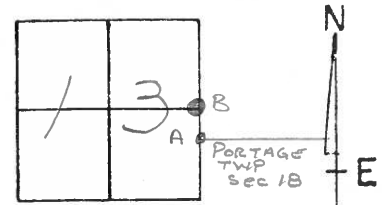

SET P.K.'S & Washers
6-6-91
mB

RECORD: POINT "A"
BRASS MON., STA. 507+07.0
POINT "B"
BRASS MON., STA. 509+31.4

SET Shi
E/S 14"

94.55

SR 25

Fd Shi SW/S

53.15

224.55

85.29

Fd Shi SW/S

28.43

Fd "T" TOP
SOUTH SIDE
of C.B.

83.07


CUT NOTCH 2' UP
ON POST of mile marker
5

S.R. 25

PAV'T N.B.L.

County Wood S.R.-U.S. 25Township LibertySection 13

T4N, R10E

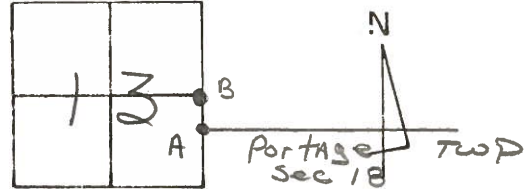Personnel HoffmanHouseholder# 9 & 10Date 6-10-81Weather clearTemp. + 78°

Pt. "A" Fd. BRASS MON @ SURFACE STA 507+07.0 - REC. S.L.M. 265+40
 Pt. "B" Fd. BRASS MON @ SURFACE STA 509+31.4 - REC. S.L.M. 267+64

SET P.K/WASHER
 @ EACH POINT
 11/9/82
 S.W.H.

SET NEW SHINER
 N/S END POST

34
 106.30



CUT "T" TOP
 CTR. S. SIDE
 C.B.

W. E. P.

LANES

North Bound

U.S. 25

80' ±

F. E. P.

45.57'
 39.27'

SHINERS w/s ANCHOR
 LINE POSTS

53.19

SHINER
 w/s

29.80'

CUT NOTCH W/S
 3RD STEEL POST S. OF LINE ANCHOR

85.30
 10.47'

SHINER
 w/s

SHINERS, w/s POSTS

41.10
 30.65

Field Drive

48.31

SHINER
 w/s
 STUB

SHINERS,
 w/s POSTS

WOOD 25
 5 mile MARKERS

Q.D.O.T. DISTRICT 2 SURVEY OFFICE

SHEET

OF

County WOOD ^{U.S.} ~~S.R.~~ 25

Township LIBERTY

Section 13

T4N, R10E

Personnel BURNSIDE


SMITH

BOWERS

Date 7-6-71

Weather CLEAR


Temp. 82°

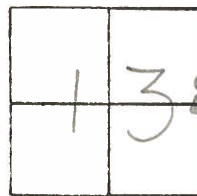


9 - # 10

BRASS MON.
509+31.4

E 1/4 POST SEC. 13
LIBERTY TWP.

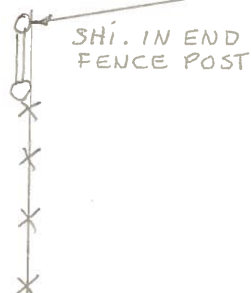

25
224.35'
U.S.

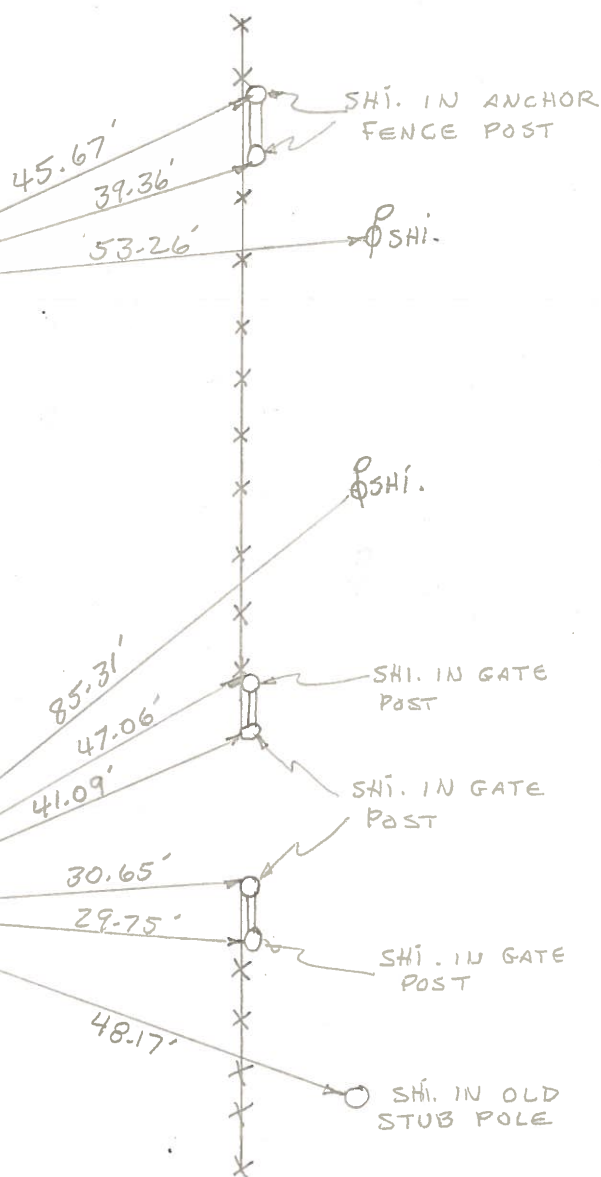

W. 1/4 POST SEC. 18
PORTAGE TWP.
SAN. CO.

BRASS MON.
STA. 507+07.0

PERSONNEL TITLE PERSONNEL TITLE

COUNTY Wood DATE 4-5-60S.R. U.S. #25 WEATHER

SEC. TEMP.

DESCRIPTION LEFT CENTER LINE RIGHT JOB NO.

Sta. 507+07.0			Shiner in Anchor Post N.N.E. 47.04'
W. 1/4 post sec. 18 Portage			Shiner in T.P. W.N.W. 29.00'
Twp.			Shiner in P.P. N.N.E. 85.30'
Brass plate - Could not raise			Shiner in 8' oak S.E. 95.76'
Mobara Mon.			Wedge post, 7.85 Edge 12.15
(10) (9) #237			Shiner in End Post N.N.E. 41.07
			Shiner in End Post N.E. 30.63
			Shiner in Anchor Post E. 29.71
Sta. 509+31.4			Shiner in T.P. N.W. 58.28'
E. 1/4 post sec. 13 Liberty			Shiner in T.P. S.S.W. 89.15'
Twp.			Shiner in P.P. N.E. 53.30 59.34'
Brass plate with top - (Could not)			Iron cor. post S.W. 35.45'
plate gone (raise)			Wedge post, 8.55' Edge 11.35'
(10) #238			Shiner Brace Post N.N.E. 45.75'
			Shiner Brace Post N.E. 39.43'
			"X" E. Edge S. Bound lane (West) 44.10'
			"X" E. Edge S. Bound lane (N. West) 54.37'
Sta. 533+62.85			Shiner in T.P. E.S.E. 66.74'
S.W. cor. sec. 7 Portage			Shiner in P.P. S.S.E. 94.22'
Twp. <u>Greensburg Pike East</u>			Shiner in T.P. W. 38.16'
Brass plate in lot post.			Shiner in End Post N.N.E. 44.74'
(11) #239			Shiner in P. Pole N.E. 93.10
			Shiner in End Post E.S.E. 50.93
			Shiner in T. Pole S.E. 66.94'
Sta. 535+91.8			Shiner in P.P. N.N.E. 94.62
S.E. cor. sec. 12 Liberty			Shiner in T.P. N.W. 45.00'
Twp. <u>Greensburg Pike West</u>			Shiner in T.P. W.N.W. 67.13'
Brass plate in E post.			conc. E/W mon. S.W. 57.29'
(12) #240			"X" in conc. curb N.W. 38.39
			"X" in conc. curb S.W. 34.14'