

O.D.O.T. DISTRICT 2 SURVEY OFFICE (USE ONLY)

PERSONNEL

REFERENCE NO. A9

SHEET OF

NOTES NIESE

DATE 11/20/23

ROUTE SR 25

H.C. NIESE

WEATHER CLEAR

COUNTY WOOD

R.C. ASTON

TEMP. 37°

TOWNSHIP PORTAGE

DWG BY BARRIERE

PID 92133

SECTION 18

T 4 N R 11 E

TYPE MONUMENT MONBOX W/ 1" IPIN

ON SURFACE - BELOW ON

OFFSET Q PAVEMENT 28' RT LT : RT


 TO EDGE PAVEMENT

STATION: 264+67

HORIZ.DATUM: NAD83(11)/WOOD LDP GEOID: 18

GRID: NORTHING: EASTING:

LDP: NORTHING: 420528.869 EASTING: 163948.611

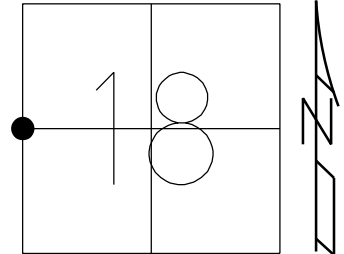

RECORD:
FD P.K. NAIL
(SHOT AS REF9)
5-30-18, JFO
DRAWING CORRECTED
11/16/23, TDN
POINT LANDS WITHIN MONBOX
DID NOT RE-ESTABLISH
11/20/23, TDN

Q S.B. SR 25

Q N.B. SR 25

FD MONBOX
W/ 1" IPIN

M₉

DIST. 9-A9=0.7'

****NOTE****
A9 IS 0.7' WEST OF PIN
INSIDE MONBOX.
**** ****

O.D.O.T. DISTRICT 2 SURVEY OFFICE (USE ONLY)

PERSONNEL

REFERENCE NO. 9 A

SHEET 20 OF 36

NOTES RHOADES DATE 5/30/18
H.C. O'DONNELL WEATHER CLOUDY
R.C. TRENKA TEMP. 82°

ROUTE SR 25
COUNTY WOOD
TOWNSHIP LIBERTY
SECTION 13

DWG BY NIESE PID NO PID

T 4 N R 10 E

TYPE MONUMENT P.K. NAIL

ON SURFACE - ~~BELOW~~ ON

OFFSET CL PAVEMENT 0.3' ~~LT~~ : RT
- TO - EDGE PAVEMENT


STATION: 264+67.5

HORIZ.DATUM: NAD83(2011)

GEOID: NAVD88 2012A

GRID: NORTHING: 598685.796

EASTING: 1652458.149

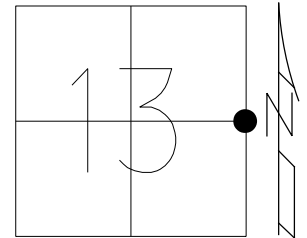

RECORD:
FD P.K. NAIL
(SHOT AS REF9)
5-30-18, JFO
DRAWING CORRECTED
11/16/23, TDN

CL S.B. SR 25

CL N.B. SR 25



FD
"+"
CBS

29.04'

9

85.84'

FD
SHI

DIST.9-9A= 0.7'

SEE VERSION UPDATED ON 11/16/23

O.D.O.T. DISTRICT 2 SURVEY OFFICE (USE ONLY)

PERSONNEL

REFERENCE NO. 9 A

SHEET 20 OF 36

NOTES RHOADES

DATE 5/30/18

ROUTE SR 25

H.C. O'DONNELL

WEATHER CLOUDY

COUNTY WOOD

R.C. TRENKA

TEMP. 82°

TOWNSHIP LIBERTY

SECTION 13

DWG BY MILLER

PID NO PID

T 4 N R 10 E

TYPE MONUMENT P.K./WASHER

ON SURFACE - ~~BELOW~~ ON

OFFSET CL PAVEMENT ON LT : RT

- TO - EDGE PAVEMENT


STATION: 264+67.5

HORIZ.DATUM: NAD83(2011)

GEOID: NAVD88 2012A

GRID: NORTHING: 598685.850

EASTING: 1652457.455

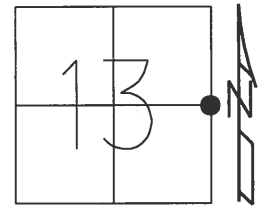

RECORD:
FD P.K./WASHER
REF A9
5-30-18, JFO

CL S.B. SR 25

CL N.B. SR 25

FD
"+"
CBS

28.40'

9

86.18'

FD
SHI

DIST. 9-9A= 0.7'

O.D.O.T. DISTRICT 2 SURVEY OFFICE

PERSONNEL

REFERENCE NO. 9-10

SHEET 12 OF 23

NOTES Huss

H.C. Rousos

R.C. VanDusen

DATE 4-12-01

WEATHER Pt Cldy-Windy

TEMP. +72°F

ROUTE SR-25

COUNTY Wood

TOWNSHIP Liberty

SECTION 13

T 4 N R 10 E


TYPE MONUMENT (A) PK/W (B) PK/W

ON SURFACE - ~~BRASS~~ Surface

~~PAV'T.~~ - PAV'T. - RIGHT (A) 0.3' (B) 0.2'

11.3 TO LT EDGE PAVEMENT

S.L.M. (A) 264+67 (B) 266+92

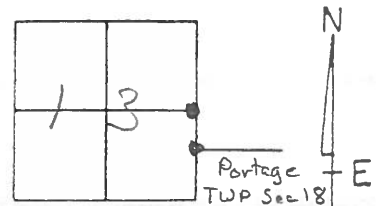

Record:

(A) BRASS MONUMENT
Sta. 507+07.0

(B) BRASS MONUMENT
Sta. 509+31.4

Fd N/shi
E/S 14"

94.55'

PAV'T
SR-25

W/SB

Fd 1" top
South Side
C.B.

(A)

(Rec)

PAV'T
SR-25
N.B.

(B)

Fd PK/W
In fence Post

Set PK/W
Both Points
10-31-01
SAH

Set N/shi
Brace Post

Fd N/shi

77.35'

41.15'

53.22'

224.55'

86.17'

Set N/shi
w/s P.P.

83.07'

Fd Watch
2' up w/s
M.M. #5
post

O.D.O.T. DISTRICT 2 SURVEY OFFICE

PERSONNEL

REFERENCE NO. 9 F 10

SHEET 12 OF 23

NOTES HOFFMAN

H.C. LOEHRKE

R.C. BARAHISEL

DATE 3-26-91

WEATHER OVERCAST

TEMP. 55°

ROUTE SR 25

COUNTY WOOD

TOWNSHIP LIBERTY

SECTION 13

T 4 N R 10 E

"A" "B"


TYPE MONUMENT P.K./washer - P.K./washer

ON SURFACE - BELOW YES YES

LEFT - C.P.A.V.T. - RIGHT 0.3 - 0.2

11.3 TO LT EDGE PAVEMENT

S.L.M. "A" = 264+67

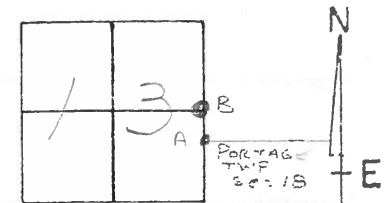

SET P.K.'S & WASHERS
6-6-91
mib

RECORD: POINT "A"
BRASS MON. STA. 507+07.0
POINT "B"
BRASS MON. STA. 509+31.4

SET SHI
E/S 14"

94.55

SR 25

Fd Shi SW/S

53.15

"B"

224.55

85.29

P

Fd Shi SW/S



28.43

Fd "T" TOP
SOUTH SIDE
of C.B.

224.55

83.07

SR 25


CUT NOTCH 2' UP
ON POST of milemarker
5

County Wood S.R.-U.S. 25Date 6-10-81Township LibertyWeather clearSection 13Temp. +78°

T4N, R10E

Personnel Hoffman
Householder


#9 & 10

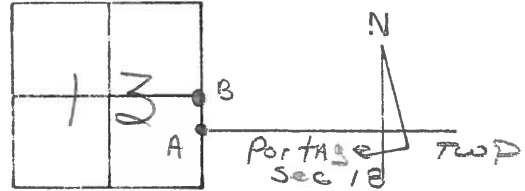

Pt. "A" Fd. BRASS MON @ SURFACE STA 507+07.0 - REC. S.L.M. 265+40
 Pt. "B" Fd. BRASS MON @ SURFACE STA 509+31.4 - REC. S.L.M. 267+64

SET P.K./WASHER
 @ EACH POINT
 11/9/82
 S.W.H.

SET NEW SHINER
 N/S END POST

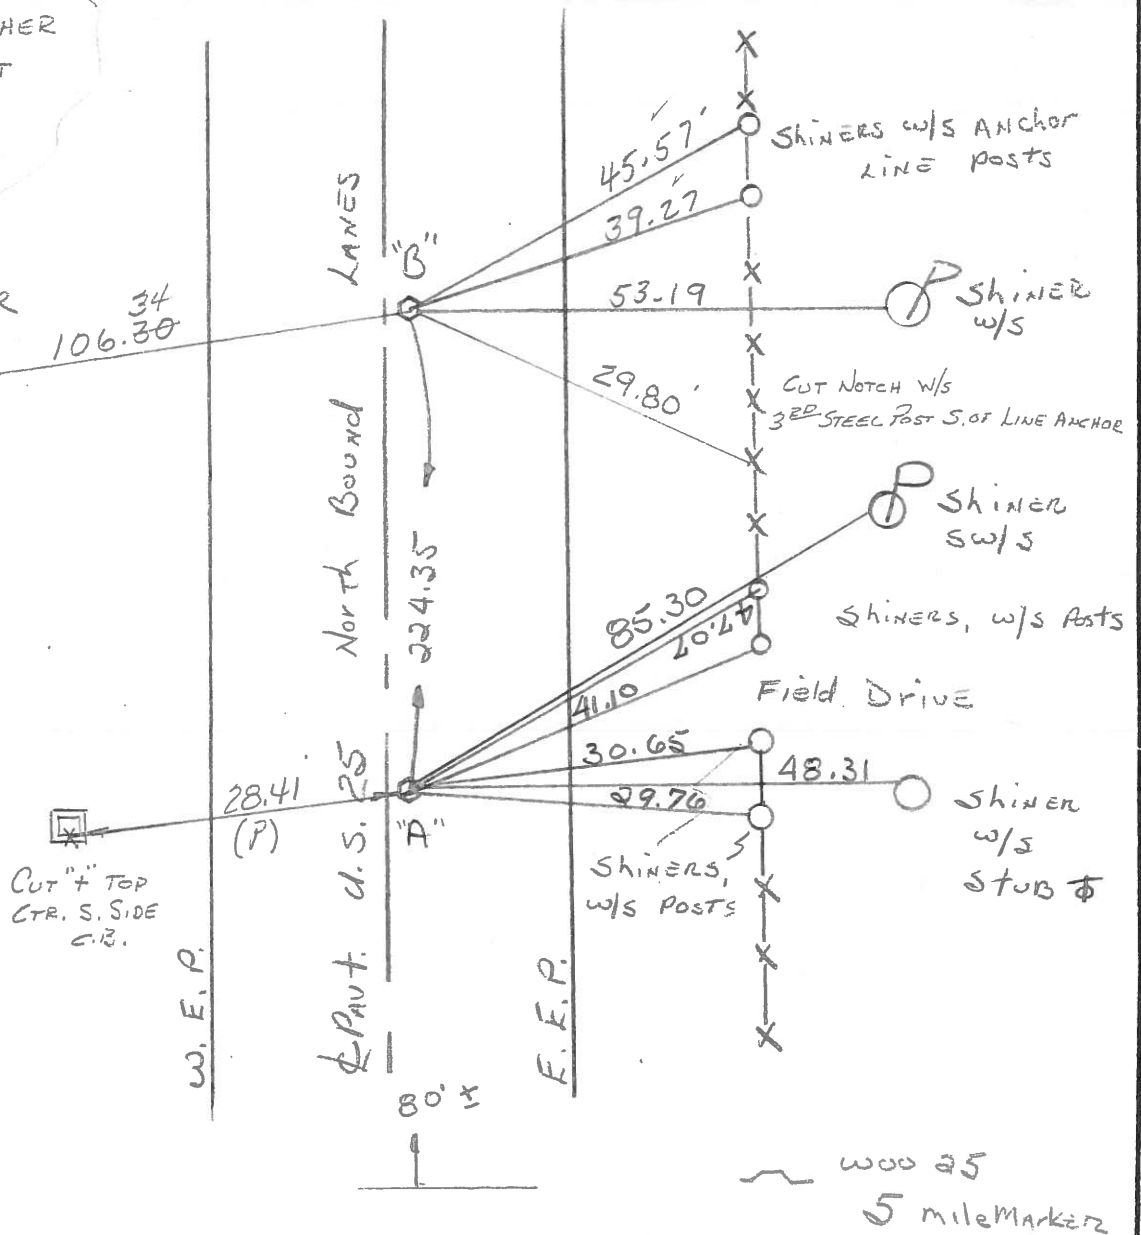

O.D.O.T. DISTRICT 2 SURVEY OFFICE

SHEET

OF

County WOOD ^{U.S.} S.R. 25

Township LIBERTY

Section 13

T4N, R10E

Personnel BURNSIDE


SMITH

BOWERS

Date 7-6-71

Weather CLEAR

Temp. 82°

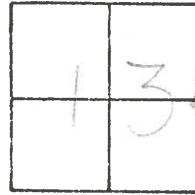

#9 - #10

BRASS MON.

507+31.4

E 1/4 POST SEC. 13

LIBERTY TWP.

SHI. IN END
FENCE POST

SHI. IN ANCHOR
FENCE POST

SHI.

SHI.

SHI. IN GATE
POST

SHI. IN GATE
POST

SHI. IN GATE
POST

SHI. IN OLD
STUB POLE

W. 1/4 POST SEC. 18

PORTAGE TWP.

SAN. CO.

BRASS MON.

STA. 507+07.0

23

224.35

U.S.

45.67'

39.36'

53.26'

109.92'

85.31'

47.06'

41.03'

30.65'

29.75'

48.17'

PERSONNEL

TITLE

PERSONNEL

TITLE

COUNTY

Wood

DATE

4-5-60

S.R.

11.5. #25

WEATHER

SEC.

TEMP.

DESCRIPTION

LEFT

CENTER LINE

RIGHT

JOB NO.

Sta. 507+07.0

W. 1/4 post sec. 18 Portage
Twp.Brass plate - Could not raise
Mobora Mon.

⑩

⑨

#237

Shiner in Anchor Post N.N.E. 47.0'

Shiner in T.P. W.N.W. 29.00

Shiner in P.P. N.N.E. 85.38

~~Shiner in 8" oak E.E. 95.76~~

W. edge post. 7.85 E. edge 12.15

Shiner in End Post N.N.E. 41.07

Shiner in End Post N.E. 30.63

Shiner in Anchor Post E. 29.71

Sta. 509+31.4

E. 1/4 post sec. 13 Liberty
Twp.Brass plate with top - (Could not
plate gone Raise)

⑩

#238

Shiner in T.P. N.W. 58.28

Shiner in T.P. S.S.W. 89.15

Shiner in P.P. N.E. 53.30 59.34

Iron cor. post S.W. 35.45

W. edge post. 8.55' E. edge 11.35'

Shiner Brace Post N.N.E. 45.75

Shiner Brace Post N.E. 39.43

"X" E. Edge S. Bound lane (west) 44.10'

"X" E. Edge S. Bound lane (N. west) 54.37'

Sta. 533+62.85

S.W. cor. sec. 7 Portage

Twp. Greensburg Pike East.
Brass plate in lot post.

⑩

#239

Shiner in T.P. E.S.E. 66.74

Shiner in P.P. S.S.E. 94.22

Shiner in T.P. W. 38.16

Shiner in End Post N.N.E. 44.74

Shiner in P. Pole N.E. 93.10

Shiner in End Post E.S.E. 50.93

Shiner in T. Pole S.E. 66.94

Sta. 535+91.8

S.E. cor. sec. 12 Liberty

Twp. Greensburg Pike West.
Brass plate in E post.

⑩

#240

Shiner in P.P. N.N.E. 94.60

Shiner in T.P. N.W. 45.00

Shiner in T.P. W.N.W. 67.13

conc. E/W mon. S.W. 57.29

"X" in conc. curb N.W. 38.3

"X" in conc. curb S.W. 34.14