

# O.D.O.T. DISTRICT 2 SURVEY OFFICE (USE ONLY)

PERSONNEL

REFERENCE NO. 11

SHEET      OF     

NOTES ASTON  
H.C. NIESE  
R.C. ASTON

DATE 11/20/23  
WEATHER WINDY  
TEMP. 37°

ROUTE SR 25  
COUNTY WOOD  
TOWNSHIP PORTAGE  
SECTION 18

DWG BY BARRIERE PID 92133

T 4 N R 11 E

TYPE MONUMENT MONBOX W/ 1 1/4" IPIN

ON SURFACE - BELOW ON

OFFSET  $\oslash$  PAVEMENT 10' RT LT : RT


     TO      EDGE PAVEMENT

STATION: 263+75.51

HORIZ.DATUM: NAD83(11)/WOOD LDP GEOID: 18

GRID: NORTHING: 601340.476 EASTING: 1652486.055


LDP: NORTHING: 423183.875 EASTING: 163941.505

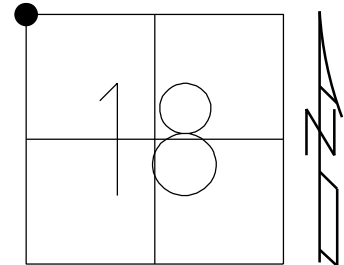

RECORD:  
NW COR SEC 18

STA.533+62.85  
FD BRASS PLUG  
FD P.K./WASHER  
4/16/01, TMR  
SET P.K./WASHER  
10-31-01, SAH  
SET MAG NAIL  
REF11  
5-30-18, JFO  
10-1-18, JFO  
FD BRASS DISK  
FD MAG NAIL  
3/17/22, JFO  
FD NEW MONBOX  
W/ 1 1/4" IPIN  
NEWREF11  
11/20/23, TDN

$\oslash$  GREENSBURG PIKE

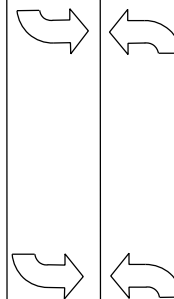

$\oslash$  GREENSBURG PIKE

**\*\*NOTE\*\***  
POINT WAS ADJUSTED PER  
WOO-25-0.75, PID 92133 PLANS.  
SEE PLANS FOR PRIOR COORDINATES  
AND INFORMATION.  
**\*\*          \*\***

PERSONNEL \_\_\_\_\_ REFERENCE NO. 11 SHEET 22 OF 36

NOTES RHOADES DATE 5/30/18 ROUTE SR 25  
H.C. O'DONNELL WEATHER CLOUDY COUNTY WOOD  
R.C. TRENKA TEMP. 84° TOWNSHIP LIBERTY  
SECTION 12

DWG BY MILLER PID NO PID T 4 N R 10 E

TYPE MONUMENT MAG NAIL

ON SURFACE - ~~BELOW~~ ON

OFFSET 1.4' ~~LT~~ : RT

10.0' TO RT EDGE PAVEMENT


STATION: 291+20

HORIZ.DATUM: NAD83(2011) GEOID: NAVD88 2012A

GRID: NORTHING: 601340.533 EASTING: 1652485.959



RECORD:  
STA.533+62.85  
FD BRASS PLUG  
FD P.K./WASHER  
4/16/01, TMR  
SET P.K./WASHER  
10-31-01, SAH  
SET MAG NAIL  
REF11  
5-30-18, JFO  
10-1-18, JFO

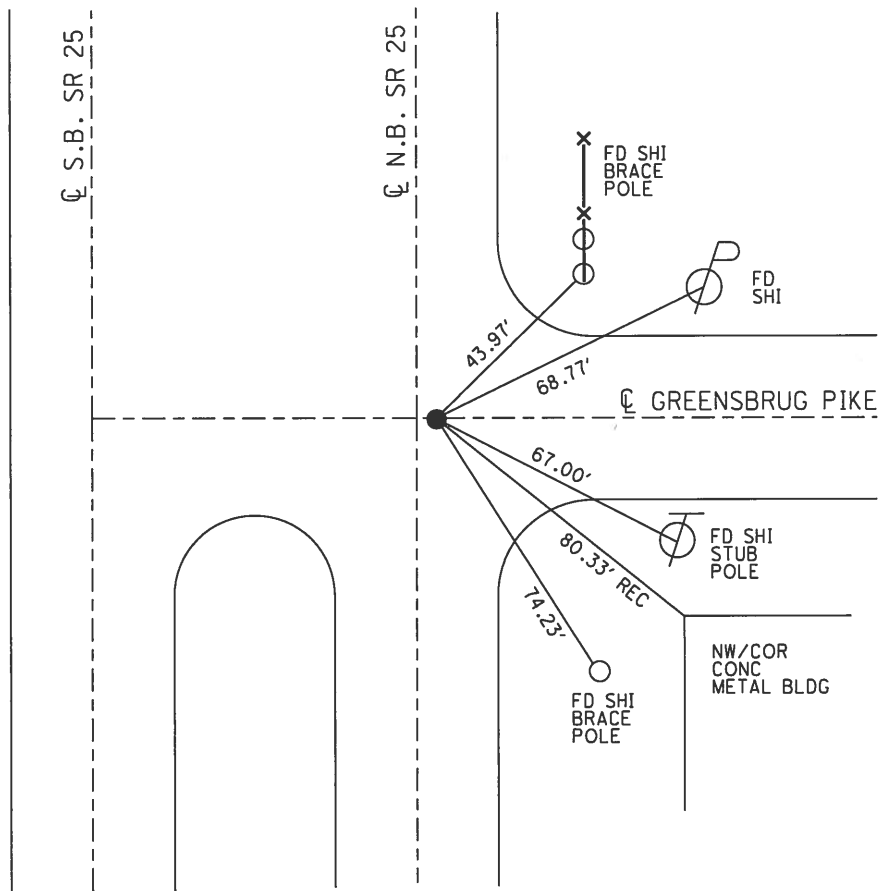

# O.D.O.T. DISTRICT 2 SURVEY OFFICE

PERSONNEL

REFERENCE NO. 11E12

SHEET 13 OF 23

NOTES Huss

H.C. Rousos

R.C. VanRusen

DATE 4-16-01

WEATHER Cloudy Rain

TEMP. 142°F

ROUTE SR 25

COUNTY Wood

TOWNSHIP Liberty

SECTION 12

T4 N R10 E



TYPE MONUMENT A- PK W/ASHER / B- PK W/ASHER

ON SURFACE - BELOW BOTH

LEFT - E PAV'T. - RIGHT A- 1.4 RT / B 1.6 RT

10.0' TO RT EDGE PAVEMENT

S.L.M. A- 291+20 / B- 293+49

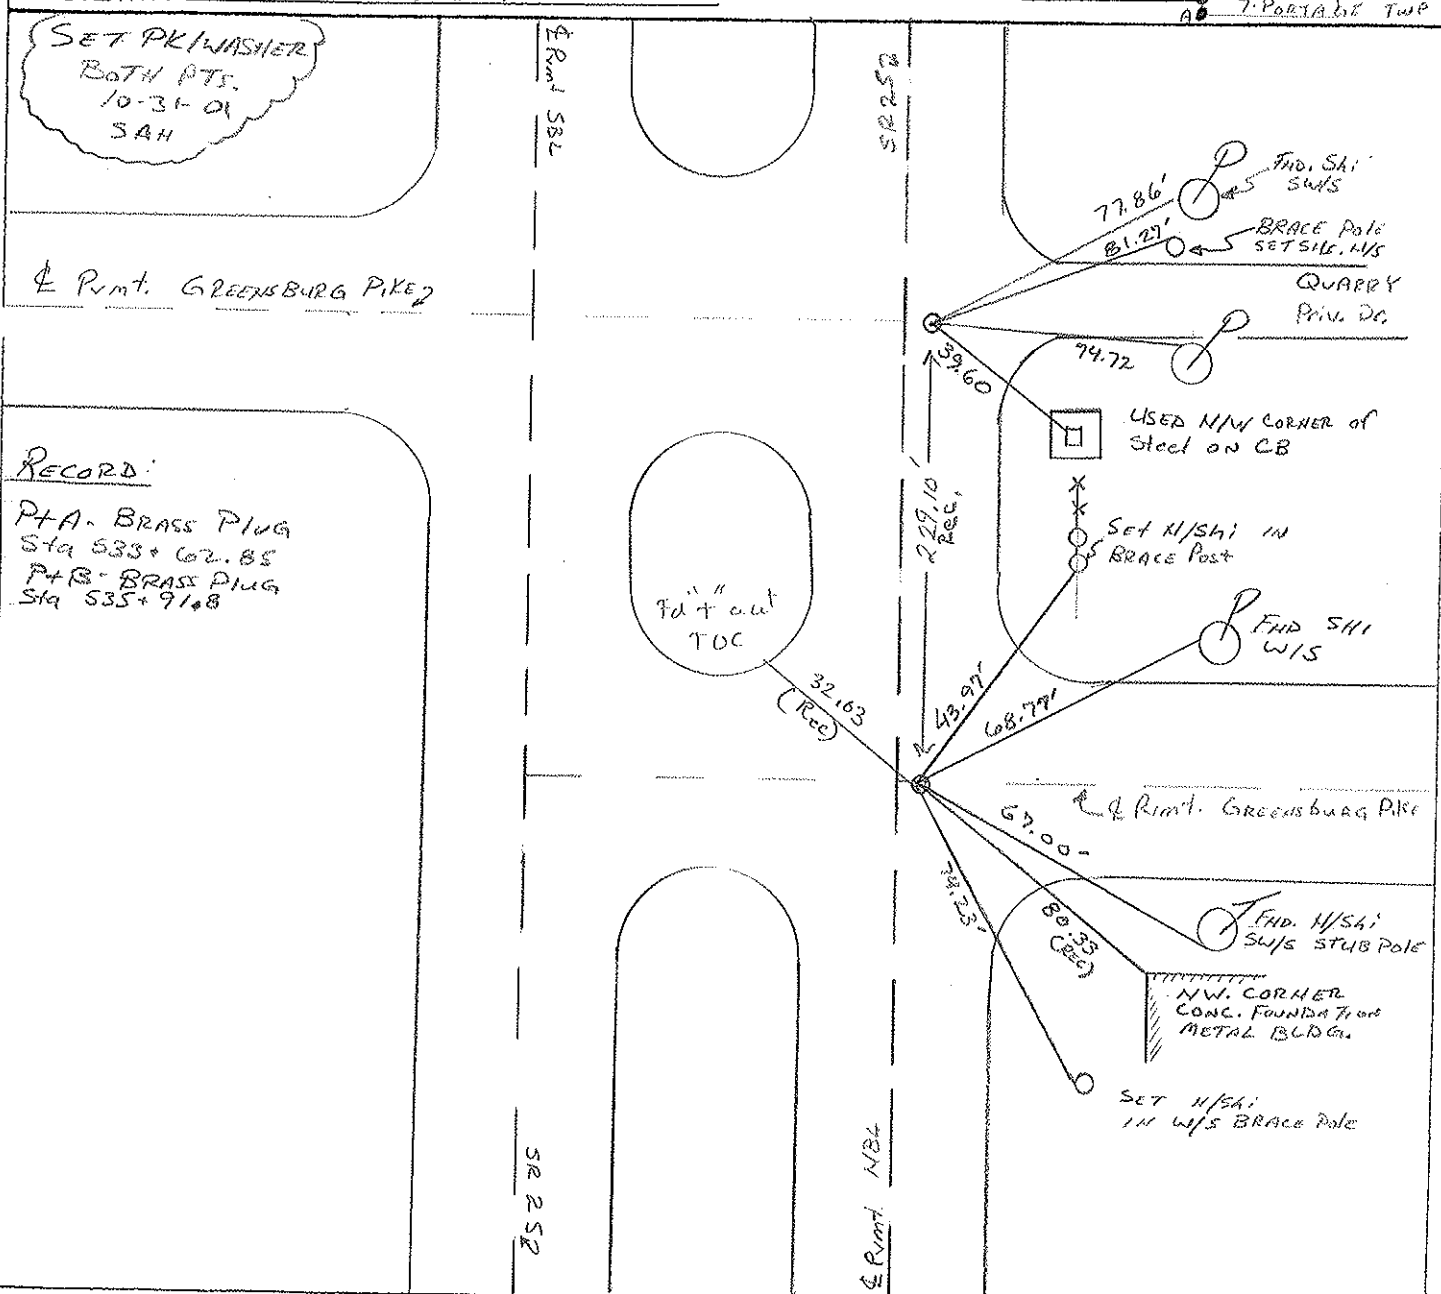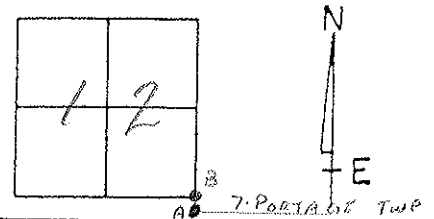

O.D.O.T. DISTRICT 2 SURVEY OFFICE

## PERSONNEL

REFERENCE NO. 11 & 12

SHEET 13 OF 23

NOTES HOFFMAN

H.C. LOENRKE

R.C. BARNHISEL

DATE 3-26-91

WEATHER OVERCAST

TEMP. 55°

ROUTE SR 25

COUNTY Wood

TOWNSHIP LIBERTY

SECTION 12

T4 NR 10 E



TYPE MONUMENT P.K./WASHER - P.K./WASHER

ON SURFACE - ~~BELOW~~ YES - YES

~~LEFT - C~~ ~~PAN~~ T. - RIGHT 1.4 - 1.6

10.0 TO RT EDGE PAVEMENT

S.L.M.  $A = 291 + 20$  ;  $B = 293 + 49$

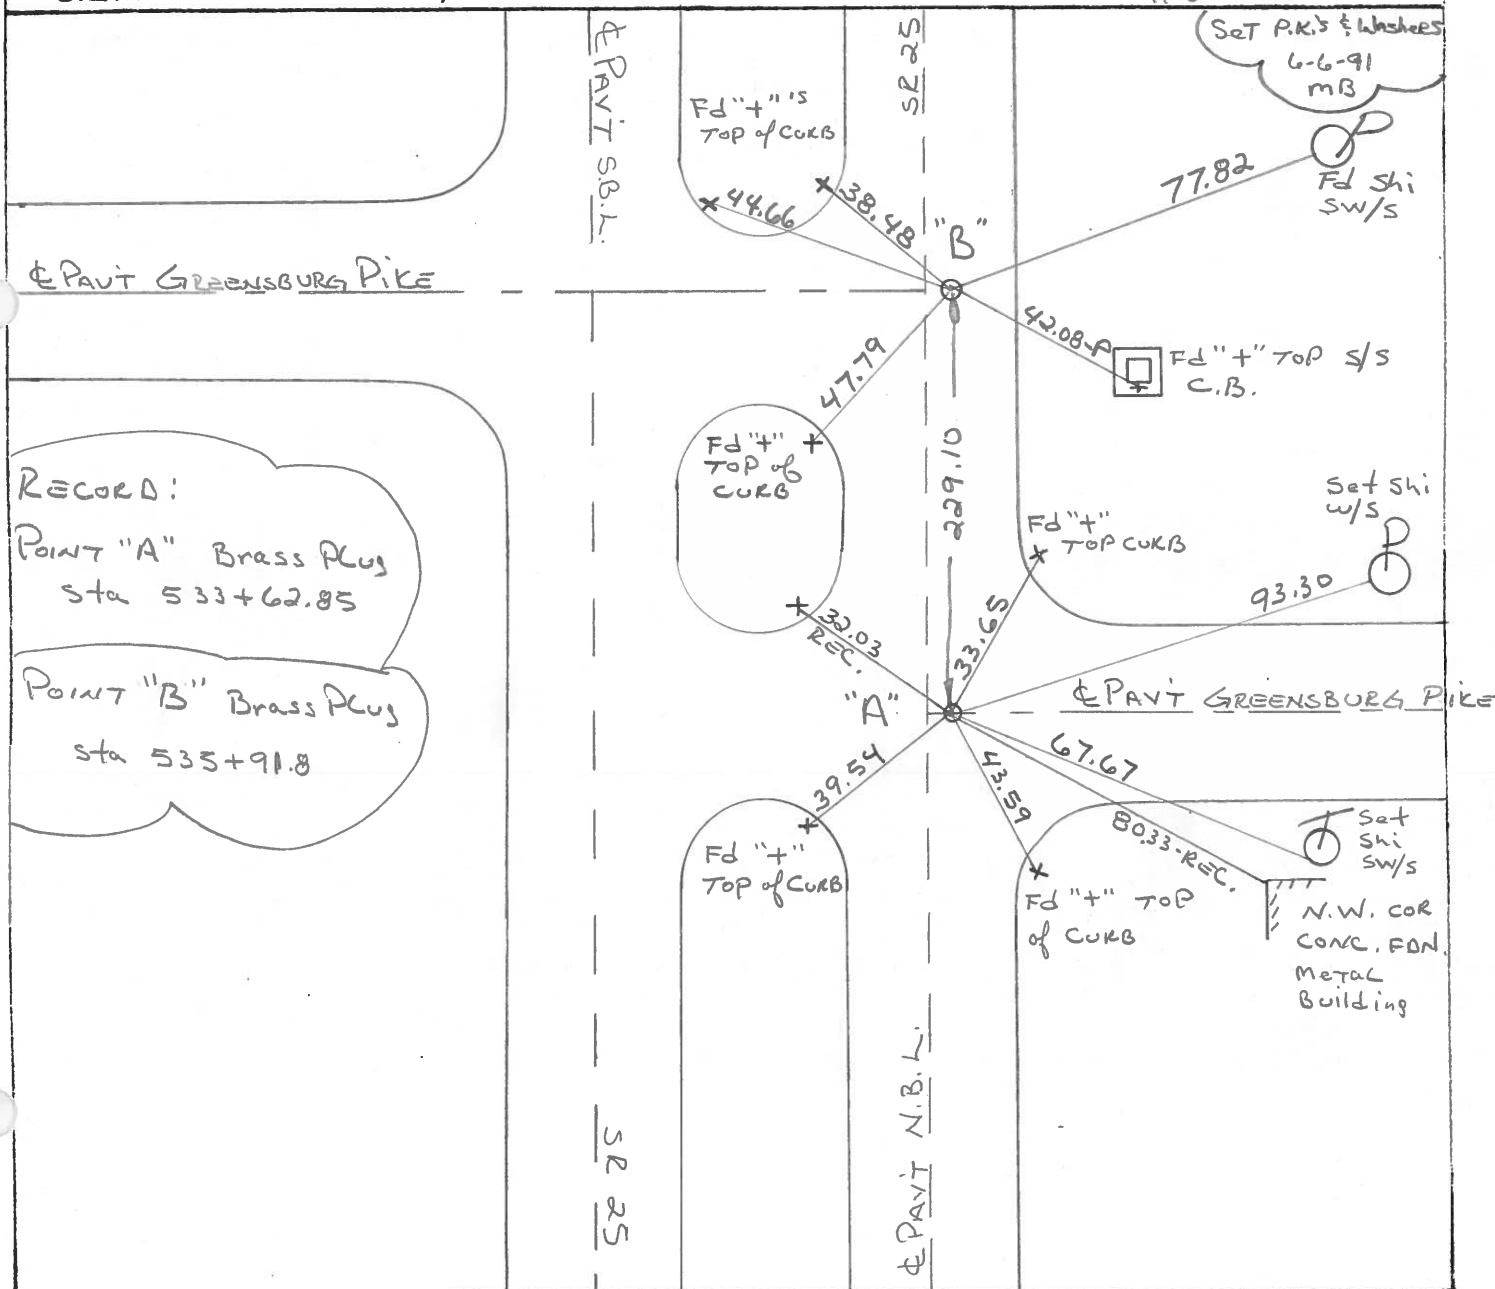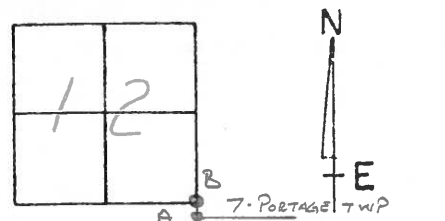

Date 6-10-81

Weather clear

Temp. + 75°

8-5-82  
+ 75°

|   |   |
|---|---|
|   |   |
| 1 | 2 |
|   | 3 |

N


PORTA LE

TWP

#11 - #12

13

1.8' E of  $\Delta$  PAUT, N.B.  
10.3' TO E. Edge PAUT

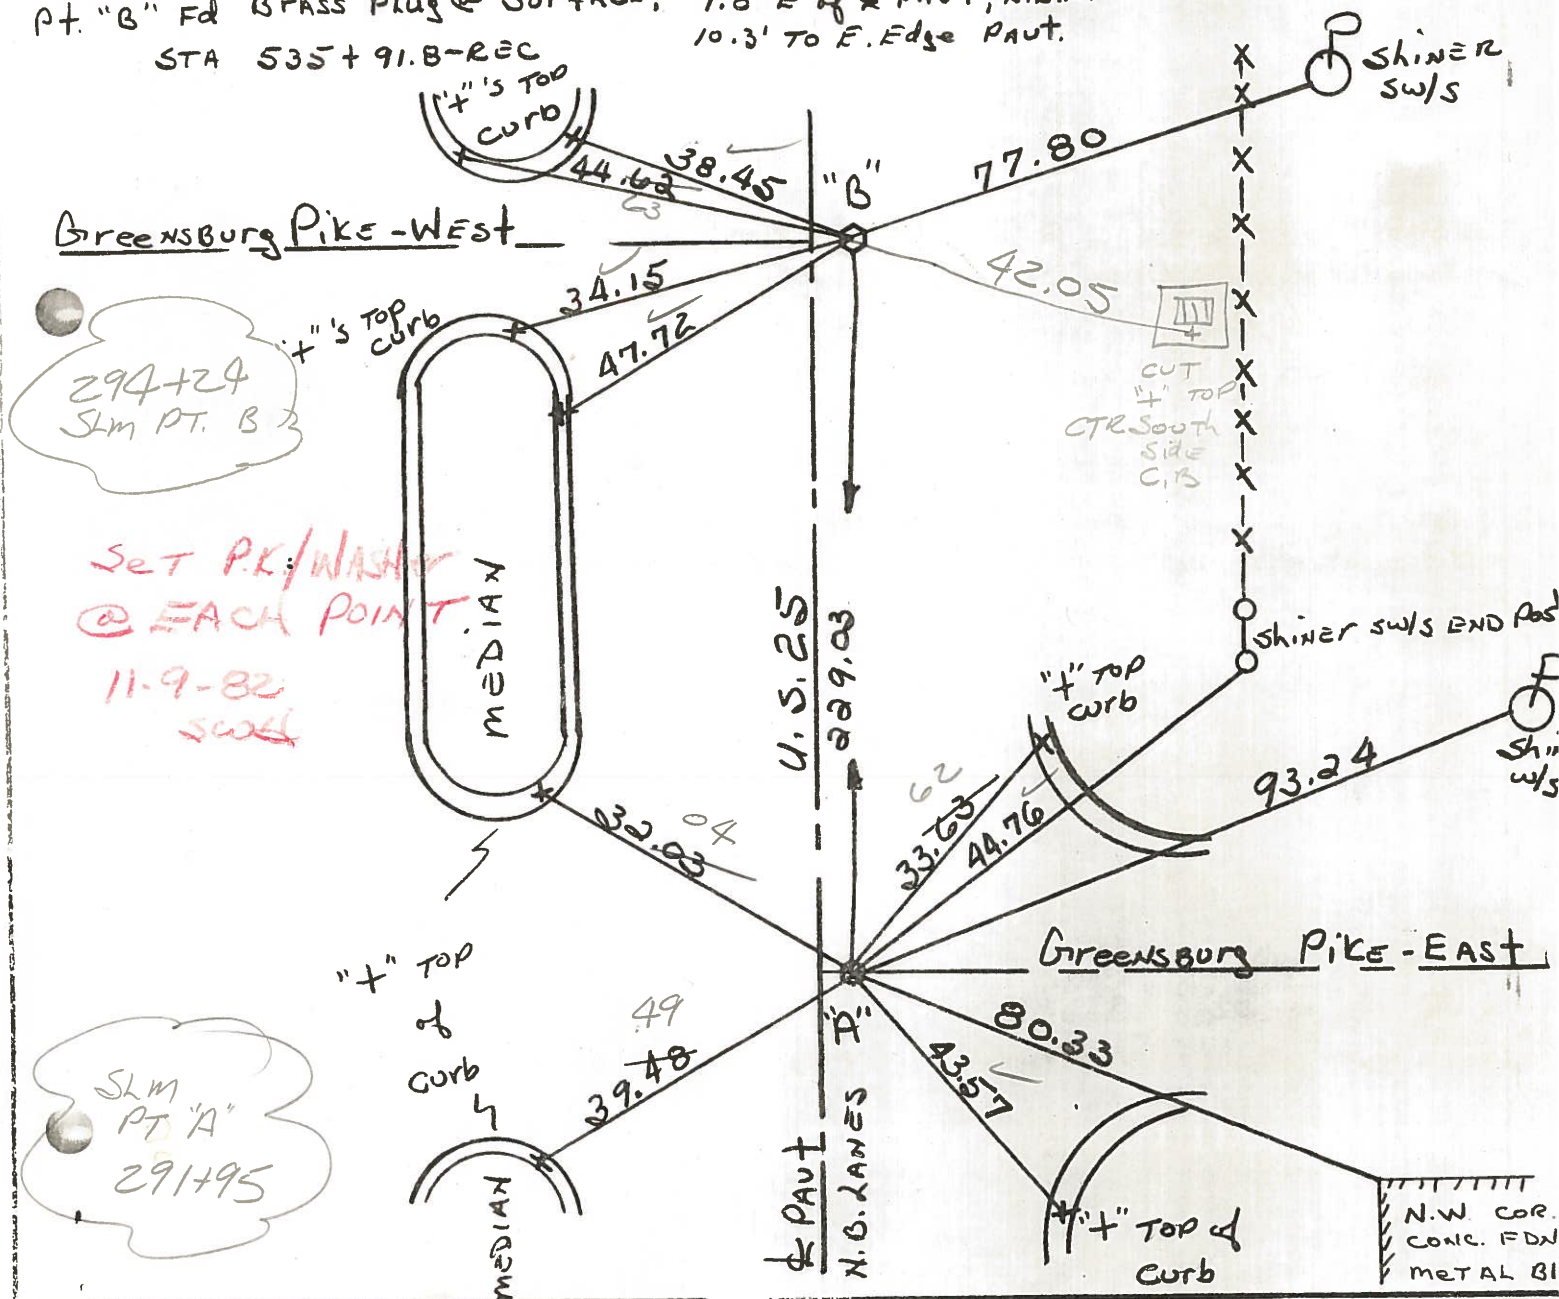

County WOOD S.R. U.S. 25

Township Liberty

Section 12

T4N, R10E

Personnel Hoffman


House holder

# 11 - # 12

Date 6-10-81

Weather clear

Temp. +75°

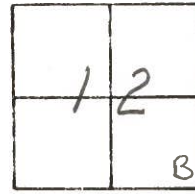


Pt. "A" Fd. BRASS Plug @ SURFACE, 1.6' E. of & PAUT, N.B.L. A  
STA 533+62.85-REC. 13.6' TO W. Edge PAUT

Pt. "B" Fd BRASS Plug @ SURFACE, 1.8' E of & PAUT, N.B.L.  
STA 535+91.8-REC 10.3' TO E. Edge PAUT.


Greensburg Pike - West

S.L.M. 294+24

"+" TOP  
Curb

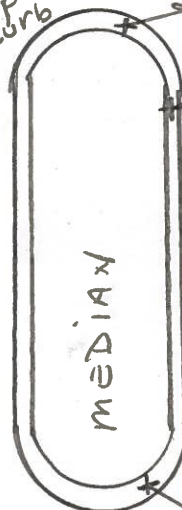

"+" TOP  
of  
Curb

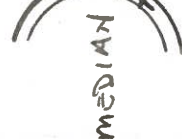

N.B. LANES

Greensburg Pike - East

S.L.M. 291+95

"+" TOP  
Curb

"+" TOP of  
Curb

N.W. COR.  
CONC. FDN.  
METAL BIDS



# ODOT. DISTRICT 2 SURVEY OFFICE

SHEET

OF

County WOOD <sup>U.S.</sup> ~~S.R.~~ 25

Date 7-6-71

Township LIBERTY


Weather CLEAR

Section 12

Temp. 83°

T4N, R10E

Personnel BURNSIDE


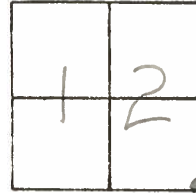


#11 - #12

S.E. COR. SEC. 12  
LIBERTY TWP.


BRASS MON.  
STA. 535+91.8

GREENSBURG PIKE

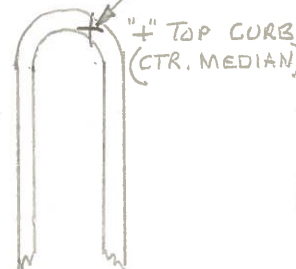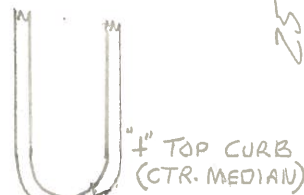

S.W. COR SEC. 7  
PORTAGE TWP  
SAN. CO.

BRASS MON.  
STA. 533+62.85

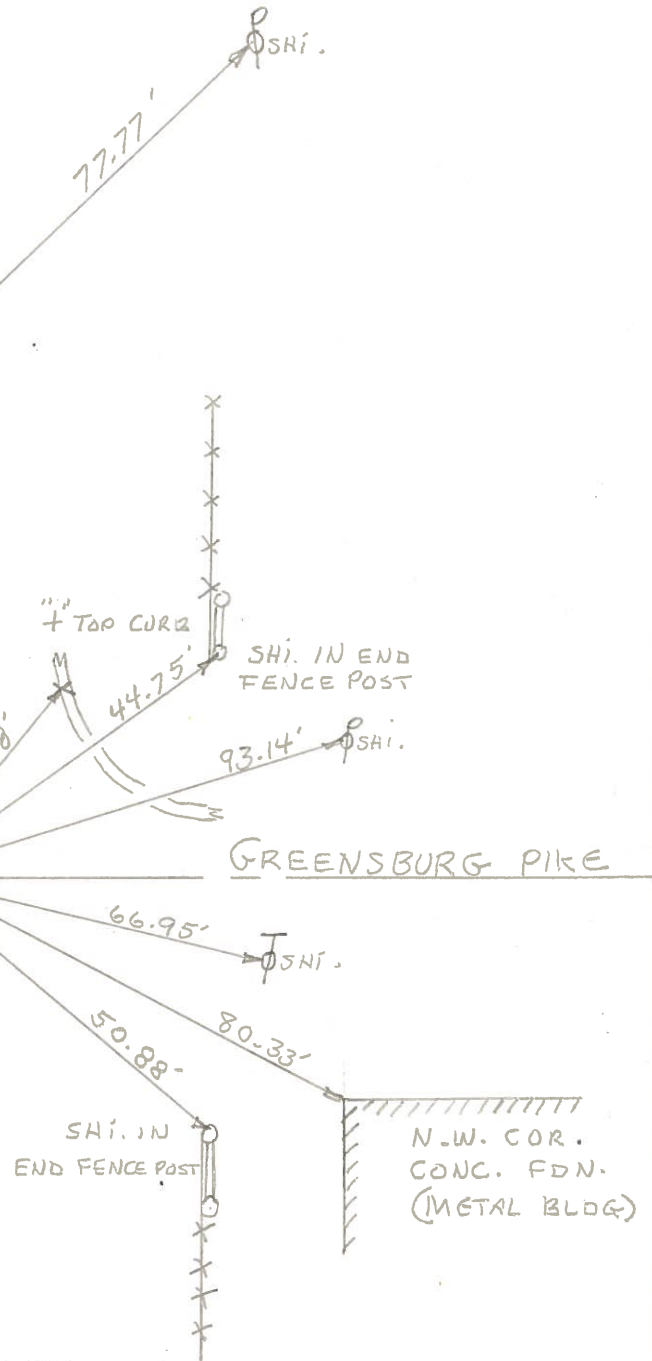

PERSONNEL

TITLE

PERSONNEL

TITLE

COUNTY

Wood

DATE

4-5-60

S.R.

14.5. #25

WEATHER

SEC.

TEMP.

DESCRIPTION

LEFT

CENTER LINE

RIGHT

JOB NO.

Sta. 507+07.0

W. 1/4 post sec. 18 Portage  
Twp.Brass plate - Could not raise  
Mabara Mon.

⑩

⑨

#237

Shiner in Anchor Post N.N.E. 47.0

Shiner in T.P. W.N.W. 29.00

Shiner in P.P. N.N.E. 85.38

~~Shiner in 8" oak S.E. 95.78~~

W. edge post. 7.85 E. edge 12.15

Shiner in End Post N.N.E. 41.07

Shiner in End Post N.E. 30.63

Shiner in Anchor Post E. 29.71

Sta. 509+31.4

E. 1/4 post sec. 13 Liberty  
Twp.Brass plate with top - (Could not  
plate gone) (Raise)

⑩

#238

Shiner in T.P. N.W. 58.28

Shiner in T.P. S.S.W. 89.15

Shiner in P.P. N.E. 53.30 59.34

Iron cor. post S.W. 35.45

W. edge post. 8.55' E. edge 11.35'

Shiner Brace Post N.N.E. 45.75

Shiner Brace Post N.E. 39.43

"X" E. Edge S. Bound lane (west) 44.10'

"X" E. Edge S. Bound lane (N. west) 54.37'

Sta. 533+62.85

S.W. cor. sec. 7 Portage

Twp. Greensburg Pike East.  
Brass plate in lot post.

⑩

#239

Shiner in T.P. E.S.E. 66.74

Shiner in P.P. S.S.E. 94.22

Shiner in T.P. W. 38.16

Shiner in End Post N.N.E. 44.74

Shiner in P. Pole N.E. 93.10

Shiner in End Post E.S.E. 50.93

Shiner in T. Pole S.E. 66.94

Sta. 535+91.8

S.E. cor. sec. 12 Liberty

Twp. Greensburg Pike West.  
Brass plate in E post.

⑩

#240

Shiner in P.P. N.N.E. 94.60

Shiner in T.P. N.W. 45.00

Shiner in T.P. W.N.W. 67.13

conc. E/W mon. S.W. 57.29

"X" in conc. curb N.W. 38.3

"X" in cons. curb S.W. 34.14