

O.D.O.T. DISTRICT 2 SURVEY OFFICE (USE ONLY)

PERSONNEL

REFERENCE NO. 12

SHEET OF

NOTES ASTON

DATE 11/20/23

ROUTE SR 25

H.C. NIESE

WEATHER WINDY

COUNTY WOOD

R.C. ASTON

TEMP. 37°

TOWNSHIP PORTAGE

DWG BY BARRIERE

PID 92133

SECTION 18

T 4 N R 11 E

TYPE MONUMENT MONBOX W/ 1" IPIN

ON SURFACE - BELOW ON

OFFSET $\oslash$ PAVEMENT 3' RT LT : RT


 TO EDGE PAVEMENT

STATION: 266+02.54

HORIZ.DATUM: NAD83(11)/WOOD LDP GEOID: 18

GRID: NORTHING: 601569.521 EASTING: 1652488.428

LDP: NORTHING: 423412.950 EASTING: 163940.858

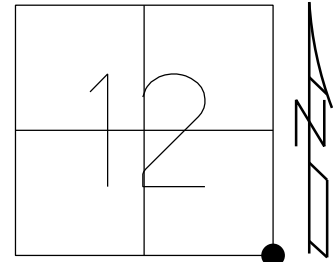

RECORD:

STA. 535+91.8
FD BRASS PLUG
FD P.K./WASHER
4/16/01, TMR
SET P.K./WASHER
10-31-01, SAH
SET MAG/WASHER
REF12
5-30-18
10-1-18, JFO
10-1-18, JFO
FD BRASS DISK
FD MAG NAIL
3/17/22, JFO
FD NEW MONBOX
W/ 1" IPIN
CHECKED WITH GPS
DID NOT PULL TIES
NEWREF12
11/20/23, TDN

$\oslash$ GREENSBURG PIKE

M

$\oslash$ GREENSBURG PIKE

O.D.O.T. DISTRICT 2 SURVEY OFFICE (USE ONLY)

PERSONNEL

REFERENCE NO. 12

SHEET 23 OF 36

NOTES RHOADES
H.C. O'DONNELL
R.C. TRENKA

DATE 5/30/18
WEATHER CLOUDY
TEMP. 84°

ROUTE SR 25
COUNTY WOOD
TOWNSHIP LIBERTY
SECTION 12

DWG BY MILLER PID NO PID

T 4 N R 10 E

TYPE MONUMENT MAG/WASHER

ON SURFACE - ~~BELOW~~ ON

OFFSET Q PAVEMENT 1.6' LT : RT

10.0' TO LT EDGE PAVEMENT


STATION: 293+49

HORZ.DATUM: NAD83(2011)

GEOID: NAVD88 2012A


GRID: NORTHING: 601569.459

EASTING: 1652488.338

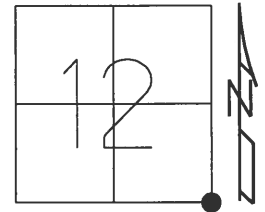

RECORD:
STA. 535+91.8
FD BRASS PLUG
FD P.K./WASHER
4/16/01, TMR
SET P.K./WASHER
10-31-01, SAH
SET MAG/WASHER
REF12
5-30-18
10-1-18, JFO

Q GREENSBURG PIKE

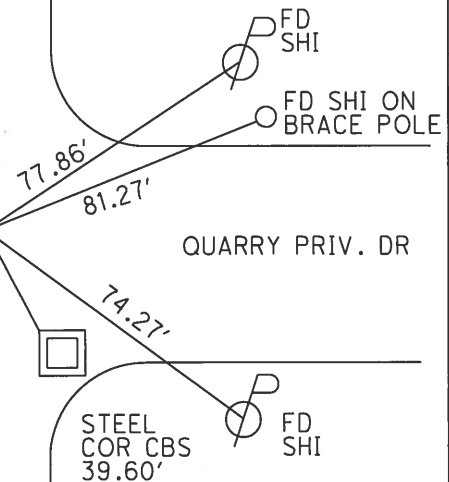

O.D.O.T. DISTRICT 2 SURVEY OFFICE

PERSONNEL

REFERENCE NO. 11 E 12

SHEET 13 OF 23

NOTES

Huss

H.C.

Rousos

R.C.

Van Dusen

DATE

4-16-01

WEATHER

Cldy-Rain

TEMP.

+42 °F

ROUTE

SR 25

COUNTY

Wood

TOWNSHIP

Liberty

SECTION

12

T4 N R10 E


TYPE MONUMENT A-PK W/ASHER / B-PK W/ASHER

ON SURFACE - ~~BELOW~~ BOTH

~~LEFT - & PAVT.~~ - RIGHT A-1.4 RT / B 1.6 RT

10.0 TO RT EDGE PAVEMENT

S.L.M. A 291+20 / B 293+49

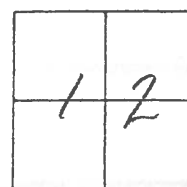

7-PORTAGE TWP

SET PK/WASHER
BOTH PTS.
10-31-01
SAH

± Pmt. GREENSBURG PIKE

RECORD:

PTA- BRASS PLUG
Sta 533+62.85
PTB- BRASS PLUG
Sta 535+91.8

Fd " cut
TUC

32.03
(Rec)

43.97

68.77

67.00

74.23

80.33
(Rec)

SET N/S/1
IN W/S BRACE POLE

N.W. CORNER
CONC. FOUNDATION
METAL BLDG.

FND. N/S/1
SLIP STUB POLE

USED N/W CORNER OF
Steel on CB

Set N/S/1 IN
BRACE Post

FND. N/S/1
W/S

QUARRY
Priv. Dr.

BRACE Pole
SET S/L. N/S

FND. N/S/1
S/L

77.86

81.27

74.72

39.60

229.10
Rec.

SR 252

± Rmt 58L

SR 252

± Rmt 184

O.D.O.T. DISTRICT 2 SURVEY OFFICE

PERSONNEL

REFERENCE NO. 11 & 12

SHEET 13 OF 23

NOTES HOFFMAN

H.C. LOEHKE

R.C. BARNHISEL

DATE 3-26-91

WEATHER OVERCAST

TEMP. 55°

ROUTE SR 25

COUNTY WOOD

TOWNSHIP LIBERTY

SECTION 12

T4 N R 10 E

"A"

"B"




TYPE MONUMENT P.K./WASHER - P.K./WASHER

ON SURFACE - BELOW YES - YES

LEFT - C PAV'T. - RIGHT 1.4 - 1.6

10.0 TO RT EDGE PAVEMENT

S.L.M. A = 291 + 20 ; B = 293 + 49

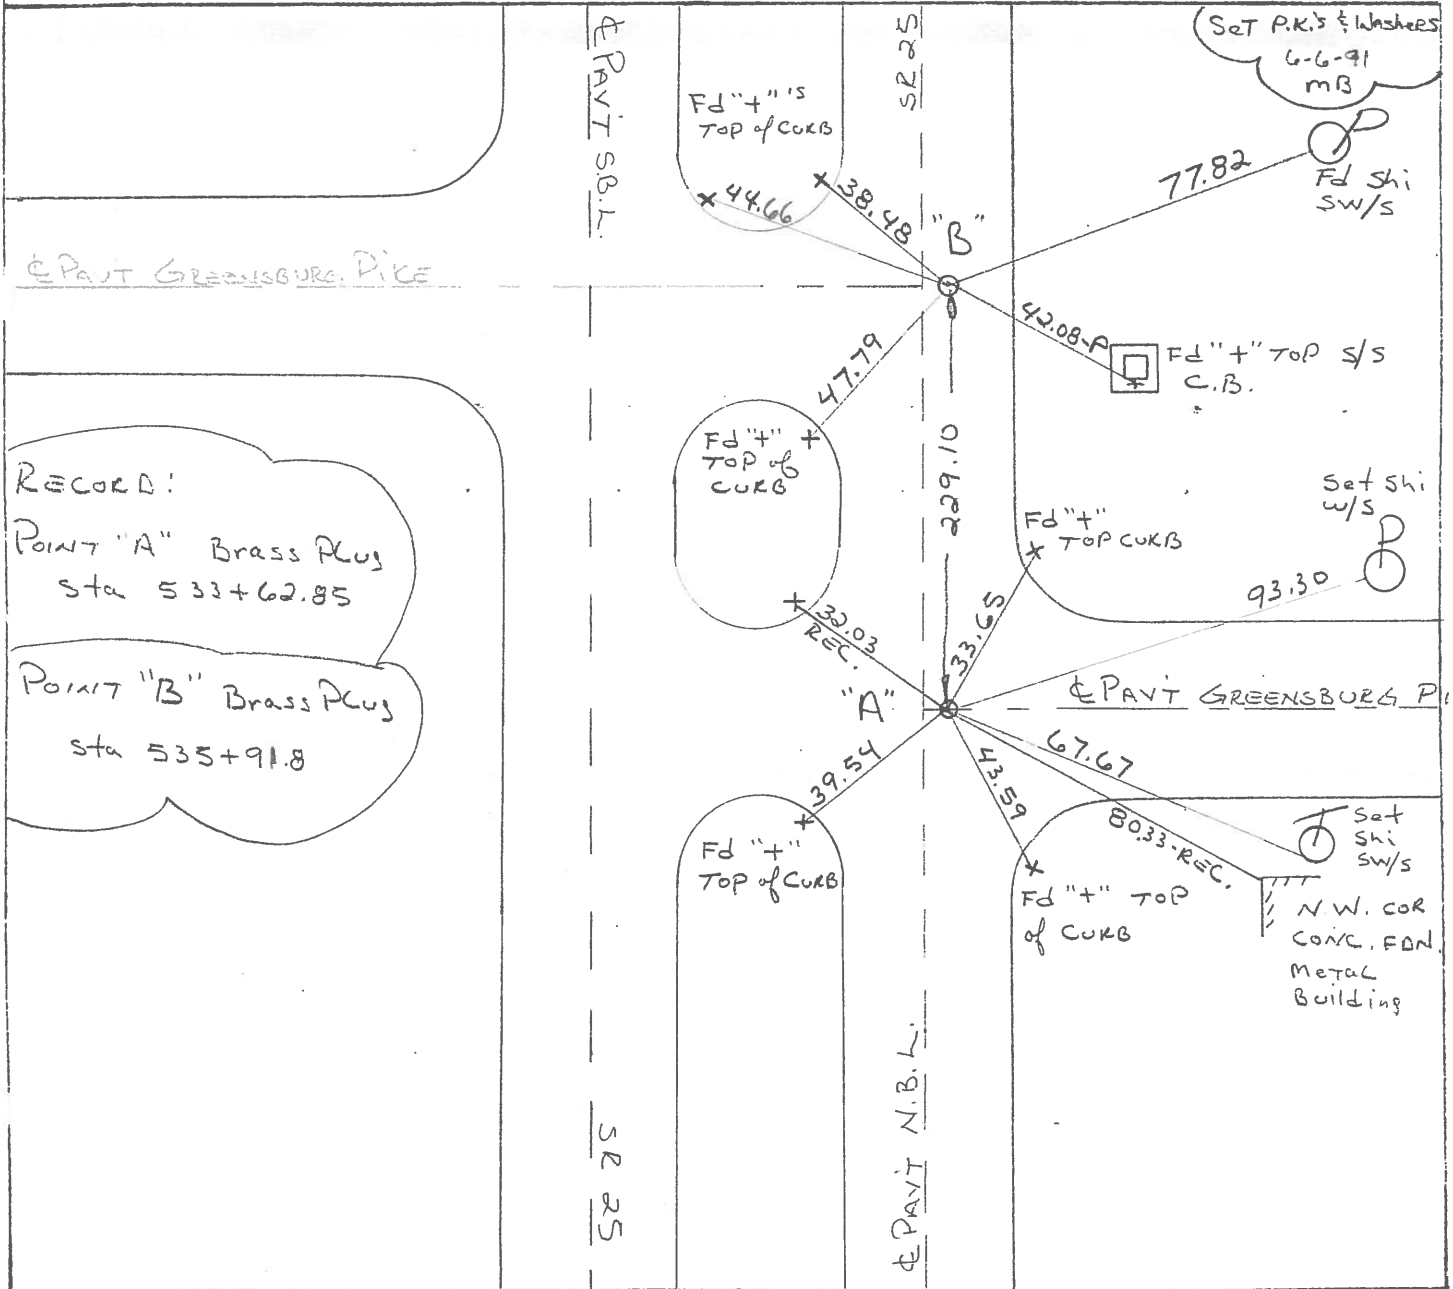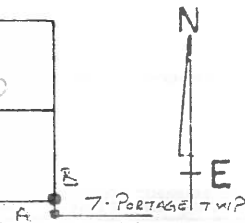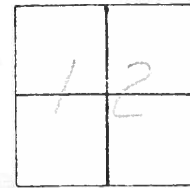


RECORD:

Point "A" Brass Plug
Sta 533+62.85

Point "B" Brass Plug
Sta 535+91.8

County WOOD S.R. -U.S.25Date 6-10-81Township LibertyWeather clearSection 12Temp. +75°

T4N, R10E

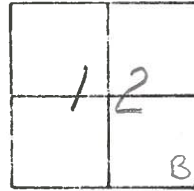
Personnel HoffmanHouse holder# 11 - # 12

Pt. "A" Fd. Brass Plug @ Surface, 1.6' E. of & PAUT, N.B.L. A
 STA 533+62.85-REC. 13.6' TO W. Edge PAUT

Pt. "B" Fd. Brass Plug @ Surface, 1.8' E. of & PAUT, N.B.L.
 STA 535+91.8-REC 10.3' TO E. Edge PAUT.

Greensburg Pike - West

S.L.M. 294+24

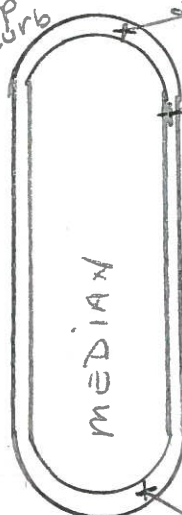"x" 's TOP
Curb

MEDIAN

U.S. 25

PAUT

N.B. LANES

Greensburg Pike - East

S.L.M. 291+95

"x" TOP
of
Curb

MEDIAN

U.S. 25

PAUT

N.B. LANES

Greensburg Pike - East

S.L.M. 291+95

"x" TOP
of
Curb

MEDIAN

U.S. 25

PAUT

N.B. LANES

Greensburg Pike - East

S.L.M. 291+95

"x" TOP
of
Curb

MEDIAN

U.S. 25

PAUT

N.B. LANES

Greensburg Pike - East

S.L.M. 291+95

"x" TOP
of
Curb

MEDIAN

U.S. 25

PAUT

N.B. LANES

Greensburg Pike - East

S.L.M. 291+95

"x" TOP
of
Curb

O.D.O.T. DISTRICT 2 SURVEY OFFICE

SHEET

OF

County WOOD ^{U.S.} S.R. 25

Township LIBERTY

Section 12

T4N, R10E

Personnel BURNSIDE


SMITH

BOWERS

Date 7-6-71

Weather CLEAR

Temp. 83°

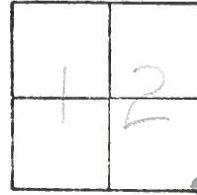

#11 - #12

S.E. COR. SEC. 12
LIBERTY TWP.
BRASS MON.
STA. 535+92.8

GREENSBURG PIKE



GREENSBURG PIKE

S.W. COR. SEC. 7
PORTAGE TWP.
SRN. CO.
BRASS MON.
STA. 533+62.25



N.W. COR.
CONC. FDN.
(METAL BLDG)

U.S.

PERSONNEL

TITLE

PERSONNEL

TITLE

COUNTY

Wood

DATE

4-5-60

S.R.

U.S. #25

WEATHER

SEC.

TEMP.

DESCRIPTION

LEFT

CENTER LINE

RIGHT

JOB NO.

Sta. 507+07.0

W. 1/4 post sec. 18 Portage
Twp.Brass plate - Could not raise
Mabara Mon.

⑩

⑨

#237

Shiner in Anchor Post N.N.E. 47.0'

Shiner in T.P. W.N.W. 29.00

Shiner in P.P. N.N.E. 85.38

~~Shiner in 8" oak S.E. 95.76~~

W. edge post. 7.85 E. edge 12.15

Shiner in End Post N.N.E. 41.07

Shiner in End Post N.E. 30.63

Shiner in Anchor Post E. 29.71

Sta. 509+31.4

E. 1/4 post sec. 13 Liberty
Twp.Brass plate with top - (Could not
plate gone (raise)

⑩

#238

Shiner in T.P. N.W. 58.28

Shiner in T.P. S.S.W. 89.15

Shiner in P.P. N.E. 53.30 59.34

Iron cor. post S.W. 35.45

W. edge post. 8.55' E. edge 11.35'

Shiner Brace Post N.N.E. 45.75

Shiner Brace Post N.E. 39.43

"X" E. Edge S. Bound lane (west) 44.10'

"X" E. Edge S. Bound lane (N. west) 54.37'

Sta. 533+62.85

S.W. cor. sec. 7 Portage

Twp. Greensburg Pike East.

Brass plate in lot post.

⑩

#239

Shiner in T.P. E.S.E. 66.74

Shiner in P.P. S.S.E. 94.22

Shiner in T.P. W. 38.16

Shiner in End Post N.N.E. 44.74

Shiner in P. Pole N.E. 93.10

Shiner in End Post E.S.E. 50.93

Shiner in T. Pole S.E. 66.94

Sta. 535+91.8

S.E. cor. sec. 12 Liberty

Twp. Greensburg Pike West.

Brass plate in E post.

⑩

#240

Shiner in P.P. N.N.E. 94.60

Shiner in T.P. N.W. 45.00

Shiner in T.P. W.N.W. 67.13

conc. E/W mon. S.W. 57.29

"X" in conc. curb N.W. 38.3

"X" in conc. curb S.W. 34.14