

# O.D.O.T. DISTRICT 2 SURVEY OFFICE (USE ONLY)

PERSONNEL

REFERENCE NO. 12A/13

SHEET \_\_\_\_ OF \_\_\_\_

NOTES NIESE

DATE 11/20/23

ROUTE SR 25

H.C. NIESE

WEATHER CLEAR

COUNTY WOOD

R.C. AUBLE

TEMP. 37°

TOWNSHIP PORTAGE

DWG BY BARRIERE

PID 92133

SECTION 7

T 4 N R 11 E

TYPE MONUMENT MONBOX W/ 1" IPIN

ON SURFACE - BELOW ON

OFFSET Q PAVEMENT 28.5' RT LT : RT


TO EDGE PAVEMENT

STATION: 290+16.33

HORIZ.DATUM: NAD83(11)/WOOD LDP GEOID: 18


GRID: NORTHING: 603983.008 EASTING: 1652514.331

LDP: NORTHING: 425826.753 EASTING: 163934.935

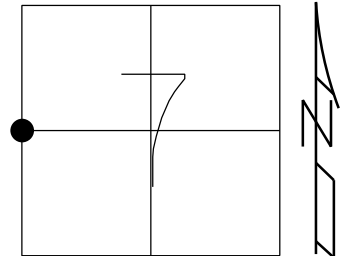

RECORD:  
STA. 571+29.6  
FD BRASS MON  
FD P.K./WASHER  
4/16/01, TMR  
SET P.K./WASHER  
10-31-01, SAH  
FD P.K. SHANK/WASHER  
REF13  
5-30-18  
10-1-18, JFO  
FD P.K. NAIL  
FD MAG NAIL  
REFA12  
FD MAG NAIL  
REF13  
3/18/22, JFO  
FD NEW MONBOX  
W/ 1" IPIN  
NEWREF13  
11/20/23, TDN

RECORD:  
SET MAGNAIL  
UNKNOWN ORIGIN  
REFA12  
11/20/23, TDN

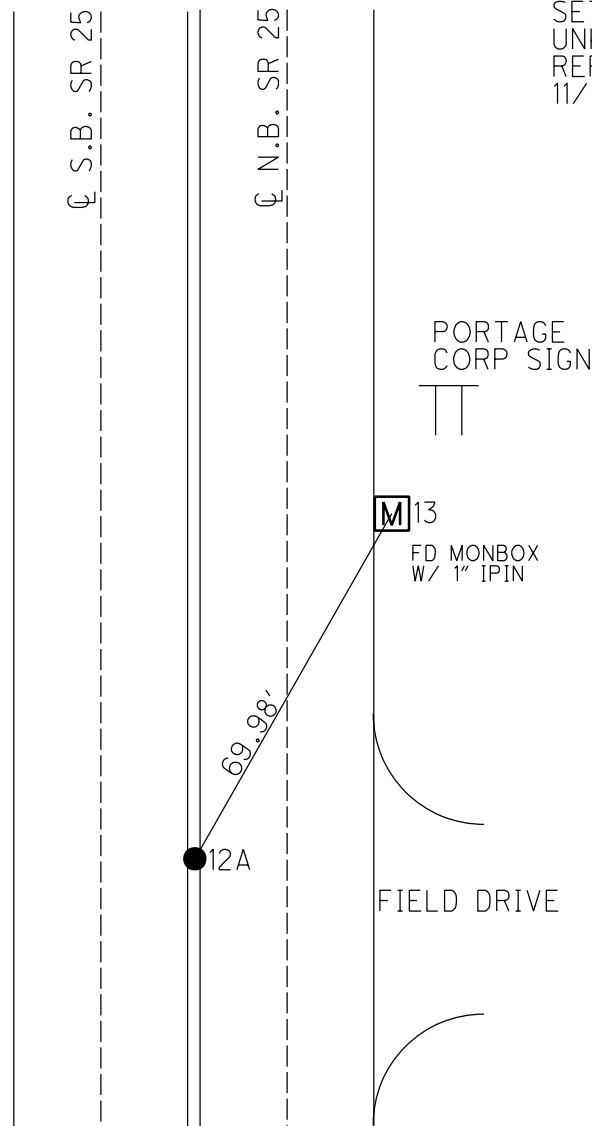

**\*\*NOTE\*\***  
POINT WAS ADJUSTED PER  
WOO-25-0.75, PID 92133 PLANS.  
SEE PLANS FOR PRIOR COORDINATES  
AND INFORMATION.  
**\*\*       \*\***

O.D.O.T. DISTRICT 2 SURVEY OFFICE (USE ONLY)

PERSONNEL

REFERENCE NO. 13

SHEET 24 OF 36

NOTES HUSS  
H.C. ROUSOS  
R.C. VAN DUSEN

DATE 4/16/01  
WEATHER CLOUDY/WINDY  
TEMP. 41°

ROUTE SR 25  
COUNTY WOOD  
TOWNSHIP LIBERTY  
SECTION 12

DWG BY MILLER

PID NO PID

T 4 N R 10 E

TYPE MONUMENT P.K./WASHER

ON SURFACE - ~~BELOW~~ ON

OFFSET Q PAVEMENT 0.5' ~~LT:RT~~

11.2' TO LT EDGE PAVEMENT


STATION: 317+63

HORIZ.DATUM: NAD83(2011)

GEOID: NAVD88 2012A

GRID: NORTHING: 603982.897

EASTING: 1652514.017

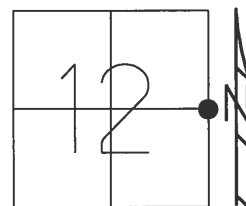

RECORD:  
STA. 571+29.6  
FD BRASS MON  
FD P.K./WASHER  
4/16/01, TMR  
SET P.K./WASHER  
10-31-01, SAH  
FD P.K. SHANK/WASHER  
REF13  
5-30-18  
10-1-18, JFO

Q S.B. SR 25

Q N.B. SR 25

EAST PORTAGE CORP

# O.D.O.T. DISTRICT 2 SURVEY OFFICE

PERSONNEL

REFERENCE NO. 13 & 14

SHEET 14 OF 23

NOTES

H.C.

R.C.

Hugo

Rouso

Van Dusen

DATE

4-16-61

WEATHER

Clay Rain

TEMP.

41°F

ROUTE

SR 25

COUNTY

WOOD

TOWNSHIP

LIBERTY

SECTION

12

T 4 N R 10 E


TYPE MONUMENT A-PK/WASHER - B-PK/WASHER

ON SURFACE - BELOW YES - YES

LEFT - Q PAV'T. - RIGHT 0.54 - 0.54

11.2 TO LT EDGE PAVEMENT

S.L.M. A=217+63 ; B=320+02

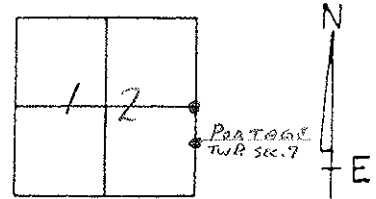


WEST PORTAGE CORP

RECORD:

PTB- BRASS MON.

PTA- BRASS MON

Sta 571+29.6

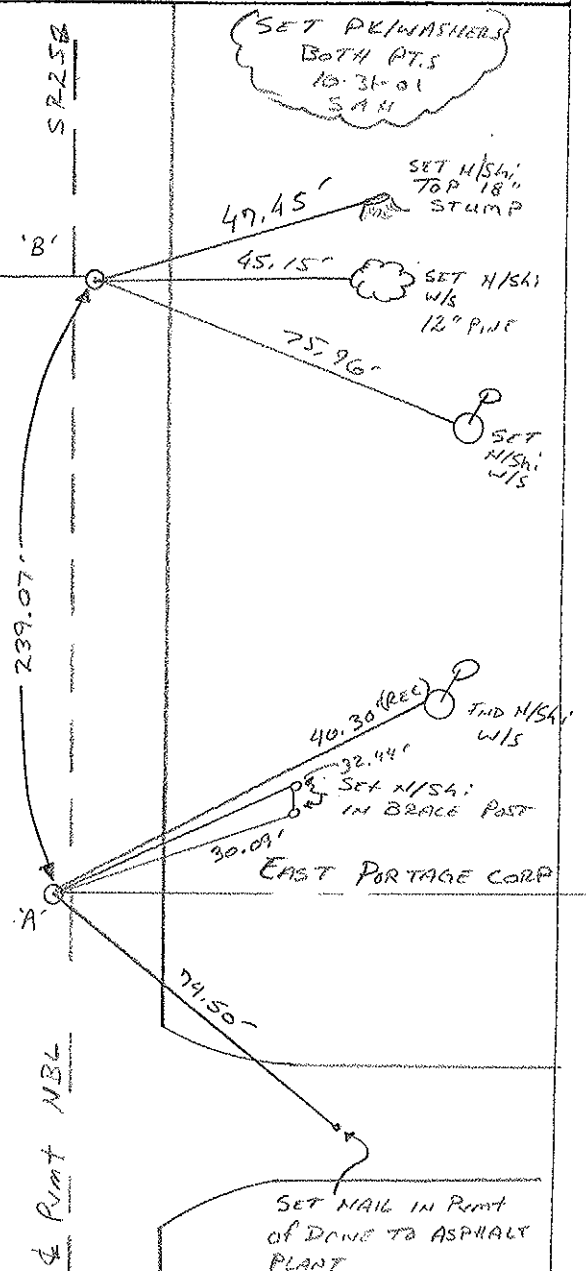

# O.D.O.T. DISTRICT 2 SURVEY OFFICE

PERSONNEL

REFERENCE NO. 13 & 14

SHEET 14 OF 23

NOTES HOFFMAN

H.C. LOHRKE

R.C. BARNHISEL

DATE 3-26-91

WEATHER OVERCAST

TEMP. 55°

ROUTE SR 25

COUNTY WOOD

TOWNSHIP LIBERTY

SECTION 12

T4 N R 10 E

"A"

"B"


TYPE MONUMENT P.K./WASHER - SMALL R.P. SPK.

ON SURFACE - BELOW YES - YES

LEFT - C PAV'T. - RIGHT 0.5' LT. - 0.5' RT.

11.2 TO LT. EDGE PAVEMENT

S.L.M. "A" = 317+63 ; B = 320+02

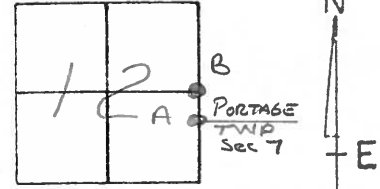

Set P.K.'s & Washers  
6-6-91  
MB

RECORD: POINT "B"  
BRASS MONUMENT

WEST-PORTAGE CORP.

Set Shi  
SE/S

RECORD: POINT "A"  
BRASS MONUMENT  
STA. 571+29.6

PAV'T S.B.L.

SR 25

"B"

239.07

"A"

PAV'T N.B.L.

SR 25

92.40

EAST-PORTAGE CORP.

56.92

Set Nail Point  
of DRIVE TO  
ASPHALT  
PLANT

Set Shi SW/S

14"

74.86

47.48

Set Shi  
W/S  
10"

70.59


Fd Shi W/S

40.30

Fd Shi  
SW/S


County WOOD S.R.-U.S. 25Township LibertySection 12

T4N, R10E

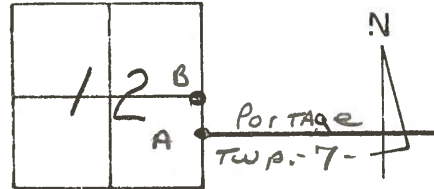Personnel HoffmanHouseholderDate 6-10-81Weather clearTemp. +75°

Pts. "A" & "B" Fd. small R.R. spks @ surface, ctr. of PAUT, N.B. LANES

#13 - #14

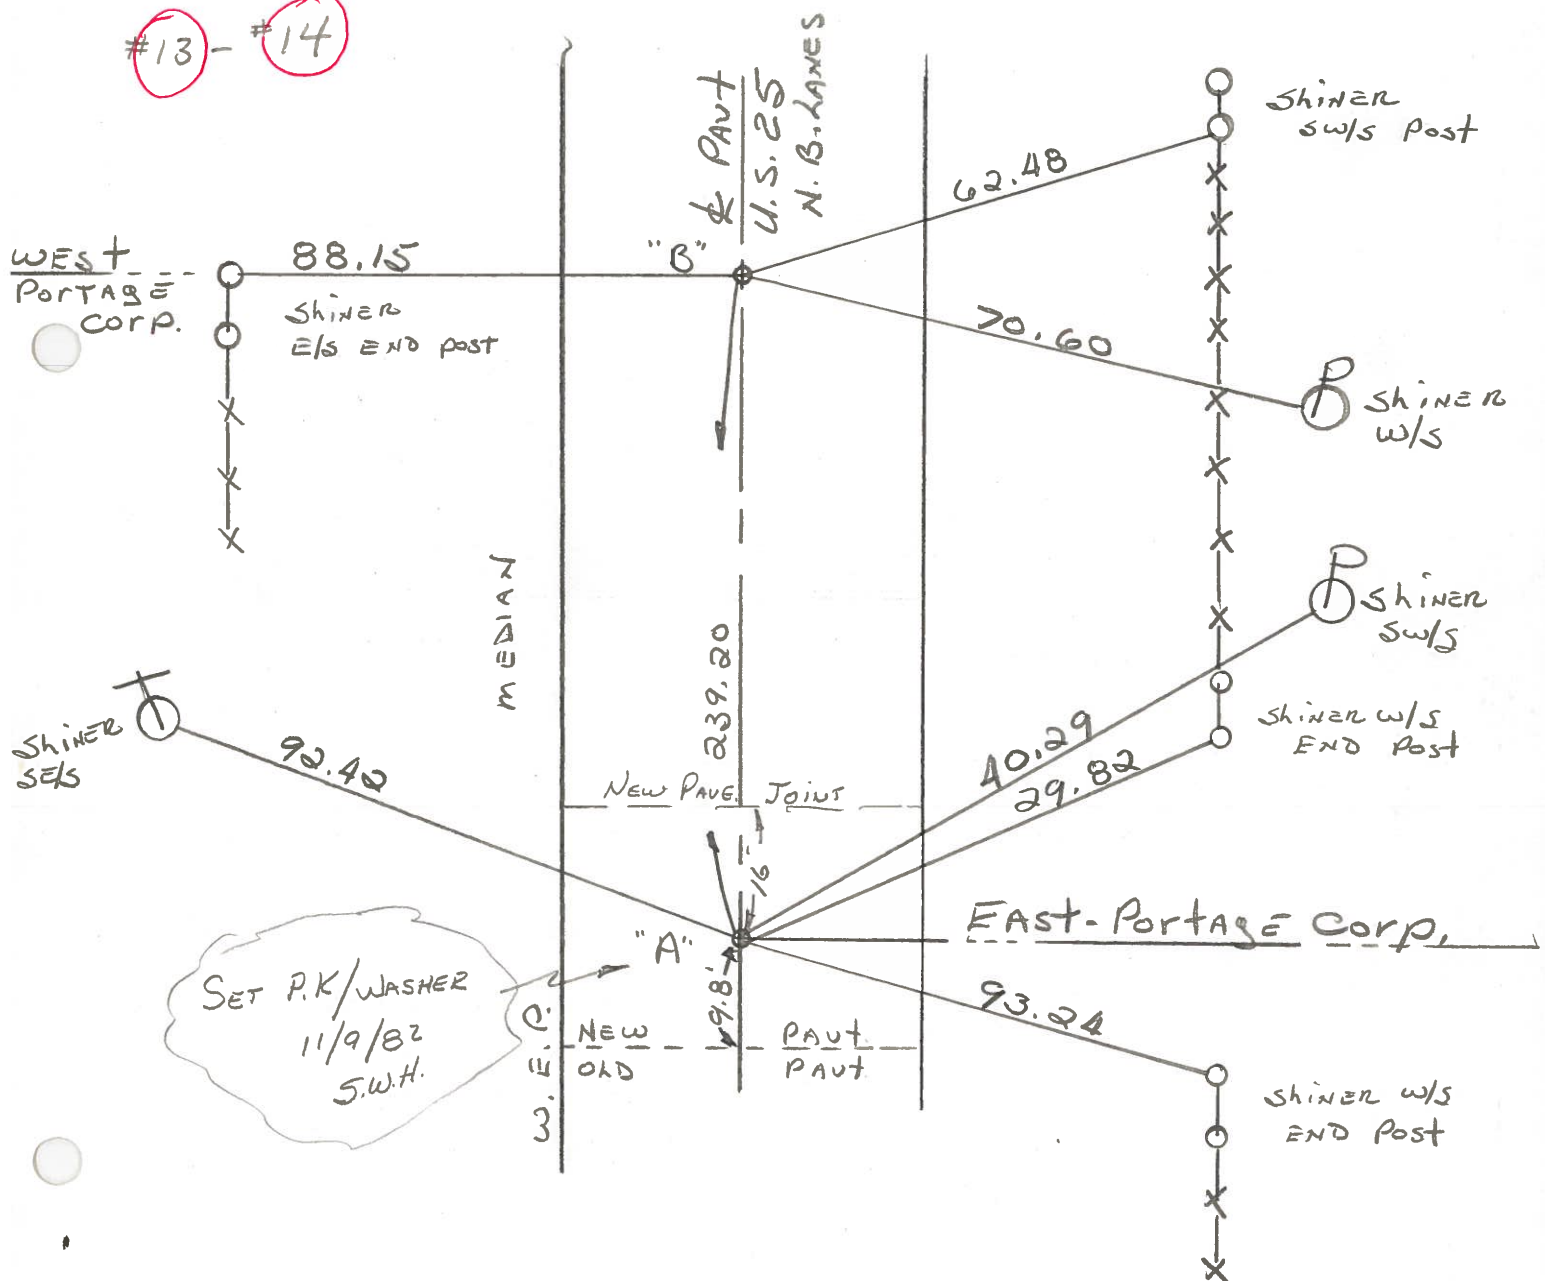

# O.D.O.T. DISTRICT 2 SURVEY OFFICE

SHEET \_\_\_\_\_ OF \_\_\_\_\_

County WOOD <sup>U.S.</sup> ~~S.R.~~ 25

Township LIBERTY

Section 12

T4N, R10E

Personnel BURNSIDE

SMITH


BOWERS

HOLCOMBE

Date 5-21-71

Weather CLEAR

Temp. 72°

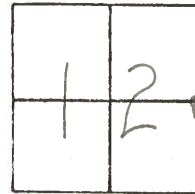

#13 - #14

BRASS MON.  
P.K. NAIL

PORTAGE CORP. WEST

SHI. IN  
FENCE POST

88.18'

62.50'

70.60'

239.20' mea.

SHI.

92.50'

40.29'

29.82'

SHI. END  
FENCE POST

BRASS MON.  
S.L.M. 571 + 29.6

PORTAGE CORP. EAST

93.24'

SHI. END  
FENCE POST

PERSONNEL TITLE PERSONNEL TITLE

COUNTY

Wood

DATE

4-7-60

S. R.

U.S. #25

WEATHER

SEC.

TEMP.

DESCRIPTION

LEFT

CENTER LINE

RIGHT

JOB NO.

Sta. 560 + 05.10

Portage Corp. Line East  
Brass plate

(13)

#241

Shiner in End Post E.N.E. 29.76'

Shiner in P.P. E.N.E. 40.35 40.47'

Shiner in T.P. N.W. 39.92'

Shiner in 12' Evergreen W.N.W. 56.93'

Shiner in 30' Elm W. 64.10'

Wedge post. 11.63' E. edge 12.32'

Shiner 16" Maple S.E. 68.47'

Sta. 562 + 44.4

Portage Corp. West  
Brass plug, ~~top of bridge~~

(14)

#242

Shiner in Anchor Post N.E. 62.63

Shiner in T.P. N.W. 44.15'

Shiner in T.P. S.W. 91.00'

Shiner in P.P. S.E. 70.48 73.05'

Wedge post. 11.83 E. edge 12.12

Shiner in End Post N.N.E. 88.86'

Iron Fence Post East 29.03'

Sta. 588 + 94.96

S.E. cor. Sec. 1 Liberty Twp.  
N.E. cor. sec. 12 Liberty Twp.  
Iron rod on top of  
Stone, center of portage

(15)

#243

Shiner in P.P. W.S.W. <sup>69.69</sup> 69.72'

Shiner in P.P. S.E. 53.89 42.73'

Iron pin in brick sidewalk S.E. 43.35'

S.E. Cor. gas. Sta. N.W. 80.55'

Town Pump N.W. (1 above road) 68.55'

Shiner T. Pole N.W. 58.65'

Shiner T. Pole N.E. 58.48'

Note  
See sheets  
6A-6B  
New. W.T.

Sta. 612 + 96.65

W. 1/4 post sec. 6 Portage  
Twp.  
Brass plate

(17)

#244

~~Shiner in P.P. S.E. 47.96'~~~~Shiner in T.P. S.S.W. 69.78'~~~~Shiner in T.P. N.N.W. 69.94'~~

Shiner in T. Pole N.W. 77.20'

Shiner in T. Pole S.W. 81.98'

"X" cut in Curb East 08.25'

"X" cut in Curb N.E. 14.60'

"X" cut in Curb S.E. 16.90'