

O.D.O.T. DISTRICT 2 SURVEY OFFICE (USE ONLY)

PERSONNEL

REFERENCE NO. 14

SHEET OF

NOTES NIESE

DATE 11/20/23

ROUTE SR 25

H.C. NIESE

WEATHER CLEAR

COUNTY WOOD

R.C. ASTON

TEMP. 37°

TOWNSHIP PORTAGE

DWG BY BARRIERE

PID 92133

SECTION 12

T 4 N R 10 E

TYPE MONUMENT MONBOX W/ 1" IPIN

ON SURFACE - BELOW ON

OFFSET $\varnothing$ PAVEMENT 22.8' RT LT : RT


 TO EDGE PAVEMENT

STATION: 292+55.22

HORIZ.DATUM: NAD83(11)/WOOD LDP GEOID: 18

GRID: NORTHING: 604221.814 EASTING: 1652516.956

LDP: NORTHING: 426065.591 EASTING: 163934.411

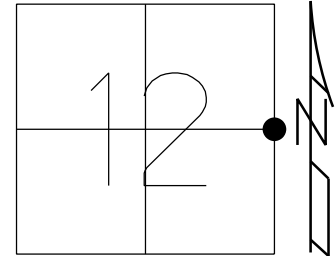

RECORD:
FD BRASS MON
FD P.K./WASHER
4/16/01, TMR
SET P.K./WASHER
10-31-01, SAH
FD P.K./WASHER
REF14
5-30-18
10-1-18, JFO
FD BRASS DISK
FD MAG NAIL
REF14
3/18/22, JFO
FD NEW MONBOX
W/ 1" IPIN
CHECKED W/ GPS
DID NOT PULL TIES
NEWREF14
11/20/23, TDN

PORTAGE
CORP SIGN



$\varnothing$ S.B. SR 25

$\varnothing$ N.B. SR 25



FD MONBOX
W/ 1" IPIN

O.D.O.T. DISTRICT 2 SURVEY OFFICE (USE ONLY)

PERSONNEL

REFERENCE NO. 14

SHEET 25 OF 36

NOTES HUSS
H.C. ROUSOS
R.C. VAN DUSEN

DATE 4/16/01
WEATHER CLOUDY/RAIN
TEMP. 41

ROUTE SR 25
COUNTY WOOD
TOWNSHIP LIBERTY
SECTION 12

DWG BY MILLER PID NO PID

T 4 N R 10 E

TYPE MONUMENT P.K./WASHER

ON SURFACE - ~~BELOW~~ ON

OFFSET Q PAVEMENT 0.5' LT : ~~RT~~

11.2' TO LT EDGE PAVEMENT


STATION: 320+02

HORIZ.DATUM: NAD83(2011)

GEOID: NAVD88 2012A

GRID: NORTHING: 604221.837

EASTING: 1652516.831

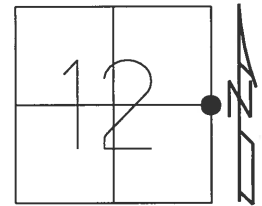

RECORD:
FD BRASS MON
FD P.K./WASHER
4/16/01, TMR
SET P.K./WASHER
10-31-01, SAH
FD P.K./WASHER
REF14
5-30-18
10-1-18, JFO

Q S.B. SR 25

Q N.B. SR 25

WEST PORTAGE CORP

75.96'
REC SET
SHI

O.D.O.T. DISTRICT 2 SURVEY OFFICE

PERSONNEL

REFERENCE NO. 13 & 14

SHEET 14 OF 23

NOTES

Hugo

H.C.

Rouso

R.C.

Van Dusen

DATE

4-16-61

WEATHER

Clay Rain

TEMP.

41°F

ROUTE

SR 25

COUNTY

WOOD

TOWNSHIP

LIBERTY

SECTION

12

T 4 N R 10 E


TYPE MONUMENT A-PK/WASHER - B-PK/WASHER

ON SURFACE - BELOW YES YES

LEFT - Q PAV'T. - RIGHT 0.54 - 0.54

11.2 TO LT EDGE PAVEMENT

S.L.M. A=217+63 ; B=320+02

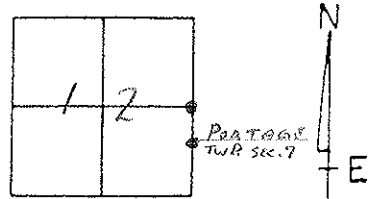


WEST PORTAGE CORP

RECORD:

PTB- BRASS MON.

PTA- BRASS MON

Sta 571+29.6

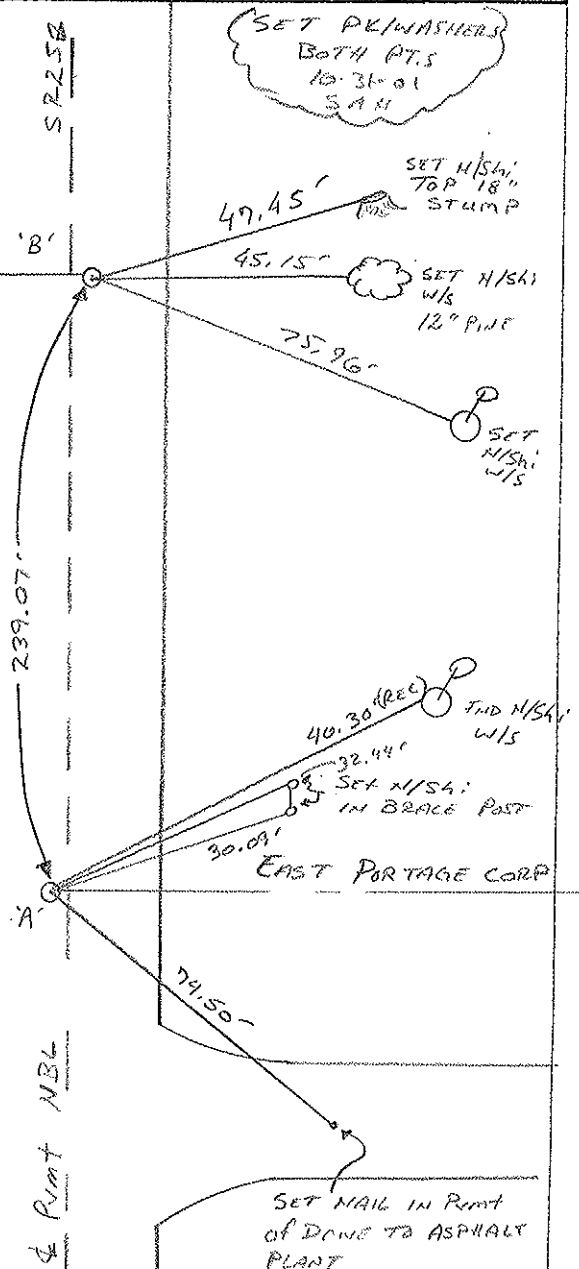

O.D.O.T. DISTRICT 2 SURVEY OFFICE

PERSONNEL

REFERENCE NO. 13^E 14

SHEET 14 OF 23

NOTES HOFFMAN

H.C. LOCHKE

R.C. BARNHISEL

DATE 3-26-91

WEATHER OVERCAST

TEMP. 55°

ROUTE SR 25

COUNTY WOOD

TOWNSHIP LIBERTY

SECTION 12

T 4 N R 10 E

"A"

"B"


TYPE MONUMENT P.K./WASHER - SMALL R.R. SPK.

ON SURFACE - BELOW YES - YES

LEFT - C PAV'T. - RIGHT 0.5' LT. - 0.5' RT.

11.2 TO LT EDGE PAVEMENT

S.L.M. "A" = 317+63 ; B = 320+02

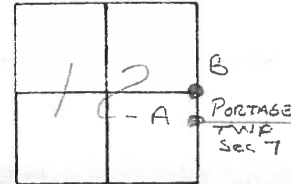

Set PK's & WASHERS
6-6-91
MB

RECORD: POINT "B"
BRASS MONUMENT

WEST-PORTAGE CORP.

Set Shi
SE/S

RECORD: POINT "A"
BRASS MONUMENT
STA. 571+29.6

PAV'T S.B.L.

SR 25

"B"

239.07

"A"

PAV'T N.B.L.

SR 25

Set Shi SW/S

14"

74.86

47.48

Set Shi
W/S
10"

70.59

Fd Shi W/S

40.30

Fd Shi
SW/S

EAST-PORTAGE CORP.

92.40

56.92

Set Nail Post
of DRIVE TO
ASPHALT
PLANT

O.D.O.T. DISTRICT 2 SURVEY OFFICE

SHEET

OF

County WOOD ^{U.S.} ~~S.R.~~ 25

Township LIBERTY

Section 12

T4N, R10E

Personnel BURNSIDE

SMITH


BOWERS

HOLCOMBE

Date 5-21-71

Weather CLEAR

Temp. 72°

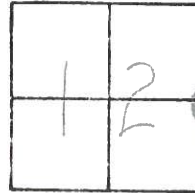


#13 - #14

BRASS MON.
P.K. DATE

PORTAGE CORR. WEST

SHI. IN
FENCE POST

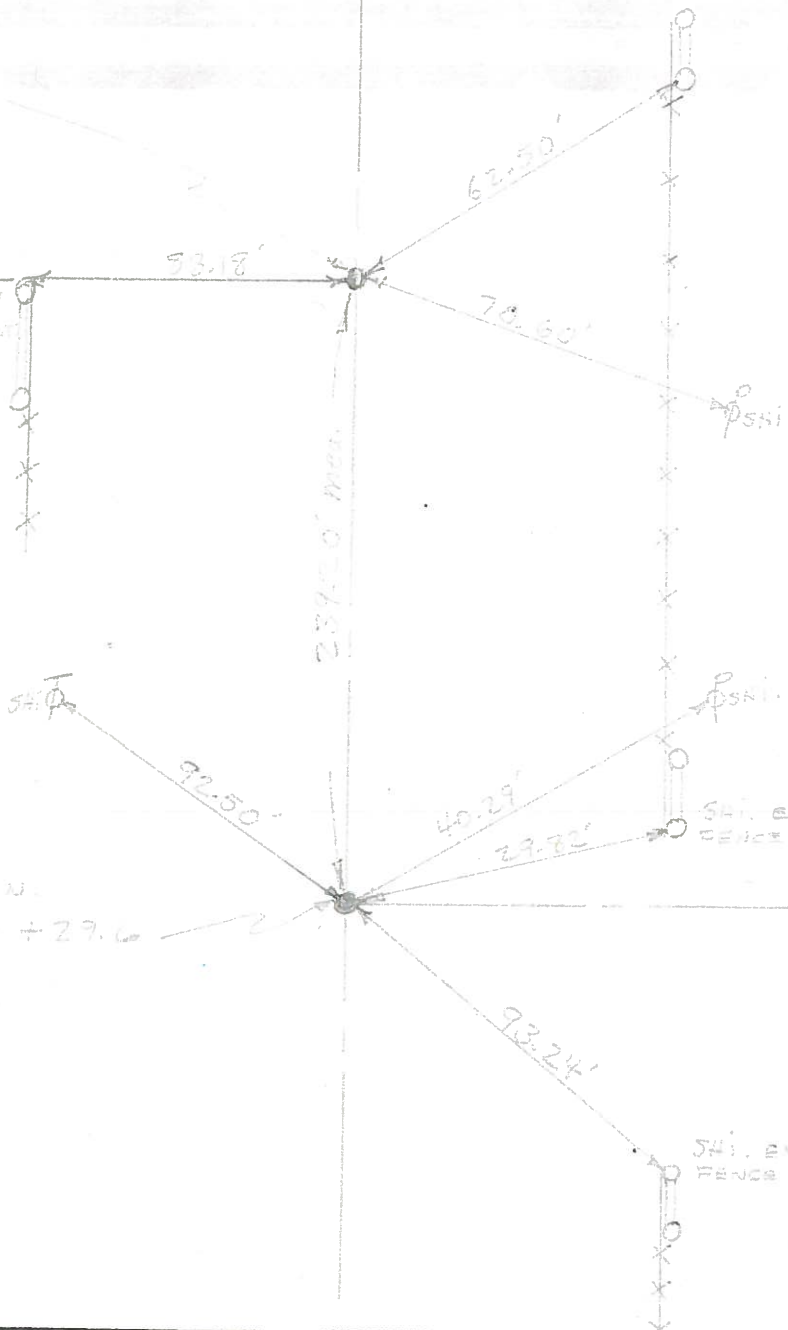

BRASS MON.

S.L.M. 571 + 29.6

PORTAGE CORR. EAST

SHI. END
FENCE POST

