

O.D.O.T. DISTRICT 2 SURVEY OFFICE (USE ONLY)

PERSONNEL

REFERENCE NO. 14A

SHEET OF

NOTES NIESE
H.C. NIESE
R.C. ASTON

DATE 11/20/23
WEATHER CLEAR
TEMP. 37°

ROUTE SR 25
COUNTY WOOD
TOWNSHIP LIBERTY
SECTION 12

DWG BY BARRIERE PID 92133

T 4 N R 10 E

TYPE MONUMENT MAG NAIL/WASHER

ON SURFACE - BELOW ON

OFFSET $\varnothing$ PAVEMENT 2.5' RT LT : RT


 TO EDGE PAVEMENT

STATION: 315+10.26


HORIZ.DATUM: NAD83(11)/WOOD LDP GEOID: 18

GRID: NORTHING: 606476.483 EASTING: 1652545.697

LDP: NORTHING: EASTING:

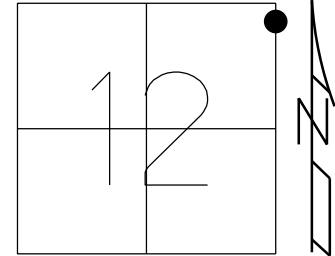

RECORD:
ORIGIN UNKOWN
FD RR SPIKE
5-18-78
FD P.K./WASHER
4/16/01, TMR
SET P.K./WASHER
10-31-01, SAH
SET MAG/WASHER
REFA14
5-30-18
10-1-18, JFO
FD MAG NAIL
FD MAG/WASHER
REFA14
3/18/22, JFO
FD MAG/WASHER
11/15/23, TDN

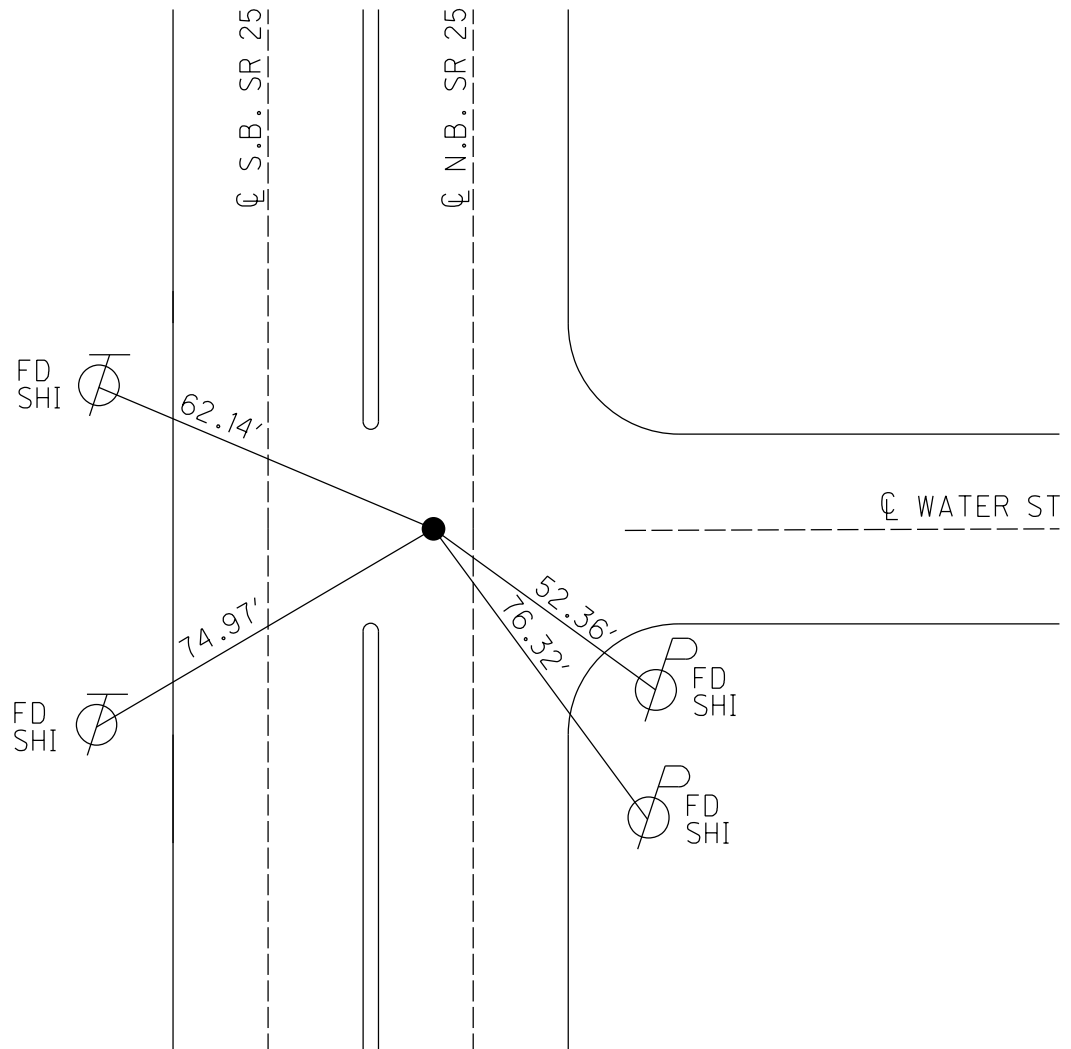

O.D.O.T. DISTRICT 2 SURVEY OFFICE (USE ONLY)

PERSONNEL

REFERENCE NO. 14 A

SHEET 26 OF 36

NOTES RHOADES
H.C. O'DONNELL
R.C. TRENKA

DATE 5/30/18
WEATHER CLOUDY
TEMP. 84°

ROUTE SR 25
COUNTY WOOD
TOWNSHIP LIBERTY
SECTION 12

DWG BY MILLER PID NO PID

T 4 N R 10 E

TYPE MONUMENT MAG/WASHER

ON SURFACE - ~~BELOW~~ ON

OFFSET Q PAVEMENT 2.5' ~~LT~~ : RT

28.5 TO LT EDGE PAVEMENT - FACE CURB


STATION: 342+56

HORZ.DATUM: NAD83(2011)


GEOID: NAVD88 2012A

GRID: NORTHING: 606476.483

EASTING: 1652545.697

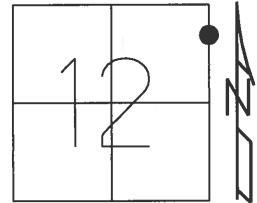

RECORD:
ORIGIN UNKNOWN
FD RR SPIKE
5-18-78
FD P.K./WASHER
4/16/01, TMR
SET P.K./WASHER
10-31-01, SAH
SET MAG/WASHER
REFA14
5-30-18
10-1-18, JFO

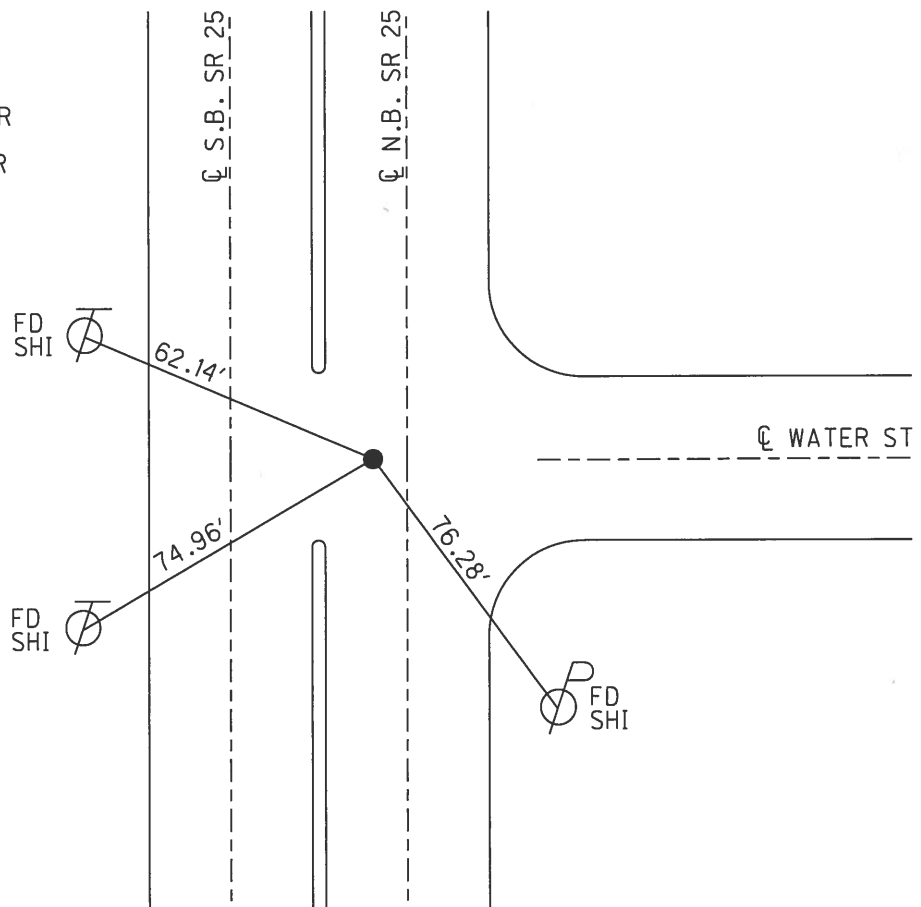

O.D.O.T. DISTRICT 2 SURVEY OFFICE

PERSONNEL

REFERENCE NO. 14A

SHEET 15 OF 23

NOTES Huss

H.C. Rousos

R.C. VanDusen

DATE 4-16-01

WEATHER Cldy. Rain

TEMP. +41°

ROUTE SR 25

COUNTY WOOD

TOWNSHIP LIBERTY

SECTION 12

T 4 N R 10 E


TYPE MONUMENT PK / WASHER

ON SURFACE - BELOW YES

LEFT 1 PAV'T. RIGHT 2.5

28.5 TO LT. EDGE PAVEMENT - FACE CURB


S.L.M. 342456

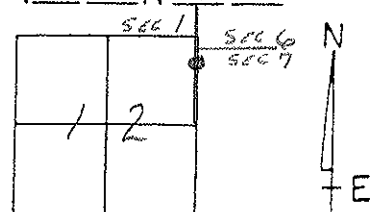

RECORD:-

5-18-78 FND RR SPK
ASSUMED SET BY
POGLMEYER
ORIGIN OF PT. UNKNOWN

SET DEWASHER
10-31-01
SAH

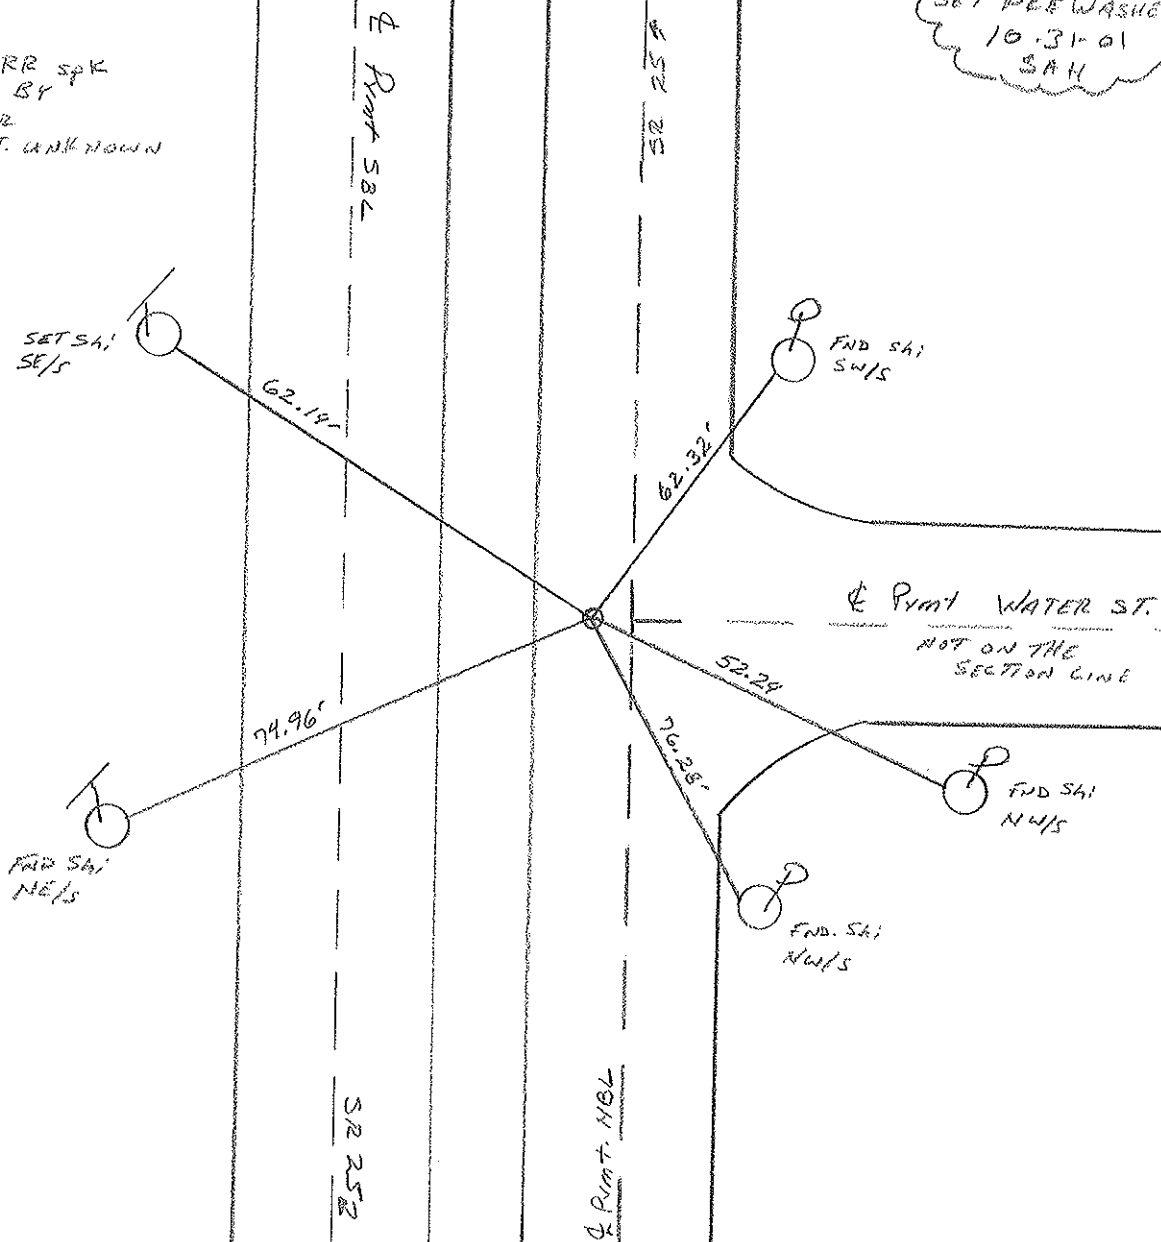

O.D.O.T. DISTRICT 2 SURVEY OFFICE

PERSONNEL

REFERENCE NO. _____

SHEET 15 OF 23

NOTES HOFFMAN

H.C. LOSHRKE

R.C. BARNHISEL

DATE 3-27-91

WEATHER P. CLEAR

TEMP. 50°

ROUTE SR 25

COUNTY WOOD

TOWNSHIP LIBERTY

SECTION 12

T 4 N R 10 E


TYPE MONUMENT P.K. - ORIGIN OF POINT UNKNOWN

ON SURFACE - BELOW YES

LEFT - C PAV'T. - RIGHT 2.5

28.5 TO LT EDGE PAVEMENT - FACE CURB

S.L.M. 342 + 56

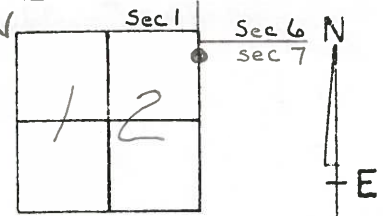


14-A

RECORD:

5-18-78 FD SPK.
ASSUMED SET BY
POGGEMEYER

SET P.K. & WASHOE
6-6-91
m3

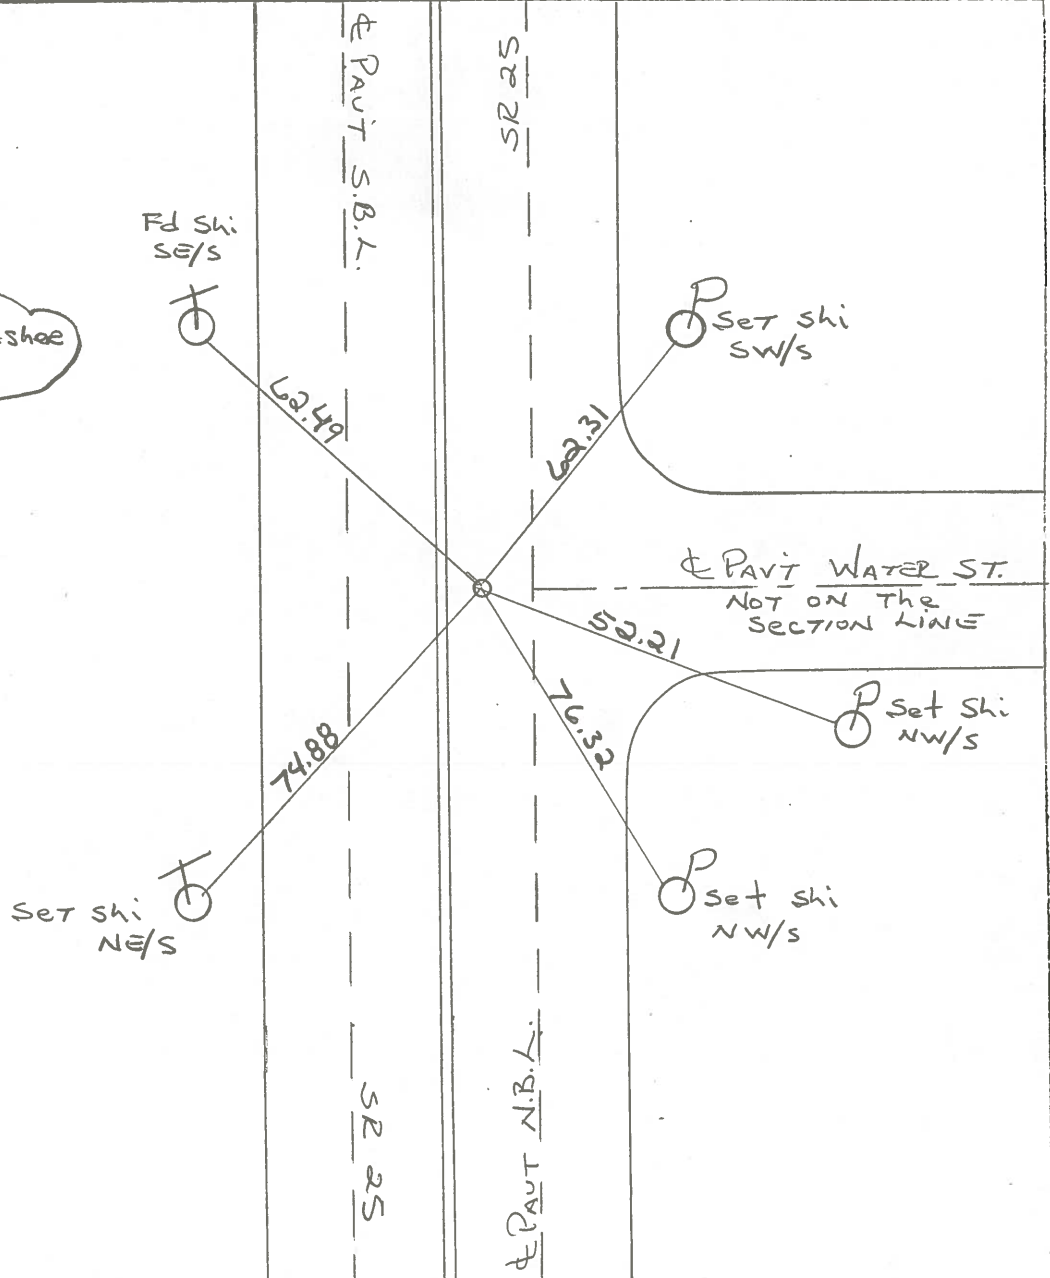

O.D.O.T. DISTRICT 2 SURVEY OFFICE

Sht. of

County Wood

Date 5-18-78

Township LIBERTY


Weather Cloudy

Section 12
PORTAGE, OHIO

Temp. +55°

T4N, R10E

Personnel BURNSIDE

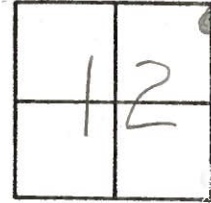

14-A

SMITH

BOWERS

MEAD

FD. SPK.

ASSUMED SET
BY ROGGE MEYER
B.G.O.

