

O.D.O.T. DISTRICT 2 SURVEY OFFICE (USE ONLY)

PERSONNEL

REFERENCE NO. 15

SHEET OF

NOTES NIESE

DATE 11/20/23

ROUTE SR 25

H.C. NIESE

WEATHER CLEAR

COUNTY WOOD

R.C. ASTON

TEMP. 37°

TOWNSHIP LIBERTY

DWG BY BARRIERE

PID 92133

SECTION 12

T 4 N R 10 E

TYPE MONUMENT MAG NAIL/WASHER

ON SURFACE - BELOW ON

OFFSET $\varnothing$ PAVEMENT ' RT LT : RT


 TO EDGE PAVEMENT

STATION: 319+05.07

HORIZ.DATUM: NAD83(11)/WOOD LDP GEOID: 18

GRID: NORTHING: 606871.234 EASTING: 1652550.794


LDP: NORTHING: 428715.428 EASTING: 163933.312

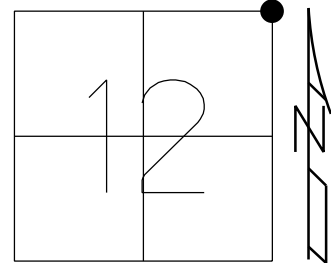

RECORD:P.I.

NE COR SEC 12

FD P.K./WASHER
OVER BRASS MON
FD P.K./WASHER
4/16/01, TMR
SET P.K./WASHER
10-31-01, SAH
FD MAG NAIL
REF15
5-30-18, JFO
10-1-18, JFO
FD MAG NAIL
NEWREF15
3/1/23, TDN
FD MAG NAIL
IN GORE AREA
W/ STRATTLERS
11/17/23, TDN

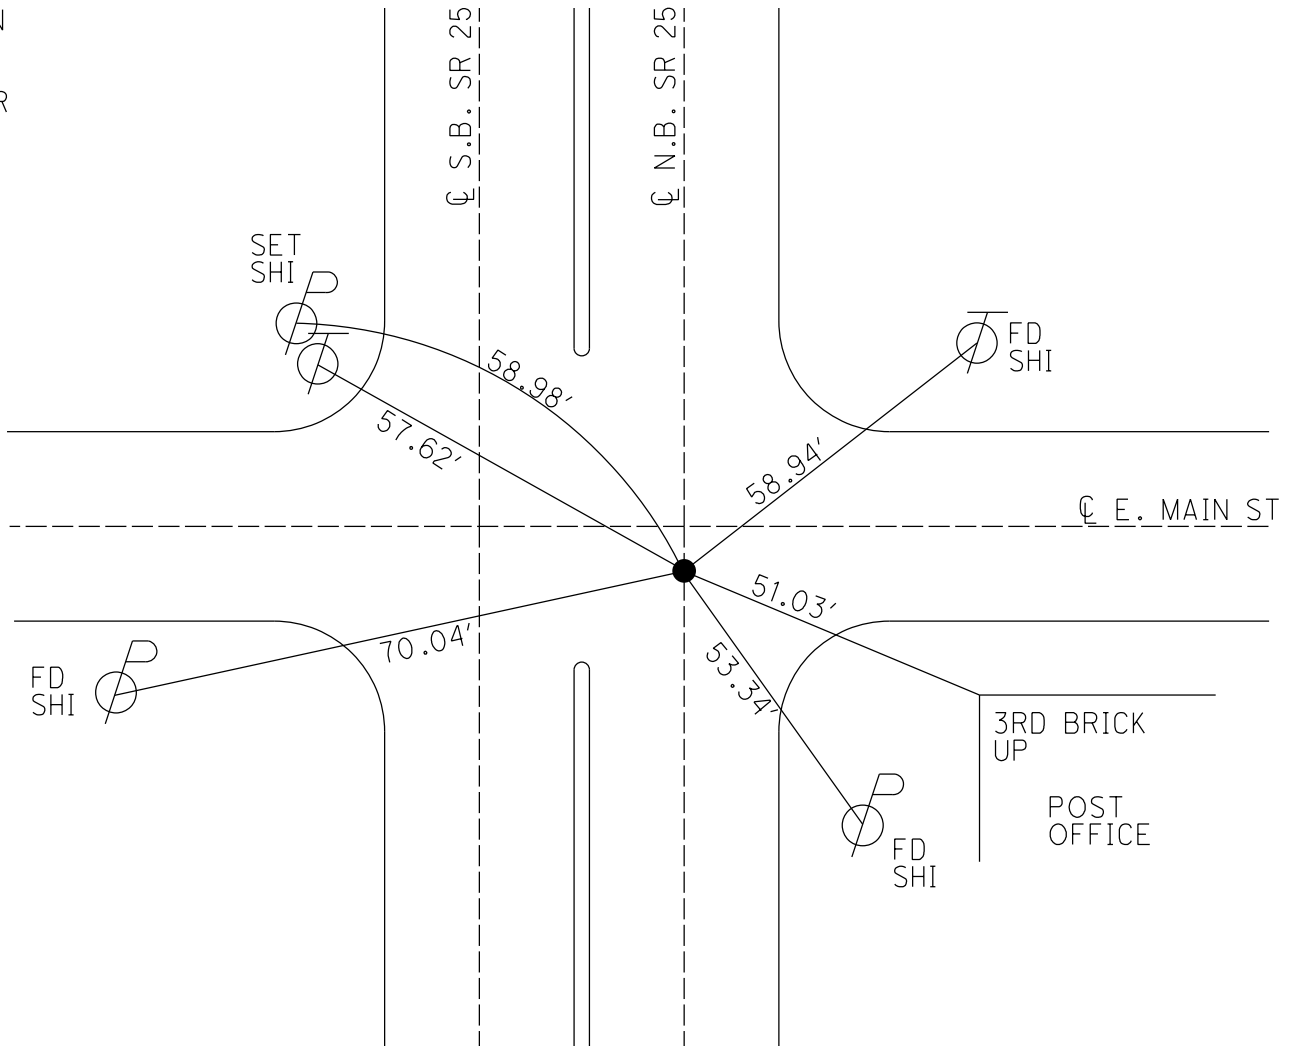

O.D.O.T. DISTRICT 2 SURVEY OFFICE (USE ONLY)

PERSONNEL

REFERENCE NO. 15

SHEET 27 OF 36

NOTES HUSS
H.C. ROUSOS
R.C. VAN DUSEN

DATE 4/16/01
WEATHER CLOUDY/RAIN
TEMP. 42°

ROUTE SR 25
COUNTY WOOD
TOWNSHIP LIBERTY
SECTION 12

DWG BY MILLER PID NO PID

T 4 N R 10 E

TYPE MONUMENT P.K./WASHER

ON SURFACE - ~~BELOW~~ ON

OFFSET CL PAVEMENT 3.1' ~~LT~~ : RT

- TO - EDGE PAVEMENT


STATION: 346+50

HORZ.DATUM: NAD83(2011)

GEOID: NAVD88 2012A


GRID: NORTHING: 606871.234

EASTING: 1652550.794

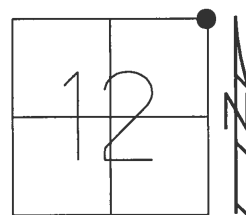

RECORD:

FD P.K./WASHER
OVER BRASS MON
FD P.K./WASHER
4/16/01, TMR
SET P.K./WASHER
10-31-01, SAH
FD MAG NAIL
REF15
5-30-18, JFO
10-1-18, JFO

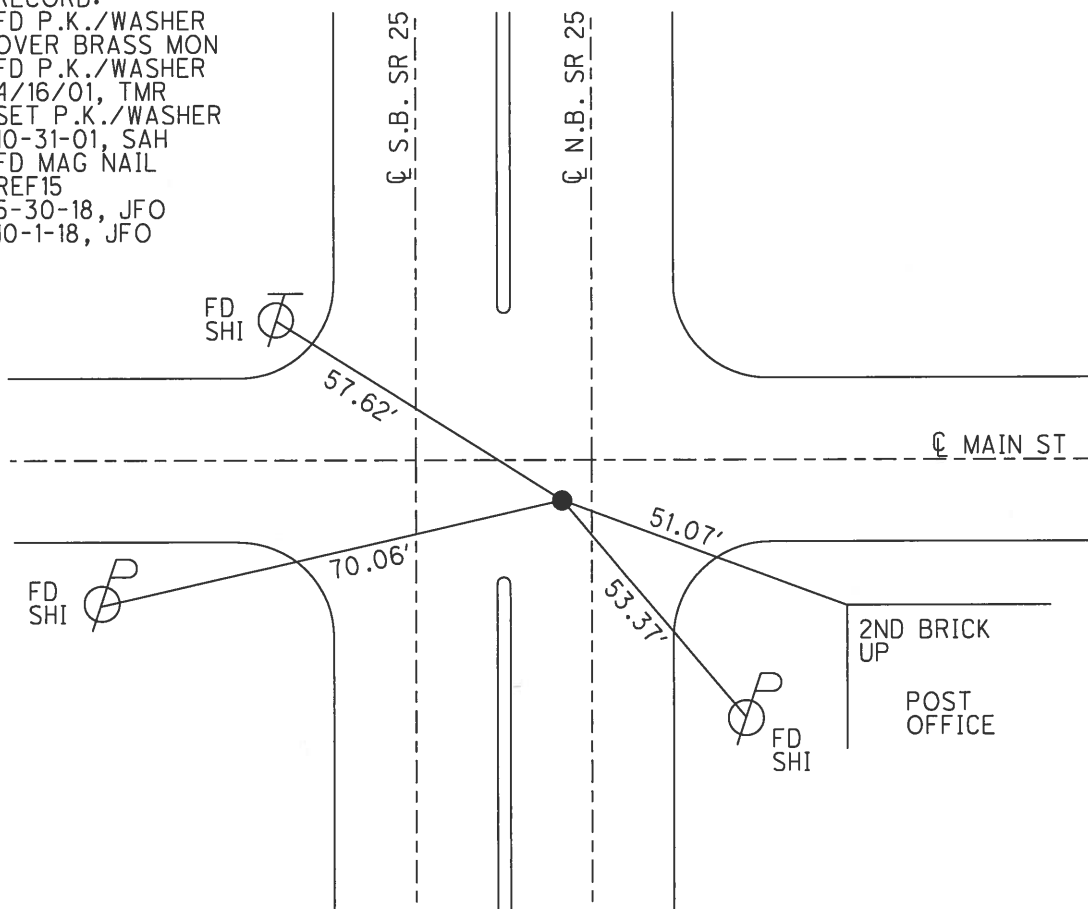

O.D.O.T. DISTRICT 2 SURVEY OFFICE

PERSONNEL

REFERENCE NO. 15

SHEET 16 OF 23

NOTES

Huss

H.C.

Rousos

R.C.

Dan Dusen

DATE

4-16-01

WEATHER

Clgy. Rain

TEMP.

+42°F

ROUTE SR 25

COUNTY WOOD

TOWNSHIP LIBERTY

SECTION 12

T 4 N R 10 E


TYPE MONUMENT PK & WASHER

ON SURFACE - BELOW Surface

LEFT - CL PAW'T. - RIGHT 3.1' & 1.0' South of CL Rmt


TO EDGE PAVEMENT Portage Rd. West

S.L.M. 346-150

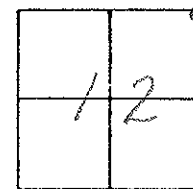

RECORD:

PK & WASHER OVER
BRASS MONUMENT

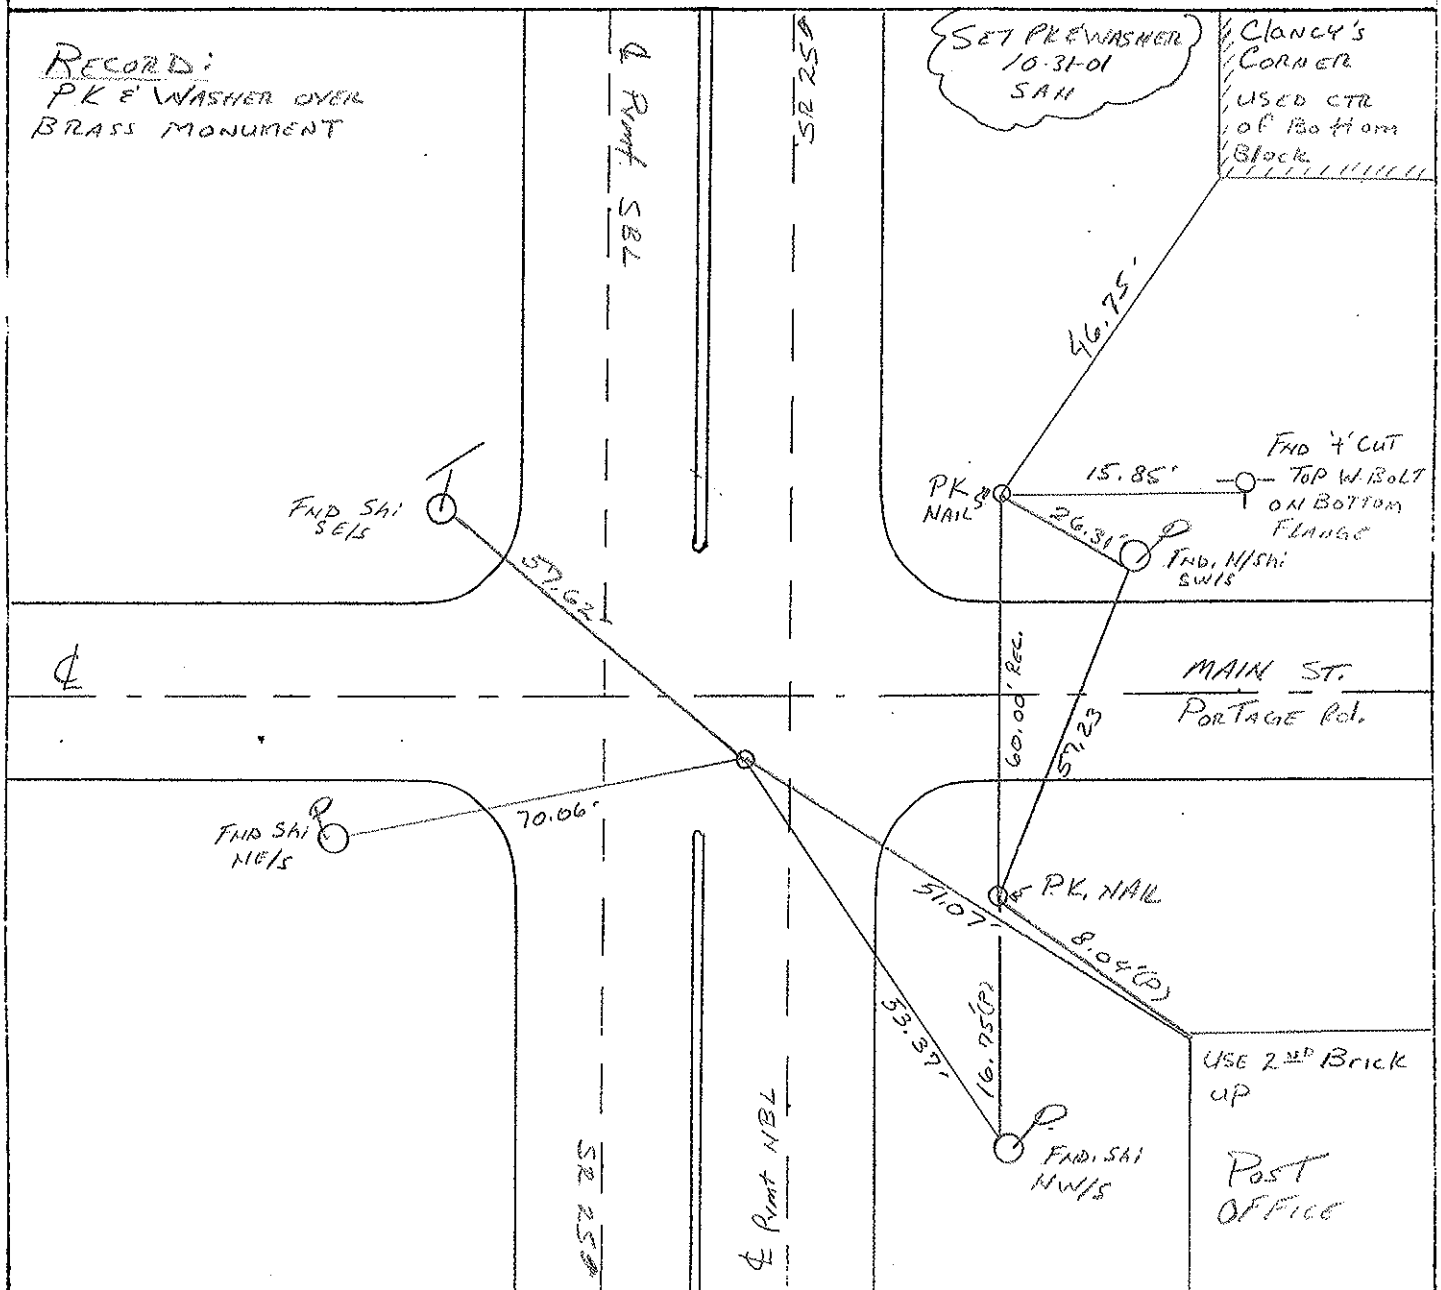

O.D.O.T. DISTRICT 2 SURVEY OFFICE

PERSONNEL

REFERENCE NO. 15

SHEET 16 OF 23

NOTES HOFFMAN

H.C. LoeHRKE

R.C. BARNHISEL

DATE 3-27-91

WEATHER P. CLEAR

TEMP. 55°

ROUTE SR 25

COUNTY Wood

TOWNSHIP LIBERTY

SECTION 12

T4 NR 10 E



TYPE MONUMENT Brass Monument

ON SURFACE - BELOW 2"

LEFT- & PAV'T. - RIGHT 3.1' $\pm$ 1.0' South of E Part

TO EDGE PAVEMENT PORTAGE Rd. WEST

S.L.M. 346 + 50

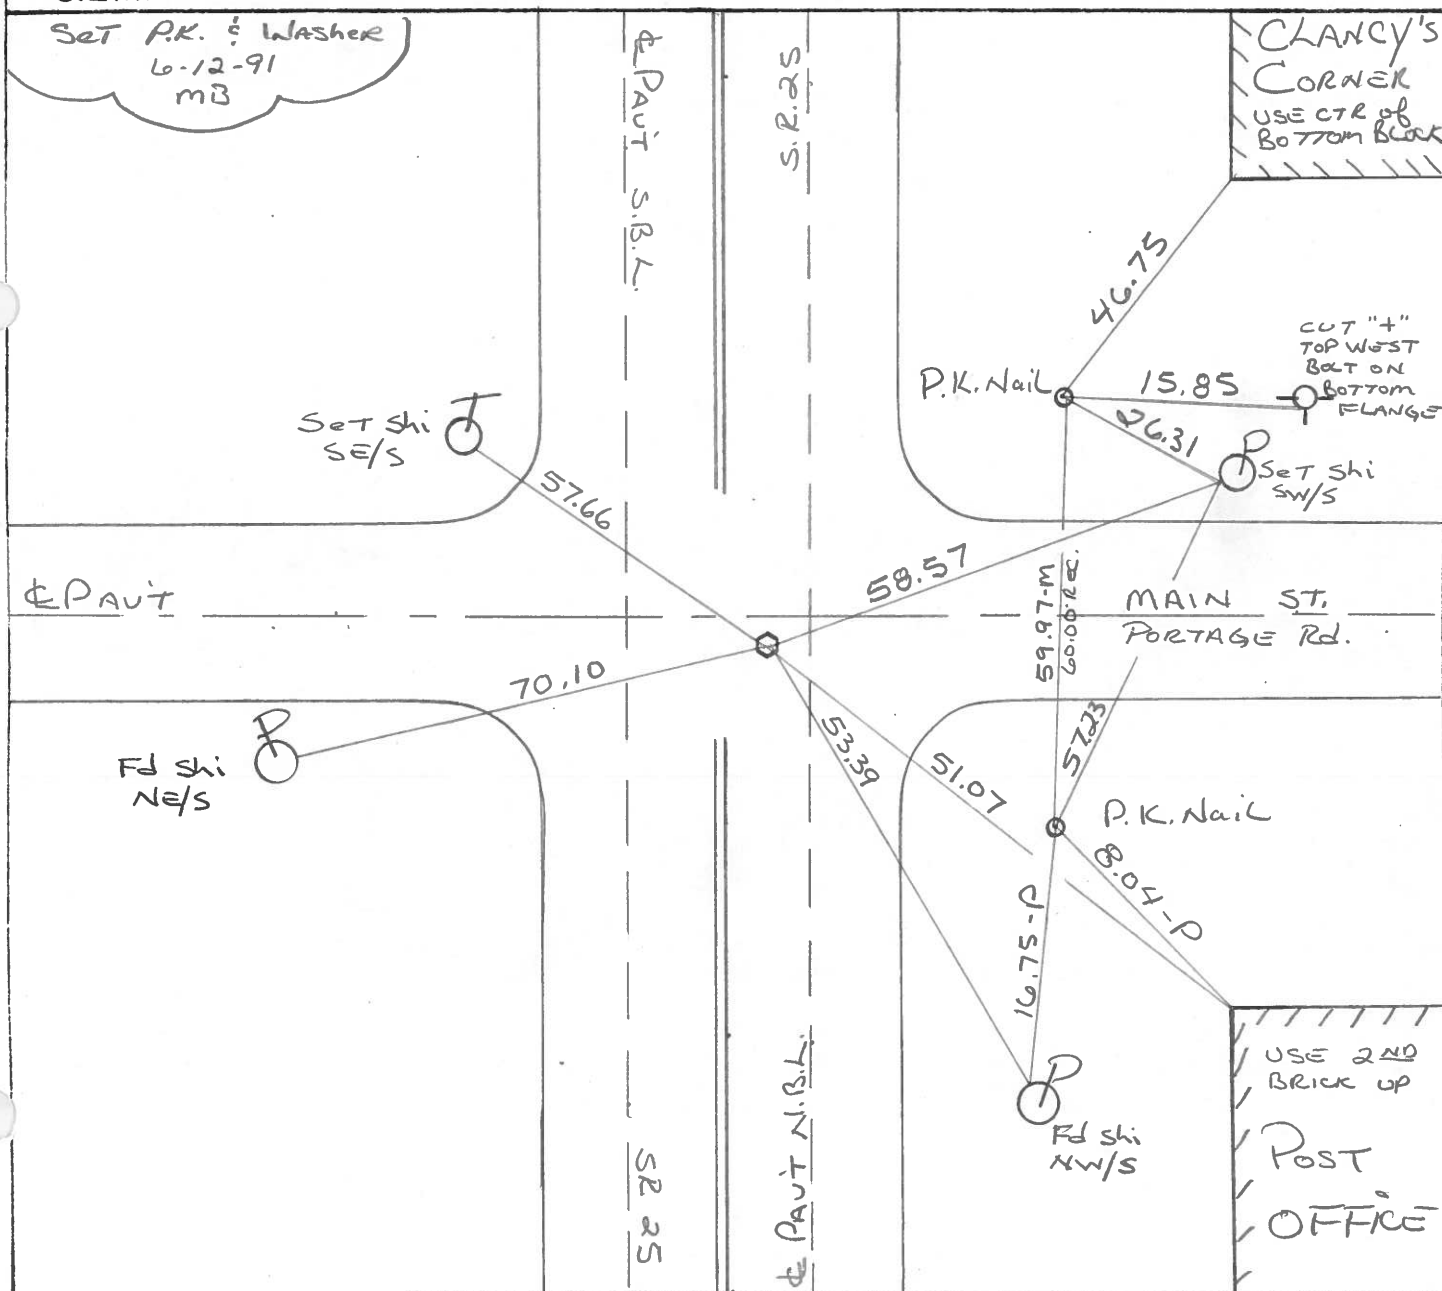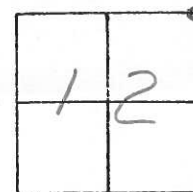

SHEET _____ OF _____

OK. -5-18-78

5-21-71

Weather

Temp. _____

1	2

42

#15

BRASS MON.

MAIN

ST.

SET P.K. NAILS
8-21-72

BOTTOM BLOCK
OLD HARDWARE STORE

-P.K.NAIL

POST OFFICE BLDG.
BOTTOM BRICK

"+" CUT IN WALK

SL 11
TO CAR. POST OFFICE

SHIP

SHI

SHI.

52

U.S.

PERSONNEL TITLE PERSONNEL TITLE

COUNTY Wood

DATE June 1st 1964

S. R. 45-25

WEATHER

SEC.

TEMP.


DESCRIPTION 45 25 Portage Crp

JOB NO.

LEFT

CENTER LINE

RIGHT

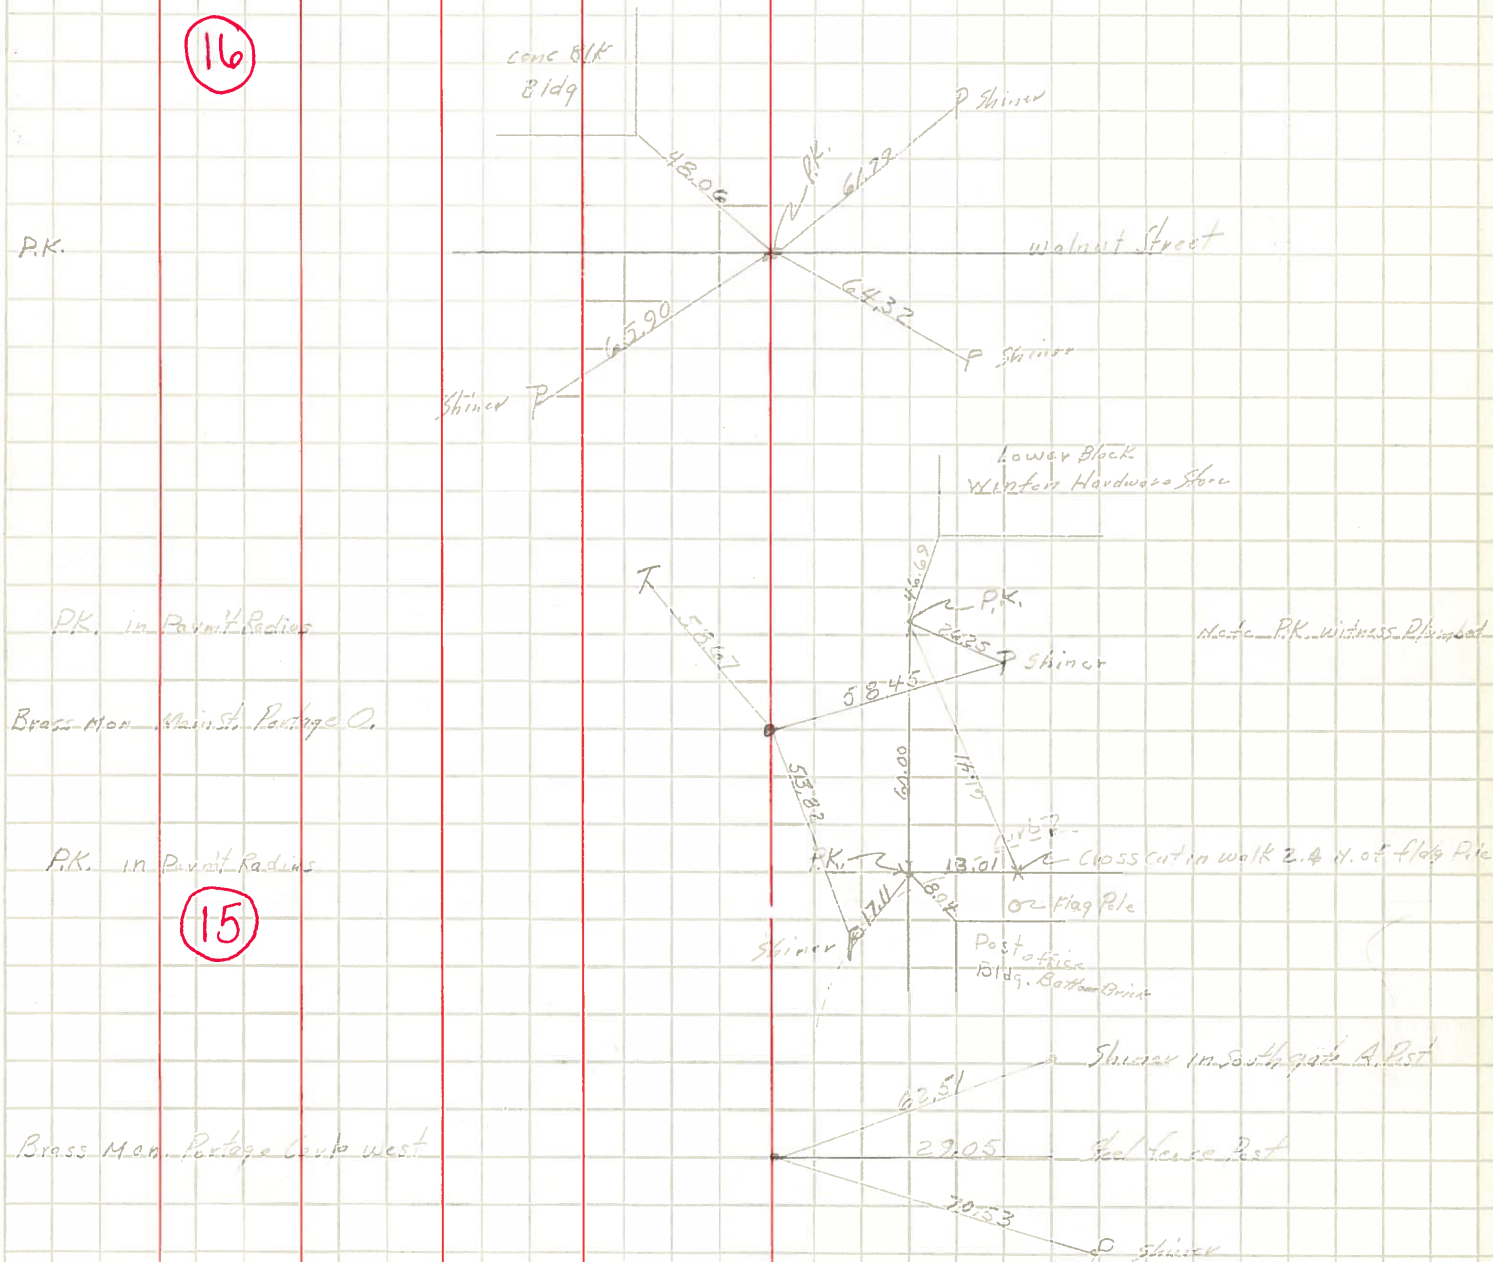

PERSONNEL

TITLE

PERSONNEL

TITLE

COUNTY

Wood

DATE

4-7-60

S. R.

U.S. #25

WEATHER

SEC.

TEMP.

DESCRIPTION

LEFT

CENTER LINE

RIGHT

JOB NO.

Sta. 560+05.10
Portage Corp. Line East
Brass plate

(13)

#241

Shiner in End Post N.E. 29.74
Shiner in P.P. E.N.E. 40.35 40.49
Shiner in T.P. N.W. 39.92
Shiner in 12' Evergreen W.N.W. 56.93
Shiner in 30' Elm W. 64.10
Wedge post. 11.63' E edge 12.32'
Shiner 16" Maple S.E. 68.47

Sta. 562+44.4
Portage Corp. West
Brass plug, ~~top of bridge~~

(14)

#242

Shiner in Anchor Post N.E. 62.63
Shiner in T.P. N.W. 44.15
Shiner in T.P. S.W. 91.00
Shiner in P.P. S.E. 70.48 73.05
Wedge post. 11.83 E edge 12.12
Shiner in End Post N.N.E. 88.86
Iron Fence Post East 29.03

Sta. 588+94.96
S.E. cor. Sec. 1 Liberty Twp.
N.E. cor. sec. 12 Liberty Twp.
Iron rod on top of
Stone, center of portage

(15)

#243

Shiner in P.P. W.S.W. ^{69.69} 69.72
Shiner in P.P. S.E. 53.89 42.73
Iron pin in brick sidewalk S.E. 43.3
S.E. Cor. gas. Sta. N.W. 80.56
Town Pump N.W. (above rd) 68.56
Shiner T. Pole N.W. 58.66
Shiner T. Pole N.E. 58.46

Note
See sheets
6A-6B
New. wit.

Sta. 612+96.65
W. 1/4 post. sec. 6 Portage
Twp.
Brass plate

(17)

#244

~~Shiner in P.P. S.E. 47.96~~
~~Shiner in T.P. S.S.W. 69.78~~
~~Shiner in T.P. N.N.W. 69.94~~
Shiner in T. Pole N.W. 77.20
Shiner in T. Pole S.W. 81.98
"X" cut in curb East 08.25
"X" cut in curb N.E. 14.60'
"X" cut in curb S.E. 16.90'