

O.D.O.T. DISTRICT 2 SURVEY OFFICE (USE ONLY)

PERSONNEL

REFERENCE NO. 16

SHEET OF

NOTES RHOADES

DATE 3/1/23

ROUTE SR 25

H.C. NIESE

WEATHER CLEAR

COUNTY WOOD

R.C. AUBLE

TEMP. 37°

TOWNSHIP LIBERTY

DWG BY BARRIERE

PID 92133

SECTION 1

T 4 N R 10 E

TYPE MONUMENT MAG NAIL

ON SURFACE - BELOW ON

OFFSET $\varnothing$ PAVEMENT 0.17 LT LT : RT


 TO EDGE PAVEMENT

STATION: 322+97.88


HORIZ.DATUM: NAD83(11)/WOOD LDP GEOID: 18

GRID: NORTHING: 607264.264 EASTING: 1652555.529

LDP: NORTHING: 429108.530 EASTING: 163932.869

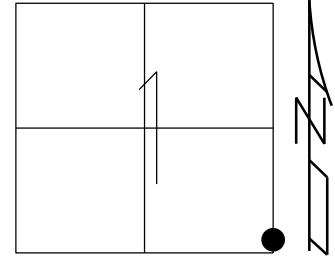

RECORD:
P.K./WASHER
ATOP P.K.NAIL
THAT DATES BACK
TO PRE-1964
FD P.K./WASHER
4/16/01, BVD
SET P.K./WASHER
10-31-01, SAH
FD MAG NAIL
REF16
5-30-18
10-1-18, JFO
FD MAG NAIL
NEWREF16
3/1/23, TDN

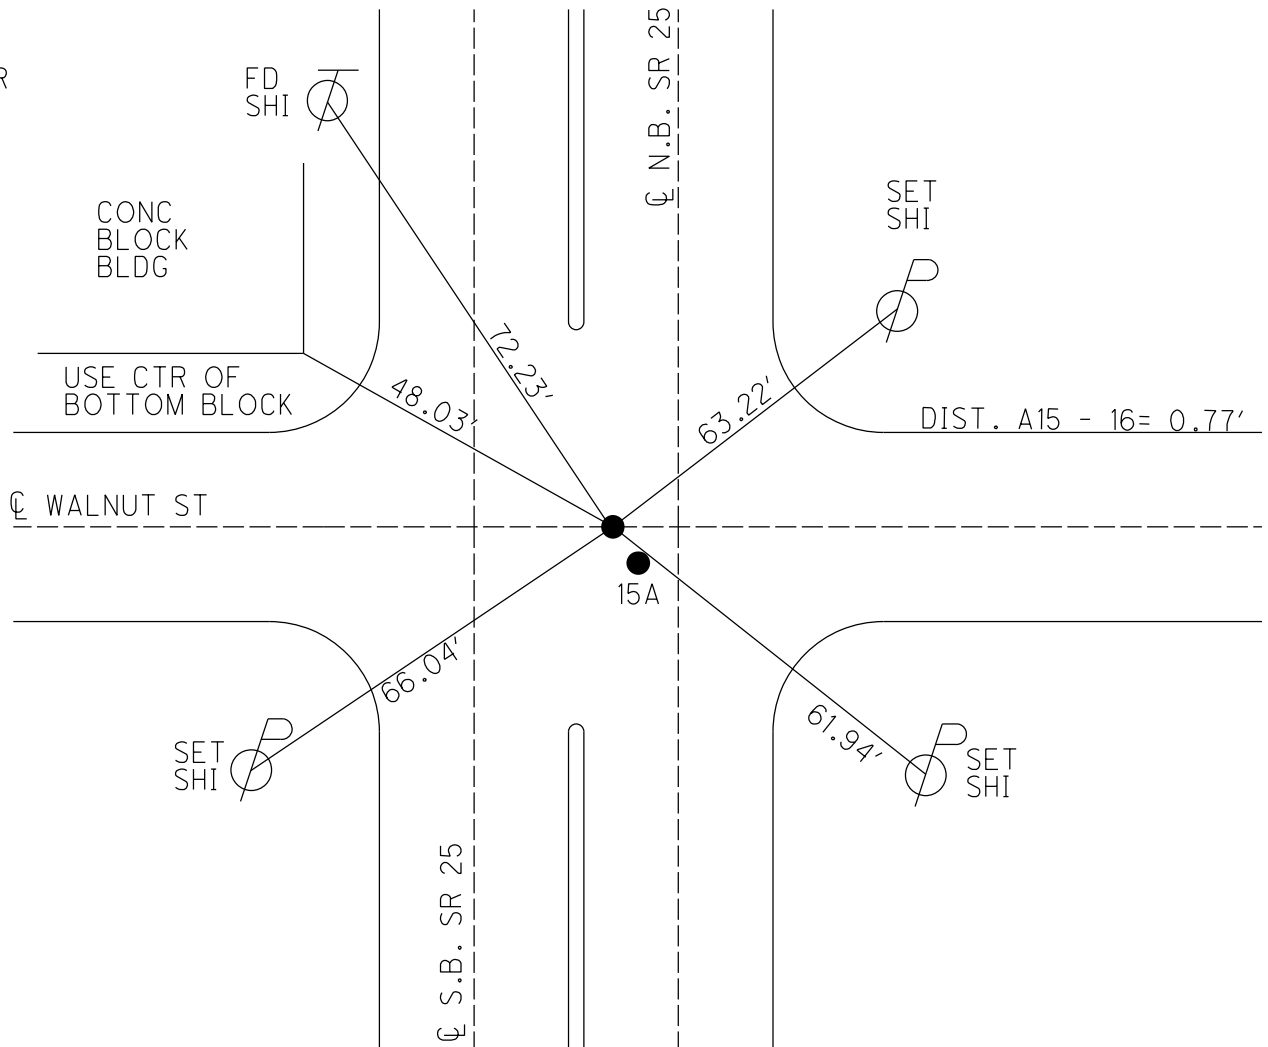

O.D.O.T. DISTRICT 2 SURVEY OFFICE (USE ONLY)

PERSONNEL

REFERENCE NO. 16

SHEET 29 OF 36

NOTES HUSS
H.C. ROUSOS
R.C. VAN DUSEN

DATE 4/16/01
WEATHER CLOUDY/RAIN
TEMP. 42°

ROUTE SR 25
COUNTY WOOD
TOWNSHIP LIBERTY
SECTION 1

DWG BY MILLER PID NO PID

T 4 N R 10 E

TYPE MONUMENT P.K./WASHER

ON SURFACE - ~~BELOW~~ ON

OFFSET 1.2' LT : RT

- TO - EDGE PAVEMENT



STATION: 350+43

HORZ.DATUM: NAD83(2011)

GEOID: NAVD88 2012A

GRID: NORTHING: 607264.264

EASTING: 1652555.529

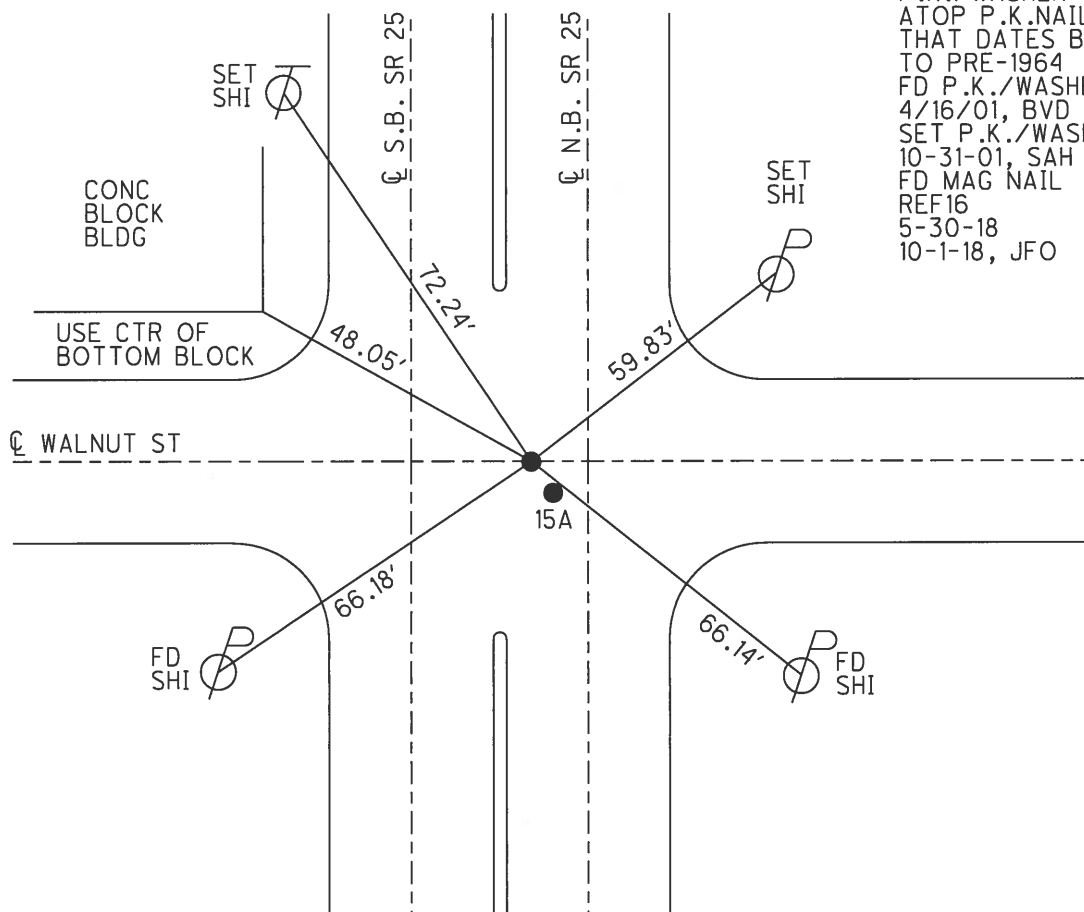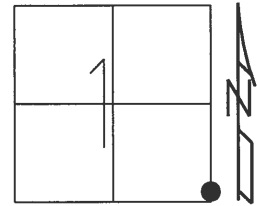

RECORD:
P.K./WASHER
ATOP P.K.NAIL
THAT DATES BACK
TO PRE-1964
FD P.K./WASHER
4/16/01, BVD
SET P.K./WASHER
10-31-01, SAH
FD MAG NAIL
REF16
5-30-18
10-1-18, JFO

O.D.O.T. DISTRICT 2 SURVEY OFFICE

PERSONNEL

REFERENCE NO. 16

SHEET 17 OF 23

NOTES

H.C.

R.C.

Huss

Rousos

VanDusen

DATE

4-16-01

WEATHER

Cloudy-Rain

TEMP.

+42°F

ROUTE

SR 25

COUNTY

WOOD

TOWNSHIP

LIBERTY

SECTION

1

T 4 N R 10 E

TYPE MONUMENT


PK & WASHER

ON SURFACE - BELOW

LEFT - & PAV'T. - RIGHT

TO EDGE PAVEMENT

S.L.M.

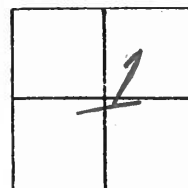

RECORD
PK NAIL & WASHER
OVER PK NAIL THAT
DATES BACK TO PRE-1964.

Set PKW
10-31-01
SAH

CONC.
BLOCK
BIDG.

USED CTR OF
BOTTOM BLOCK

SET SHI
SE/S

SET SHI
SW/S

& PAVT.

WALNUT ST.

FND. SHI
NE/S

FND. SHI
NW/S

& PAVT. SBL

SR 25

& PAVT. NBL

SR 25

48.05'

72.24'

59.83'

66.14'

66.18'

O.D.O.T. DISTRICT 2 SURVEY OFFICE

PERSONNEL

REFERENCE NO. 16

SHEET 17 OF 23

NOTES HOFFMAN

H.C. LOENRKE

R.C. BARNHISE

DATE 3-27-91

WEATHER P. CLEAR

TEMP. 55°

ROUTE SR 25

COUNTY WOOD

TOWNSHIP LIBERTY

SECTION 1

T 4 N R 10 E


TYPE MONUMENT P.K.

ON SURFACE - BELOW YES

LEFT-~~C~~ PAUT. - RIGHT 2.6

24.0 TO RT EDGE PAVEMENT - CURB LINE

S.L.M. 350+43

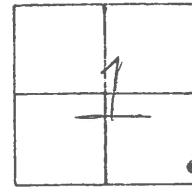

RECORD:

P.K. nail dates
BACK TO PRE-1964

Set P.K. & Washer
6-12-91
MB

CONC.
BLOCK
BLDG

USE CTR. of
BOTTOM BLOCK

Fd Shi
SE/S

P Fd Shi
SW/S

PAUT

WALNUT ST.

P
Set Shi
NE/S

P Fd Shi
NW/S

SR 25

PAUT N.B.L.

O.D.O.T. DISTRICT 2 SURVEY OFFICE

SHEET

OF

County WOOD ^{U.S.} ~~S.R.~~ 25

Township LIBERTY

Section 1

T4N, R10E

Personnel BURNSIDE

SMITH


BOWERS

HOLCOMBE


Date OK. 5-18-78
5-21-71

Weather CLEAR

Temp. 72°

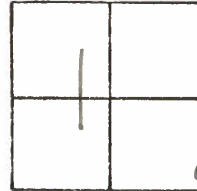

#16

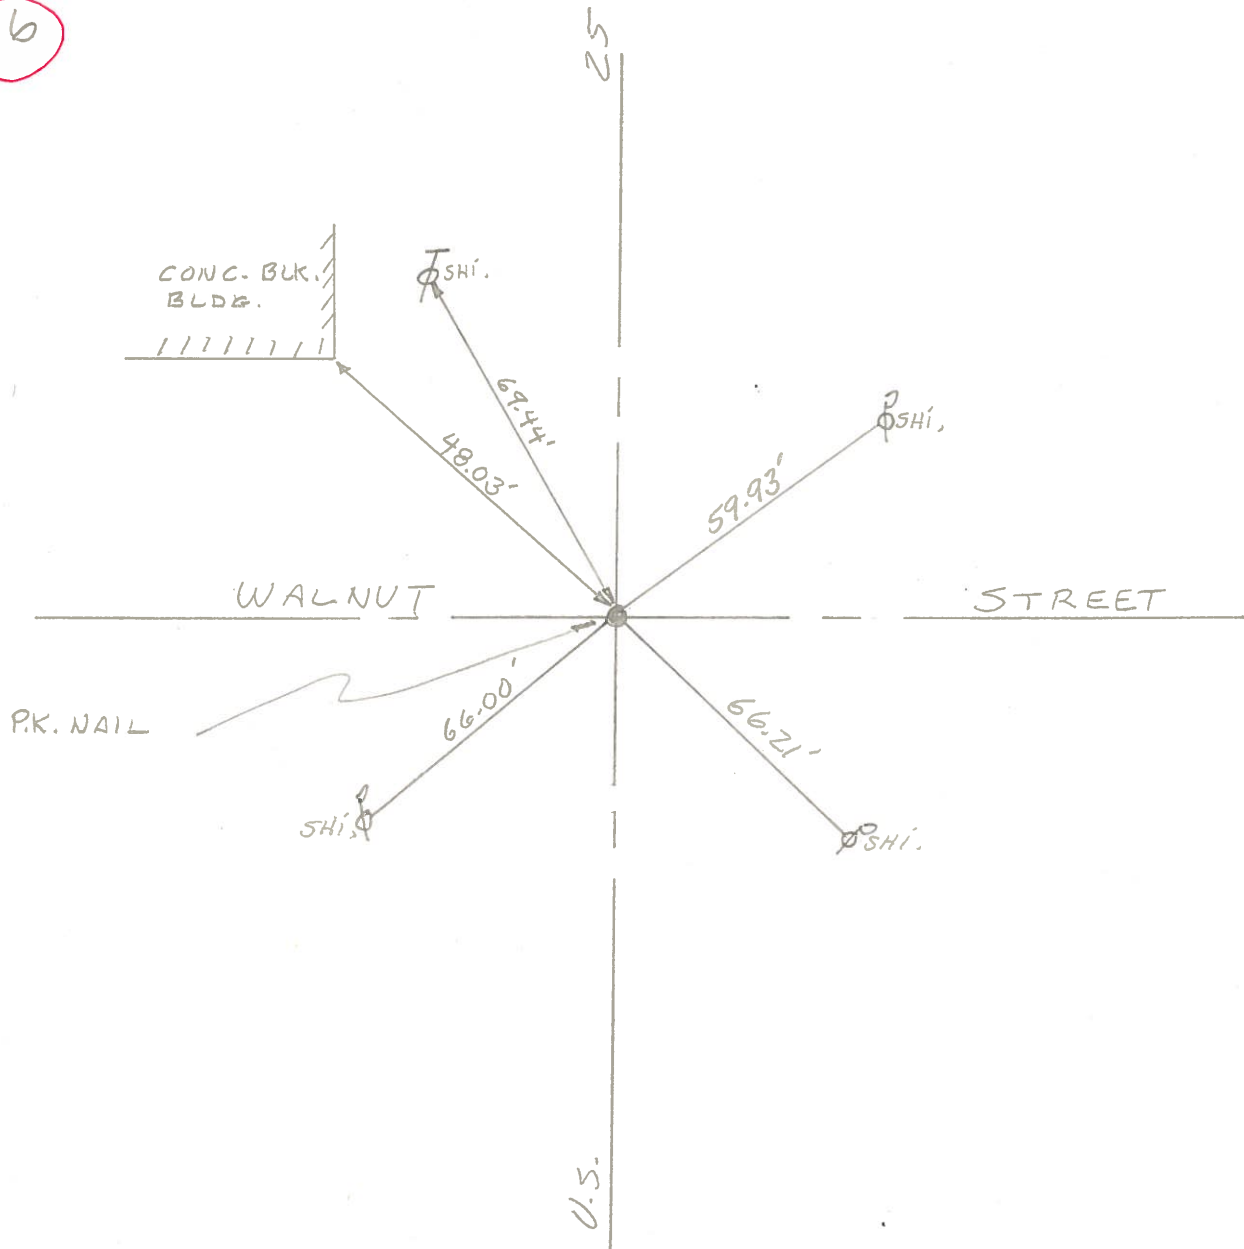

PERSONNEL	TITLE	PERSONNEL	TITLE
DESCRIPTION		U.S. 25 Portage Carb	

COUNTY Wood DATE June 1st 1964

S. R. 618-25 WEATHER _____

SEC. _____ TEMP. _____

LEFT CENTER LINE RIGHT JOB NO. _____

