


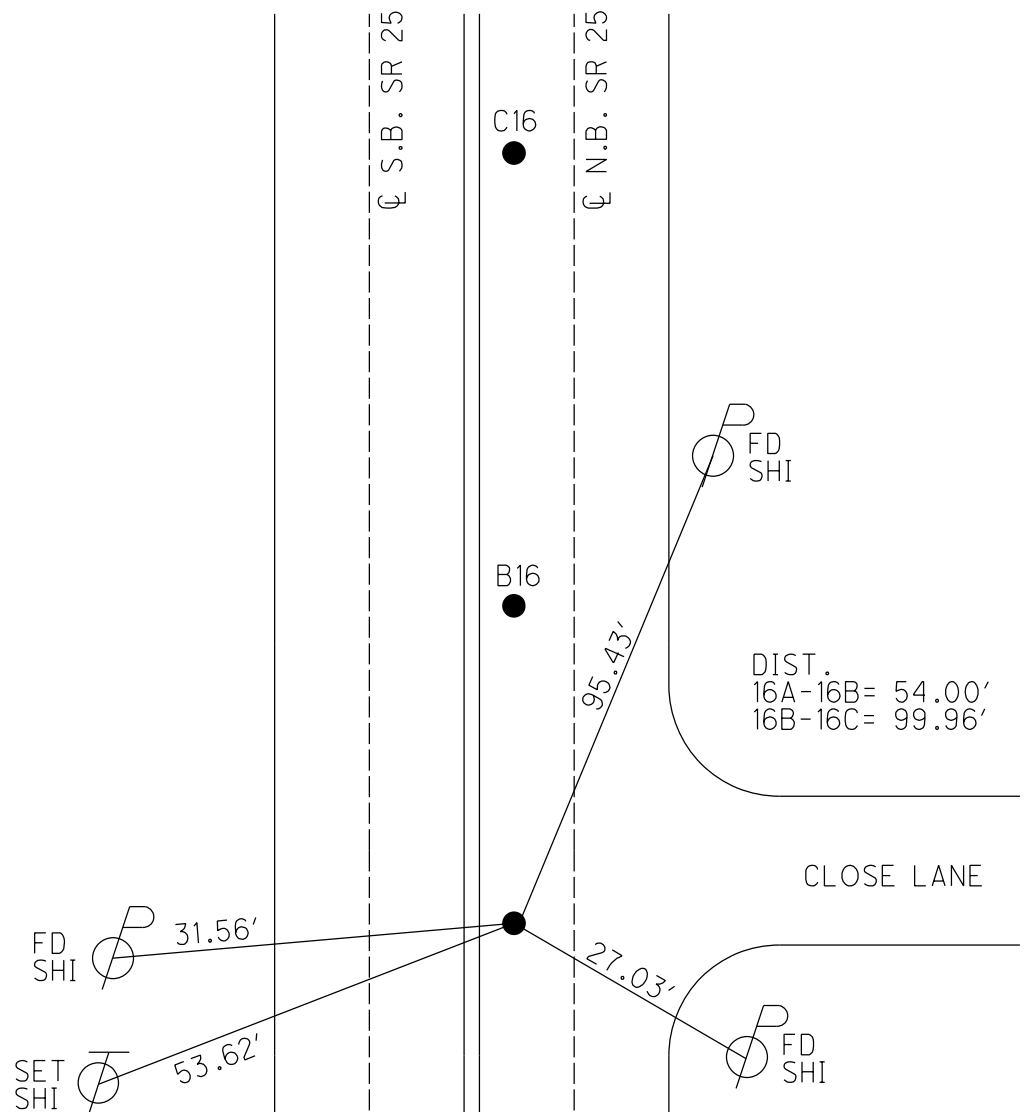

O.D.O.T. DISTRICT 2 SURVEY OFFICE (USE ONLY)

PERSONNEL

REFERENCE NO. 16 A

SHEET 30 OF 36

NOTES HUSS

DATE 4/16/01

ROUTE SR 25

H.C. ROUSOS

WEATHER CLOUDY/RAIN

COUNTY WOOD

R.C. VAN DUSEN

TEMP. 42°

TOWNSHIP LIBERTY

DWG BY MILLER

PID NO PID

SECTION 1

T 4 N R 10 E

TYPE MONUMENT P.K./WASHER

ON SURFACE - ~~BELOW~~ ON

OFFSET Q PAVEMENT 2.6' LT : RT

28.6' TO LT EDGE PAVEMENT


STATION: 357+45

HORIZ.DATUM: NAD83(2011)

GEOID: NAVD88 2012A

GRID: NORTHING: 607966.591


EASTING: 1652564.267

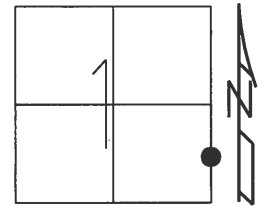

RECORD:

FD P.K./WASHER
4/16/01, BVD
SET P.K./WASHER
10-31-01, SAH
FD P.K./WASHER
REFA16
5-30-18
10-1-18, JFO

DIST.
16A-16B= 54.00'
16B-16C= 100.00'

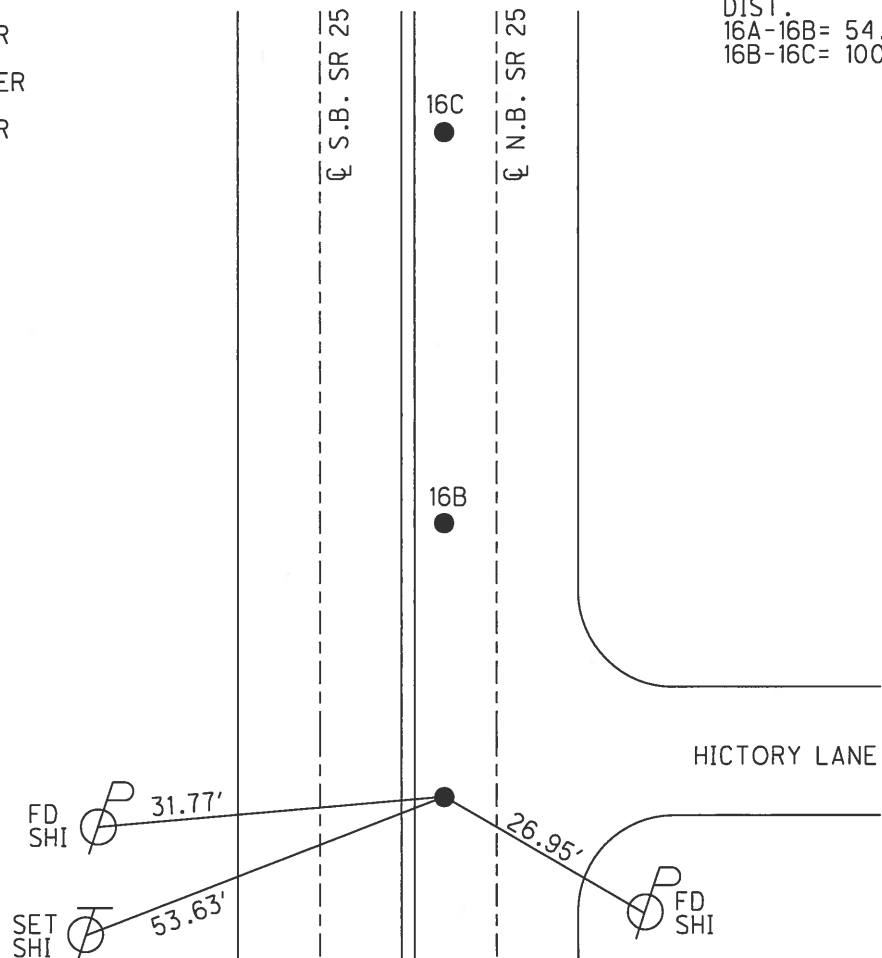

O.D.O.T. DISTRICT 2 SURVEY OFFICE

PERSONNEL

REFERENCE NO. _____

SHEET 18 OF 23

NOTES Huss

H.C. Rousar

R.C. Van Dusen

DATE 4-16-61

WEATHER Cldy - Rain

TEMP. +42°F

ROUTE SR-25

COUNTY Wood

TOWNSHIP Liberty

SECTION 1

T 4 N R 10 E



TYPE MONUMENT PK/W All three points

ON SURFACE - ~~BELOW~~ Surf.

~~11.77'~~ - PAV'T. - RIGHT 2.6' Right - All

28.6' TO Lt. EDGE PAVEMENT

S.L.M. (A) = 357+45 (B) = 357+99 (C) = 358+99

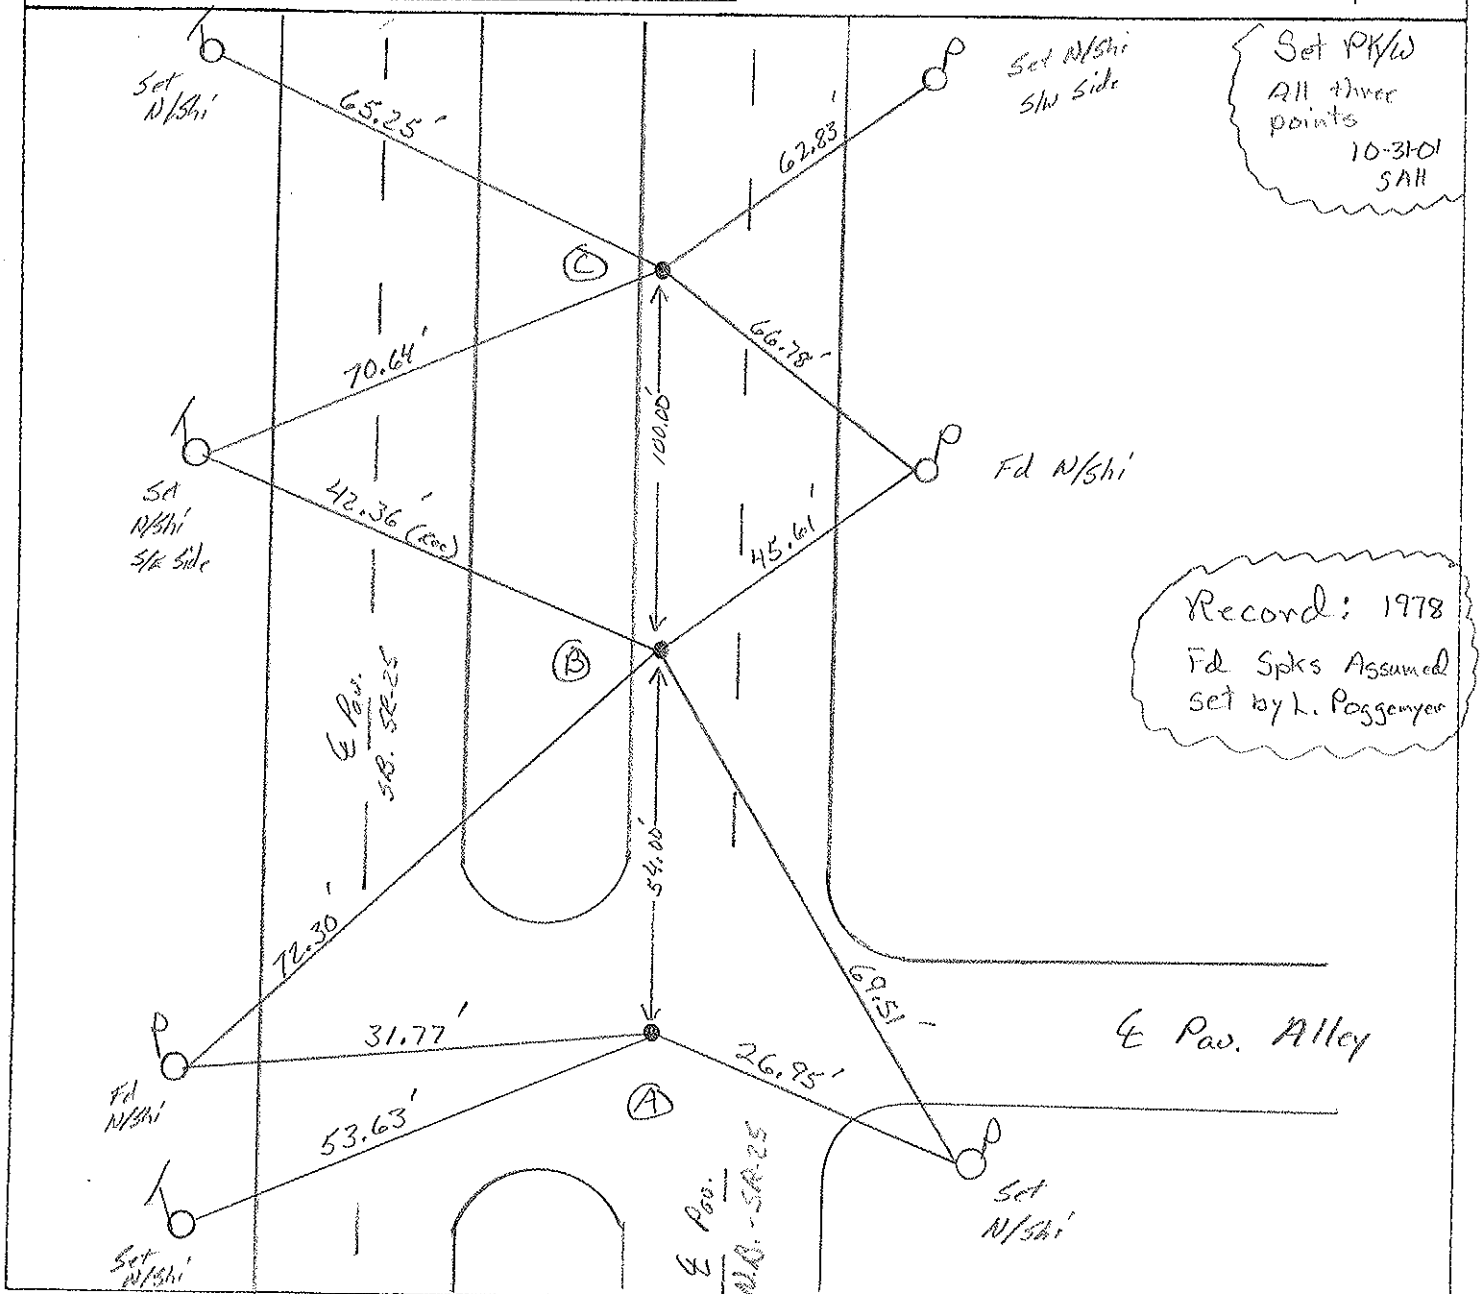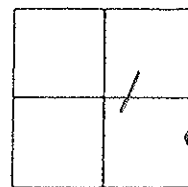

O.D.O.T. DISTRICT 2 SURVEY OFFICE

PERSONNEL

REFERENCE NO. _____

SHEET 18 OF 23

NOTES Hoffmann

H.C. LOENRICE

R.C. BARNHISEL

DATE 3-27-91

WEATHER P. CLEAR

TEMP. 55°

ROUTE SR 25

COUNTY WOOD

TOWNSHIP LIBERTY

SECTION 1

T4 NR 10 E

TYPE MONUMENT P.K. Nails (3)

~~ON SURFACE~~ - BELOW ALL 1"

~~LEFT - C PART~~ - RIGHT ALL 2.6'



28.6 TO RT. EDGE PAVEMENT - CURB

S.L.M. Center Point = 357+99

16-A

16-B

11b-C.

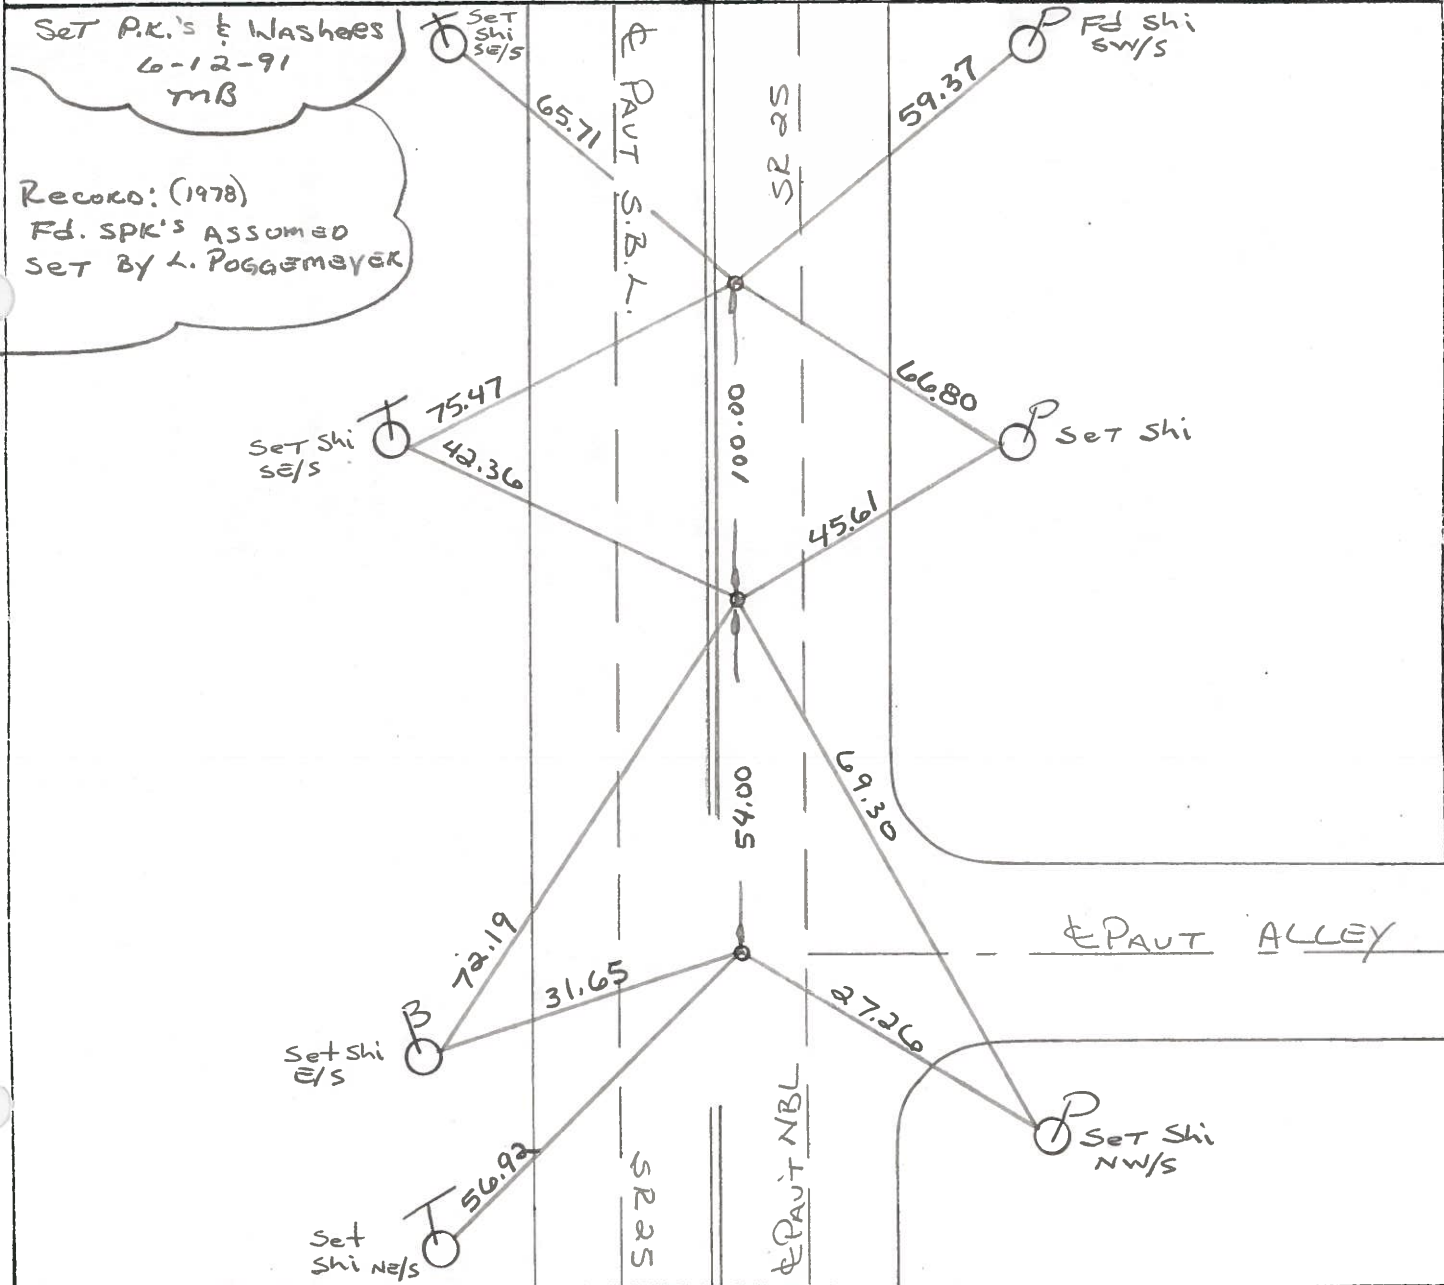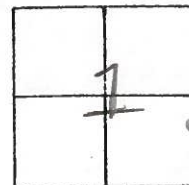

Sht. _____ of _____

Date 5-18-78

Weather CLEARING

Temp. +58°

16-A

16-B

16-C

N
4

POINTS FOUND
BEFORE RESURFACING
PROJECT.

FD. SPK. ASSUMED —
SET BY L. POGGEMEYER

