

O.D.O.T. DISTRICT 2 SURVEY OFFICE (USE ONLY)

PERSONNEL

REFERENCE NO. B16

SHEET OF

NOTES RHOADES

DATE 3/1/23

ROUTE SR 25

H.C. NIESE

WEATHER CLEAR

COUNTY WOOD

R.C. AUBLE

TEMP. 37°

TOWNSHIP LIBERTY

DWG BY BARRIERE

PID 92133

SECTION 1

T 4 N R 10 E

TYPE MONUMENT PK SHANK

ON SURFACE - BELOW ON

OFFSET $\varnothing$ PAVEMENT 2.6' RT LT : RT


 TO EDGE PAVEMENT

STATION: 330+54.51


HORIZ.DATUM: NAD83(11)/WOOD LDP GEOID: 18

GRID: NORTHING: 608020.516 EASTING: 1652564.935

LDP: NORTHING: 429864.883 EASTING: 163932.298

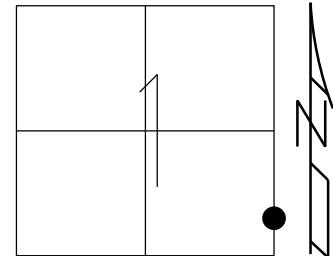

RECORD:
FD P.K./WASHER
4/16/01, BVD
SET P.K./WASHER
10-31-01, SAH
FD HOLE
REFB16
5-30-18
10-1-18, JFO
FD PK SHANK
NEWREFB16
3/1/23, TDN
FD SHANK
11/17/23, TDN

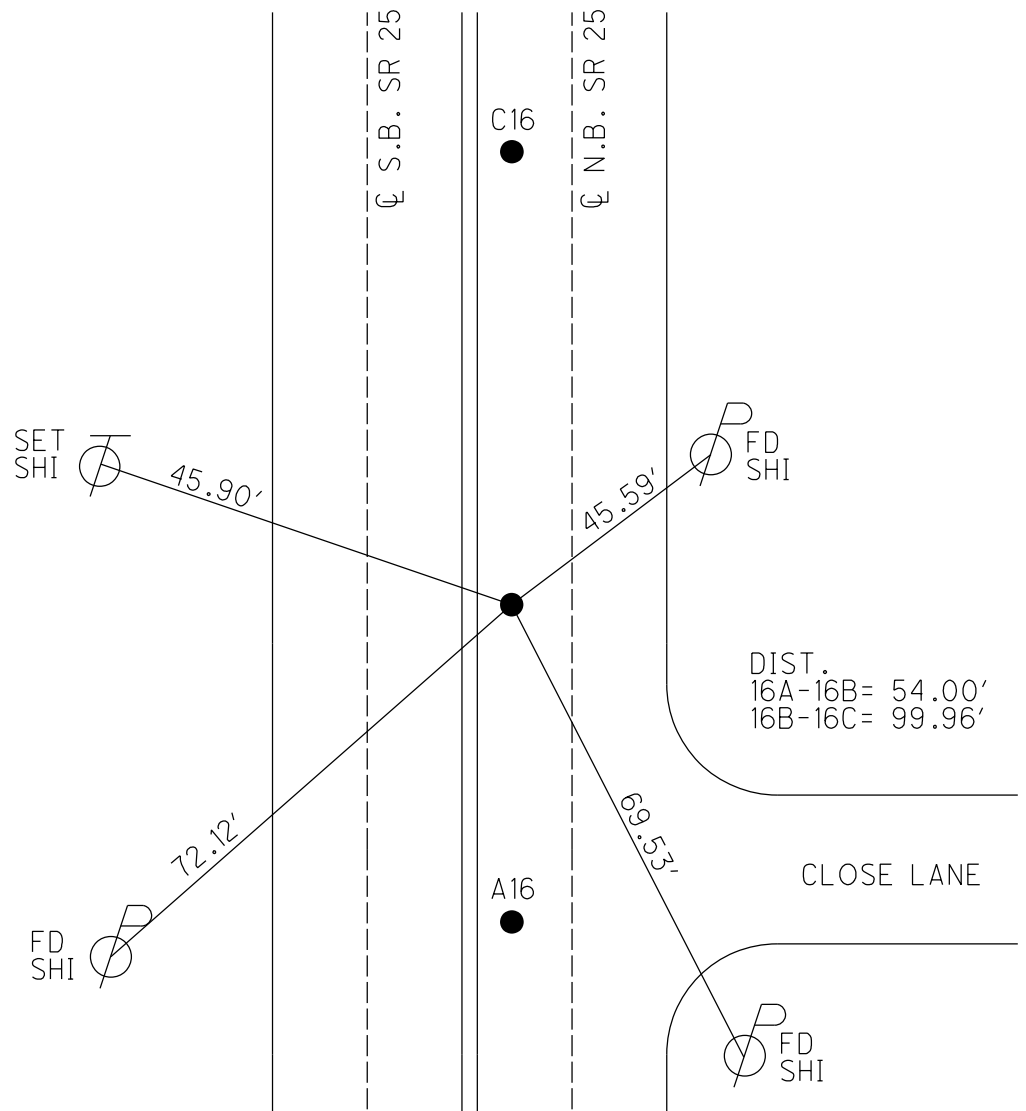

O.D.O.T. DISTRICT 2 SURVEY OFFICE (USE ONLY)

PERSONNEL

REFERENCE NO. 16 B

SHEET 31 OF 36

NOTES

HUSS

DATE

4/16/01

ROUTE

SR 25

H.C.

ROUSOS

WEATHER

CLOUDY/RAIN

COUNTY

WOOD

R.C.

VAN DUSEN

TEMP.

42°

TOWNSHIP

LIBERTY

SECTION

1

DWG BY MILLER

PID NO PID

T 4 N R 10 E

TYPE MONUMENT

P.K./WASHER

ON SURFACE - ~~BELOW~~

ON

OFFSET CL PAVEMENT

2.6'

LT : RT

28.6' TO LT EDGE PAVEMENT


STATION: 357+99

HORZ.DATUM: NAD83(2011)

GEOID: NAVD88 2012A

GRID: NORTHING: 608020.513

EASTING: 1652564.956

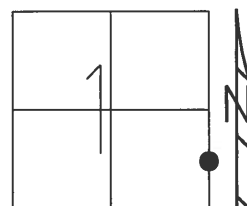


RECORD:

FD P.K./WASHER
4/16/01, BVD
SET P.K./WASHER
10-31-01, SAH
FD HOLE
REFB16
5-30-18
10-1-18, JFO

DIST.

16A-16B= 54.00'
16B-16C= 100.00'

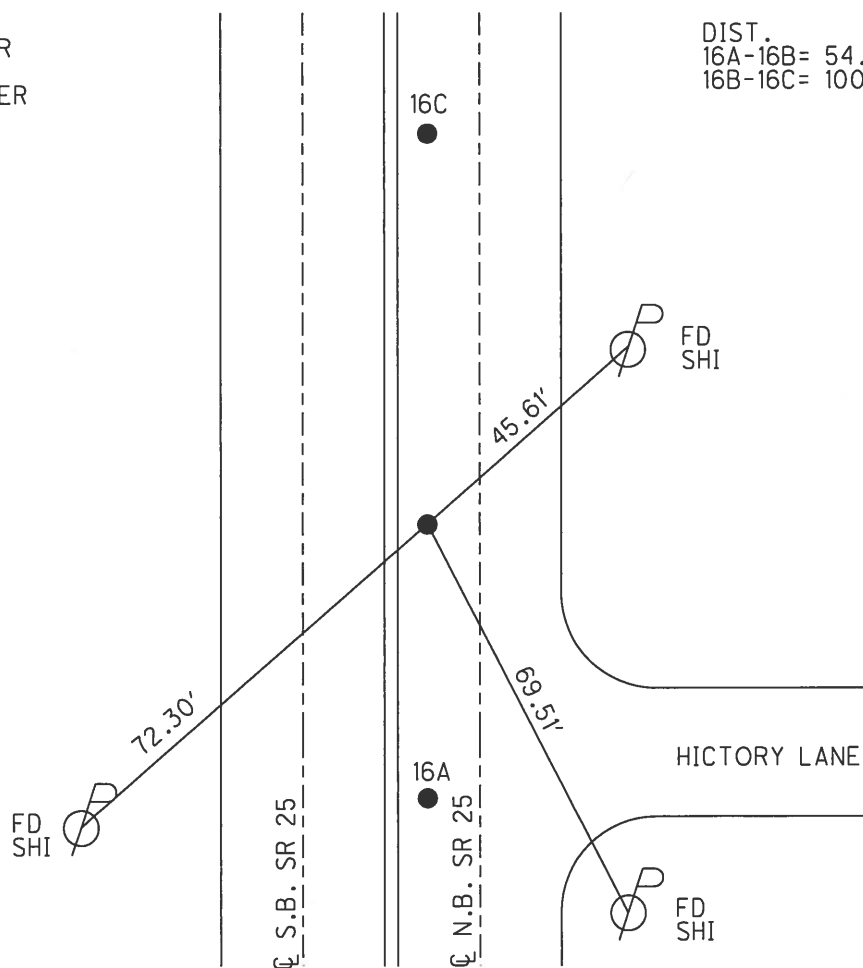

O.D.O.T. DISTRICT 2 SURVEY OFFICE

PERSONNEL

REFERENCE NO. _____

SHEET 18 OF 23

NOTES Huss

H.C. Rousar

R.C. Van Dusen

DATE 4-16-61

WEATHER Cldy - Rain

TEMP. +42°F

ROUTE SR-25

COUNTY Wood

TOWNSHIP Liberty

SECTION 1

T 4 N R 10 E



TYPE MONUMENT PK/W All three points

ON SURFACE - ~~BELOW~~ Surf.

~~11.77'~~ - PAV'T. - RIGHT 2.6' Right - All

28.6' TO Lt. EDGE PAVEMENT

S.L.M. (A) = 357+45 (B) = 357+99 (C) = 358+99

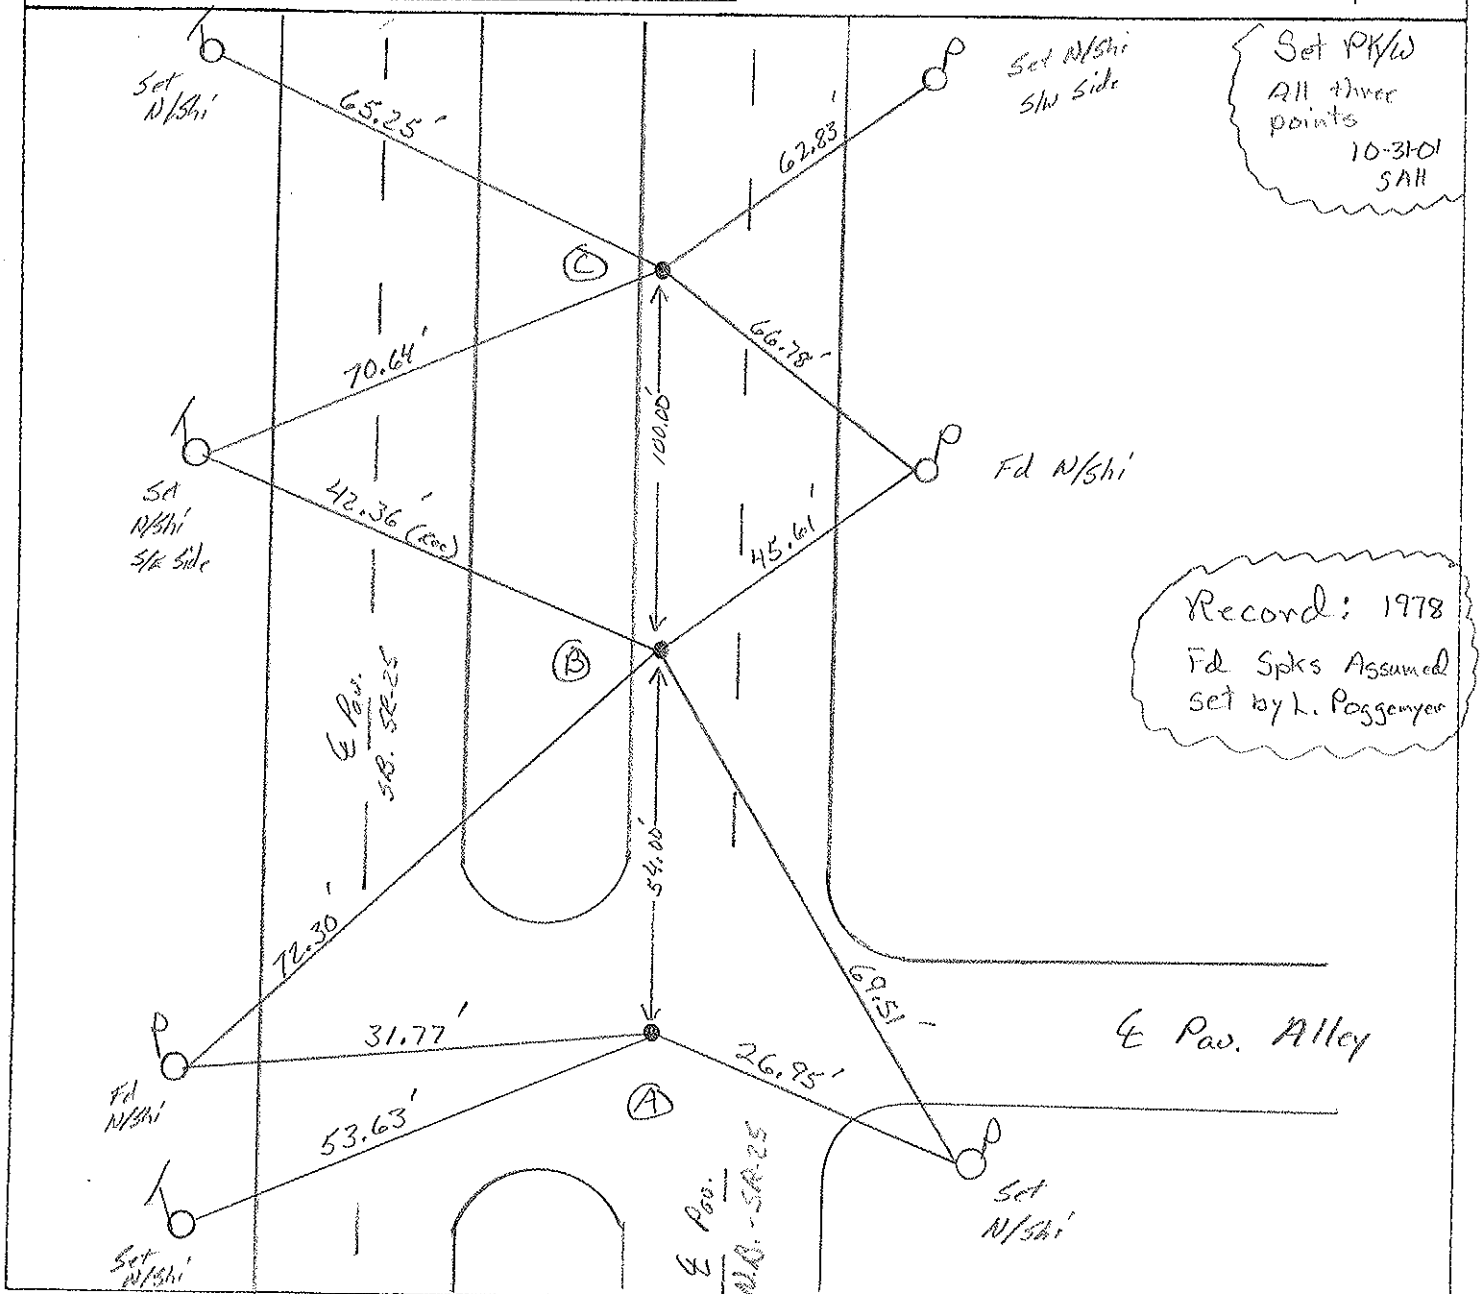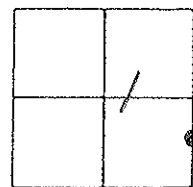

O.D.O.T. DISTRICT 2 SURVEY OFFICE

PERSONNEL

REFERENCE NO. _____

SHEET 18 OF 23

NOTES Hoffman

H.C. LOENRKE

R.C. BARNHISEL

DATE 3-27-91

WEATHER P. CLEAR

TEMP. 55°

ROUTE 5225

COUNTY WOOD

TOWNSHIP LIBERTY

SECTION 1

T4 NR 10 E

TYPE MONUMENT P.K. NAILS (3)

~~ON SURFACE~~ - BELOW ALL 1"



~~LEFT - C PAVT.~~ - RIGHT ALL 2.6'
28.6 TO 41. EDGE PAVEMENT - CURB

S.L.M. CENTER POINT = 357+99

16-A

16-B

16-C

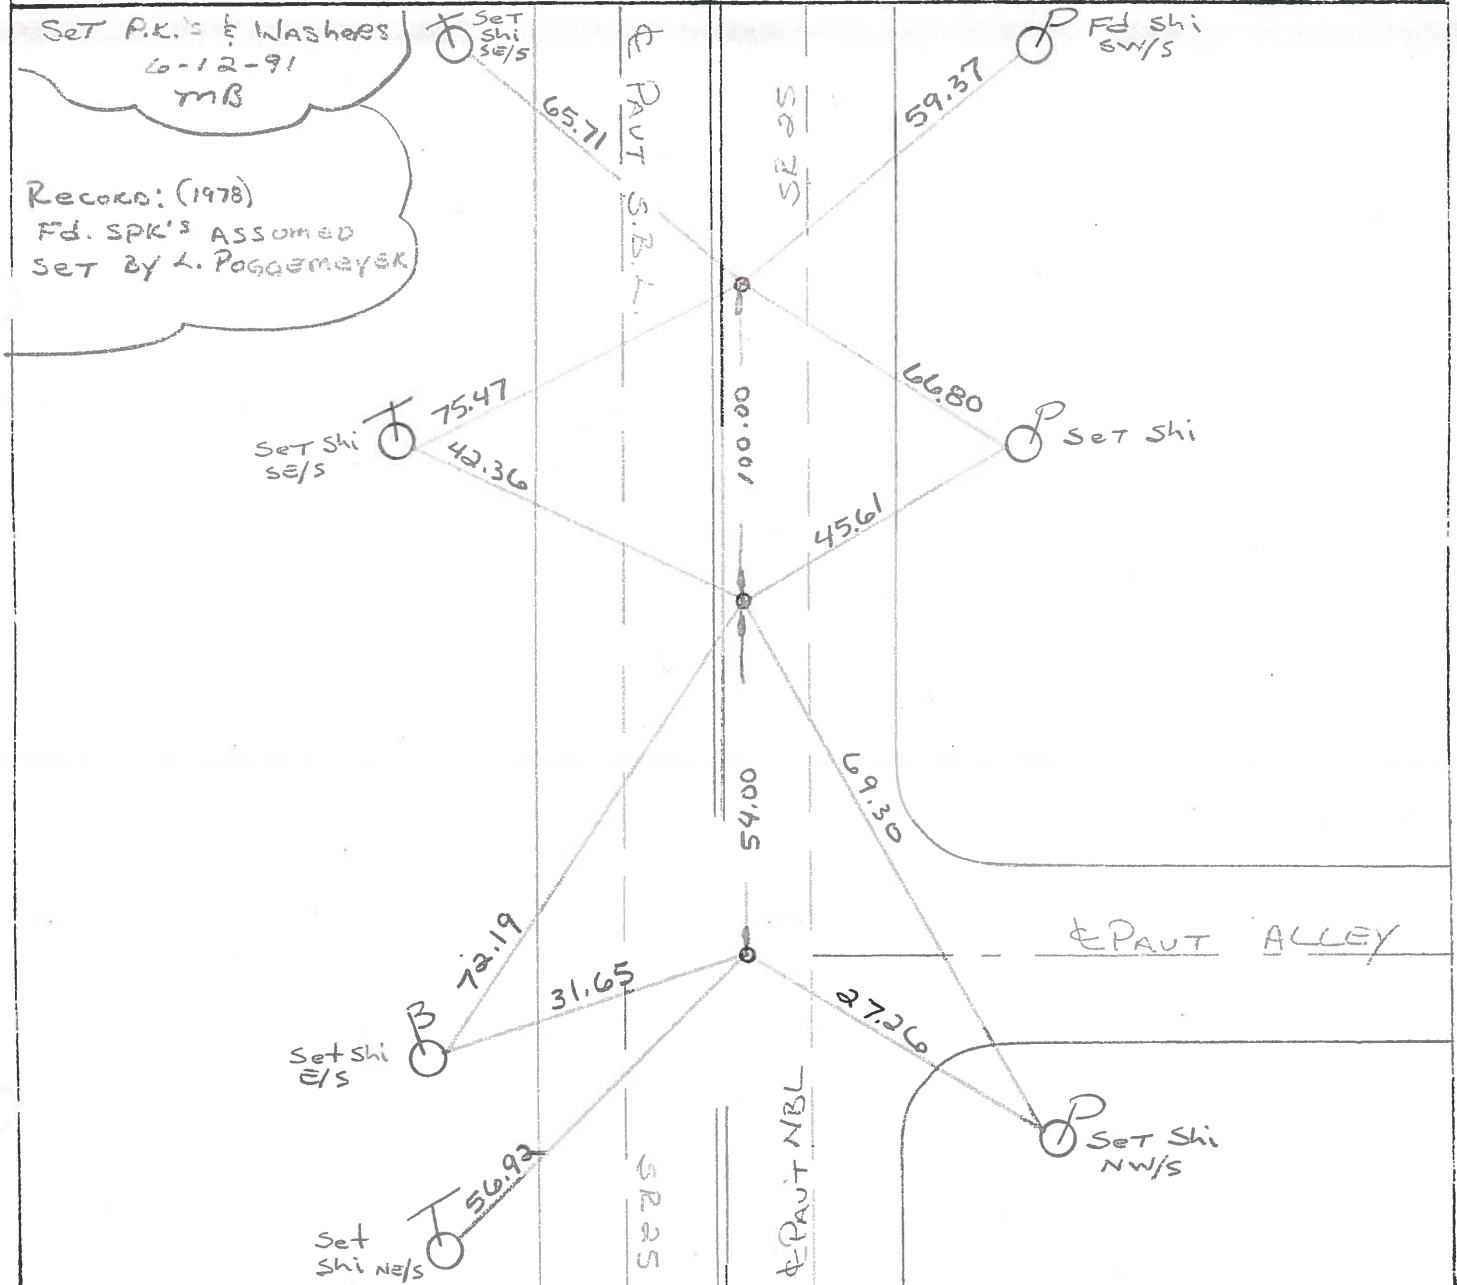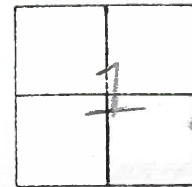

O.D.O.T. DISTRICT 2 SURVEY OFFICE

Sht. of

County Wood

Township LIBERTY

Section PORTAGE OHIO

T4N, R10E

Personnel BURNSIDE

SMITH

BOWERS

KNAPE

MEAD

Date 5-18-78


Weather CLEARING

Temp. +58°

16-A

16-B

16-C

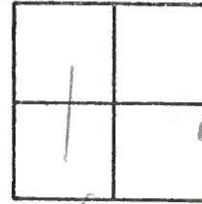

POINTS FOUND
BEFORE RESURFACING
PROJECT.

FD. SPK. ASSUMED
SET BY L. POGGEMEYER

