

O.D.O.T. DISTRICT 2 SURVEY OFFICE (USE ONLY)

PERSONNEL

REFERENCE NO. C16

SHEET OF

NOTES RHOADES

DATE 3/1/23

ROUTE SR 25

H.C. NIESE

WEATHER CLEAR

COUNTY WOOD

R.C. AUBLE

TEMP. 37°

TOWNSHIP LIBERTY

DWG BY BARRIERE

PID 92133

SECTION 1

T 4 N R 10 E

TYPE MONUMENT PK SHANK

ON SURFACE - BELOW ON

OFFSET $\varnothing$ PAVEMENT 2.6' RT LT : RT


 TO EDGE PAVEMENT

STATION: 331+54.42


HORIZ.DATUM: NAD83(11)/WOOD LDP GEOID: 18

GRID: NORTHING: 608120.430 EASTING: 1652566.244

LDP: NORTHING: 429964.814 EASTING: 163932.290

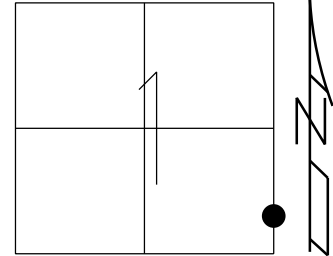

RECORD:
FD P.K./WASHER
4/16/01, BVD
SET P.K./WASHER
10-31-01, SAH
FD HOLE
REFC16
5-30-18
10-1-18, JFO
FD PK SHANK
NEWREFC16
3/1/23, TDN
FD SHANK
11/17/23, TDN

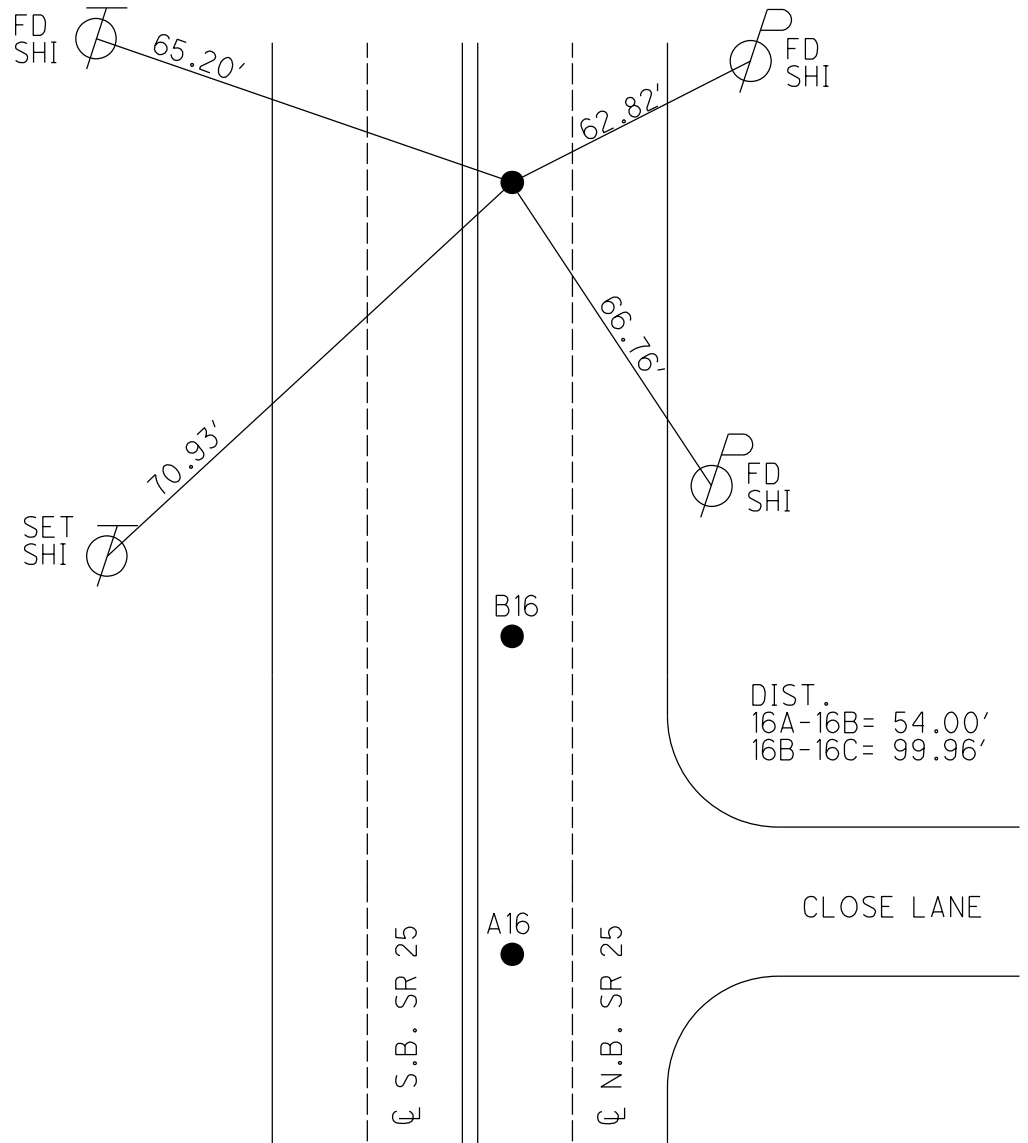

O.D.O.T. DISTRICT 2 SURVEY OFFICE (USE ONLY)

PERSONNEL

REFERENCE NO. 16 C

SHEET 32 OF 36

NOTES HUSS

DATE 4/16/01

ROUTE SR 25

H.C. ROUSOS

WEATHER CLOUDY/RAIN

COUNTY WOOD

R.C. VAN DUSEN

TEMP. 42°

TOWNSHIP LIBERTY

DWG BY MILLER

PID NO PID

SECTION 1

T 4 N R 10 E

TYPE MONUMENT P.K./WASHER

ON SURFACE - ~~BELOW~~ ON

OFFSET Q PAVEMENT 2.6' ~~LT~~ : RT

28.6' TO LT EDGE PAVEMENT


STATION: 358+99

HORIZ.DATUM: NAD83(2011)

GEOID: NAVD88 2012A

GRID: NORTHING: 608120.394

EASTING: 1652566.235

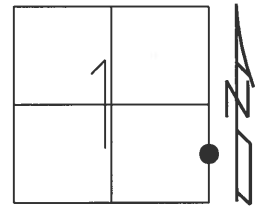

RECORD:
FD P.K./WASHER
4/16/01, BVD
SET P.K./WASHER
10-31-01, SAH
FD HOLE
REFC16
5-30-18
10-1-18, JFO

FD
SHI



65.25'

16B



16A



Q S.B. SR 25

Q N.B. SR 25

62.83'

66.78'

FD
SHI



FD
SHI



DIST.
16A-16B= 54.00'
16B-16C= 100.00'

HICTORY LANE

O.D.O.T. DISTRICT 2 SURVEY OFFICE

PERSONNEL

REFERENCE NO. _____

SHEET 18 OF 23.

NOTES Huss

H.C. Nousos

R.C. Van Dusen

DATE 4-16-61

WEATHER *Cloudy - Rain*

TEMP *+42 °F*

ROUTE *SR-25*

COUNTY Wood

TOWNSHIP Liberty

SECTION 1

T4 NR 10 E



TYPE MONUMENT PK/W All three points

ON SURFACE - ~~BELOW~~ Surf.

~~LEFT~~ - (C PAV'T. - RIGHT) 2.6' Right - All

28.6 TO 47. EDGE PAVEMENT

S.I. M. (A) = $357 + 45$ (B) = $357 + 99$ (C) = $358 + 99$

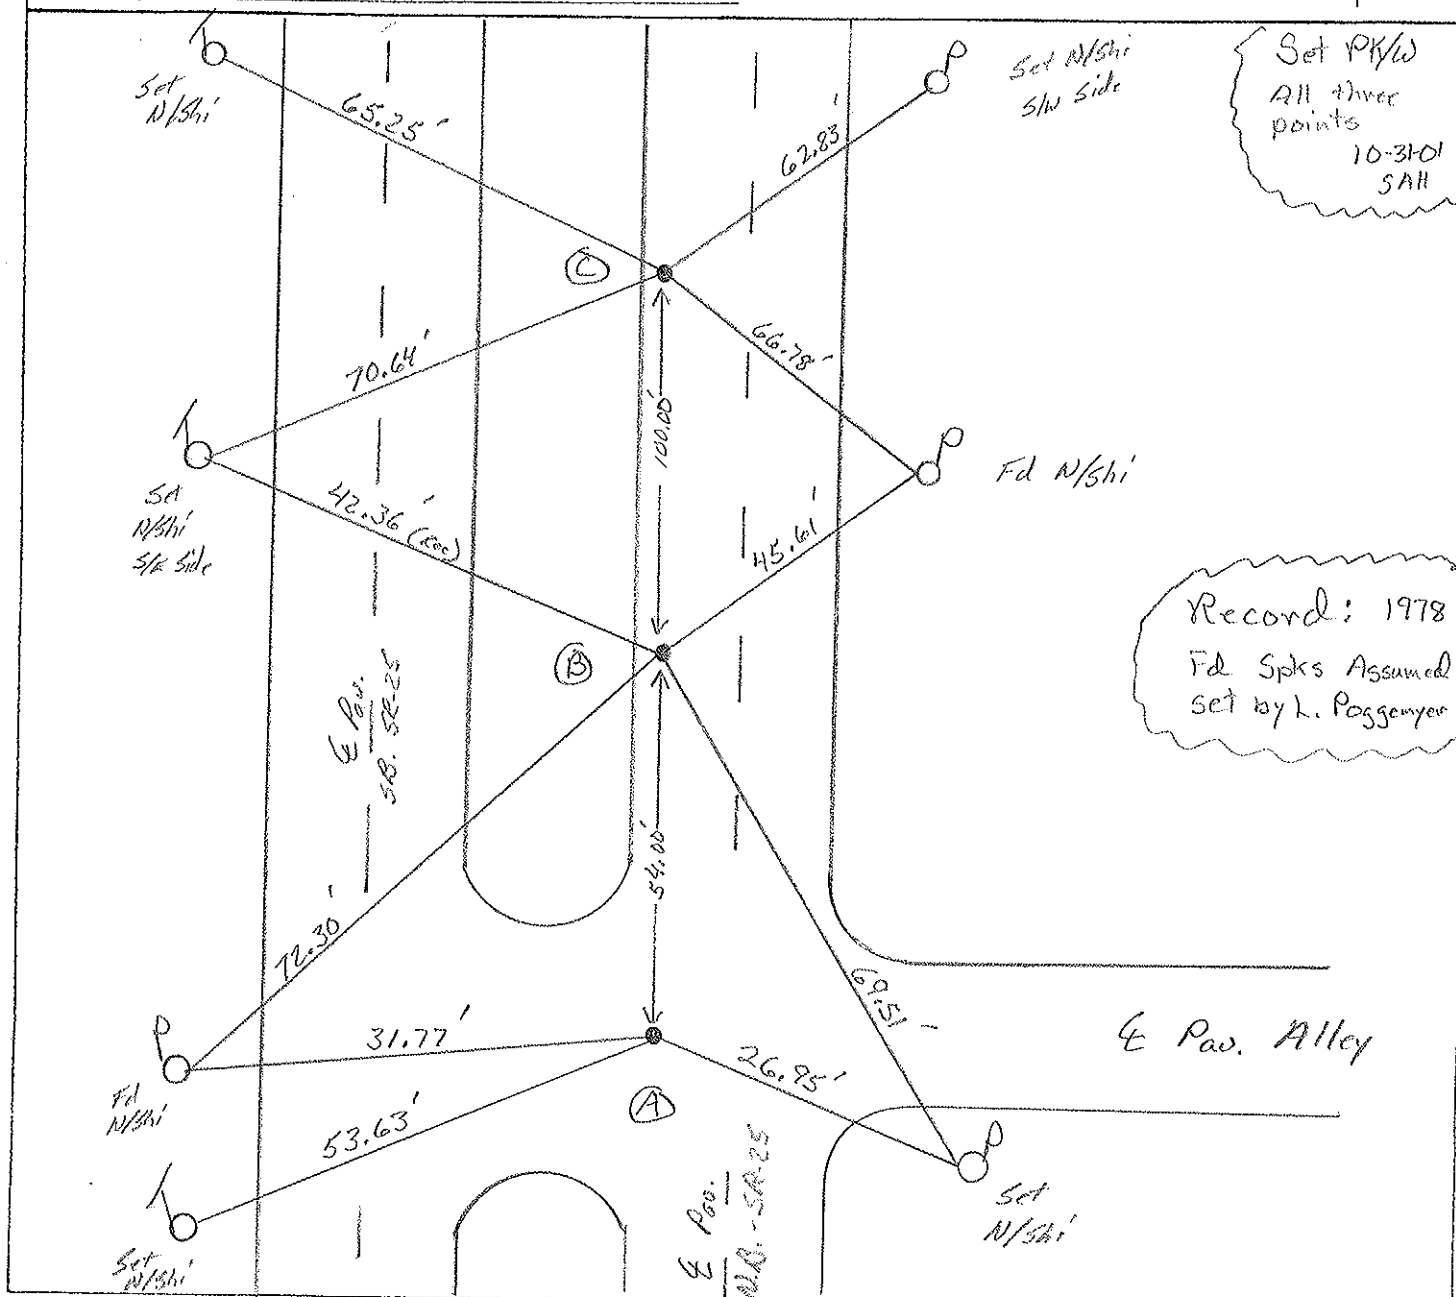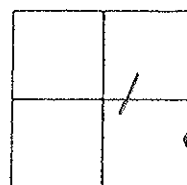

O.D.O.T. DISTRICT 2 SURVEY OFFICE

PERSONNEL

REFERENCE NO. _____

SHEET 18 OF 23

NOTES Hoffmann

H.C. LOENRICE

R.C. BARANHISEL

DATE 3-27-91

WEATHER P. CLEAR

TEMP. 55°

ROUTE SR 25

COUNTY WOOD

TOWNSHIP LIBERTYSECTION 1

T4 NR 10 E

TYPE MONUMENT P.K. NAILS (3)

~~ON SURFACE~~ - BELOW ALL 1"

~~LEFT - C PAVT.~~ - RIGHT ALL 2.6'



28.6 TO RT. EDGE PAVEMENT - CURB

S.L.M. Center Point = 357 + 99

16-A

16-B

16-C

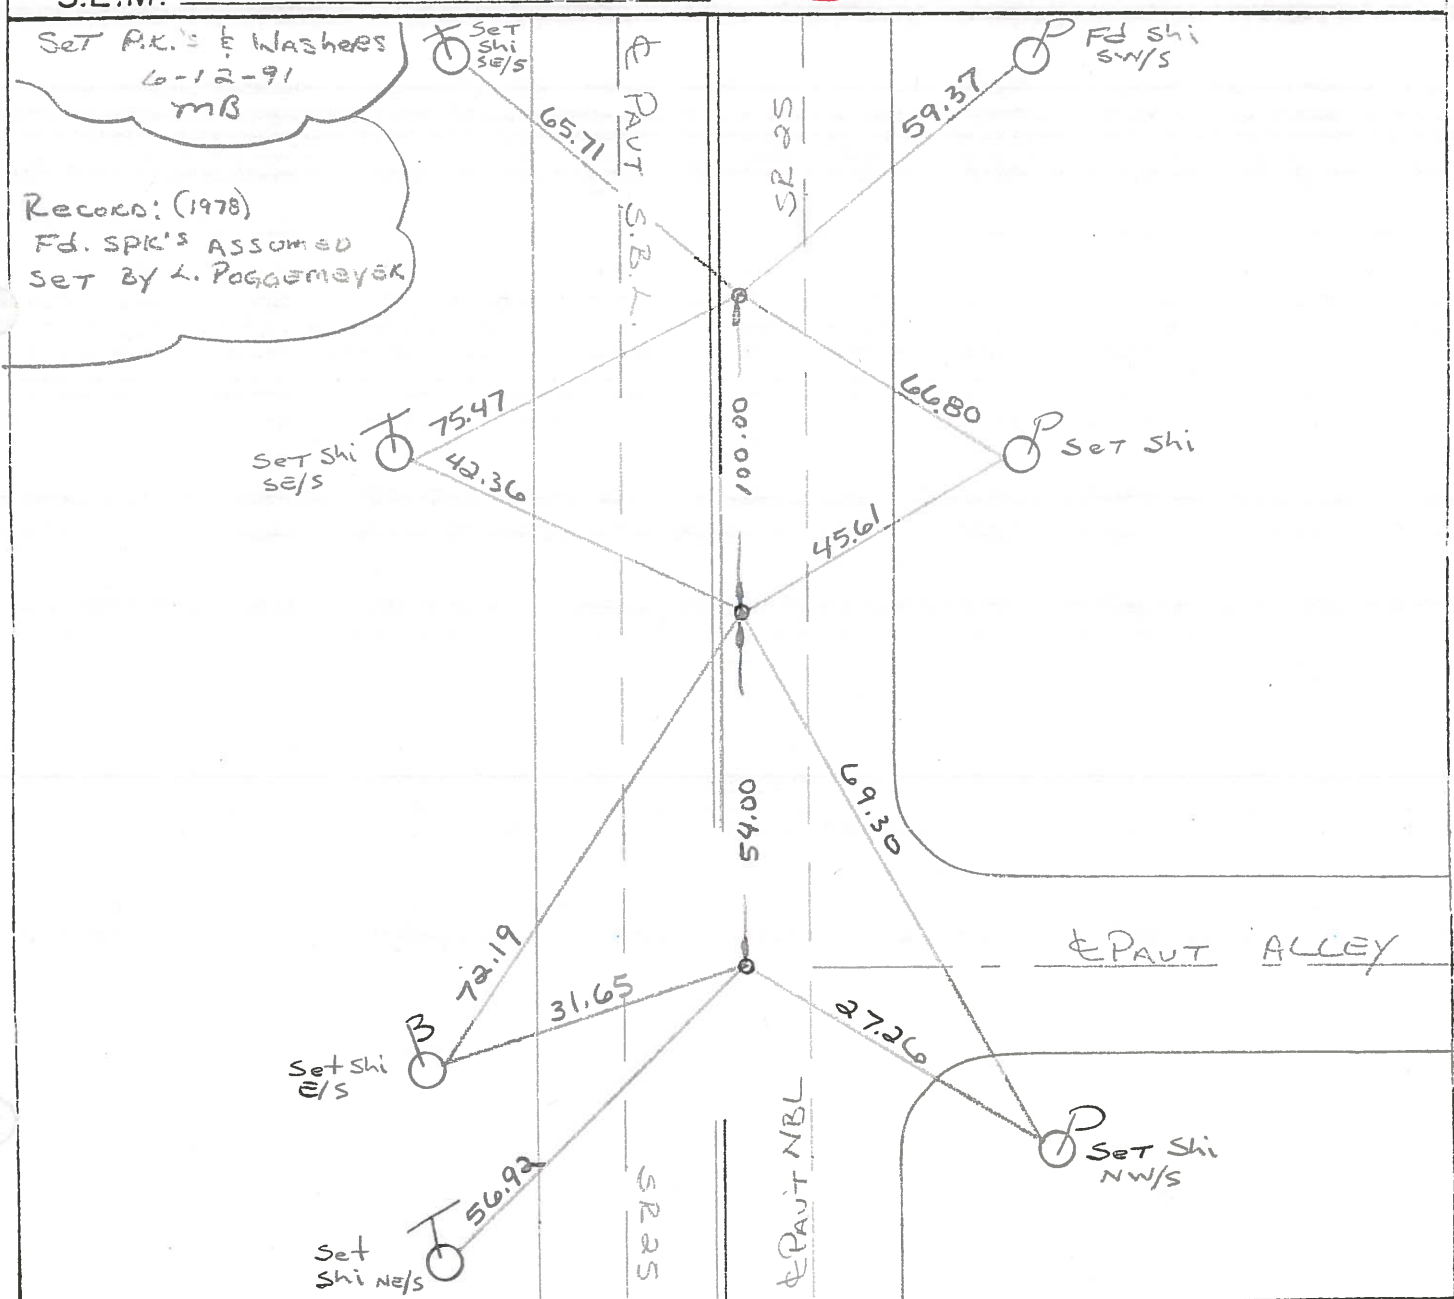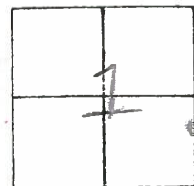

Q.D.O.T. DISTRICT 2 SURVEY OFFICE

Sht. ____ of ____

County WOOD

Date 5-18-78

Township LIBERTY

Weather CLEARING

Section PORTAGE OHIO

Temp. +58°

T4N, R10E

Personnel BURNSIDE

SMITH

BOWERS


KNAPE

MEAD

16-A

16-B

16-C

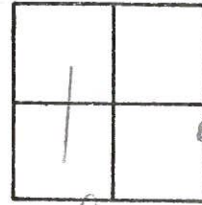

POINTS FOUND
BEFORE RESURFACING
PROJECT.

FD. SPK. ASSUMED
SET BY L. POGGEMEYER

