

O.D.O.T. DISTRICT 2 SURVEY OFFICE (USE ONLY)

PERSONNEL

REFERENCE NO. 17

SHEET OF

NOTES RHOADES

DATE 11/20/23

ROUTE SR 25

H.C. NIESE

WEATHER CLEAR

COUNTY WOOD

R.C. AUBLE

TEMP. 37°

TOWNSHIP PORTAGE

DWG BY BARRIERE

PID 92133

SECTION 6

T 4 N R 11 E

TYPE MONUMENT MONBOX W/ 1" IPIN

ON SURFACE - BELOW ON

OFFSET CL PAVEMENT 7.4' RT (SB LANE) LT : RT


 TO EDGE PAVEMENT

STATION: 343+06.76

HORIZ.DATUM: NAD83(11)/WOOD LDP GEOID: 18


GRID: NORTHING: 609272.516 EASTING: 1652580.826

LDP: NORTHING: 431117.079 EASTING: 163931.680

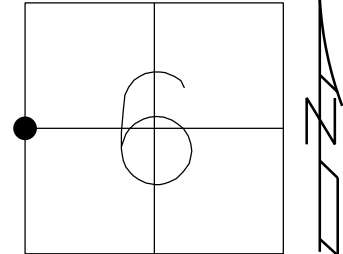

RECORD:
W 1/4 SEC 6

PORTAGE CORP LINE EAST
FD BRASS MON
FD SM.R.R.SPIKE
4/16/01, BVD
SET P.K./WASHER
6-12-91, MB
SET P.K./WASHER
10-31-01, SAH
FD HOLE
5-30-18, JFO
FD MAG NAIL
PREREF17
3/1/23, TDN
FD NEW MONBOX
W/ 1" IPIN
NEWREF17
11/20/23, TDN

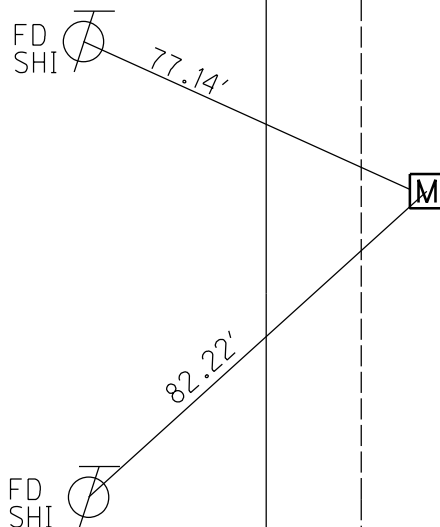

CL S.B. SR 25

CL N.B. SR 25

****NOTE****

POINT WAS ADJUSTED PER
WOO-25-0.75, PID 92133 PLANS.
SEE PLANS FOR PRIOR COORDINATES
AND INFORMATION.

**** ****

O.D.O.T. DISTRICT 2 SURVEY OFFICE (USE ONLY)

PERSONNEL

REFERENCE NO. 17

SHEET 33 OF 36

NOTES HUSS

DATE 4/16/01

ROUTE SR 25

H.C. ROUSOS

WEATHER CLOUDY/RAIN

COUNTY WOOD

R.C. VAN DUSEN

TEMP. 41°

TOWNSHIP LIBERTY

DWG BY MILLER

PID NO PID

T 4 N R 10 E

TYPE MONUMENT SM.R.R.SPIKE

ON SURFACE - ~~BELOW~~ ON

OFFSET 5.4' LT : RT

- TO - EDGE PAVEMENT


STATION: 370+52

HORIZ.DATUM: _____


GEOID: _____

GRID: NORTHING: _____

EASTING: _____

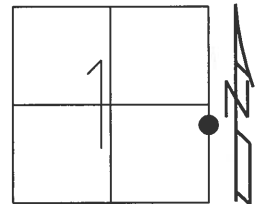

RECORD:
PORTAGE CORP LINE EAST
FD BRASS MON
FD SM.R.R.SPIKE
4/16/01, BVD
SET P.K./WASHER
6-12-91, MB
SET P.K./WASHER
10-31-01, SAH
FD HOLE
5-30-18, JFO

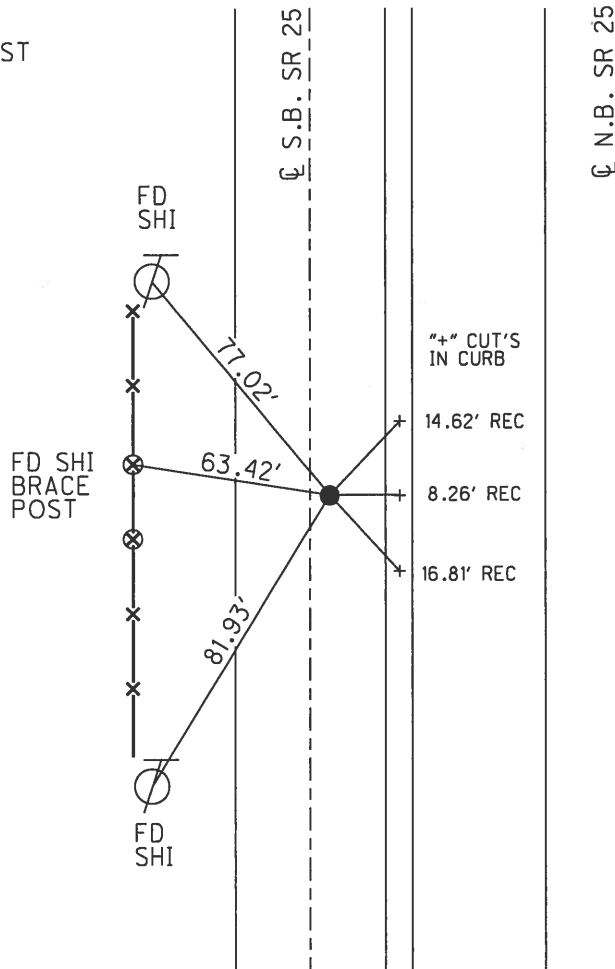

O.D.O.T. DISTRICT 2 SURVEY OFFICE

PERSONNEL

REFERENCE NO. 17

SHEET 19 OF 23

NOTES Huss

H.C. Rousos

R.C. Van Dusen

DATE 4-16-61

WEATHER Cloudy - Rain

TEMP. 41°F

ROUTE SVE-25

COUNTY Wood

TOWNSHIP Liberty

SECTION 1

THNR 10 E


TYPE MONUMENT Small RR. Spk.

(ON SURFACE) - ~~BELOW~~ surface

LEFT - & PAW'T. - RIGHT 5.4' East. of & Paw. SIB. Lane

____JO____EDGE PAVEMENT

S.L.M. 370752

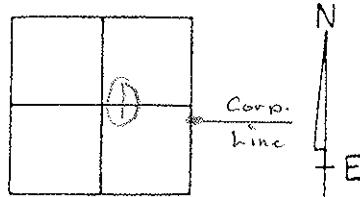

Record:

Portage Corp Line
Fast - (Brass Mon.)

Record:

Set PK/A)

M.B.

6-12-91

Set
N/5th

Set N/Shi
in N. Brace
Post

Set N/shi'

W 158-23 Pas.

Rel.
+ Cut
T.O.C.

Rec¹
+ Cut
T.O.C.

Rec:
+ Cut
TAC

Set PK/w
76-31-01
SAH

W. P.O.
NB - SR-2.5

O.D.O.T. DISTRICT 2 SURVEY OFFICE

PERSONNEL

REFERENCE NO. 17

SHEET 19 OF 23

NOTES HOFFMAN

H.C. LOCHRIE

DATE 3-27-91

ROUTE SR 25

R.C. BARWISSEL

WEATHER P. CLEAR

COUNTY WOOD

TEMP. 55°

TOWNSHIP LIBERTY

SECTION 1


T4 N R 10 E

TYPE MONUMENT SMALL RR SPR


ON SURFACE - BELOW YES

LEFT- & PAW'T. - RIGHT 5.4' EAST of & PAUT OF THE
TO EDGE PAVEMENT SOUTHBOUND LANE

S.L.M. 370+52

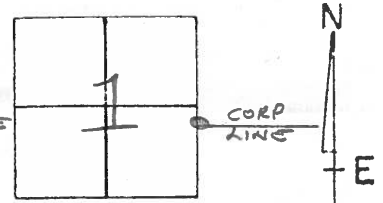

Set P.K. & Washers
6-12-91
MB

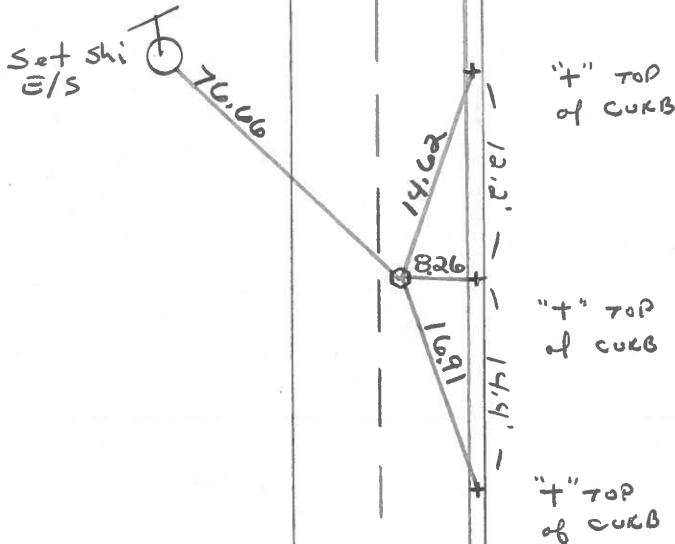

RECORD:
PORTAGE CORP LINE
EAST
BRASS MONUMENT

SR 25

& PAUT NBL

SR 25

ODOT DISTRICT 2 SURVEY OFFICE

SHEET _____ OF _____

County WOOD ^{U.S.} ~~S.R.~~ 25

Township LIBERTY

Section 1

T4N, R10E

Personnel BURNSIDE

SMITH


BOWERS

HOLCOMBE


Date 5-24-71 ^{O.K. 5-18-78}

Weather RAIN

Temp. 70°

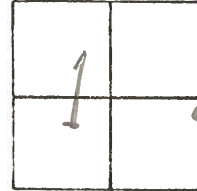

#17

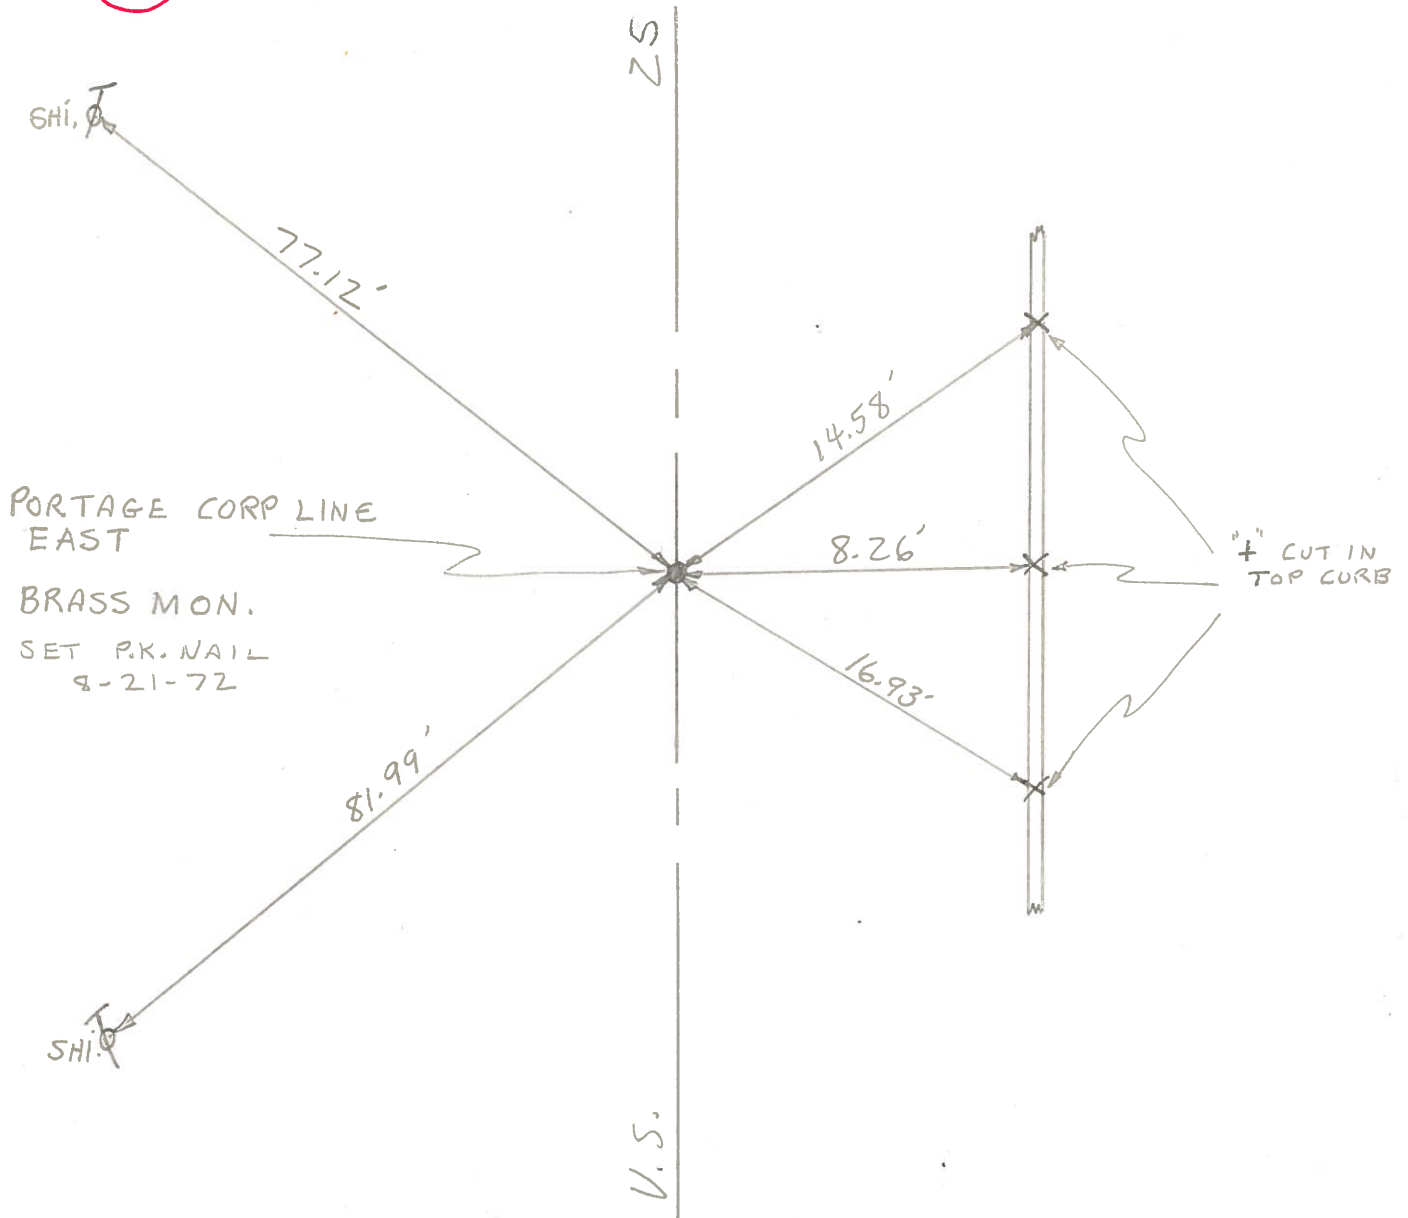

PERSONNEL

TITLE

PERSONNEL

TITLE

COUNTY

Wood

DATE

4-7-60

S. R.

U.S. #25

WEATHER

SEC.

TEMP.

DESCRIPTION

LEFT

CENTER LINE

RIGHT

JOB NO.

Sta. 560+05.10
Portage Corp Line East
Brass plate

(13)

#241

Shiner in End Post E.N.E. 29.74
Shiner in P.P. E.N.E. 40.35 40.49
Shiner in T.P. N.W. 39.92
Shiner in 12' Evergreen W.N.W. 56.93
Shiner in 30' Elm W. 64.10
Wedge post. 11.63' E edge 12.32'
Shiner 16" Maple S.E. 68.47

Sta. 562+44.4
Portage Corp. West
Brass plug, ~~top of bridge~~

(14)

#242

Shiner in Anchor Post N.E. 62.63
Shiner in T.P. N.W. 44.15
Shiner in T.P. S.W. 91.00
Shiner in P.P. S.E. 70.48 73.05
Wedge post. 11.83 E edge 12.12
Shiner in End Post N.N.E. 88.86
Iron Fence Post East 29.03

Sta. 588+94.96
S.E. cor. Sec. 1 Liberty Twp.
N.E. cor. sec. 12 Liberty Twp.
Iron rod on top of
Stone, center of portage

(15)

#243

Note
See sheets
6A-6B
New. wit.

Shiner in P.P. W.S.W. ^{69.69} 69.72
Shiner in P.P. S.E. 53.89 42.75
Iron pin in brick sidewalk S.E. 43.3
S.E. Cor. gas. Sta. N.W. 80.56
Town Pump N.W. (14 above rd) 68.56
Shiner T. Pole N.W. 58.66
Shiner T. Pole N.E. 58.46

Sta. 612+96.65
W. 1/4 post sec. 6 Portage
Twp.
Brass plate

(17)

#244

~~Shiner in P.P. S.E. 47.96~~
~~Shiner in T.P. S.S.W. 69.78~~
~~Shiner in T.P. N.N.W. 69.94~~
Shiner in T. Pole N.W. 77.20
Shiner in T. Pole S.W. 81.98
"X" cut in curb East 08.25
"X" cut in curb N.E. 14.60
"X" cut in curb S.E. 16.90