

# O.D.O.T. DISTRICT 2 SURVEY OFFICE (USE ONLY)

PERSONNEL

REFERENCE NO. A17

SHEET      OF     

NOTES ASTON  
H.C. NIESE  
R.C. MILLER

DATE 11/15/23  
WEATHER CLEAR  
TEMP. 60°

ROUTE SR 25  
COUNTY WOOD  
TOWNSHIP LIBERTY  
SECTION 1

DWG BY BARRIERE PID 92133

T 4 N R 10 E

TYPE MONUMENT MAG/WASHER

ON SURFACE - BELOW ON

OFFSET  $\varnothing$  PAVEMENT 1' RT (SB LANE) LT : RT


     TO      EDGE PAVEMENT

STATION: 345+52.92


HORIZ.DATUM: NAD83(11)/WOOD LDP GEOID: 18

GRID: NORTHING: 609518.698 EASTING: 1652583.630

LDP: NORTHING: 431363.294 EASTING: 163931.238

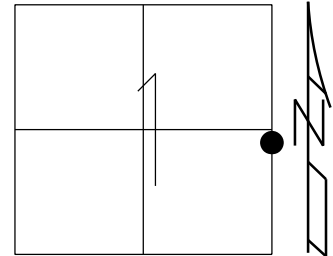

RECORD:  
PORTAGE CORP LINE WEST  
SECTION 1  
EAST  $\frac{1}{4}$  COR  
STA. 615+42.12  
1950  
FD P.K./NAIL  
1 1/2" DOWN  
FD P.K./WASHER  
4/16/01, BVD  
SET P.K./WASHER  
10-31-01, SAH  
FD HOLE  
5-30-18, JFO  
FD P.K. SHANK  
NEWREFA17  
3/1/23, TDN  
SET MAG/WASHER  
11/15/23, TDN

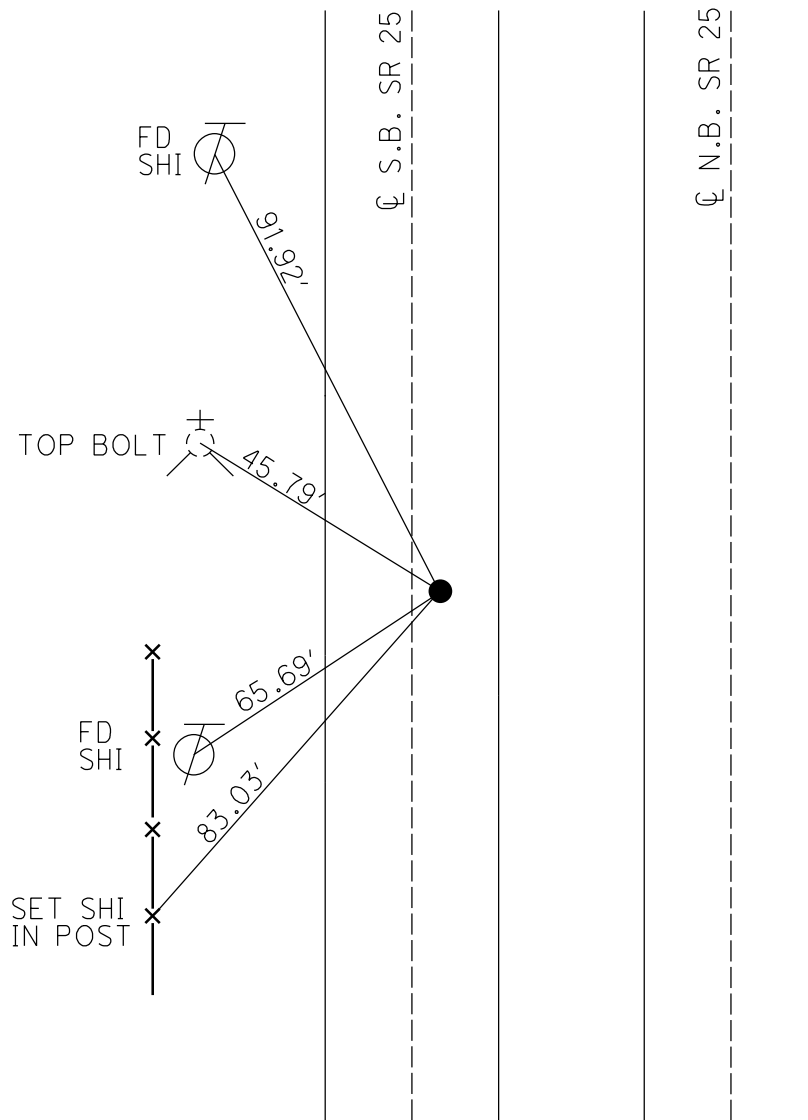

# O.D.O.T. DISTRICT 2 SURVEY OFFICE (USE ONLY)

PERSONNEL

REFERENCE NO. 17 A

SHEET 34 OF 36

NOTES HUSS DATE 4/16/01  
H.C. ROUSOS WEATHER CLOUDY/WINDY  
R.C. VAN DUSEN TEMP. 41°

ROUTE SR 25  
COUNTY WOOD  
TOWNSHIP LIBERTY  
SECTION 1  
T 4 N R 10 E

DWG BY MILLER PID NO PID

TYPE MONUMENT P.K./WASHER

ON SURFACE - ~~BELOW~~ ON


OFFSET Q PAVEMENT 2.6' LT : RT

20.2' TO RT EDGE PAVEMENT

STATION: 372+98


HORZ.DATUM: \_\_\_\_\_ GEOID: \_\_\_\_\_

GRID: NORTHING: \_\_\_\_\_ EASTING: \_\_\_\_\_

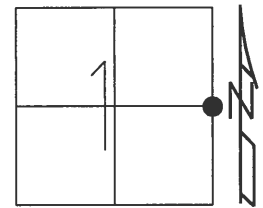

RECORD:  
PORTAGE CORP LINE WEST  
SECTION 1  
EAST 1/4 COR  
STA. 615+42.12  
1950  
FD P.K./NAIL  
1 1/2" DOWN  
FD P.K./WASHER  
4/16/01, BVD  
SET P.K./WASHER  
10-31-01, SAH  
FD HOLE  
5-30-18, JFO

SET NOTCH  
2' UP PORTAGE  
CORP SIGN

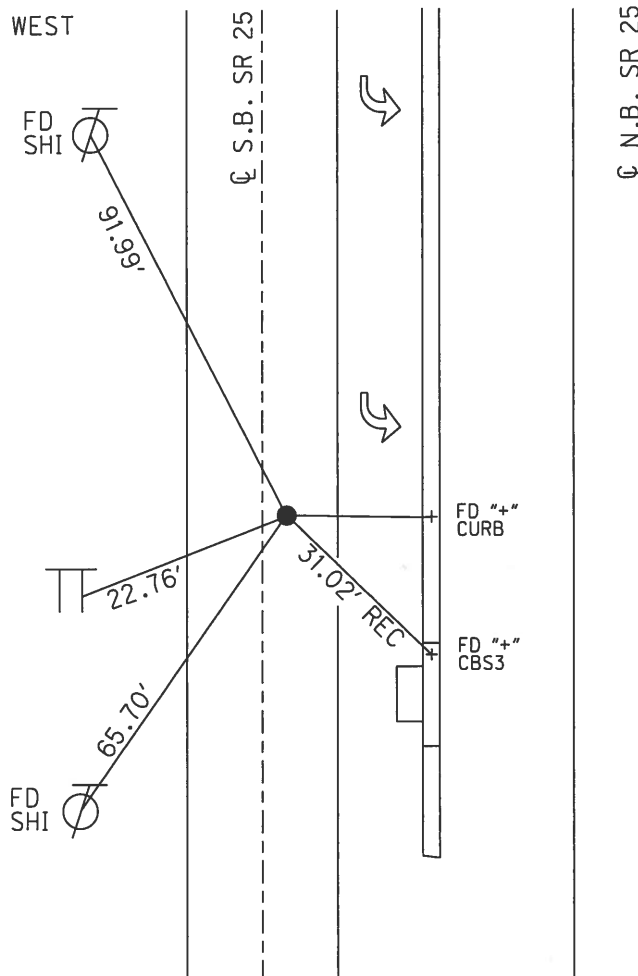

# O.D.O.T. DISTRICT 2 SURVEY OFFICE

PERSONNEL

REFERENCE NO. 17-A

SHEET 20 OF 23

NOTES Huss

H.C. Roussos

R.C. Dan Dusen

DATE 4-16-01

WEATHER Cloudy - Rain

TEMP. 41°F

ROUTE SR-25

COUNTY Wood

TOWNSHIP Liberty

SECTION 1

T4 N R 10 E


TYPE MONUMENT PK/W

ON SURFACE - ~~BELOW~~ Surface

~~100'~~ - (E) PAV'T. - RIGHT 2.6' East - E Pav. S.B. Lanes

20.2' TO <sup>EAST</sup> <sub>RT.</sub> EDGE PAVEMENT

S.L.M. 372+98 (268' ± S. of Powell Rd)

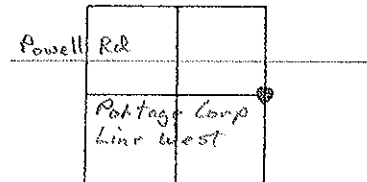

Record: 1950

Plan Sta - 615+42.12

Record: Fd PK/Wail

1 1/2" Below Surf.

Set PK/W

10-31-01

SAH

Fd  
N/Sht

PK/W  
SR-25

Turn Lane

PK/W  
SR-25

Portage Corp Line (West)

Point is E. 1/4 Corner  
Section 1

Set Notch  
2' up on  
Portage Corp.  
Sign

Fd  
N/Sht

Fd "cut  
TOC

Fd "cut  
curb for  
drain inlet

91.99'

22.76'

65.70'

31.02' Rec.

# O.D.O.T. DISTRICT 2 SURVEY OFFICE

PERSONNEL

REFERENCE NO. 17-A

SHEET 20 OF 23

NOTES BARNHISEL

H.C. " "

R.C. VEAGER

KUSZ

DATE 6-21-91

WEATHER CLEAR

TEMP. + 85°

ROUTE S.E. 25

COUNTY WOOD

TOWNSHIP LIBERTY

SECTION 1

T 4 N R 10 E

TYPE MONUMENT P.K. & WASHER

ON SURFACE - ~~BELOW~~ YES


LEFT - E PAV'T. - RIGHT 2.6 EAST of & PAUT

20.2 TO RT <sup>"EAST"</sup> EDGE PAVEMENT

S.L.M. 372+98


NOTE: This Point is 268±

SOUTH OF Powell Rd.

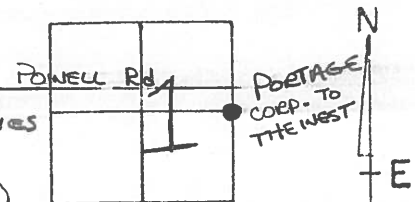

Record:

FD P.K. Nail  
1 1/2" Below Surface

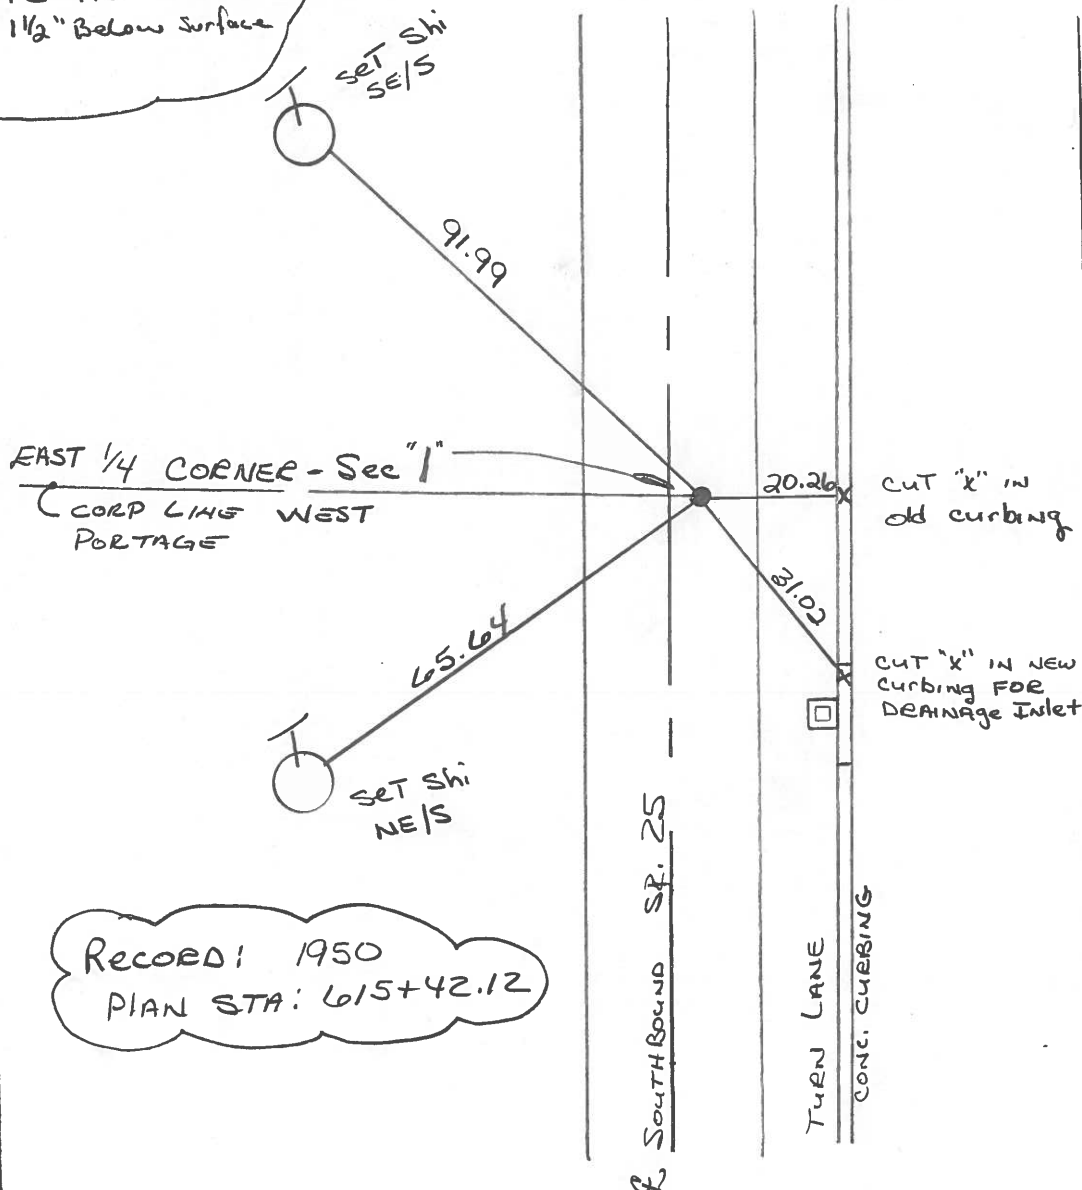

RECORD: 1950  
PLAN STA: 615+42.12