


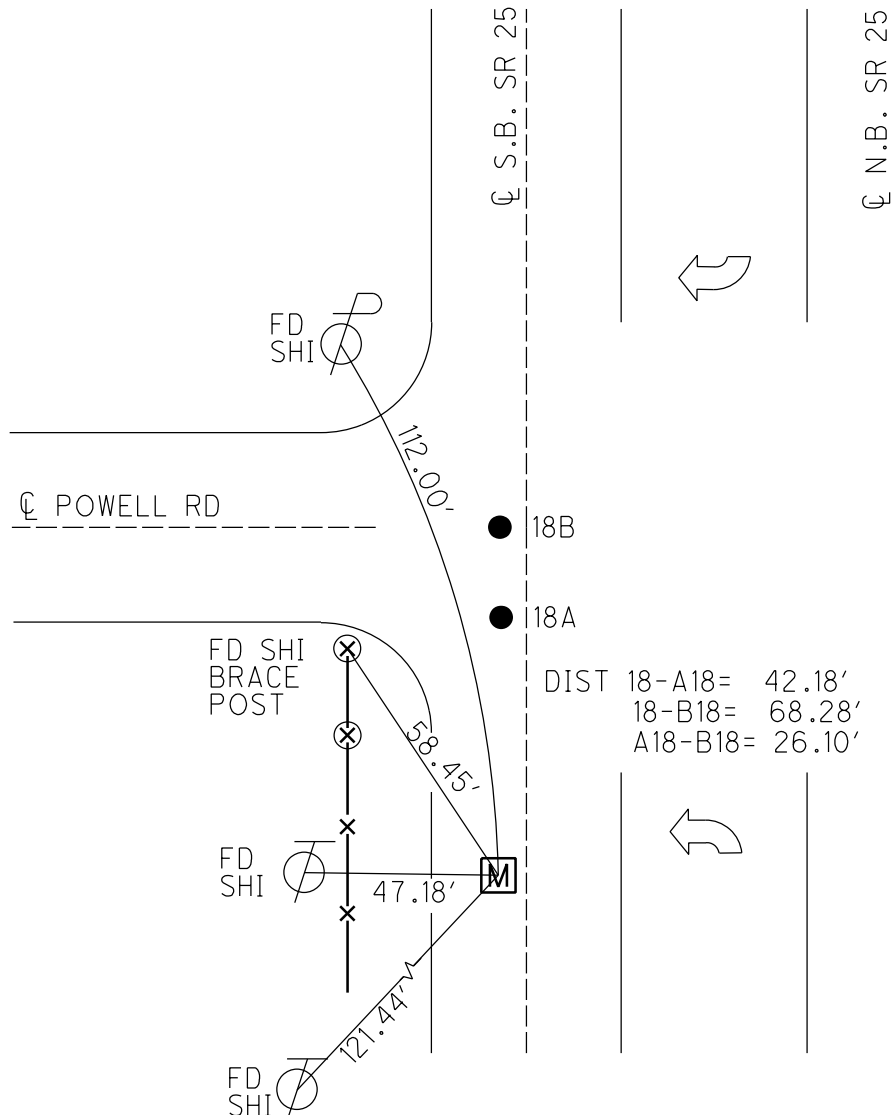

O.D.O.T. DISTRICT 2 SURVEY OFFICE (USE ONLY)

PERSONNEL

REFERENCE NO. 18

SHEET 35 OF 36

NOTES HUSS
H.C. ROUSOS
R.C. VAN DUSEN

DATE 4/16/01
WEATHER CLOUDY/WINDY
TEMP. 41°

ROUTE SR 25
COUNTY WOOD
TOWNSHIP LIBERTY
SECTION 1

DWG BY MILLER PID NO PID

T 4 N R 10 E

TYPE MONUMENT P.K./WASHER

ON SURFACE - ~~BELOW~~ ON

OFFSET 1.7' LT : RT

13.2' TO LT EDGE PAVEMENT


STATION: 374+92

HORIZ.DATUM: NAD83(2011)

GEOID: NAVD88 2012A

GRID: NORTHING: 609712.404


EASTING: 1652586.402

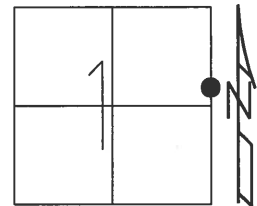

RECORD:

STA. 617+37.14
FD BRASS MON
1950
FD SM.R.R.SPIKE
3-27-91, SWH
FD P.K./WASHER
4/16/01, BVD
SET P.K./WASHER
10-31-01, SAH
FD MAG NAILS
REF18
5-30-18
10-1-18, JFO

DIST.18-18A= 68.22'

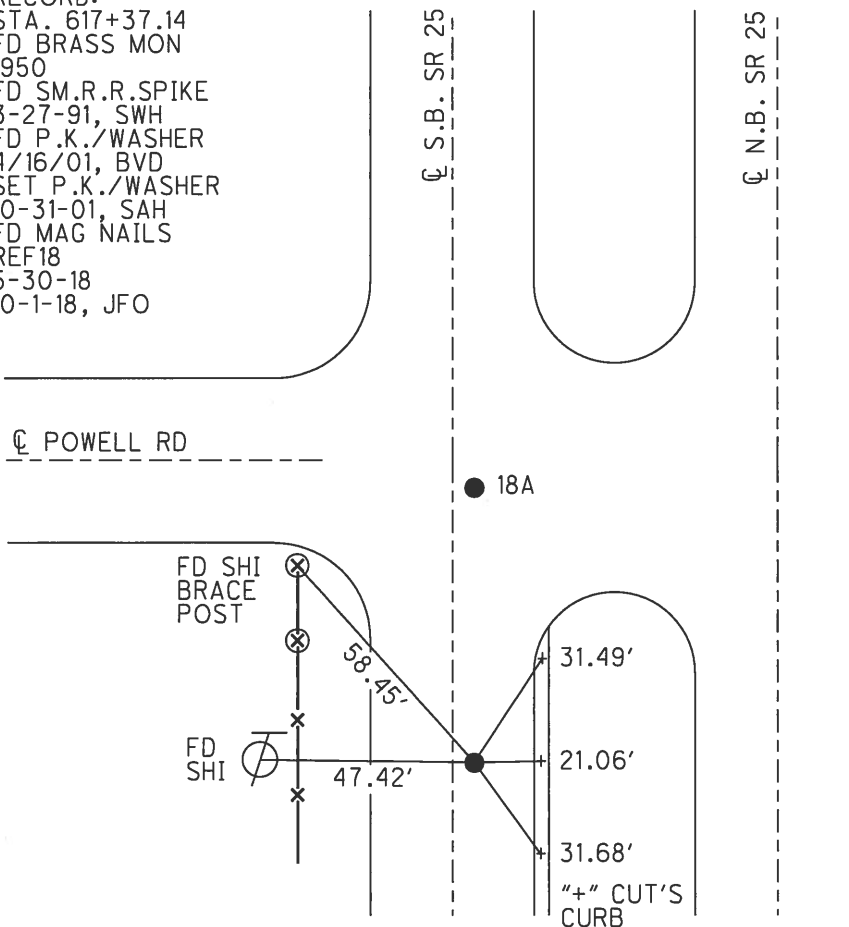

O.D.O.T. DISTRICT 2 SURVEY OFFICE

PERSONNEL

REFERENCE NO. 18

SHEET 21 OF 23

NOTES Huss

H.C. Rollins

R.C. Van Dusen

DATE 4-16-01

WEATHER Cldy - Rain

TEMP. 41°F

ROUTE SR-25

COUNTY Wood

TOWNSHIP Liberty

SECTION 1

T 4 N R 10 E


TYPE MONUMENT PK/W (Both Points)

ON SURFACE - ~~BELOW~~ surface

LEFT & PAVT - RIGHT 1.7' East 4' of S.B. Lane

13.2' TO West EDGE PAVEMENT


S.L.M. (A) - 374192 (B) - 375160.22

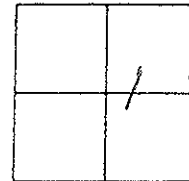

Record:
Brass Mon.
Poss. 1950 Phon
Sta. 617+37.11

Record:
(A) = Sm RR Spk
(B) = PK
SWH 3-27-91

SA PK/W
10-31-01
SAH

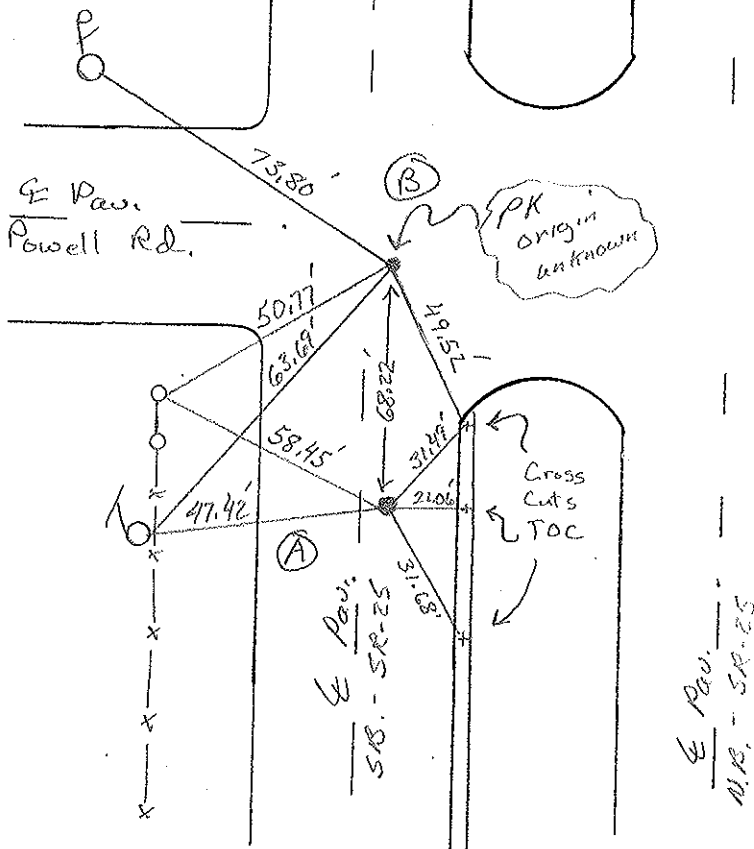

O.D.O.T. DISTRICT 2 SURVEY OFFICE

PERSONNEL

REFERENCE NO. 18

SHEET 21 OF 23

NOTES HOFFMAN

H.C. LOHRKE

R.C. BARNHISEL

DATE 3-27-91

WEATHER P. CLEAR

TEMP. 55°

ROUTE SR 25

COUNTY WOOD

TOWNSHIP LIBERTY

SECTION 1

T4 N R 10 E

"A"

"B"


TYPE MONUMENT SMALL RR SPK & P.K.

ON SURFACE - BELOW YES - YES

LEFT- & PAV'T. - RIGHT 1.7' EAST of & Part of the
Southbound Lanes

13.2 TO West EDGE PAVEMENT

S.L.M. "A" = 374 +92

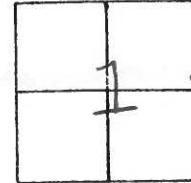

Set P.K.'s & Washers
6-12-91
MB

RECORD:

BRASS MONUMENT
ALSO - POSSIBLE IT IS
1950 PLAN STATION OF
617+37.14

& PAVT POWELL Rd
WEST CORP LINE
PORTAGE

FD P.K.
ORIGIN IS
UNKNOWN

48.15

49.52

07.87

65.13

21.06

31.08

FD. "A" IS CUT TOP of CURBS

SR 25

SR 25

& PAVT NBL

ODOT. DISTRICT 2 SURVEY OFFICE

SHEET _____ OF _____

County WOOD ^{U.S.} ~~S.R.~~ 25

Township LIBERTY

Section 1

T4N, R10E

Personnel BURNSIDE

SMITH


BOWERS

HOLCOMBE

Date 5-24-71 ^{O.K. 5-18-78}

Weather RAIN

Temp. 70°

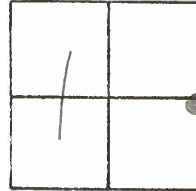


#18

SHI. END
FENCE POST

SHI.

BRASS MON.
P.I.

SET P.K. NAIL
8-21-72

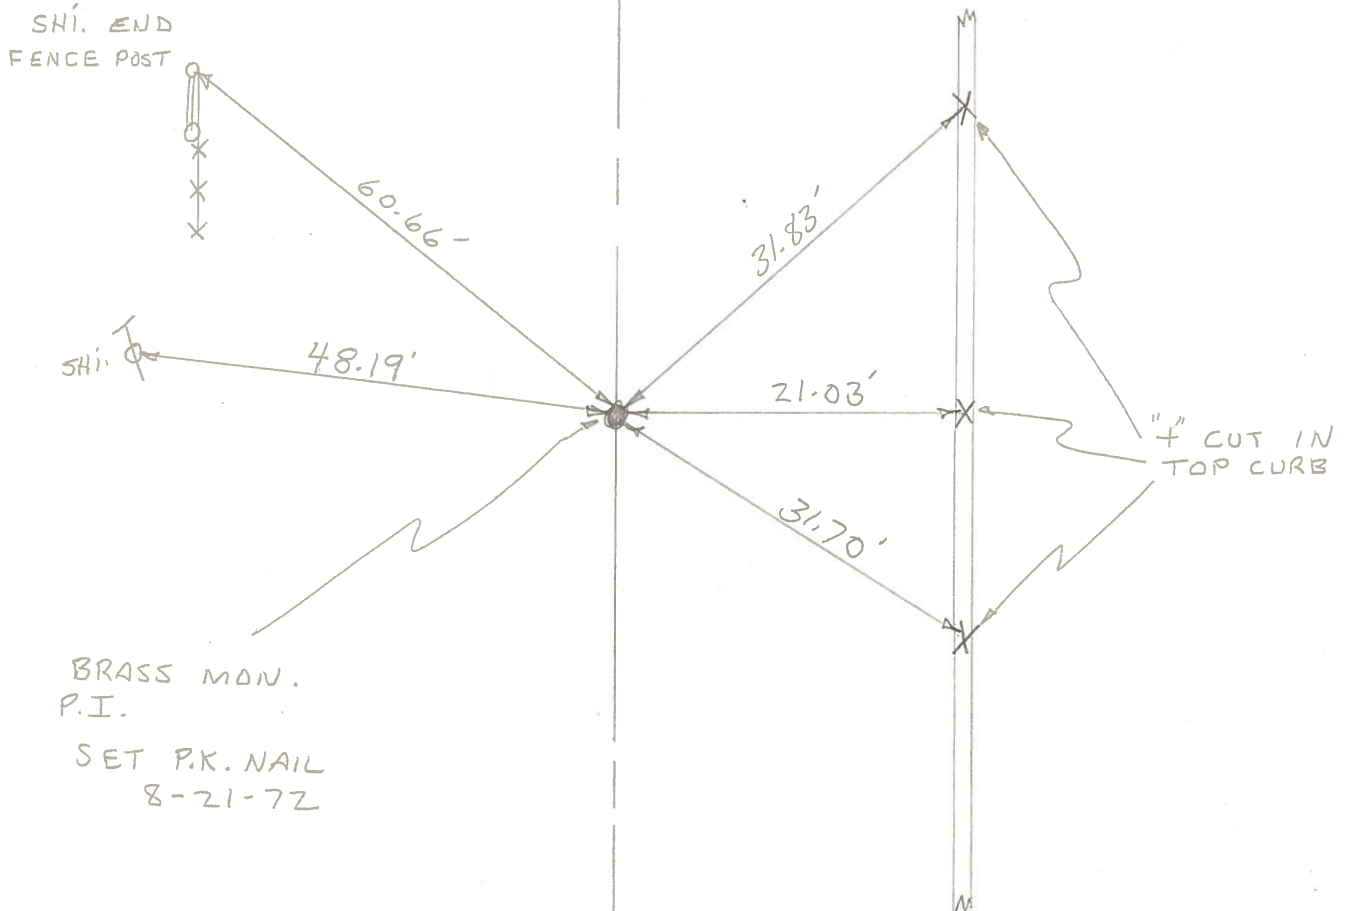

PERSONNEL

TITLE

PERSONNEL

TITLE

COUNTY

Wood

DATE

S. R.

U.S. #25

WEATHER

SEC.

TEMP.

DESCRIPTION

LEFT

CENTER LINE

RIGHT

JOB NO.

Sta. 617+37.14

E 1/4 post sec. 1 Liberty

Twp. 65.0' South Powell Ed.

Brass plate

(18)

#245

Shiner in T. Pole N.W.

48.16'

Shiner in P.P. S.S.E.

75.20'

~~Shiner in T.P. N.W.~~~~36.28'~~

Shiner in T.P. S.S.W.

115.47'

"X" in curb East

20.97

Shiner in End Post N.N.W.

60.51'

"X" in curb

N.E.

31.63

"X" in curb

S.E.

31.83

Shiner in Anchor Post N.W.

62.65

Iron cor. post S.W.

39.45

Shiner in T.P. N.N.W.

71.73 ~~60.68~~

Shiner in P.P. N.E.

46.37'

Shiner in P. Pole S.W.

57.80

Shiner in Anchor Post S.S.W.

64.15

Sta. 645+32.8

S.W. cor. sec. 31 Center

Twp. & Portage twp. line W.

Brass plate, intersection

of ~~sec. 31~~ ~~PL 5~~ Kramer Ed.

(19)

#246

Note
see sheets
6A-6B
New
wit.

Sta. 671+72.35

W 1/4 post sec. 31 Center

Twp.

Brass plate

#247

Shiner in P.P. N.N.E.

76.37

Shiner in W. TT pole N.W.

34.25' ~~58.85~~

conc. R/W mon. W.

29.91

Shiner in P. Pole S.W.

110.22

Sta. 698+37.3

S.E. cor. sec. 25 Plain Twp.

Gypsy lane Rd.

Brass plate

(Could not
Raise)

(21)

#248

Shiner T. Pole N.W.

84.10

Shiner in 12" Walnut N.W.

58.65

Shiner in P.P. E.

82.04 ~~41.33~~

N.E. cor. gas sta. (Bldg proper)

S.W. 96.17'

Shiner in light Pole S.W.

77.30