

O.D.O.T. DISTRICT 2 SURVEY OFFICE (USE ONLY)

PERSONNEL

REFERENCE NO. A18/B18

SHEET OF

NOTES ASTON
H.C. NIESE
R.C. PRESTON-COLVIN

DATE 5/15/24
WEATHER CLEAR
TEMP. 65°

ROUTE SR 25
COUNTY WOOD
TOWNSHIP LIBERTY
SECTION 1

DWG BY BARRIERE PID 92133

T 4 N R 10 E

TYPE MONUMENT MAG NAIL/WASHER

ON SURFACE - BELOW ON

OFFSET Q PAVEMENT 2.7' LT (SB LANE) LT : RT


 TO EDGE PAVEMENT

STATION: 348+14.90

HORIZ.DATUM: NAD83(11)/WOOD LDP GEOID: 18


GRID: NORTHING: 609754.543 EASTING: 1652586.790

LDP: NORTHING: 431599.178 EASTING: 163931.287

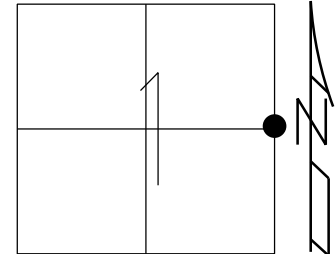

RECORD:(18A)
ORIGIN UNKNOWN
FD P.K.NAIL
3-27-91, SWH
FD P.K./WASHER
4/16/01, BDV
SET P.K./WASHER
10-31-01, SAH
FD MAG NAILS
REFA18
5-30-18
10-1-18, JFO
FD P.K. SHANK
NEWREFA18
3/1/23, TDN
SET MAG/WASHER
11/15/23

RECORD:(18B)
ORIGIN UNKNOWN
FD P.K.SHANK
NEW REFB18
SET MAG/WASHER
11/15/23, TDN

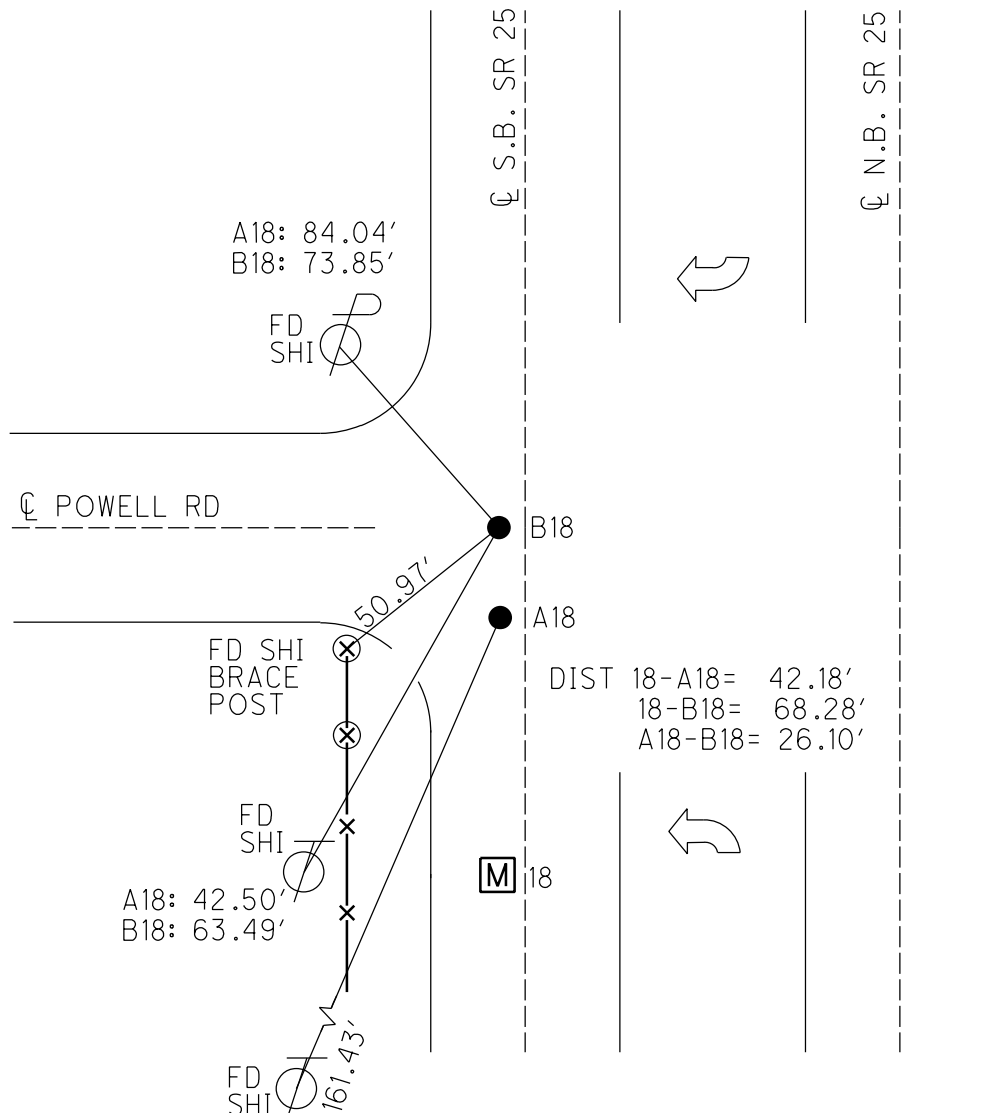

RECORD:
ORIGIN UNKNOWN
FD P.K.NAIL
3-27-91, SWH
FD P.K./WASHER
4/16/01, BDV
SET P.K./WASHER
10-31-01, SAH
FD MAG NAILS
REFA18
5-30-18
10-1-18, JFO

O.D.O.T. DISTRICT 2 SURVEY OFFICE

PERSONNEL

REFERENCE NO. 18

SHEET 21 OF 23

NOTES Huss

H.C. Rollins

R.C. Van Dusen

DATE 4-16-01

WEATHER Cldy - Rain

TEMP. 41°F

ROUTE SR-25

COUNTY Wood

TOWNSHIP Liberty

SECTION 1

T 4 N R 10 E


TYPE MONUMENT PK/W (Both Points)

ON SURFACE - ~~BELOW~~ surface

LEFT & PAVT - RIGHT 1.7' East 4' of S.B. Lane

13.2' TO West EDGE PAVEMENT


S.L.M. (A) - 374192 (B) - 375160.22

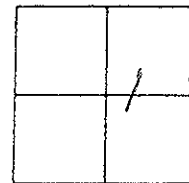

Record:
Brass Mon.
Poss. 1950 Phon
Sta. 617+37.11

Record:
(A) = Sm RR Spk
(B) = PK
SWH 3-27-91

SA PK/W
10-31-01
SAH

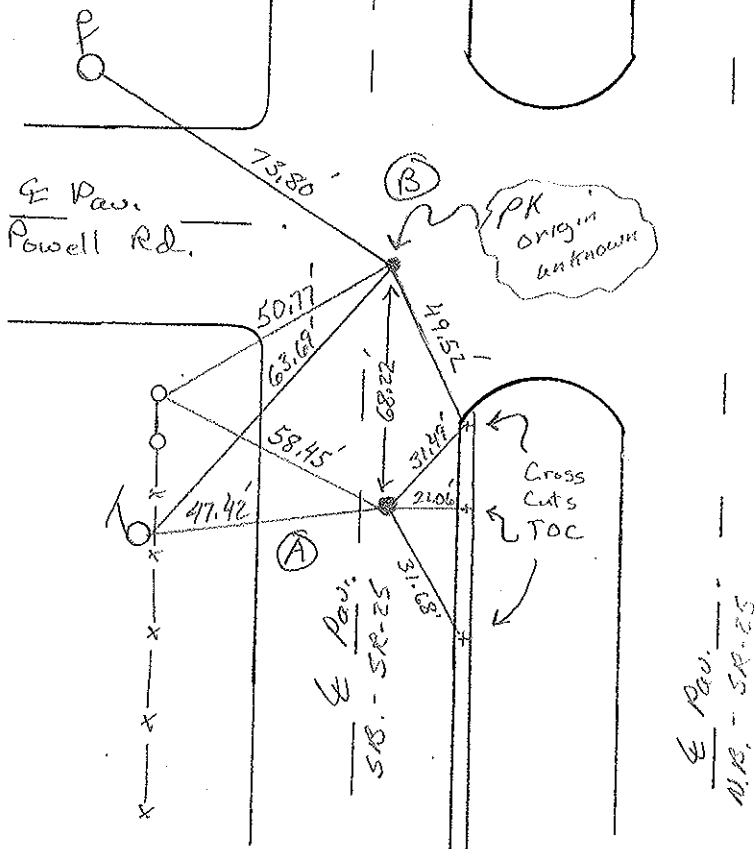

O.D.O.T. DISTRICT 2 SURVEY OFFICE

PERSONNEL

REFERENCE NO. 18

SHEET 21 OF 23

NOTES HOFFMAN

H.C. LOHRKE

R.C. BARNHISEL

DATE 3-27-91

WEATHER P. CLEAR

TEMP. 55°

ROUTE SR 25

COUNTY WOOD

TOWNSHIP LIBERTY

SECTION 1

T4 N R 10 E

"A"

"B"



TYPE MONUMENT SMALL RR SPK. P.K.

ON SURFACE - BELOW YES - YES

LEFT- & PAW'T. - RIGHT 1.7' EAST of & Point of the

13.2 TO West EDGE PAVEMENT

S.L.M. "A" = 374 + 92

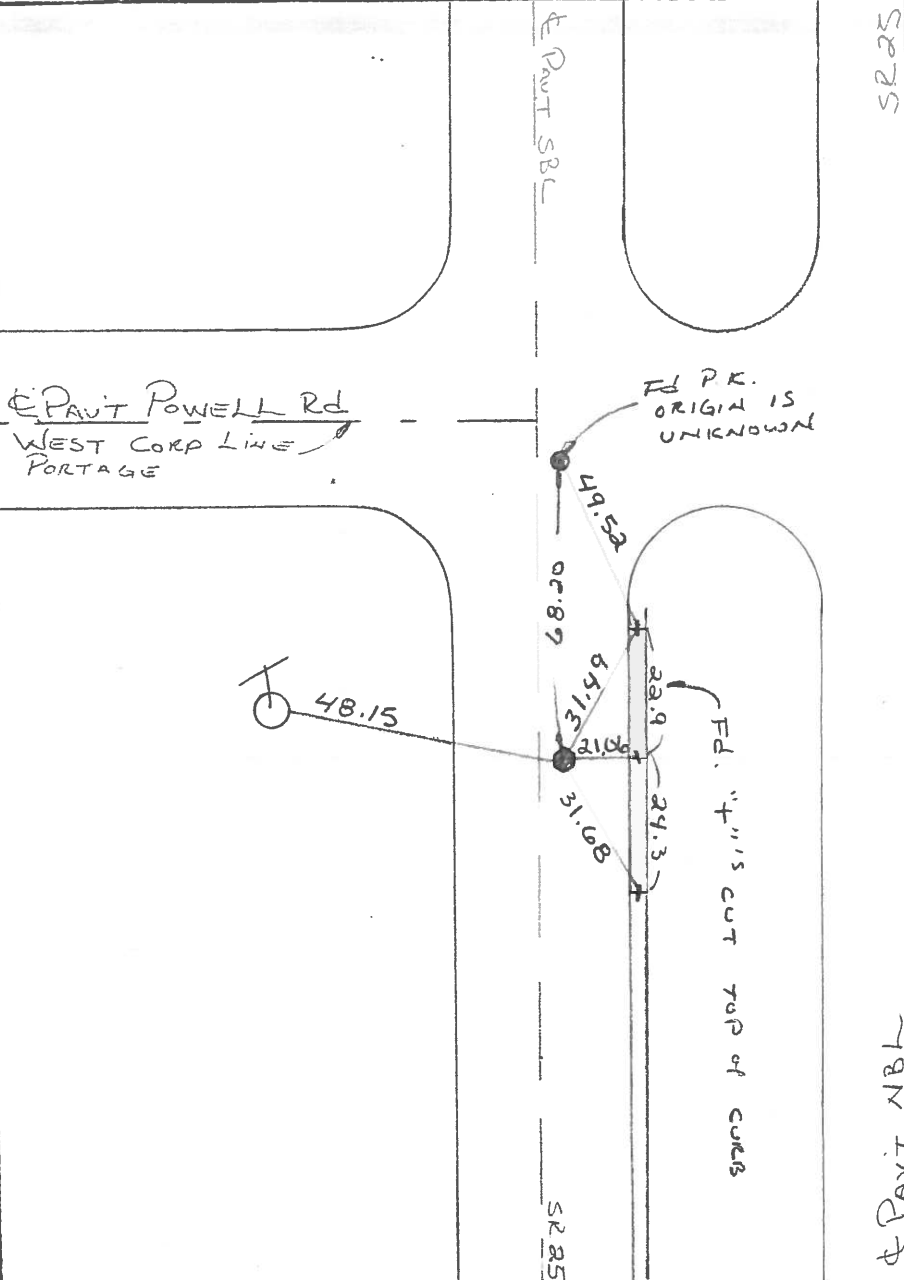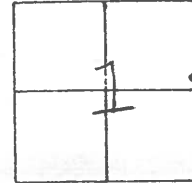

Set P.K.'s & Washers
6-12-91
MB

RECORD:

BRASS MONUMENT
ALSO - POSSIBLE IT IS
1950 PLAN STATION OF
617 + 37.14