

O.D.O.T. DISTRICT 2 SURVEY OFFICE (USE ONLY)

PERSONNEL

REFERENCE NO. 19

SHEET OF

NOTES RHOADES

DATE 3/1/23

ROUTE SR 25

H.C. NIESE

WEATHER CLEAR

COUNTY WOOD

R.C. AUBLE

TEMP. 37°

TOWNSHIP LIBERTY

DWG BY BARRIERE

PID 92133

SECTION 1

T 4 N R 10 E

TYPE MONUMENT MONBOX W/ 1" IPIN

ON SURFACE - BELOW ON

OFFSET $\varnothing$ PAVEMENT 5.7' LT LT : RT


 TO EDGE PAVEMENT

STATION: 375+43.33

HORIZ.DATUM: NAD83(11)/WOOD LDP GEOID: 18

GRID: NORTHING: 612508.547 EASTING: 1652623.652

LDP: NORTHING: 434353.635 EASTING: 163931.834

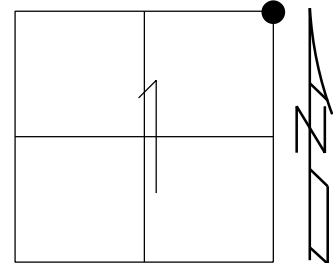

RECORD: P.I.

NE COR SEC 1

BRASS MON
FD SM RR SPIKE
3-27-91, SWH
SET PK/WASHER
6-13-91, MB
SET PK/WASHER
11-01-01, BVD
GPS, RT25KRAMER
8-27-13
POINT DESTROYED
5-30-18, JFO
PULLED TIES
DID NOT CROSS
10-1-18, JFO
FD MAG NAIL
NEWREF19
3/1/23, TDN
FD MONBOX
W/ 1" IPIN
REF19
5/15/24, TDN

$\varnothing$ KRAMER RD



$\varnothing$ N.B. SR 25

$\varnothing$ KRAMER RD

$\varnothing$ S.B. SR 25

O.D.O.T. DISTRICT 2 SURVEY OFFICE (USE ONLY)

PERSONNEL

REFERENCE NO. 19

SHEET 1 OF 4

NOTES HUSS

DATE 4-16-01

ROUTE US 25

H.C. ROUSOS

WEATHER RAIN

COUNTY WOOD

R.C. VAN DUSEN

TEMP. 41°F

TOWNSHIP CENTER

SECTION 31

T 4 N R 10 E

TYPE MONUMENT P.K./WASHER


ON SURFACE - ~~BELOW~~ ON

LEFT - ℄ PAV'T - RIGHT 5.7' E. OF ℄ SB, 3' N. ℄ W.


18.9' TO W. EDGE PAVEMENT

S.L.M. 402+87

Grid: Northing: 612508.505 Easting: 1652623.745

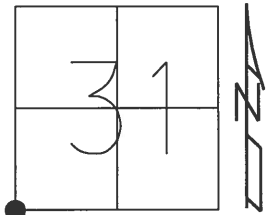

RECORD:
BRASS MON
FD SM RR SPIKE
3-27-91, SWH
SET PK/WASHER
6-13-91, MB
SET PK/WASHER
11-01-01, BVD
GPS, RT25KRAMER
8-27-13
POINT DESTROYED
5-30-18, JFO
PULLED TIES
DID NOT CROSS
10-1-18, JFO

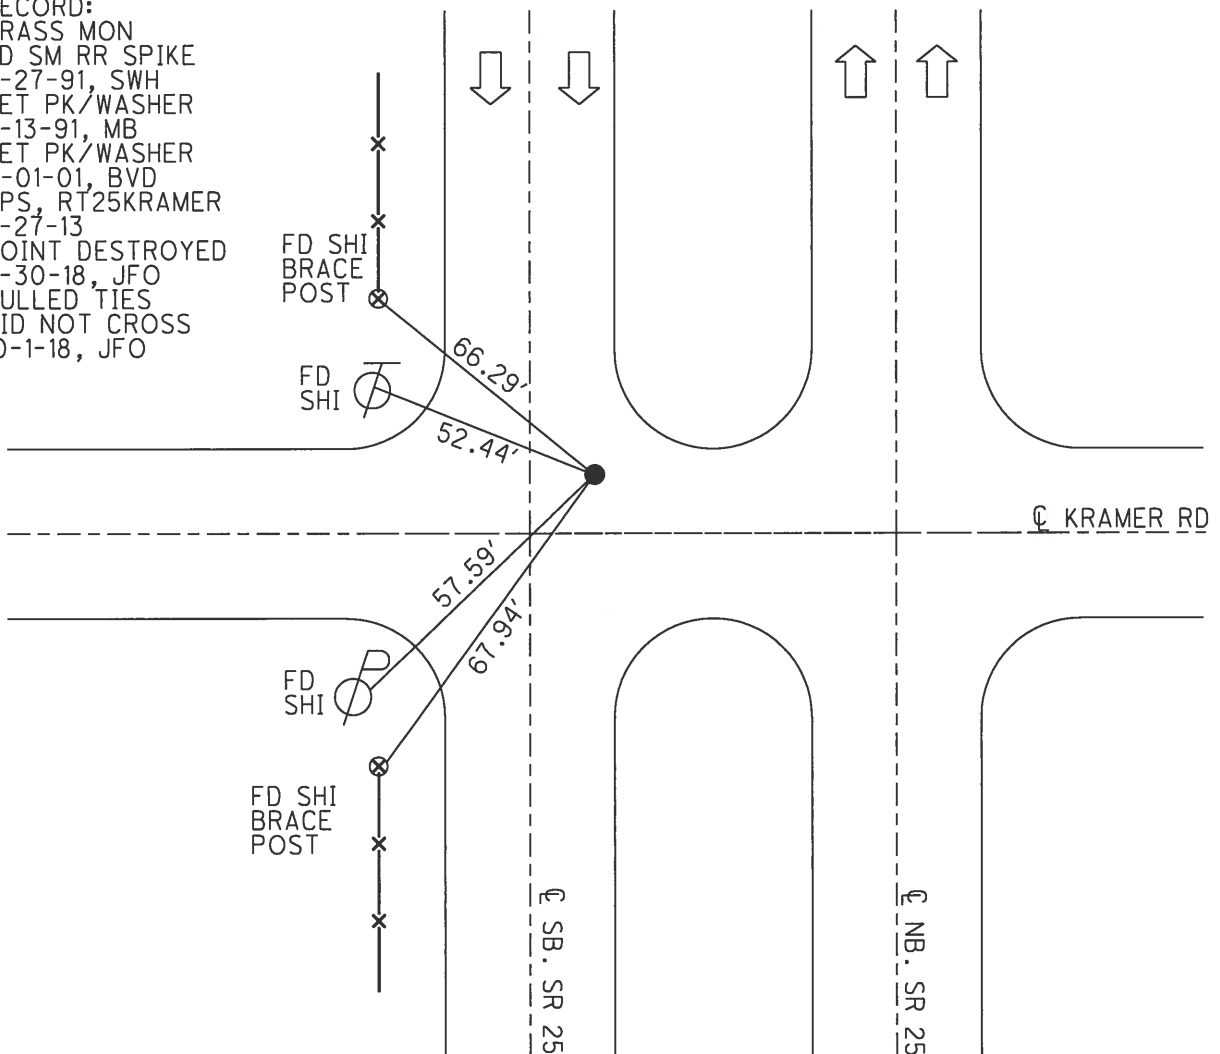


O.D.O.T. DISTRICT 2 SURVEY OFFICE (USE ONLY)

PERSONNEL	REFERENCE NO.	19	SHEET	1	OF	4
NOTES	HUSS	DATE	4-16-01	ROUTE	US 25	
H.C.	ROUSOS	WEATHER	RAIN	COUNTY	WOOD	
R.C.	VAN DUSEN	TEMP.	41°F	TOWNSHIP	CENTER	
				SECTION	31	
				T	4	N
				R	10	E

TYPE MONUMENT PK/WASHER
 ON SURFACE - ~~BELOW~~ ON
 LEFT - ℄ PAV'T - RIGHT 5.7' E. OF ℄ SB, 3' N. ℄ W.
18.9' TO W. EDGE PAVEMENT
 S.L.M. 402+87

Grid: Northing: 612508.5053 Easting: 1652623.7454

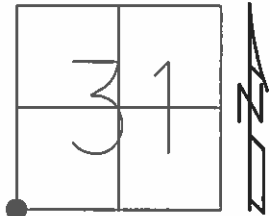


RECORD:
BRASS MON

FD SM RR SPIKE
3-27-91, SWH

SET PK/WASHER
6-13-91, MB

SET PK/WASHER
11-01-01, BVD

GPS, RT25KRAMER
8-27-13

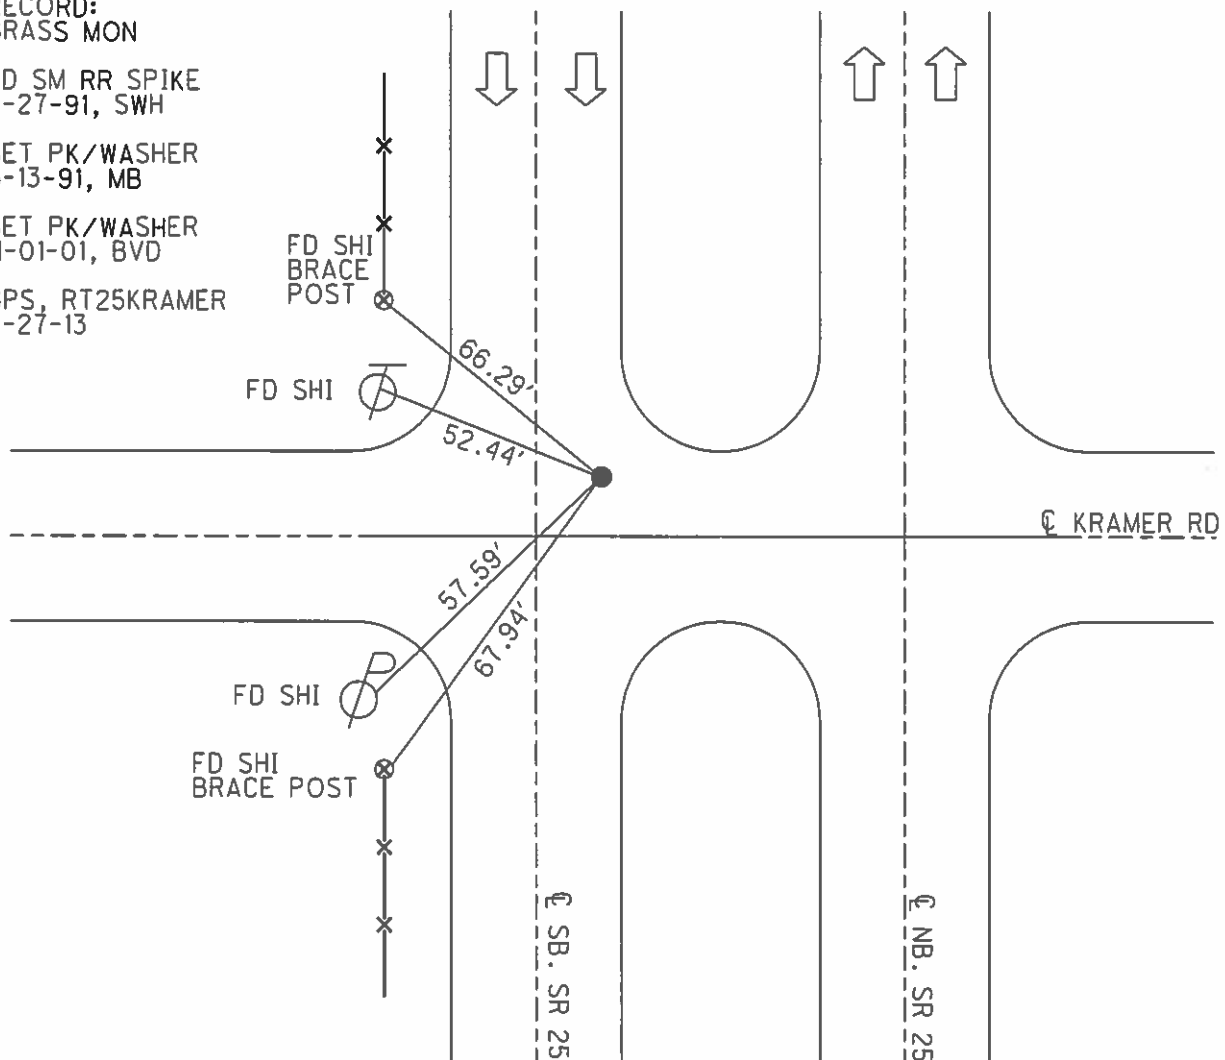

O.D.O.T. DISTRICT 2 SURVEY OFFICE

PERSONNEL

REFERENCE NO. 19

SHEET 22 OF 23

NOTES

H.C.

R.C.

Huss

Rousos

VanDusen

DATE

WEATHER

TEMP.

4-16-01

Cldy-Rain

+41°F

ROUTE

COUNTY

TOWNSHIP

SECTION

T 4 N R 10 E

SR-25

Wood

Center

31

TYPE MONUMENT

ON SURFACE

LEFT - & PAV'T. - RIGHT

18.9' TO West EDGE PAVEMENT

S.L.M.


PK/W

BELOW

Surface

5.7' E. & S.R. Lanes

402+87

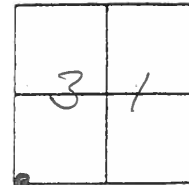

N

E

Record:
Set PK/W
6-13-91 MB

Record:
Brass Mon

Record:
Fd Sm. RR
Spk 3-27-91
SWH

Set PK/W
11-01-01
BUD.

Set N/Shi
in Brass Post

66.29'

52.74'

57.66'

3' North
of E For
Kramer Rd

E Pav.
Kramer Rd.

Set
N/Shi

W Pav.
SR-25

E Pav.
NR SR-25

O.D.O.T. DISTRICT 2 SURVEY OFFICE

PERSONNEL

REFERENCE NO. 19

SHEET 22 OF 23

NOTES HOFFMAN

H.C. LOEHRS

R.C. BARNHISEL

DATE 3-27-91

WEATHER P. CLEAR

TEMP. 55°

ROUTE SR 25

COUNTY WOOD

TOWNSHIP CENTER

SECTION 31



T4 N R 10 E

TYPE MONUMENT SMALL R.R. SPK

ON SURFACE - BELOW YES

LEFT- & PAVT. - RIGHT 5.7' EAST OF & PAVT OF THE
18.9 TO WEST EDGE PAVEMENT SOUTH BOUND LANE

S.L.M. 402+87

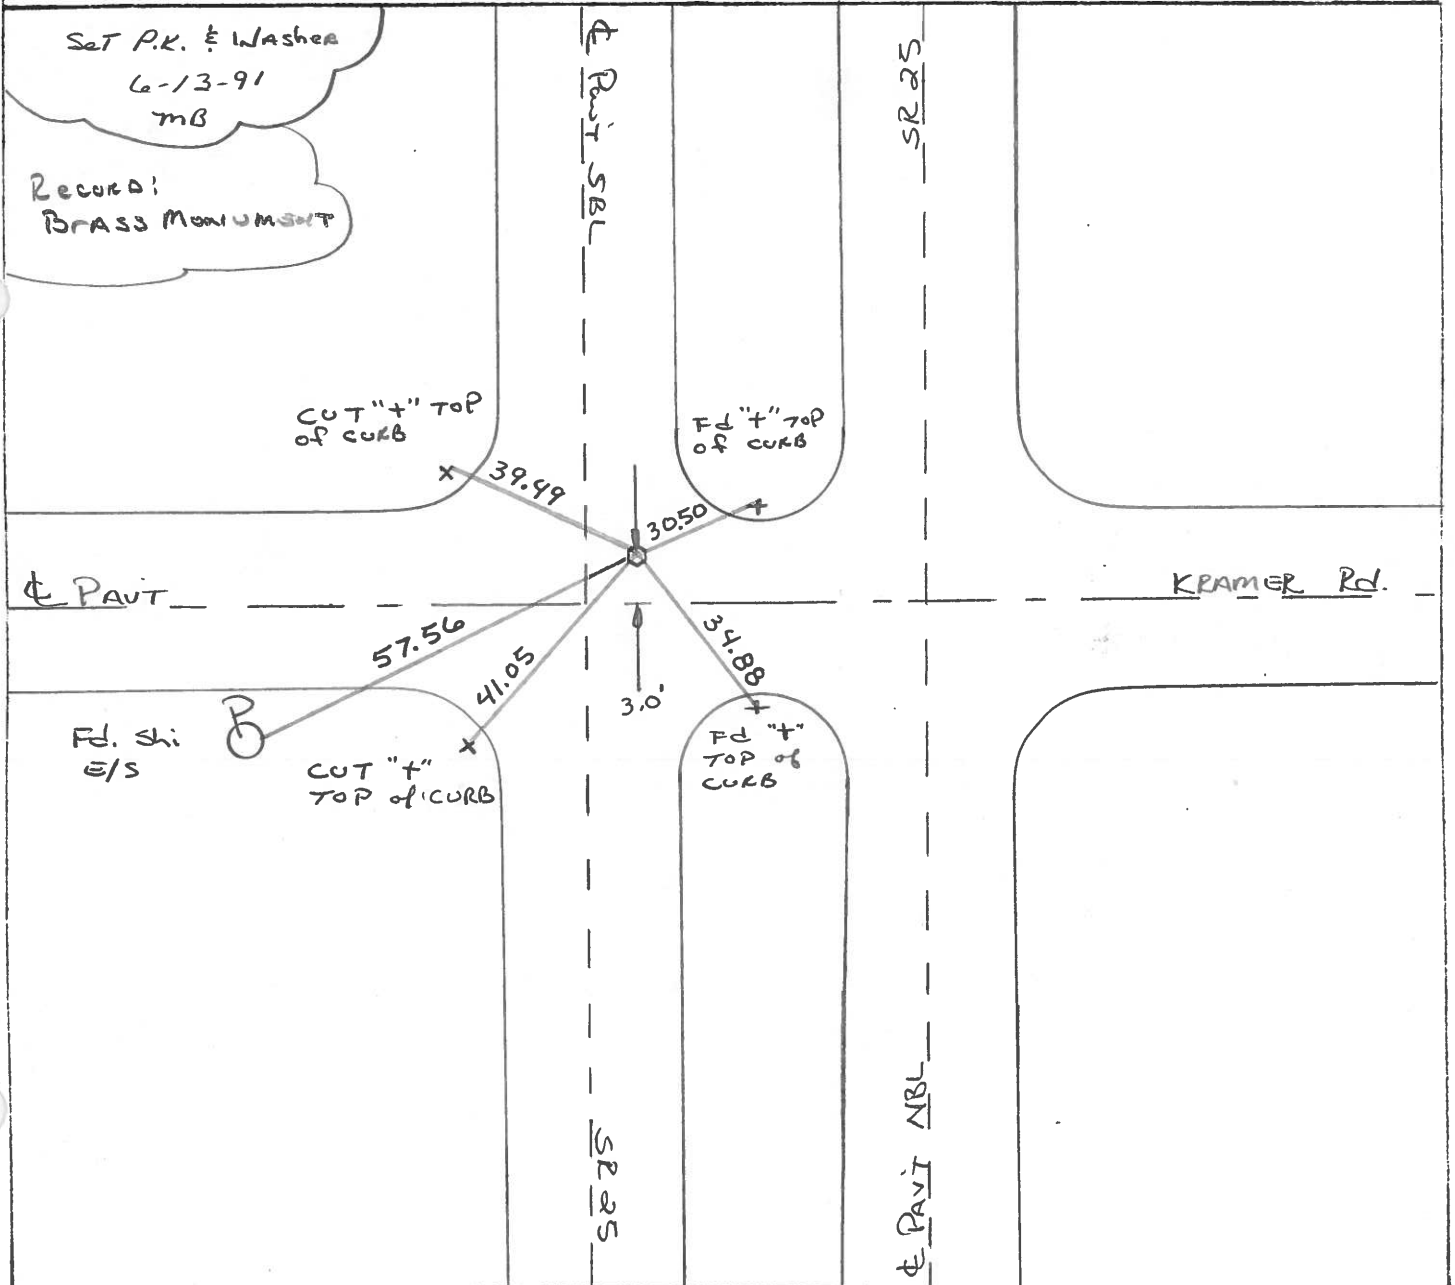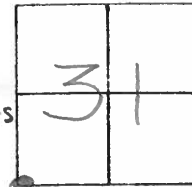

O.D.O.T. DISTRICT 2 SURVEY OFFICE

SHEET _____ OF _____

County WOOD U.S. S.R. 25

Township CENTER

Section 31

T4N, R10E

Personnel BURNSIDE

SMITH


BOWERS

HOLCOMBE

Date OK. 5-18-78
5-24-71


Weather RAIN

Temp. 70°

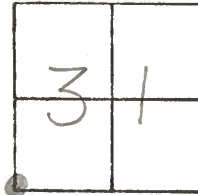

#19

BRASS MON.
PORTAGE CORP.
LINE - WEST.
SET P.K. NAIL
8-21-22

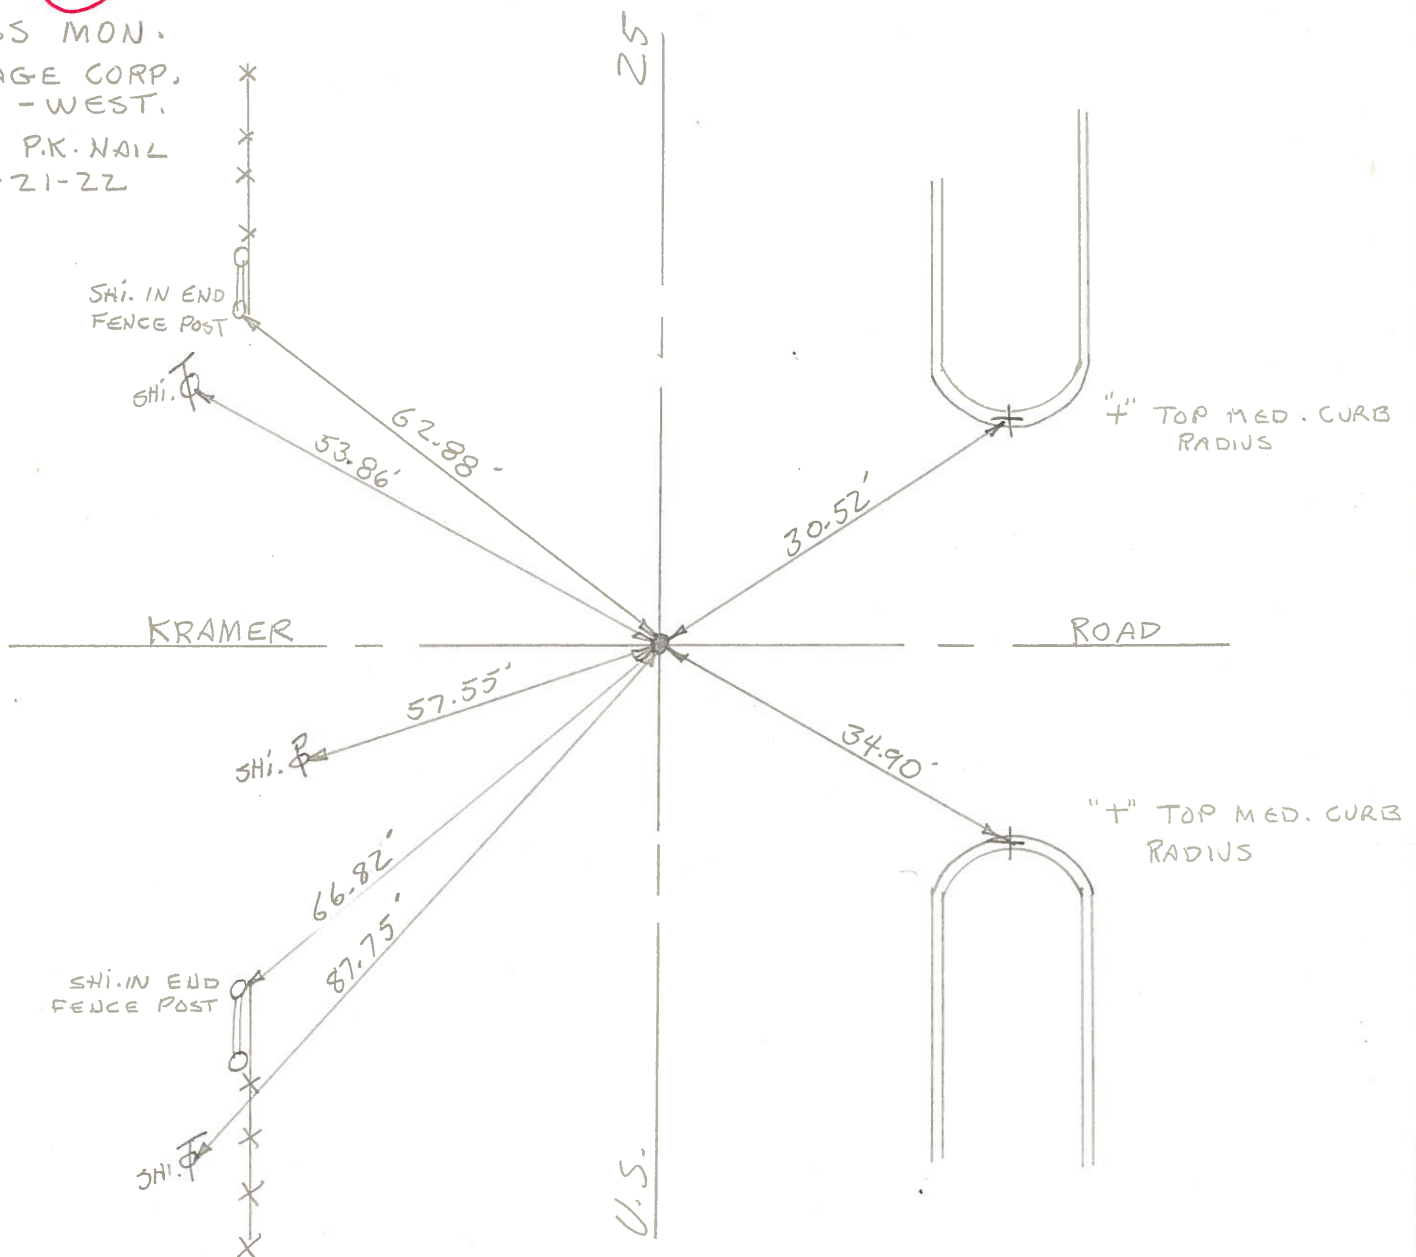

PERSONNEL	TITLE	PERSONNEL	TITLE	COUNTY	DATE
				Wood	
				S. R. U.S. #25	WEATHER
				SEC.	TEMP.

DESCRIPTION	LEFT	CENTER LINE	RIGHT	JOB NO.
Sta. 617+37.14 E 1/4 post sec. 1 Liberty Twp. 65.0' South Powell Rd. Brass plate (18) #245			Shiner in T. Pole N.W. 48.16 Shiner in P.P. S.S.E. 75.26 Shiner in T.P. N.W. 36.28 Shiner in T.P. S.S.W. 115.47 "X" in curb East 20.97 Shiner in End Post N.N.W. 60.51 "X" in curb N.E. 31.63 "X" in curb S.E. 31.83 Shiner in Anchor Post N.W. 62.6. Iron ear. post S.W. 39.46 Shiner in T.P. N.N.W. 71.73 68.68 Shiner in P.P. N.E. 46.37 Shiner in P. Pole S.W. 57.86 Shiner in Anchor Post S.S.W. 64.15	
Sta. 645+32.8 S.W. cor. sec. 31 Center Twp. & Portage twp. line W. Brass plate, intersection of east Elm Kramer Rd. (19) #246			Shiner in P.P. N.N.E. 76.3 Shiner in W. TT pole N.W. 34.76 58.84 Conc. R/W mon. W. 29.91 Shiner in P. Pole S.W. 110.22 Shiner T. Pole N.W. 84.1 Shiner in 12" Walnut N.W. 58.6 Shiner in P.P. E. 82.04 41.23 N.E. cor. gas Sta. (Bldg proper) S.W. 96.17 Shiner in light Pole S.W. 77.30	
Sta. 671+72.35 W. 1/4 post sec. 31 Center Twp. Brass plate (21) #247				
Sta. 698+37.3 S.E. cor. sec. 25 Plain Twp. Gypsy lane Rd. Brass plate (Could not Raise) (21) #248				

Note
see sheets
6A-6B
New
w/it.