

O.D.O.T. DISTRICT 2 SURVEY OFFICE (USE ONLY)

PERSONNEL

REFERENCE NO. 20/A20

SHEET _____ OF _____

NOTES RHOADES
H.C. NIESE
R.C. AUBLE

DATE 3/1/23
WEATHER CLEAR
TEMP. 37°

ROUTE SR 25
COUNTY WOOD
TOWNSHIP LIBERTY
SECTION 1

DWG BY BARRIERE PID 92133

T 4 N R 10 E

TYPE MONUMENT MONBOX W/ 1" IPIN

ON SURFACE - BELOW ON

OFFSET $\varnothing$ PAVEMENT 5.7' LT LT : RT


TO EDGE PAVEMENT

STATION: 401+82.69

HORZ. DATUM: NAD83(11)/WOOD LDP GEOID: 18

GRID: NORTHING: 615147.441 EASTING: 1652659.660

LDP: NORTHING: 436992.970 EASTING: 163933.044

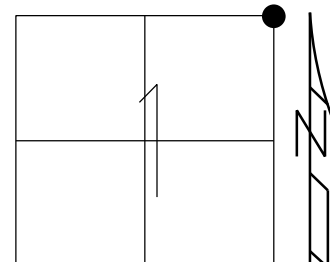


RECORD: (20)
W 1/4 SEC 31

BRASS MON
SET PK/WASHER
6-13-91, MB
SET PK/WASHER
11-01-01, BVD
FD PK SHANK
GPS, CNTRL9
10-01-13
D.N.F
5-30-18, JFO
PULLED TIES
DID NOT CROSS
10-1-18, JFO
FD MAG NAIL
PREREF20
3/1/23, TDN
FD NEW MONBOX
W/ 1" IPIN
NEWREF20
11/20/23, TDN

RECORD: (A20)


FD NEW MONBOX
W/ 1" IPIN
NEWREF A20
11/20/23, TDN

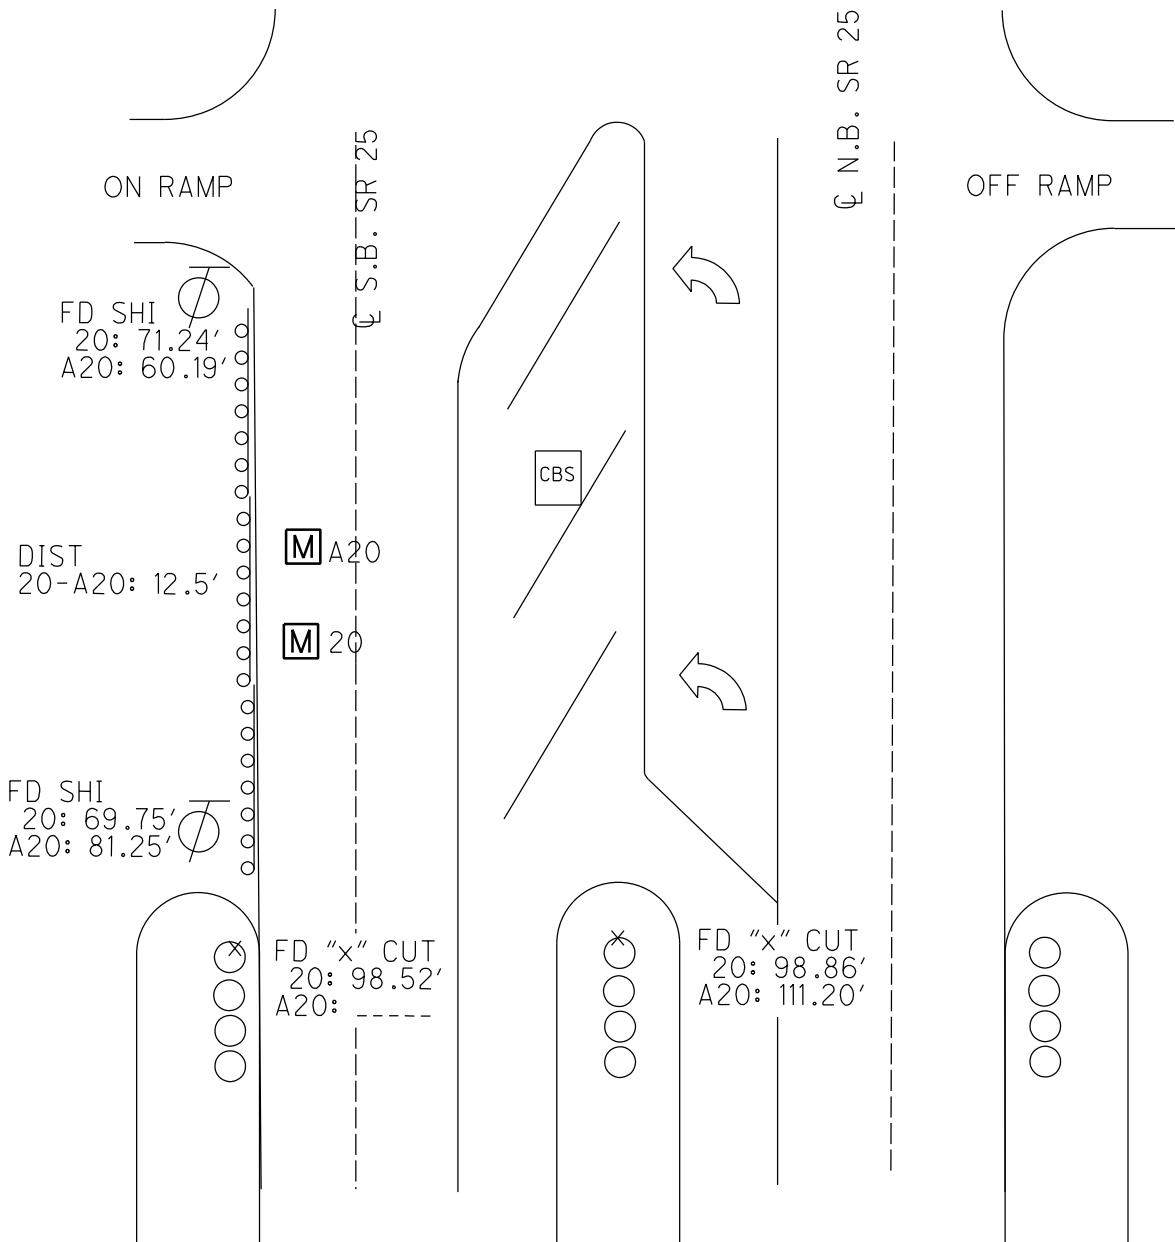

O.D.O.T. DISTRICT 2 SURVEY OFFICE (USE ONLY)


PERSONNEL	REFERENCE NO.	20	SHEET	2	OF	4
NOTES	HUSS	DATE	4-16-01	ROUTE	US 25	
H.C.	ROUSOS	WEATHER	RAIN	COUNTY	WOOD	
R.C.	VAN DUSEN	TEMP.	41°F	TOWNSHIP	CENTER	
				SECTION	31	
				T	5	N
				R	10	E

TYPE MONUMENT P.K./WASHER
 ON SURFACE - ~~BELOW~~ ON
 LEFT - ℄ PAV'T - RIGHT 2.3' E. ℄ SB LANE
9.9' TO E. EDGE PAVEMENT
 S.L.M. 427+24

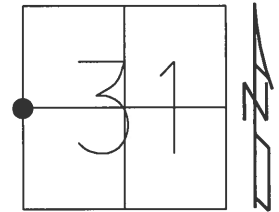

Grid: Northing: 615147.486 Easting: 1652659.669

RECORD:
 BRASS MON
 SET PK/WASHER
 6-13-91, MB
 SET PK/WASHER
 11-01-01, BVD
 FD PK SHANK
 GPS, CNTRL9
 10-01-13
 D.N.F
 5-30-18, JFO
 PULLED TIES
 DID NOT CROSS
 10-1-18, JFO

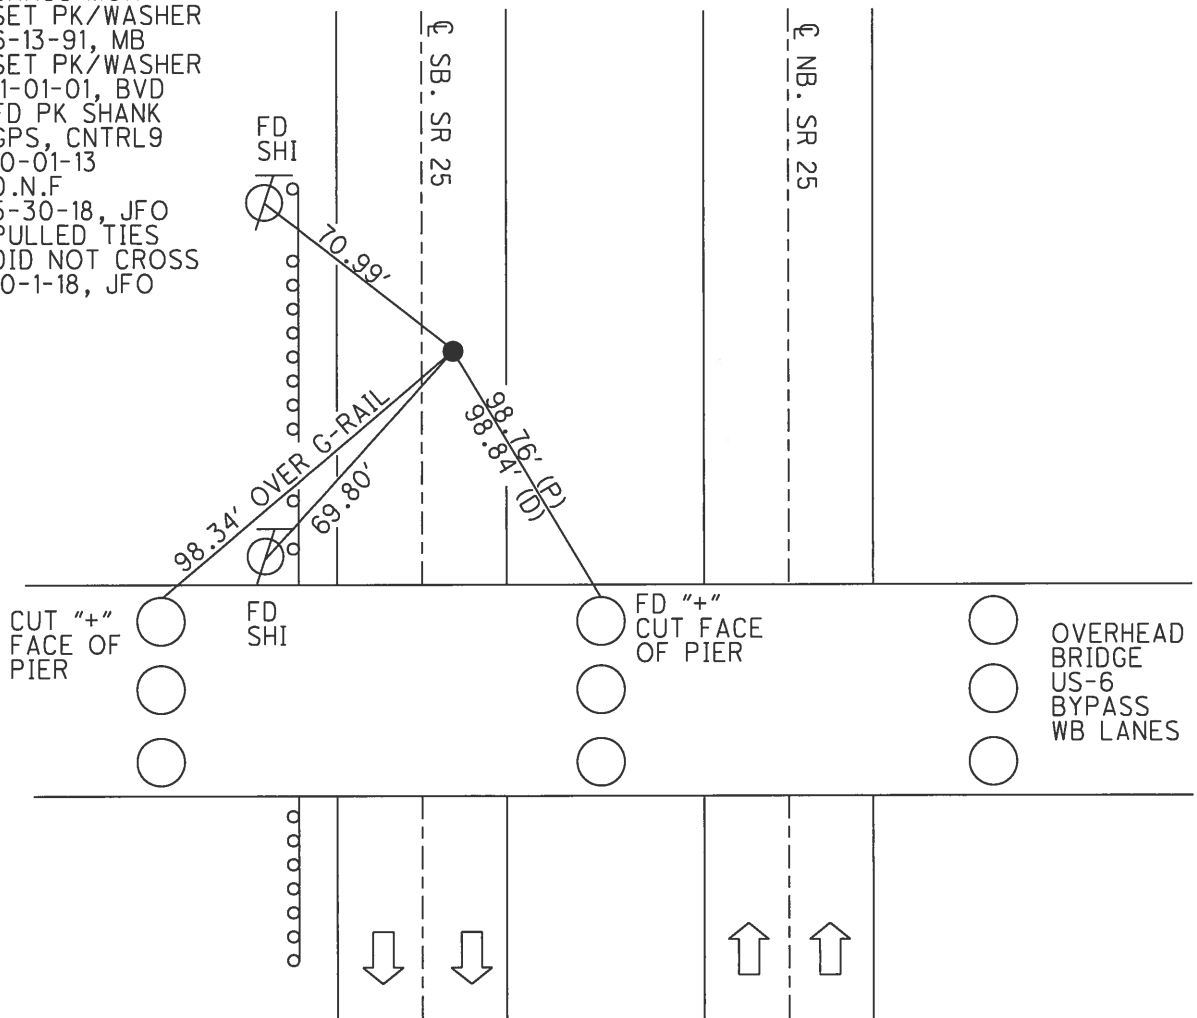


O.D.O.T. DISTRICT 2 SURVEY OFFICE (USE ONLY)

PERSONNEL	REFERENCE NO.	20	SHEET	2	OF	4
NOTES	HUSS	DATE	4-16-01	ROUTE	US 25	
H.C.	ROUSOS	WEATHER	RAIN	COUNTY	WOOD	
R.C.	VAN DUSEN	TEMP.	41°F	TOWNSHIP	CENTER	
				SECTION	31	
				T	5	N
				R	10	E

TYPE MONUMENT PK/WASHER
 ON SURFACE - ~~BELOW~~ ON
 LEFT - ℄ PAV'T - RIGHT 2.3' E. ℄ SB LANE
9.9' TO E. EDGE PAVEMENT
 S.L.M. 427+24

Grid: Northing: 615147.4855 Easting: 1652659.6690

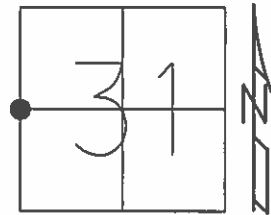


RECORD:
BRASS MON

SET PK/WASHER
6-13-91, MB

SET PK/WASHER
11-01-01, BVD

FD PK SHANK
GPS, CNTRL9
10-01-13

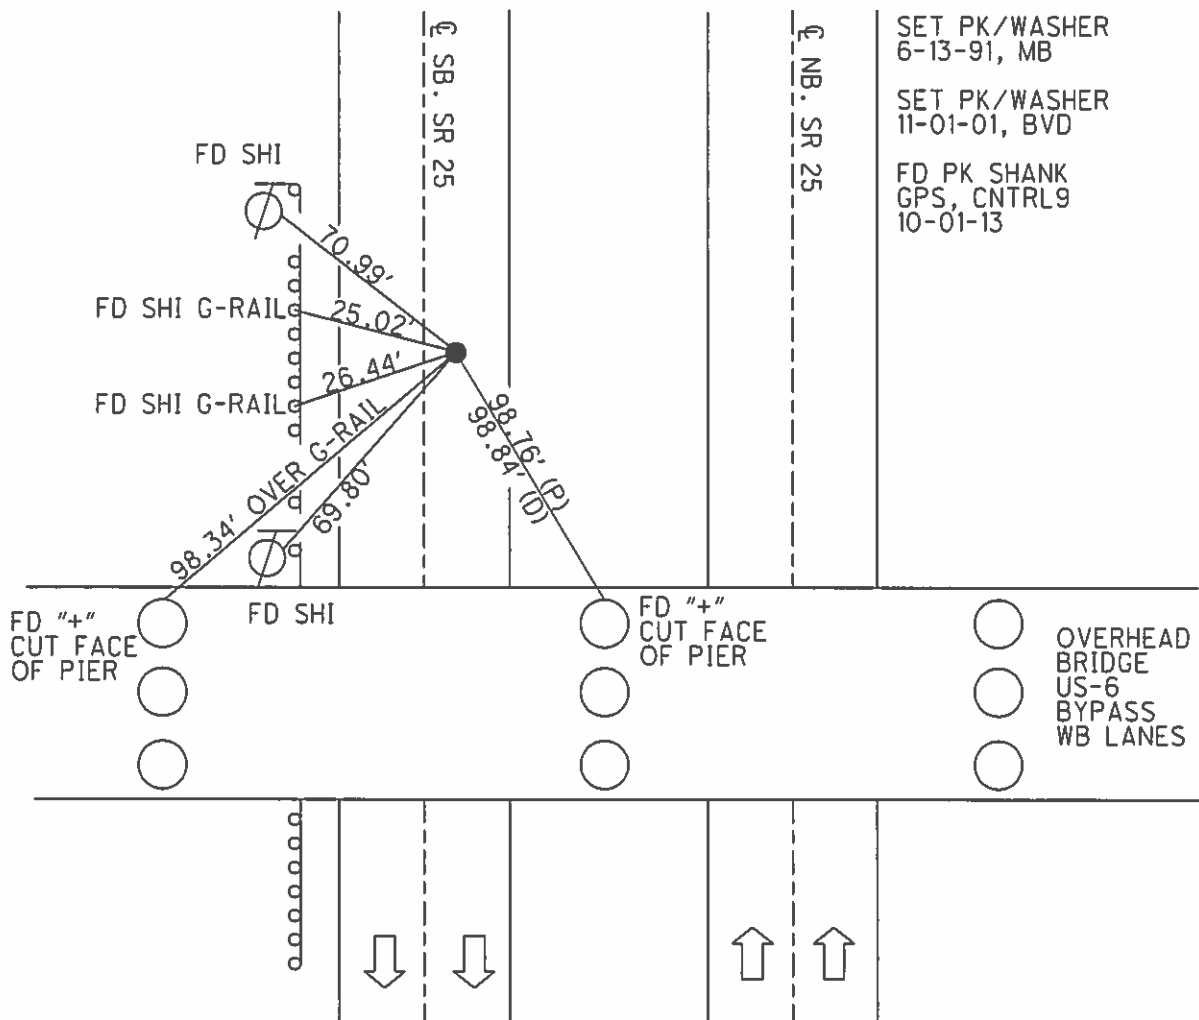

O.D.O.T. DISTRICT 2 SURVEY OFFICE

PERSONNEL

REFERENCE NO. 20

SHEET 23 OF 23

NOTES HOFFMAN

H.C. LOENKE

R.C. BARNHISEL

DATE 3-27-91

WEATHER P. CLEAR

TEMP. 55°

ROUTE SR 25

COUNTY Wood

TOWNSHIP CENTER

SECTION 31


T5 NR 10 E

TYPE MONUMENT SMALL R.R. SPIK

ON SURFACE - ~~BELOW~~ YES

LEFT - & PAVT. - RIGHT 2.3' EAST of & PAVT of the
9.9 TO EAST EDGE PAVEMENT SOUTHBOUND LANES

S.L.M. 429 + 24

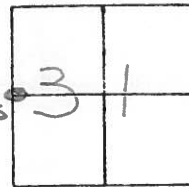


Set P.K. & Washere

6-13-91

MB

RECORD:

BRASS MONUMENT

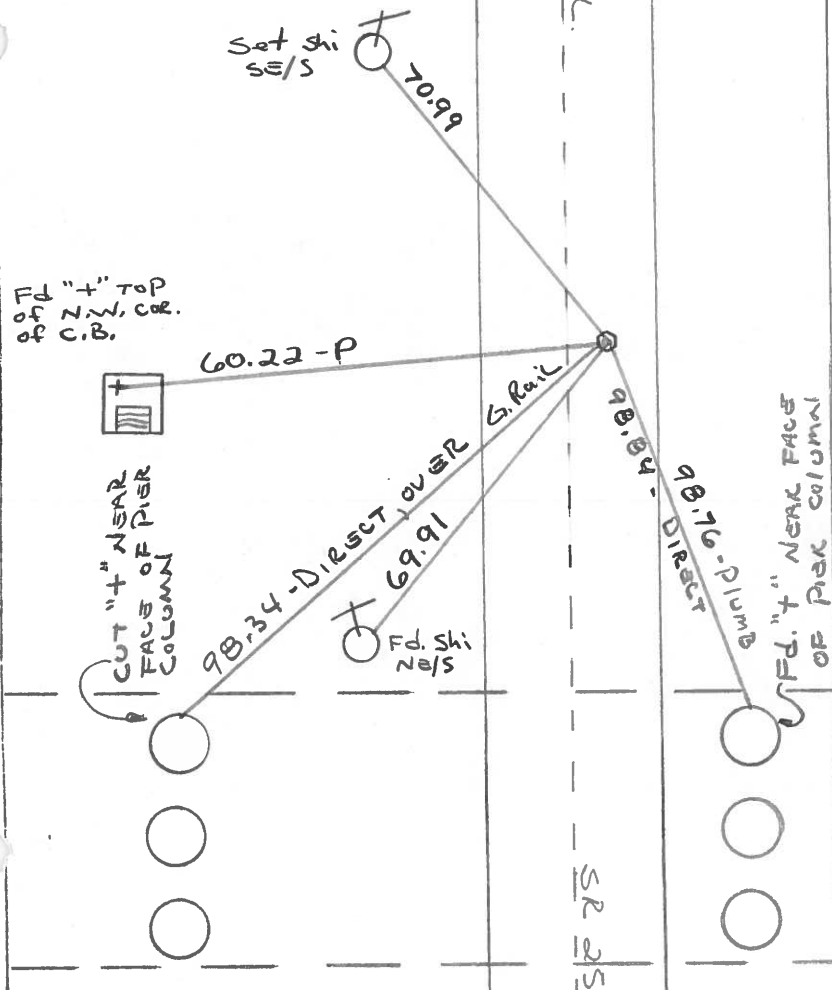

OVERHEAD BRIDGES

U.S. 6

BY-PASS

WEST-BOUND
LANES

O.D.O.T. DISTRICT 2 SURVEY OFFICE

SHEET

OF

County WOOD ^{U.S.} S.R. 25

Date 5-25-71 ^{OK. 5-18-78}

Township CENTER

Weather RAIN

Section 31

Temp. 60°


T5N, R10E

Personnel BURNSIDE

SMITH

BOWER

HOLCOMBE

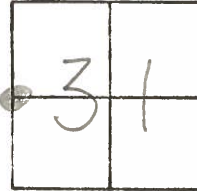

20

BRASS MON.

SET P.K. NAIL

8-21-72

"+" TOP OF
N.W. COR. C.B.



SHI. 

73.09'

60.18'
(D)

69.95'

98.78'

"+" NEAR EDGE
CTR. PIER COLUMN
U.S. #6 BY-PASS



U.S.

25