

O.D.O.T. DISTRICT 2 SURVEY OFFICE (USE ONLY)

PERSONNEL

REFERENCE NO.

23 E

SHEET

14

OF 44

NOTES

NEISE

DATE

10/24/24

ROUTE

SR 65

H.C.

PRESTON-COLIVN

WEATHER

SUNNY

COUNTY

WOOD

R.C.

NEISE

TEMP.

51°

TOWNSHIP

MIDDLETON

SECTION

RT 53, 54

T 6 N

R 10 E

TYPE MONUMENT

MAG SHANK

ON SURFACE -

~~BELOW~~

ON

LEFT - C PAV'T - ~~RIGHT~~

1.0'

9.3'

TO LT

EDGE PAVEMENT

S.L.M.


685+29.33

Grid: Northing:

675346.719

Easting:

1637527.682

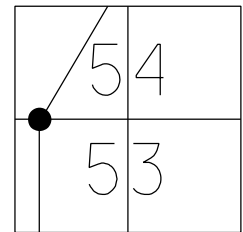

RECORD:

STA. 683+30
FD P.K.NAIL
FD P.K./WASHER
5/24/95, SAH
SET P.K./WASHER
8/7/95, SAH
FD P.K.NAIL
REFE23
9/17/12, SDC
FD P.K.NAIL
CKREFE23
5/12/14, DCH
SET MAG/WASHER
3/16/16, DCH
FD MAG SHANK
10/24/24, TDN

FD SHI
30" CATALPA

38.82'

FD SHI

27.89'

29.65'

SET SHI
12" CATALPA

16.39'-D

FD IPID

"GARCIA TRAVERSE"

33.72'

FD SHI

C SR 65

O.D.O.T. DISTRICT 2 SURVEY OFFICE (USE ONLY)

PERSONNEL

REFERENCE NO. 23 E SHEET 14 OF 44

NOTES VAN DUSEN

DATE 5/24/95

ROUTE SR 65

H.C. MOSER

WEATHER CLOUDY

COUNTY WOOD

R.C. HUSS

TEMP. 60°

TOWNSHIP MIDDLETON

SECTION RT 53, 54

T 6 N R 10 E

TYPE MONUMENT P.K.NAIL


ON SURFACE - ~~BELOW~~ ON

LEFT - Q PAV'T - ~~RIGHT~~ 1.0'


9.3' TO LT EDGE PAVEMENT

S.L.M. 685+29.33

Grid: Northing: 675346.719 Easting: 1637527.682

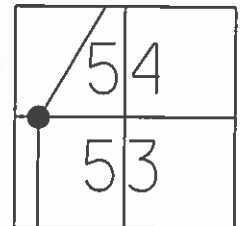

GPS E23

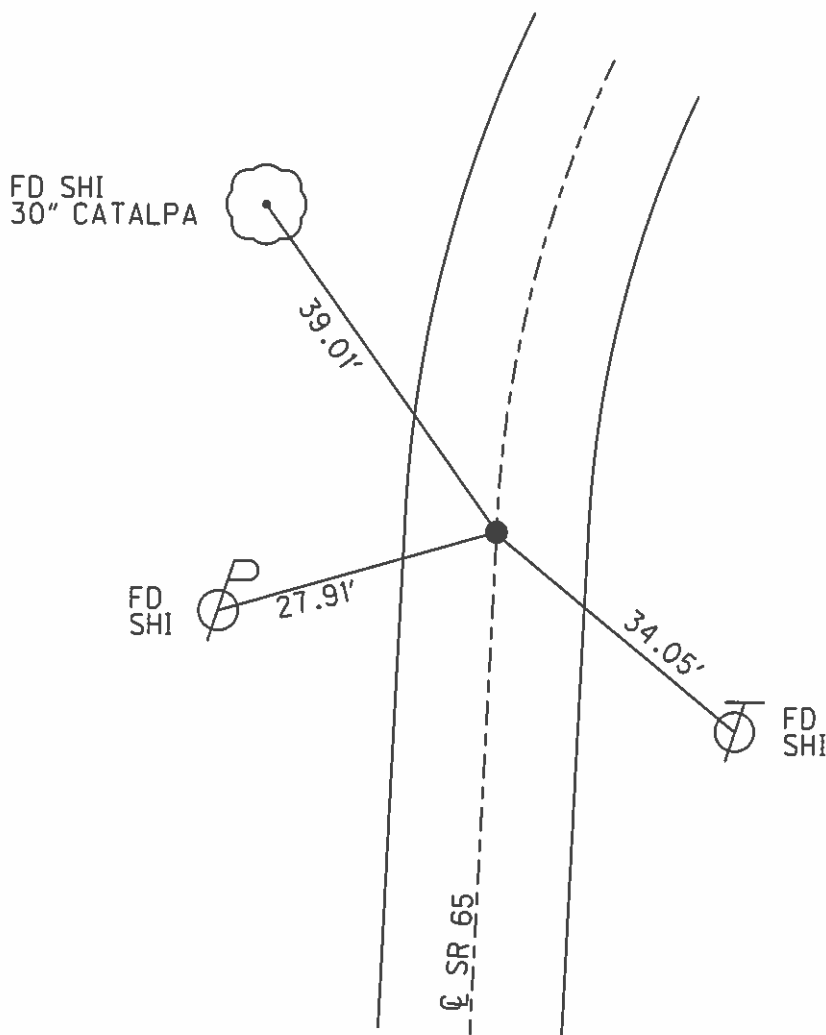

O.D.O.T. DISTRICT 2 SURVEY OFFICE

PERSONNEL

REFERENCE NO. _____

SHEET 46 OF 91

NOTES VAN DUSEN

H.C. MOSE

R.C. HUSS

DATE 5-24-95

WEATHER CLOUDY

TEMP. +60°F

ROUTE SR 65

COUNTY WOOD

TOWNSHIP MIDDLETON

SECTION R.T. 53 & 54

T 6 N R 10 E

TYPE MONUMENT P.K. / WASHER

ON SURFACE - BELOW

LEFT - C PAV'T. - RIGHT A+B+C 1.0' LT


TO LT EDGE PAVEMENT

S.L.M. A=678+78 B=681+65 C=683+30

23-C

23-D

23-E

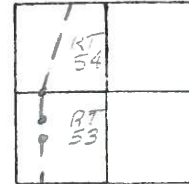


SET PK & WASHER @ ALL 3 POINTS
8-7-95
SAH

REC. SLM 683+30
Fol. PK @ SURFACE
0.5' LT. & PYMT.


REC. SLM 681+65
Fol. PK @ SURFACE
0.5' LT. & PYMT.

REC. SLM 678+78
Fol. SMALL RR SPK @ SURFACE
0.8' LT. & PYMT.

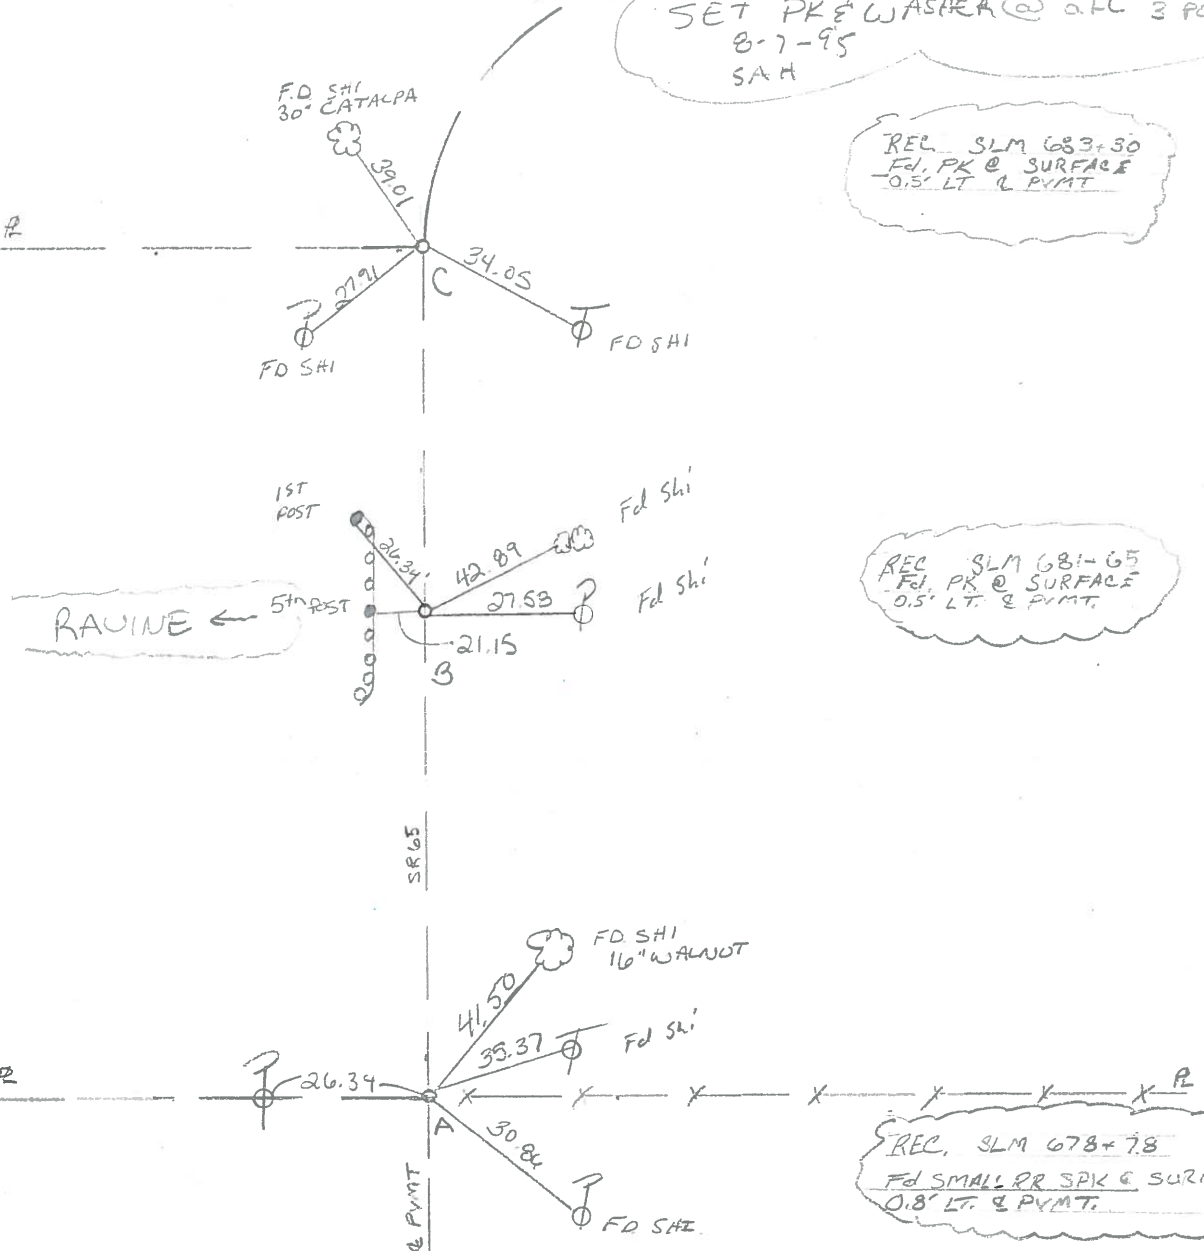

County WOOD S.R. 65Township MIDDLETONSection R.T. 53 & 54

T6N, R10E

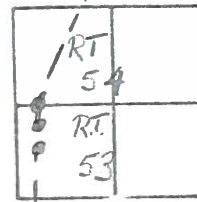Personnel HOFFMANDate 4-13-84Weather P. ClearTemp. 50°23-C23-D23-ELOENRGEHOUSEHOLDER H.C.BACHMISER R.C.

SET PK/WASHER

CALL 3 POINTS

10-17-84

S.W.H.


SLM 683+30
 Fd P.K. @ SURFACE
 0.5' Lt. of & Post
 9.3' to Lt. EP
 10.2' to Rt. EP

RAVINE ←

SLM 681+65
 Fd P.K. @ SURFACE
 0.5' Lt. of & Post
 9.1' to Lt. EP
 10.8' to Rt. EP

SLM 678+78

Fd small R.R. spk @ surface
 0.8' Lt. of & Post
 6.7' to Lt. EP
 9.9' to Rt. EP

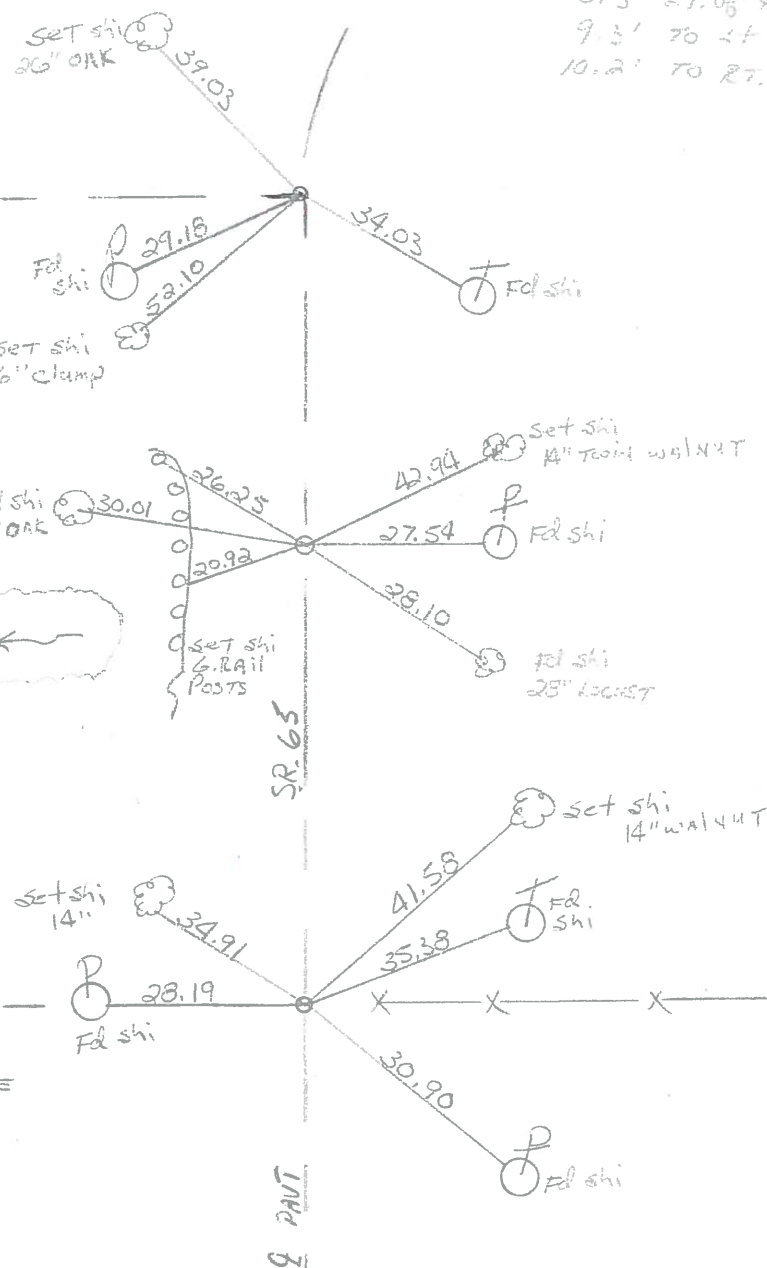

O.D.O.T. DISTRICT 2 SURVEY OFFICE

SHEET

OF

County WOOD S.R. 65

Date 7-10-80

Township MIDDLETON

Weather FAIR


Section R.T. 53-54

Temp. 85°

T.N, R.E


Personnel SMITH

23-C

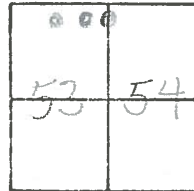

23-D

23-E

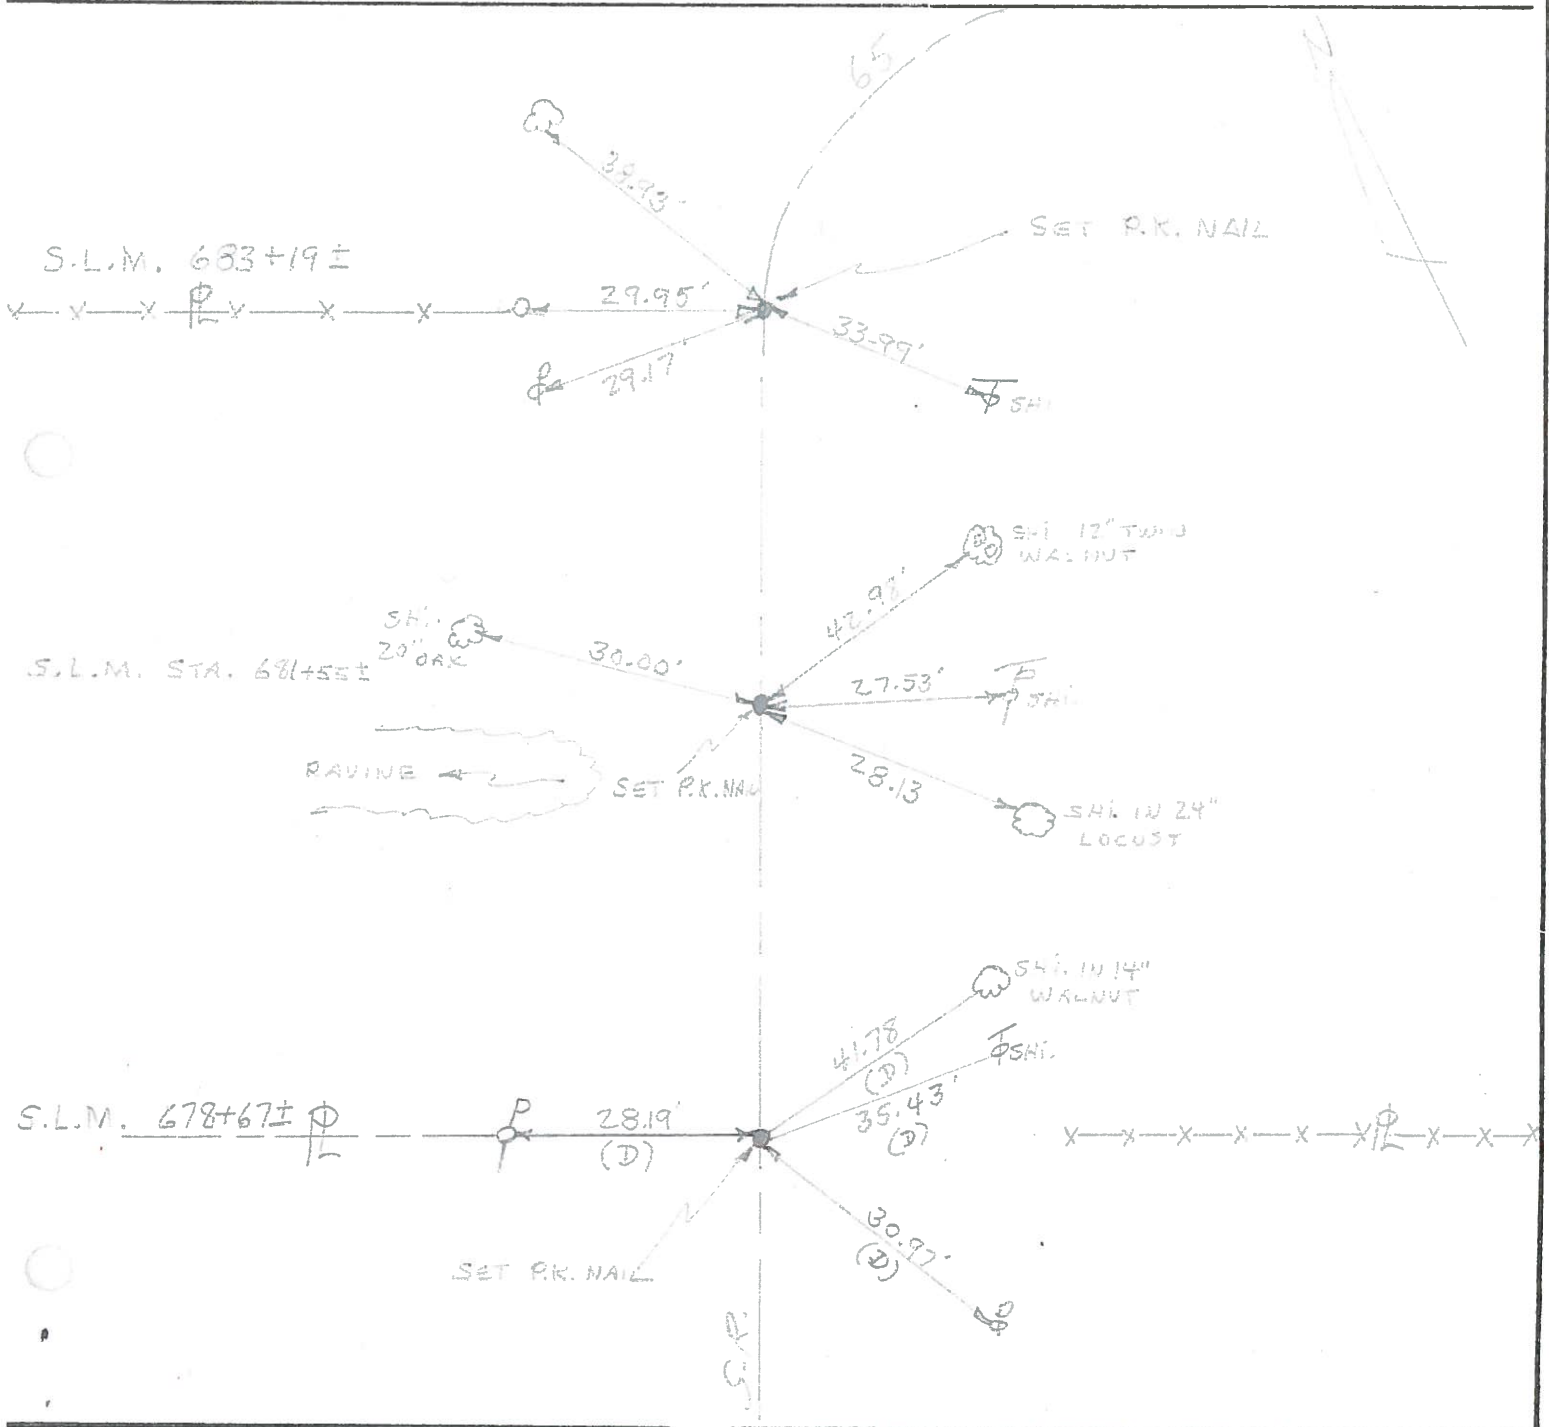

PERSONNEL	TITLE	PERSONNEL	TITLE	COUNTY	DATE	WEATHER	TEMP.
BURNSIDE				Wood	4-18-72	CLEAR	+77°
SMITH				S. R. 65			
BOWERS				SEC MIDDLETON TWP			

DESCRIPTION	LEFT	CENTER LINE	RIGHT	JOB NO.
-------------	------	-------------	-------	---------

