


O.D.O.T. DISTRICT 2 SURVEY OFFICE (USE ONLY)

PERSONNEL _____ REFERENCE NO. 24 B SHEET 24 OF 44
 NOTES NEISE DATE 10/24/24 ROUTE SR 65
 H.C. PRESTON-COLVIN WEATHER SUNNY COUNTY WOOD
 R.C. NEISE TEMP. 53° TOWNSHIP PERRYSBURG
 _____ SECTION RT 57
 _____ T 7 N R 10 E


TYPE MONUMENT MAG SHANK
 ON SURFACE - ~~BELOW~~ ON
~~LEFT~~ - Q PAV'T - RIGHT 1'
10.7' TO LT EDGE PAVEMENT
 S.L.M. 739+00.02

Grid: Northing: 679850.697 Easting: 1640422.514

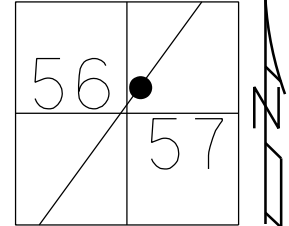

RECORD:
 FD LG.R.R.SPIKE
 SET BY H.FREY FOR
 THE WILLOWBROOK SUB.
 -FARNHAM, WIRRES & BERNING
 10/17/84
 FD P.K./WASHER
 5/23/95, SAH
 SET P.K./WASHER
 8/8/95, SAH
 FD P.K./WASHER
 REFB24
 9/18/12, SAH
 FD P.K./WASHER
 REFB24
 6/12/14, DCH
 SET MAG/WASHER
 3/16/16, DCH
 FD MAG SHANK
 10/24/24, TDN

USE TOP OF 8TH
 BRICK FROM BOT.
 DRIVE MARKER
 #25815

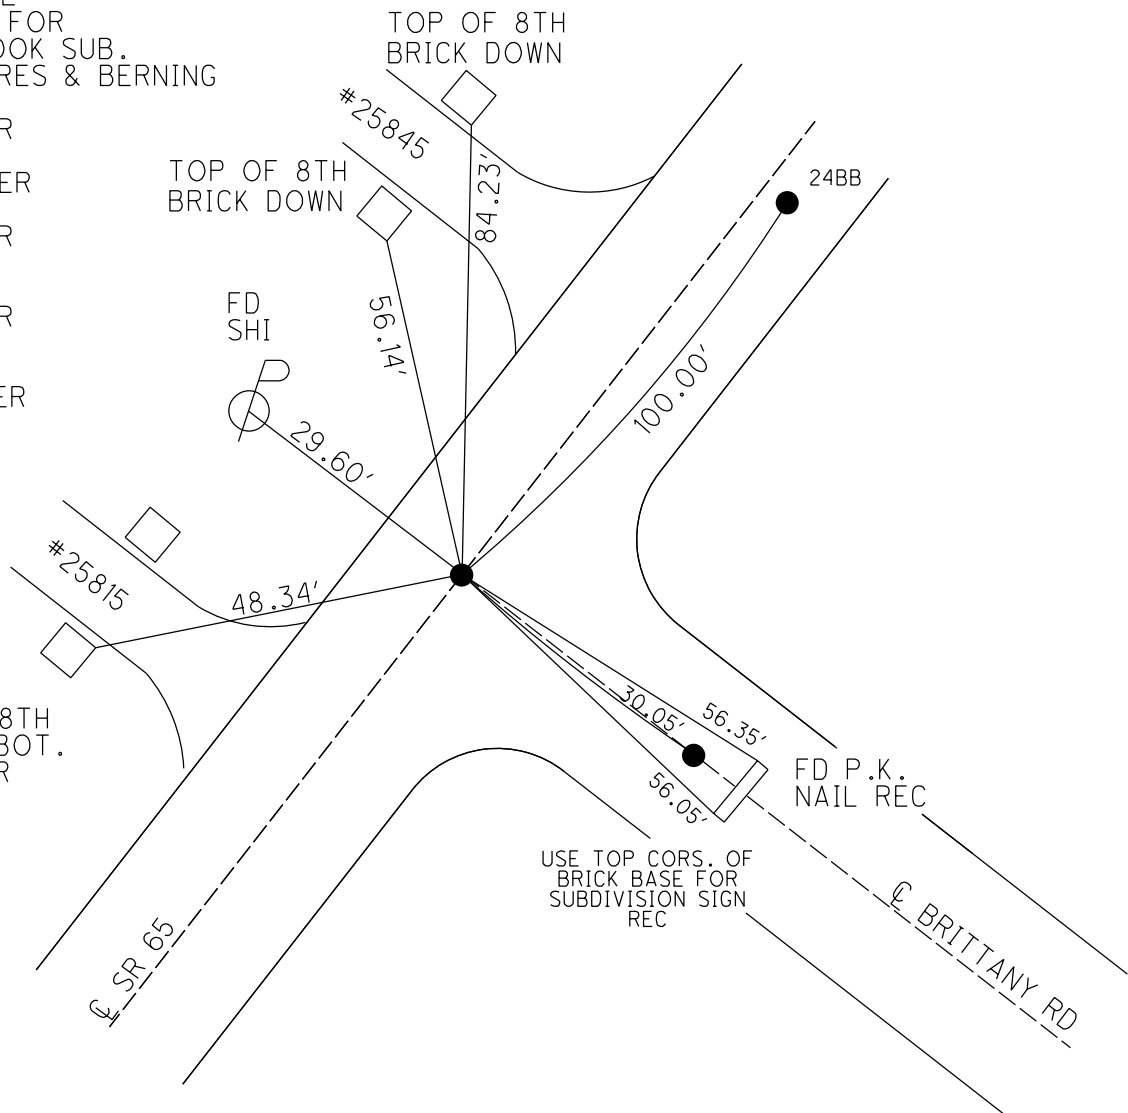

O.D.O.T. DISTRICT 2 SURVEY OFFICE (USE ONLY)


PERSONNEL

REFERENCE NO. 24 B SHEET 24 OF 44


NOTES	LEU	DATE	6/12/14	ROUTE	SR 65
H.C.	MOSER	WEATHER	CLOUDY	COUNTY	WOOD
R.C.	WESTFALL	TEMP.	71°	TOWNSHIP	PERRYSBURG
	RHOADES			SECTION	RT 57
				T	7 N R 10 E

TYPE MONUMENT P.K./WASHER
ON SURFACE - ~~BELOW~~ ON
~~LEFT~~ - C PAV'T - RIGHT 1'
10.7' TO LT EDGE PAVEMENT
S.L.M. 739+00.02

Grid: Northing: 679850.697 Easting: 1640422.514

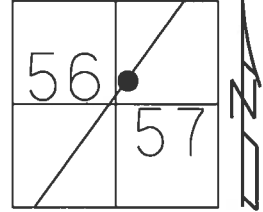

RECORD:
FD LG.R.R.SPIKE
SET BY H.FREY FOR
THE WILLOWBROOK SUB.
-FARNHAM, WIRRES & BERNING
10/17/84
FD P.K./WASHER
5/23/95, SAH
SET P.K./WASHER
8/8/95, SAH
FD P.K./WASHER
REFB24
9/18/12, SAH
FD P.K./WASHER
REFB24
6/12/14, DCH
SET MAG/WASHER
3/16/16, DCH

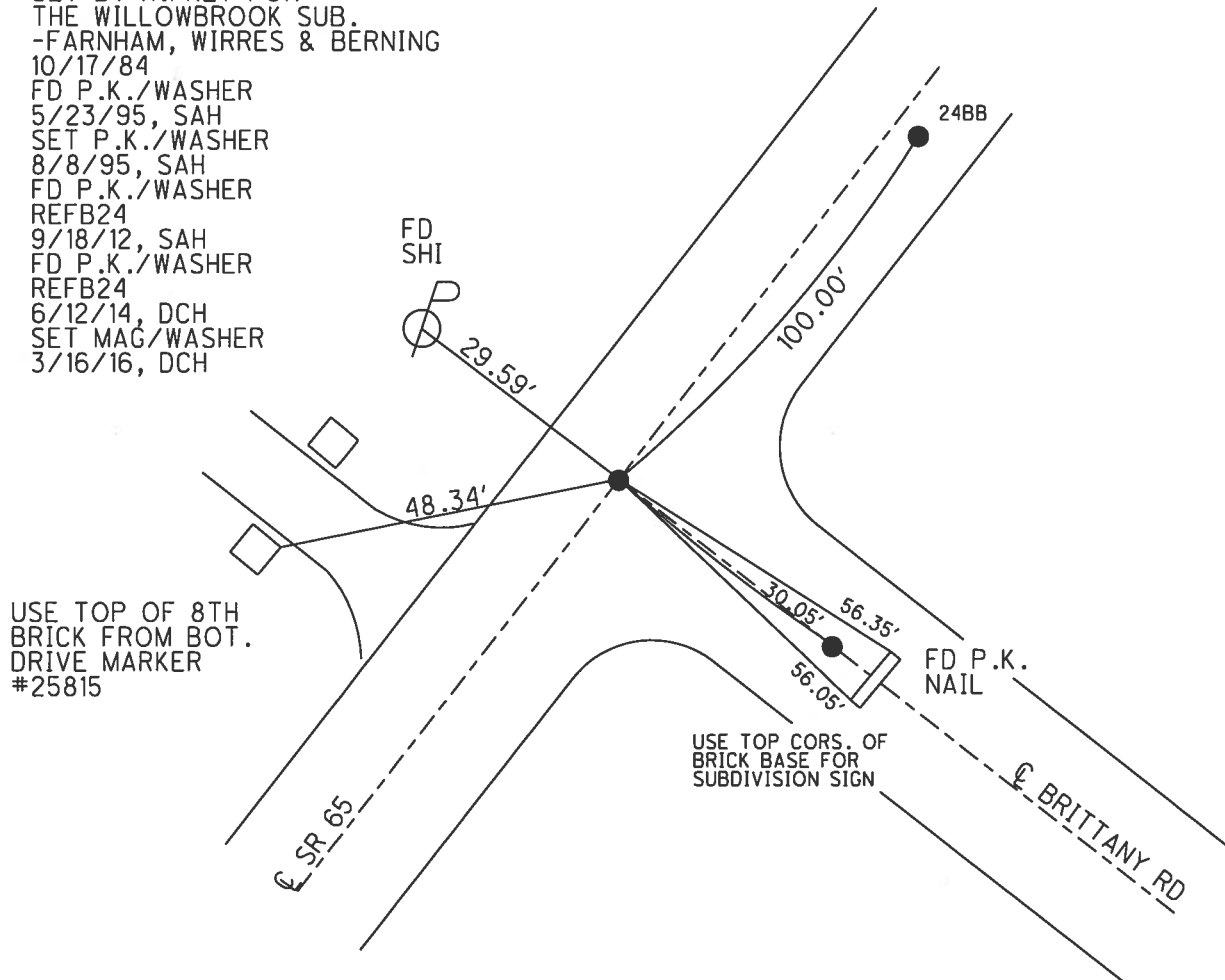

O.D.O.T. DISTRICT 2 SURVEY OFFICE (USE ONLY)

PERSONNEL

REFERENCE NO.

24 B

SHEET 24 OF 44

NOTES, VAN DUSEN

DATE 5/23/95

ROUTE SR 65

H.C. MOSER

WEATHER SUNNY

COUNTY WOOD

R.C. HUSS

TEMP. 80°

TOWNSHIP PERRYSBURG

CORDES

SECTION RT 57

T_7_N R_10_E

TYPE MONUMENT P.K./WASHER


ON SURFACE - ~~BELOW~~ ON

LEFT - C PAV'T - RIGHT ON

10.7' TO LT EDGE PAVEMENT

S.L.M. 739+00.02

Grid: Northing: 679850.697 Easting: 1640422.514

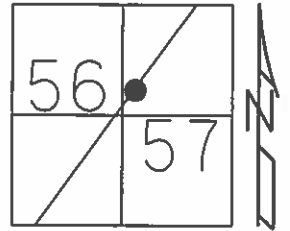

RECORD:

FD LG.R.R.SPIKE

AT SURFACE.

SET BY H.FREY FOR


THE WILLOWBROOK SUB.

-FARNAHM, WIRRES & BERNING

10/17/84

SET P.K./WASHER

8/8/95, SAH

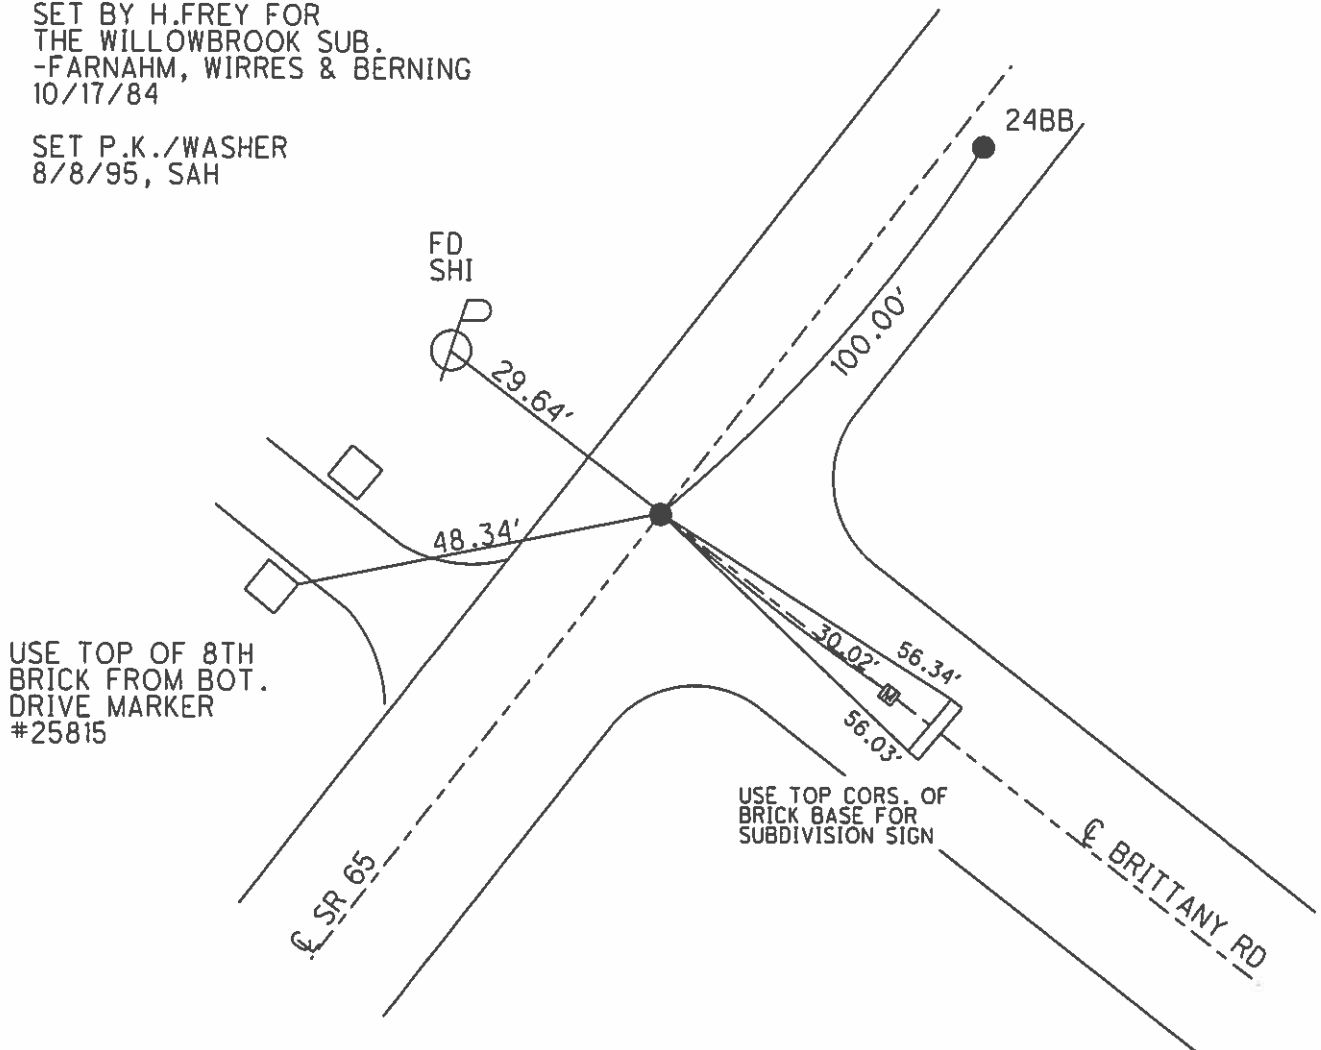

O.D.O.T. DISTRICT 2 SURVEY OFFICE

PERSONNEL

REFERENCE NO. _____

SHEET 53 OF 91

NOTES VAN DUSEN

H.C. MOSEY

R.C. HUSS

COLAES

DATE 5-23-95

WEATHER SUNNY

TEMP. +80°F

ROUTE Wood

COUNTY SR-65

TOWNSHIP Pennsburg

SECTION R.T. 57-58

T 7 N R 10 E

TYPE MONUMENT PK/WASHER

ON SURFACE - BELOW


~~LEFT~~ - PAV'T. - RIGHT A=4 B=3.0' RT

TO RT EDGE PAVEMENT

S.L.M. A = 736+99 B = 737+99

24-B

24-C

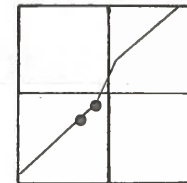


RECORD PT A.

FD LARGE R.F. SPK @
SURFACE & PAVT
S.R. US 10.7' LTER.
SET BY H. FREY FOR
WILLIAM BEND SUB.
(FARNAHM, WILKES & BERNING)
10-17-84

RECORD PT B.

FD. SMALL R.F. SPK
@ SURFACE
SLM 737+99

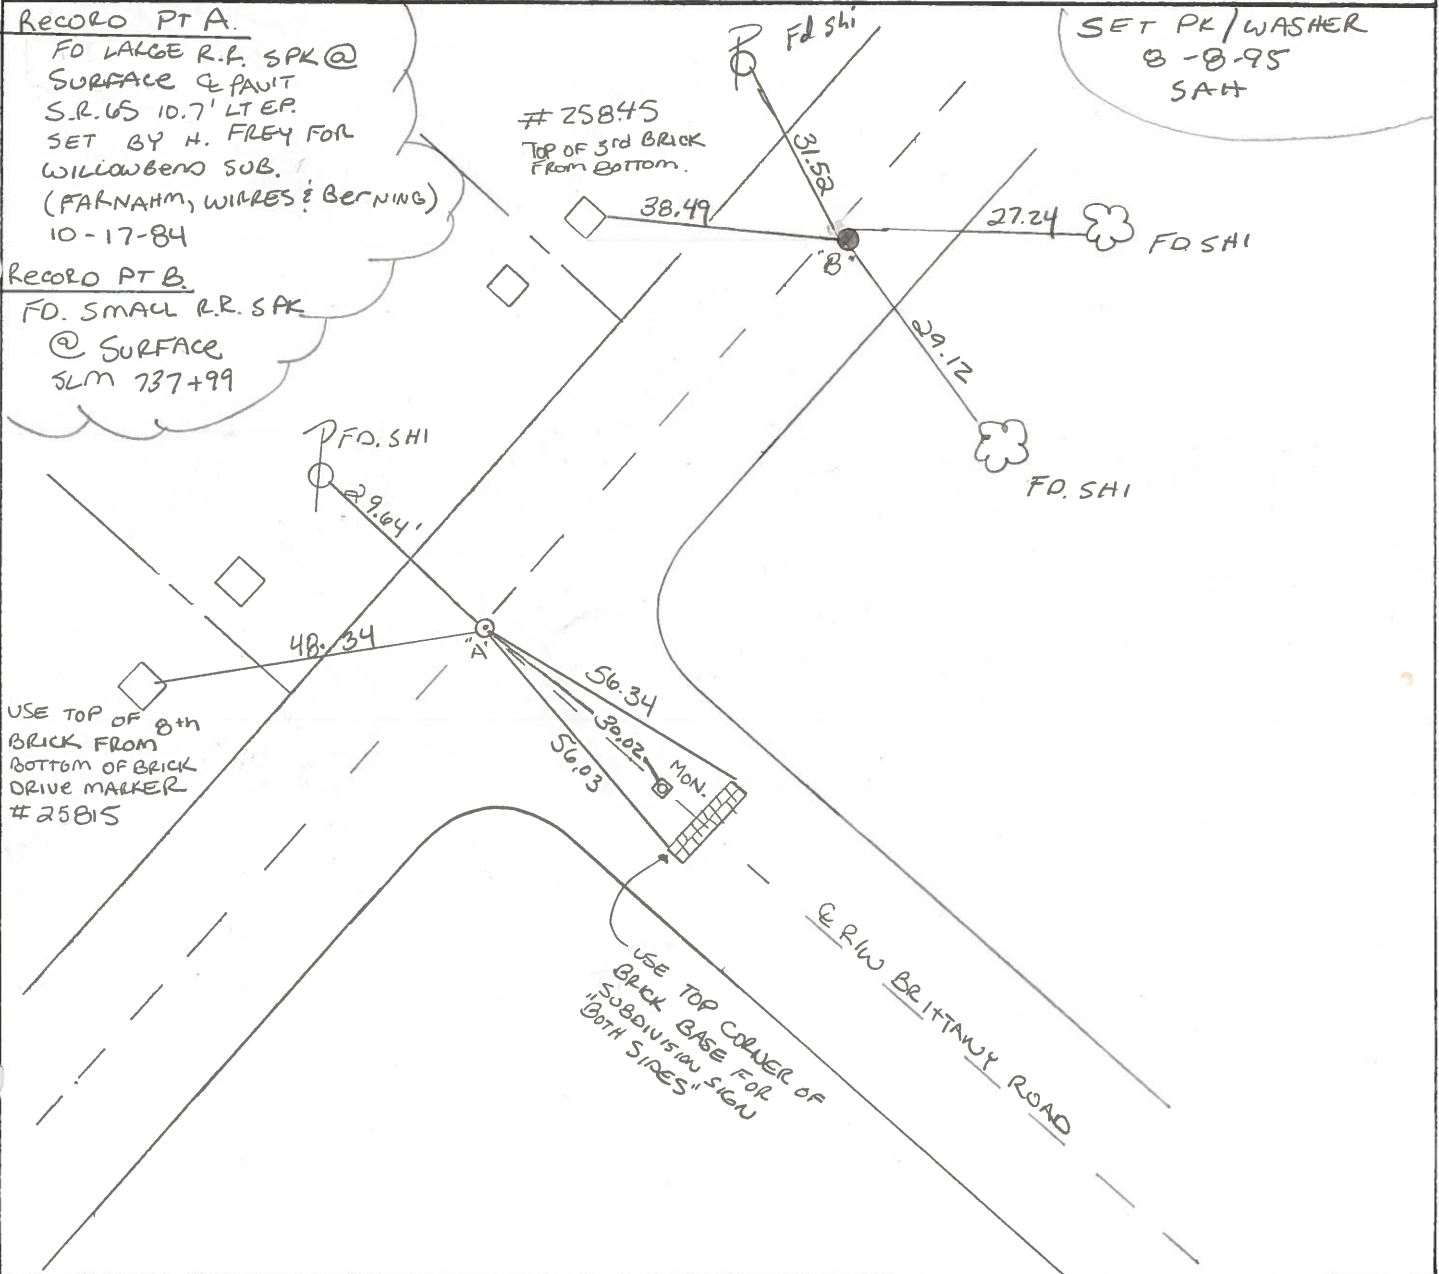

County WOOD S.R. 65Township PERRYSBURGSection RT. 57-58 (Willow Bend Sub.)

T7N, R10E

Personnel HOFFMANLOEHRKEHOUSEHENDER H.C.BARNHISEL R.C.Date 4-16-84Weather CloudyTemp. 45°

RT	RT
57	58



SET P.K./WASHER

10-17-84

S.W.H.

SLM 737+99

Fcl small R.R. spk @ surface

1.8' RT. of & Pant

7.7' TO RT. EP

11.1' TO LT. EP

Record:

P.I. = 738+90.6

 $\Delta = 21^\circ$ 