


O.D.O.T. DISTRICT 2 SURVEY OFFICE (USE ONLY)


PERSONNEL _____ REFERENCE NO. 24 D SHEET 26 OF 44
 NOTES NEISE DATE 10/28/24 ROUTE SR 65
 H.C. NEISE WEATHER CALM COUNTY WOOD
 R.C. PRESTON-COLVIN TEMP. 60° TOWNSHIP PERRYSBURG
 _____ SECTION RT 57
 _____ T 7 N R 10 E

TYPE MONUMENT MAG/WASHER
 ON SURFACE - ~~BELOW~~ ON
 LEFT - ℄ PAV'T - ~~RIGHT~~ 1.5'
8.6' TO LT EDGE PAVEMENT
 S.L.M. 741+70.63

Grid: Northing: 680083.077 Easting: 1640560.846

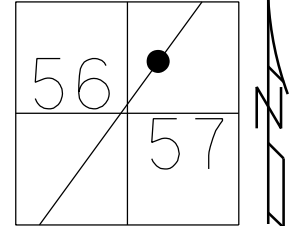


RECORD: P.C.
 STA. 740+61.32
 FD SM.R.R.SPIKE
 4/18/84
 FD P.K./WASHER
 5/23/95, SAH
 SET P.K./WASHER
 8/8/95, SAH
 FD P.K./WASHER
 REFD24
 9/18/12, SAH
 FD P.K.NAIL
 REFD24
 6/12/14, DCH
 SET MAG/WASHER
 3/16/16, DCH
 SET MAG/WASHER
 REF24D
 10/28/24, TDN

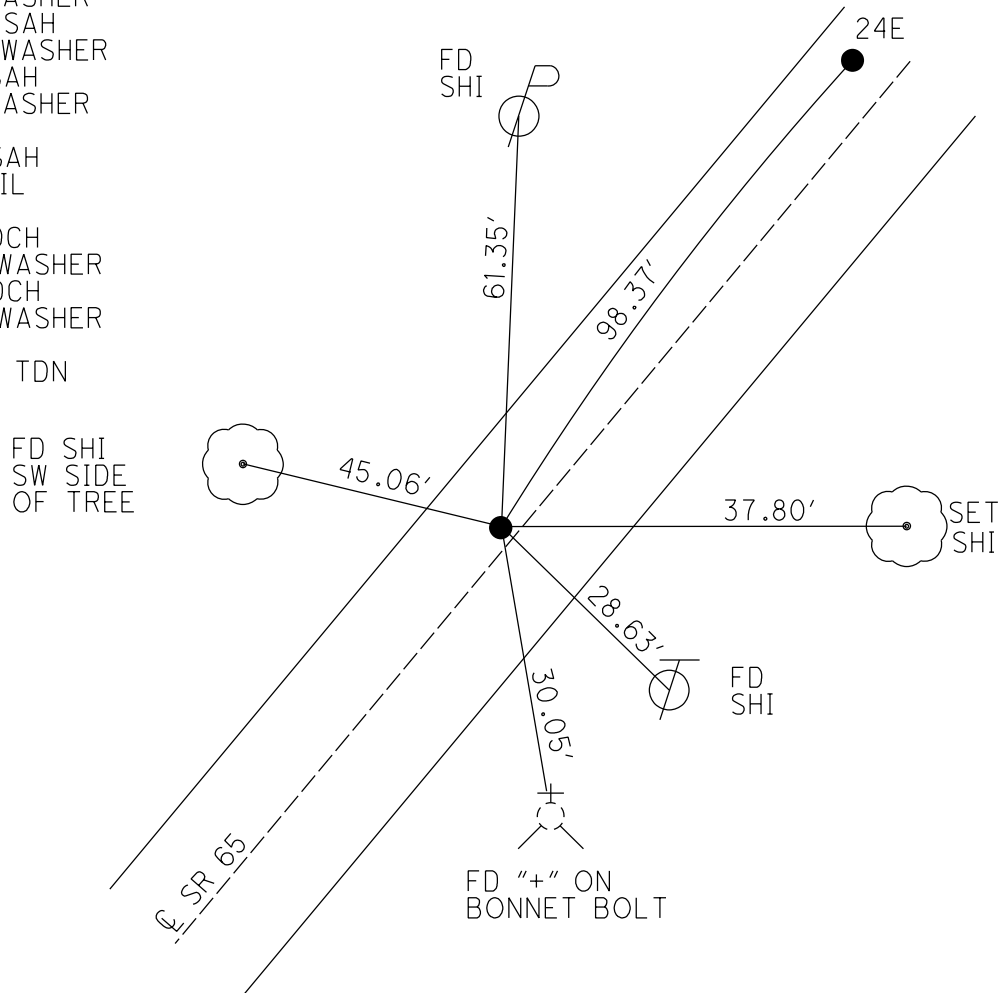


O.D.O.T. DISTRICT 2 SURVEY OFFICE (USE ONLY)

PERSONNEL	REFERENCE NO. <u>24 D</u>	SHEET <u>26</u> OF <u>44</u>	
NOTES <u>LEU</u>	DATE <u>6/12/14</u>	ROUTE <u>SR 65</u>	
H.C. <u>HOMAN</u>	WEATHER <u>CLOUDY</u>	COUNTY <u>WOOD</u>	
R.C. <u>WESTFALL</u>	TEMP. <u>72°</u>	TOWNSHIP <u>PERRYSBURG</u>	
<u>RHOADES</u>		SECTION <u>RT 57</u>	
		T <u>7</u> N R <u>10</u> E	

TYPE MONUMENT P.K.NAIL
 ON SURFACE - ~~BELOW~~ ON
 LEFT - C PAV'T - ~~RIGHT~~ 1.4'
8.6' TO LT EDGE PAVEMENT
 S.L.M. 741+70.63

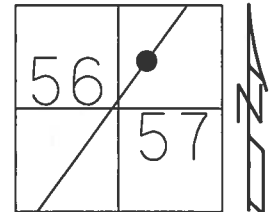

RECORD: P.C.
 STA. 740+61.32
 FD SM.R.R.SPIKE
 4/18/84
 FD P.K./WASHER
 5/23/95, SAH
 SET P.K./WASHER
 8/8/95, SAH
 FD P.K./WASHER
 REFD24
 9/18/12, SAH
 FD P.K.NAIL
 REFD24
 6/12/14, DCH
 SET MAG/WASHER
 3/16/16, DCH

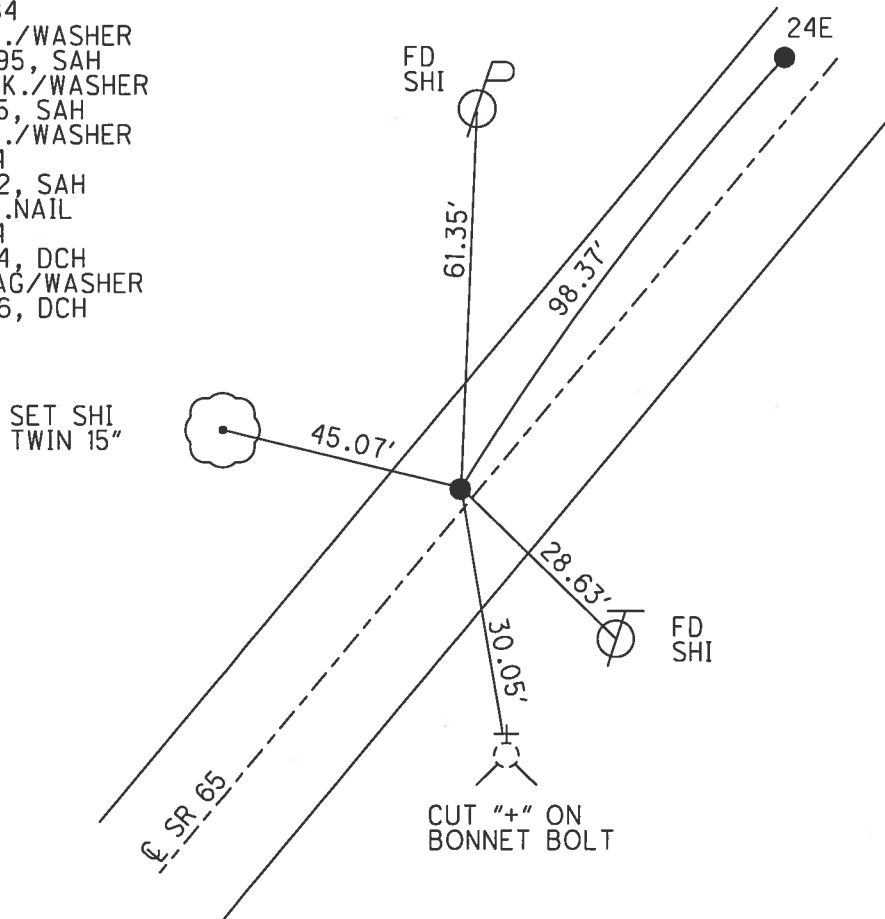


O.D.O.T. DISTRICT 2 SURVEY OFFICE (USE ONLY)

PERSONNEL	REFERENCE NO. <u>24 C</u>	SHEET <u>26</u> OF <u>44</u>
NOTES <u>VAN DUSEN</u>	DATE <u>5/23/95</u>	ROUTE <u>SR 65</u>
H.C. <u>MOSER</u>	WEATHER <u>SUNNY</u>	COUNTY <u>WOOD</u>
R.C. <u>HUSS</u>	TEMP. <u>80°</u>	TOWNSHIP <u>PERRYSBURG</u>
<u>CORDES</u>		SECTION <u>RT 57</u>
		T <u>7</u> N R <u>10</u> E


TYPE MONUMENT P.K./WASHER
 ON SURFACE - ~~BELOW~~ ON
 LEFT - CL PAV'T - ~~RIGHT~~ 1.4'
8.6' TO LT EDGE PAVEMENT
 S.L.M. 741+70.63

Grid: Northing: 680083.077 Easting: 1640560.846

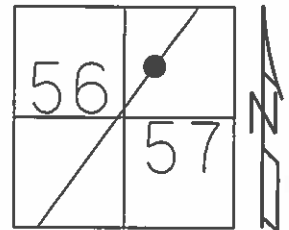

RECORD: P.C.
 FD SM.R.R.SPIKE
 4/18/84

SET P.K./WASHER
 8/8/95, SAH

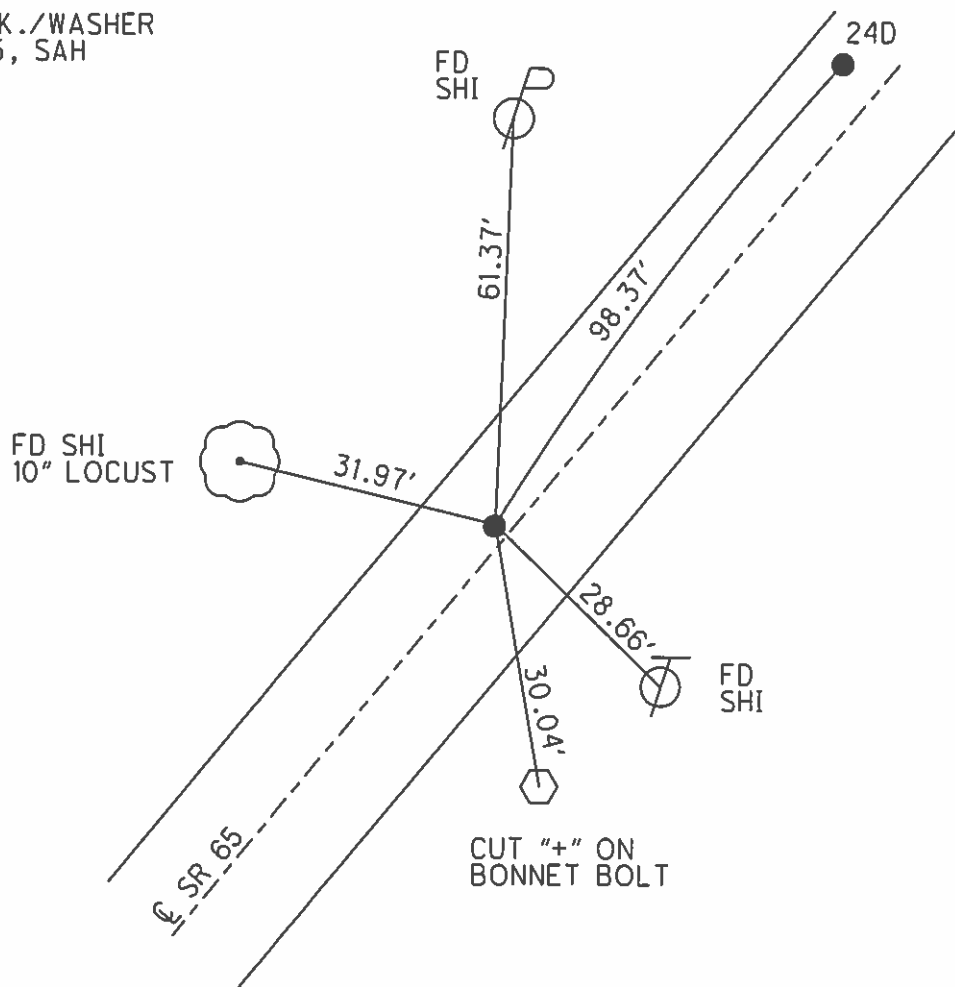

O.D.O.T. DISTRICT 2 SURVEY OFFICE

PERSONNEL

REFERENCE NO. _____

SHEET 54 OF 91

NOTES VANAJSEN

H.C. MOSEL

R.C. HUSS

CORDES

DATE 5-23-95

WEATHER Sunny

TEMP. +80°F

ROUTE SR 65

COUNTY WOOD

TOWNSHIP Perryburg

SECTION R.T. 58 (Willow bend)

T. 7 N R. 12 E

TYPE MONUMENT PK / WASHER (MAG LITE'S)

ON SURFACE - BELOW

LEFT - C PAV'T. - RIGHT A=1.4 LT B=5.2 LT C=0.5 LT

TO EDGE PAVEMENT

S.L.M. A=740+61.32 B=741+59.72 C=742+57.55

24-D

24-E

24-F

RT	RT
57	58



RECORD PTA

FD. SM. RR. SPK @ SURF.

RECORD P.C. 740+61.32

4-18-84

RECORD PT B

FD. SM. RR. SPK @ SURF.


PI=741+59.72

$\Delta = 70^\circ - 50' - 51''$ RT

RECORD PTC

FD PK @ SURFACE

P.T. 742+57.55

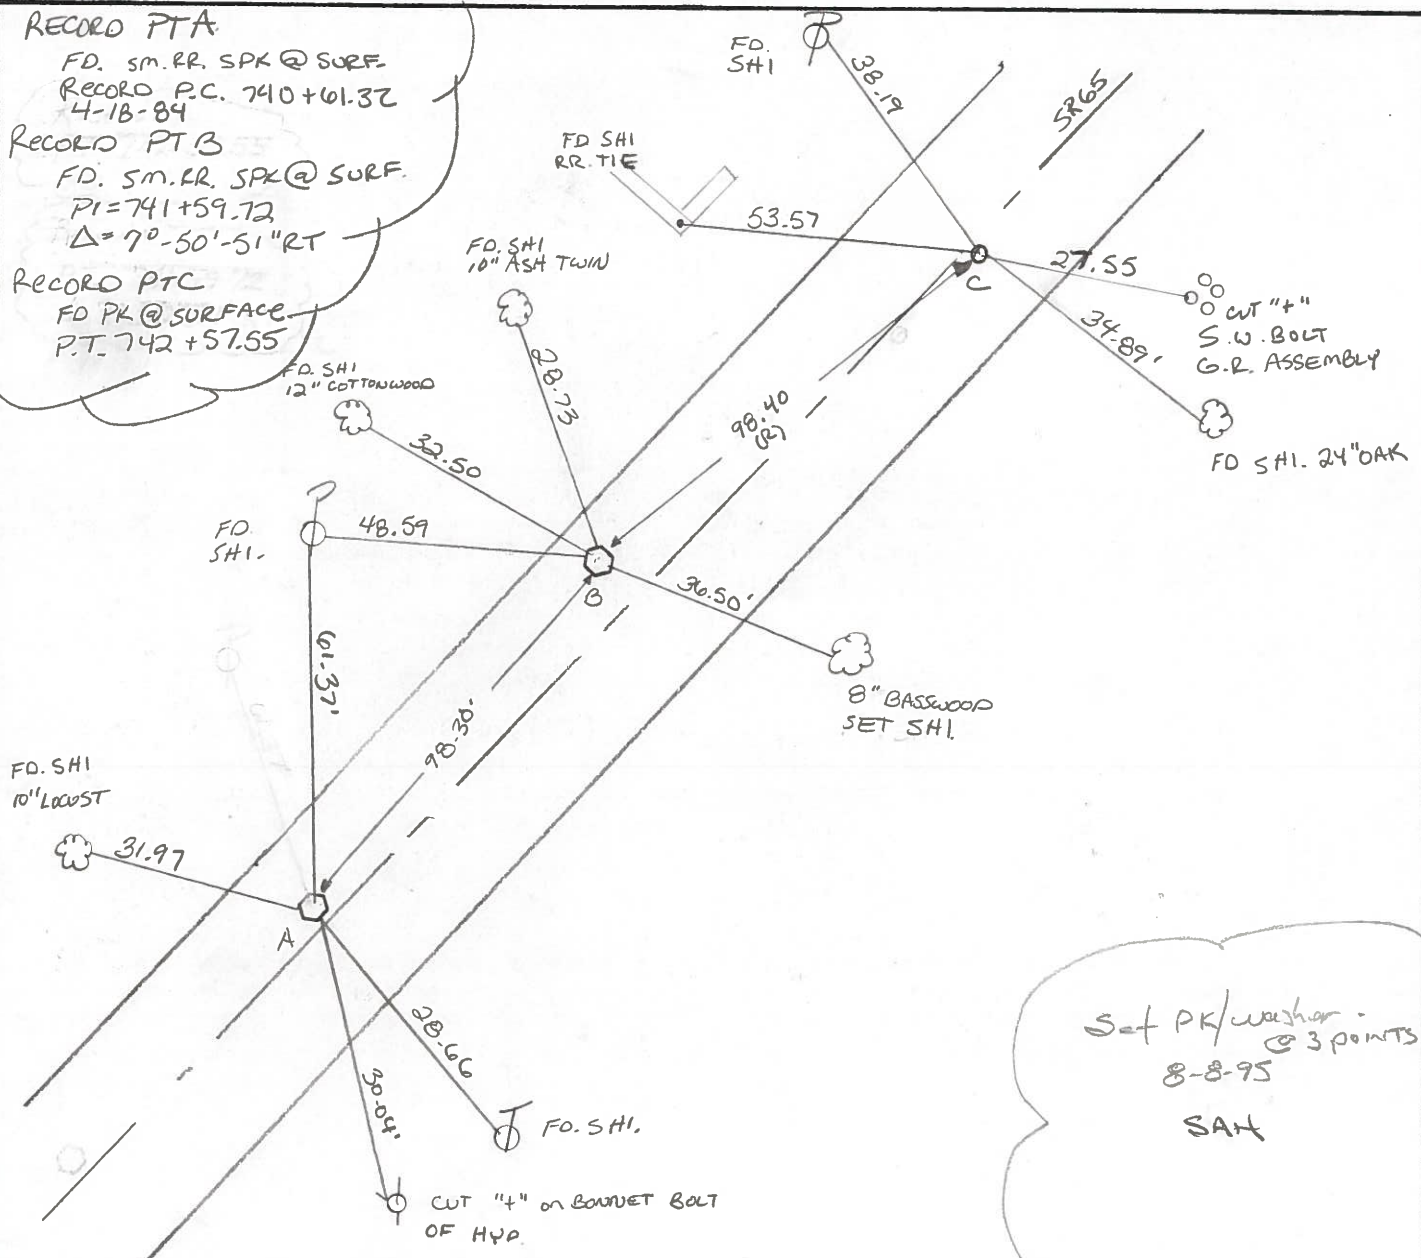


Set PK/washer
@ 3 points
8-8-95
SAH

County WOOD S.R. 65
 Township PERRYSBURG
 Section (WILLOWBEND SUBDIVISION)
 T7N, R10E
 Personnel BURNSIDE
 SMITH
 MEAD

Date 11-8-79
 Weather LT. RAIN
 Temp. +40°

24-D
24-E
24-F

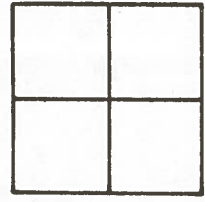

P.T.
 STA. 742+57.55
 F.D. P.K. NAIL
 @ SURFACE

P.I.
 STA. 741+59.72
 Δ = 7°50'51" Rt.
 F.D. SMALL R.R. SPK.
 @ SURFACE

P.C.
 STA. 740+61.32
 F.D. SMALL R.R. SPK.
 @ SURFACE

