


O.D.O.T. DISTRICT 2 SURVEY OFFICE (USE ONLY)

PERSONNEL _____ REFERENCE NO. 24 E SHEET 27 OF 44
NOTES NEISE DATE 10/28/24 ROUTE SR 65
H.C. NEISE WEATHER CALM COUNTY WOOD
R.C. PRESTON-COLVIN TEMP. 60° TOWNSHIP PERRYSBURG


SECTION RT 57
T 7 N R 10 E

TYPE MONUMENT MAG/WASHER
ON SURFACE - ~~BELOW~~ ON _____
LEFT - ℄ PAV'T - ~~RIGHT~~ 5.2'
4.7' TO LT EDGE PAVEMENT
S.L.M. 742+69

Grid: Northing: 680168.914 Easting: 1640608.897

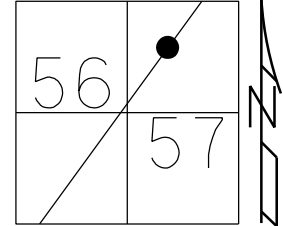


RECORD: P.I.
Δ = 7°50' 51" RT
STA. 741+59.72
FD SM.R.R.SPIKE
4/18/84
SET P.K./WASHER
8/8/95, SAH
FD P.K./WASHER
REFE24
9/18/12, SAH
FD P.K.NAIL
REFE24
6/12/14, DCH
SET MAG/WASHER
3/16/16, DCH
FD MAG/WASHER
REF24E
10/28/24, TDN

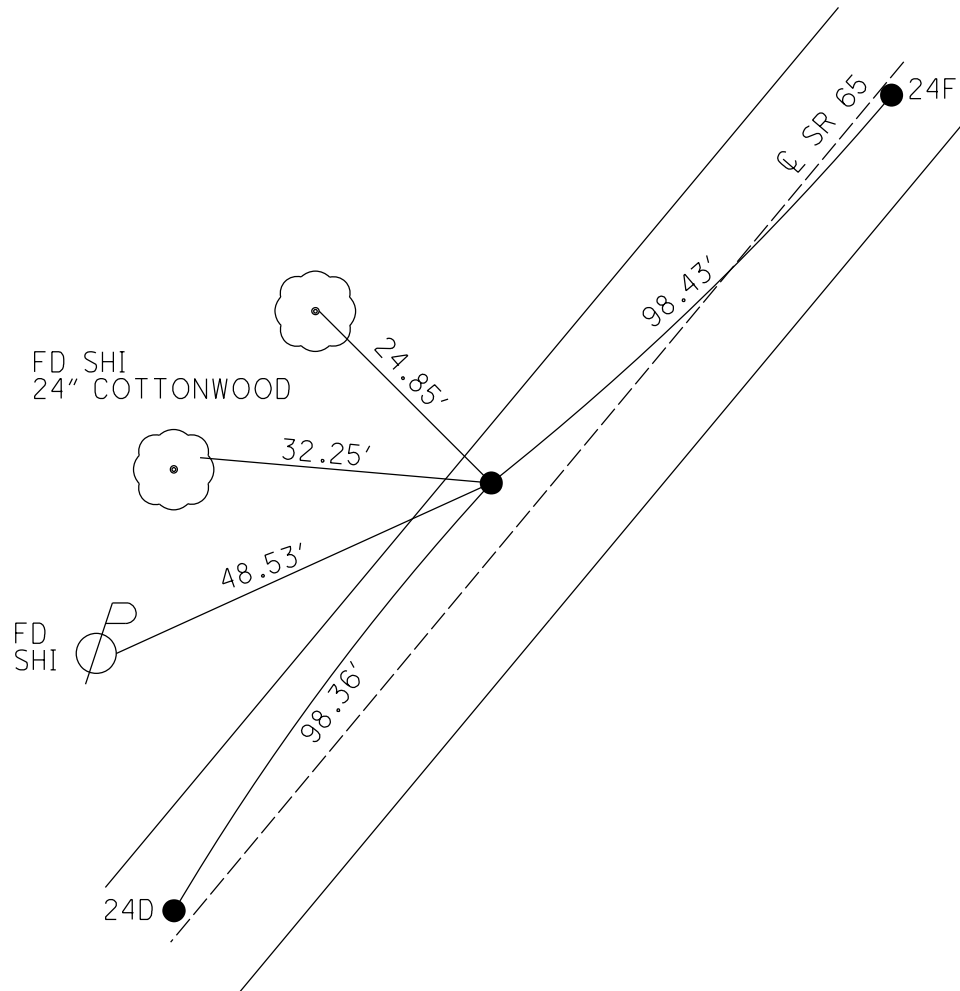


O.D.O.T. DISTRICT 2 SURVEY OFFICE (USE ONLY)

PERSONNEL	REFERENCE NO. <u>24 E</u>	SHEET <u>27</u> OF <u>44</u>
NOTES	DATE <u>6/12/14</u>	ROUTE <u>SR 65</u>
H.C. <u>HOMAN</u>	WEATHER <u>CLOUDY</u>	COUNTY <u>WOOD</u>
R.C. <u>WETFALL</u>	TEMP. <u>72°</u>	TOWNSHIP <u>PERRYSBURG</u>
<u>RHOADES</u>		SECTION <u>RT 57</u>
		T <u>7</u> N R <u>10</u> E

TYPE MONUMENT P.K./WASHER
 ON SURFACE - ~~BELOW~~ ON
 LEFT - ℄ PAV'T - ~~RIGHT~~ 5.2'
4.7' TO LT EDGE PAVEMENT
 S.L.M. 742+69

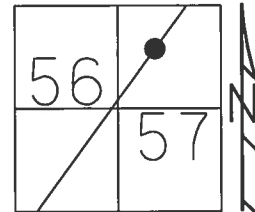

RECORD: P.I.
 $\Delta = 7^{\circ}50' 51''$ RT
 STA. 741+59.72
 FD SM.R.R.SPIKE
 4/18/84
 SET P.K./WASHER
 8/8/95, SAH
 FD P.K./WASHER
 REFE24
 9/18/12, SAH
 FD P.K.NAIL
 REFE24
 6/12/14, DCH
 SET MAG/WASHER
 3/16/16, DCH

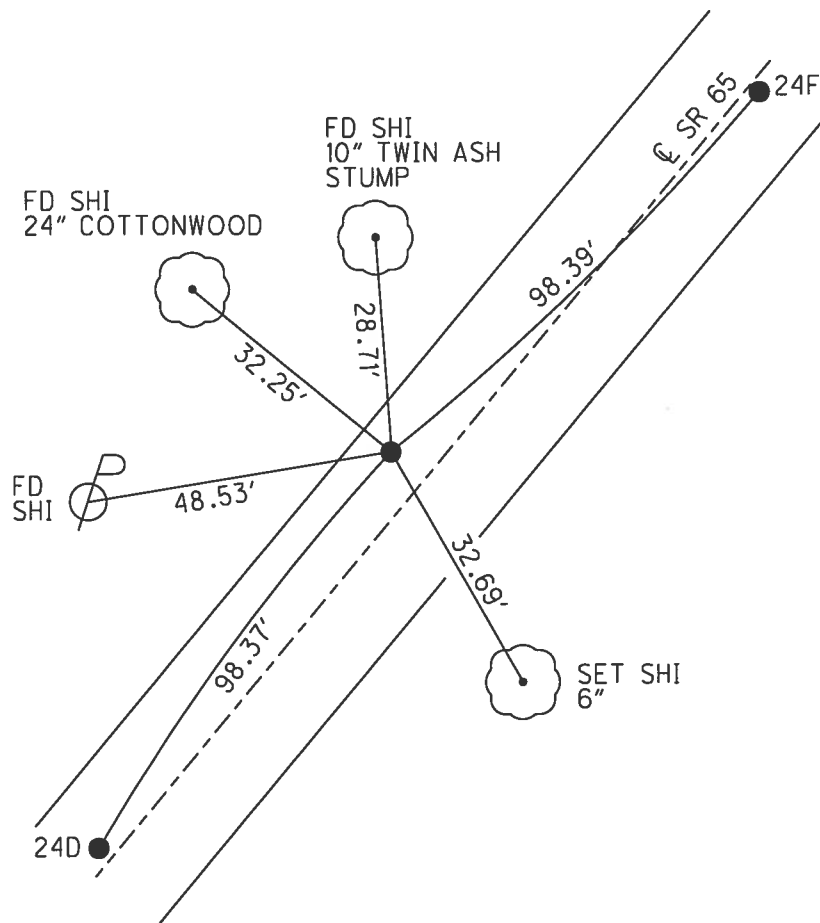

O.D.O.T. DISTRICT 2 SURVEY OFFICE (USE ONLY)

PERSONNEL


REFERENCE NO. 24 D SHEET 27 OF 44

NOTES VAN DUSEN
H.C. MOSER
R.C. HUSS
CORDES

DATE 5/23/95
WEATHER SUNNY
TEMP. 80°

ROUTE SR 65
COUNTY WOOD
TOWNSHIP PERRYSBURG
SECTION RT 57
T 7 N R 10 E


TYPE MONUMENT P.K./WASHER
ON SURFACE - ~~BELOW~~ ON
LEFT - CL PAV'T - ~~RIGHT~~ 5.2'
4.7' TO LT EDGE PAVEMENT
S.L.M. 742+69

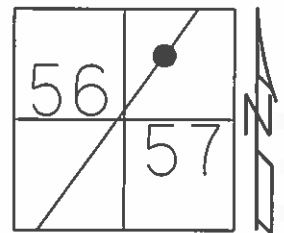

Grid: Northing: 680168.914 Easting: 1640608.897

RECORD: P.I.
 $\Delta = 7^{\circ} 50' 51''$ RT
FD SM.R.R.SPIKE
AT SURFACE
4/18/84

SET P.K./WASHER
8/8/95, SAH

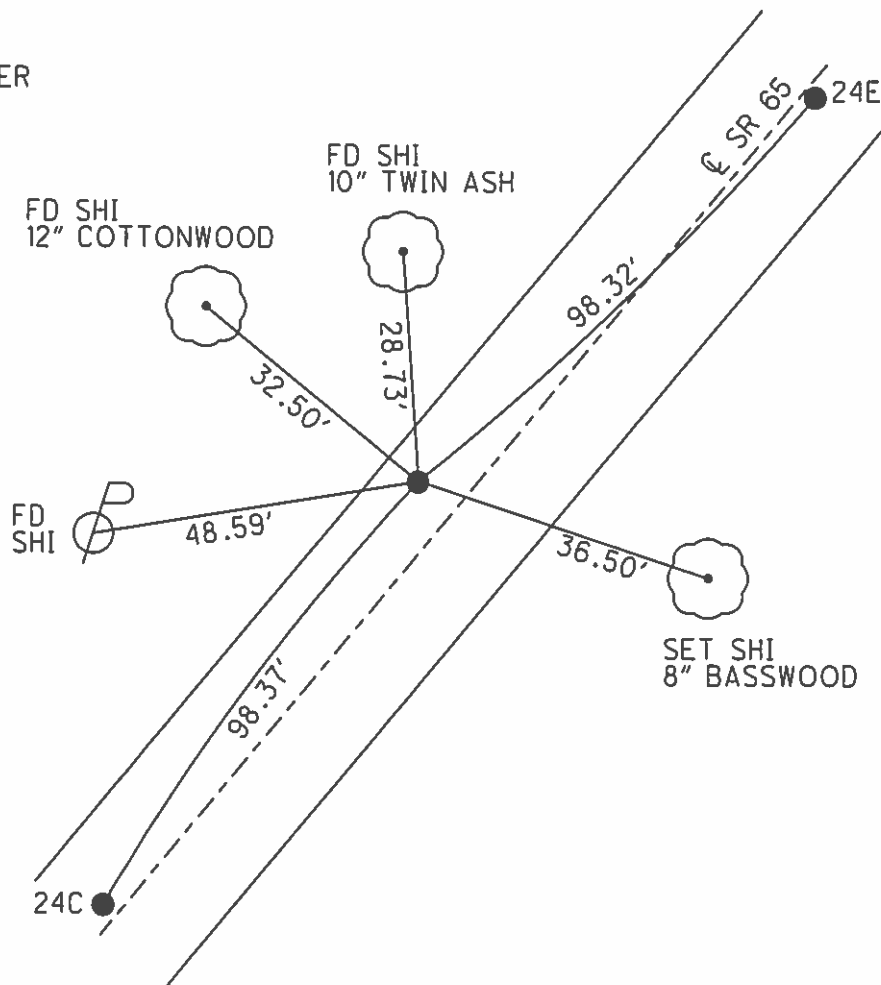

O.D.O.T. DISTRICT 2 SURVEY OFFICE

PERSONNEL

REFERENCE NO. _____

SHEET 54 OF 91

NOTES VANASEN

H.C. MOSEK

R.C. HUSS

CORDES

DATE 5-23-95

WEATHER SUNNY

TEMP. +80°F

ROUTE SR 65

COUNTY WOOD

TOWNSHIP Perryburg

SECTION R.T. 58 (Willowbend)

T 7 N R 10 E

TYPE MONUMENT PK / WASHER (MAG LITE'S)

ON SURFACE - BELOW

LEFT - C PAV'T. - RIGHT A=1.4LT B=5.2LT C=0.5'LT

TO EDGE PAVEMENT

S.L.M. A=740+61.32 B=741+59.72 C=742+57.55

24-D

24-E

24-F

RT	RT
57	58



RECORD PTA


FD. SM. RR. SPK @ SURF.
RECORD P.C. 740+61.32
4-18-84

RECORD PT B

FD. SM. RR. SPK @ SURF.
PI=741+59.72
 $\Delta=70-50'-51''$ RT

RECORD PTC

FD PK @ SURFACE
P.T. 742+57.55

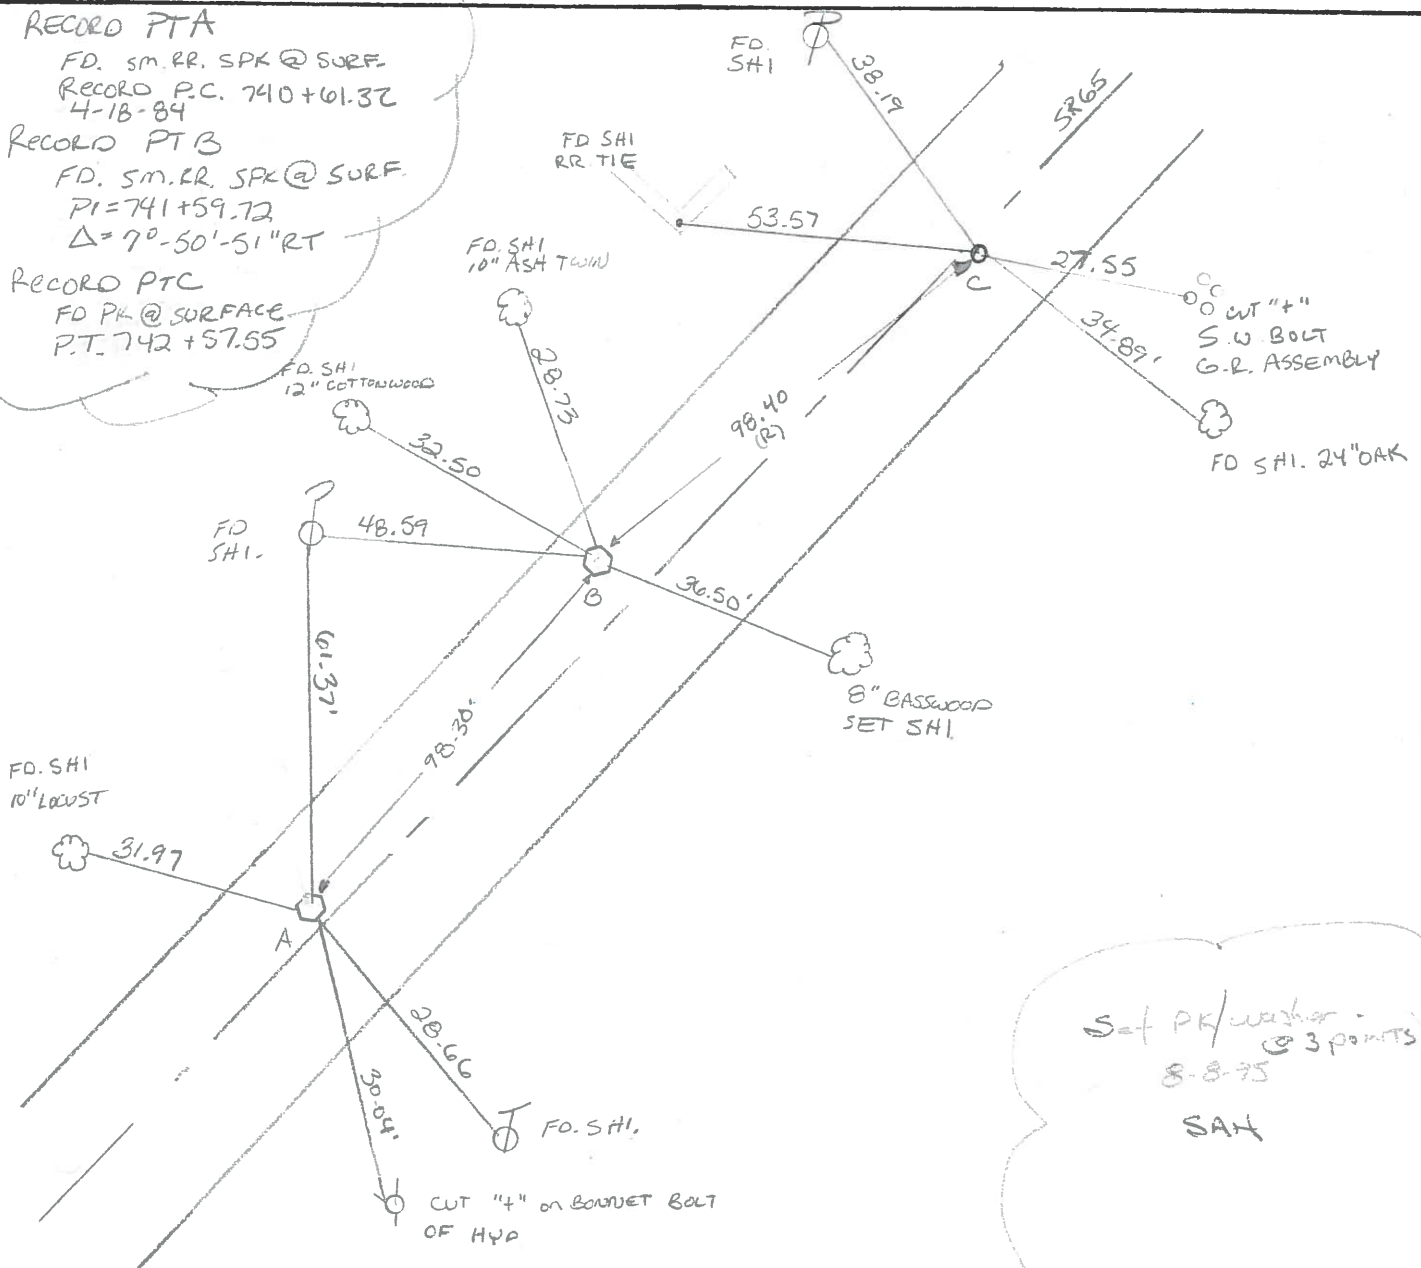

Set PK/washer
@ 3 points
8-8-95

SAH

PERSONNEL	TITLE	PERSONNEL	TITLE	COUNTY	DATE	WEATHER	TEMP.
Delventhal	Hoover			Wood	8		
Young	Butter			65	23-66	1	
	Delventhal			11.96-17.65			8
	Young						
	Hoff						

DESCRIPTION	CONTROL POINTS	JOB NO.
	LEFT	RIGHT

24-EShiner
in Twin 8"
Box ElderShiner
in 5'Shiner
in
P
PShiner
in 18" Oak

OK-2-23-66

Placed PK 12-5-60

Found R.R. spike (small)
3300' (approx.) N. of inter-
section of SR 65 & Roachton
Rd. (1± from R edge of part.)

24-G

Sh. 8" maple

Shiner
12" Ch. s. n. v.

S.R. 65

Note: LL - a

Placed PK 12-5-60

Found R.R. spike
240 (approx.) north
of inters. of
SR 65 & Roachton Rd.
4'± left of S

#748

edge of part

Near side (NW)
of Fire hydrant

#749