


O.D.O.T. DISTRICT 2 SURVEY OFFICE (USE ONLY)


PERSONNEL _____ REFERENCE NO. 24 F SHEET 28 OF 44
 NOTES NEISE DATE 10/28/24 ROUTE SR 65
 H.C. NEISE WEATHER CALM COUNTY WOOD
 R.C. PRESTON-COLVIN TEMP. 60° TOWNSHIP PERRYSBURG
 _____ SECTION RT 57
 _____ T 7 N R 10 E

TYPE MONUMENT MAG/WASHER
 ON SURFACE - ~~BELOW~~ ON
~~LEFT~~ - CL PAV'T - RIGHT 0.5'
9.7' TO RT EDGE PAVEMENT
 S.L.M. 743+67.32

Grid: Northing: 680247.408 Easting: 1640668.101

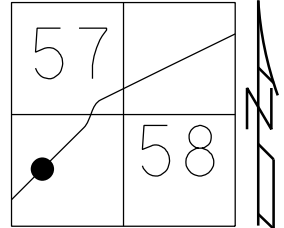

RECORD: P.T.
 STA. 742+57.55
 FD P.K./WASHER
 5/23/95, SAH
 SET P.K./WASHER
 8/8/95, SAH
 FD P.K./WASHER
 REFF24
 9/18/12, SAH
 FD P.K.NAIL
 REFF24
 6/12/14, DCH
 SET MAG/WASHER
 3/16/16, DCH
 SET MAG/WASHER
 REF24F
 10/28/24, TDN

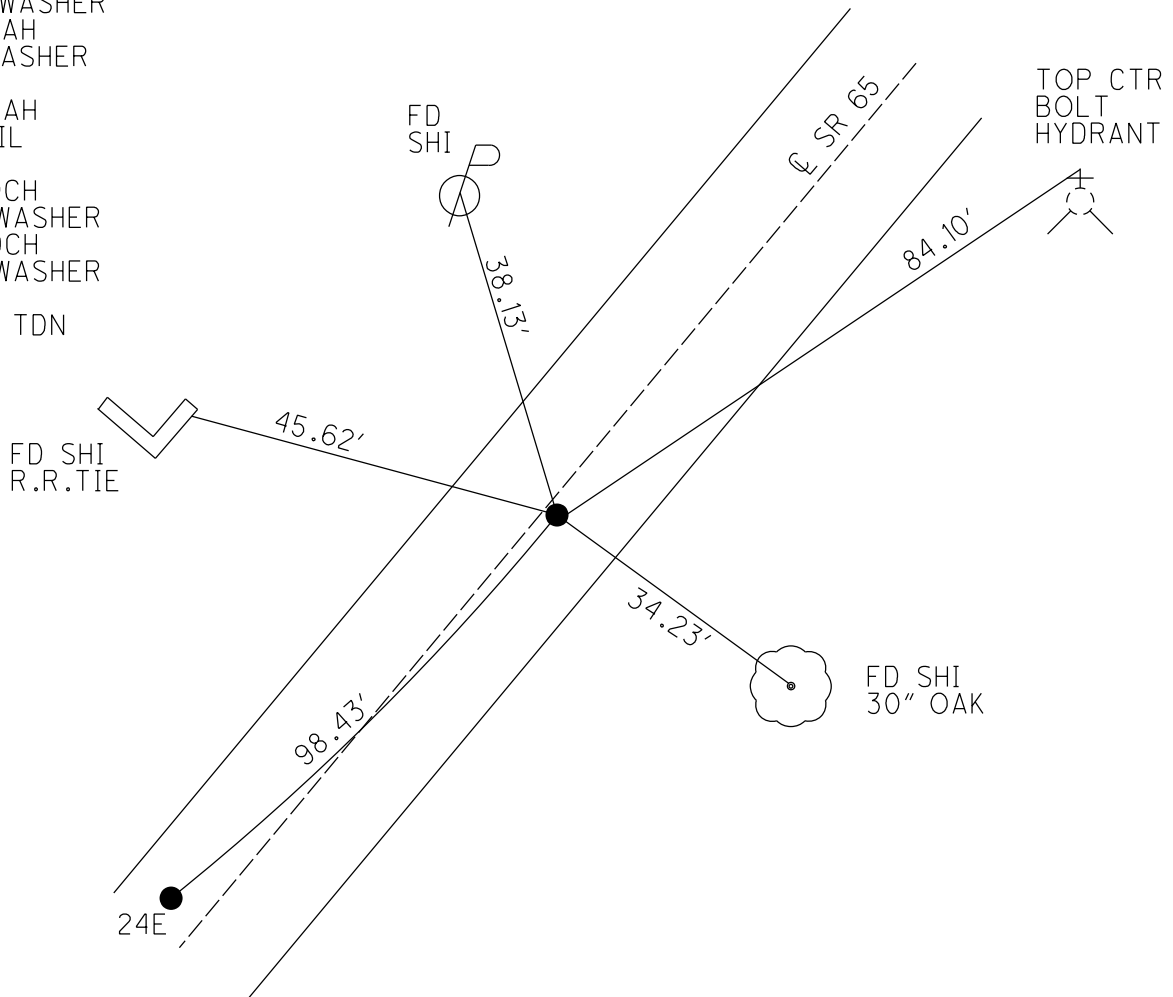

O.D.O.T. DISTRICT 2 SURVEY OFFICE (USE ONLY)

PERSONNEL

REFERENCE NO. 24 F

SHEET 28 OF 44

NOTES LEU

DATE 6/12/14

ROUTE SR 65

H.C. HOMAN

WEATHER CLOUDY

COUNTY WOOD

R.C. WESTFALL

TEMP. 72°

TOWNSHIP PERRYSBURG

RHOADES

SECTION RT 57

T 7 N R 10 E

TYPE MONUMENT P.K./WASHER


ON SURFACE - ~~BELOW~~ ON

LEFT - Q PAV'T - ~~RIGHT~~ 0.5'


9.7' TO RT EDGE PAVEMENT

S.L.M. 743+67.32

Grid: Northing: 680247.408 Easting: 1640668.101

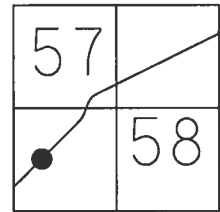

RECORD: P.T.
STA. 742+57.55
FD P.K./WASHER
5/23/95, SAH
SET P.K./WASHER
8/8/95, SAH
FD P.K./WASHER
REFF24
9/18/12, SAH
FD P.K.NAIL
REFF24
6/12/14, DCH
SET MAG/WASHER
3/16/16, DCH

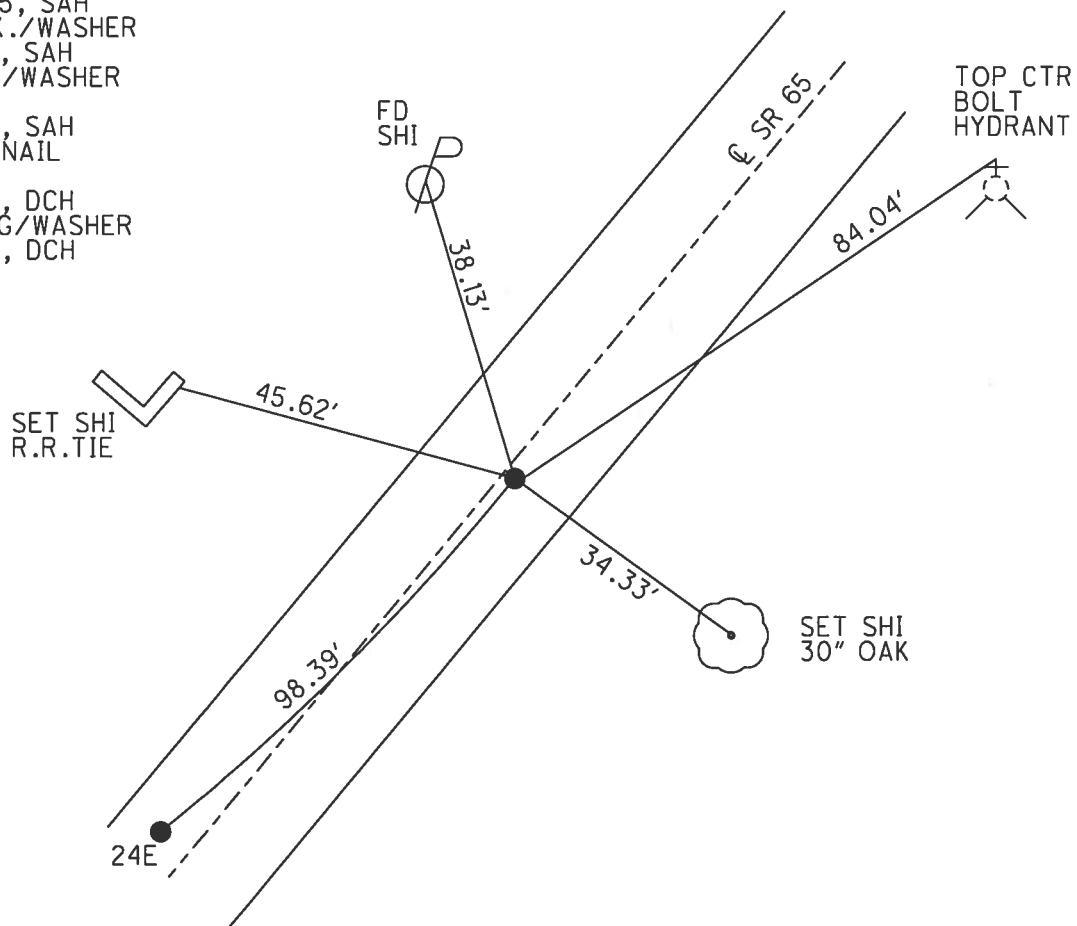

O.D.O.T. DISTRICT 2 SURVEY OFFICE (USE ONLY)

PERSONNEL

REFERENCE NO. 24 E SHEET 28 OF 44

NOTES VAN DUSEN

DATE 5/23/95

ROUTE SR 65

H.C. MOSER

WEATHER SUNNY

COUNTY WOOD

R.C. HUSS

TEMP. 80°

TOWNSHIP PERRYSBURG

CORDES

SECTION RT 57

T 7 N R 10 E

TYPE MONUMENT P.K./WASHER


ON SURFACE - ~~BELOW~~ ON

~~LEFT~~ - Q PAV'T - RIGHT 0.5'

9.7' TO RT EDGE PAVEMENT


S.L.M. 743+67.32

Grid: Northing: 680247.408 Easting: 1640668.101

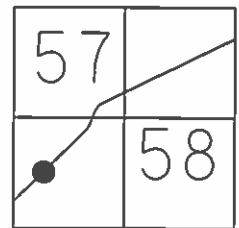

RECORD: P.T.
FD P.K. NAIL
AT SURFACE
4/18/84

SET P.K./WASHER
8/8/95, SAH

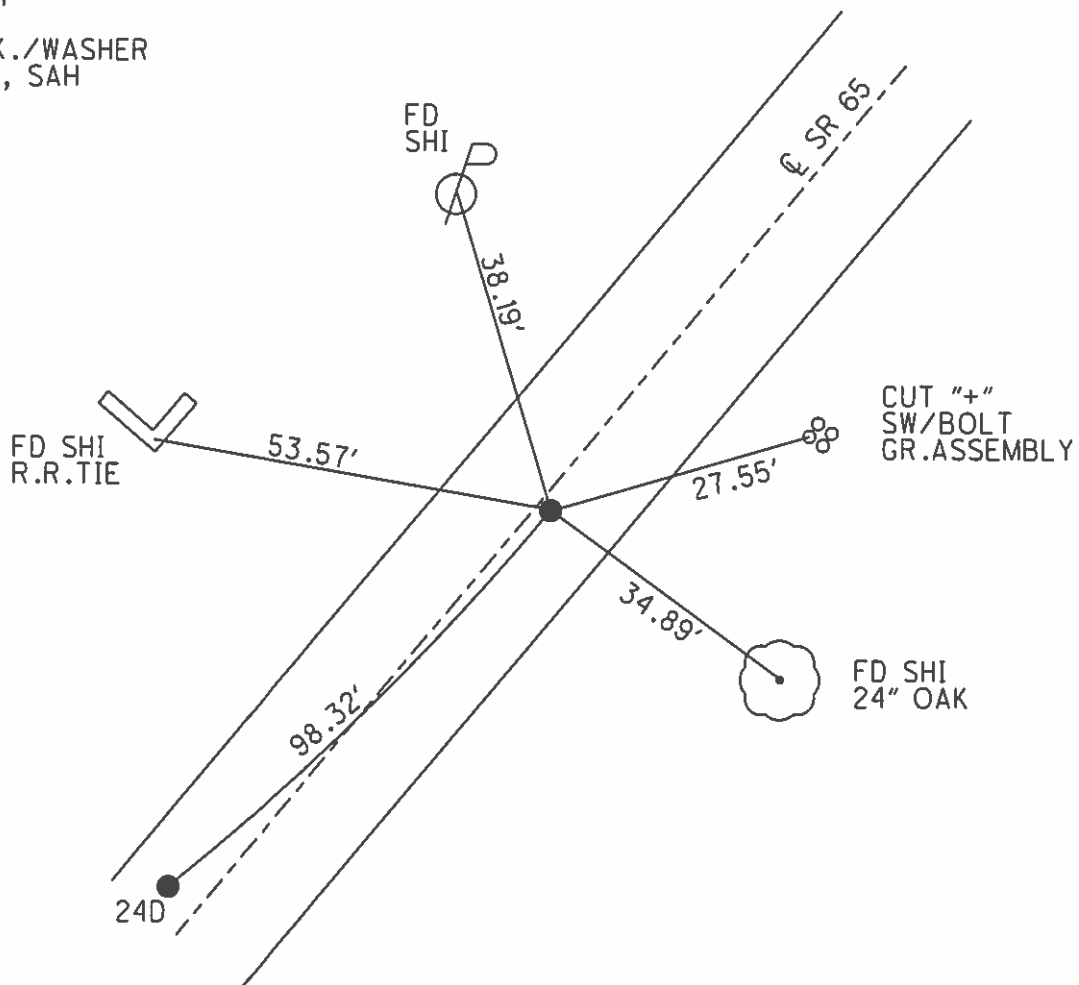

O.D.O.T. DISTRICT 2 SURVEY OFFICE

PERSONNEL

REFERENCE NO. _____

SHEET 54 OF 91

NOTES VANDUSEN

H.C. MOSE

R.C. HUSS

CORDES

DATE 5-23-95

WEATHER Sunny

TEMP. +80°F

ROUTE SR 65

COUNTY WOOD

TOWNSHIP Perryburg

SECTION R.T. 58 (Willow bend)

T. 7 N R. 10 E

TYPE MONUMENT PK / WASHER (MAG LITE'S)

ON SURFACE - BELOW

LEFT - C PAV'T. - RIGHT A=1.4LT B=5.2LT C=0.5'LT

TO EDGE PAVEMENT

S.L.M. A=740+61.32 B=741+59.72 C=742+57.55

24-D

24-E

24-F

RT	RT
57	58



RECORD PTA


FD. SM. RR. SPK @ SURF.
RECORD P.C. 740+61.32
4-18-84

RECORD PTB

FD. SM. RR. SPK @ SURF.
PI=741+59.72
 $\Delta=70-50'-51"$ RT

RECORD PTC

FD PK @ SURFACE
P.T. 742+57.55

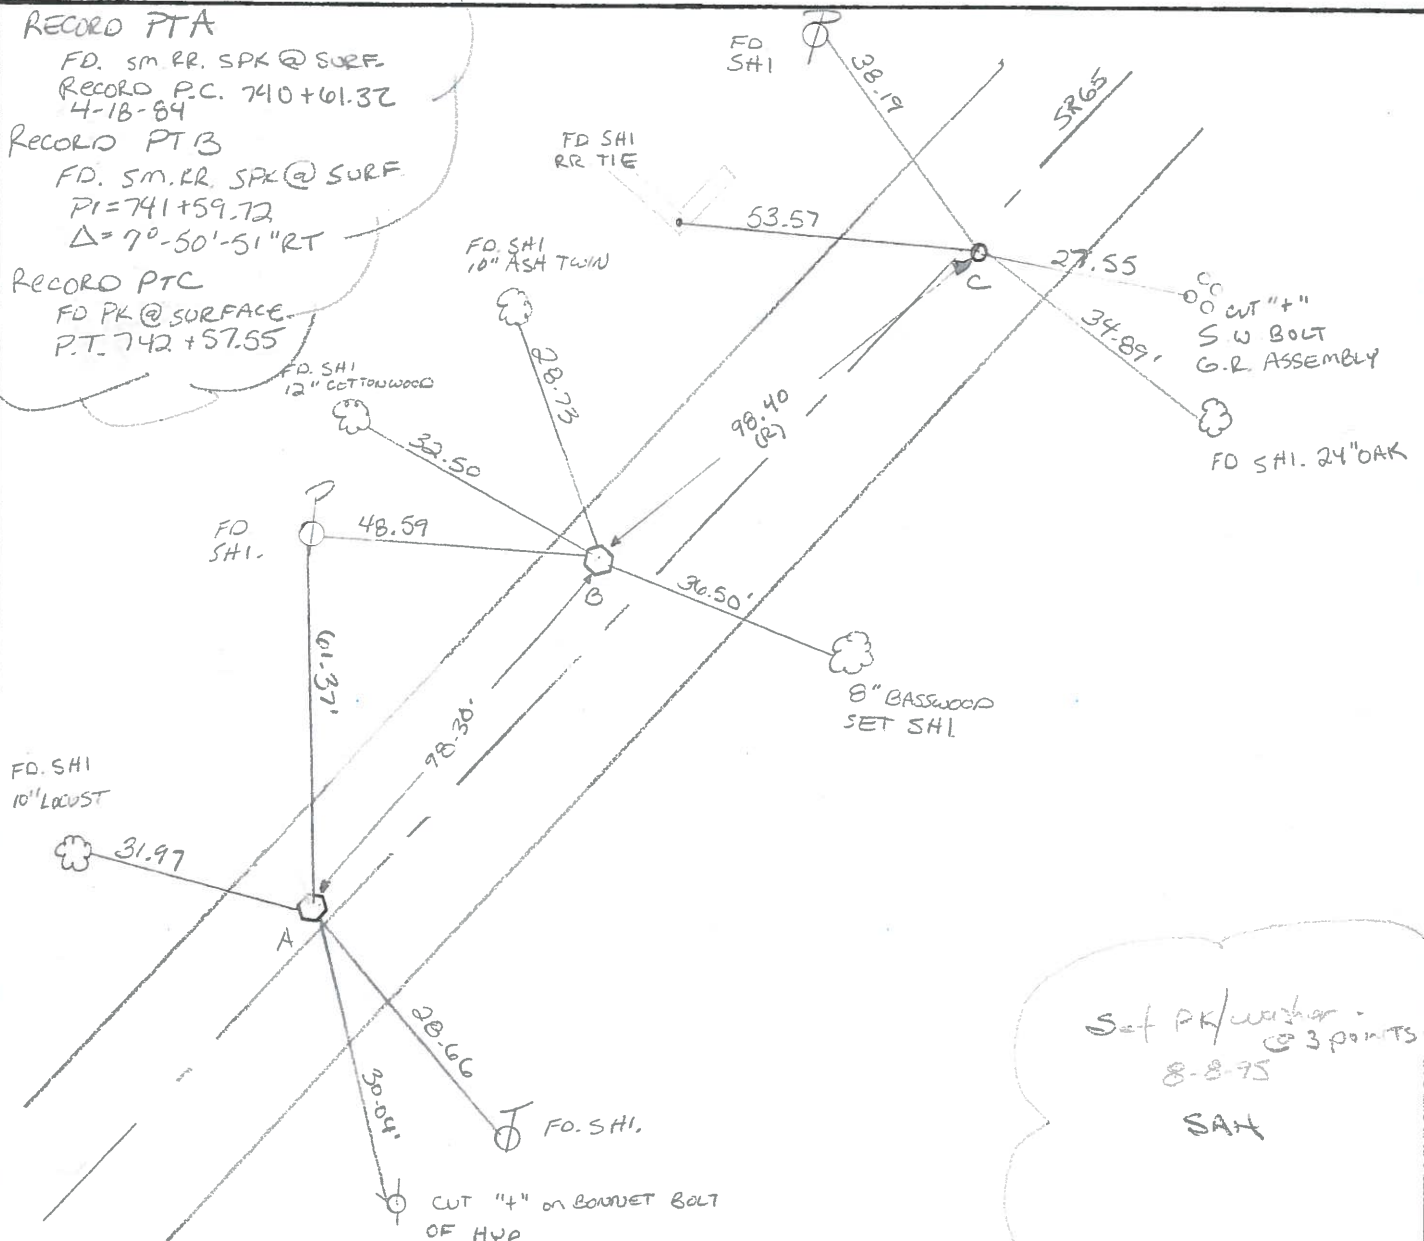

Set PK/washer
@ 3 points
8-8-95
SAH

Q.D.O.T. DISTRICT 2 SURVEY OFFICE

Sht. 2 of 3


County Wood S.R. 65
 Township PERRYSBURG
 Section (WILLOWBEND SUBDIVISION)

Date 11-8-79
 Weather LT. RAIN
 Temp. +40°


T7N, R10E

Personnel BURNSIDE
SMITH
MEAD

24-D
24-E
24-F

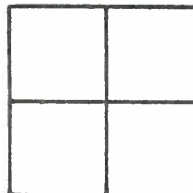

P.T.
 STA. 742+57.55
 F.D. P.K. NAIL
 @ SURFACE

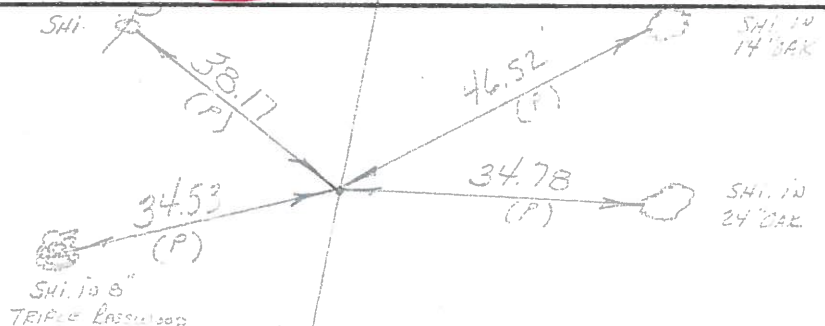

SHI IN
 TWIN 8\"/>

SHI IN
 8\"/>

P.I.
 STA. 741+59.72
 $\Delta = 7^{\circ}50'51''$ Rt.
 F.D. SMALL R.R. SPK.
 @ SURFACE

CURVE DATA:
 $\Delta = 7^{\circ}50'51''$ Rt.
 $R = 1432.64$
 $L = 196.23$
 $T = 98.40'$
 $D = 4^{\circ}0'$
 $E = 3.5'$ MEAN
 $CHORD = 196.08'$

SHI IN
 10\"/>

P.C.
 STA. 740+61.32
 F.D. SMALL R.R. SPK.
 @ SURFACE

SHI IN
 10\"/>

NEAR EDGE BOTTOM
 FLANGE OF FIRE HYD.