

# O.D.O.T. DISTRICT 2 SURVEY OFFICE (USE ONLY)

PERSONNEL

REFERENCE NO. 30

SHEET 1 OF 23

NOTES BARRIERE

DATE 7/1/24

ROUTE SR 65

H.C. MILLER

WEATHER SUNNY

COUNTY WOOD

R.C. BLUBAUGH

TEMP. 65°

TOWNSHIP PERRYSBURG

DWG BY BARRIERE

PID 101291

SECTION 68

T 4 N R 12 MI RESERVE

TYPE MONUMENT MONBOX W/ 1" IPIN

ON SURFACE - BELOW ON

OFFSET Q PAVEMENT 7.3' LT : RT

TO EDGE PAVEMENT

STATION: 1003+60

HORIZ.DATUM: NAD83 (2011)


GEOID: 18

GRID: NORTHING:


EASTING:

LDP: NORTHING: 515478.217

EASTING: 172704.287

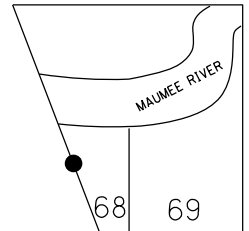

RECORD: P.I.  
STA. 0+00  
1937 PLANFD R.R.SPIKE  
FD P.K.NAIL  
5/22/72, BURNSIDE  
FD MONBOX  
W/1" IPIN  
6/4/85, CL  
9/13/05, DCH  
FD MONBOX W/  
1" IPIN  
7/1/24, JAM  
REF30

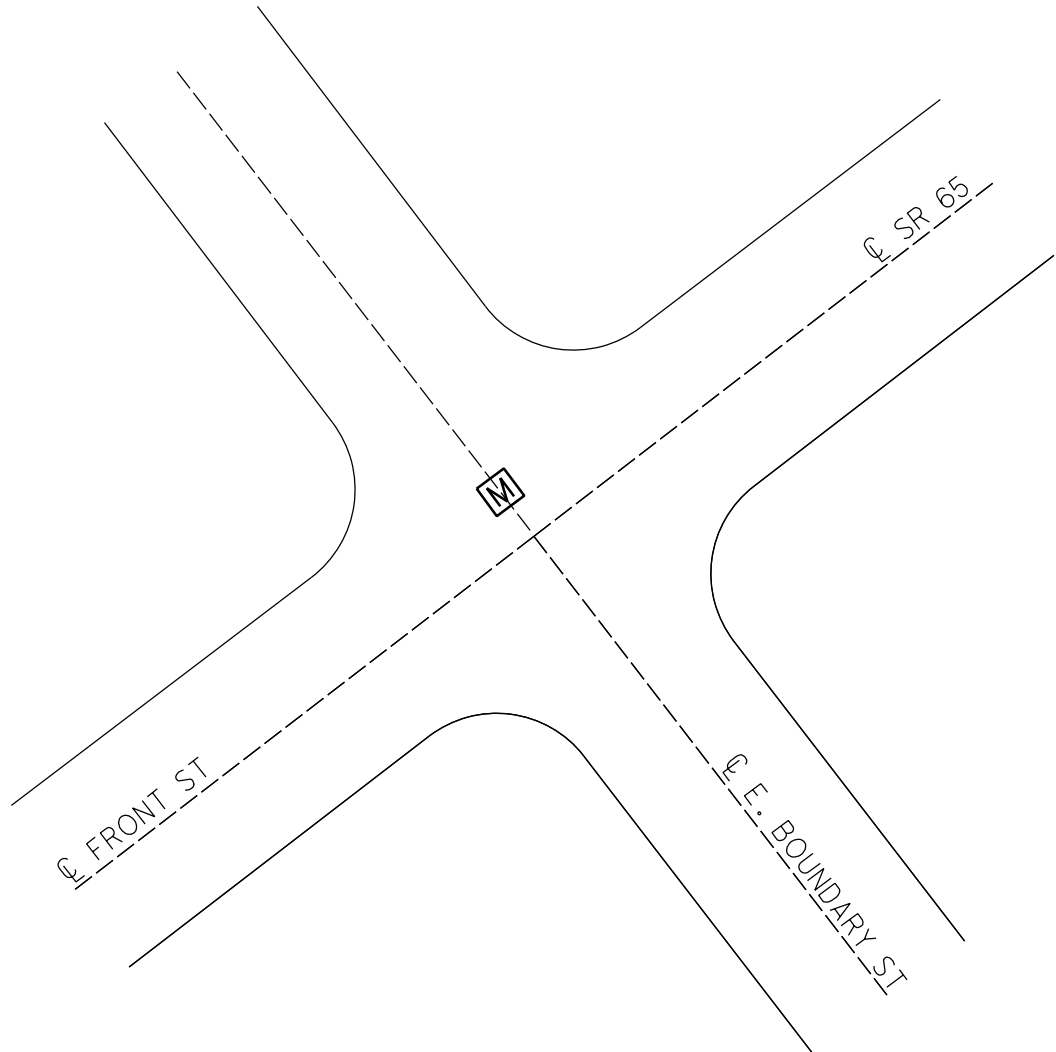

O.D.O.T. DISTRICT 2 SURVEY OFFICE (USE ONLY)

PERSONNEL

REFERENCE NO. 30

SHEET 1 OF 23

NOTES HUSS

DATE 9/13/05

ROUTE SR 65

H.C. HOMAN

WEATHER CLOUDY

COUNTY WOOD

R.C. MIKLOVIC

TEMP. 72°

TOWNSHIP PERRYSBURG

SECTION RT 68

DWG BY RHOADES PID                     

T 4 12 MILE RESERVE

TYPE MONUMENT MONBOX W/1" IPIN

ON SURFACE - ~~BELOW~~ ON

OFFSET Q PAVEMENT 7.3' LT : ~~RT~~

           TO            EDGE PAVEMENT


STATION: 1003+60

HORZ.DATUM:                     


GEOID:                     

GRID: NORTHING:                     

EASTING:                     

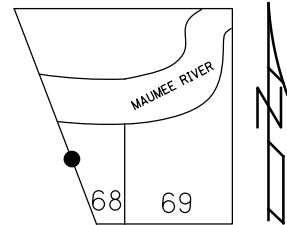

RECORD: P.I.  
STA. 0+00  
1937 PLANFD R.R.SPIKE  
FD P.K.NAIL  
5/22/72, BURNSIDE  
FD MONBOX  
W/1" IPIN  
6/4/85, CL  
9/13/05, DCH

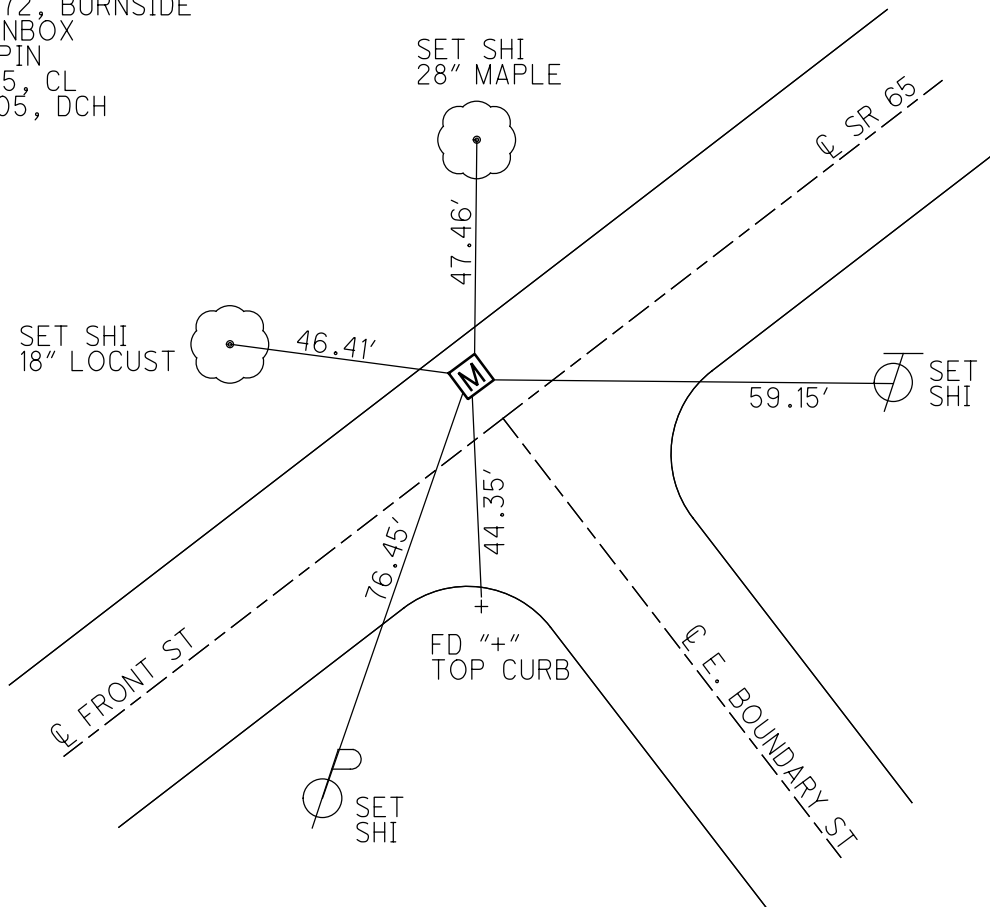

O.D.O.T. DISTRICT 2 SURVEY OFFICE

*PERSONNEL*

REFERENCE NO. 30

SHEET 1 OF 14

NOTES \_\_\_\_\_ HUSS

DATE 9-13-05

ROUTE S.R. 65

H.C. HOMAN

WEATHER           CLOUDY          

COUNTY WOOD

R.C. MIKLOVIC

TEMP. 72°

TOWNSHIP Perryburg

SECTION \_\_\_\_\_

T        N        R        E        *of*

Town 4, 12 miles E of


TYPE MONUMENT MON BOX

ON SURFACE - ~~BELOW~~ ON

~~LEFT - C PAV'T - RIGHT~~ 7.3' LT.


\_\_\_\_\_ TO \_\_\_\_\_ EDGE PAVEMENT

S.L.M. 1003 + 60

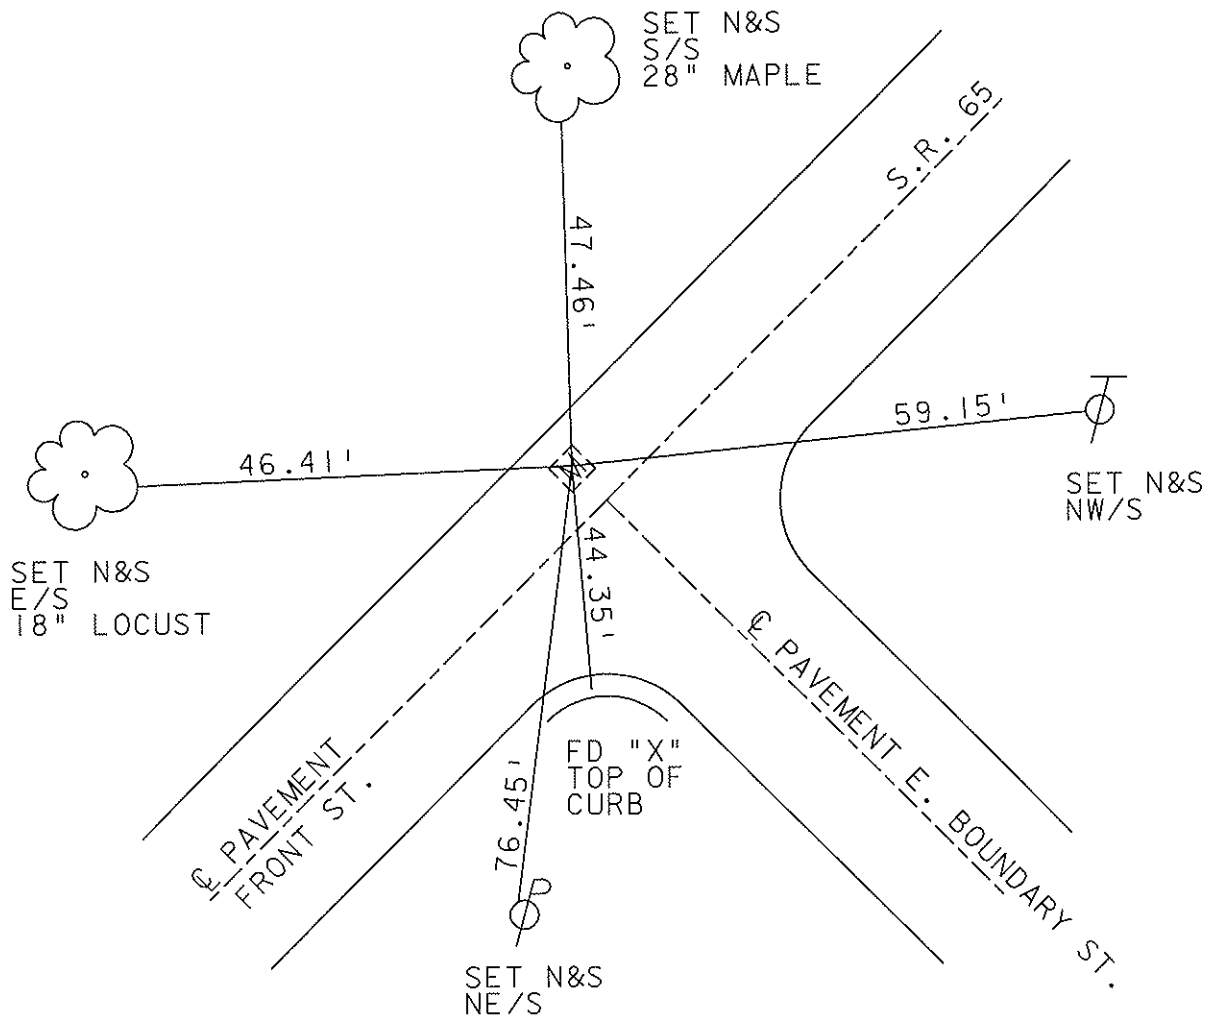

County WOOD S.R. 65Township PERRYSBURG, CITY

Section \_\_\_\_\_

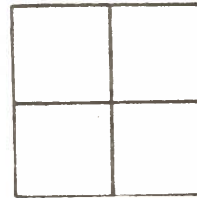T N, R EPersonnel LOEHRKE ☐Hoffman RCBARNHISEL HCDate 6-4-85Weather CLOUDYTemp. +65

(30)


MON. BOX @ SURFACE "+" Top

7.3 Lf of &amp; PAUT SR65

ON &amp; PAUT E. BOUNDARY ST.

SLM 1003+60

Box RAISED To SURFACE  
As of 7-1-85  
C.L.

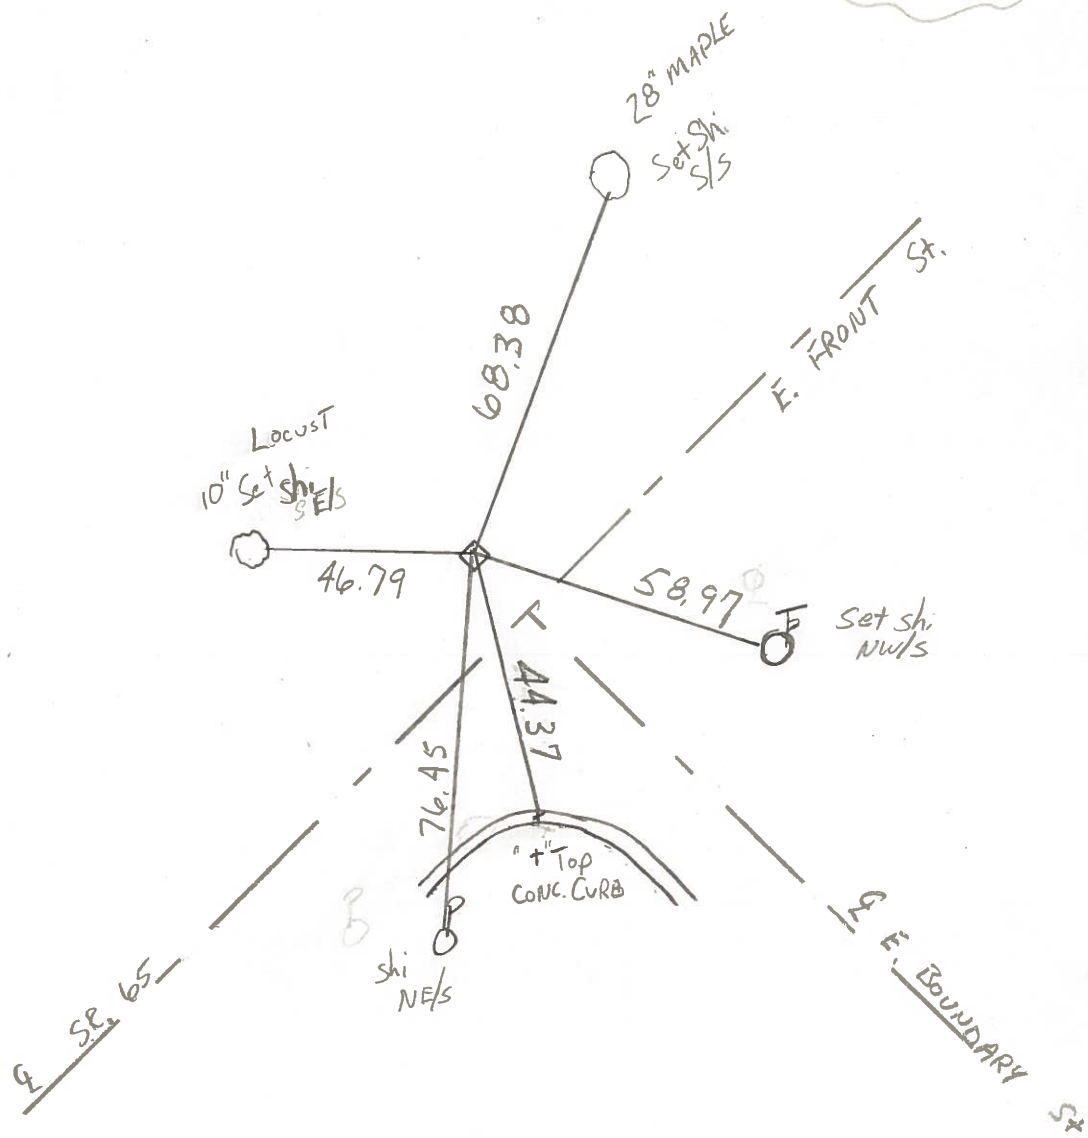

# O.D.O.T. DISTRICT 2 SURVEY OFFICE

SHEET

OF

County Wood S.R. 65

Township \_\_\_\_\_

Section Perrysburg

T N, R E

Personnel I. Stone

P. Neuser

R. Michalak


D. Curtis

H. Mead


Date 13 Nov. 80

Weather Cloudy

Temp. 40°

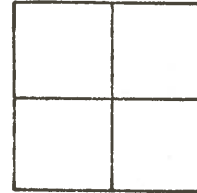

REF. NO. 30

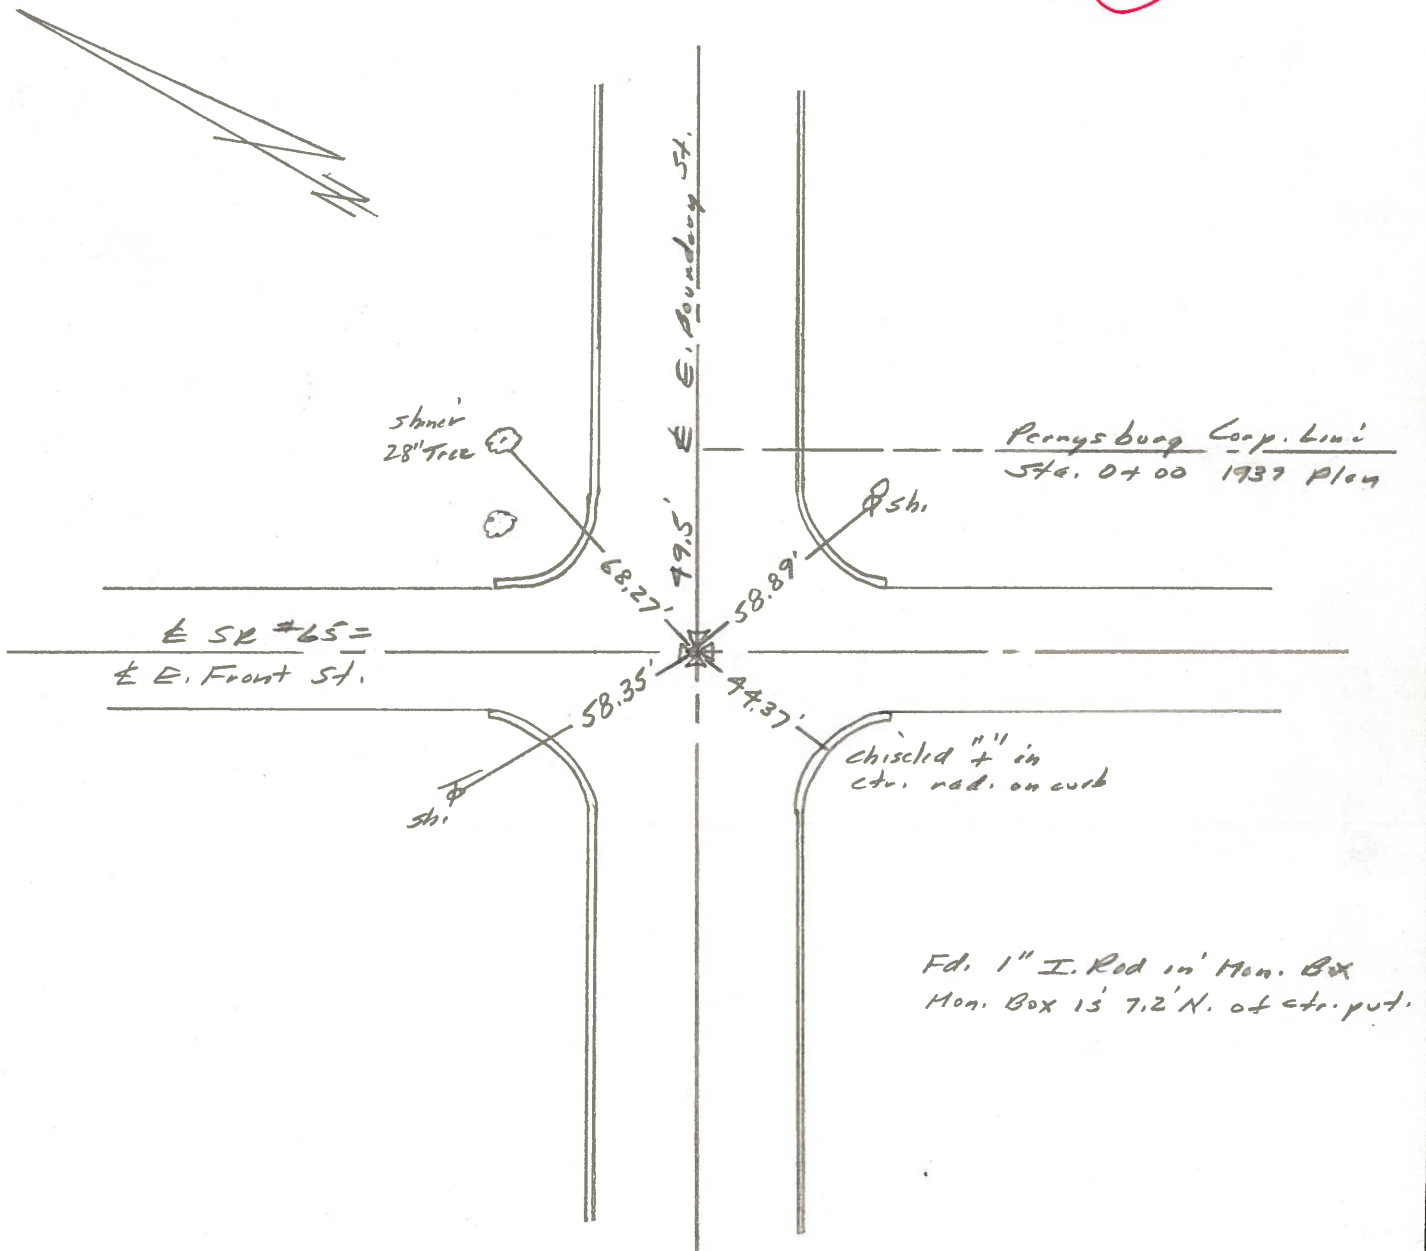

| PERSONNEL | TITLE | PERSONNEL | TITLE |
|-----------|-------|-----------|-------|
| BURNSIDE  |       |           |       |
| SMITH     |       |           |       |
| BOWERS    |       |           |       |

COUNTY Wood DATE 5-22-72S. R. 65 WEATHER CLEARSEC. PERRYSBURG - EAST TEMP. +70°PERRYSBURG TWP.


JOB NO. \_\_\_\_\_

DESCRIPTION

LEFT

CENTER LINE

RIGHT

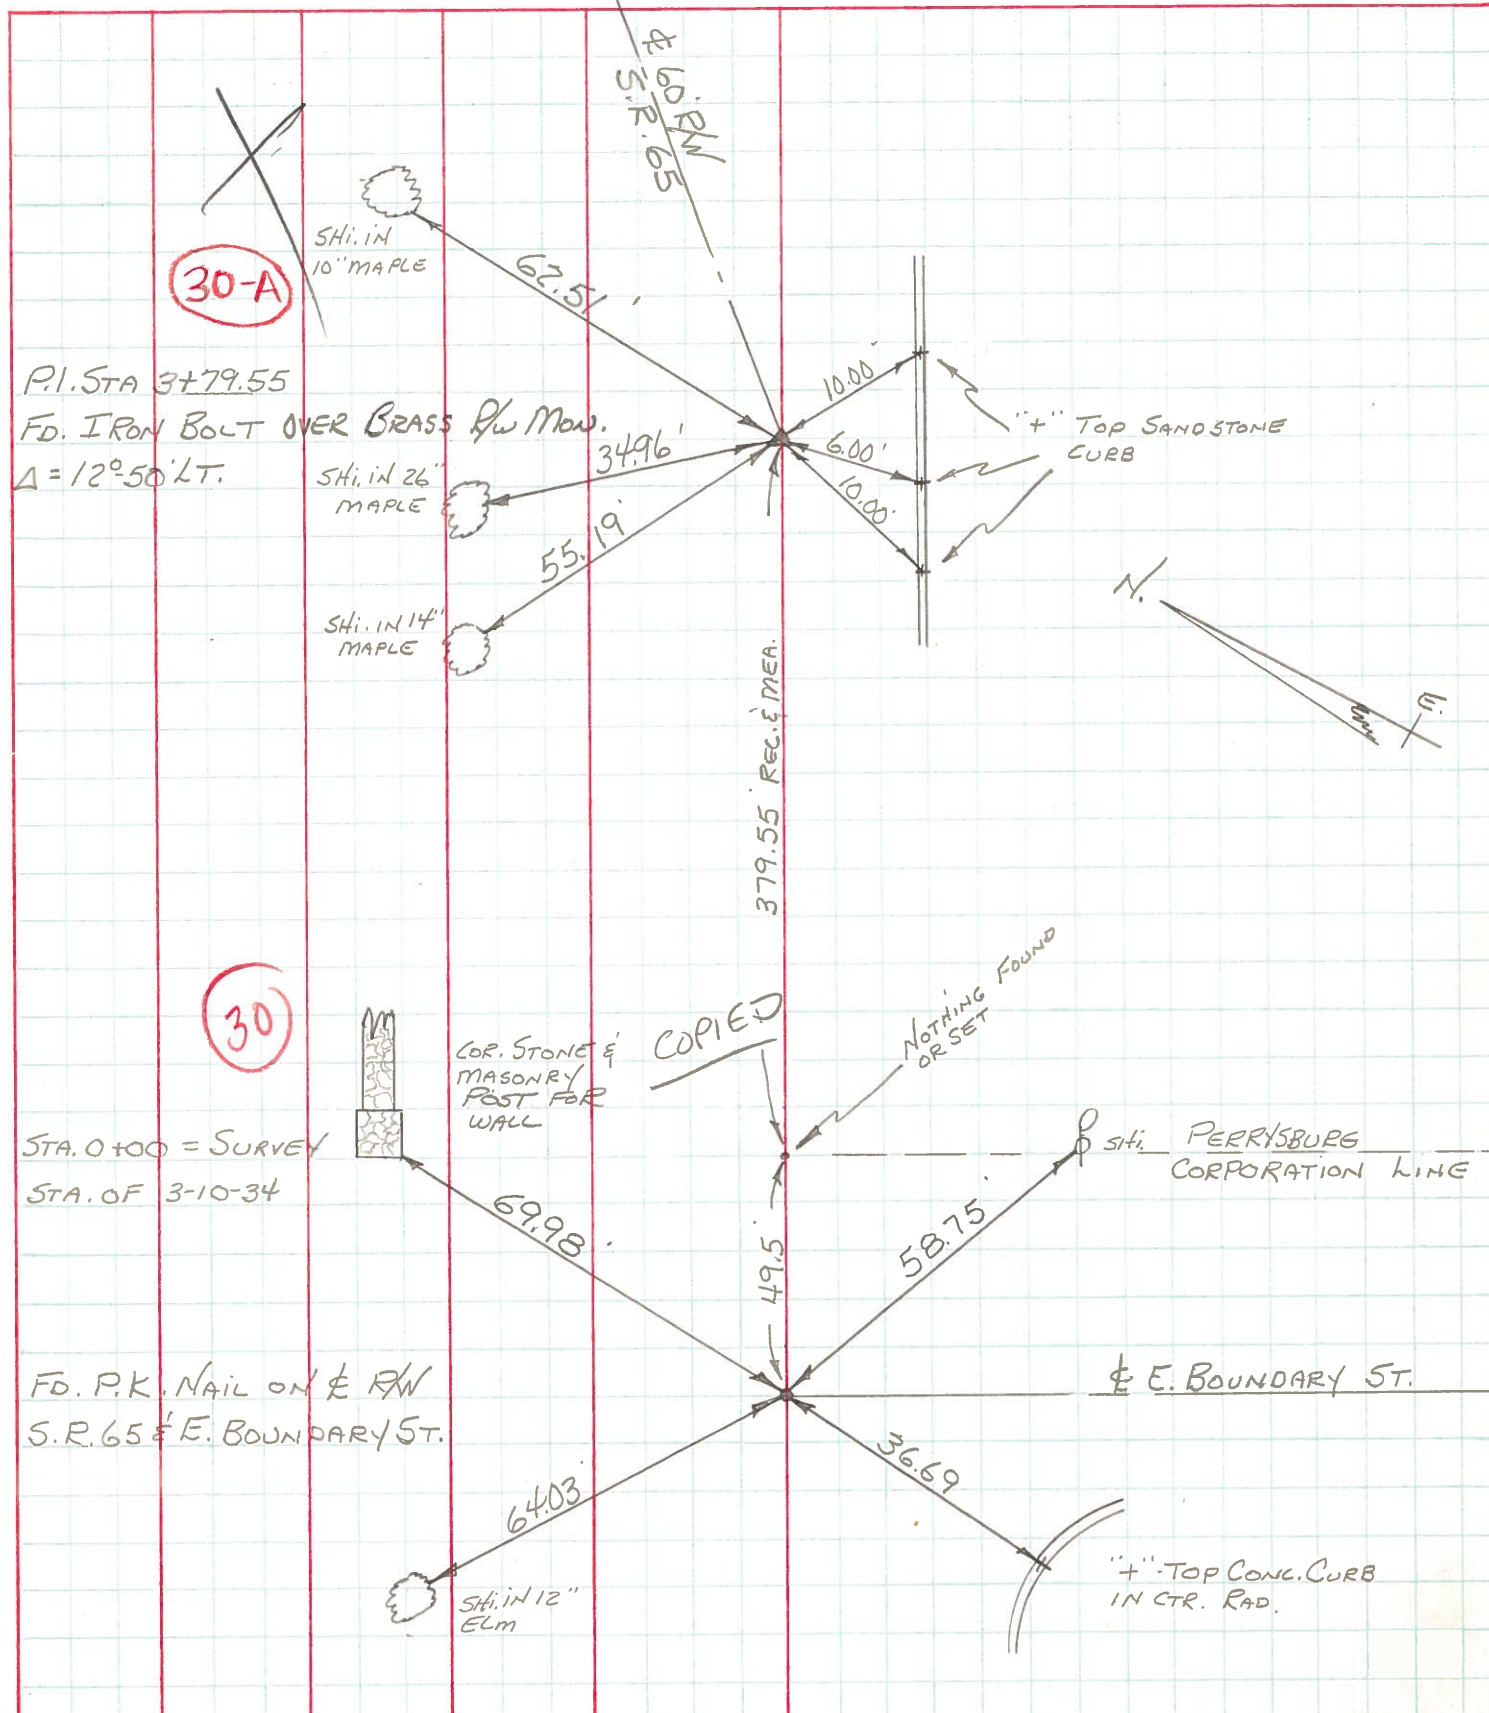

[illegible]