

O.D.O.T. DISTRICT 2 SURVEY OFFICE (USE ONLY)

PERSONNEL

REFERENCE NO. 30 A

SHEET 2 OF 23

NOTES BARRIERE
H.C. MILLER
R.C. BLUBAUGH

DATE 7/1/24
WEATHER SUNNY
TEMP. 65°

ROUTE SR 65
COUNTY WOOD
TOWNSHIP PERRYSBURG
SECTION 68

DWG BY BARRIERE PID 101291

T 4 N R 12 MI RESERVE

TYPE MONUMENT MAG/WASHER

ON SURFACE - BELOW ON

OFFSET $\angle$ PAVEMENT 9.5' RT LT : RT

TO EDGE PAVEMENT

STATION: 1007+89

HORZ.DATUM: NAD83 (2011)


GEOID: 18

GRID: NORTHING:


EASTING:

LDP: NORTHING: 515669.347

EASTING: 173088.405

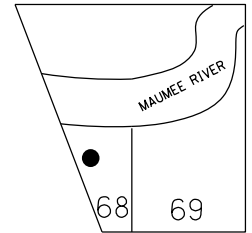

RECORD: P.I.
STA. 3+79.55
1937 PLANS
 $\Delta = 12^\circ 50' \text{ LT}$
FD R.R.SPIKE
FD IRON BLOT
ATOP BRASS R/W MON.
5/22/72, BURNSIDE
SET P.K.NAIL
11/13/80, IRS
FD P.K.NAIL
5/2/88, CL
SET P.K./WASHER
8/26/88, MB
FD P.K.NAIL
9/13/05, DCH
SET MAG/WASHER
10/27/05, SAH
FD MAG/WASH
REF30A
7/11/24, JAM

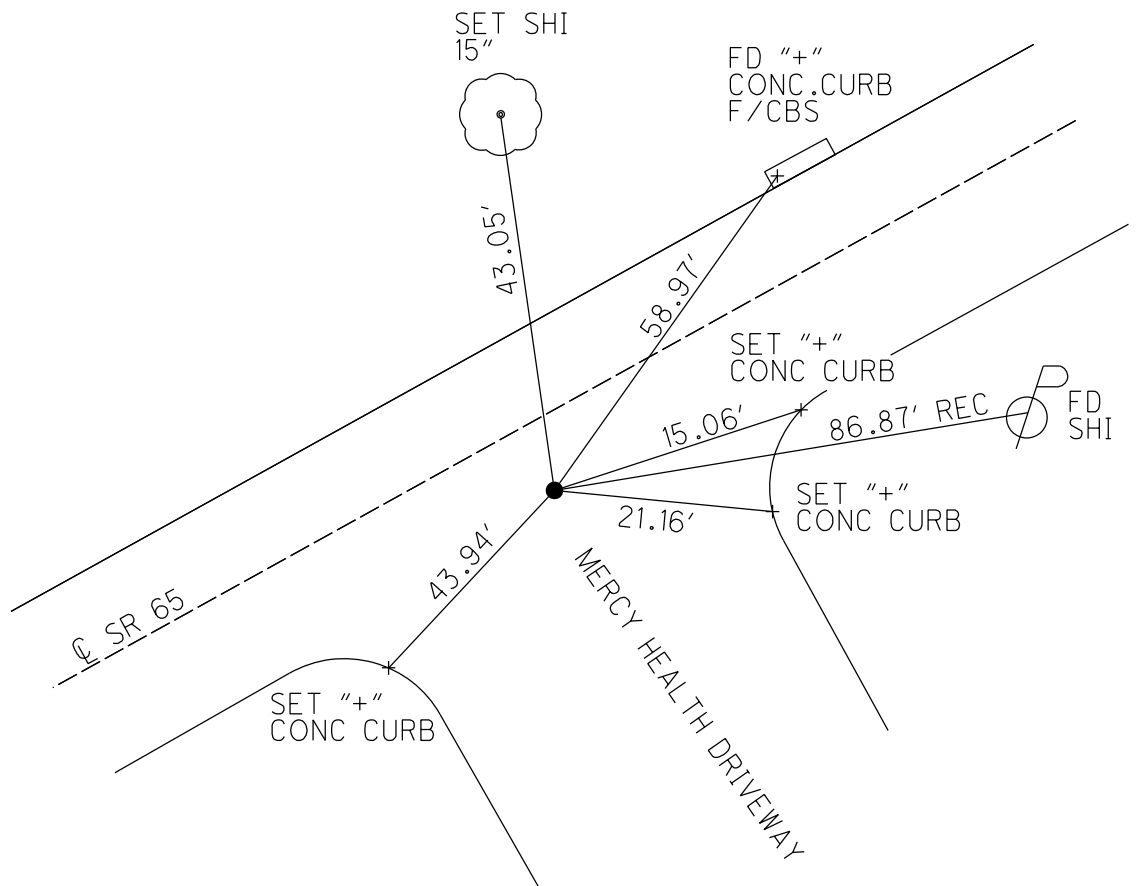

O.D.O.T. DISTRICT 2 SURVEY OFFICE (USE ONLY)

PERSONNEL

REFERENCE NO. 30 A

SHEET 2 OF 23

NOTES HUSS

DATE 9/13/05

ROUTE SR 65

H.C. HOMAN

WEATHER SUNNY

COUNTY WOOD

R.C. MIKLOVIC

TEMP. 78°

TOWNSHIP PERRYSBURG

SECTION RT 68

DWG BY RHOADES PID

T 3 12 MILE RESERVE

TYPE MONUMENT MAG/WASHER

ON SURFACE - ~~BELOW~~ ON


OFFSET CL PAVEMENT 9.5' ~~LT~~ : RT

1.6' TO RT EDGE PAVEMENT


STATION: 1007+89

HORZ.DATUM: GEOID:

GRID: NORTHING: EASTING:

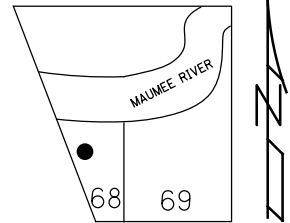

RECORD: P.I.
STA. 3+79.55
1937 PLANS
 $\Delta = 12^\circ 50' \text{ LT}$
FD R.R. SPIKE
FD IRON BLOT
ATOP BRASS R/W MON.
5/22/72, BURNSIDE
SET P.K. NAIL
11/13/80, IRS
FD P.K. NAIL
5/2/88, CL
SET P.K./WASHER
8/26/88, MB
FD P.K. NAIL
9/13/05, DCH
SET MAG/WASHER
10/27/05, SAH

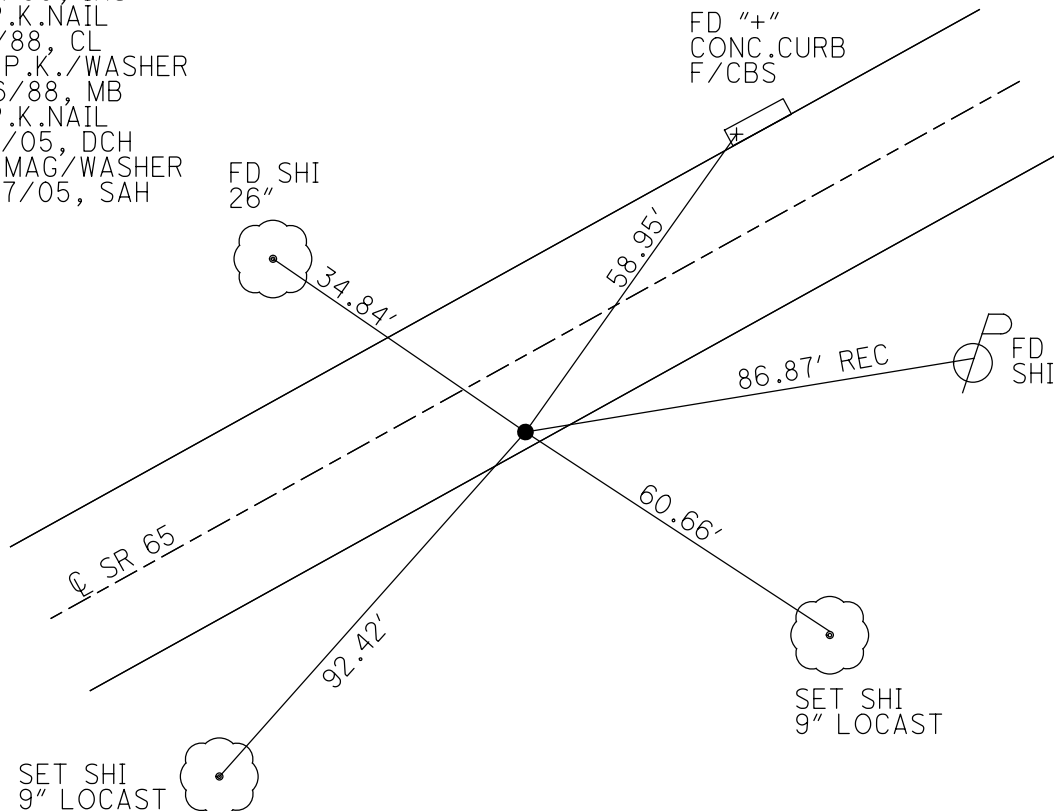

O.D.O.T. DISTRICT 2 SURVEY OFFICE

PERSONNEL

REFERENCE NO. 30-A

SHEET 2 OF 14

NOTES

HUSS

DATE 9-13-05

ROUTE SR 65

H.C.

HOMAN

WEATHER SUNNY

COUNTY WOOD

R.C.

MIKLOVIC

TEMP. 78°

TOWNSHIP PERRYSBURG

SECTION RIVER TRACT

T-7-N R-11-E

Town 3, 12 mile Res.

TYPE MONUMENT

PK NAIL

ON SURFACE - ~~BELOW~~

ON


~~LEFT & PAVE~~ - RIGHT

9.5' RT.

1.6' TO RT EDGE PAVEMENT

S.L.M.


1007+89

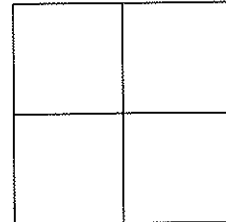

RECORD

STA 3+79.55 (1937 PLANS)
DELTA=12°50' LT.

SET MAG NAIL
& WASHER
10-27-05
SAH

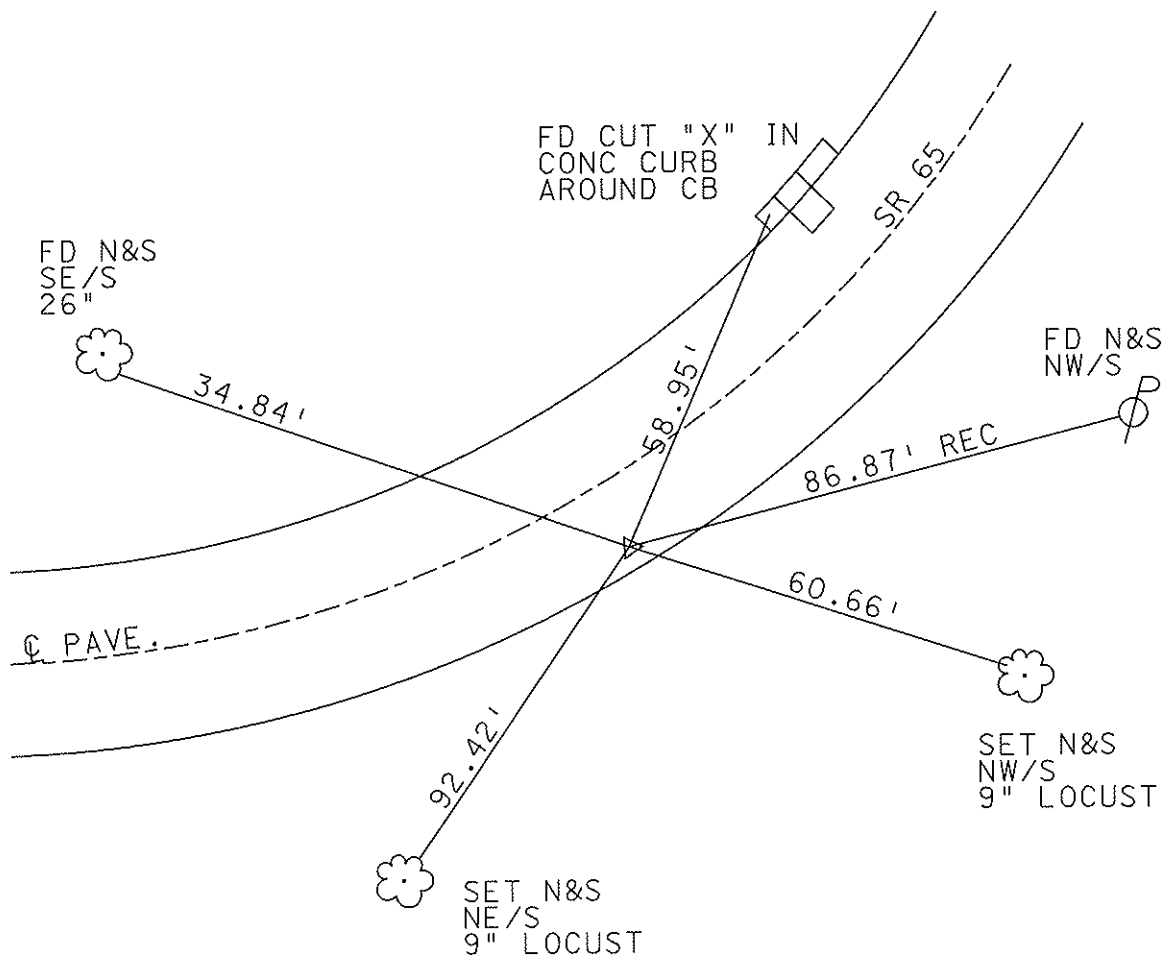

O.D.O.T. DISTRICT 2 SURVEY OFFICE

PERSONNEL

REFERENCE NO. 30-A

SHEET OF

NOTES BARNHISEL

H.C. Reed

R.C. Loehrke

HOFFMAN

DATE 5-2-88

WEATHER Sunny

TEMP. +70°

ROUTE 65

COUNTY WOOD

TOWNSHIP Perrysburg

SECTION LINE TRACT

T. 7 N. R. 11 E.

TYPE MONUMENT P.K. NAIL


ON SURFACE - ~~BELOW~~ yes

LEFT - ~~Q~~ PAV'T. - RIGHT 9.7

5.8 TO Lt EDGE ~~PAVEMENT~~ CURB

S.L.M. 1007+89

30-A

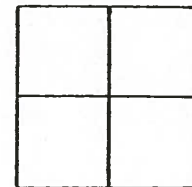

RECORD


STA: 3+79.55 (1937 PLANS)

$\Delta = 120^\circ 50'$ Lt

Set P.K. & Klasher

8-26-88

YMB

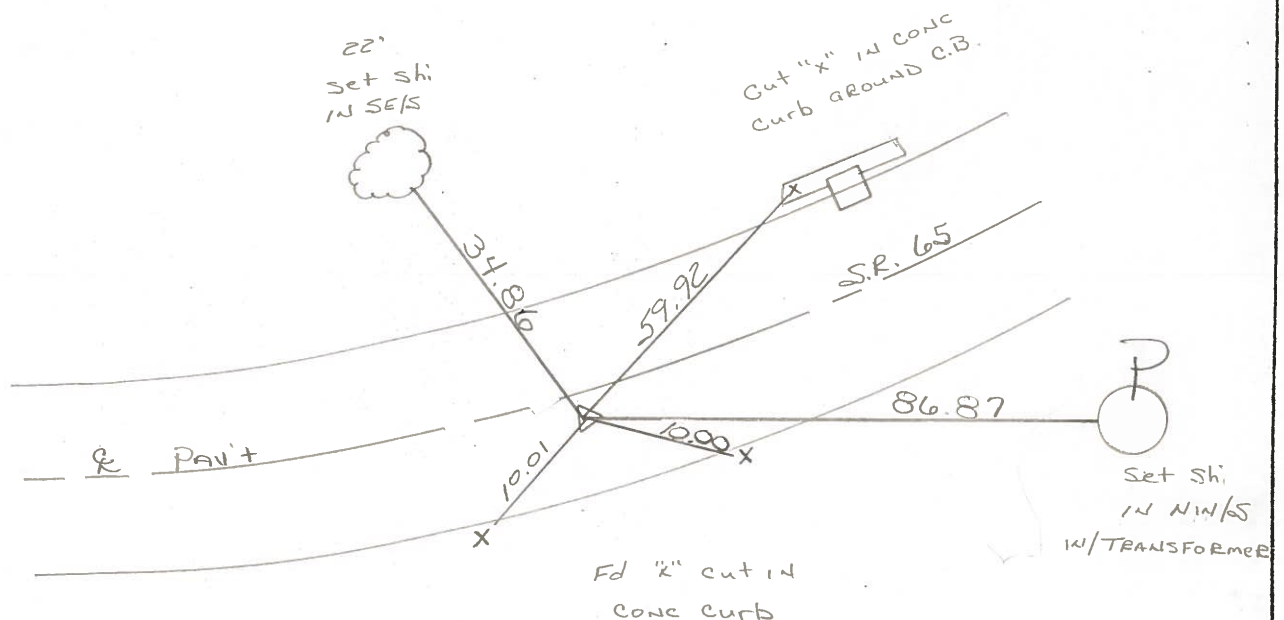

ODOT. DISTRICT 2 SURVEY OFFICE

SHEET

OF

County Wood S.R. 65

Date 13 Nov. 80

Township _____


Weather Cloudy

Section _____

Temp. 40°

T N, R E

Personnel L. Stone

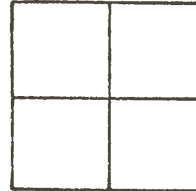


R. Michalek

P. Neuser

D. Curtis

H. Mead

REF. No. 30-A

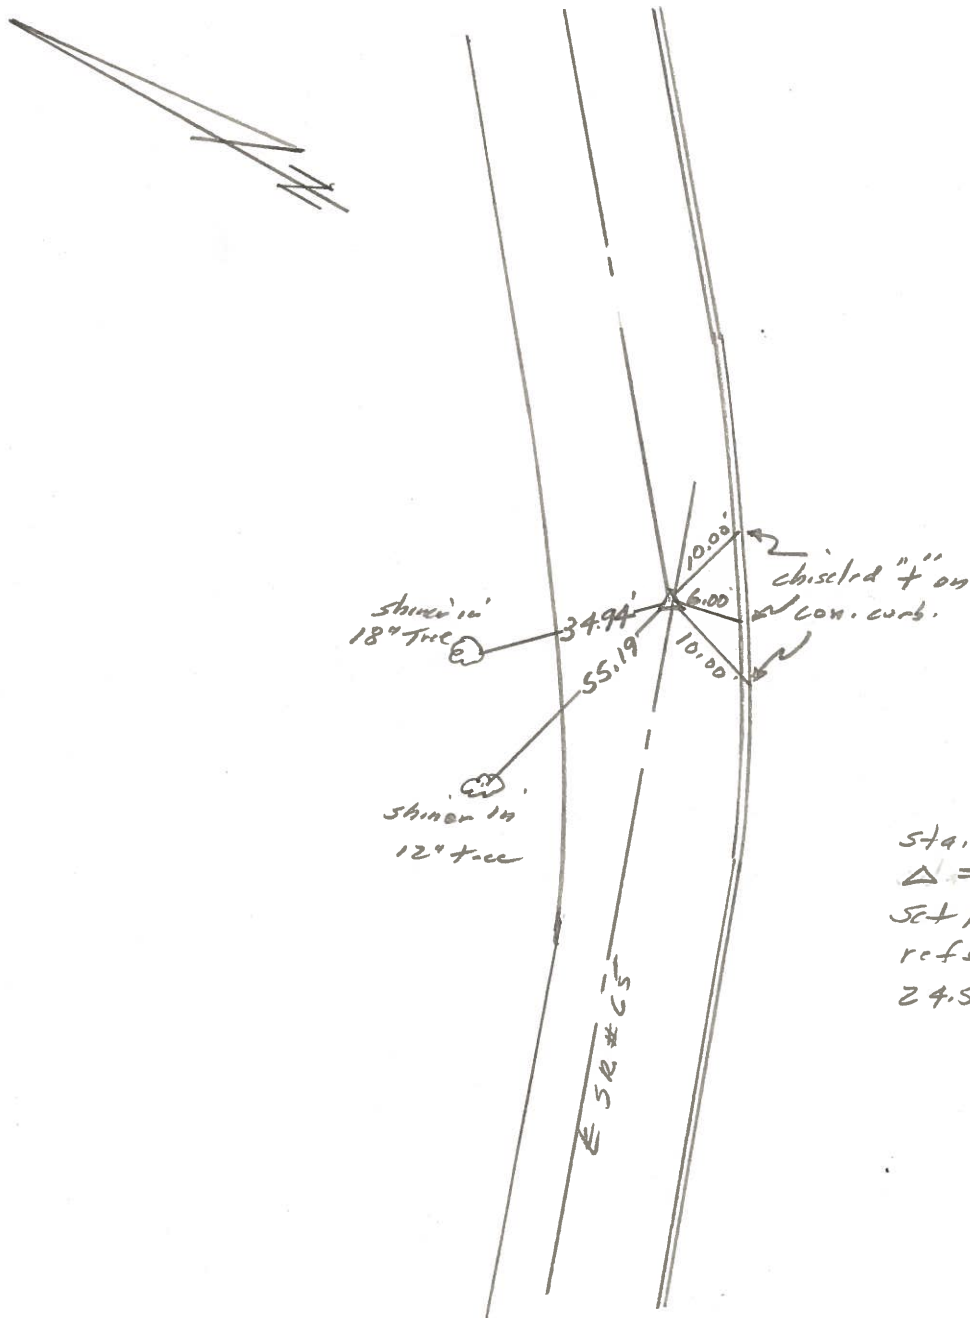

Sta. 3+79.55 (1937 plans)
 $\Delta = 120^{\circ} 50'$ Lt.
 Set PK Nail as per 1972
 refs. 5.7' to S. edge put,
 24.5' to N. edge put.

PERSONNEL	TITLE	PERSONNEL	TITLE
BURNSIDE			
SMITH			
BOWERS			

COUNTY Wood DATE 5-22-72

S. R. 65 WEATHER CLEAR

Sec. C (PT)

SEC. PERRYSBURG - EAST TEMP. +70°

PERRYSBURG TWP.

JOB NO

DESCRIPTION

LEFT

CENTER LINE

RIGHT

