

O.D.O.T. DISTRICT 2 SURVEY OFFICE (USE ONLY)

PERSONNEL

REFERENCE NO. 30 B

SHEET 3 OF 23

NOTES BARRIERE

DATE 7/1/24

ROUTE SR 65

H.C. MILLER

WEATHER SUNNY

COUNTY WOOD

R.C. BLUBAUGH

TEMP. 73°

TOWNSHIP PERRYSBURG

DWG BY BARRIERE

PID 101291

SECTION 69

T 3 N R 12 MI RESERVE

TYPE MONUMENT MAG/WASHER

ON SURFACE - BELOW ON

OFFSET Q PAVEMENT 5.3' RT LT : RT

TO EDGE PAVEMENT

STATION: 1035+75

HORIZ.DATUM: NAD83 (2011)


GEOID: 18

GRID: NORTHING: 695424.330

EASTING: 1665032.098


LDP: NORTHING: 517430.997

EASTING: 175246.441

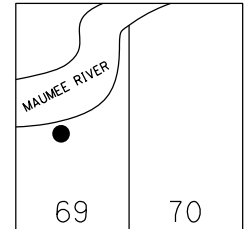

RECORD: P.I.
1937 Q SURVEY
Q RW
STA. 31+66.4
 $\Delta = 9^\circ 50'$ LT
SET MAG/WASHER
10/28/05, SAH
FD MAG/WASHER
REFB30
12/16/19, JFO
FD MAG/WASHER
REF30B
7/1/24, JAM

** DIST. 30B-30BC = 64.73'

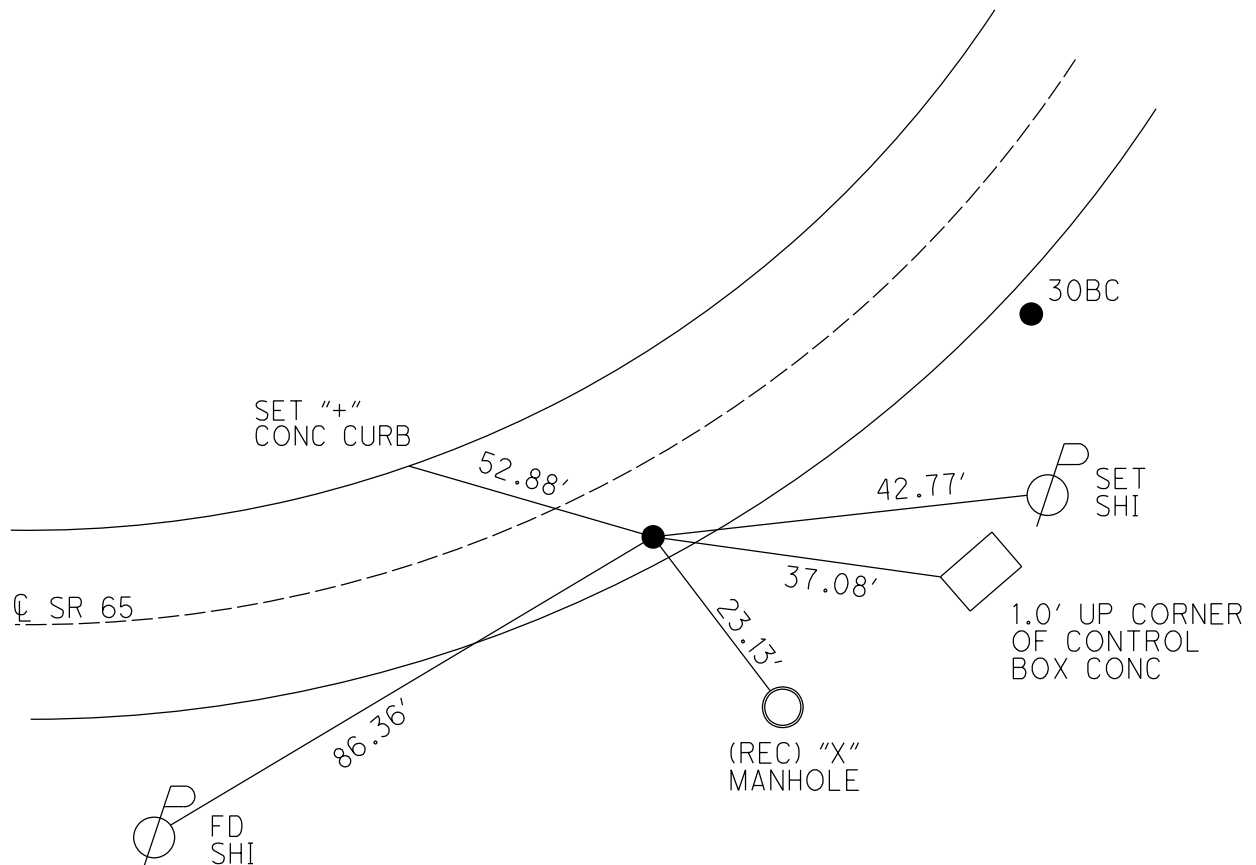

O.D.O.T. DISTRICT 2 SURVEY OFFICE (USE ONLY)

PERSONNEL

REFERENCE NO. 30 B

SHEET 1 OF 8

NOTES HUSS DATE 9/13/05
H.C. HOMAN WEATHER SUNNY
R.C. MIKLOVIC TEMP. 78°

ROUTE SR 65
COUNTY WOOD
TOWNSHIP PERRYSBURG
SECTION RT 69
T 3 12 MILE RESERVE

DWG BY NIESE PID -

TYPE MONUMENT SM.R.R.SPIKE


ON SURFACE - ~~BELOW~~ ON

OFFSET CL PAVEMENT 5.3' ± : RT
6.5' TO RT EDGE PAVEMENT

STATION: 1035+75


HORIZ.DATUM: NAD83(2011) GEOID: 2012A

GRID: NORTHING: 695424.330 EASTING: 1665032.098

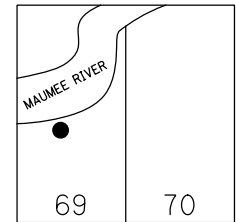

RECORD: P.I.
1937 CL SURVEY
CL RW
STA. 31+66.4
 $\Delta = 9^\circ 50'$ LT
SET MAG/WASHER
10/28/05, SAH
FD MAG/WASHER
REFB30
12/16/19, JFO

DIST. 30B-30BC= 64.73'

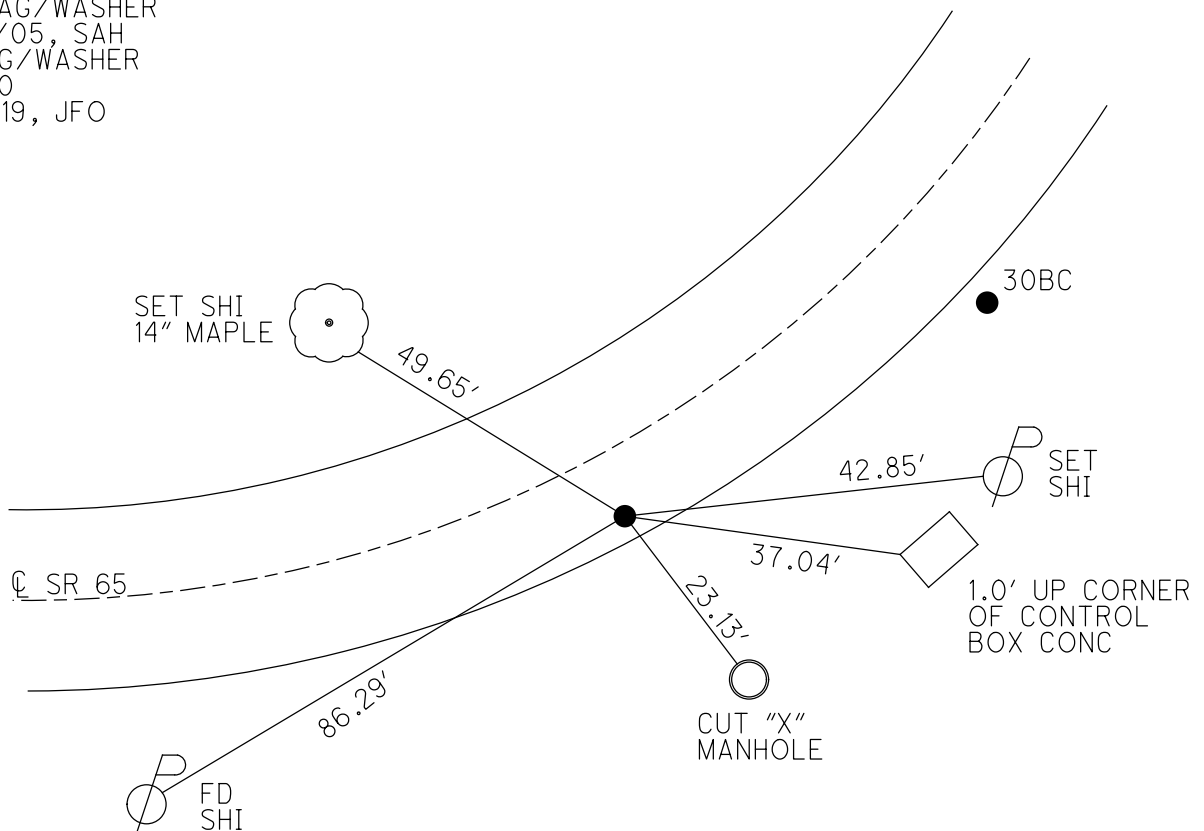

O.D.O.T. DISTRICT 2 SURVEY OFFICE

PERSONNEL

REFERENCE NO. 30-B

SHEET 3 OF 14

NOTES

HUSS

DATE

9-13-05

ROUTE

SR 65

H.C.

HOMAN

WEATHER

SUNNY

COUNTY

WOOD

R.C.

MIKLOVIC

TEMP.

78°

TOWNSHIP PERRYSBURG

SECTION RIVER TRACT

~~T 7 N R 11 E~~

78 and 3, 12 mile Res.

TYPE MONUMENT

SM RR SPIKE

ON SURFACE - ~~BELOW~~

ON


~~LEFT - Q PAVE~~ - RIGHT

5.3' RT

6.5' TO RT EDGE PAVEMENT

S.L.M.

1035+75

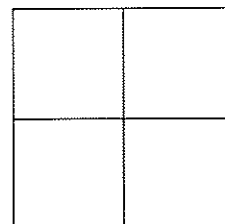

1937 Q SURVEY & Q RW STATION=

P.I. 31+66.4


DELTA=9°50' LT.

SET MAG NAIL

& WASHER

10-28-05

SAH

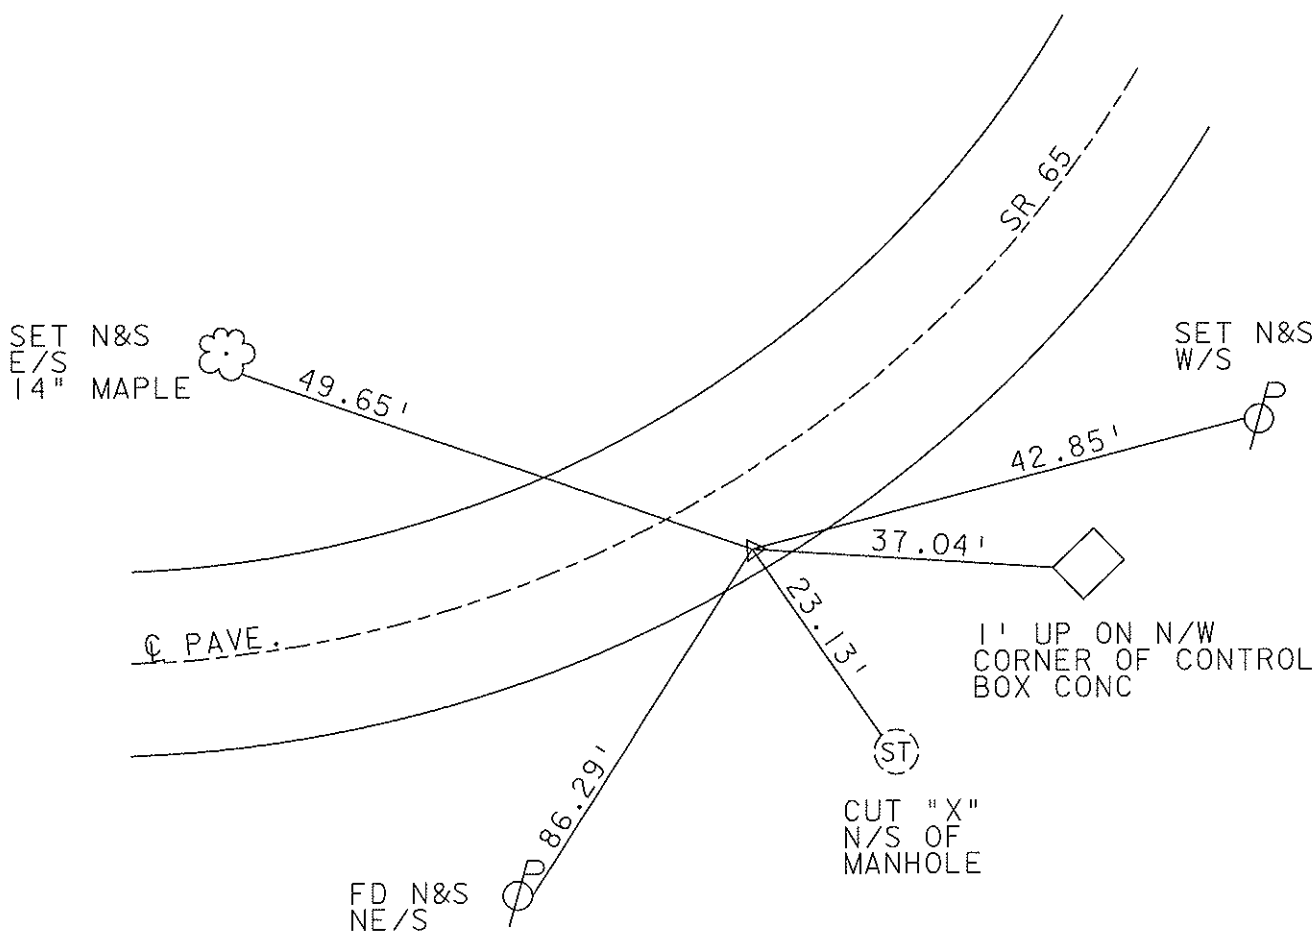

O.D.O.T. DISTRICT 2 SURVEY OFFICE

PERSONNEL

REFERENCE NO. 30-B

SHEET OF

NOTES BARNHISEL

H.C. REED

DATE 5-2-88

ROUTE 65

R.C. Loehrke

WEATHER SUNNY

COUNTY WOOD

HOFFMAN

TEMP. +70°

TOWNSHIP Perryburg

SECTION RIVER TRACT 49

T 7 N R 11 E


TYPE MONUMENT Pt. A 1/4 SPK Pt. B P.K. NAIL

ON SURFACE - BELOW 2" SURFACE

LEFT - 0 PAV'T. - RIGHT 14.2

TO EDGE PAVEMENT curbing

S.L.M. Pt. "A" 1035+75

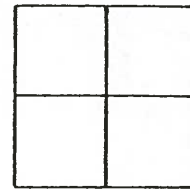


RECORD Pt. "A"

STA: 31+66.4 & Survey
Δ = 9° 50' Lt

RECORD Pt. "B"

STA: 32+31.06 & Const.
Δ = 9° 50' Lt

Pt. "A" Set 2m RE SPK
Pt. "B" Set P.K. & washer
8-26-88
m.B.

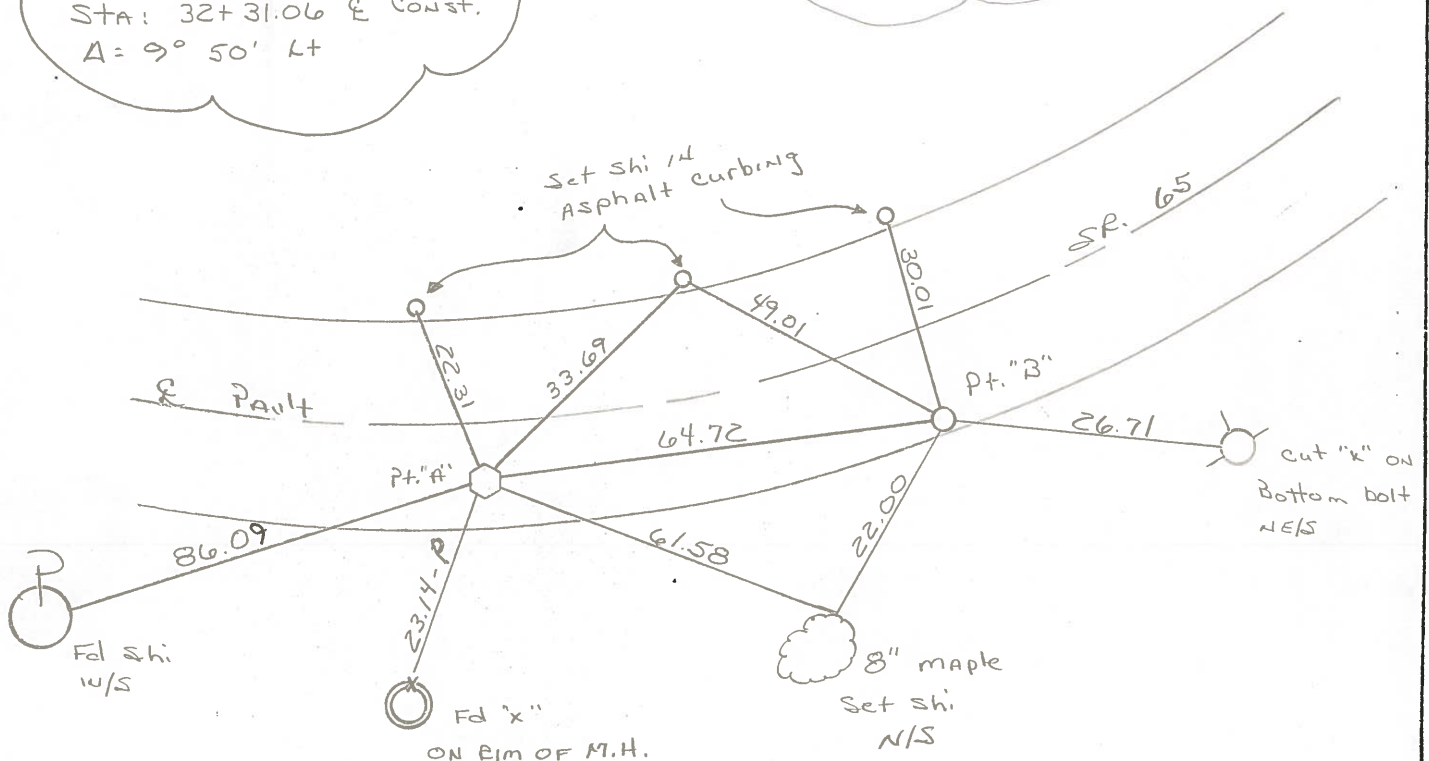

O.D.O.T. DISTRICT 2 SURVEY OFFICE

PERSONNEL

REFERENCE NO. 30-B

SHEET ____ OF ____

NOTES Hoffman

H.C. Barnhisel

R.C. Loehrk

DATE 4-4-85

WEATHER P. Clear

TEMP. 50°

ROUTE SR 65

COUNTY Wood

TOWNSHIP Perryburg

SECTION RIVER TRACT 69

T ____ R ____


TYPE MONUMENT Small RR Spike

ON SURFACE - BELOW 2"

LEFT- & PAW'T. - RIGHT 6.0'

8.8' TO RT EDGE PAVEMENT


S.L.M. _____

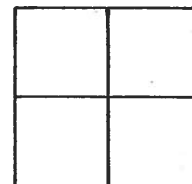

1937 E Survey & R/W station =

P.I. 31+66.4

$\Delta = 90^\circ - 50' \text{ LT.}$

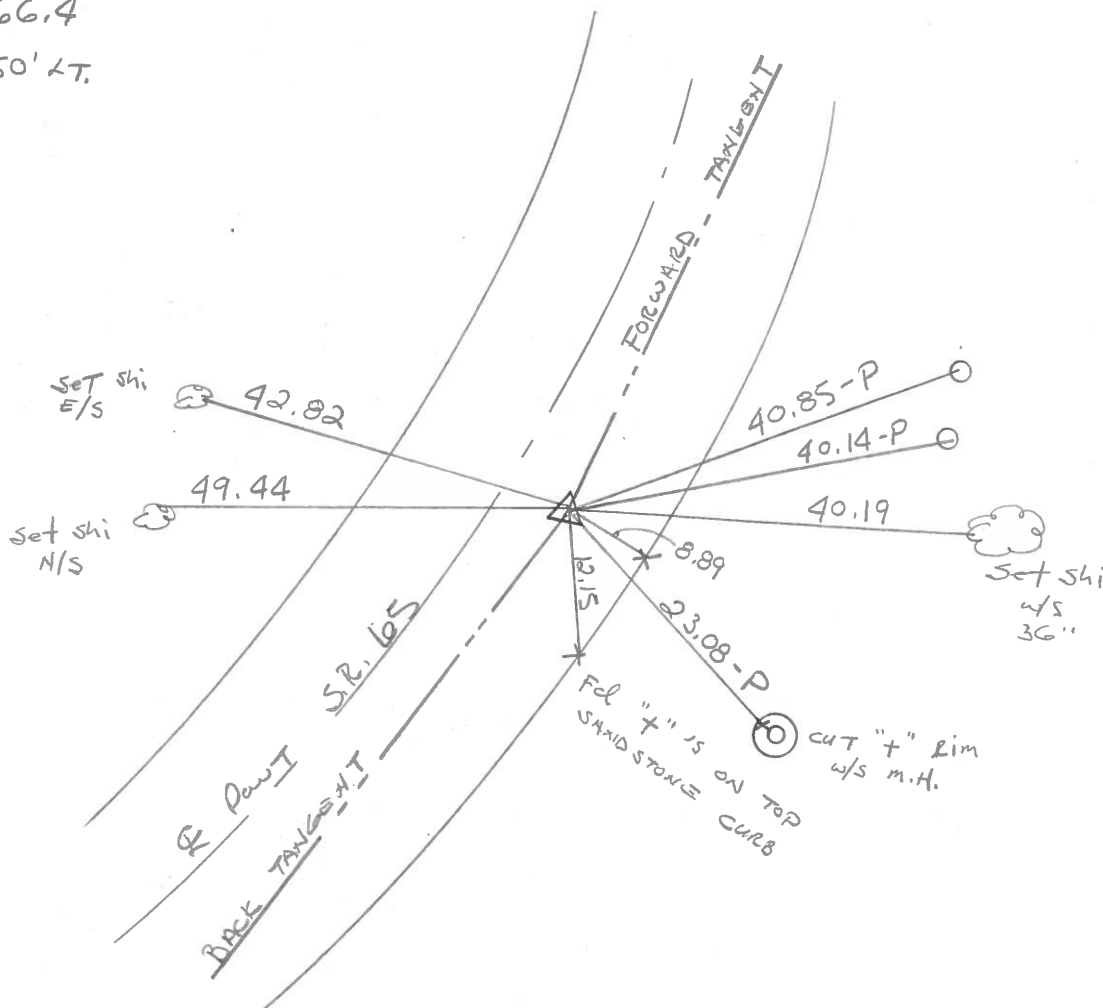


County Wood S.R. 65Date 13 Nov. 80

Township _____

Weather cloudy

Section _____

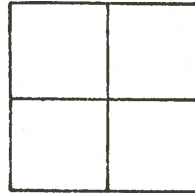
Temp. 40°T N, R EPersonnel L. StoneR. MichalakP. NeuseD. CurtisH. Mead

REF. NO. 30-B

Ⓐ = Fd. Spk. 2" deep
Sta. 31+66.4 E. Surv.
 $\Delta = 9^{\circ}50'$ Lt.

22.0' to N. edge put,
8.7' to S. edge put

Ⓑ = Set PK Nail as per
1972 refs,
Sta. 32+31.06 E. Const.
 $\Delta = 9^{\circ}50'$ Lt.
29.8' to N. edge put,
0.7' to S. edge put.

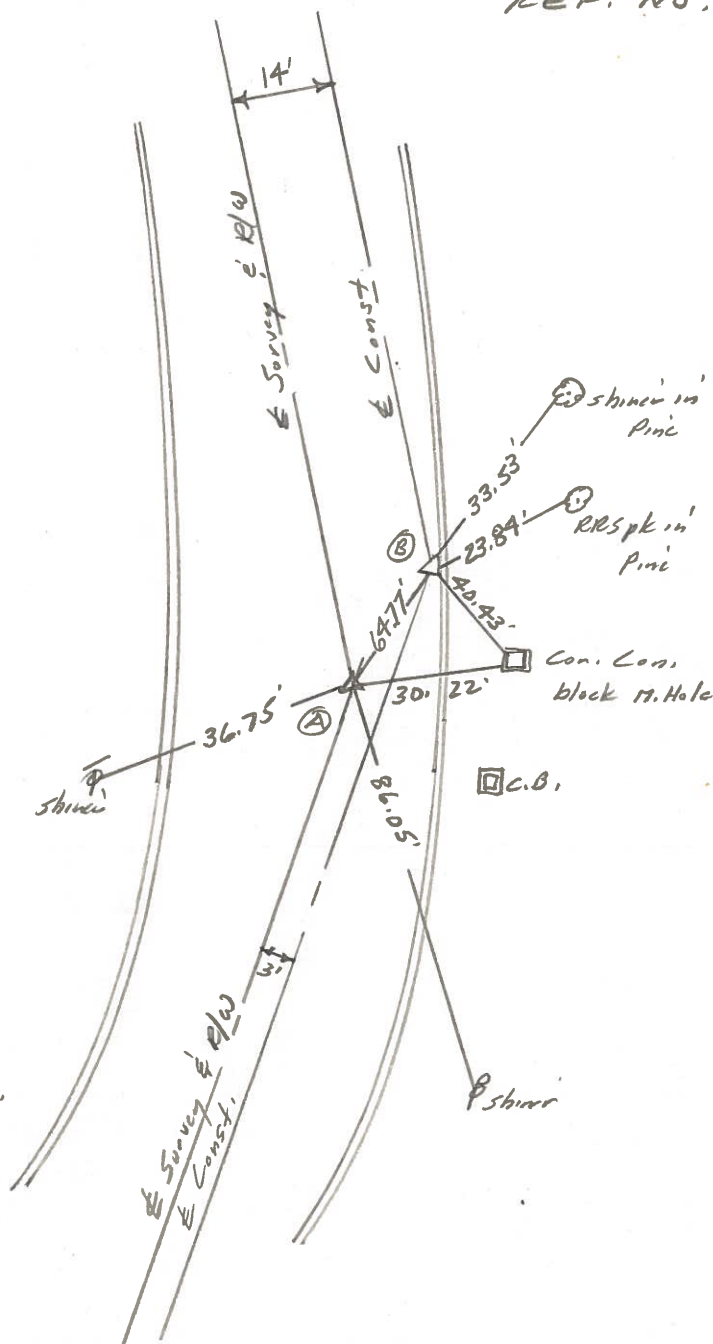

PERSONNEL TITLE PERSONNEL TITLE

BURNSIDE

SMITH

BOWERS

COUNTY Wood

DATE 5-22-72

S. R. 65

WEATHER CLEAR

SEC. C (PT)

TEMP. +80°

DESCRIPTION

PERAYS BURG TWP

JOB NO.

LEFT

CENTER LINE

RIGHT

30-B

B


SET SMALL R.R. Spk.
CONSTRUCTION P.I.

STA. 32+31.06

 $\Delta = 9^\circ 50'$ $D = 1^\circ 30'$ $T = 328.58$ $L = 655.55$ $E = 14.11$ $R = 3819.72$

SET SMALL R.R. Spk.
SURVEY P.I.

STA. 31+66.4

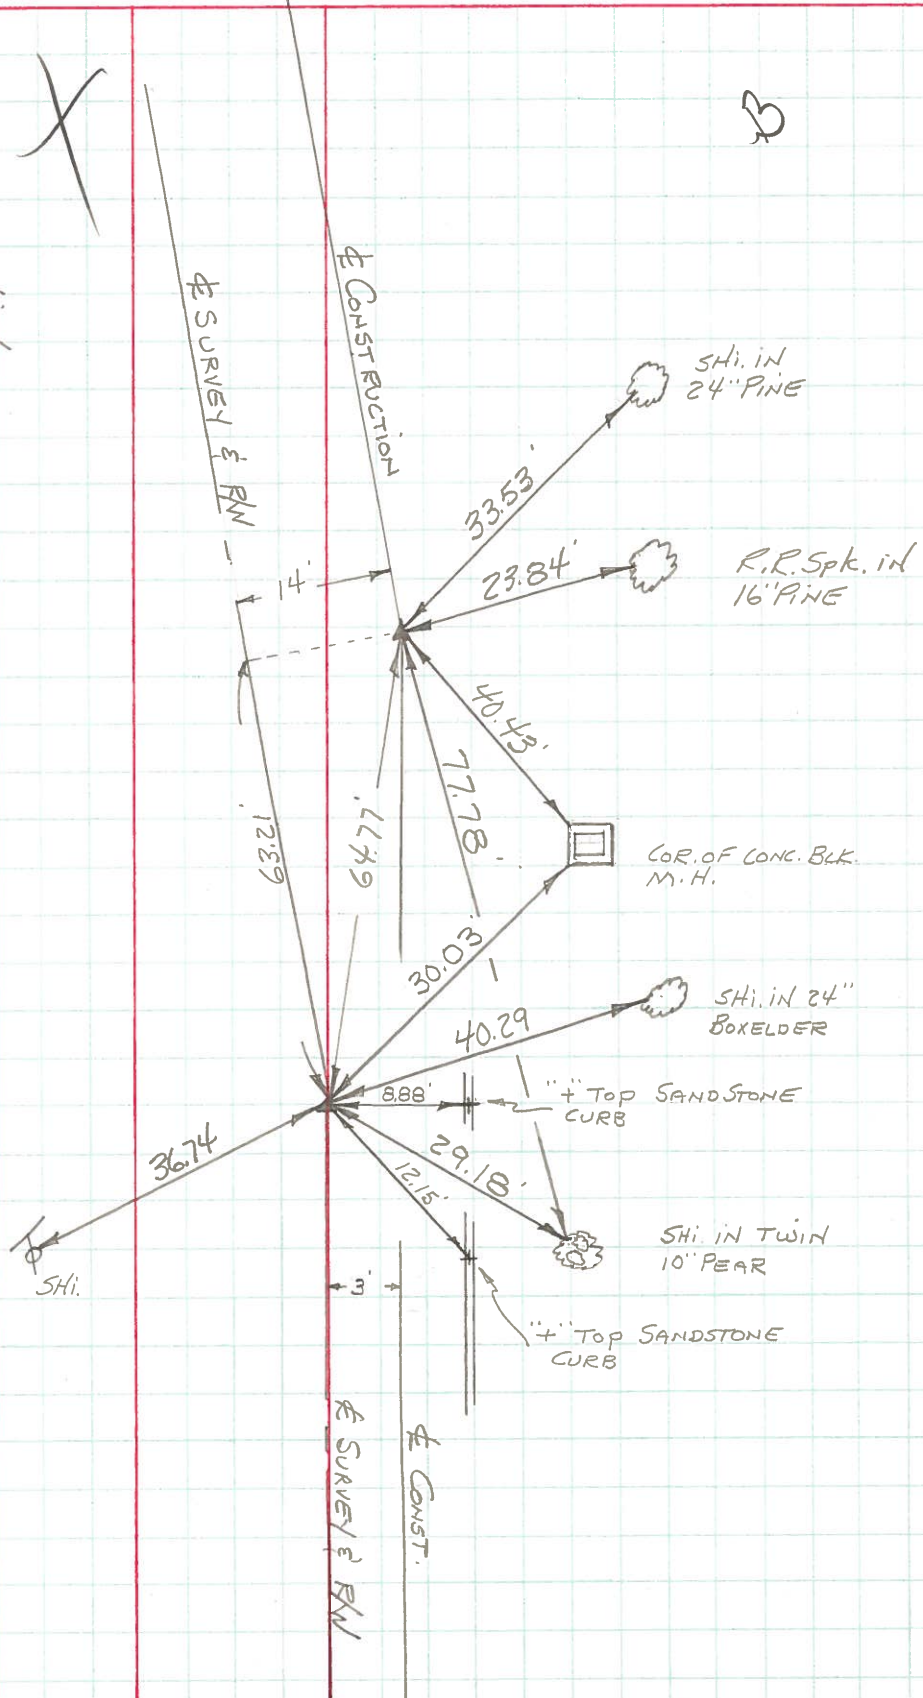 $\Delta = 9^\circ 50' \text{ LT.}$ 

PERSONNEL TITLE PERSONNEL TITLE

COUNTY Wood

DATE

S. R. #65

WEATHER

SEC. "C" (pt.)

TEMP.

DESCRIPTION East boundary, Perrysburg

JOB NO.

774

Sta. 25+94.0

I. pin


Shiner in 20" Elm N. 32.1
 Shiner in 2" Elm N.E. 41.3
 Near edge of sewer M.H. S.E. 37.1

#

775

Sta. 48+54.2

P.I. Δ = 32° 09' E.

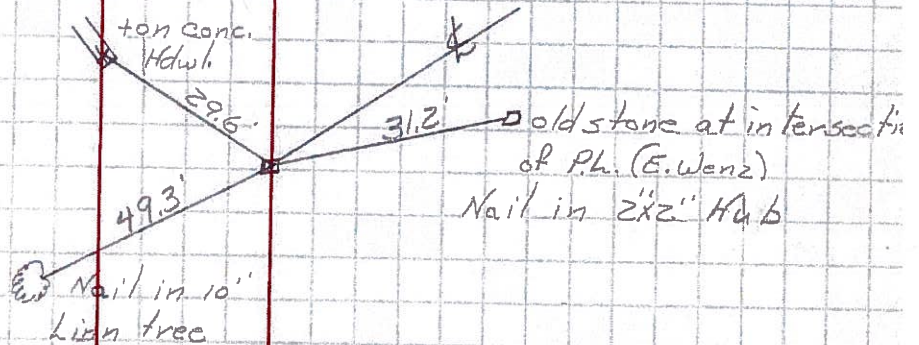

#

776

Sta. 40+25.7

P.I. Δ = 26° 22' 30"

Shiner in 10" Linn S.W. 25.6
 Shiner in 18" Linn S.E. 66.2
 10" Box Elder E. 36.9

#

777

Sta. 31+66.4

P.I. Δ = 9° 47' Lt.

