

O.D.O.T. DISTRICT 2 SURVEY OFFICE (USE ONLY)

PERSONNEL

REFERENCE NO. 30 BC

SHEET 4 OF 23

NOTES BARRIERE

DATE 7/1/24

ROUTE SR 65

H.C. MILLER

WEATHER SUNNY

COUNTY WOOD

R.C. BLUBAUGH

TEMP. 74°

TOWNSHIP PERRYSBURG

DWG BY BARRIERE

PID 101291

SECTION 69

T 3 N R 12 MI RESERVE

TYPE MONUMENT MAG SHANK

ON SURFACE - BELOW ON

OFFSET $\odot$ PAVEMENT 14.5' RT LT : RT

TO EDGE PAVEMENT

STATION: 1036+40

HORZ.DATUM: NAD83 (2011)


GEOID: 18

GRID: NORTHING: 695462.039

EASTING: 1665084.641


LDP: NORTHING: 517469.438

EASTING: 175298.473

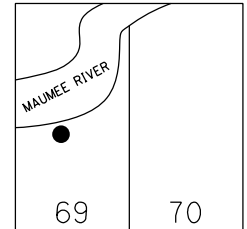

RECORD:
STA 32+31.06
 $\odot$ CONSTRUCTION
 $\Delta = 9^\circ 50' \text{ LT}$
SET MAG/WASHER
10/28/05, SAH
FD MAG/WASHER
REFBC30
12/16/19, JFO
FD MAG SHANK
REF30BC
7/1/24, JAM

DIST. 30B-30BC=64.73'

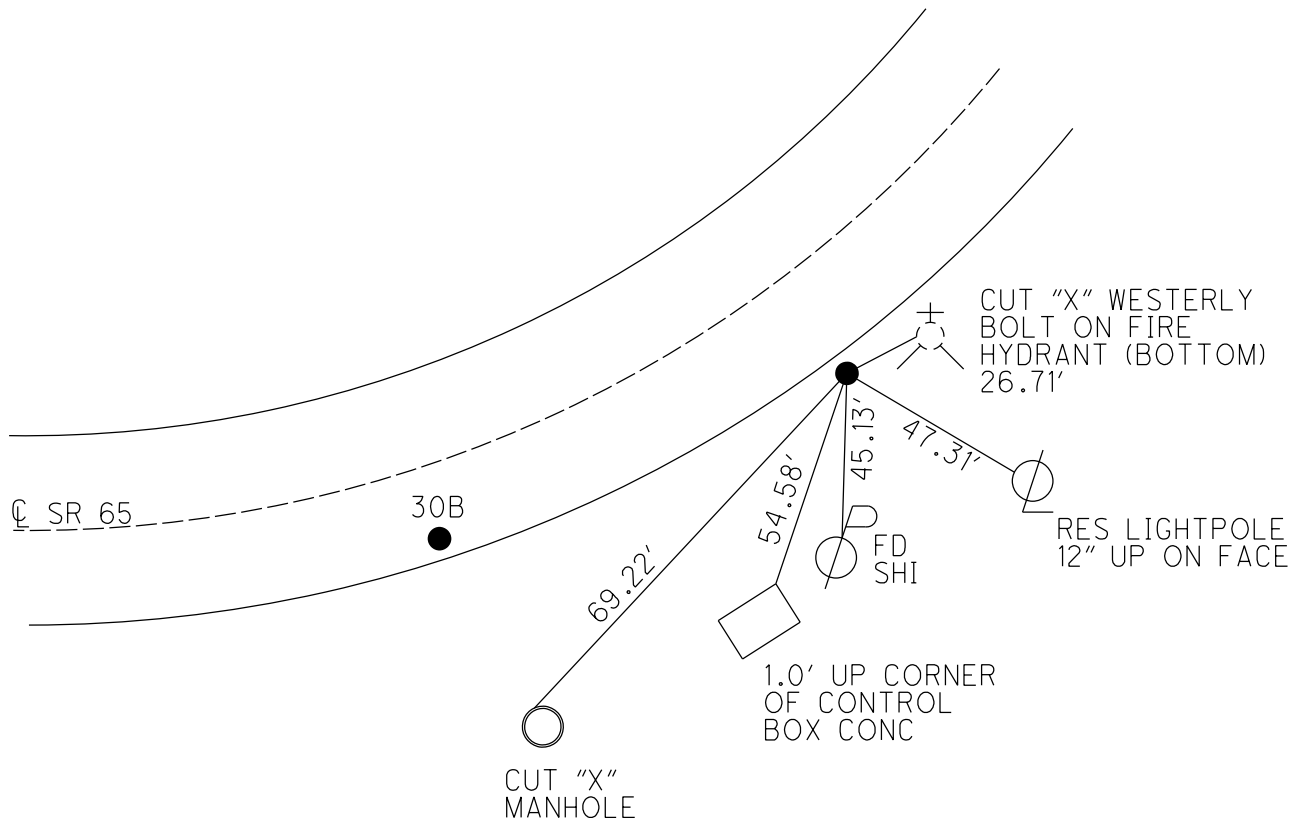

O.D.O.T. DISTRICT 2 SURVEY OFFICE (USE ONLY)

PERSONNEL

REFERENCE NO. 30 BC

SHEET 2 OF 8

NOTES HUSS

DATE 9/13/05

ROUTE SR 65

H.C. HOMAN

WEATHER SUNNY

COUNTY WOOD

R.C. MIKLOVIC

TEMP. 78°

TOWNSHIP PERRYSBURG

SECTION RT 69

DWG BY NIESE

PID -

T 3 12 MILE RESERVE

TYPE MONUMENT P.K./WASHER

ON SURFACE - ~~BELOW~~ ON

OFFSET CL PAVEMENT 14.5' ~~LT~~ : RT
2.5' TO RT EDGE PAVEMENT


STATION: 1036+40

HORZ.DATUM: NAD83(2011)

GEOID: 2012A


GRID: NORTHING: 695462.039

EASTING: 1665084.641

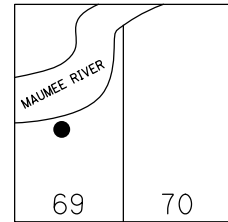

RECORD:
STA 32+31.06
CL CONSTRUCTION
 $\Delta = 9^\circ 50'$ LT
SET MAG/WASHER
10/28/05, SAH
FD MAG/WASHER
REFBC30
12/16/19, JFO

DIST. 30B-30BC=64.73'

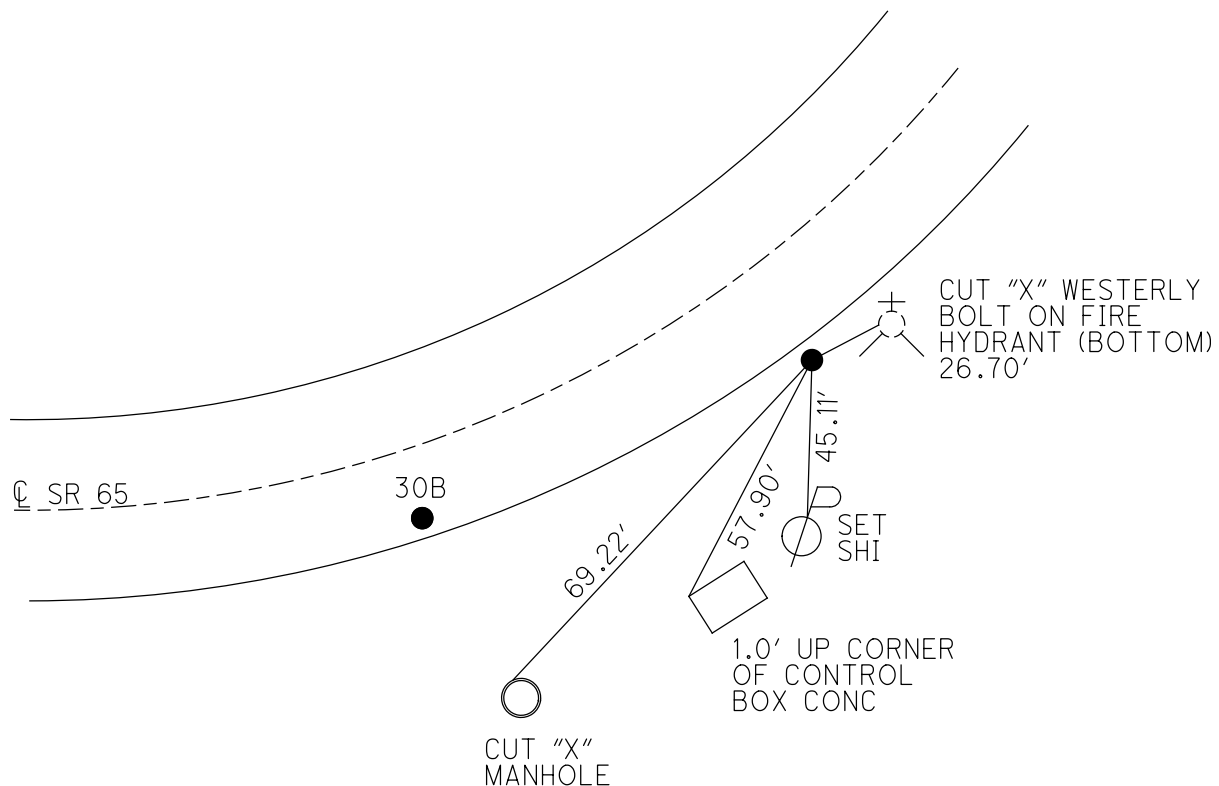

O.D.O.T. DISTRICT 2 SURVEY OFFICE

PERSONNEL

REFERENCE NO. 30-8

SHEET 4 OF 14

NOTES

HUSS

DATE

9-13-05

ROUTE

SR 65

H.C.

HOMAN

WEATHER

SUNNY

COUNTY

WOOD

R.C.

MIKLOVIC

TEMP.

78°

TOWNSHIP PERRYSBURG

SECTION RIVER TRACT

~~T 7 N~~ ~~R 11 E~~

Town 3, 12 mile Res.

TYPE MONUMENT

PK & WASHER

ON SURFACE - ~~BELOW~~

ON


~~LEFT~~ ~~C PAVT~~ - RIGHT

14.5' RT

2.5' TO RT OF EDGE PAVEMENT

S.L.M.


1036+40

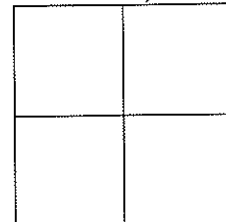

RECORD PT A
1937 C SURVEY & C RW STATION=
P.I. 31+66.4
DELTA=9°50' LT.

SET MAG NAIL
& WASHER
10-28-05
SAH

RECORD PT B
STA 32+31.06 C CONST.
DELTA=9°50' LT.

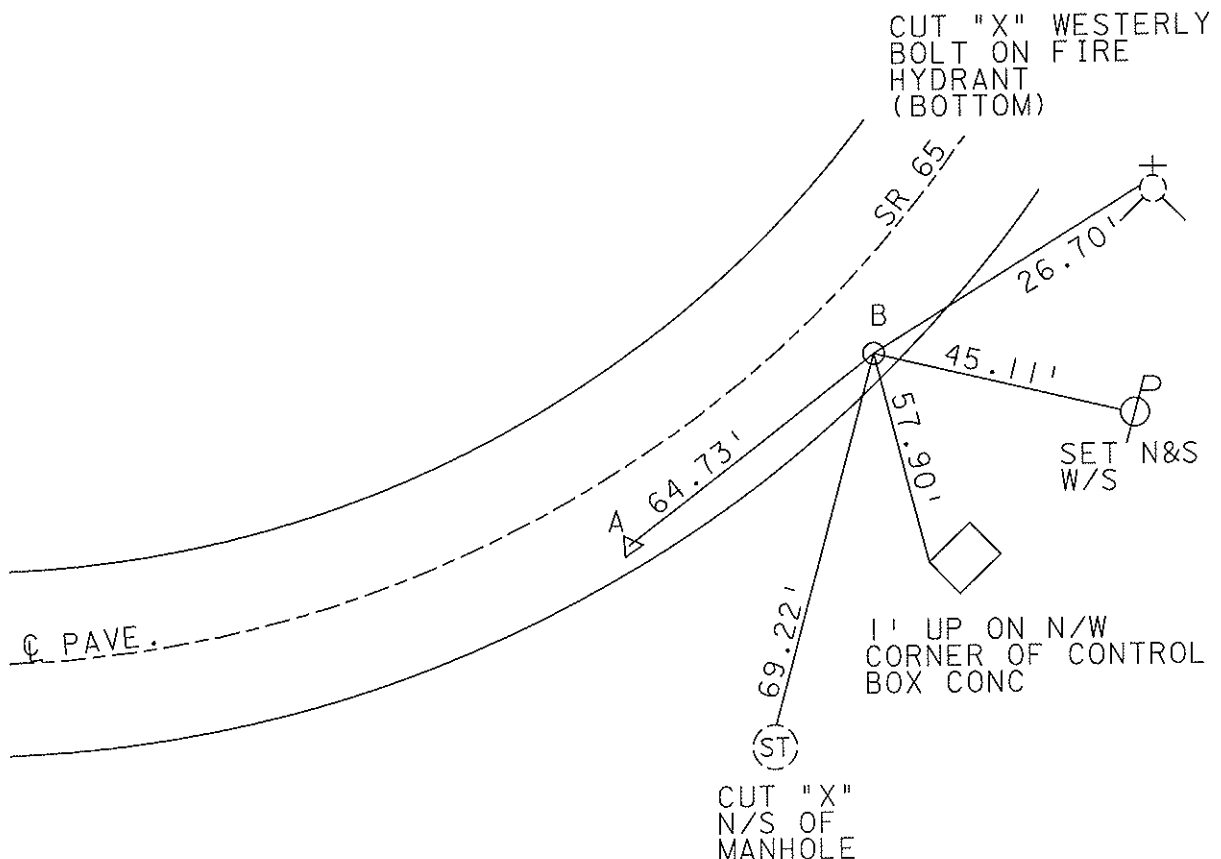

O.D.O.T. DISTRICT 2 SURVEY OFFICE

PERSONNEL

REFERENCE NO. 30-B

SHEET OF

NOTES BARNHISEL

H.C. FEED

DATE 5-2-88

ROUTE 65

R.C. Loehrke

WEATHER SUNNY

COUNTY WOOD

HOFFMAN

TEMP. +70°

TOWNSHIP Perryburg

SECTION FIVE TRACT 49

T 7 N R 11 E


TYPE MONUMENT PI. A 6g Spk Pt. B. PK NAIL

ON SURFACE - BELOW 2" SURFACE

LEFT-~~C~~ PAV'T. - RIGHT 6.1 14.2

.7 TO Lt EDGE PAVEMENT curbing

S.L.M. Pt. "A" 1035+75

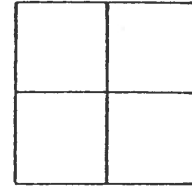

Pt. A
Pt. B


RECORD Pt. "A"

STA: 31+66.4 & Survey
 $\Delta = 90^\circ 50' \text{ Lt}$

RECORD Pt. "B"

STA: 32+31.06 & Const.
 $\Delta = 90^\circ 50' \text{ Lt}$

Pt. "A" Set 2nd 6g Spk
Pt. B Set PK Nail
8-26-88
T.B.

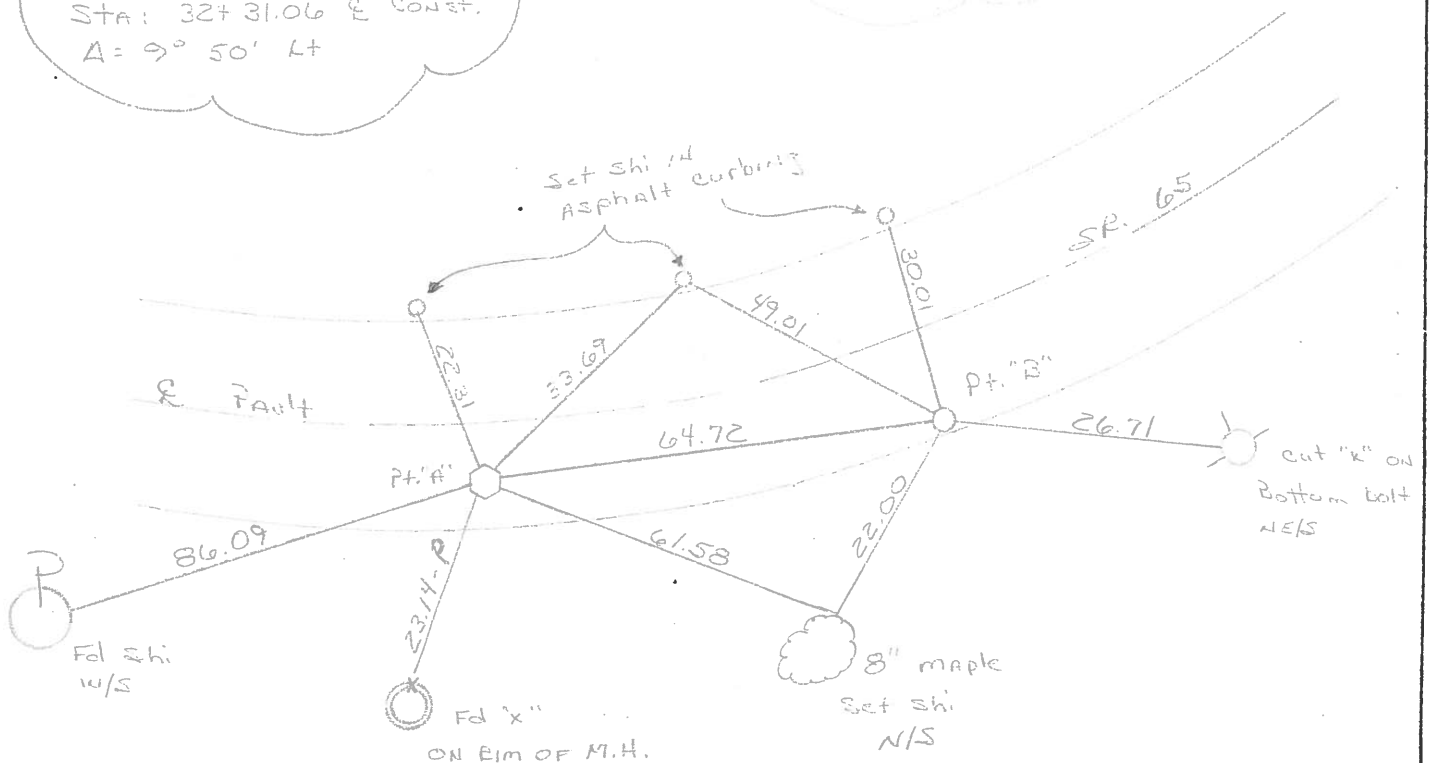

O.D.O.T. DISTRICT 2 SURVEY OFFICE

SHEET

OF

County Wood S.R. 65

Township _____

Section _____

T N, R E

Personnel L. Stone

R. Michalak

P. Neuse


D. Curtis

H. Mead


Date 13 Nov. 80

Weather cloudy

Temp. 40°

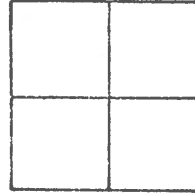

REF. NO. 30-B

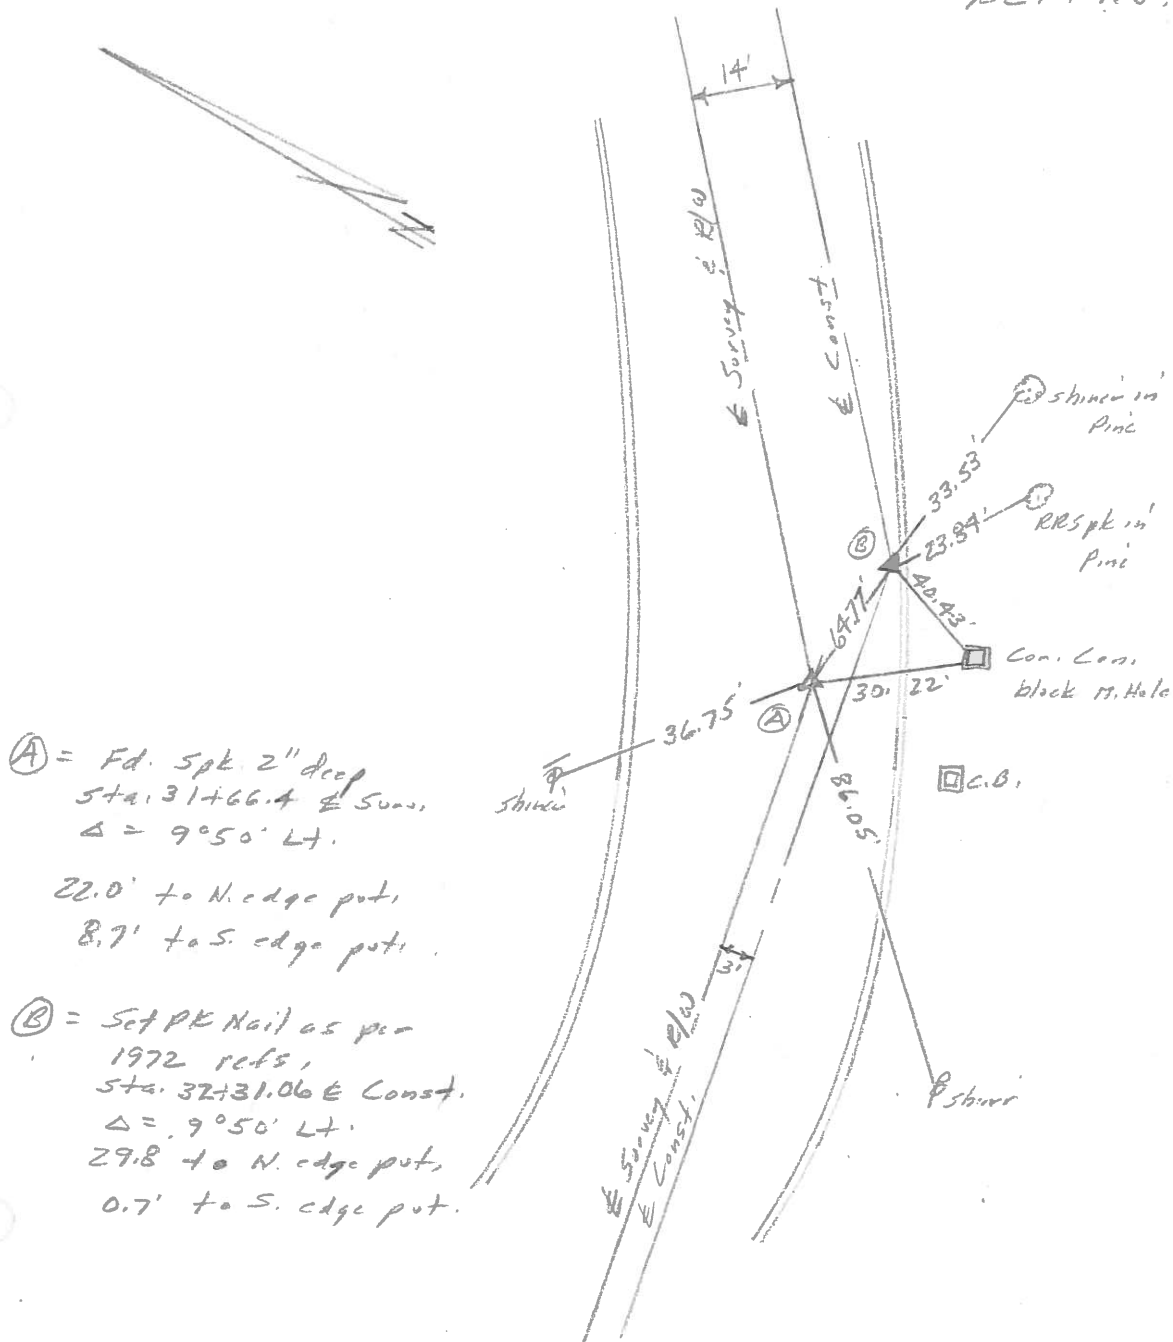

PERSONNEL	TITLE	PERSONNEL	TITLE
BURNSIDE			
SMITH			
BOWERS			

COUNTY Wood DATE 5-22-72S. R. 65 WEATHER CLEARSEC. SEC. C (PT) TEMP. +80°DESCRIPTION PERAYS BURG TWP JOB NO. _____