

O.D.O.T. DISTRICT 2 SURVEY OFFICE (USE ONLY)

PERSONNEL

REFERENCE NO. 30 C

SHEET 5 OF 23

NOTES BARRIERE
H.C. MILLER
R.C. BLUBAUGH

DATE 7/1/24
WEATHER SUNNY
TEMP. 74°

ROUTE SR 65
COUNTY WOOD
TOWNSHIP PERRYSBURG
SECTION 69

DWG BY BARRIERE PID 101291

T 3 N R 12 MI RESERVE

TYPE MONUMENT MAG SHANK

ON SURFACE - BELOW ON

OFFSET $\varnothing$ PAVEMENT 41.00' RT LT : RT

TO EDGE PAVEMENT

STATION: 1044+34

HORIZ.DATUM: NAD83 (2011)


GEOID: 18

GRID: NORTHING: 696064.792


EASTING: 1665602.426

LDP: NORTHING: 518078.986

EASTING: 175808.260

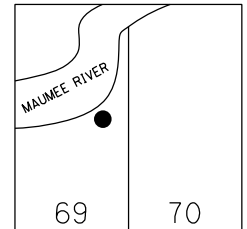

RECORD: P.I.
1937 $\varnothing$ SURVEY
STA. 40+25.7
 $\Delta = 26^{\circ} 22' \text{ LT}$
D = $3^{\circ} 00'$
T = 447.39'
L = 878.88'
E = 51.69'
R = 1909.86'
T = 298.32'
FD 3/4" IPIN
5/22/72, BURNSIDE
FD STONE
SET DRILLH
11/13/80, IRS
FD IPID
W/ 1 1/2" CAP
3 1/2" DOWN
REFC30
12/16/19, JFO
FD IPID 3" DOWN
NEW TIES PULLED
REF30C
7/1/24, JAM

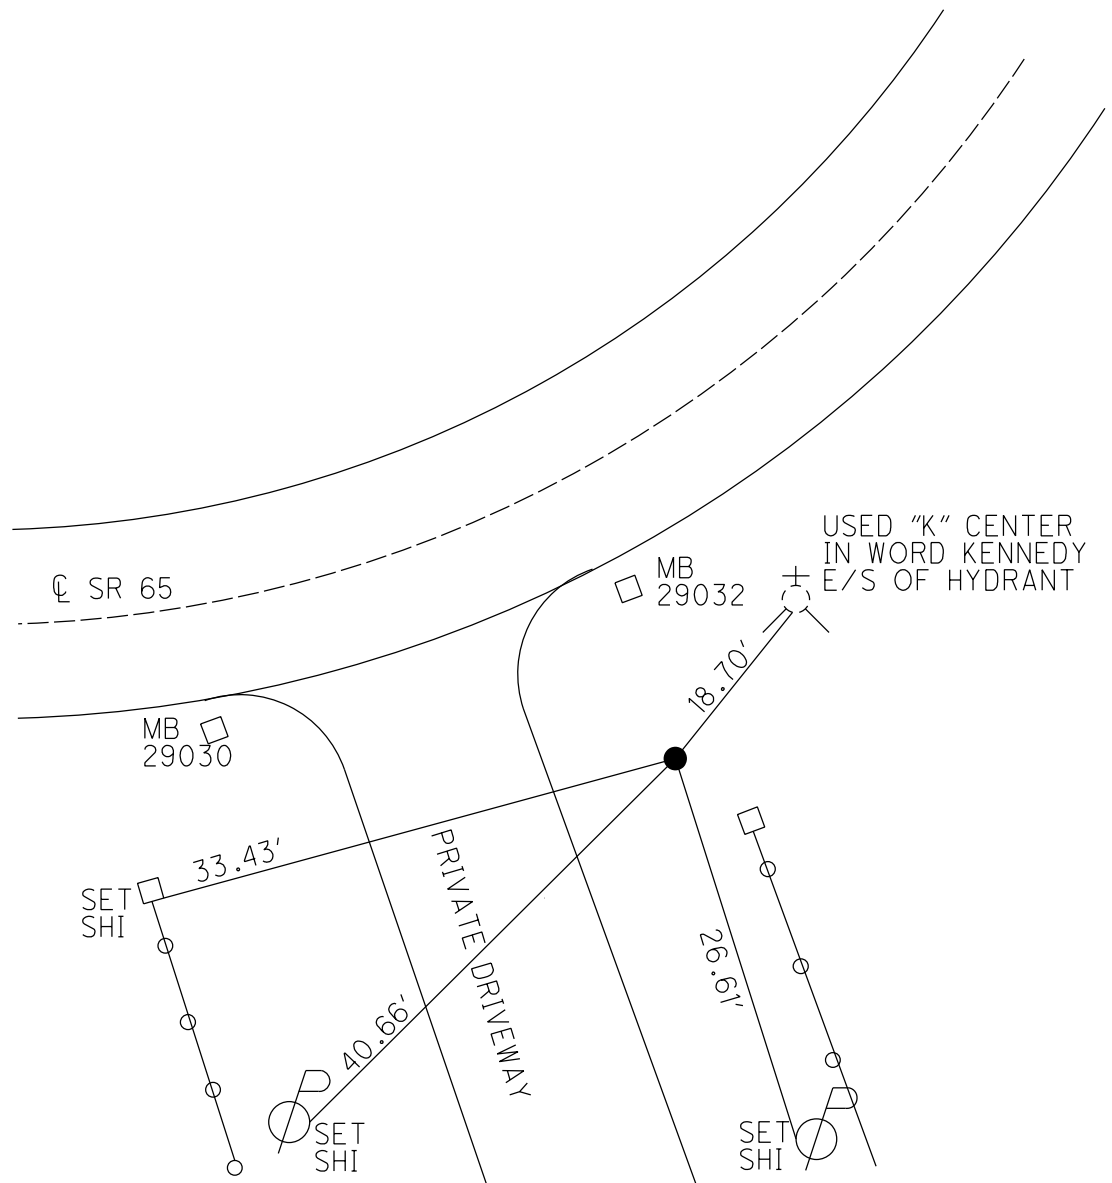

O.D.O.T. DISTRICT 2 SURVEY OFFICE (USE ONLY)

PERSONNEL

REFERENCE NO. 30 C

SHEET 3 OF 8

NOTES HOFFMAN

DATE 4/4/85

ROUTE SR 65

H.C. BARNHISEL

WEATHER CLOUDY

COUNTY WOOD

R.C. LOEHRKE

TEMP. 50°

TOWNSHIP PERRYSBURG

DWG BY NIESE

PID -

SECTION RT 69

T 3 12 MILE RESERVE

TYPE MONUMENT SANDSTONE W/ DRILLH

ON SURFACE - ~~BELOW~~ ON

OFFSET Q PAVEMENT 41.00' ~~LT~~ : RT

25.7' TO RT EDGE PAVEMENT


STATION: 1044+34

HORZ.DATUM: NAD83(2011)


GEOID: 2012A

GRID: NORTHING: 696064.792

EASTING: 1665602.426

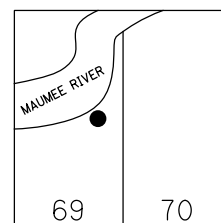

RECORD: P.I.
1937 Q SURVEY
STA. 40+25.7
 $\Delta = 26^\circ 22' LT$
 $D = 3^\circ 00'$
 $T = 447.39'$
 $L = 878.88'$
 $E = 51.69'$
 $R = 1909.86'$
 $T = 298.32'$
FD 3/4" IPIN
5/22/72, BURNSIDE
FD STONE
SET DRILLH
11/13/80, IRS
FD IPID
W/ 1 1/2" CAP
3 1/2" DOWN
REFC30
12/16/19, JFO

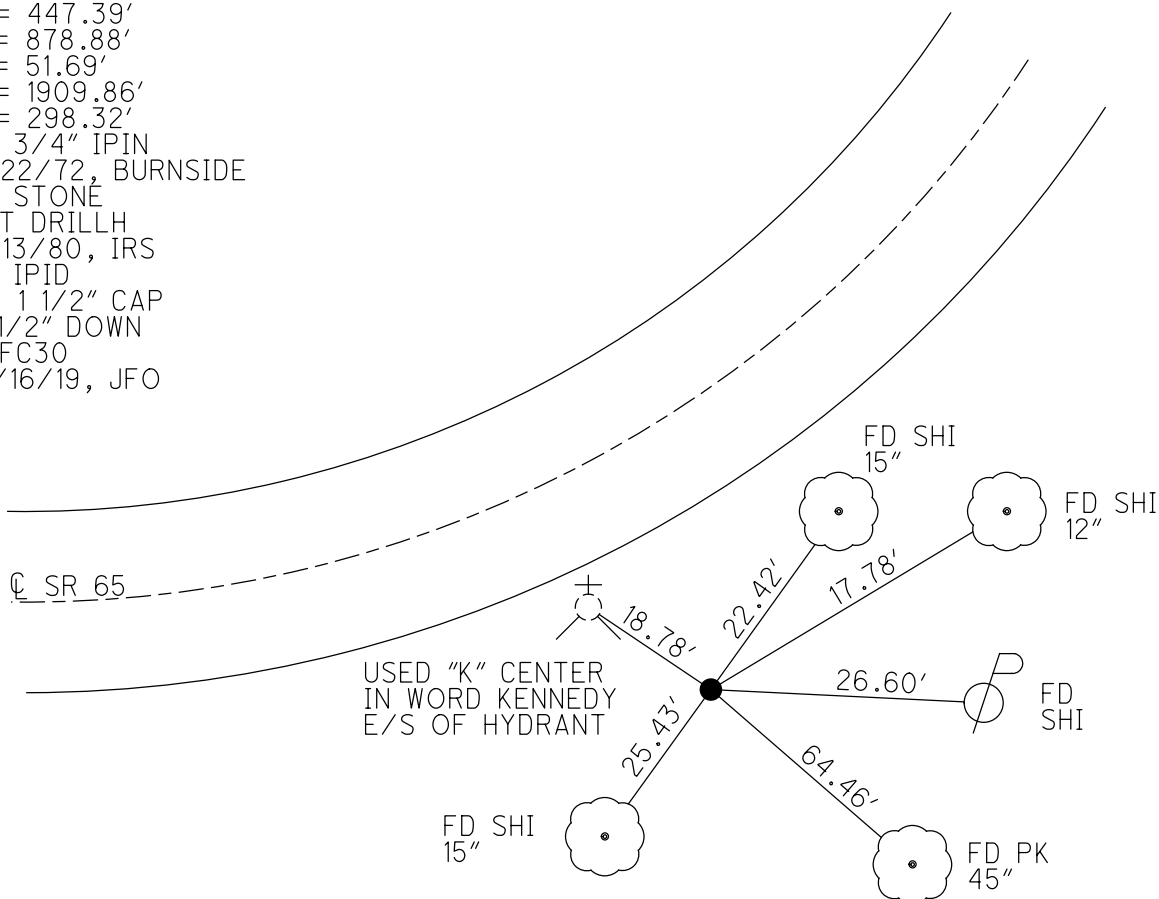

O.D.O.T. DISTRICT 2 SURVEY OFFICE

PERSONNEL

REFERENCE NO. 30-C SHEET 5 OF 14



NOTES _____
H.C. HOFFMAN
R.C. BARNHISEL
LOEHRKE

DATE 4-4-85
WEATHER CLOUDY
TEMP. 50°

ROUTE SR 65
COUNTY WOOD
TOWNSHIP PERRYSBURG
SECTION RIVER TRACT
T 7 N R 11 E


Township 3, 12 mile Les.

TYPE MONUMENT SANDSTONE W/ DRILL HOLE
ON SURFACE - ~~BELOW~~ ON
~~LEFT - Q PAVT~~ - RIGHT 41' RT
25.7' TO RT EDGE PAVEMENT
S.L.M. 1044+34

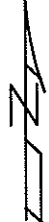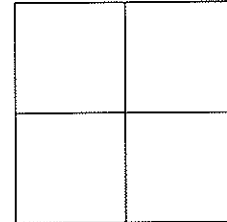

1937 C SURVEY STATION=
P.I. 40+25.7
DELTA=26°22' LT.

NOTES: OFF ROAD
Did not locate
ALL Recon Data

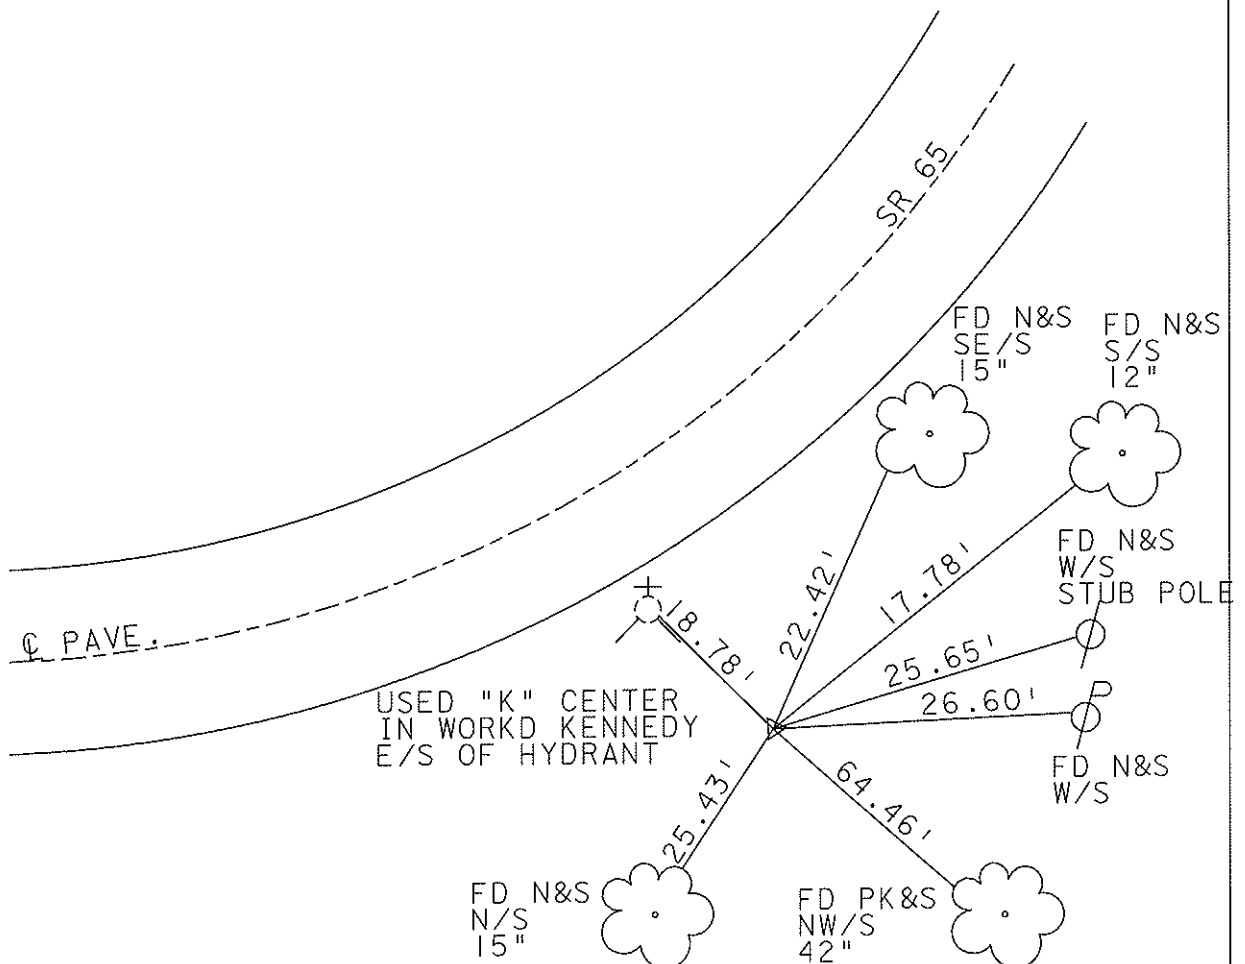

O.D.O.T. DISTRICT 2 SURVEY OFFICE

PERSONNEL

REFERENCE NO. 30-C

SHEET OF

NOTES Hoffman

H.C. BARNHISEL

R.C. LEHRKE

DATE 4-4-85

WEATHER Cloudy

TEMP. 50°

ROUTE SR 65

COUNTY WOOD

TOWNSHIP Perrysburg

SECTION River TRACT 69

T R


TYPE MONUMENT SANDSTONE / DRILL HOLE

ON SURFACE - BELOW

~~LEFT~~ - & PAW'T. - RIGHT 41.0'

25.7 TO SOUTH EDGE PAVEMENT
(RT.)

S.L.M.

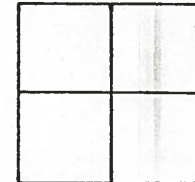


1937 & Survey STATION =

40 + 25.7

$\Delta = 26^{\circ} - 22' \text{ Lt.}$

1044 + 28 - S.L.M.

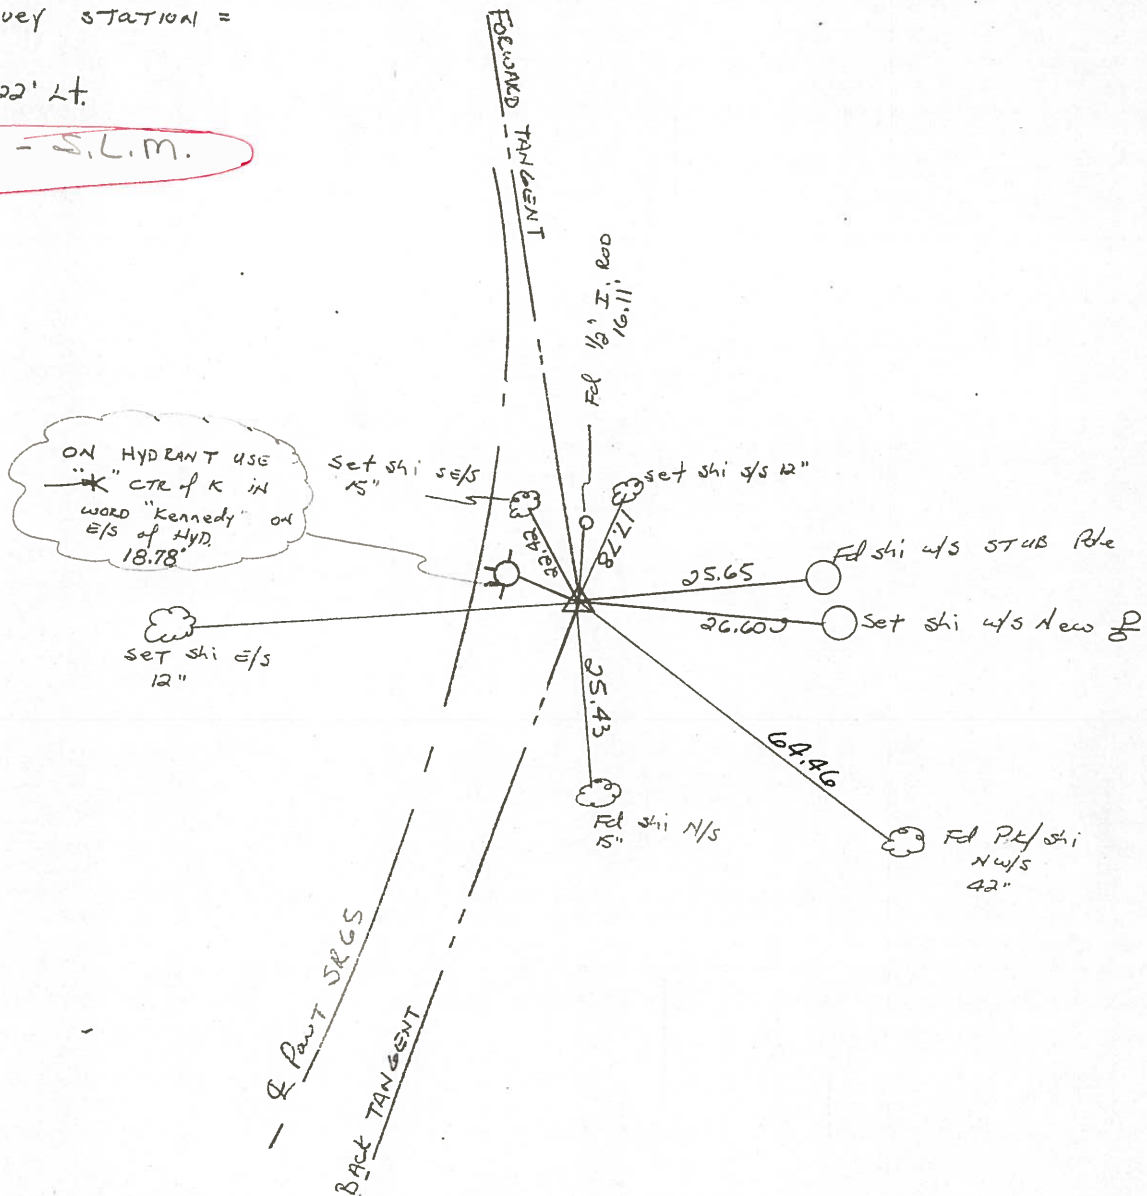

O.D.O.T. DISTRICT 2 SURVEY OFFICE

PERSONNEL

REFERENCE NO. 30-C

SHEET ____ OF ____

NOTES Hoffman

H.C. BARNHISEL

R.C. LOEHRS

DATE 4-4-85

WEATHER Cloudy

TEMP. 50°

ROUTE SR 65

COUNTY WOOD

TOWNSHIP Perrysburg

SECTION River TRACT 69

T ____ R ____


TYPE MONUMENT SANDSTONE / DRILL HOLES

ON SURFACE BELOW

~~LEFT~~ - & PAW'T. - RIGHT 41.0'

25.7 TO SOUTH EDGE PAVEMENT
(R.T.)


S.L.M. _____

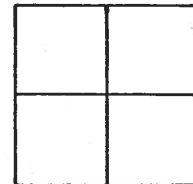

1937 & Survey station =

40 + 25.7

$\Delta = 26^{\circ} - 22' \text{ Lt.}$

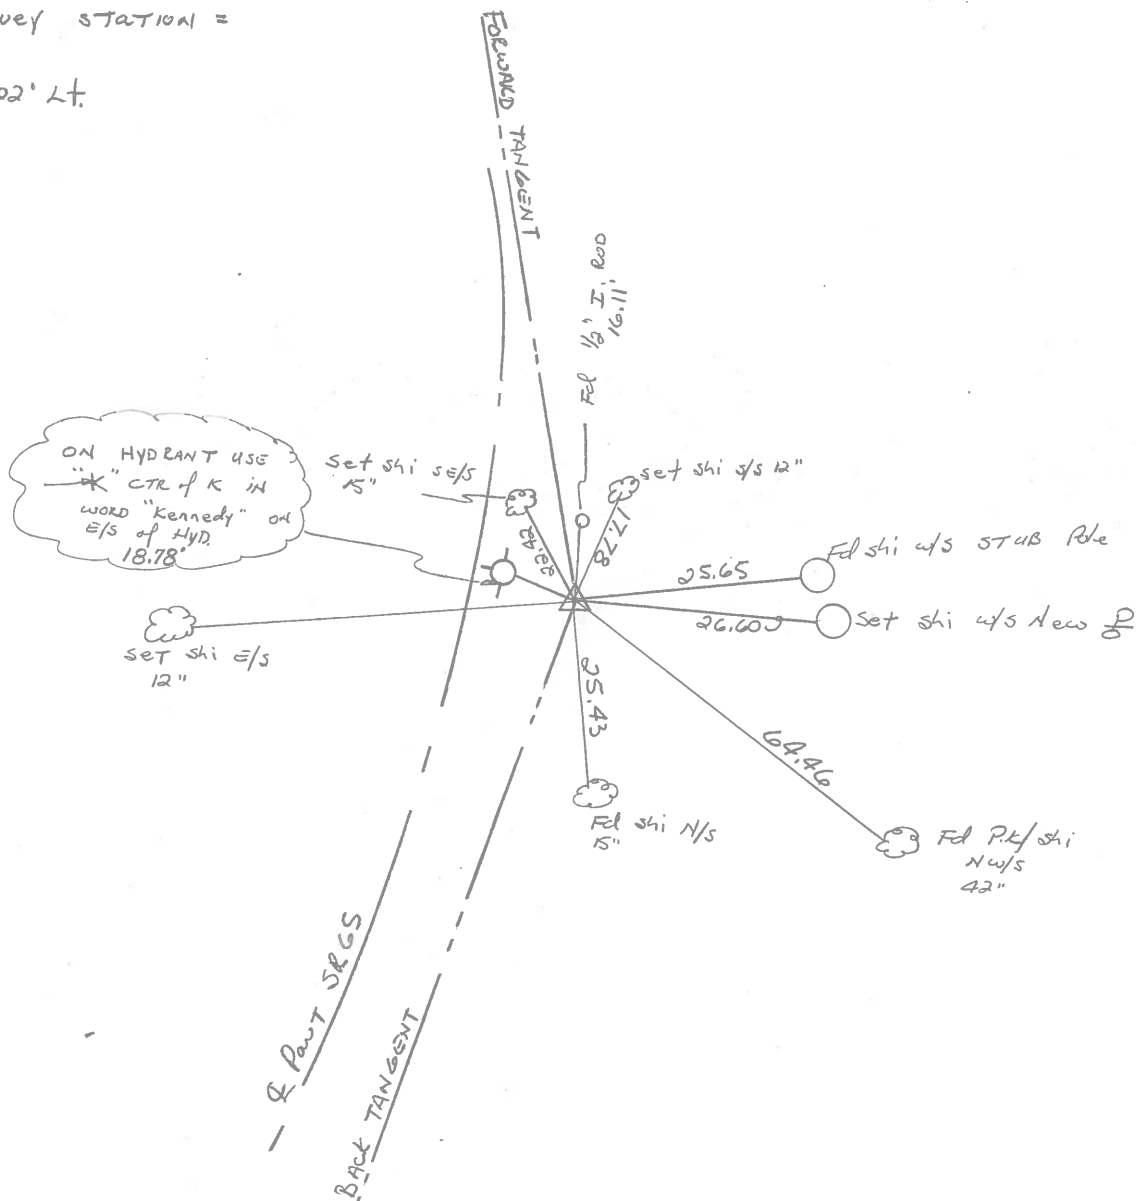

O.D.O.T. DISTRICT 2 SURVEY OFFICE

SHEET

OF

County Wood S.R. 65

Township _____

Section _____

T N, R E

Personnel I. Stone

P. Neuser

R. Michalak


D. Curtis

H. Mead


Date 13 Nov. 1980

Weather Cloudy

Temp. 45°

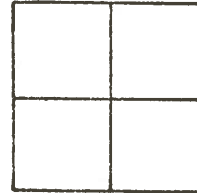

REF. No 30C

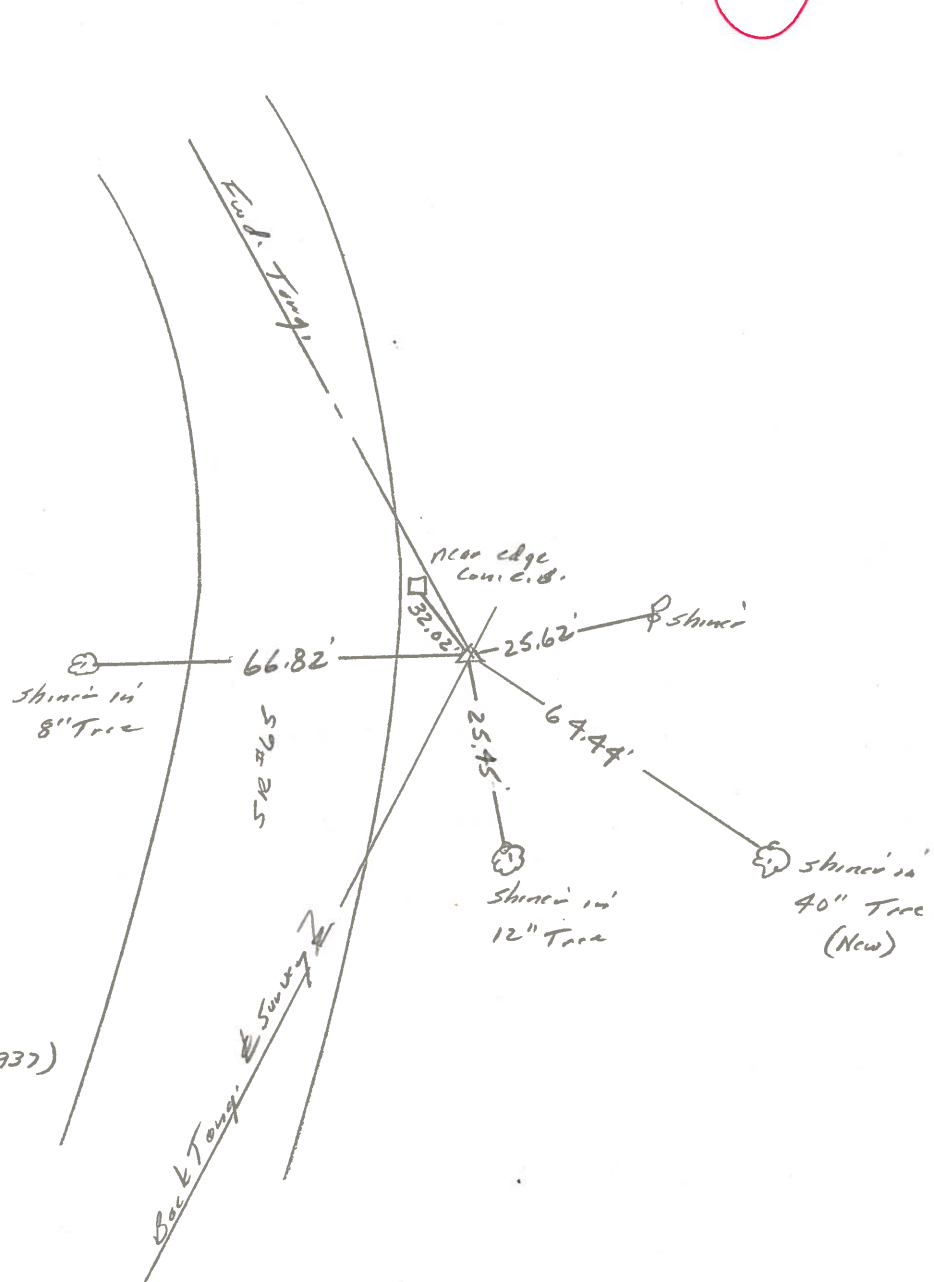

PERSONNEL	TITLE	PERSONNEL	TITLE	COUNTY	DATE	WEATHER	TEMP.
BURNSIDE				WOOD	5-22-72	CLEAR	+80°
SMITH				S. R. 65			
BOWERS				SEC. C (PT)			

DESCRIPTION _____ **PERRYSBURG TWP** JOB NO. _____

LEFT

CENTER LINE

RIGHT

