

O.D.O.T. DISTRICT 2 SURVEY OFFICE (USE ONLY)

PERSONNEL

REFERENCE NO. 30 D

SHEET 6 OF 23

NOTES BARRIERE

DATE 7/1/24

ROUTE SR 65

H.C. MILLER

WEATHER SUNNY

COUNTY WOOD

R.C. BLUBAUGH

TEMP. 74°

TOWNSHIP PERRYSBURG

DWG BY BARRIERE

PID 101291

SECTION 69

T 3 N R 12 MI RESERVE

TYPE MONUMENT 3/4" IPIN

ON SURFACE - BELOW 12" BELOW

OFFSET Q PAVEMENT 46.3' LT LT : RT

TO EDGE PAVEMENT

STATION: 1052+43

HORIZ.DATUM: _____


GEOID: _____

GRID: NORTHING: _____


EASTING: _____

LDP: NORTHING: _____

EASTING: _____

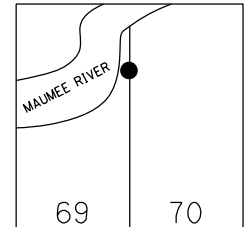

RECORD: P.I.
1937 Q SURVEY & RW
STA. 48+54.2
 $\Delta = 32^{\circ} 09' RT$
DNF
12/16/19, JFO
DID NOT FIND
7/1/24, JAM

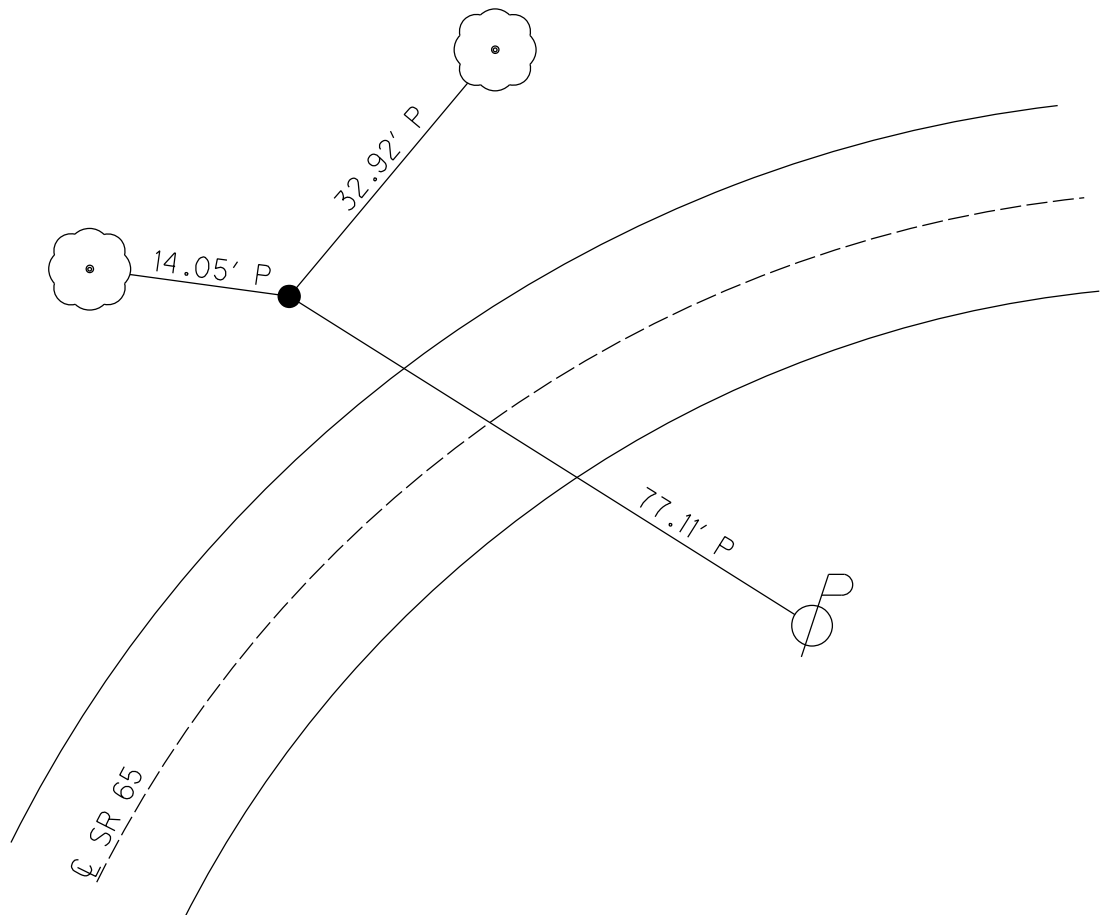

O.D.O.T. DISTRICT 2 SURVEY OFFICE (USE ONLY)

PERSONNEL

REFERENCE NO. 30 D

SHEET 4 OF 8

NOTES BARNHISEL

DATE 5/2/88

ROUTE SR 65

H.C. REED

WEATHER SUNNY

COUNTY WOOD

R.C. LOEHRKE

TEMP. 70°

TOWNSHIP PERRYSBURG

HOFFMAN

SECTION RT 69

DWG BY NIESE

PID -

T 3 12 MILE RESERVE

TYPE MONUMENT 3/4" IPIN

~~ON SURFACE~~ - BELOW 12"

OFFSET CL PAVEMENT 46.3' LT : ~~RT~~

31.2' TO LT EDGE PAVEMENT


STATION: 1052+43

HORZ.DATUM: -


GEOID: -

GRID: NORTHING: -

EASTING: -

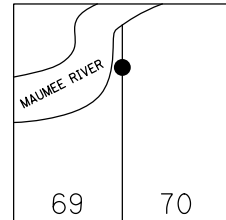

RECORD: P.I.
1937 CL SURVEY & RW
STA. 48+54.2
 $\Delta = 32^\circ 09' RT$
DNF
12/16/19, JFO

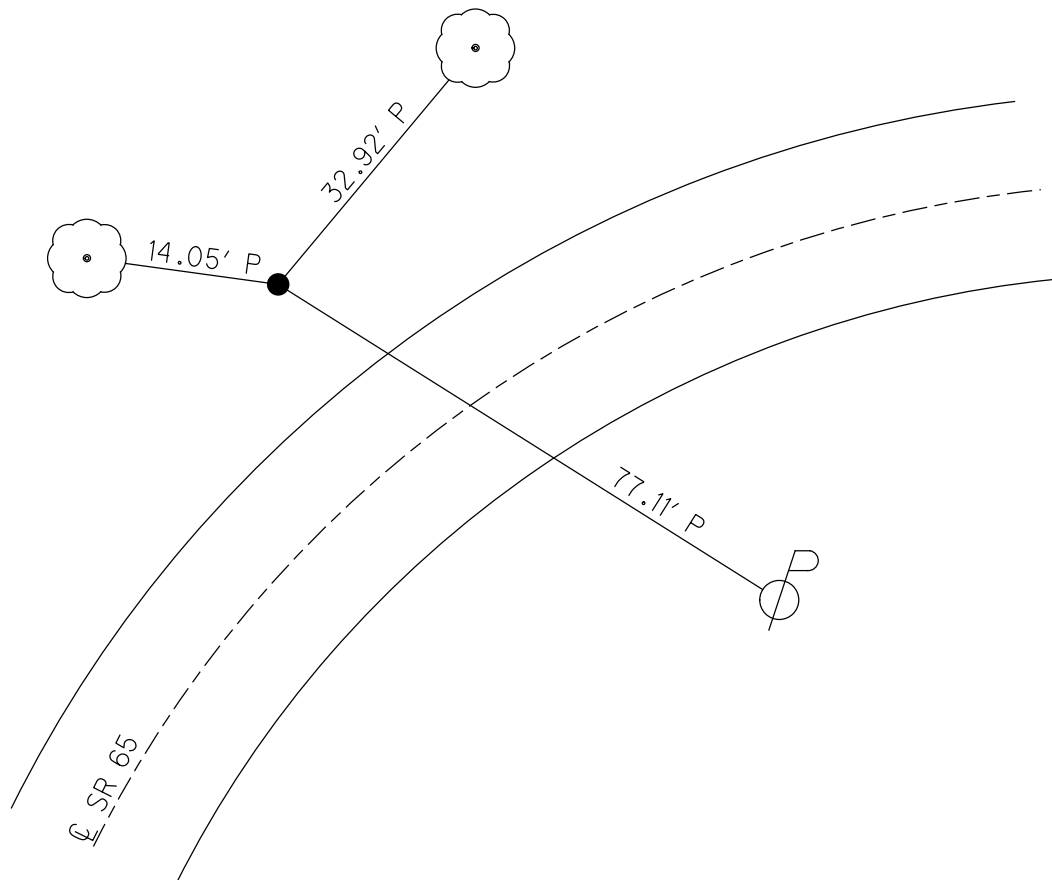

O.D.O.T. DISTRICT 2 SURVEY OFFICE

PERSONNEL

REFERENCE NO. 30-D SHEET 6 OF 14

NOTES BARNHISEL
H.C. REED
R.C. LOEHRKE
HOFFMAN

DATE 5-2-88
WEATHER SUNNY
TEMP. 70°

ROUTE SR 65
COUNTY WOOD
TOWNSHIP PERRYSBURG
SECTION RIVER TRACT

~~T7-N~~ ~~R11-E~~

Town 3, 12 mile Res.


TYPE MONUMENT P.I. 3 / 4" IRON ROD

~~ON SURFACE~~ - BELOW 12"

LEFT - ~~Q PAVT~~ ~~RIGHT~~ 46.3' LT


31.2' TO LT EDGE PAVEMENT

S.L.M. 1052+43

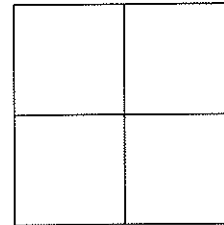

RECORD
1937 Q SURVEY & Q R/W STATION=
P.I. 48+54.2
DELTA=32°09' RT.

Note: OFF ROAD
DID NOT LOCATE
ALL RECORD DATA

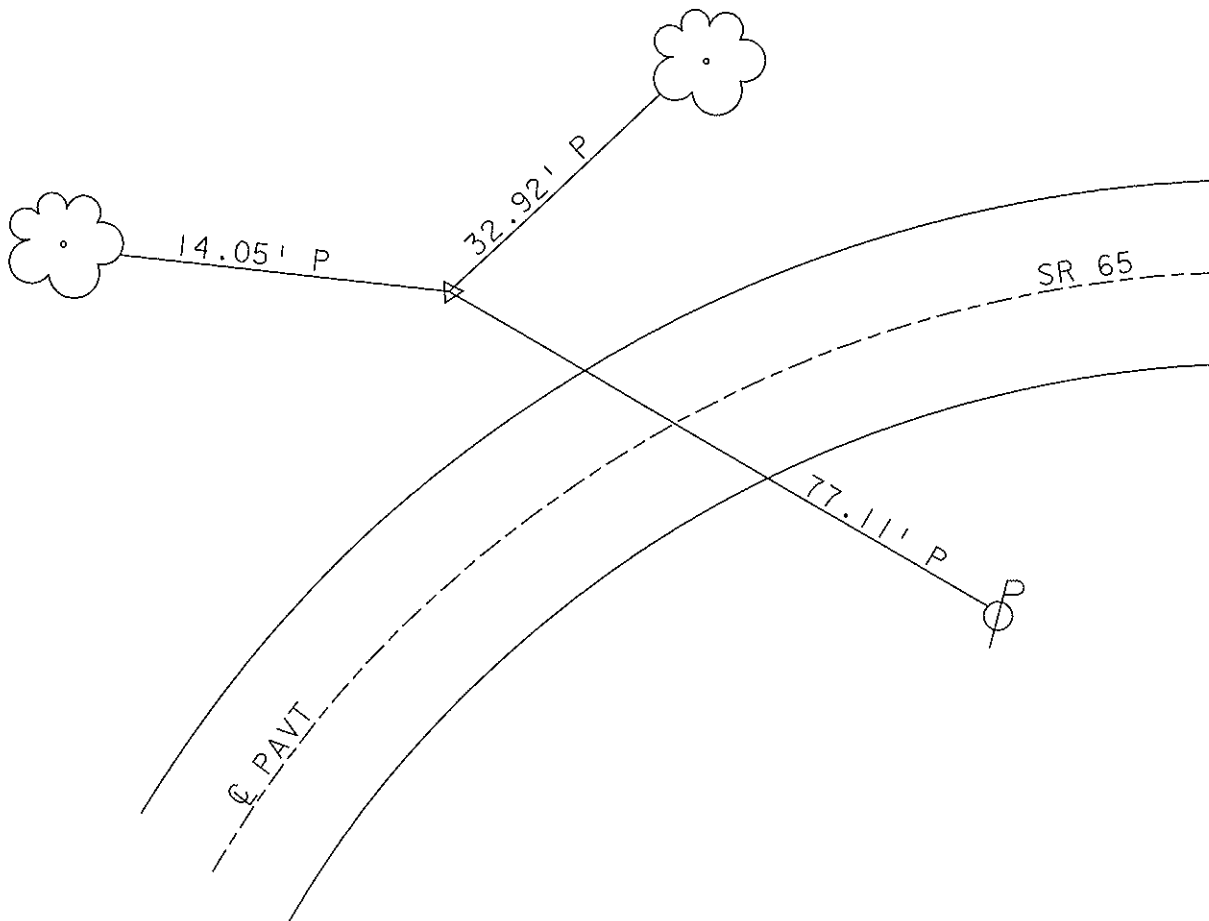

O.D.O.T. DISTRICT 2 SURVEY OFFICE

PERSONNEL

REFERENCE NO. 30-D

SHEET OF

NOTES BARNHISEL

H.C. Reed

R.C. Locheke

HOFFMAN

DATE 5-2-88

WEATHER SUNNY

TEMP. +70°

ROUTE 65

COUNTY WOOD

TOWNSHIP Perryburg

SECTION RIVER TRACT 70

T 7 N R 11 E


TYPE MONUMENT P.I. 3/4" IRON Rod

ON SURFACE - BELOW 12"

LEFT - & PAV'T. - RIGHT 46.3

31.2 TO Lt EDGE PAVEMENT

S.L.M. 1052+43

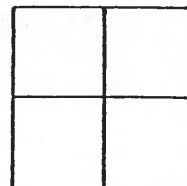


RECORD

1937 & Survey / R/L Station =

48+54.2

A = 32°-09' Rt

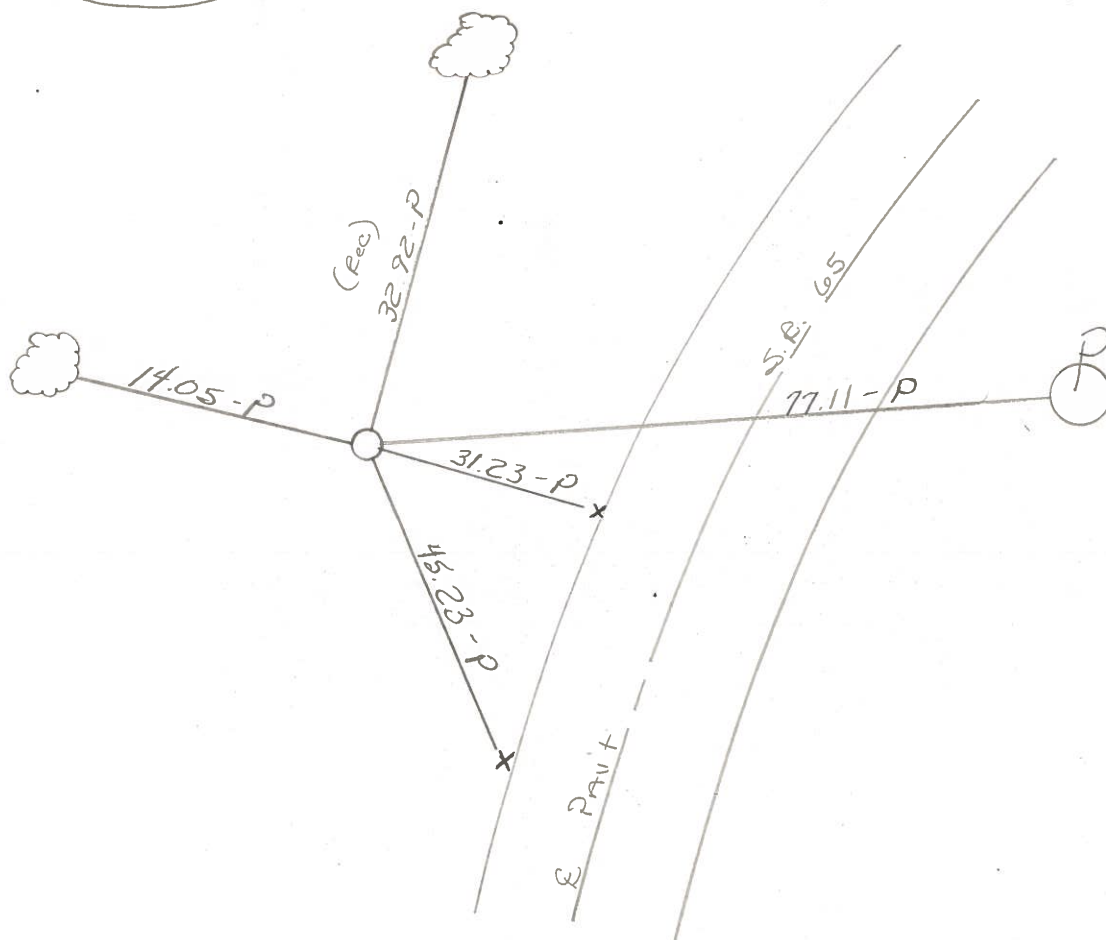

O.D.O.T. DISTRICT 2 SURVEY OFFICE

PERSONNEL

REFERENCE NO. 30-D

SHEET _____ OF _____

NOTES Hoffman

H.C. Barnhisel

R.C. Loehrer

DATE 4-4-85

WEATHER P. CLEAR

TEMP. 50°

ROUTE SR 65

COUNTY Wood

TOWNSHIP Perrysburg

SECTION RIVER TRACT 70

T _____ R _____


TYPE MONUMENT 3/4" I. Rod in 4" F. Tile

~~ON SURFACE~~ - BELOW 12"

LEFT - C PAV'T. - RIGHT 46.3

31.2 TO EAST EDGE PAVEMENT


S.L.M. LT.

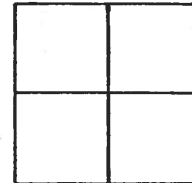

1937 E SURVEY R/W STATION =

48+54.2

$\Delta = 32^{\circ}-09' RT.$

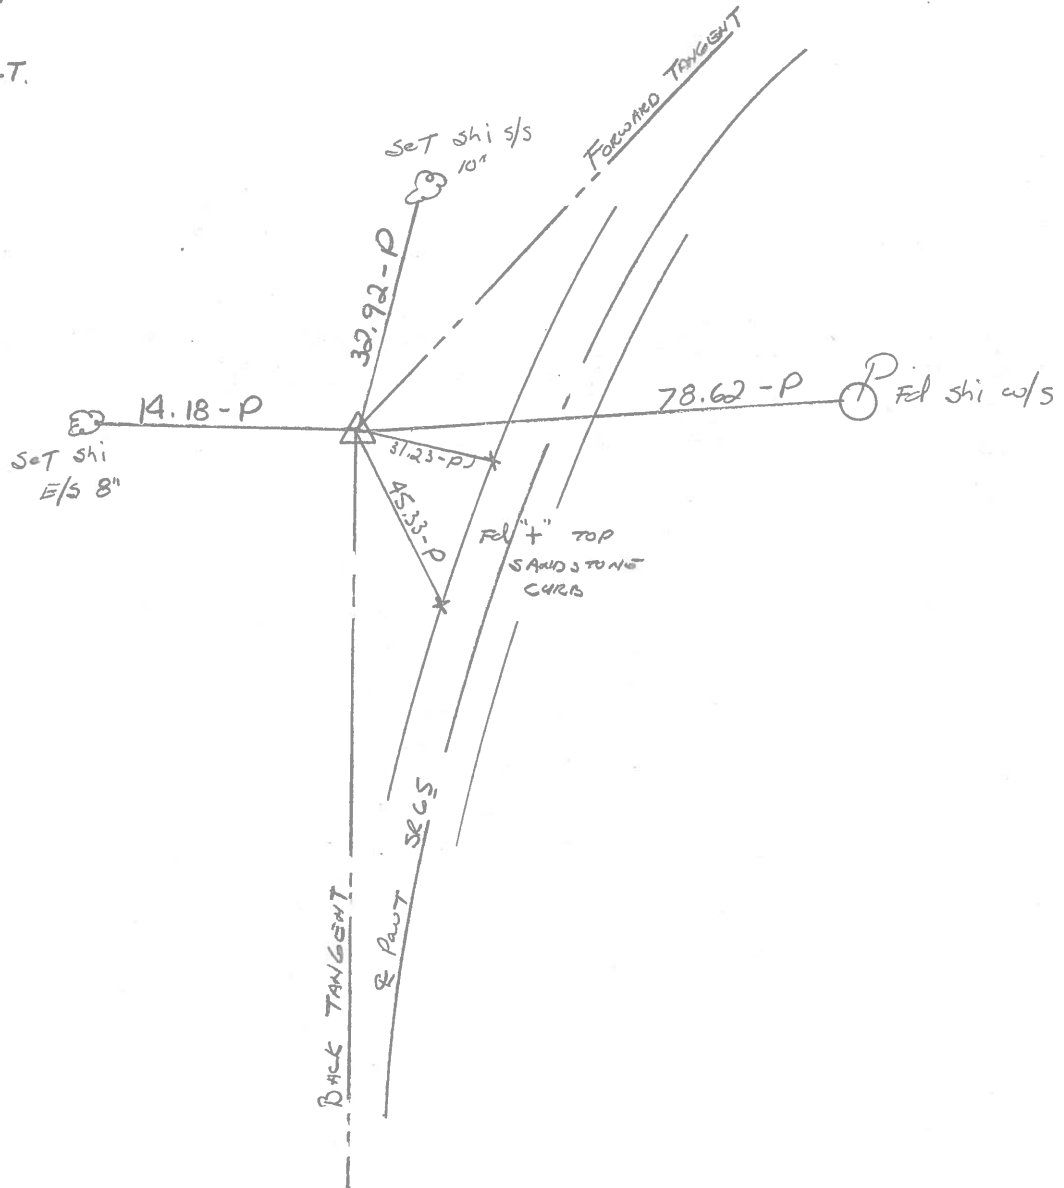

O.D.O.T. DISTRICT 2 SURVEY OFFICE

SHEET

OF

County Wood S.R. 65

Township _____

Section _____

T N, R E

Personnel J. Stone

R. Michalak

P. Neuser


D. Curtis

H. Meed


Date 13 Nov. 80

Weather cloudy

Temp. 46°

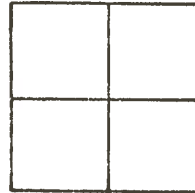

REF. No 30D

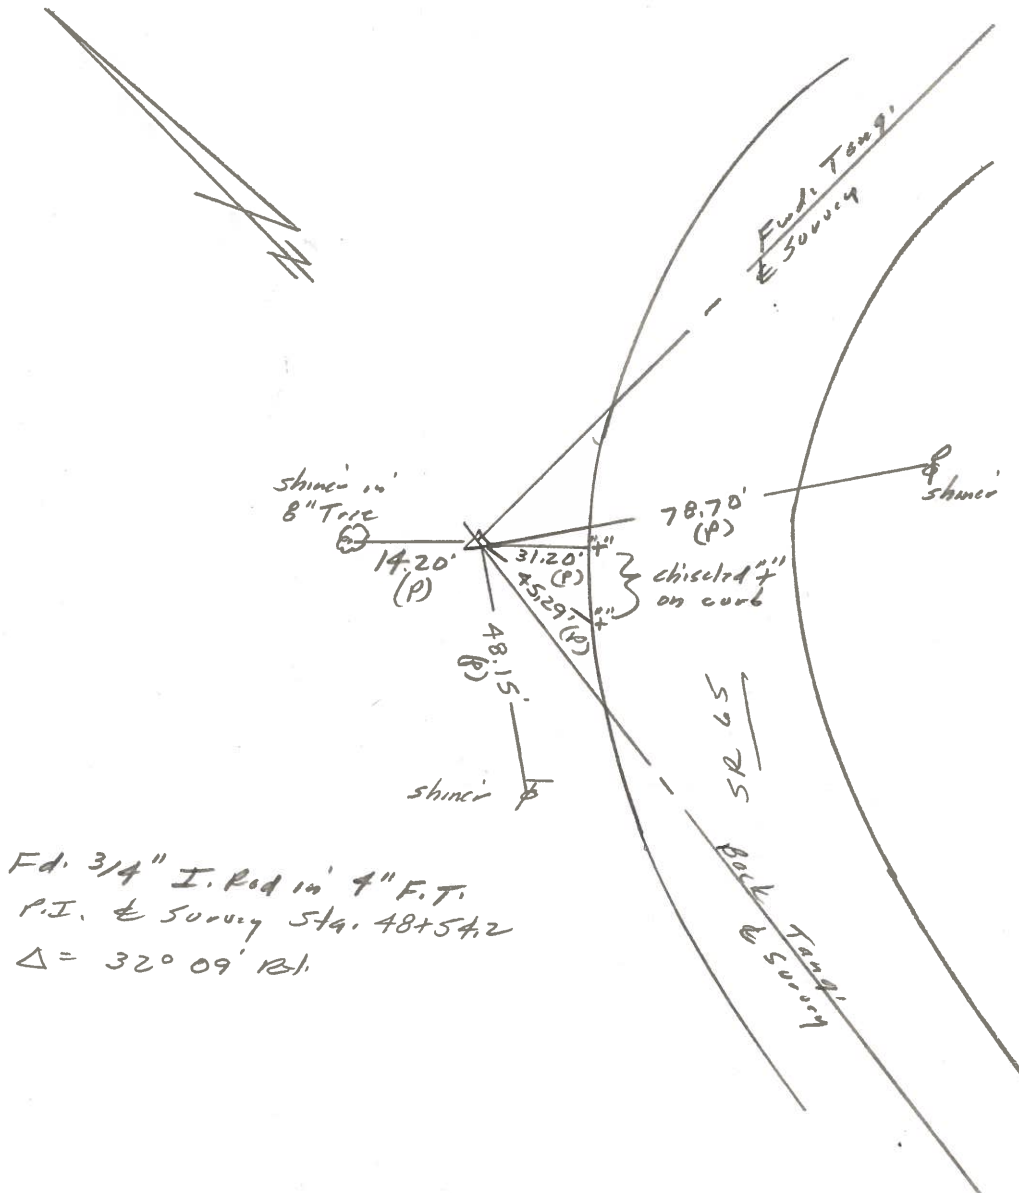

PERSONNEL	TITLE	PERSONNEL	TITLE
BURNSIDE			
SMITH			
BOWERS			

COUNTY WOOD DATE 5-22-72

S. R. 65 WEATHER CLEAR

SEC. C.(PT) TEMP. + 80°

DESCRIPTION PERRYSBURG TWP JOB NO. _____

