

O.D.O.T. DISTRICT 2 SURVEY OFFICE (USE ONLY)

PERSONNEL

REFERENCE NO. 30 E

SHEET 7 OF 23

NOTES BARRIERE

DATE 7/1/24

ROUTE SR 65

H.C. MILLER

WEATHER SUNNY

COUNTY WOOD

R.C. BLUBAUGH

TEMP. 74°

TOWNSHIP PERRYSBURG

DWG BY BARRIERE

PID 101291

SECTION 69

T 3 N R 12 MI RESERVE

TYPE MONUMENT MAG/WASHER

ON SURFACE - BELOW ON

OFFSET $\varnothing$ PAVEMENT 7.1' LT LT : RT

TO EDGE PAVEMENT

STATION: 1066+22

HORIZ.DATUM: NAD83 (2011)


GEOID: 18

GRID: NORTHING: 697801.237


EASTING: 1666843.670

LDP: NORTHING: 519831.704

EASTING: 177026.634

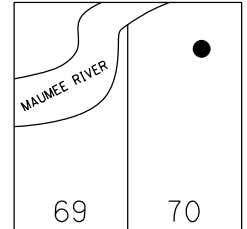

RECORD:
SET MAG/WASHER
10/28/05, SAH
FD MAG/WASHER
REFE30
12/16/19, JFO
FD MAG/WASHER
REF30E
5/8/23, TDN
10/12/23, TDN
FD MAG/WASH
REF30E
7/1/24, JAM

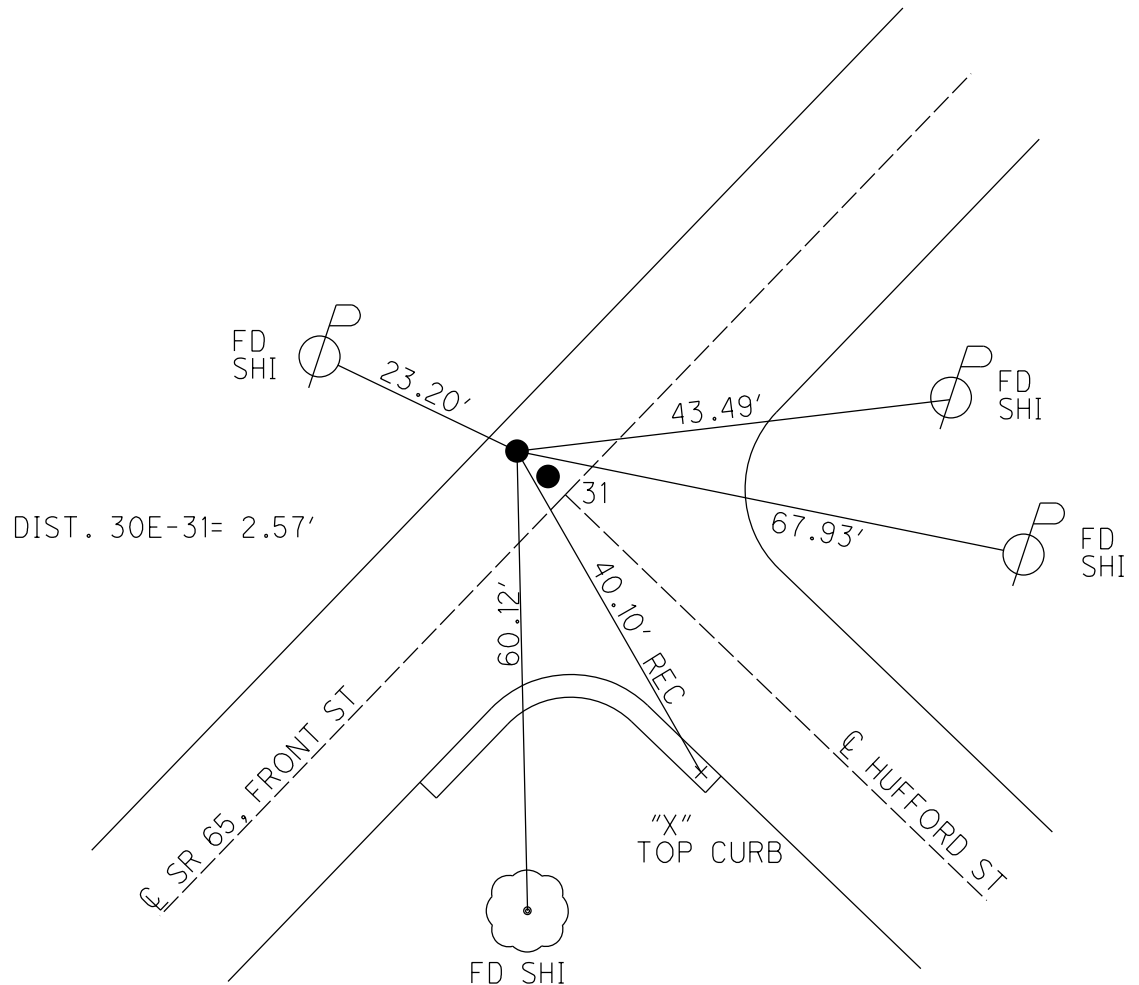

O.D.O.T. DISTRICT 2 SURVEY OFFICE (USE ONLY)

PERSONNEL

REFERENCE NO. 30 E

SHEET 5 OF 21

NOTES AUBLE

DATE 5/8/23

ROUTE SR 65

H.C. NIESE

WEATHER CLOUDY

COUNTY WOOD

R.C. AUBLE

TEMP. 55°

TOWNSHIP PERRYSBURG

SECTION RT 70

DWG BY RHOADES

PID PAVING TRAIN

T 3 12 MILE RESERVE

TYPE MONUMENT MAG/WASHER

ON SURFACE - ~~BELOW~~ ON

OFFSET CL PAVEMENT 7.1' LT : ~~RT~~

4.8' TO LT EDGE PAVEMENT


STATION: 1066+22

HORZ.DATUM: NAD83 2011

GEOID: NAVD88 2018


GRID: NORTHING: 697801.237

EASTING: 1666843.670

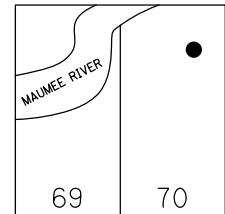

RECORD:
SET MAG/WASHER
10/28/05, SAH
FD MAG/WASHER
REFE30
12/16/19, JFO
FD MAG/WASHER
REF30E
5/8/23, TDN
10/12/23, TDN

WOOD LPD:
N: 519831.728
E: 177026.605

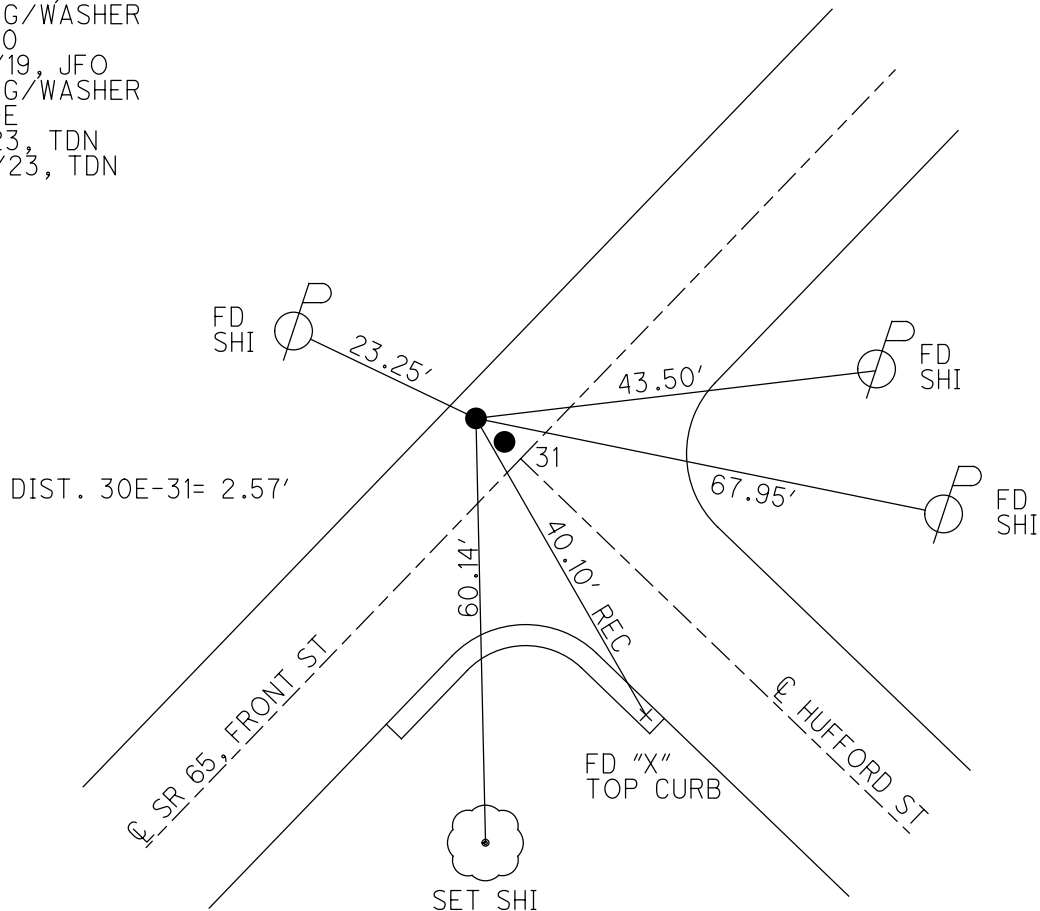

O.D.O.T. DISTRICT 2 SURVEY OFFICE (USE ONLY)

PERSONNEL

REFERENCE NO. 30 E

SHEET 5 OF 8

NOTES HUSS

DATE 9/13/05

ROUTE SR 65

H.C. HOMAN

WEATHER SUNNY

COUNTY WOOD

R.C. MIKLOVIC

TEMP. 80°

TOWNSHIP PERRYSBURG

SECTION RT 70

DWG BY NIESE

PID -

T 3 12 MILE RESERVE

TYPE MONUMENT P.K.NAIL

ON SURFACE - ~~BELOW~~ ON

OFFSET Q PAVEMENT 7.1' LT : ~~RT~~

4.8' TO LT EDGE PAVEMENT


STATION: 1066+22

HORIZ.DATUM: NAD83(2011)


GEOID: 2012A

GRID: NORTHING: 697801.253

EASTING: 1666843.673

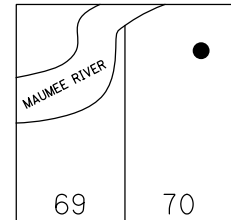

RECORD:
SET MAG/WASHER
10/28/05, SAH
FD MAG/WASHER
REFE30
12/16/19, JFO

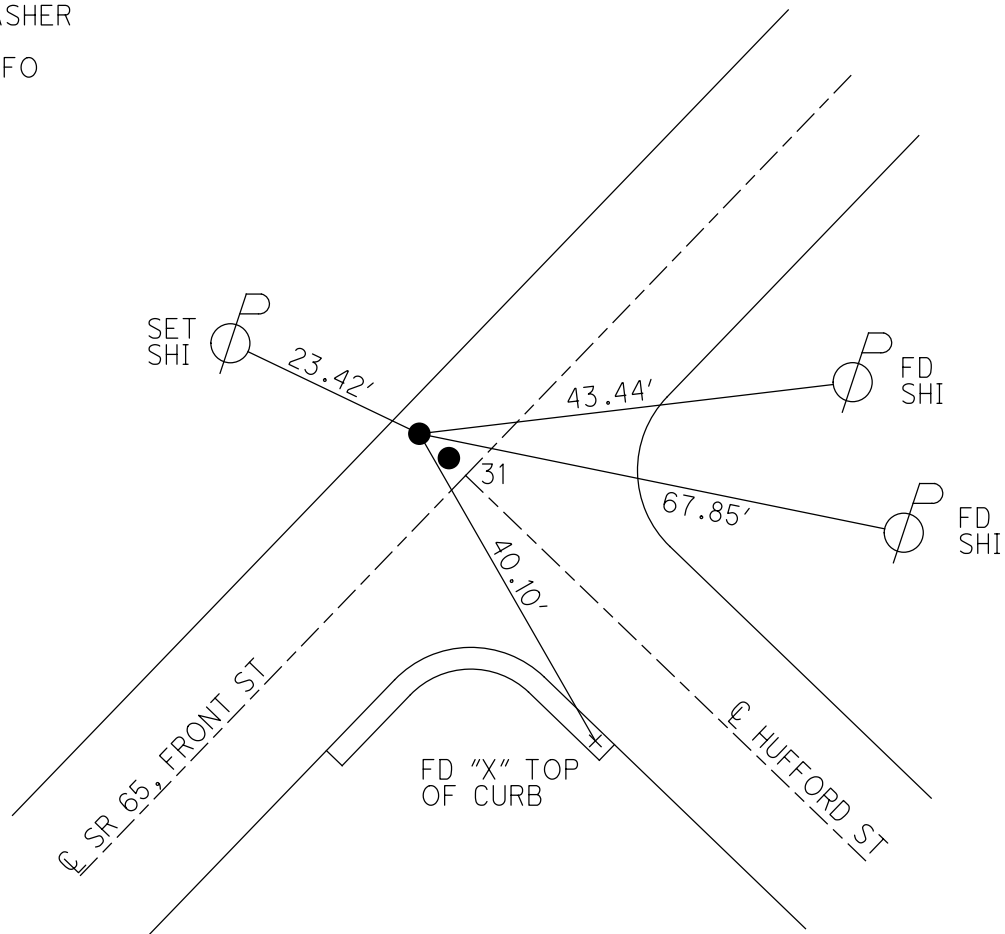

O.D.O.T. DISTRICT 2 SURVEY OFFICE

PERSONNEL

REFERENCE NO. 31

SHEET 7 OF 14

NOTES

HUSS

DATE 9-13-05

ROUTE S.R. 65

H.C.

HOMAN

WEATHER SUNNY

COUNTY WOOD

R.C.

MIKLOVIC

TEMP. 80°

TOWNSHIP PERRYSBURG

SECTION RIVER TRACT

T 7 N R 11 E

town 3, 12 mile Res.

TYPE MONUMENT

PK NAILS

ON SURFACE - ~~BELOW~~

ON

LEFT - ~~C PAVT~~ - RIGHT


A 7.1' B 4.6'

A 4.8'
B 7.4'


TO LT EDGE PAVEMENT

S.L.M.

1066+22

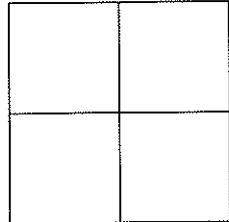

SET MAG NAILS
& WASHERS
10-28-05
SAH

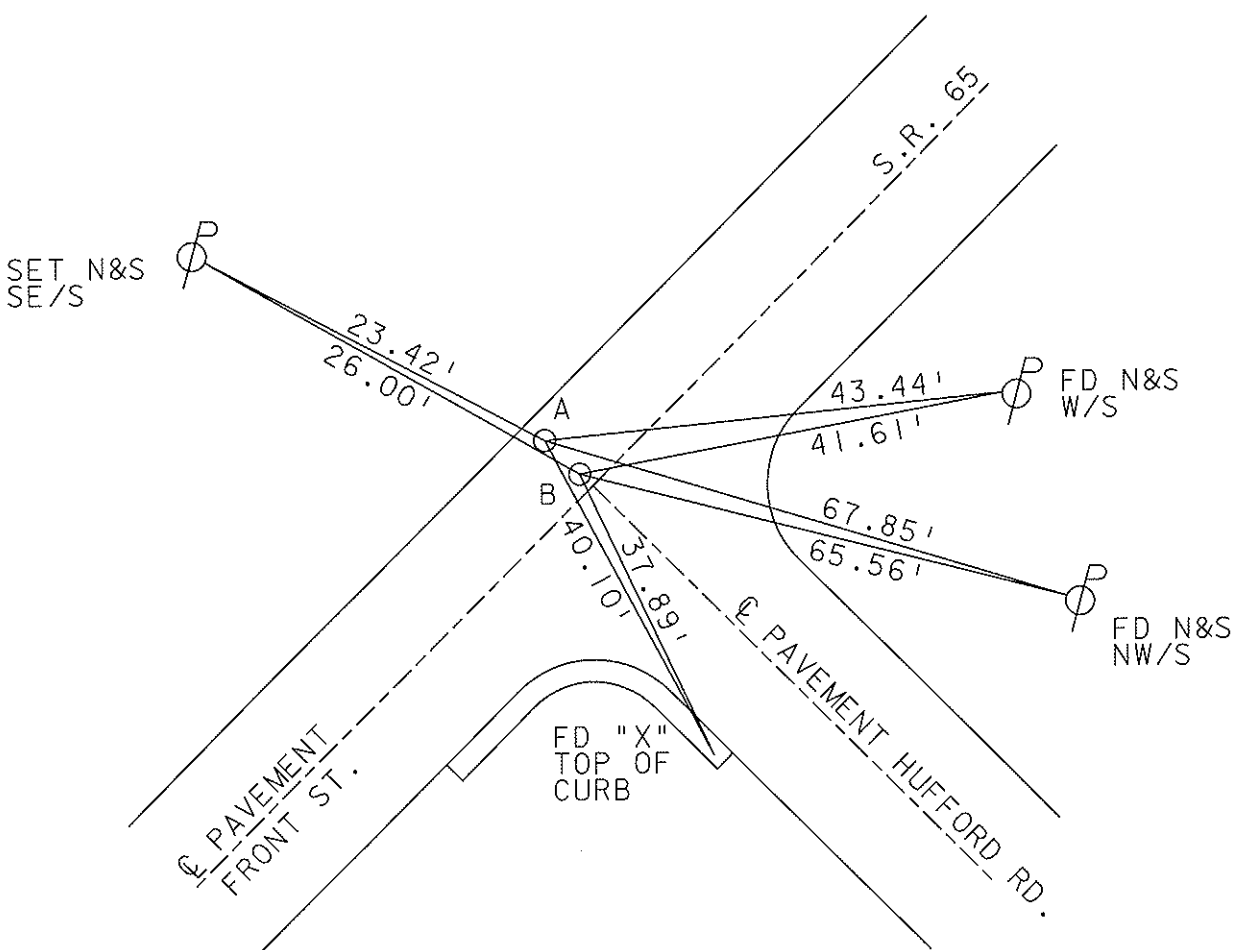

O.D.O.T. DISTRICT 2 SURVEY OFFICE

PERSONNEL

REFERENCE NO. 31

SHEET OF

NOTES BARNHISEL

H.C. Reed

R.C. Loehrke

HOFFMAN

DATE 5-3-88

WEATHER Partly Cloudy

TEMP. +55°

ROUTE 65

COUNTY Wood

TOWNSHIP Perrysburg

SECTION Rice Tract 70

T 7 N R 11 E


TYPE MONUMENT P.K. Nails

ON SURFACE - BELOW yes

LEFT - C PAV'T. - RIGHT 5.2 - 2.60 Between


8.2 TO Lt EDGE PAVEMENT

S.L.M. 1066 + 22

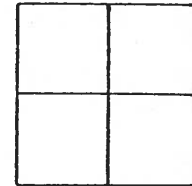

Pt. A.
Pt. B.

Set P.K.'s & washers
8-26-88
m.B.

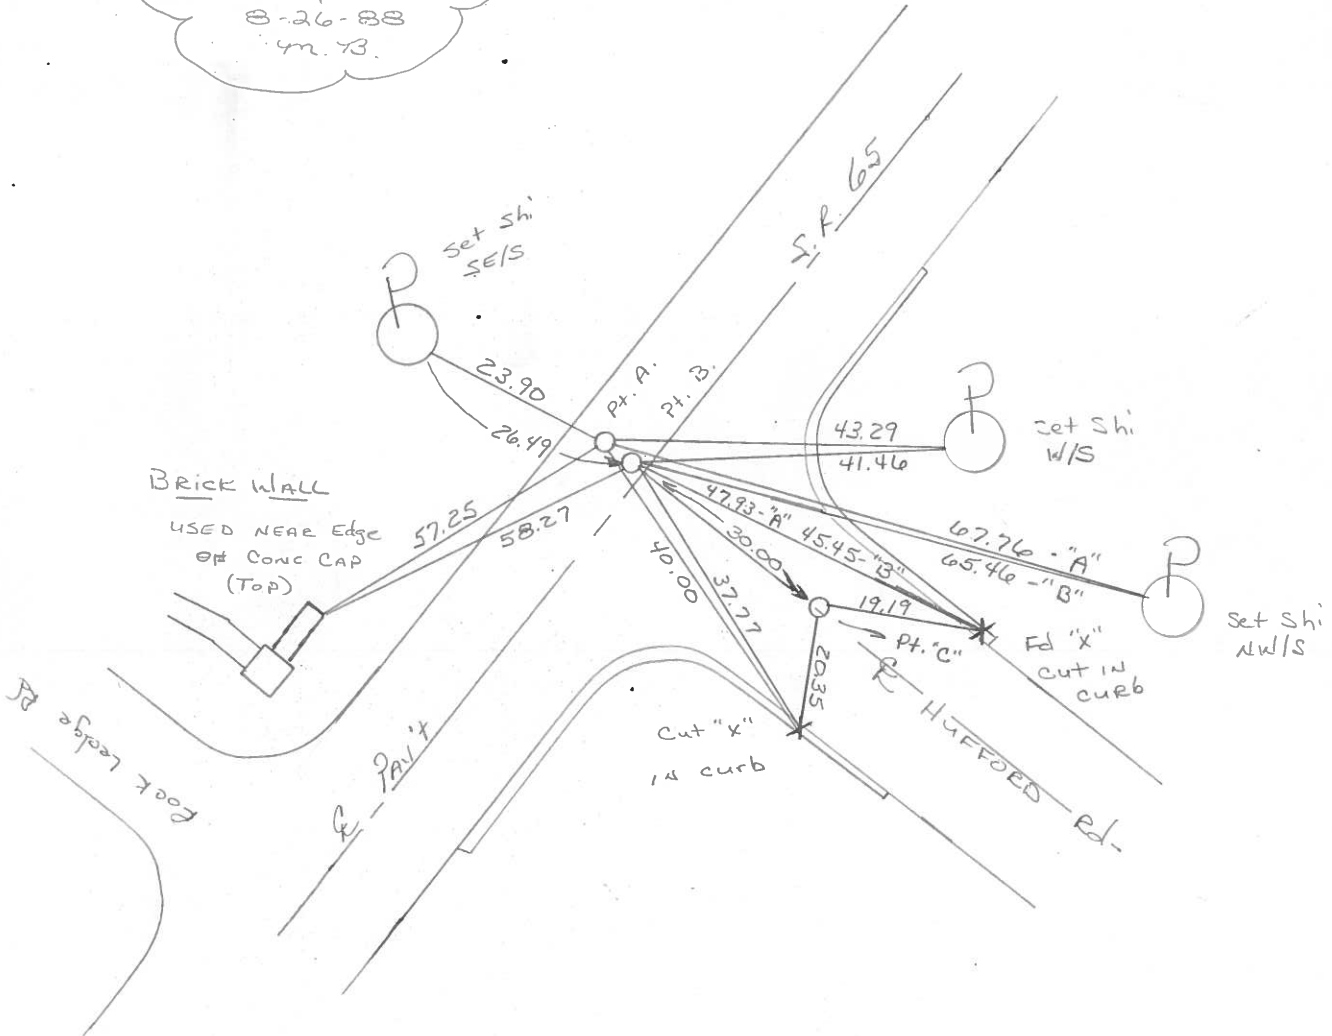

9-13-05

DID NOT FIND or
Reset "C"

O.D.O.T. DISTRICT 2 SURVEY OFFICE

SHEET

OF

County Wood S.R. 65

Township _____

Section _____

T N, R E

Personnel J. Stone

P. Neuser

E. Michalek


D. Curtis

H. Mead


Date 13 Nov. 80

Weather Cloudy

Temp. 50°

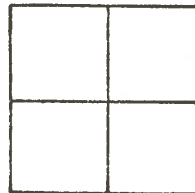

REF. NO. 31

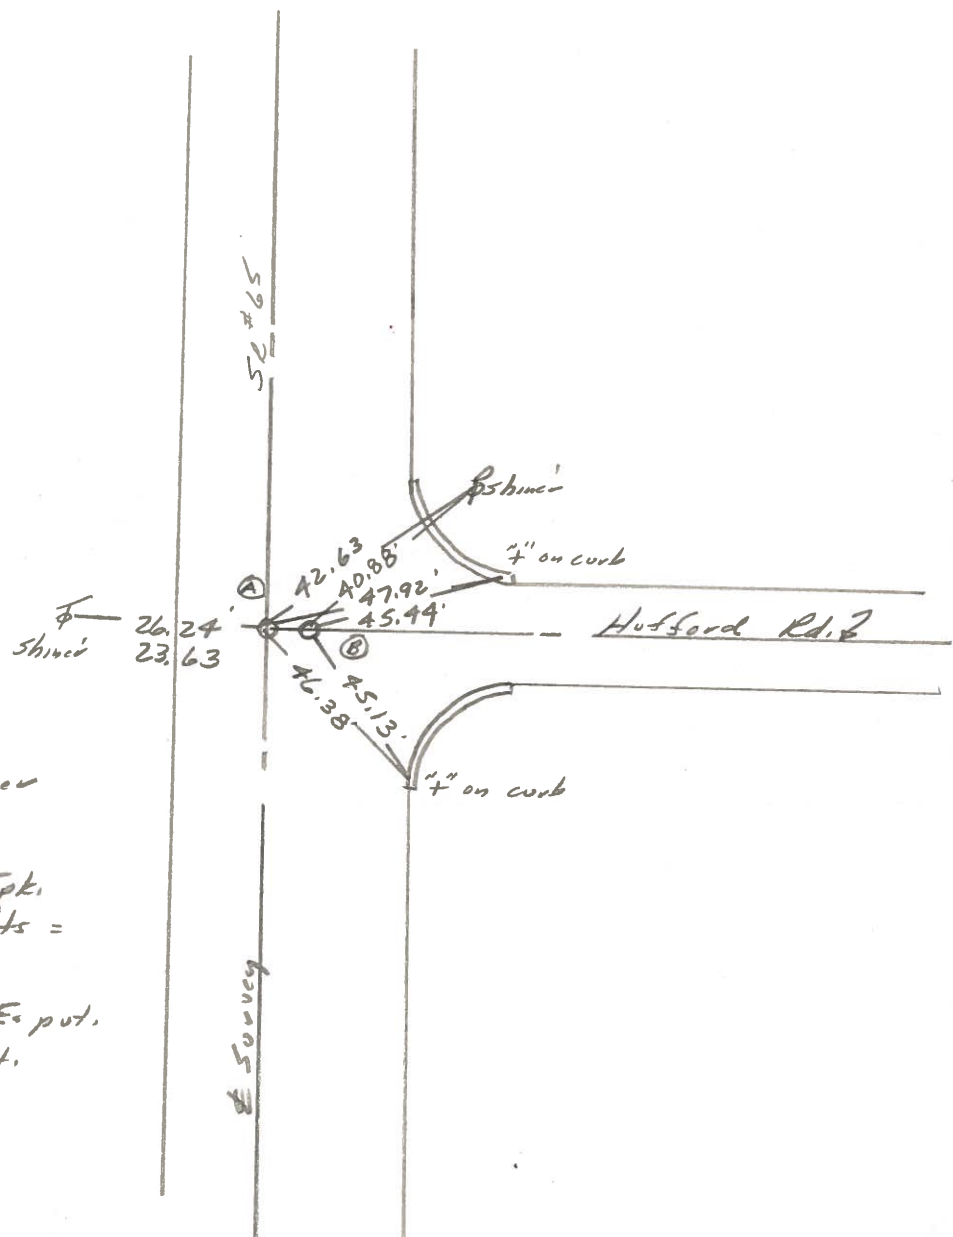

Set PK Nails as per
1978 Refs.

400 ± S. of Ohio Tpk.
distance between points =
2.60'

Splits A = 8.2' to N.E. put.

B = 10.7' to N.E. put.

O.D.O.T. DISTRICT 2 SURVEY OFFICE

Sht. 14 of 20
S.R. 65

County WOOD

Date 7-31-78

Township PERRYSBURG


Weather CLEAR

Section 1

Temp. +75°

T N, R E

Personnel BURNSIDE

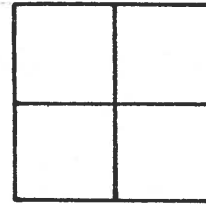

SMITH

BOWERS


KNAPE

MEAD

31



FD P.K. NAILS
@ SURFACE

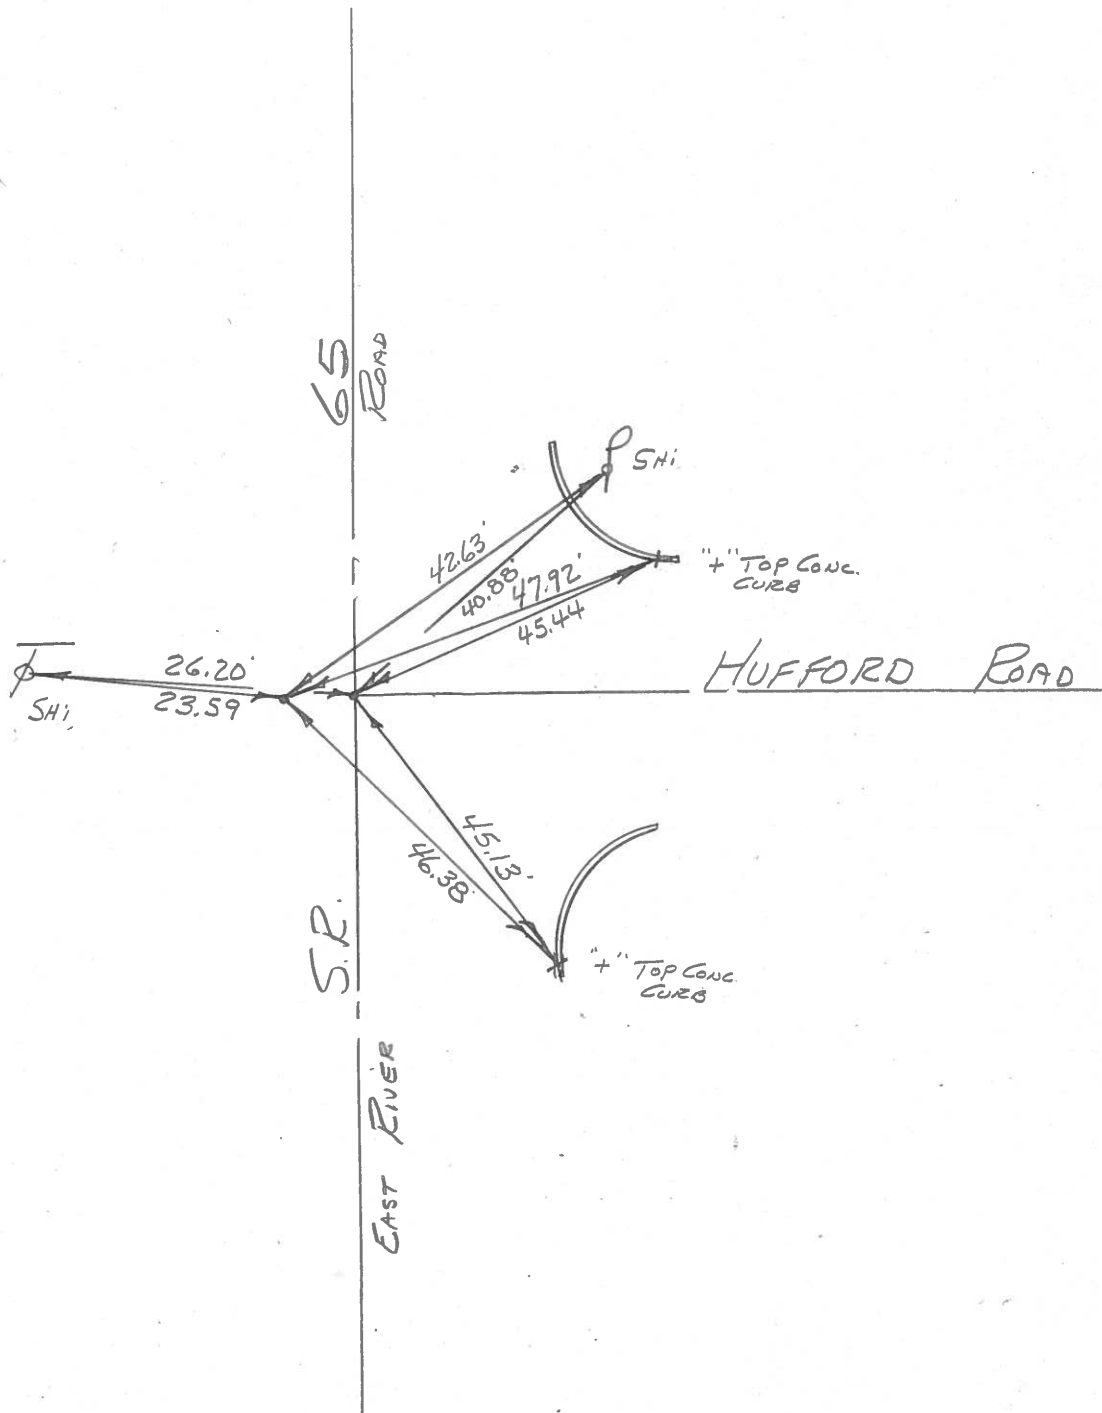


PERSONNEL	TITLE	PERSONNEL	TITLE
Granata			
Neuser			
Vanyo			
Jackson			

COUNTY Wood DATE Aug. 16, 1971S. R. #65 WEATHER FairSEC. PERRYSBURG TWP TEMP. 80'sDESCRIPTION Reference Mon. on S.R. #65 JOB NO. _____

LEFT


CENTER LINE

RIGHT

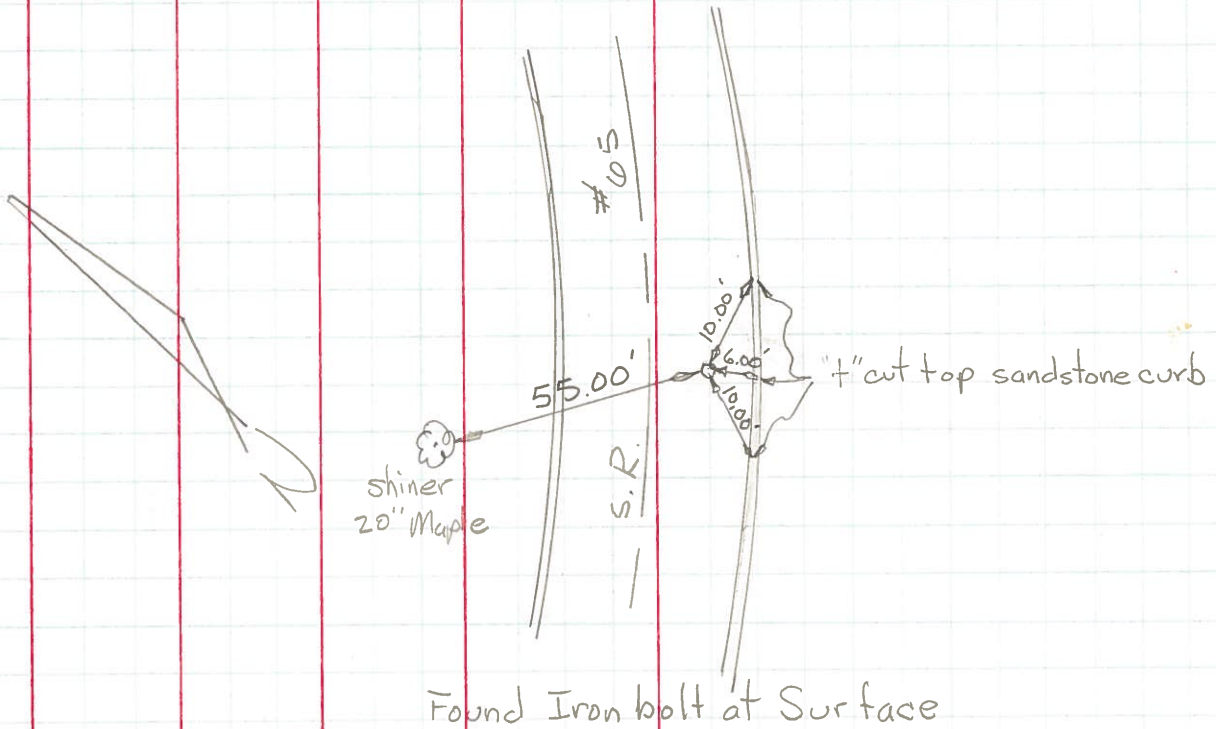

Found Iron bolt at Surface

(31)

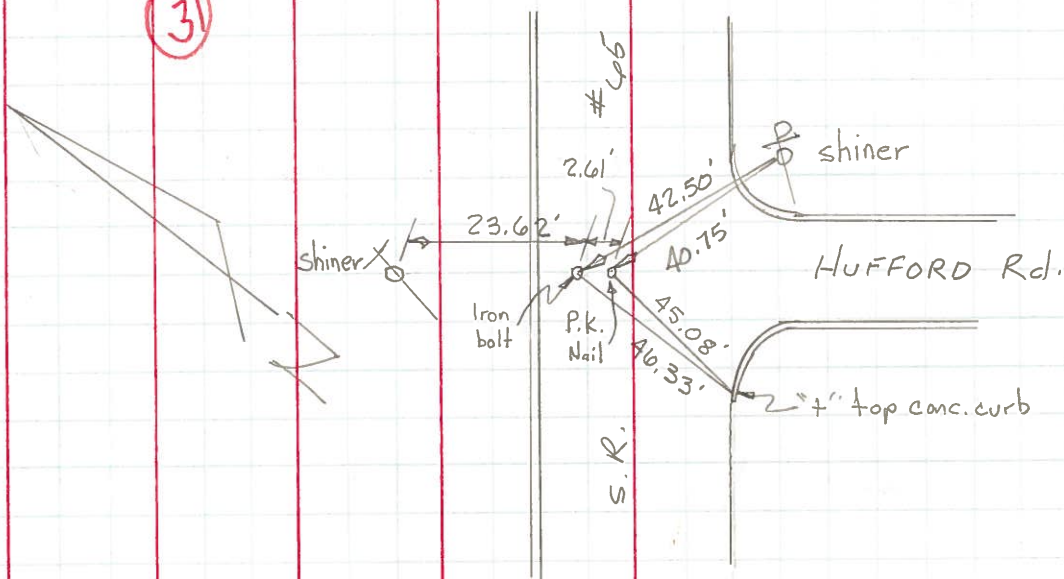Found $\frac{1}{2}$ " Iron bolt & P.K. Nail at Surface.

PERSONNEL	TITLE	PERSONNEL	TITLE
1	2	3	4
5	6	7	8
9	10	11	12
13	14	15	16
17	18	19	20
21	22	23	24
25	26	27	28
29	30	31	32
33	34	35	36
37	38	39	40
41	42	43	44
45	46	47	48
49	50	51	52
53	54	55	56
57	58	59	60
61	62	63	64
65	66	67	68
69	70	71	72
73	74	75	76
77	78	79	80
81	82	83	84
85	86	87	88
89	90	91	92
93	94	95	96
97	98	99	100

COUNTY Wood DATE _____

S. R. 65 WEATHER

SEC. _____ TEMP. _____

[illegible]

LEFT

CENTER LINE

RIGHT

JOB NO.

Use Δ_{Hess} for True Cn.

2. 15" East of Iron Bolt $3\frac{1}{2}$ " below Surface 2056

Repl. 2.2 Spk
8-29-01

Stone Cor.
Rest.

30

mon. Box.

Replaced P.M.
8-24-65

Sh. 12' 4" cor.

Fd. P.K.

[illegible]

31

P. 24.28
shi.

£ HUFFORD ST.

Car. Brick
Fence 1' above
Ground

Shi. 16 Elm

'X' Curved & Pt
Pier Column

24.65
24.70

4 OHIO TURNPIKE

Fd. Ak.

P.K. 0.20 West.

31-A

X Cut on Face
Pier Collar