

# O.D.O.T. DISTRICT 2 SURVEY OFFICE (USE ONLY)

PERSONNEL

REFERENCE NO. 31

SHEET 8 OF 23

NOTES BARRIERE

DATE 7/1/24

ROUTE SR 65

H.C. MILLER

WEATHER SUNNY

COUNTY WOOD

R.C. BLUBAUGH

TEMP. 74°

TOWNSHIP PERRYSBURG

DWG BY BARRIERE

PID 101291

SECTION 70

T 3 N R 12 MI RESERVE

TYPE MONUMENT MAG/WASHER

ON SURFACE - BELOW ON

OFFSET  $\varnothing$  PAVEMENT 4.6' LT LT : RT

TO EDGE PAVEMENT

STATION: 1066+22

HORZ.DATUM: NAD83 (2011)


GEOID: 18

GRID: NORTHING: 697799.288


EASTING: 1666845.401

LDP: NORTHING: 519829.847

EASTING: 177028.355

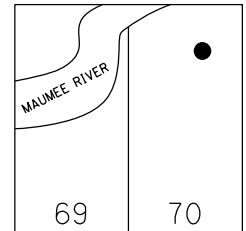

RECORD:  
 SET MAG/WASHER  
 10/28/05, SAH  
 FD MAG/WASHER  
 REF 31  
 12/16/19, JFO  
 FD MAG/WASHER  
 REF 31  
 5-8-23, TDN  
 10/12/23, TDN  
 FD MAG/WASH  
 REF 31  
 7/1/24, JAM

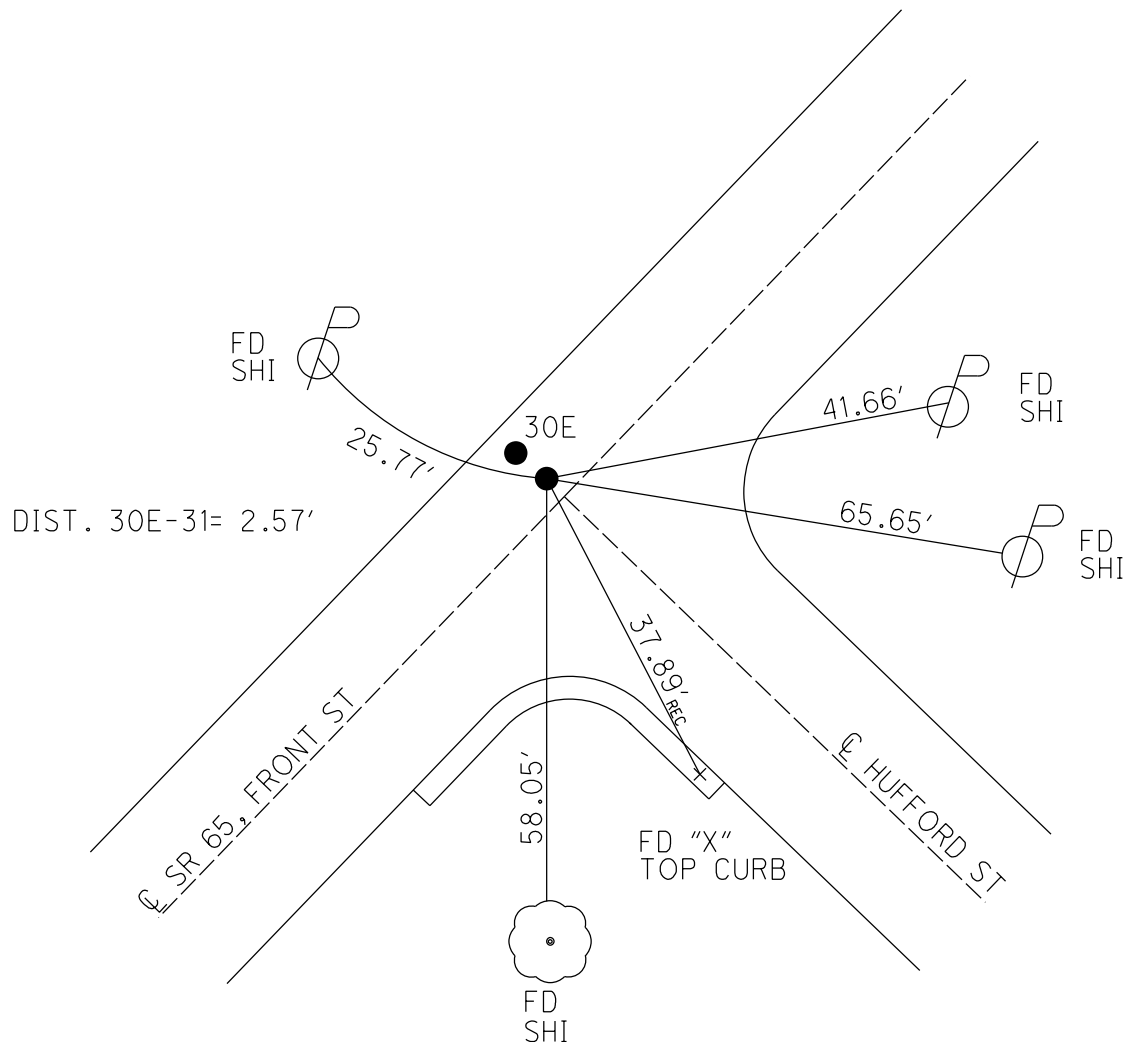

## O.D.O.T. DISTRICT 2 SURVEY OFFICE (USE ONLY)

## PERSONNEL

REFERENCE NO. 31

SHEET 6 OF 21

NOTES AUBLE

DATE 5/8/23

ROUTE SR 65

H.C. NIESE

WEATHER CLOUDY

COUNTY WOOD

R.C. AUBLE

TEMP. 55°

TOWNSHIP PERRYSBURGSECTION RT 70

T\_3      12 MILE RESERVE

DWG BY RHOADESPID PAVING TRAIN

TYPE MONUMENT MAG/WASHER

ON SURFACE - ~~BELOW~~ ON

OFFSET C PAVEMENT 4.6' LT : RT


7.4' TO LT EDGE PAVEMENT

STATION: 1066+22

HORZ.DATUM: NAD83 2011


GEOID: NAVD88 2018

GRID: NORTHING: 697799.288

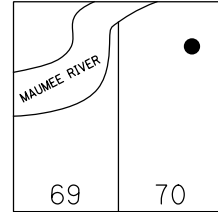EASTING: 1666845.401

RECORD:  
SET MAG/WASHER  
10/28/05, SAH  
FD MAG/WASHER  
REF31  
12/16/19, JFO  
FD MAG/WASHER  
REF 31  
5-8-23, TDN  
10/12/23, TDN

WOOD LPD:  
N: 519829.802  
E: 177028.361

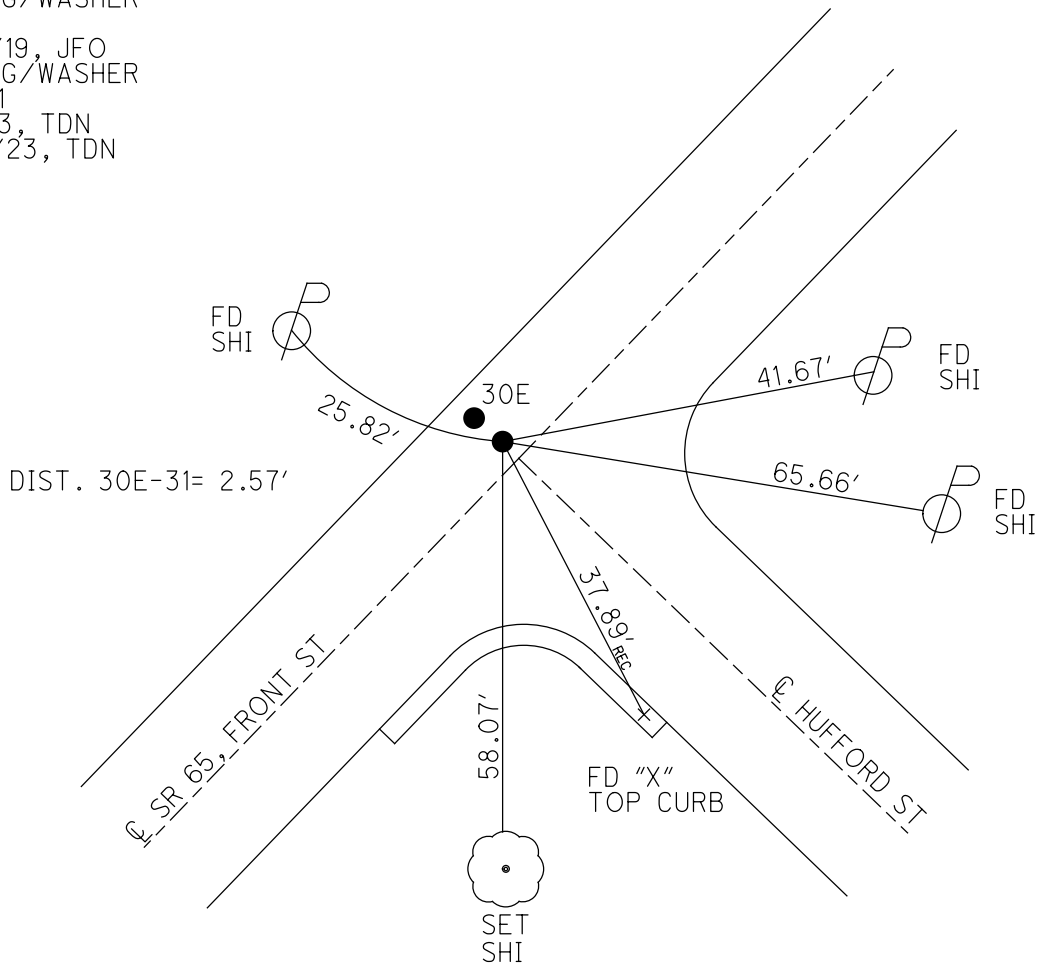

O.D.O.T. DISTRICT 2 SURVEY OFFICE (USE ONLY)

PERSONNEL

REFERENCE NO. 31

SHEET 6 OF 8

NOTES HUSS

DATE 9/13/05

ROUTE SR 65

H.C. HOMAN

WEATHER SUNNY

COUNTY WOOD

R.C. MIKLOVIC

TEMP. 80°

TOWNSHIP PERRYSBURG

SECTION RT 70

DWG BY NIESE PID -

T 3 12 MILE RESERVE

TYPE MONUMENT P.K.NAIL

ON SURFACE - ~~BELOW~~ ON

OFFSET CL PAVEMENT 4.6' LT : ~~RT~~

7.4' TO LT EDGE PAVEMENT


STATION: 1066+22

HORZ.DATUM: NAD83(2011)


GEOID: 2012A

GRID: NORTHING: 697799.337

EASTING: 1666845.371

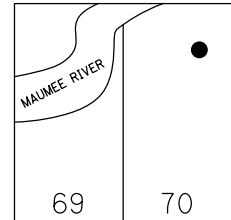

RECORD:  
SET MAG/WASHER  
10/28/05, SAH  
FD MAG/WASHER  
REF31  
12/16/19, JFO

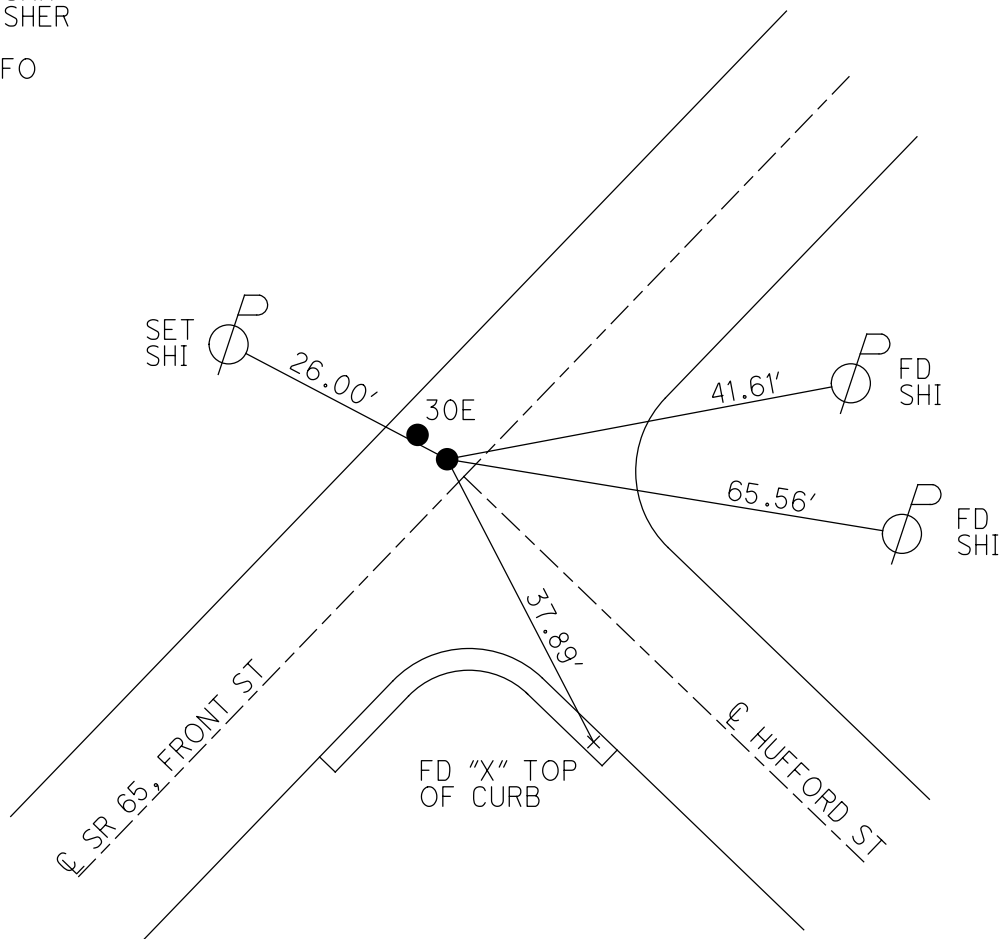

O.D.O.T. DISTRICT 2 SURVEY OFFICE

PERSONNEL

REFERENCE NO. 31

SHEET 7 OF 14

NOTES

HUSS

DATE 9-13-05

ROUTE S.R. 65

H.C.

HOMAN

WEATHER SUNNY

COUNTY WOOD

R.C.

MIKLOVIC

TEMP. 80°

TOWNSHIP PERRYSBURG

SECTION RIVER TRACT

T 7 N R 11 E

town 3, 12 mile Res.

TYPE MONUMENT

PK NAILS

ON SURFACE - ~~BELOW~~

ON

LEFT - ~~C PAVT~~ - RIGHT


A 7.1' B 4.6'

A 4.8'  
B 7.4'


TO LT EDGE PAVEMENT

S.L.M.

1066+22

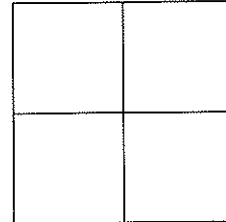

SET MAG NAILS  
& WASHERS  
10-28-05  
SAH

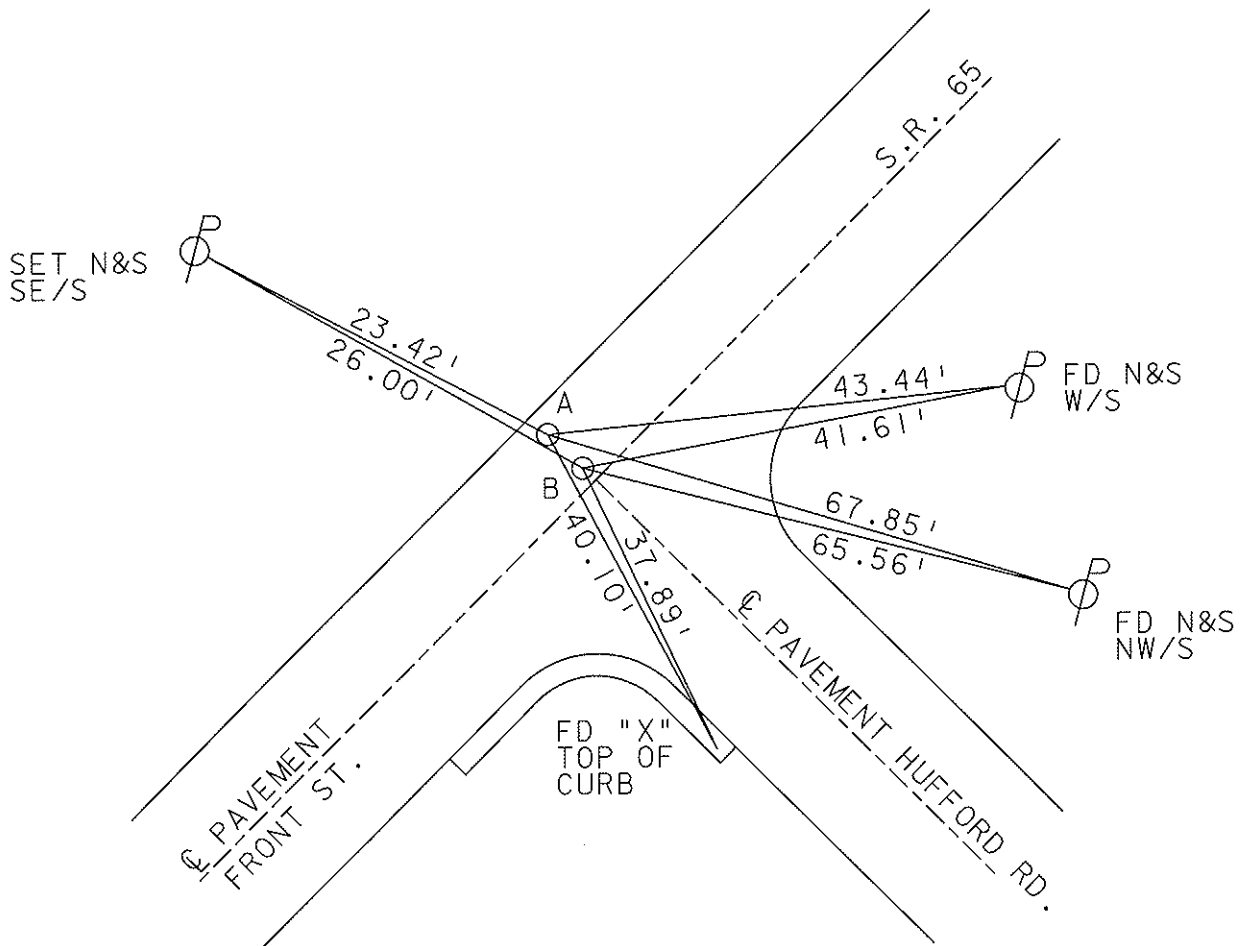

# O.D.O.T. DISTRICT 2 SURVEY OFFICE

PERSONNEL

REFERENCE NO. 31

SHEET      OF     

NOTES BARNHISEL

H.C. Reed

R.C. Loehrke

HOFFMAN

DATE 5-3-88

WEATHER Partly Cloudy

TEMP. +55°

ROUTE 65

COUNTY Wood

TOWNSHIP Perryburg

SECTION Rice Tract 70

T 7 N R 11 E


TYPE MONUMENT P.K. Nails

ON SURFACE - BELOW yes

LEFT - C PAV'T. - RIGHT 5.2 - 2.60 Between


8.2 TO Lt EDGE PAVEMENT

S.L.M. 1066 + 22

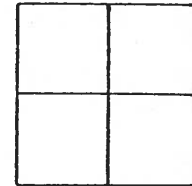

Pt. A.  
Pt. B.

Set P.K.'s & washers  
8-26-88  
m.B.

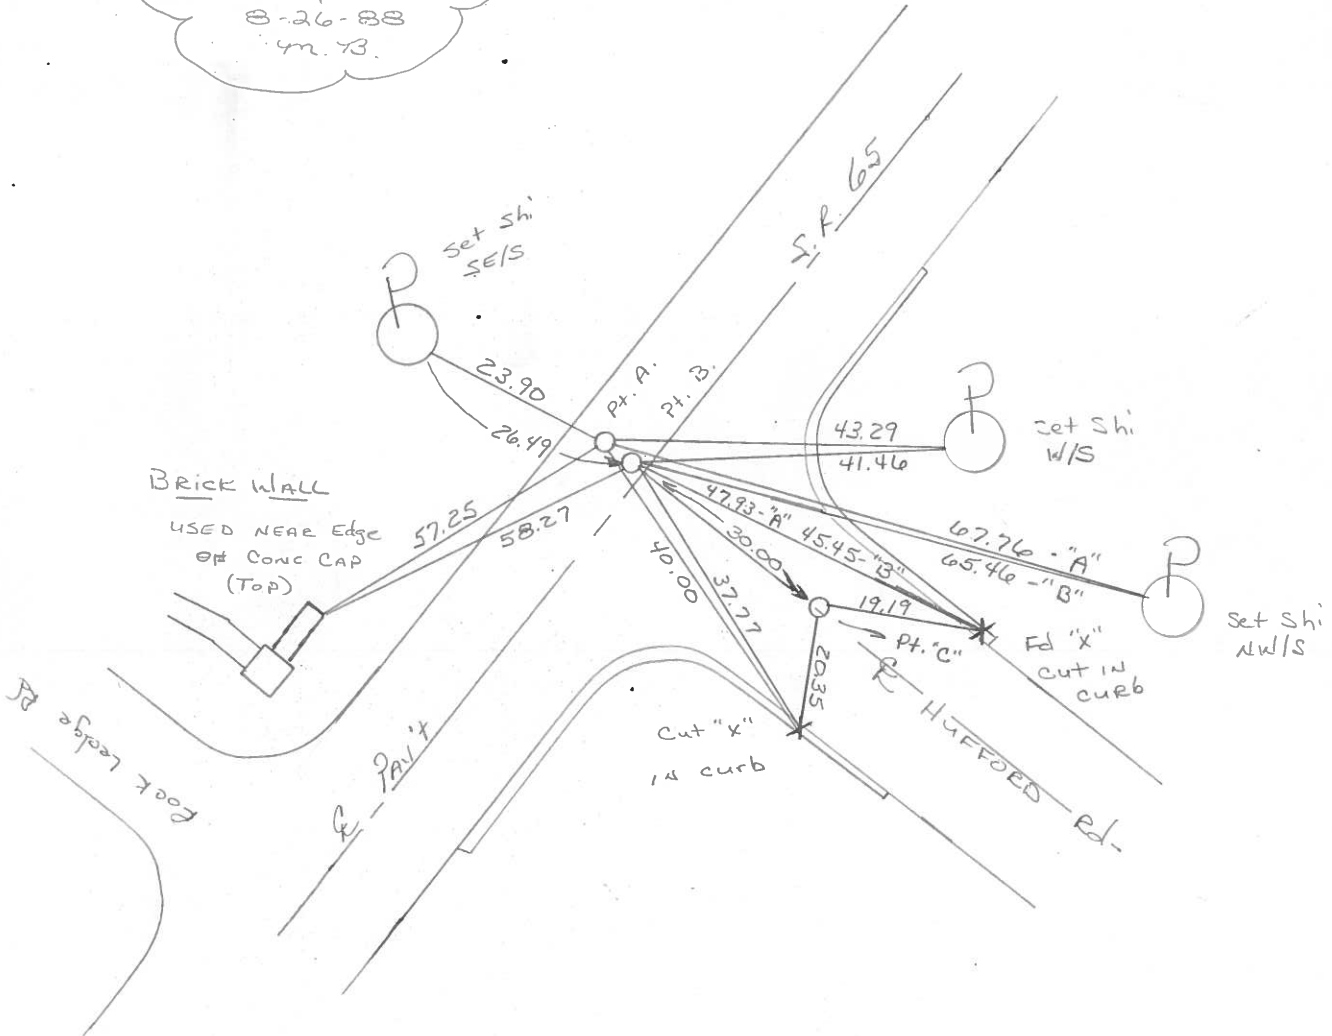

9-13-05

DID NOT FIND or  
Reset "C"

# O.D.O.T. DISTRICT 2 SURVEY OFFICE

SHEET

OF

County Wood S.R. 65

Township \_\_\_\_\_

Section \_\_\_\_\_

T N, R E

Personnel J. Stone

P. Neuser

E. Michalek


D. Curtis

H. Mead


Date 13 Nov. 80

Weather Cloudy

Temp. 50°

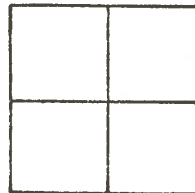

REF. NO. 31

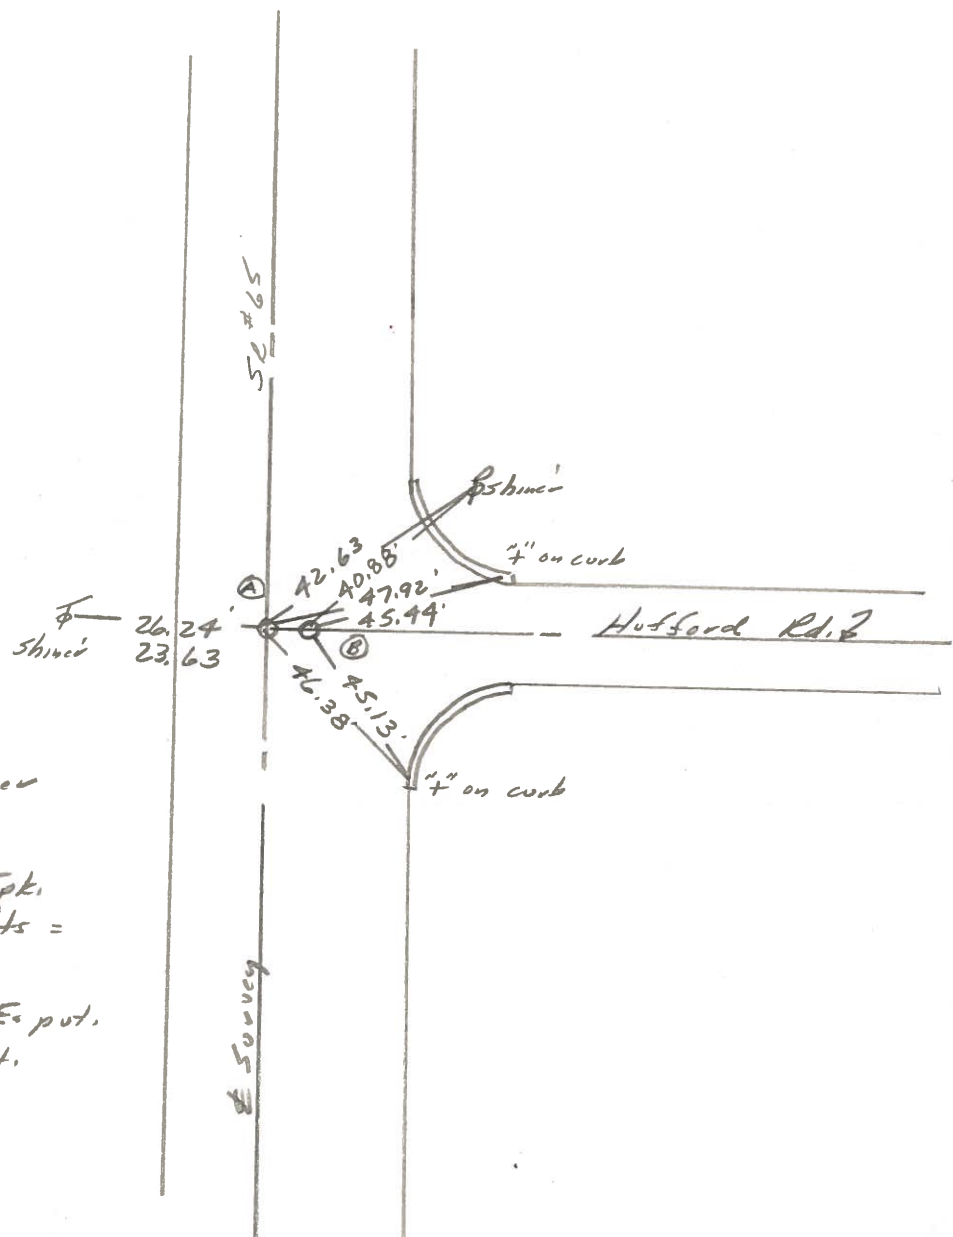

Set PK Nails as per  
1978 Refs.

400 ± S. of Ohio Tpk.  
distance between points =  
2.60'

Splits A = 8.2' to N.E. put.  
B = 10.7' to N.E. put.

# O.D.O.T. DISTRICT 2 SURVEY OFFICE

Sht. 14 of 20  
S.R. 65

County WOOD

Date 7-31-78

Township PERRYSBURG


Weather CLEAR

Section 1

Temp. +75°

T N, R E

Personnel BURNSIDE

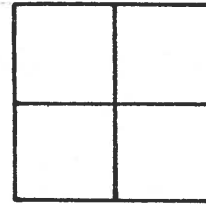

SMITH

BOWERS


KNAPE

MEAD

# 31



FD P.K. NAILS  
@ SURFACE

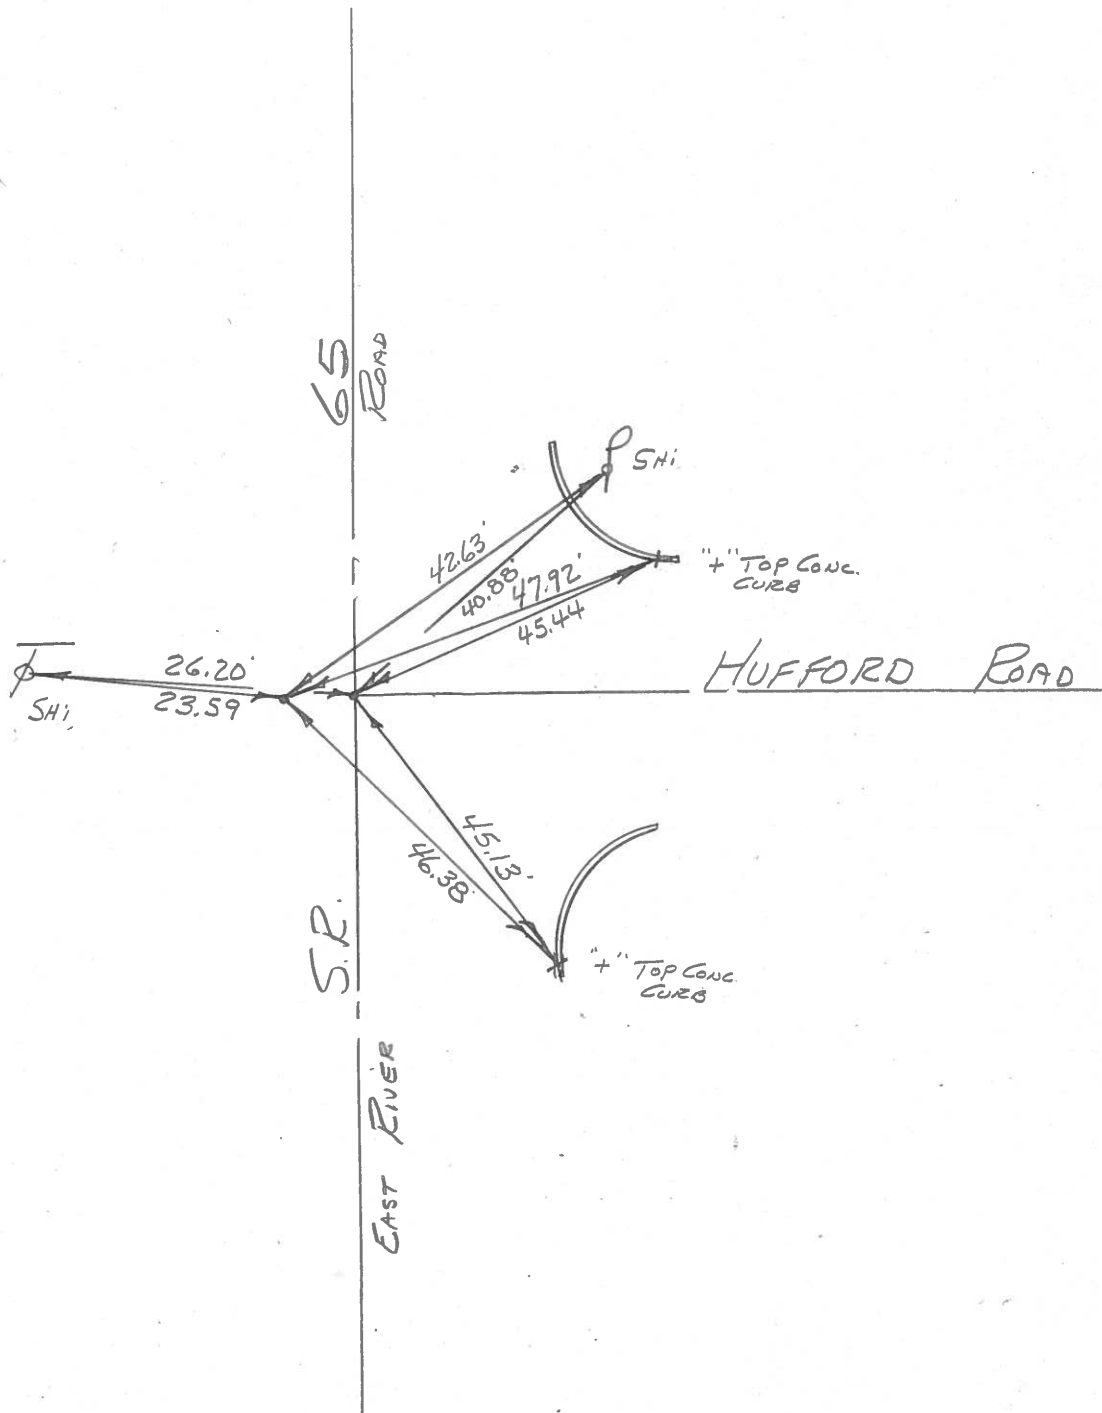

| PERSONNEL | TITLE | PERSONNEL | TITLE |
|-----------|-------|-----------|-------|
| Granata   |       |           |       |
| Neuser    |       |           |       |
| Vanyo     |       |           |       |
| Jackson   |       |           |       |

COUNTY Wood DATE Aug. 16, 1971

S. R. #65 WEATHER Fair


SEC. PERRYSBURG TWP TEMP. 80's

DESCRIPTION Reference Mon. on S.R. #65 JOB NO. \_\_\_\_\_

LEFT


CENTER LINE

RIGHT

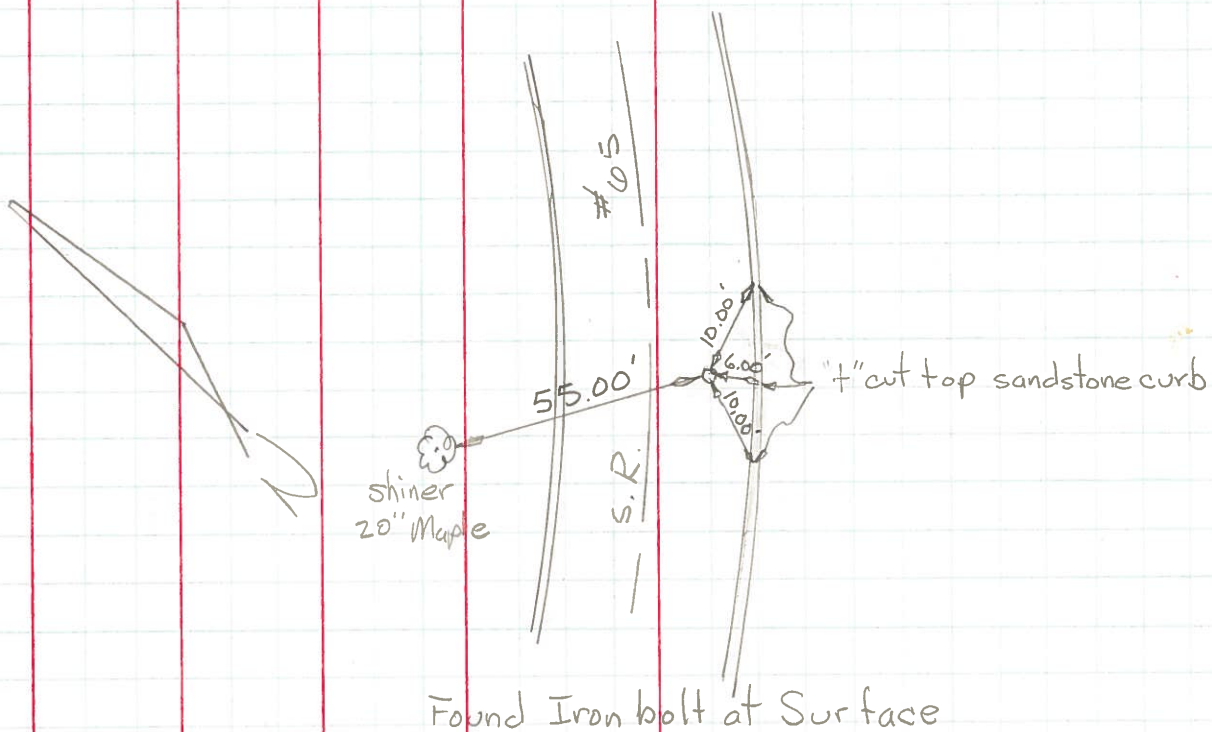

Found Iron bolt at Surface

(31)

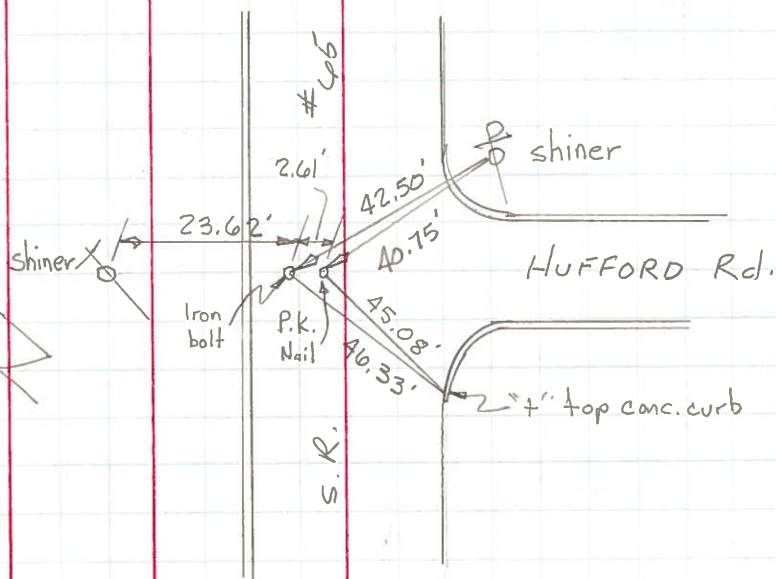

Found  $\frac{1}{2}$ " Iron bolt & P.K. Nail at Surface.

| PERSONNEL | TITLE | PERSONNEL | TITLE |
|-----------|-------|-----------|-------|
|-----------|-------|-----------|-------|

COUNTY Wood DATE \_\_\_\_\_

S. R. 65 WEATHER

SEC. \_\_\_\_\_ TEMP. \_\_\_\_\_

|             |             |         |
|-------------|-------------|---------|
| DESCRIPTION |             | JOB NO. |
| LEFT        | CENTER LINE | RIGHT   |

LEFT

**CENTER LINE**

**RIGHT**

**JOB NO.**

Use  $\Delta_{\text{Hess}}$  for True Cn.

2. 15" East of Iron Bolt  $3\frac{1}{2}$ " below Surface 2056

Repl. 2.2 Spk  
8-29-01

Stone Cor.  
Rest.

(30)

mon. Box.

Replaced P.R.  
5-7-66

Sh. 12.4500 ft.

Fd. P.K.

2. 6. 5. 12.  
5. 2. 5. 5.

31

P 24.28  
Shi.

59.35  
Car. Brick  
Fence 1/2 Ave.  
Ground.

Ed. Ak.

P.K. 0.20 West

31-A

4 OHIO TURNPIKE

X Cut on Face  
Rider Collar