

O.D.O.T. DISTRICT 2 SURVEY OFFICE (USE ONLY)

PERSONNEL

REFERENCE NO. 31 A

SHEET 9 OF 23

NOTES BARRIERE
H.C. MILLER
R.C. BLUBAUGH

DATE 7/1/24
WEATHER SUNNY
TEMP. 74°

ROUTE SR 65
COUNTY WOOD
TOWNSHIP PERRYSBURG
SECTION 70

DWG BY BARRIERE PID 101291

T 3 N R 12 MI RESERVE

TYPE MONUMENT MAG/WASHER

ON SURFACE - BELOW ON

OFFSET ϕ PAVEMENT 7.2' LT LT : RT

TO EDGE PAVEMENT

STATION: 1070+08

HORZ.DATUM: NAD83 (2011)


GEOID: 18

GRID: NORTHING: 698062.320

EASTING: 1667128.321


LDP: NORTHING: 520096.579

EASTING: 177307.750

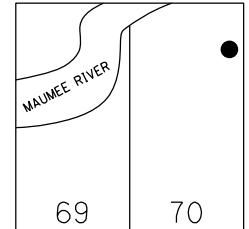

RECORD:
SET MAG/WASHER
10-28-05, SAH
FD MAG/WASHER
REFA31
11-7-2019, JLL
FD MAG/WASHER
5-8-23, TDN
10/12/23, TDN
FD MAG/WASHER
7/10/24, TDN

NOTE: UNDER BRIDGE

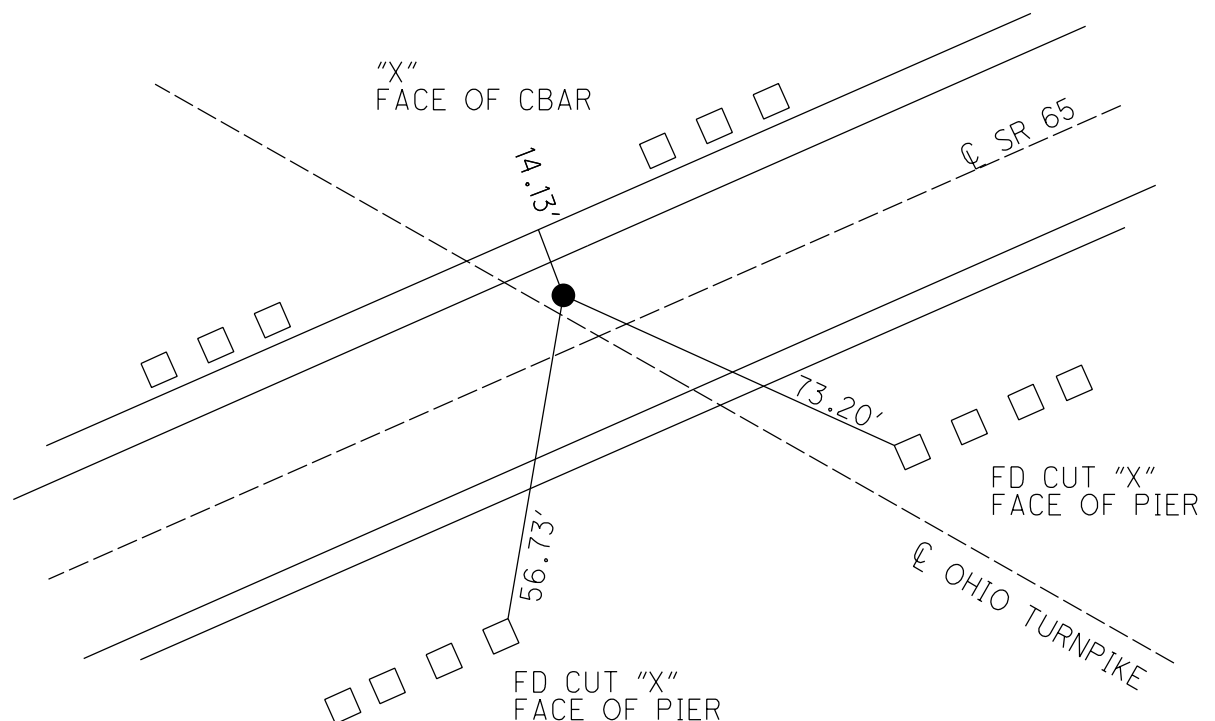

O.D.O.T. DISTRICT 2 SURVEY OFFICE (USE ONLY)

PERSONNEL

REFERENCE NO. 31 A

SHEET 7 OF 21

NOTES AUBLE

DATE 5-8-23

ROUTE SR 65

H.C. NIESE

WEATHER CLOUDY

COUNTY WOOD

R.C. AUBLE

TEMP. 55° F

TOWNSHIP PERRYSBURG

SECTION RT 70

DWG BY AUBLE

PID PAVING TRAIN

T 3 12 MILE RESERVE

TYPE MONUMENT MAG/ WASHER

ON SURFACE - ~~BELOW~~ ON

OFFSET CL PAVEMENT 7.2' LT : RT

4.7' TO LT EDGE PAVEMENT


STATION: 1070+08

HORIZ.DATUM: NAD83 2011

GEOID: NAVD88 2018


GRID: NORTHING: 698062.320

EASTING: 1667128.321

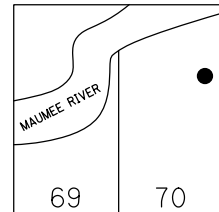

RECORD:
SET MAG/WASHER
10-28-05, SAH
FD MAG/WASHER
REFA31
11-7-2019, JLL
FD MAG/WASHER
5-8-23, TDN
10/12/23, TDN

NOTE: UNDER BRIDGE

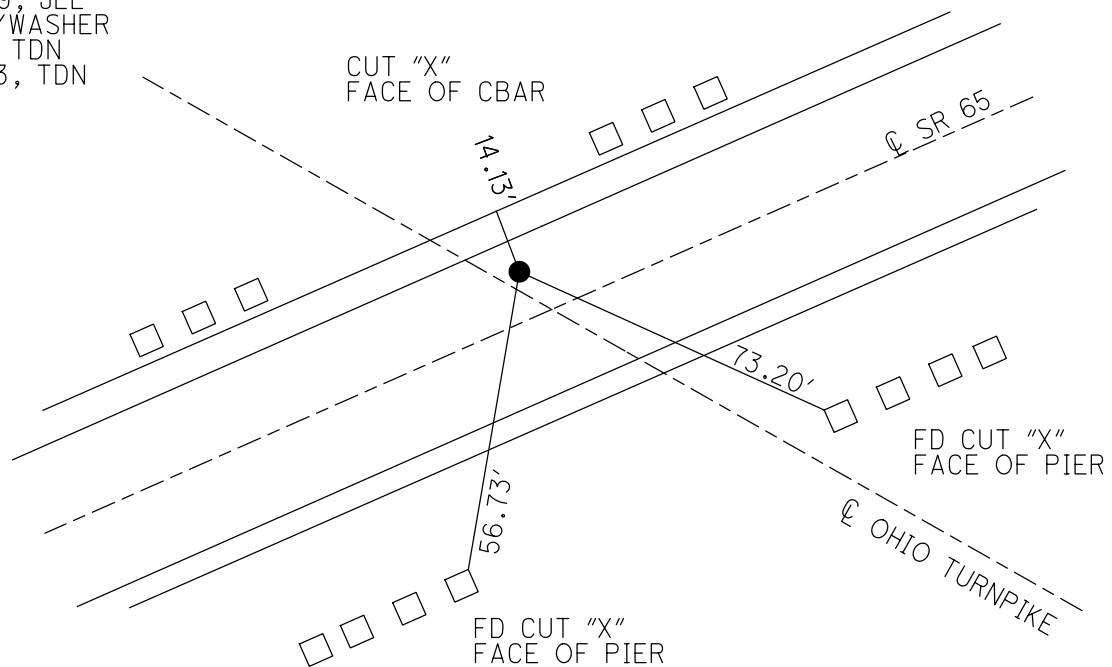

O.D.O.T. DISTRICT 2 SURVEY OFFICE (USE ONLY)

PERSONNEL

REFERENCE NO. 31 A

SHEET 7 OF 8

NOTES HUSS

DATE 9-13-05

ROUTE SR 65

H.C. HOMAN

WEATHER SUNNY

COUNTY WOOD

R.C. MIKLOVIC

TEMP. 80° F

TOWNSHIP PERRYSBURG

SECTION RT 70

DWG BY AUBLE PID 100460

T 3 12 MILE RESERVE

TYPE MONUMENT P.K.NAIL

ON SURFACE - ~~BELOW~~ ON

OFFSET CL PAVEMENT 7.2' LT : ~~RT~~

4.7' TO LT EDGE PAVEMENT


STATION: 1070+08

HORZ.DATUM: NAD83 (2011)


GEOID: 2012A

GRID: NORTHING: 698062.32

EASTING: 1667128.3212

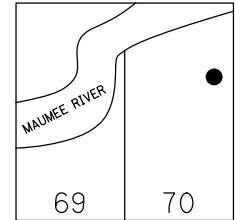

RECORD:
SET MAG/WASHER
10-28-05, SAH
FD MAG/WASHER
REFA31
11-7-2019, JLL

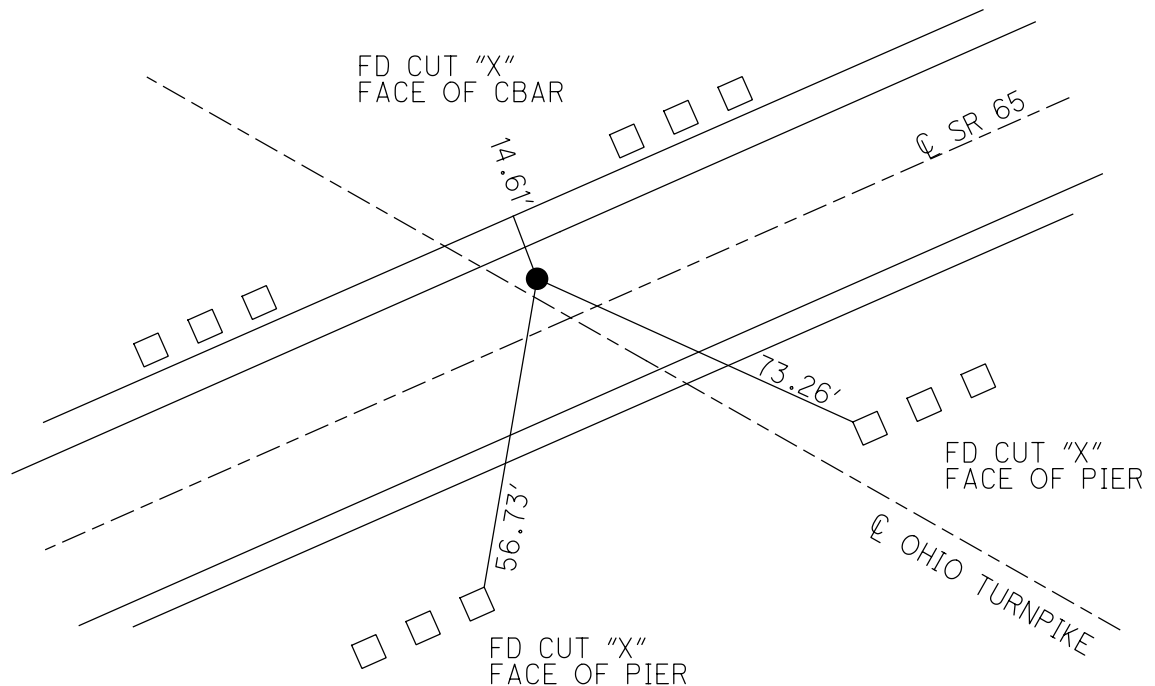

O.D.O.T. DISTRICT 2 SURVEY OFFICE

PERSONNEL

REFERENCE NO. 31-A

SHEET 8 OF 14

NOTES

HUSS

DATE

9-13-05

ROUTE

S.R. 65

H.C.

HOMAN

WEATHER

SUNNY

COUNTY

WOOD

R.C.

MIKLOVIC

TEMP.

80°

TOWNSHIP PERRYSBURG

SECTION RIVER TRACT

~~T 7 N R 11 E~~

~~Town 3, 12 mile Res.~~

TYPE MONUMENT

PK NAIL

ON SURFACE - ~~BELOW~~

ON



LEFT - ~~C PAVT~~ RIGHT

7.2' LT.


4.7' TO LT EDGE PAVEMENT

S.L.M.

1070+08

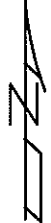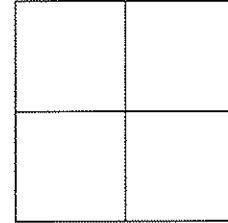

SET MAG NAILS
& WASHERS
10-28-05
SAH

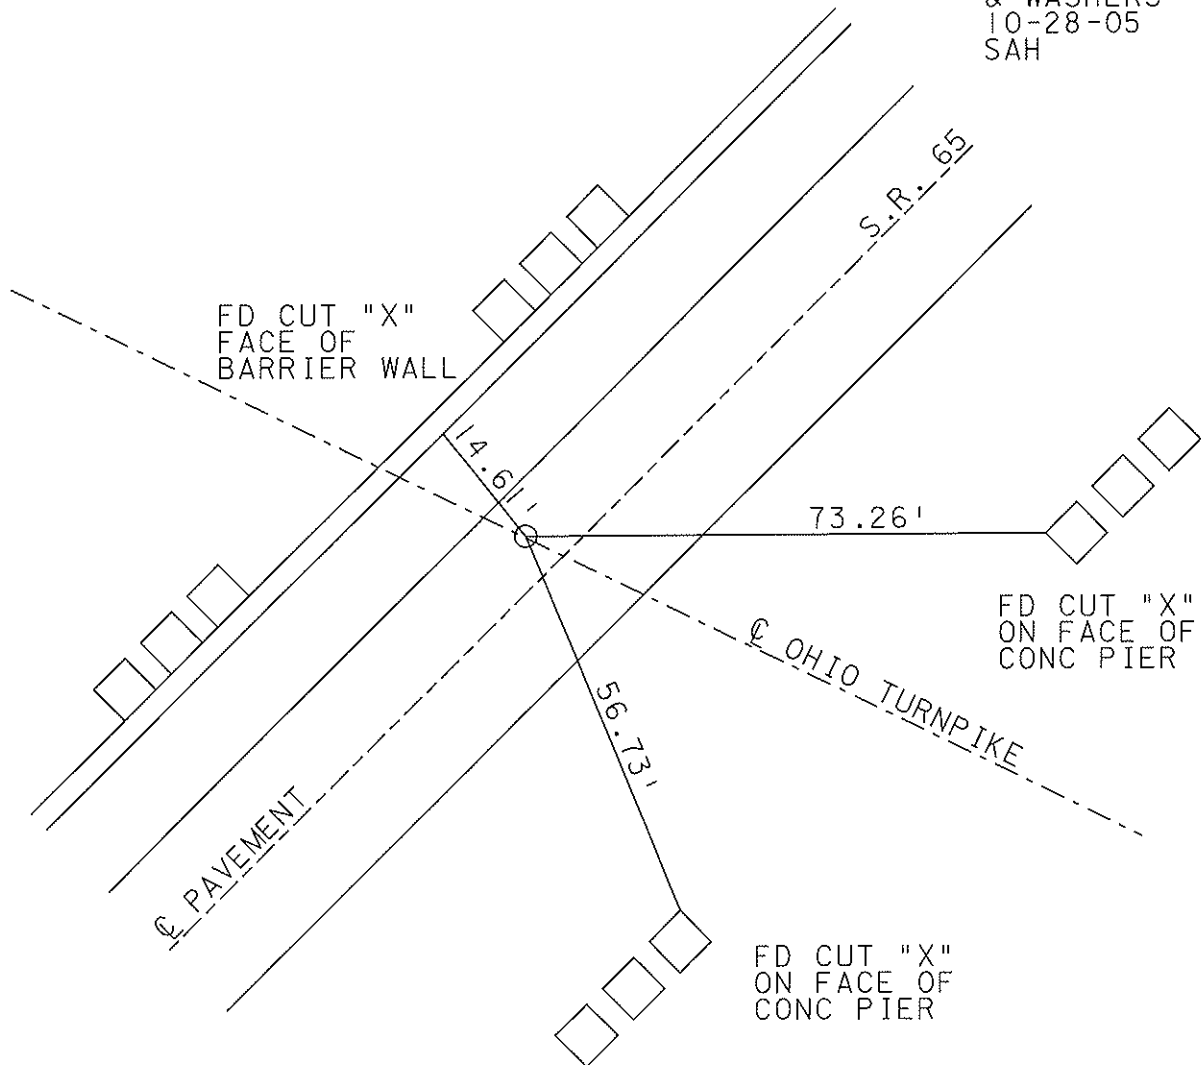

O.D.O.T. DISTRICT 2 SURVEY OFFICE

PERSONNEL

REFERENCE NO. 31 A

SHEET _____ OF _____

NOTES BARNHISEL

H.C. REED

R.C. Loehrke

HOFFMAN

DATE 5-3-88

WEATHER Partly Cloudy

TEMP. +55°

ROUTE 65

COUNTY Wood

TOWNSHIP Perrysburg

SECTION RIVER TRACT 70

T 7 N R 11 E



TYPE MONUMENT P.K. NAIL

ON SURFACE - ~~BELOW~~ yes

LEFT - & PAN'T. - RIGHT 7.6

7.7 TO L^+ EDGE PAVEMENT

S.L.M. 1070 + 08

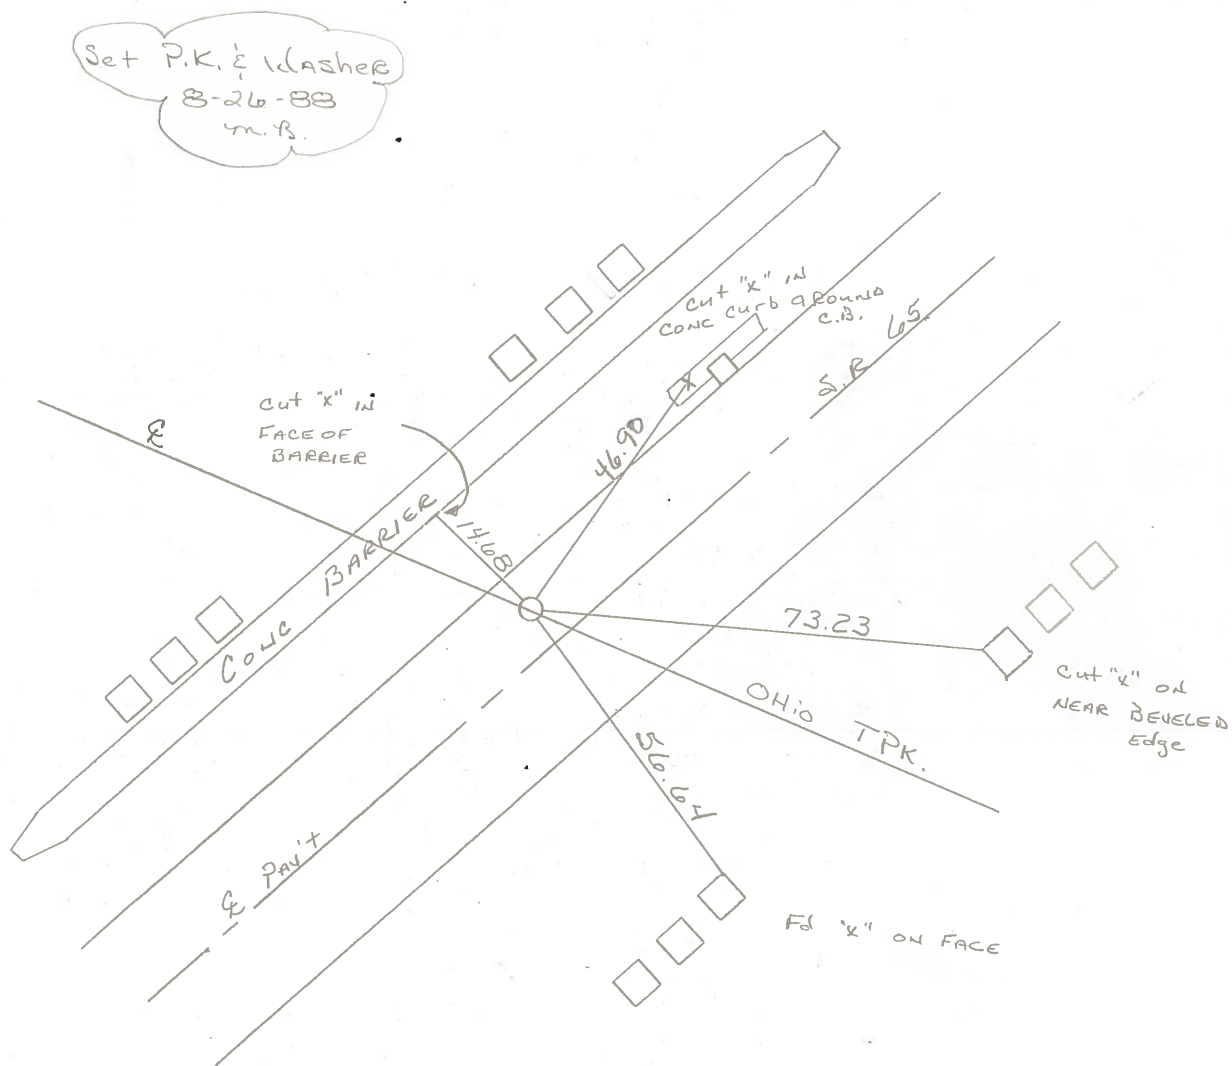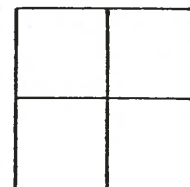

O.D.O.T. DISTRICT 2 SURVEY OFFICE

Sht. 15 of 20
S.R. 65

County WOOD

Date 7-31-78

Township PERRYSBURG


Weather CLEAR

Section _____

Temp. +76°

T N, R E

Personnel BURNSIDE

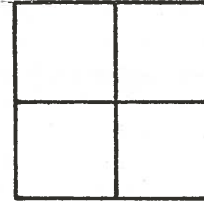

SMITH

BOWERS

KNAPE

MEAD

31-A



FD.P.K. NAIL
@ SURFACE

