

O.D.O.T. DISTRICT 2 SURVEY OFFICE (USE ONLY)

PERSONNEL

REFERENCE NO. 31 B

SHEET 10 OF 23

NOTES BARRIERE
H.C. MILLER
R.C. BLUBAUGH

DATE 7/1/24
WEATHER SUNNY
TEMP. 70°

ROUTE SR 65
COUNTY WOOD
TOWNSHIP PERRYSBURG
SECTION 71
T 3 N R 12 MI RESERVE

DWG BY BARRIERE PID 101291

TYPE MONUMENT MAG SHANK

ON SURFACE - BELOW ON

OFFSET $\varnothing$ PAVEMENT 7.0' LT LT : RT

TO EDGE PAVEMENT

STATION: 1075+11

HORIZ.DATUM: NAD83 (2011)


GEOID: 18

GRID: NORTHING: 698402.077


EASTING: 1667499.575

LDP: NORTHING: 520441.148

EASTING: 177674.556

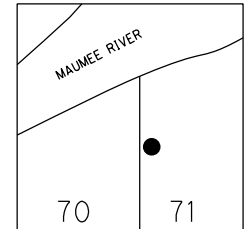

RECORD:
SET MAG/WASHER
10-28-05, SAH
FD MAG SHANK
REFB31
11-7-2019, JLL
FD MAG SHANK
REFB31
11-17-22, TDN
5-8-23, TDN
10/12/23, TDN
FD MAG SHANK
REF31B
7/1/24, JAM
FD MAG SHANK
NEWREF31B
7/10/24, TDN

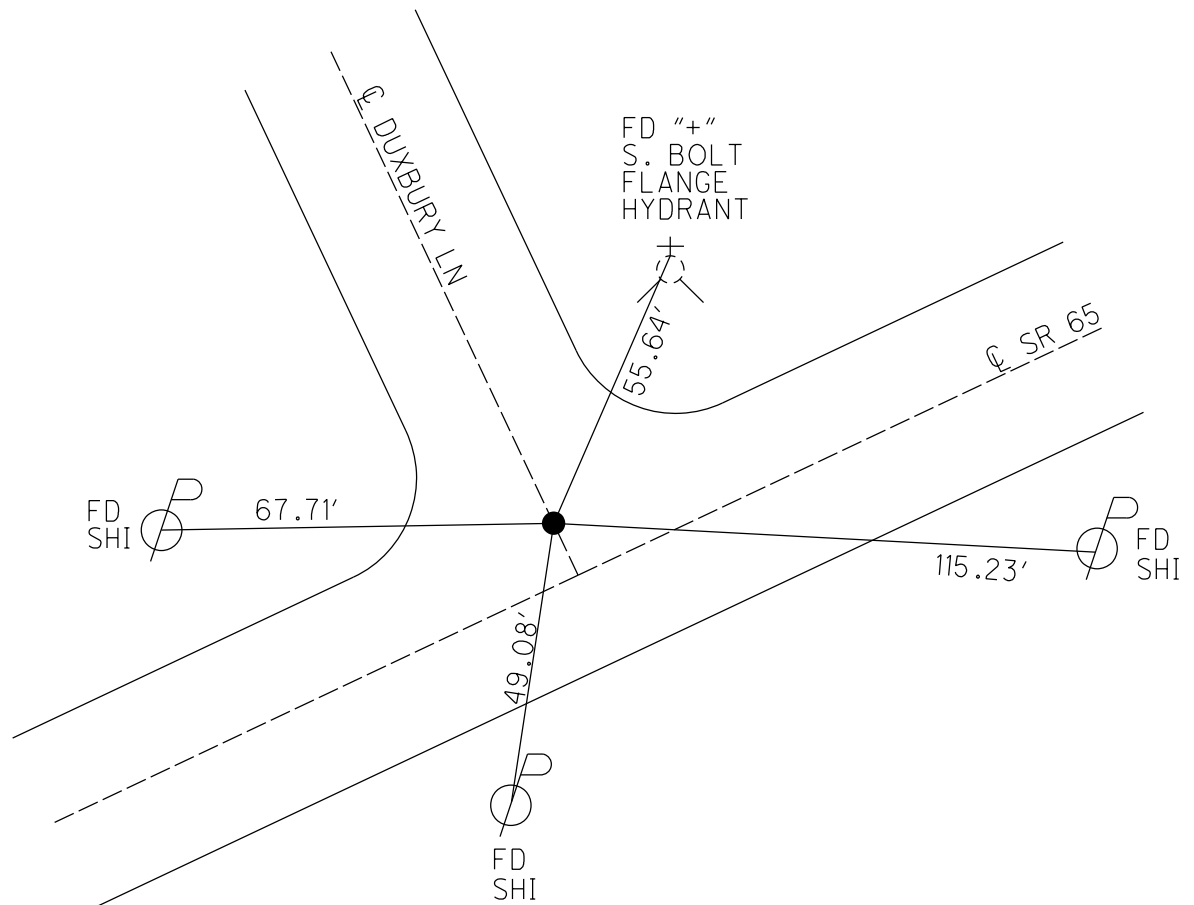

O.D.O.T. DISTRICT 2 SURVEY OFFICE (USE ONLY)

PERSONNEL

REFERENCE NO. 31 B

SHEET 8 OF 21

NOTES AUBLE

DATE 5-8-23

ROUTE SR 65H.C. NIESE

WEATHER CLOUDY

COUNTY WOOD

R.C. AUBLE

TEMP. 55° F

TOWNSHIP PERRYSBURGDWG BY AUBLEPID PAVING TRAIN

T 3 12 MILE RESERVE

TYPE MONUMENT MAG SHANK

ON SURFACE - ~~BELOW~~ _____ ON

OFFSET @ PAVEMENT 7.0' LT : RT


5.4' TO LT EDGE PAVEMENT

STATION: 1075+11

HORZ.DATUM: NAD83 2011


GEOID: NAVD88 2018

GRID: NORTHING: 698402.077

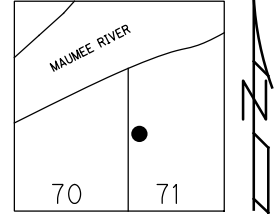EASTING: 1667499.575

RECORD:
SET MAG/WASHER
10-28-05, SAH
FD MAG SHANK
REFB31
11-7-2019, JLL
FD MAG SHANK
REFB31
11-17-22, TDN
5-8-23, TDN
10/12/23, TDN

WOOD LPD:
N: 520441.196
E: 177674.557

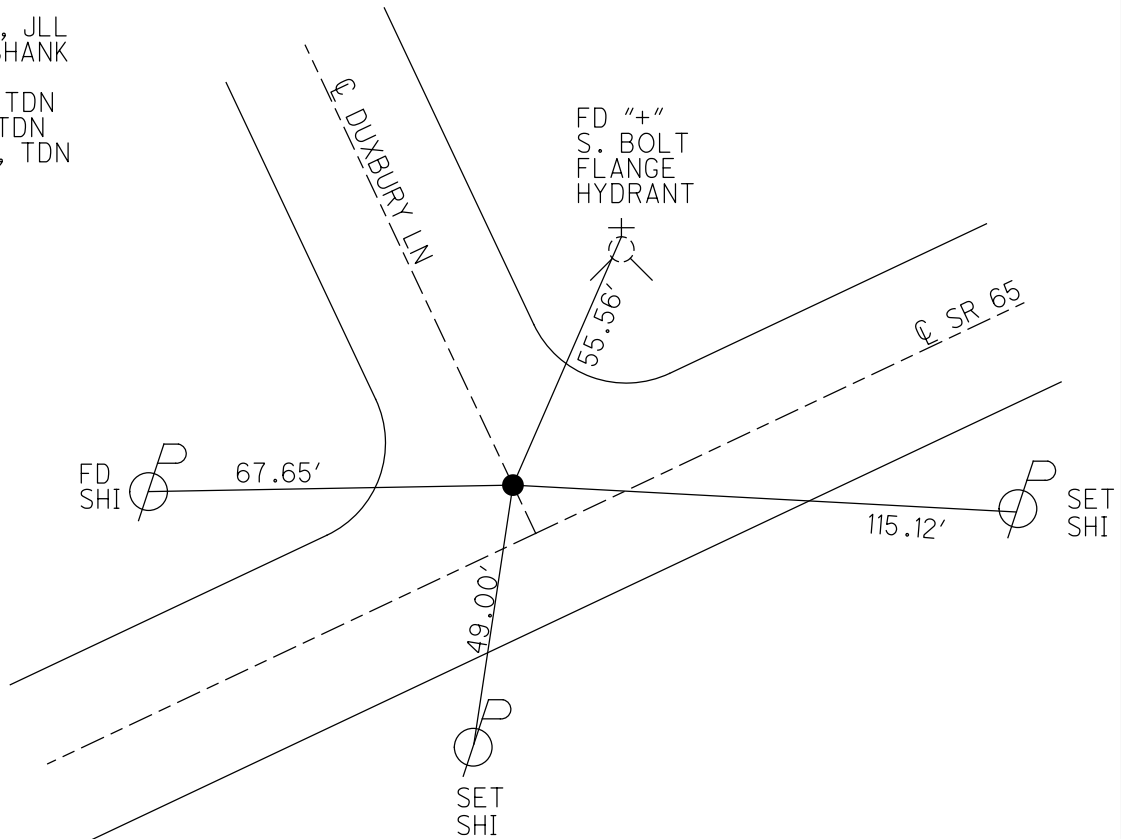

O.D.O.T. DISTRICT 2 SURVEY OFFICE (USE ONLY)

PERSONNEL

REFERENCE NO. 31 B

SHEET 8 OF 8

NOTES AUBLE

DATE 11-7-2019

ROUTE SR 65

H.C. LEU

WEATHER CLOUDY

COUNTY WOOD

R.C. NASON

TEMP. 40° F

TOWNSHIP PERRYSBURG

SECTION RT 71

DWG BY AUBLE

PID 100460

T 3 12 MILE RESERVE

TYPE MONUMENT MAG SHANK

ON SURFACE - ~~BELOW~~ ON

OFFSET Q PAVEMENT 7.0' LT : RT

5.4' TO LT EDGE PAVEMENT


STATION: 1075+11

HORZ.DATUM: NAD83 (2011)


GEOID: 2012A

GRID: NORTHING: 698402.0631

EASTING: 1667499.6086

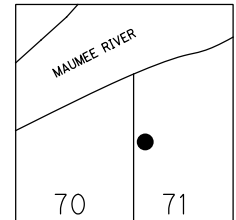

RECORD:
SET MAG/WASHER
10-28-05, SAH
FD MAG SHANK
REFB31
11-7-2019, JLL

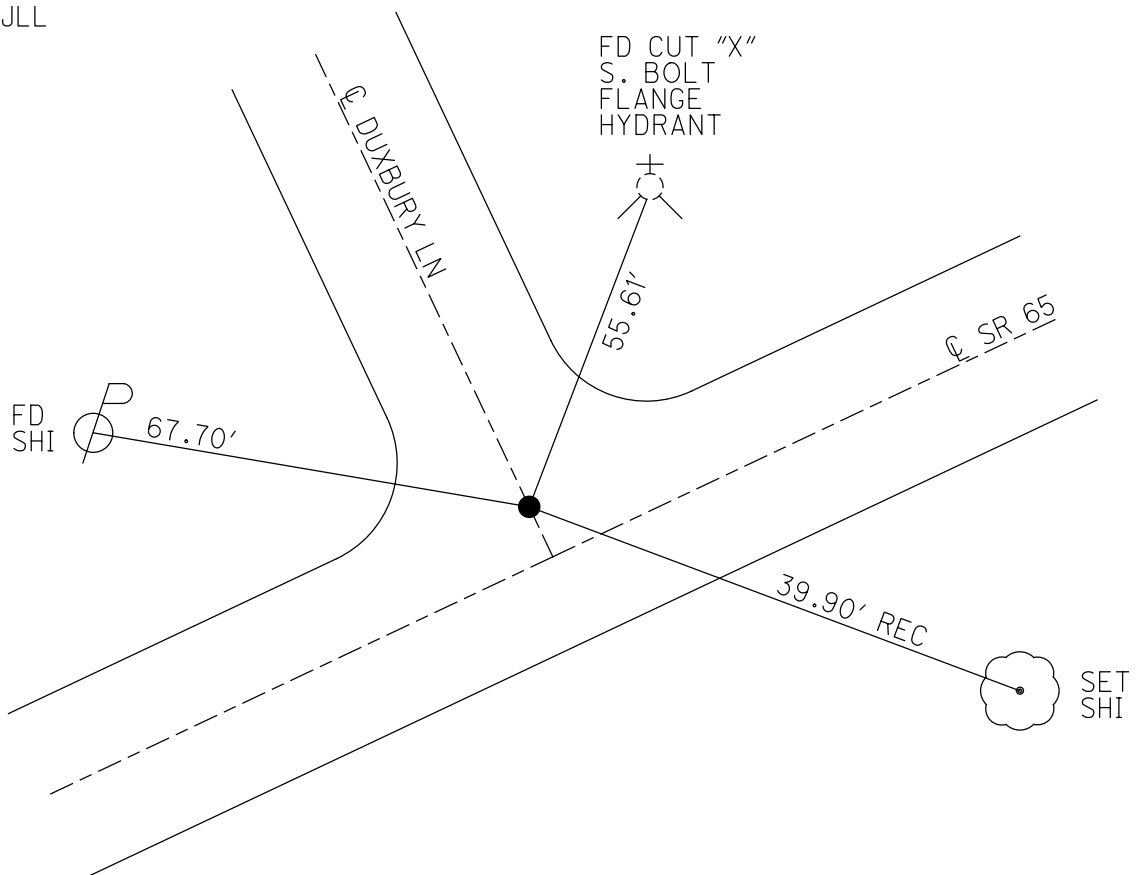

O.D.O.T. DISTRICT 2 SURVEY OFFICE

PERSONNEL

REFERENCE NO. 31-6

SHEET 9 OF 14

NOTES

HUSS

DATE 9-13-05

ROUTE S.R. 65

H.C.

HOMAN

WEATHER SUNNY

COUNTY WOOD

R.C.

MIKLOVIC

TEMP. 80°

TOWNSHIP PERRYSBURG

SECTION RIVER TRACT

~~T-7-N R-11-E~~

Town 3, 12 mile Res.



TYPE MONUMENT SM RR SPIKE

~~ON SURFACE~~ - BELOW 1"

LEFT - ~~C PAVT~~ - RIGHT 7.0' LT

5.4' TO LT EDGE PAVEMENT

S.L.M. 1075+11

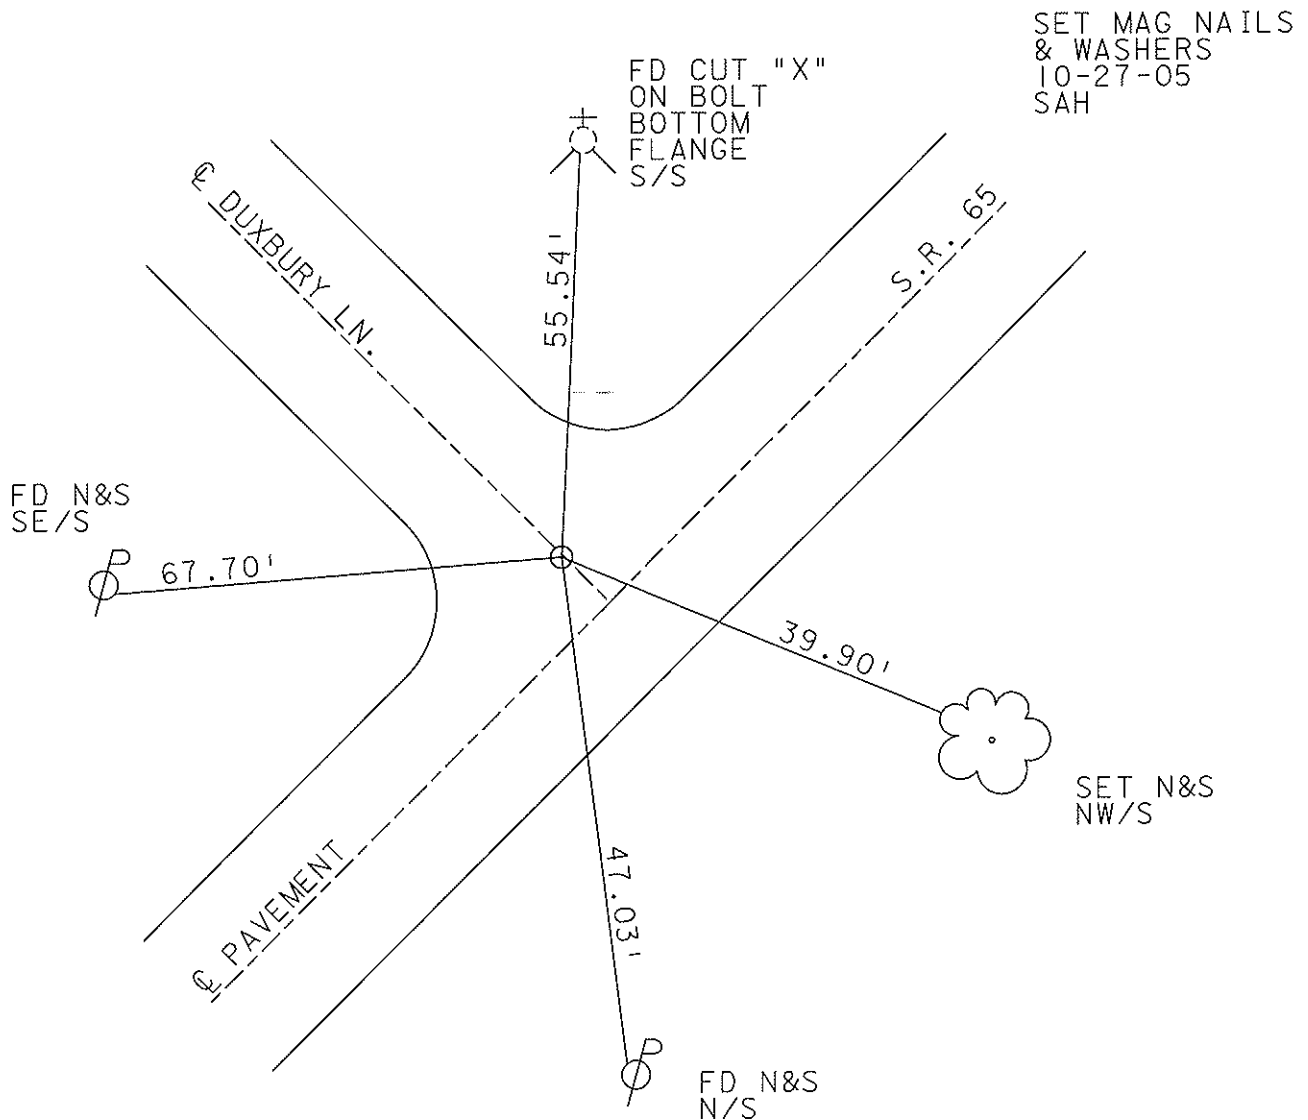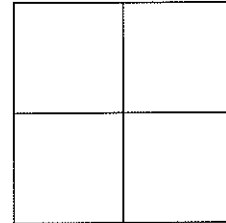

O.D.O.T. DISTRICT 2 SURVEY OFFICE

PERSONNEL

REFERENCE NO. 31 B

SHEET OF

NOTES BARNHISEL

H.C. Reed

R.C. Loehrke

HOFFMAN

DATE 5-3-88

WEATHER SUNNY

TEMP. +58°

ROUTE 65

COUNTY Wood

TOWNSHIP Perryburg

SECTION River Tract 71

T 7 N R 11 E


TYPE MONUMENT Sm BR Spk - P.K. NAIL ON R/W

ON SURFACE - BELOW yes


LEFT-CL PAV'T. - RIGHT 7.4

8.5 TO LT EDGE PAVEMENT

S.L.M. 1075+11

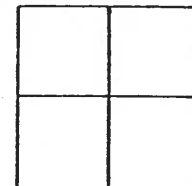

Set P.K. & Washer
8-26-88
m.B.

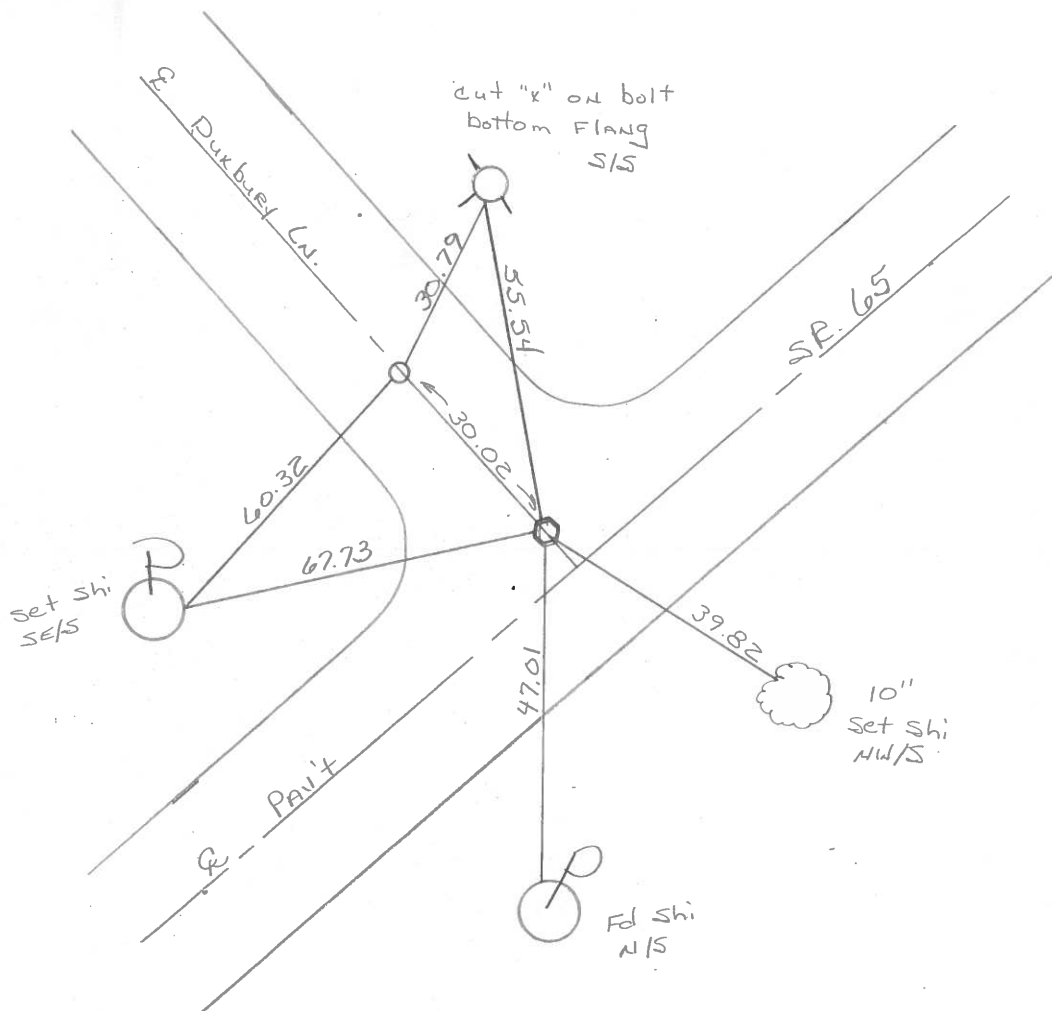

O.D.O.T. DISTRICT 2 SURVEY OFFICE

SHEET

OF

County Wood S.R. 65

Township _____

Section _____

T N, R E

Personnel J. Stone

R. Michalak

P. Neuse


D. Curtis

H. Mead

Date 17 Nov. 80

Weather cloudy

Temp. 38°

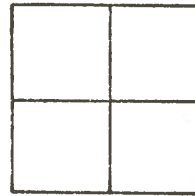

REF. NO. 313

