

O.D.O.T. DISTRICT 2 SURVEY OFFICE (USE ONLY)

PERSONNEL

REFERENCE NO. 32

SHEET 11 OF 23

NOTES BARRIERE
H.C. MILLER
R.C. BLUBAUGH

DATE 7/1/24
WEATHER SUNNY
TEMP. 70°

ROUTE SR 65
COUNTY WOOD
TOWNSHIP PERRYSBURG
SECTION 71

DWG BY BARRIERE PID 101291

T 3 N R 12 MI RESERVE

TYPE MONUMENT MAG SHANK

ON SURFACE - BELOW ON

OFFSET $\varnothing$ PAVEMENT 7.0' LT LT : RT

TO EDGE PAVEMENT

STATION: 1088+83

HORIZ.DATUM: NAD83 (2011)


GEOID: 18

GRID: NORTHING: 699328.185


EASTING: 1668510.815

LDP: NORTHING: 521380.648

EASTING: 178673.513

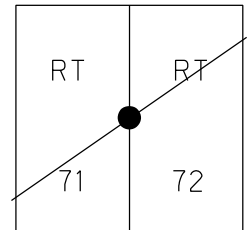

RECORD: P.I.
STA 85+02.65
 $\Delta = 0^\circ 05' RT$
FD OVER BRASS MON
1978
SET MAG/WASHER
10-27-05, SAH
FD MAG/WASHER
REF 32
11-17-22, TDN
FD MAG/WASHER
REF 32
5-8-23, TDN
10/12/23, TDN
FD MAG/WASHER
REF 32
7/1/24, JAM

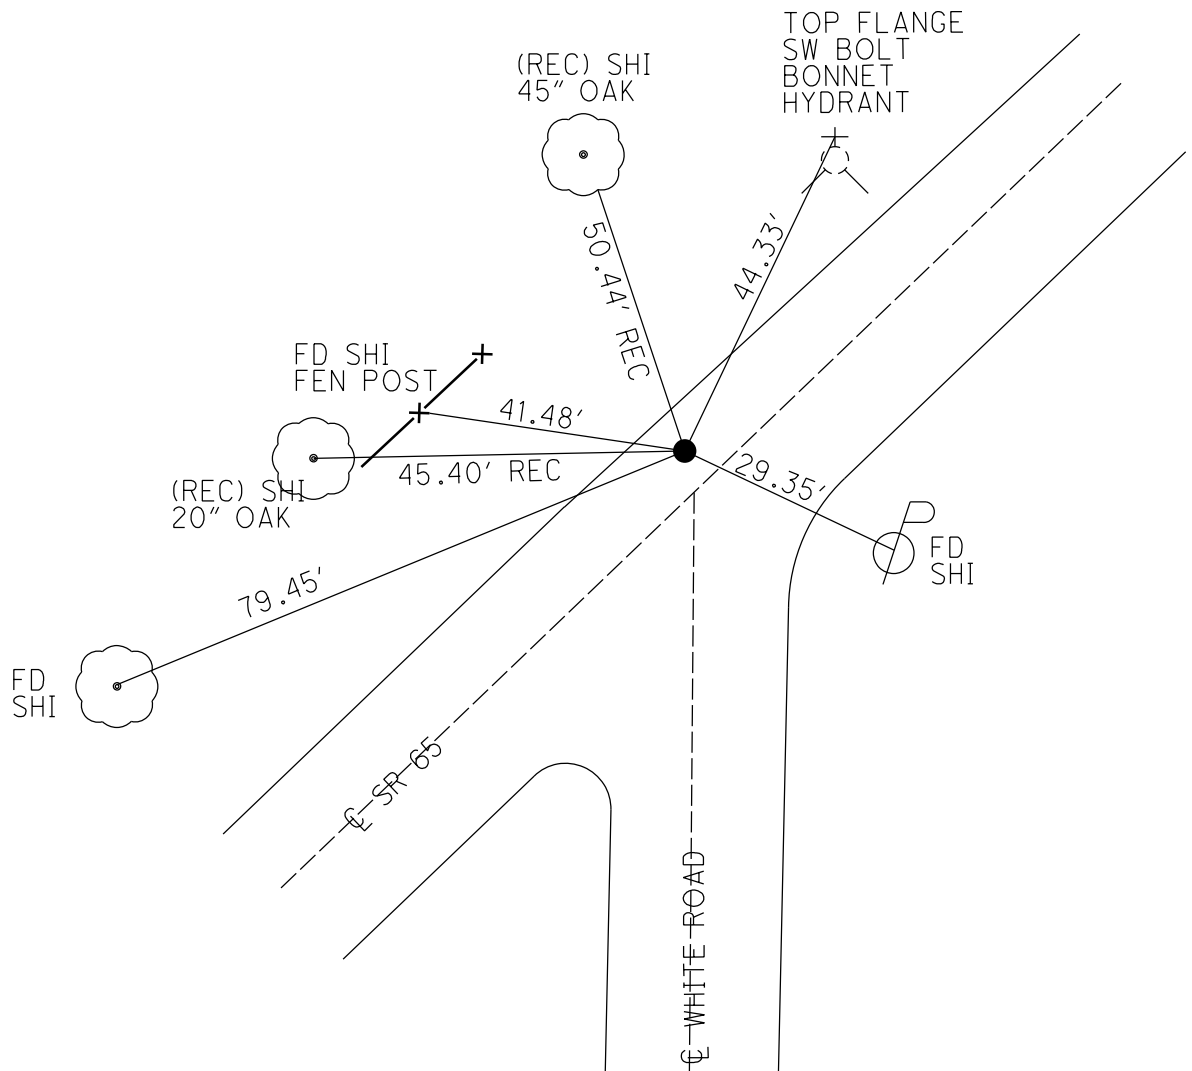

O.D.O.T. DISTRICT 2 SURVEY OFFICE (USE ONLY)

PERSONNEL

REFERENCE NO. 32

SHEET 9 OF 21

NOTES AUBLE

DATE 5-8-23

ROUTE SR 65

H.C. NIESE

WEATHER CLOUDY

COUNTY WOOD

R.C. AUBLE

TEMP. 55° F

TOWNSHIP PERRYSBURG

SECTION RT 71

DWG BY RHOADES

PID PAVING TRAIN

T 3 12 MILE RESERVE

TYPE MONUMENT MAG/WASHER

ON SURFACE - ~~BELOW~~ ON

OFFSET CL PAVEMENT 4.8' LT : RT

4.8' TO LT EDGE PAVEMENT


STATION: 1088+83

HORZ.DATUM: NAD83 2011

GEOID: NAVD88 2018


GRID: NORTHING: 699328.185

EASTING: 1668510.815

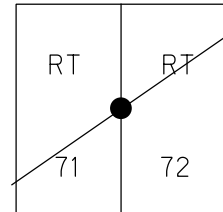

RECORD: P.I.
STA 85+02.65
 $\Delta = 0^\circ 05' RT$
FD OVER BRASS MON
1978
SET MAG/WASHER
10-27-05, SAH
FD MAG/WASHER
REF 32
11-17-22, TDN
FD MAG/WASHER
REF 32
5-8-23, TDN
10/12/23, TDN

WOOD LPD:
N: 521380.607
E: 178673.538

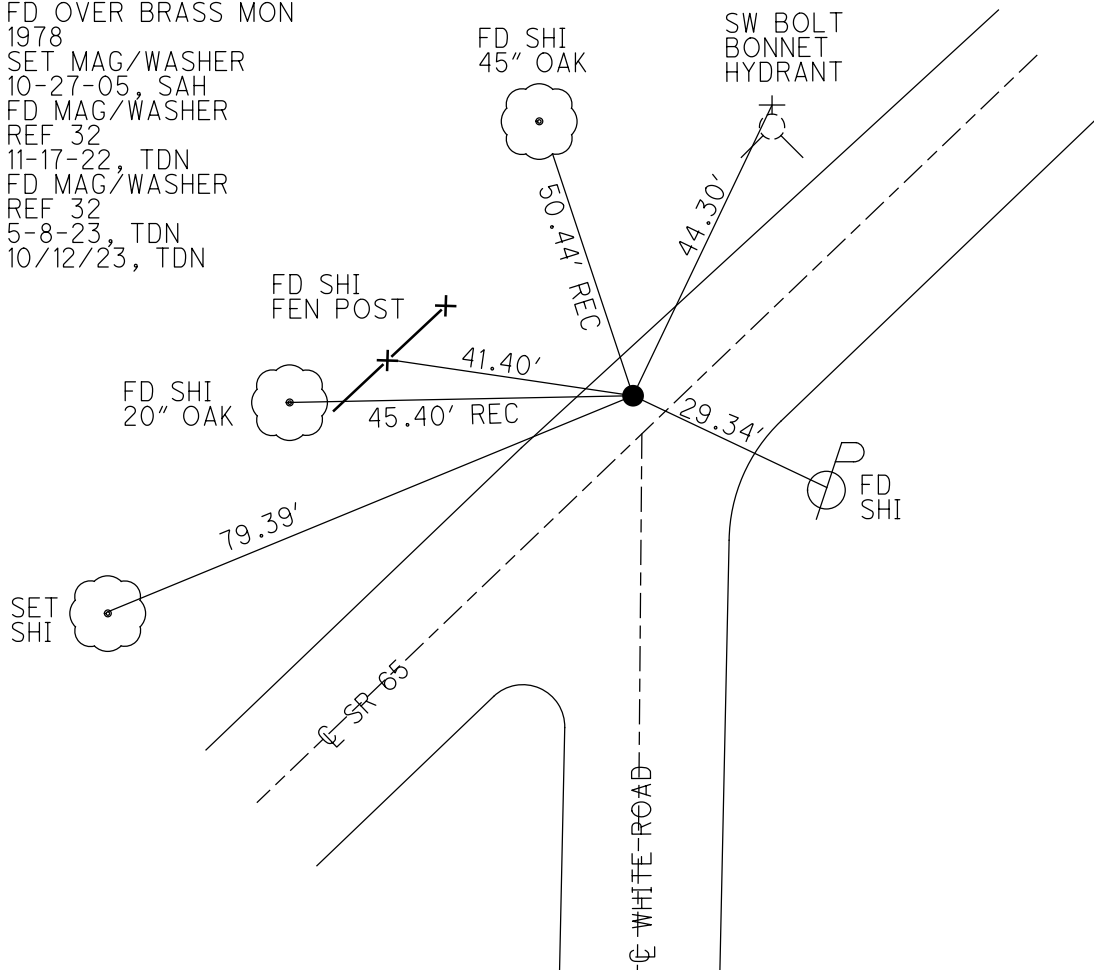

O.D.O.T. DISTRICT 2 SURVEY OFFICE

PERSONNEL

REFERENCE NO. 32

SHEET 10 OF 14

NOTES HUSS

DATE 9-13-05

ROUTE S.R. 65

H.C. HOMAN

WEATHER SUNNY

COUNTY WOOD

R.C. MIKLOVIC

TEMP. 80°

TOWNSHIP PERRYSBURG

SECTION RIVER TRACT

T-7-N R-11-E

town 3, 12 mile Res.


TYPE MONUMENT PK NAIL

ON SURFACE - ~~BELOW~~ ON


LEFT - ~~C PAVT - RIGHT~~ 4.8' LT

4.8' TO LT EDGE PAVEMENT

S.L.M. 1088+83

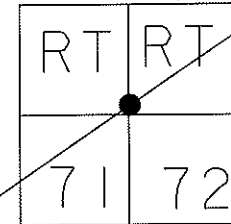

RECORD
1978 REF OVER BRASS MON.
P.I. STA 85+02.65
DELTA=0°05' RT.

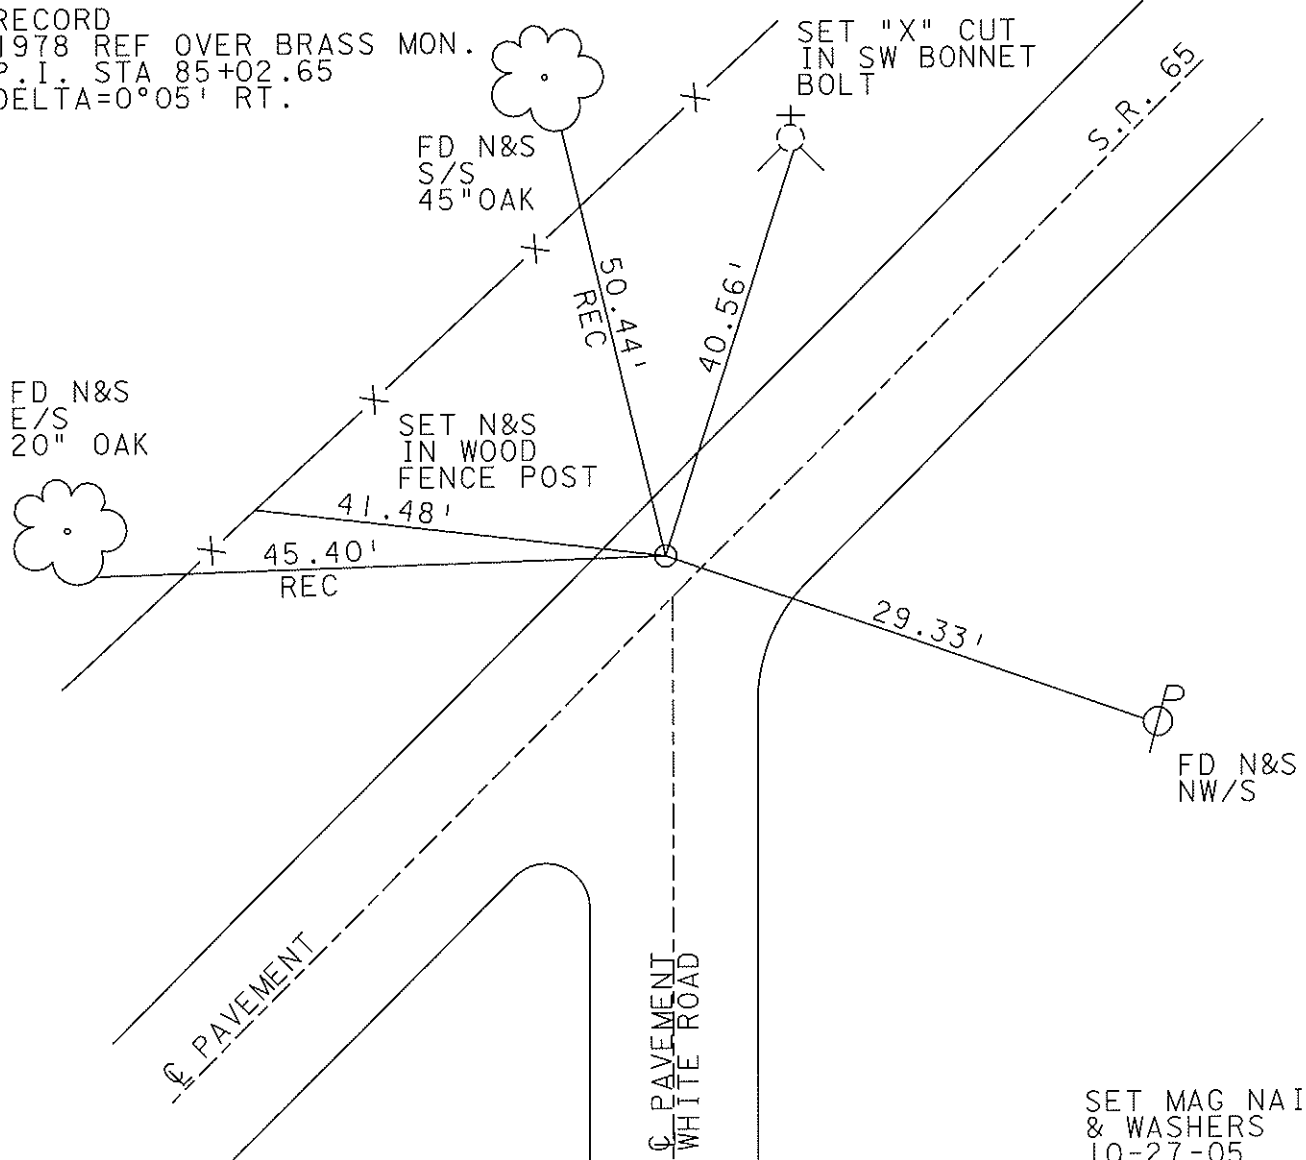

SET MAG NAILS
& WASHERS
10-27-05
SAH

O.D.O.T. DISTRICT 2 SURVEY OFFICE

PERSONNEL

REFERENCE NO. 32

SHEET OF

NOTES BARNHISEL

H.C. REED

R.C. Loehrke

HOFFMAN

DATE 5-3-88

WEATHER SUNNY

TEMP. + 58°

ROUTE 65

COUNTY WOOD

TOWNSHIP Perryburg

SECTION R.T. 71 & 72

T 7 N R 11 E


TYPE MONUMENT P.K. NAIL

ON SURFACE - BELOW yes

LEFT- & PAV'T. - RIGHT 7.3

8.4 TO Lt EDGE PAVEMENT

S.L.M. 1088+83

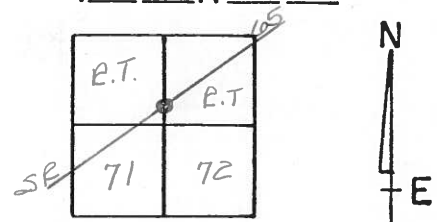

RECORD

1978 Refs. over BEASS MON.


P.I. STA. 85+02.65

$\Delta = 0^{\circ} 05' \text{ RT}$

Set P.K. & washer

8-29-88

m.B.

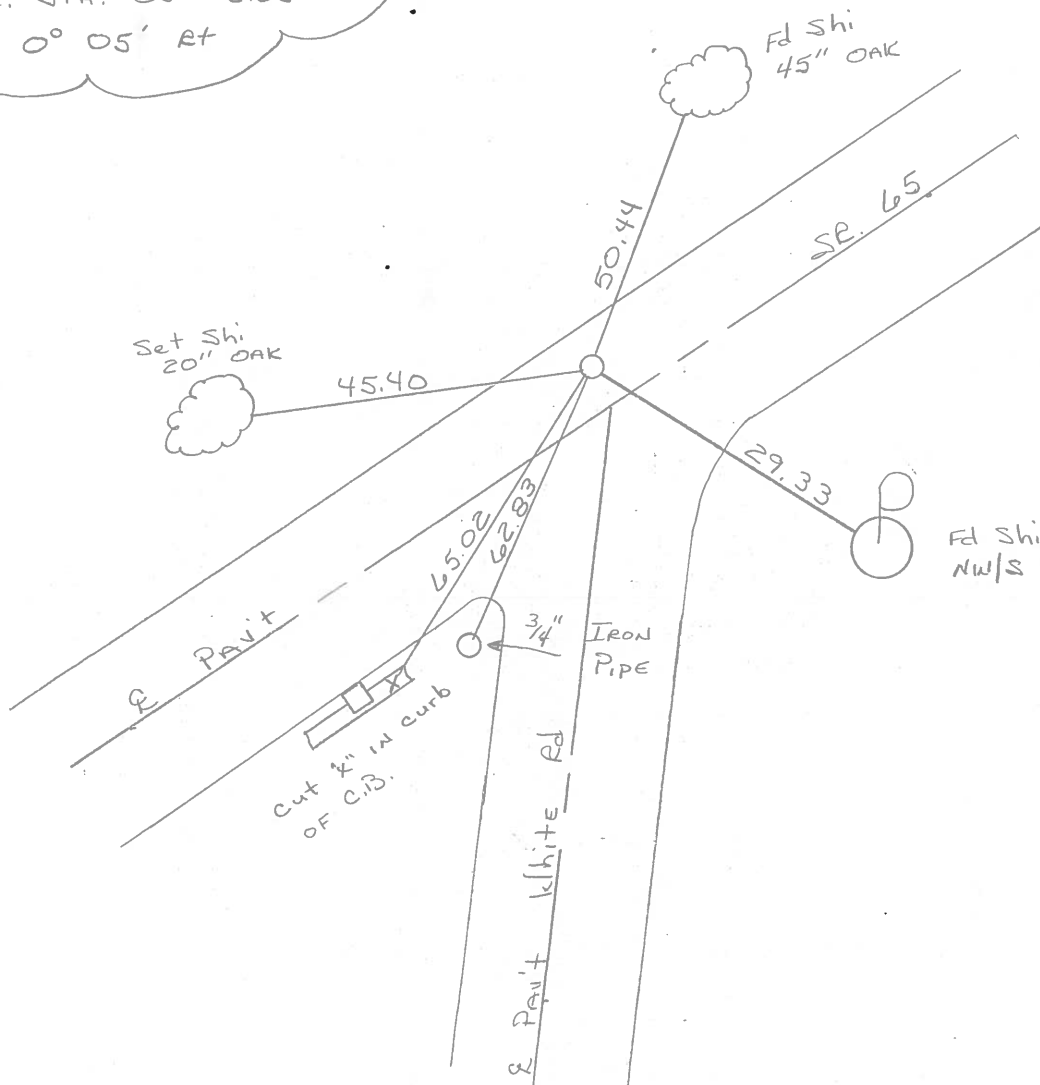

O.D.O.T. DISTRICT 2 SURVEY OFFICE

SHEET

OF

County Wood S.R. 65

Township Perry's bog

Section RT 71 & 72

T N, R E

Personnel J. Stone

R. Michalak

P. Neuser


D. Curtis

H. Meed


Date 13 Nov. 80

Weather Cloudy

Temp. 49°

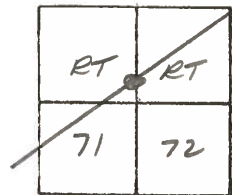

REF. No. 32

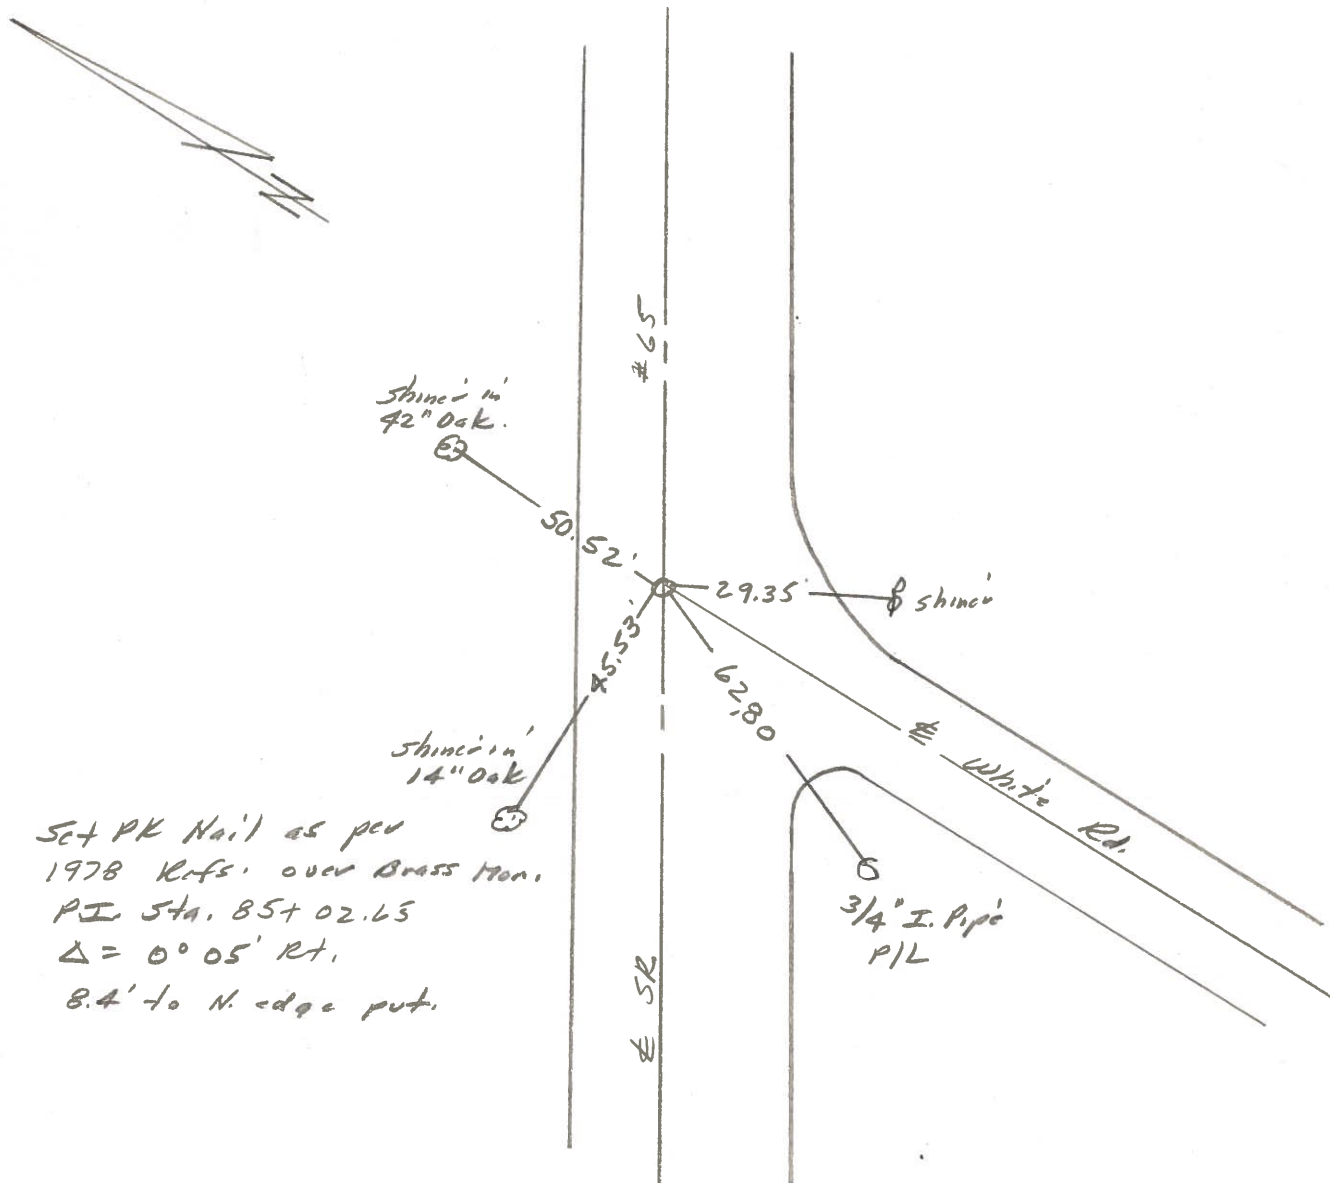

Set PK Nail as per
1978 Refs. over Brass Mon.
P.I. Sta. 85+02.65
 $\Delta = 0^\circ 05' \text{ RT.}$
8.4' to N. edge put.

O.D.O.T. DISTRICT 2 SURVEY OFFICE

Sht. 16 of 20
S.R. 65

County WOOD

Date 7-31-78

Township PERRYSBURG

Weather CLEAR

Section 1

Temp. +76°

T N, R E



Personnel BURNSIDE

SMITH

BOWERS

KNAPE

MEAD

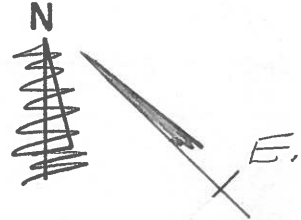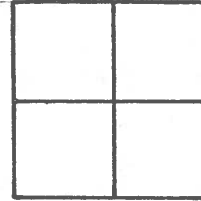


#32



FD. BRASS PLATE
OF STATE RW
MON. (2" DEEP)
8.2' TO N. CURB

P.I. STA = BS + 02.65
 $\Delta = 0^\circ - 05'$ R.

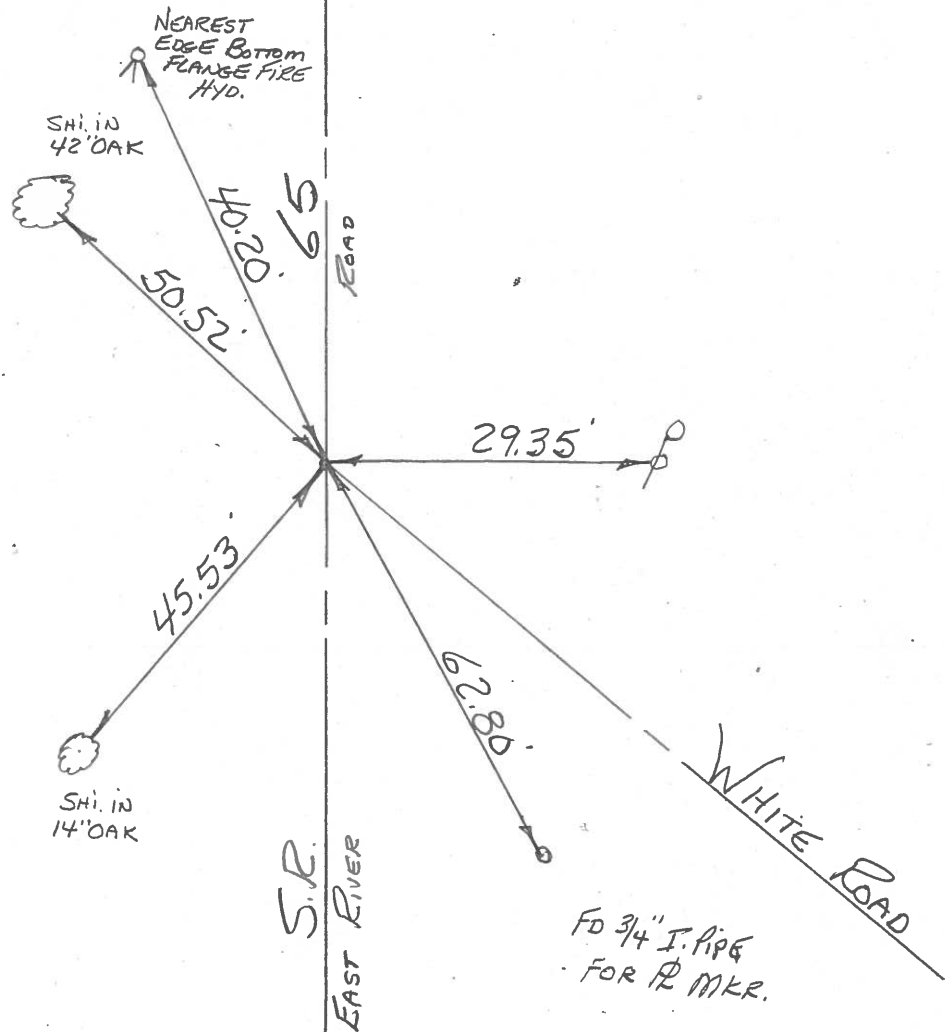


PERSONNEL	TITLE	PERSONNEL	TITLE	COUNTY	DATE	WEATHER	TEMP.
Granata				Wood	Aug. 18, 1971	P. Cloudy	80°
Neuser				#65			
Vanyo							
Jackson							

DESCRIPTION Reference Mon. on S.R. #65 JOB NO. _____

LEFT

CENTER LINE

RIGHT

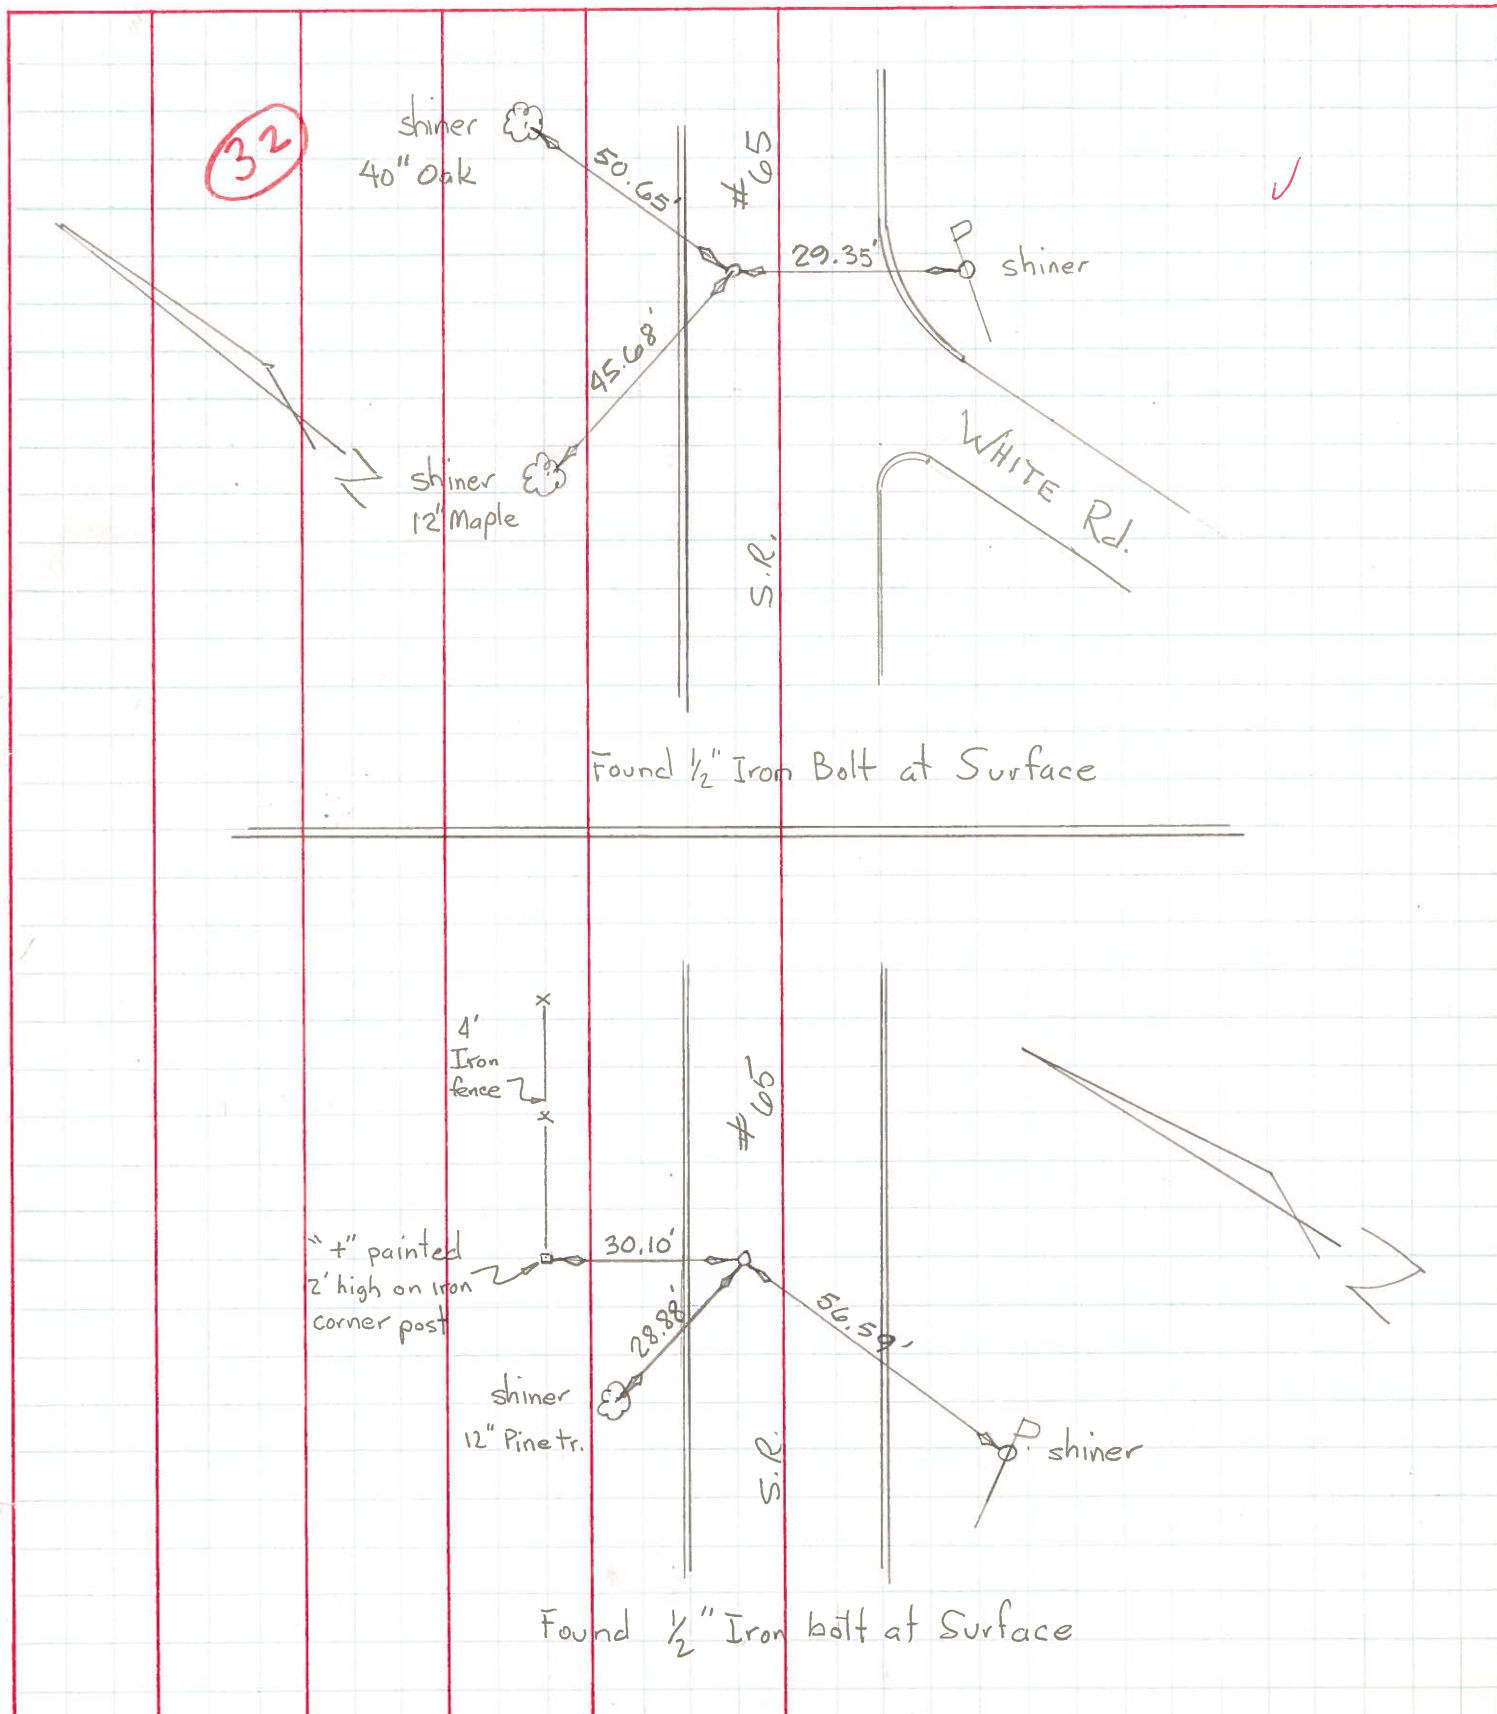

PERSONNEL TITLE PERSONNEL TITLE


COUNTY Wood DATE 8/24/65

Silvester

S. R. 65 WEATHER _____

SEC. _____ TEMP. _____

DESCRIPTION LEFT CENTER LINE RIGHT JOB NO. _____

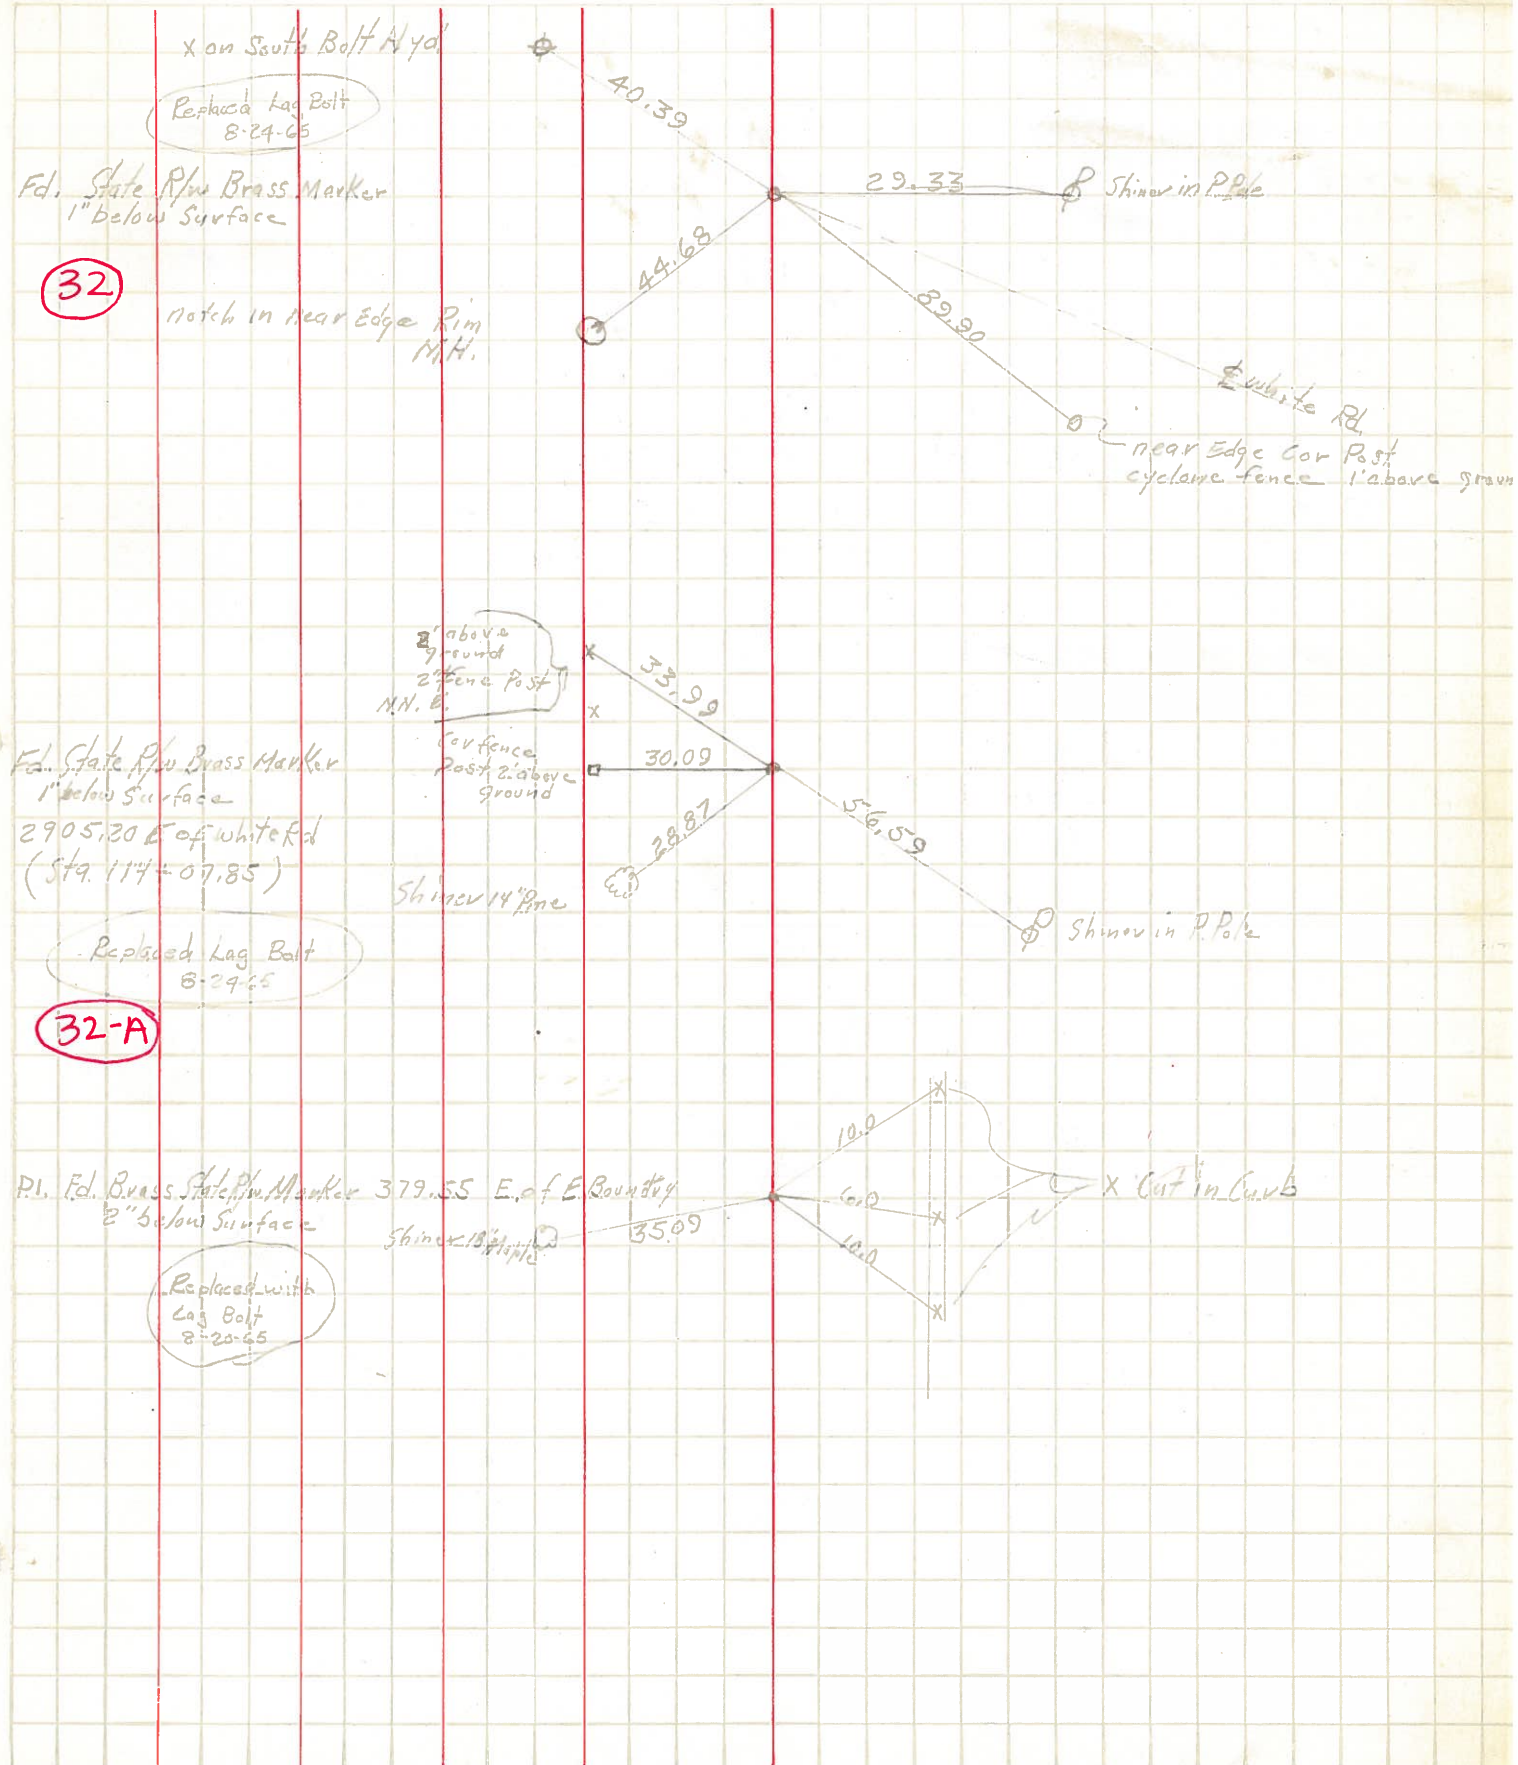

PERSONNEL TITLE PERSONNEL TITLE

COUNTY Wood

DATE

S. R. #65

WEATHER

SEC. "C" Rossford

TEMP.

DESCRIPTION

LEFT

CENTER LINE

RIGHT

JOB NO.

#

778

Sta. 3+79.55

P.I. $\Delta = 12^\circ 50' \text{ Lt.}$ R.R. spike (set
over original stone)

12" maple

35.9'

70'

Shiner in wild cherry

#

779

Sta. 0-49.5

Conc. post

49.5' to stone

70.0'

50.35'

Nail on E.W.E. line of
E. Boundary st.Iron pin E. Boundary st
pin leaning North

Nail on line 00.2' E. of I. pin

#

780

Sta. 85 to 2.7

P.I. (inter White Ed.)

At old stone

X-in pave.

41.05'

52.85'

90.00'

Iron post in
conc.