

O.D.O.T. DISTRICT 2 SURVEY OFFICE (USE ONLY)

PERSONNEL

REFERENCE NO. 32 B

SHEET 13 OF 23

NOTES BARRIERE
H.C. MILLER
R.C. BLUBAUGH

DATE 7/1/24
WEATHER SUNNY
TEMP. 70°

ROUTE SR 65
COUNTY WOOD
TOWNSHIP PERRYSBURG
SECTION 75
T 3 N R 12 MI RESERVE

DWG BY BARRIERE PID 101291

TYPE MONUMENT MAG/WASHER

ON SURFACE - BELOW ON

OFFSET $\odot$ PAVEMENT 5.7' LT LT : RT
TO EDGE PAVEMENT

STATION: 1142+70

HORIZ.DATUM: NAD83 (2011)


GEOID: 18

GRID: NORTHING:


EASTING:

LDP: NORTHING: 525066.893

EASTING: 182597.887

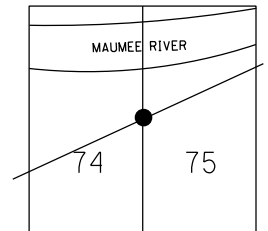

RECORD: P.I.
STA.138+88.8
 $\Delta=0^{\circ}30'$ LT
SET P.K.NAIL
ATOP IPIPE
1937
SET MAG/WASHER
10-27-05, SAH
FD MAG/WASHER
REF32B
11-17-22, TDN
FD MAG/WASHER
REF32B
5-8-23, TDN
10/12/23, TDN
FD MAG/WASHER
REF32B
7/1/24, JAM

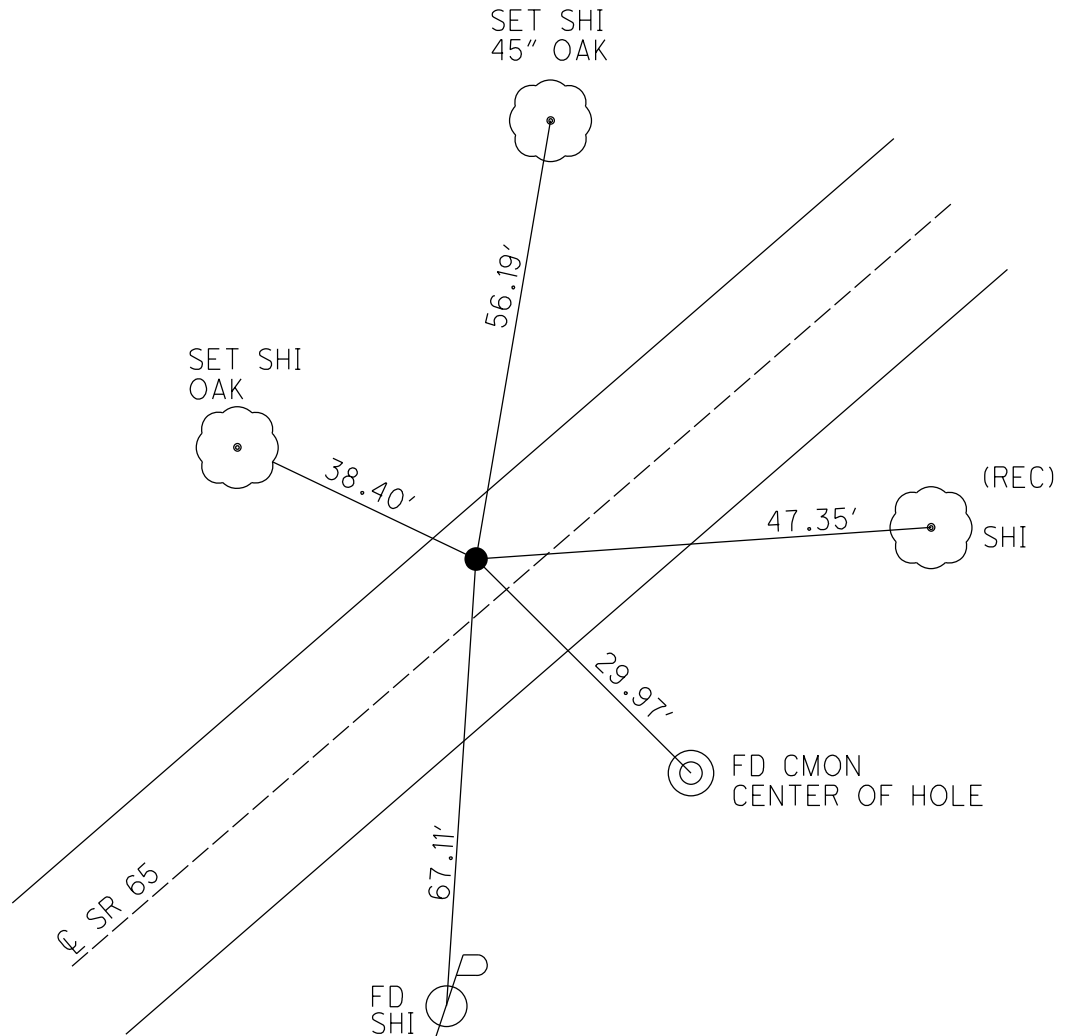

O.D.O.T. DISTRICT 2 SURVEY OFFICE (USE ONLY)

PERSONNEL

REFERENCE NO. 32 B

SHEET 11 OF 21

NOTES AUBLE

DATE 5-8-23

ROUTE SR 65

H.C. NIESE

WEATHER CLOUDY

COUNTY WOOD

R.C. AUBLE

TEMP. 55° F

TOWNSHIP PERRYSBURG

SECTION RT 75

DWG BY RHOADES

PID PAVING TRAIN

T 3 12 MILE RESERVE

TYPE MONUMENT MAG/WASHER

ON SURFACE - ~~BELOW~~ ON

OFFSET Q PAVEMENT 5.7' LT : RT

8.3' TO LT EDGE PAVEMENT


STATION: 1142+70

HORIZ.DATUM: NAD83 2011

GEOID: NAVD88 2018

GRID: NORTHING: 701287.946

EASTING: 1670654.892

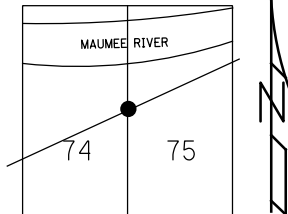

RECORD: P.I.

STA.138+88.8

$\Delta=0^{\circ}30'$ LT

SET P.K.NAIL

ATOP IPIPE

1937

SET MAG/WASHER

10-27-05, SAH

FD MAG/WASHER

REF32B

11-17-22, TDN

FD MAG/WASHER

REF32B


5-8-23, TDN

10/12/23, TDN

WOOD LPD:

N: 525066.922

E: 182597.864

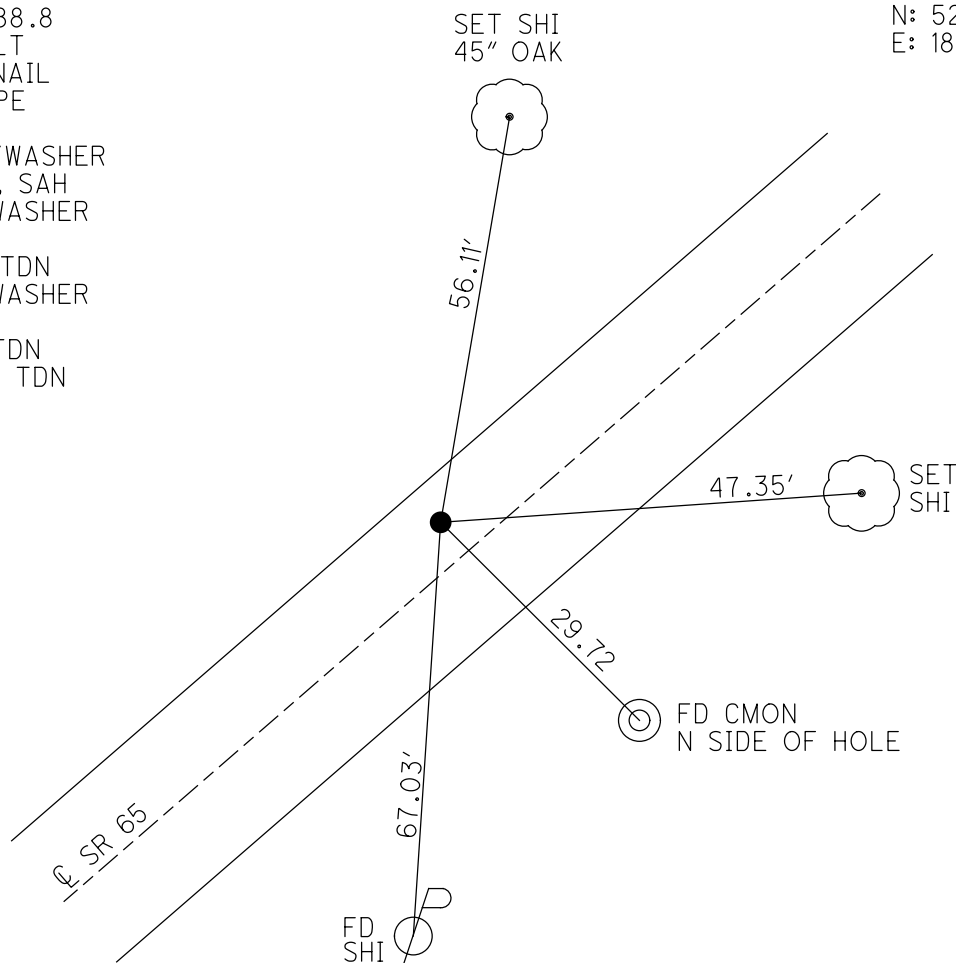

O.D.O.T. DISTRICT 2 SURVEY OFFICE

PERSONNEL

NOTES

H.C.

R.C.

HUSS

HOMAN

MIKLOVIC

REFERENCE NO. 32-B

DATE

9-13-05

WEATHER

SUNNY

TEMP.

86°

SHEET 12 OF 14

ROUTE

S.R. 65

COUNTY

WOOD

TOWNSHIP

PERRYSBURG

SECTION

RIVER TRACT

~~T-7-N~~ ~~R-11-E~~

Town 3, 12 mile Res.

TYPE MONUMENT

PK NAIL

ON SURFACE - ~~BELOW~~

ON


LEFT - ~~C PAVT~~ RIGHT

S.7' LT.

8.3' TO LT EDGE PAVEMENT

S.L.M.


1142+70

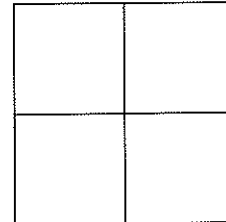

RECORD
PK NAIL WAS SET
OVER I. PIPE
P.I. STA 138+88.8 (1937)
DELTA=0°30' LT.

FD N&S
SW/S
30" OAK

SET MAG NAILS
& WASHERS
10-27-05
SAH

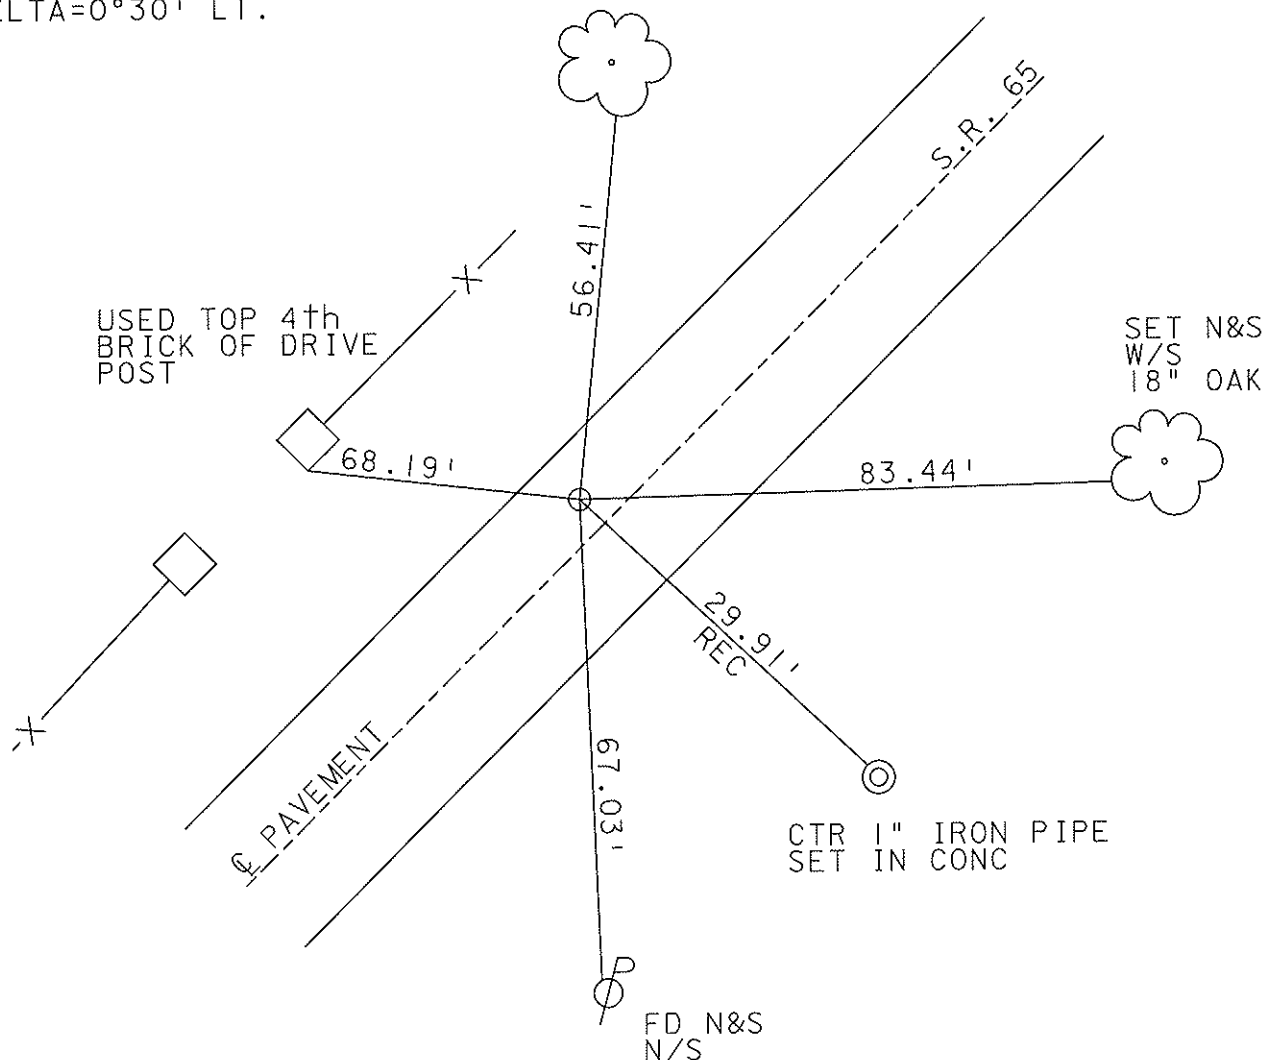

O.D.O.T. DISTRICT 2 SURVEY OFFICE

PERSONNEL

REFERENCE NO. 32 B

SHEET OF

NOTES BARNHISEL

H.C. Reed

DATE 5-3-88

ROUTE 65

R.C. Loehrke

WEATHER Sunny

COUNTY Woods

Hoffman

TEMP. +62°

TOWNSHIP Perryburg

SECTION R.T. 74

T. 8 N. R. 11 E


TYPE MONUMENT P.K. NAIL

ON SURFACE - BELOW yes

LEFT-CL PAV'T. - RIGHT 4.5

11.1 TO LT EDGE PAVEMENT

S.L.M. 1142+70

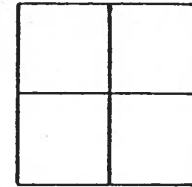

RECORD

Set P.K. OVER IRON
PIPE

(1937) STA. 138+88.8


A = 0° - 30' LT

Set P.K. & Washer

8-29-88
m B.

Set Shi
1" 30" OAK
SW/S

Wood Fence
DRIVE
USED TOP 4" BRICK OF DRIVE
POST

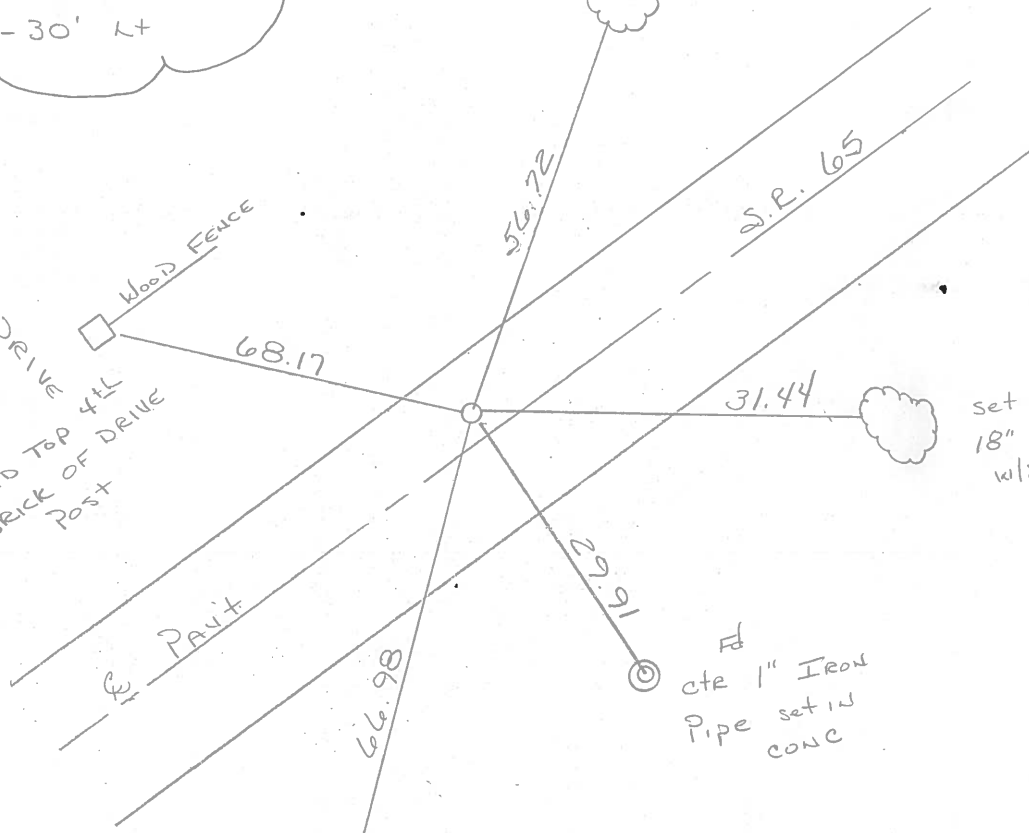

set Shi
N/S

O.D.O.T. DISTRICT 2 SURVEY OFFICE

SHEET


OF

County Wood S.R. 65Date 17 Nov. 80


Township _____

Weather Cloudy

Section _____

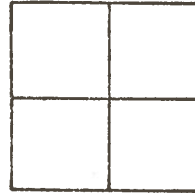Temp. 36°T N, R EPersonnel L. StoneR. MichalskeP. NeuseD. CurtisH. Mead

REF. NO. 32 B

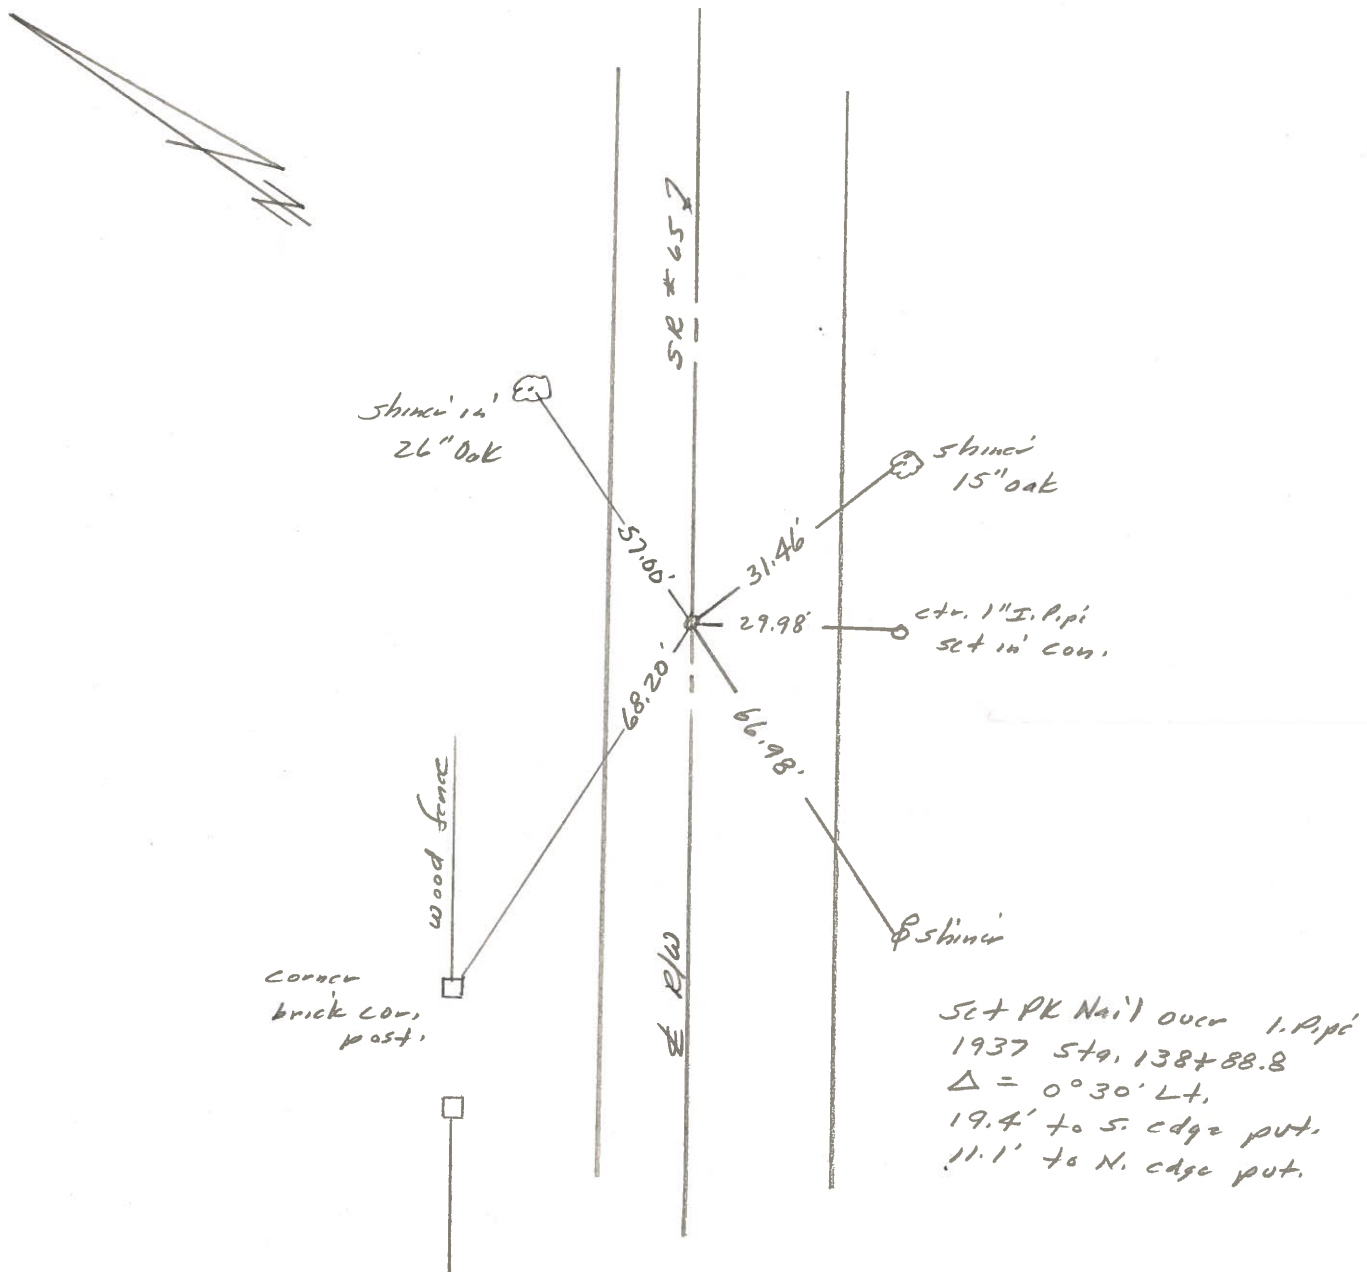

O.D.O.T. DISTRICT 2 SURVEY OFFICE

Sht. 18 of 20
5.2.65

County WOOD

Date 8-1-78

Township PERRYSBURG



Weather CLEAR

Section _____

Temp. +70°

T N, R E

Personnel BURNSIDE

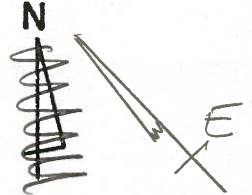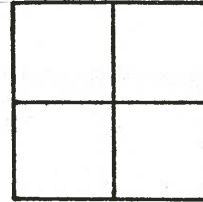

32-B

BOWERS

P.I.
S.L.M. STA = 1142+59.00
OLD STA 138+88.8
 $\Delta = 0^\circ - 30' \text{ LT.}$
OLD TIES TO I. PIPE
GOOD - USED SAME
TO EST. & R/W
SET NAIL & SHI.
4' LT OF CTR. PAVE.

