

O.D.O.T. DISTRICT 2 SURVEY OFFICE (USE ONLY)

PERSONNEL

REFERENCE NO. 32 C

SHEET 14 OF 23

NOTES BARRIER
H.C. MILLER
R.C. BLUBAUGH

DATE 7/1/24
WEATHER SUNNY
TEMP. 70°

ROUTE SR 65
COUNTY WOOD
TOWNSHIP PERRYSBURG
SECTION 71

DWG BY BARRIERE PID 101291

T 3 N R 12 MI RESERVE

TYPE MONUMENT MAG/WASHER

ON SURFACE - BELOW ON

OFFSET $\odot$ PAVEMENT 8.5' LT LT : RT

TO EDGE PAVEMENT

STATION: 1151+22

HORIZ.DATUM: NAD83 (2011)


GEOID: 18

GRID: NORTHING: 703542.789


EASTING: 1673106.583

LDP: NORTHING: 525655.682

EASTING: 183213.512

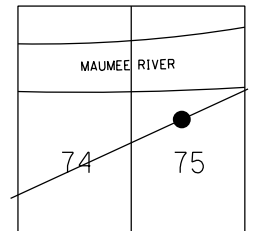

RECORD: P.I.
STA.147+39.55
 $\Delta = 06^{\circ} 28' RT$
P.I. =
SET PK NAIL OVER
BRASS MON
1937
SET MAG/WASHER
10-27-05, SAH
FD MAG/WASHER
REF32C
11-17-22, TDN
FD MAG/WASHER
REF32C
5-8-23, TDN
FD MAG/WASH
REF32C
7/1/24, JAM

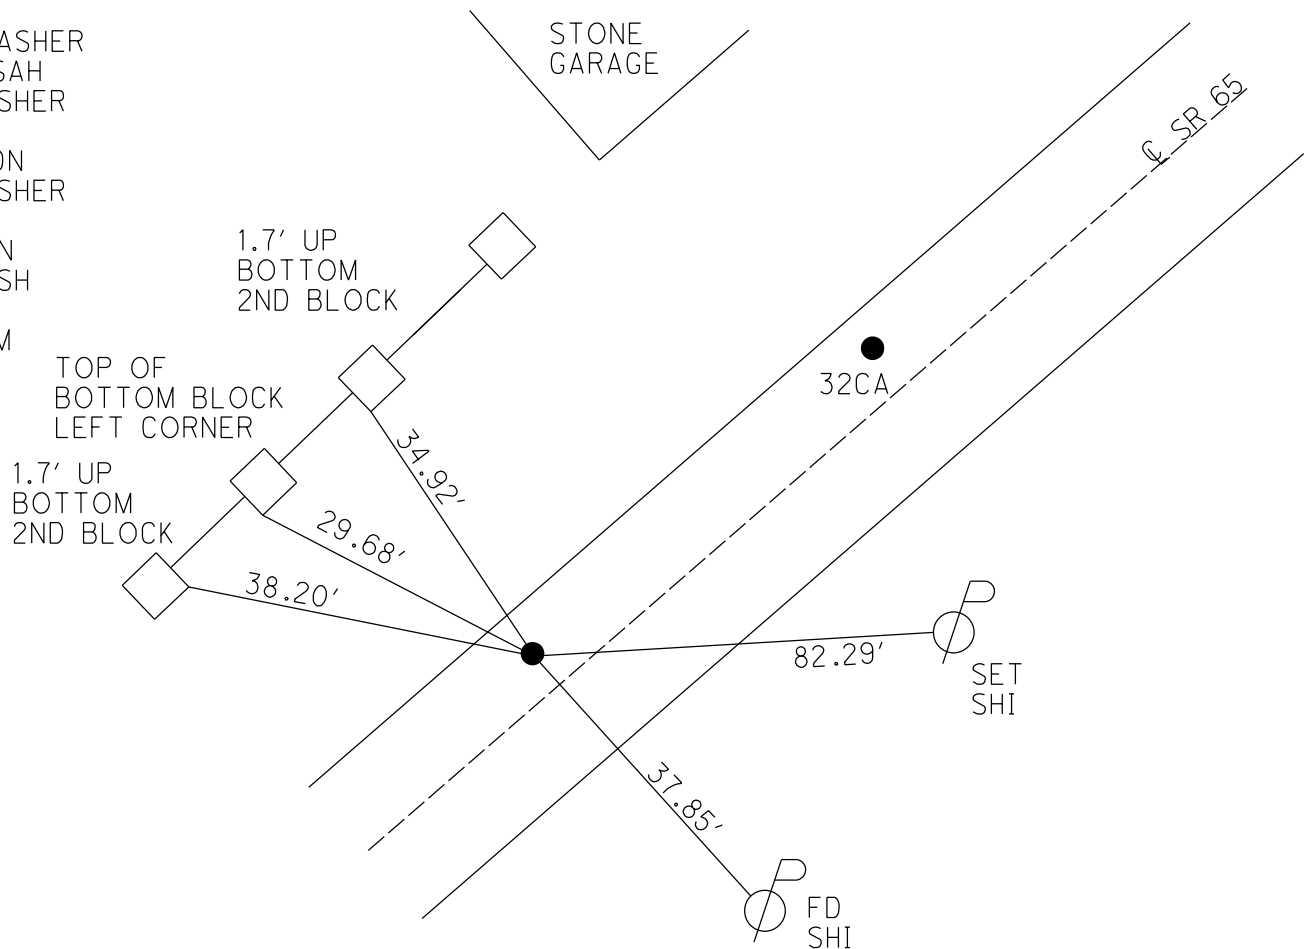

DIST.32C-32CA= 60.43'

O.D.O.T. DISTRICT 2 SURVEY OFFICE (USE ONLY)

PERSONNEL

REFERENCE NO. 32 C

SHEET 12 OF 21

NOTES AUBLE

DATE 5-8-23

ROUTE SR 65

H.C. NIESE

WEATHER CLOUDY

COUNTY WOOD

R.C. AUBLE

TEMP. 55° F

TOWNSHIP PERRYSBURG

SECTION RT 75

DWG BY RHOADES

PID PAVING TRAIN

T 3

12 MILE RESERVE

TYPE MONUMENT MAG/WASHER

ON SURFACE - ~~BELOW~~ ON

OFFSET Q PAVEMENT 8.5' LT : RT

3.7' TO LT EDGE PAVEMENT



STATION: 1151+22

HORZ.DATUM: NAD83 2011

GEOID: NAVD88 2018

GRID: NORTHING: 703542.789

EASTING: 1673106.583

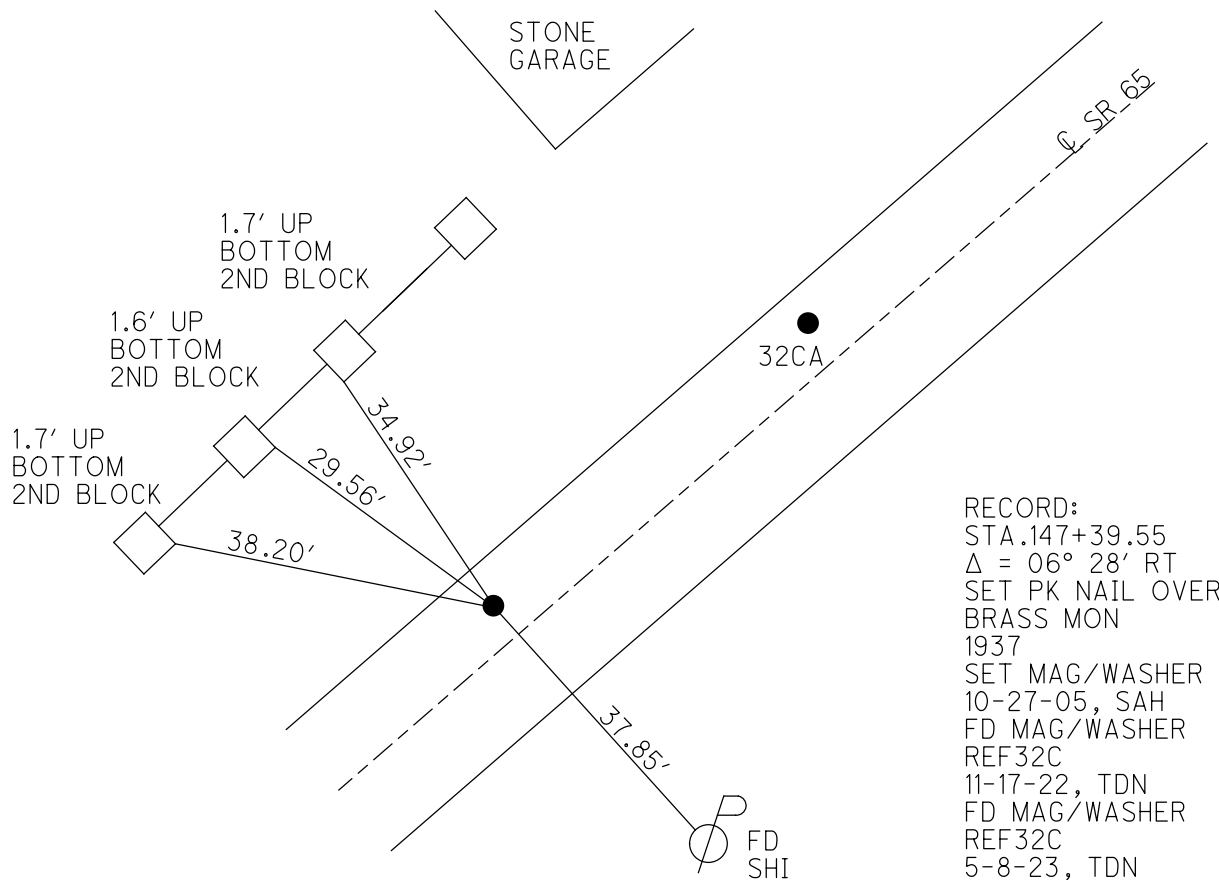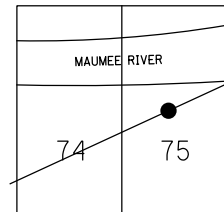

WOOD LPD:
N: 525655.669
E: 183213.509

RECORD:
STA.147+39.55
 $\Delta = 06^\circ 28' RT$
SET PK NAIL OVER
BRASS MON
1937
SET MAG/WASHER
10-27-05, SAH
FD MAG/WASHER
REF32C
11-17-22, TDN
FD MAG/WASHER
REF32C
5-8-23, TDN

O.D.O.T. DISTRICT 2 SURVEY OFFICE

PERSONNEL

REFERENCE NO. 32-C SHEET 13 OF 14

NOTES

HUSS

DATE

9-14-05

ROUTE

S.R. 65

H.C.

NUHFER

WEATHER

SUNNY

COUNTY

WOOD

R.C.

HOMAN

TEMP.

76°

TOWNSHIP PERRYSBURG

SECTION RIVER TRACT

~~T-7-N R-1-E~~

Town 3, 12 mile Res.

TYPE MONUMENT

PK NAIL

ON SURFACE - ~~BELOW~~

ON

LEFT - ~~Q PAVT~~ RIGHT

A 8.5' LT

B 5.7' LT


TO LT EDGE PAVEMENT

A 3.7'

B 6.2'

S.L.M.

A 1151+22 B 1151+82

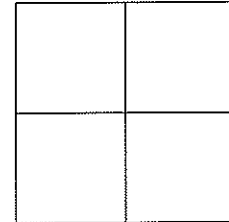

RECORD

PT A

SET PK NAIL OVER

BRASS MON

STA 147+39.55 (1937)

DELTA=06°28' RT.

PT B

ORIGIN UNKNOWN

SET N&S

SW/S

40" COTTONWOOD

SET MAG NAILS

& WASHERS

10-27-05

SAH

FD N&S

S/S

12"

STONE GARAGE

TOP OF 1st BLOCK 2.4' UP

BOTTOM OF 2nd BLOCK 2.5' UP


BOTTOM OF 2nd BLOCK 2.5' UP

BOTTOM OF 2nd BLOCK 2.5' UP

PAVEMENT

SET N&S NW/S

SET N&S W/S

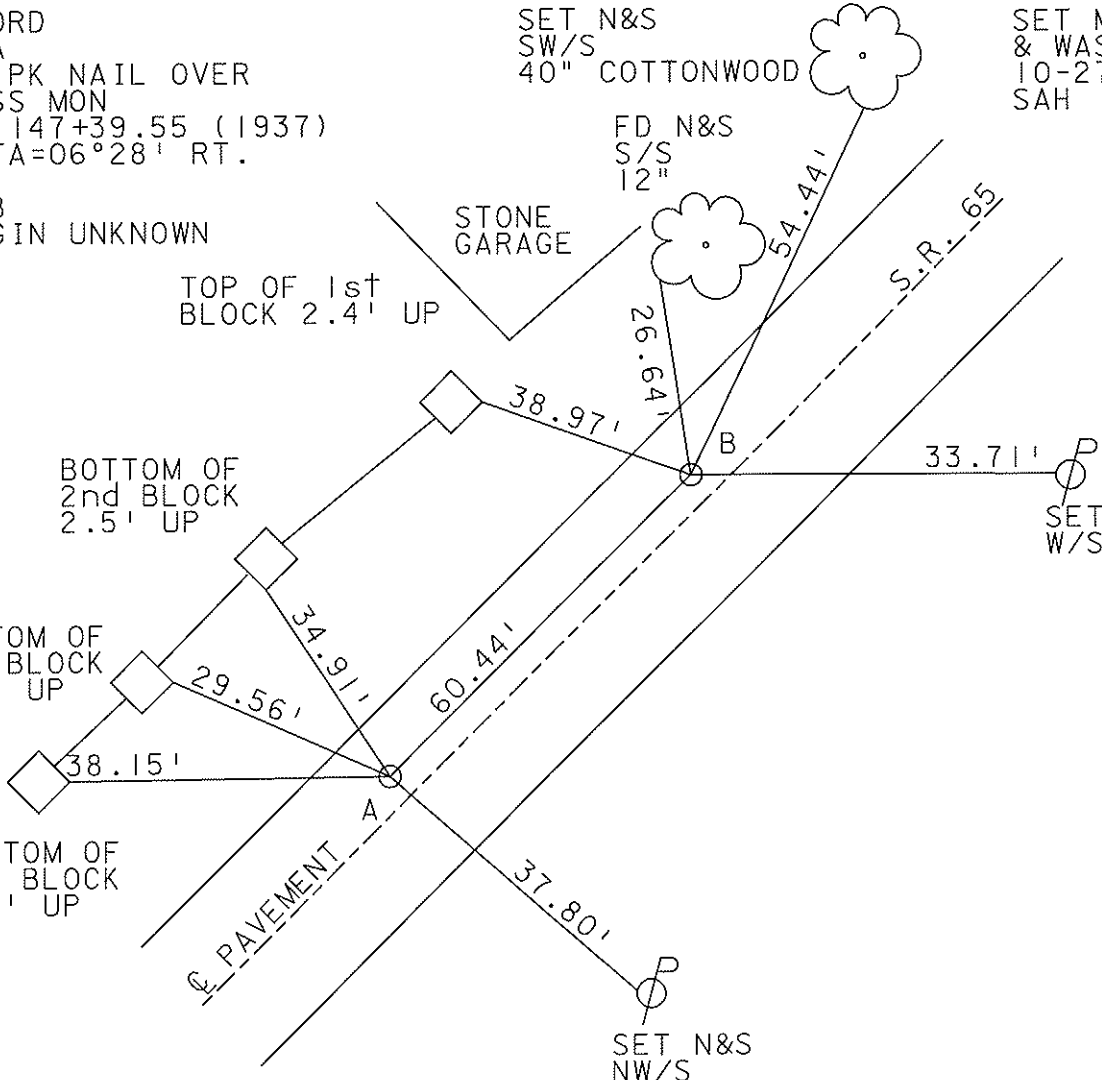

O.D.O.T. DISTRICT 2 SURVEY OFFICE

PERSONNEL

REFERENCE NO. 32 C

SHEET OF

NOTES BARNHISEL

H.C. Reed

DATE 5-3-88

ROUTE 65

R.C. koehrke

WEATHER Sunny

COUNTY WOOD

HOFFMAN

TEMP. +62°

TOWNSHIP Perrysburg

SECTION R.T. 75

T. 8 N. R. 11 E



TYPE MONUMENT P.K. NAILS

ON SURFACE - BELOW yes

LEFT - CL PAV'T. - RIGHT PT A 8.9 PT B 6.4

(A) 6.5
(B) 9.5 TO 4 EDGE PAVEMENT


S.L.M. 1151+22

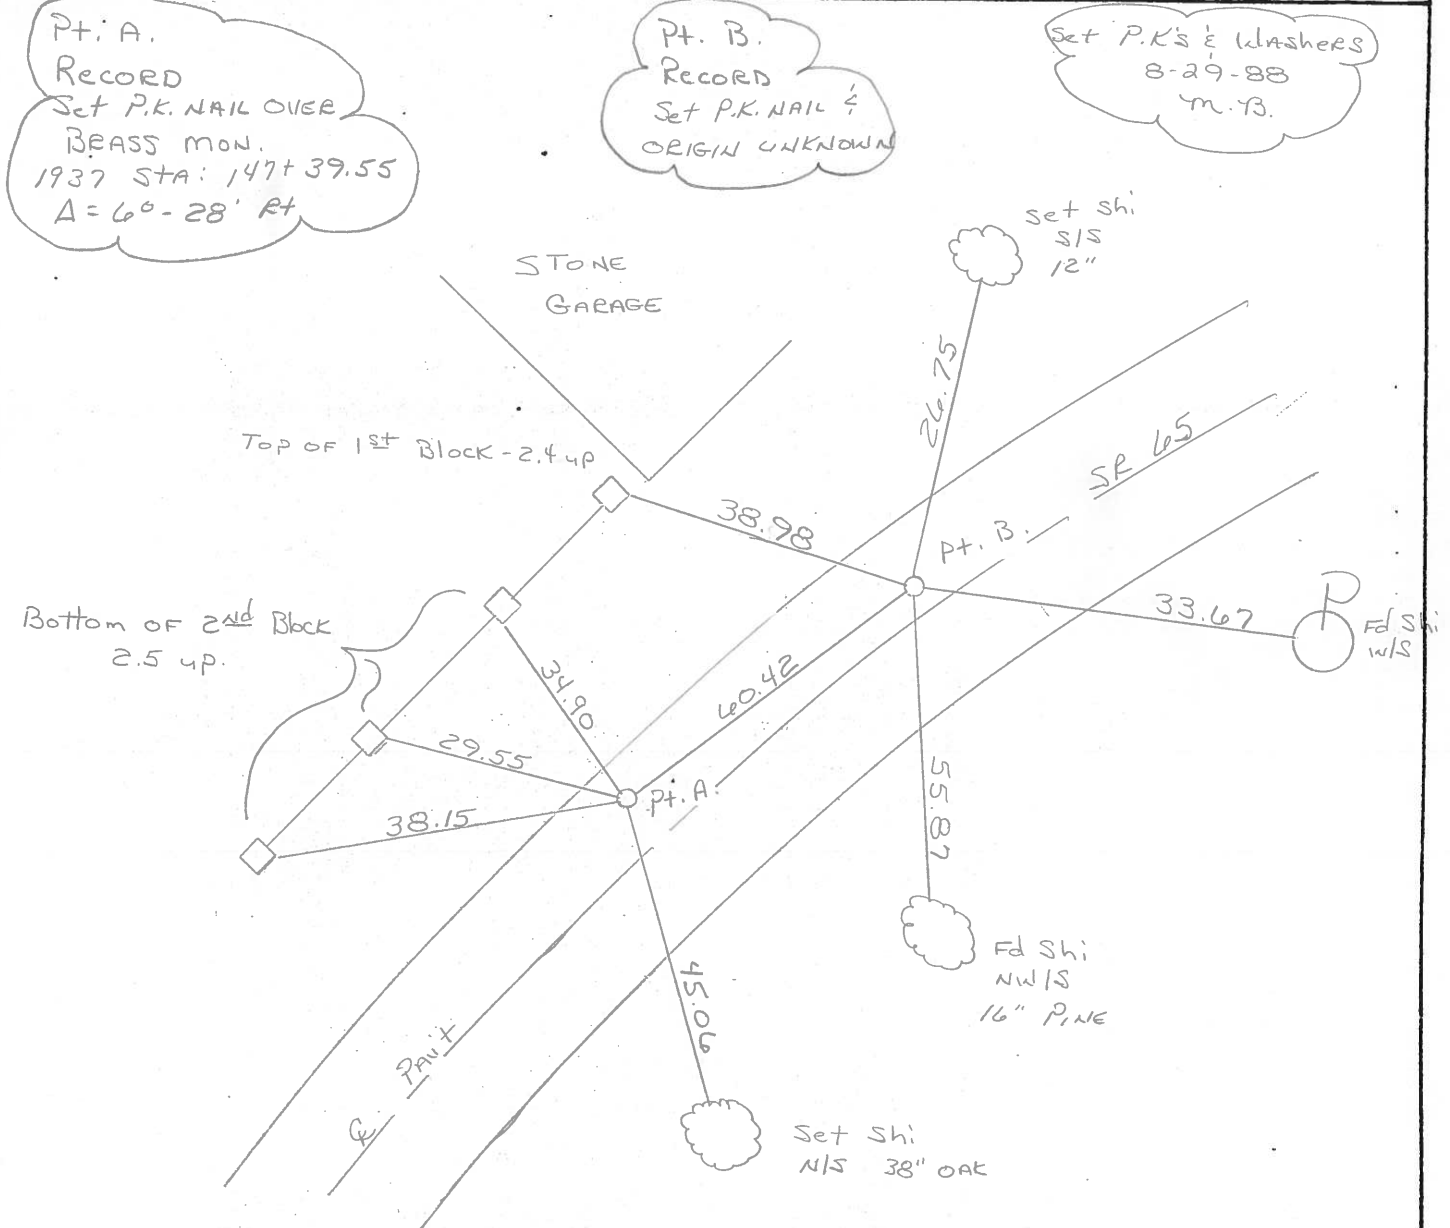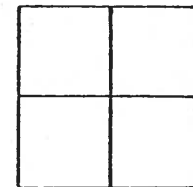


County Wood S.R. 65

Township _____

Section _____

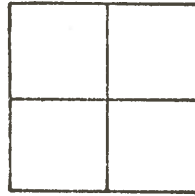T N, R EPersonnel L. StoneR. MichalakP. NeuserD. CurtisH. MoadDate 17 Nov. 80Weather CloudyTemp. 37°

REF. NO. 32 C

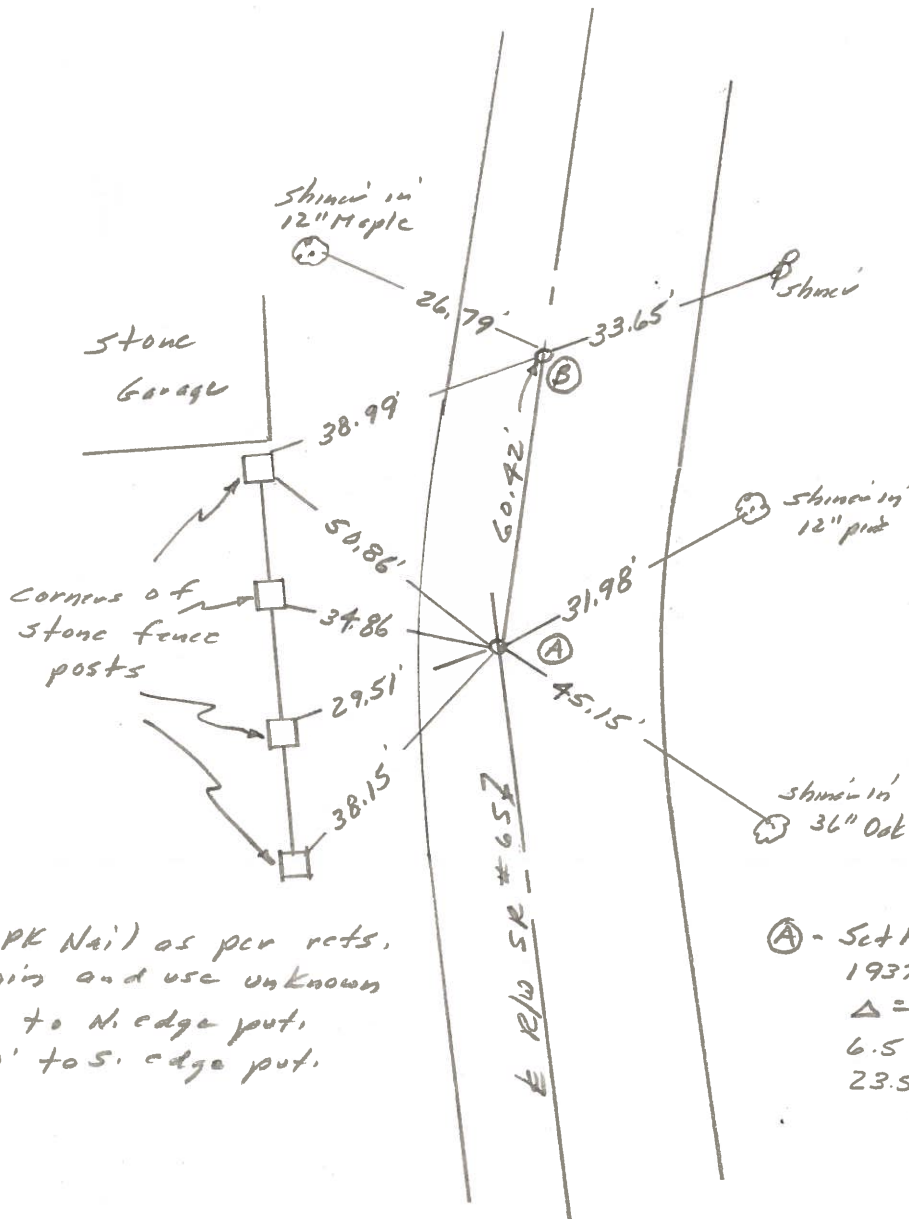

ODOT DISTRICT 2 SURVEY OFFICE

Sht. 19 of 20
S.R. 65

County WOOD

Date 8-1-78

Township PERRYSBURG

Weather CLEAR

Section _____



Temp. +73°

T. N, R. E

Personnel BURNSIDE

BOWERS

32-C

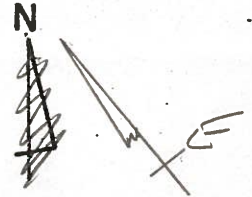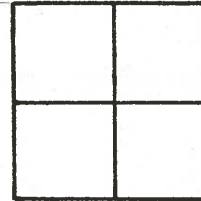

FD. P.K.
ORIGIN & USE
UNKNOWN

