

O.D.O.T. DISTRICT 2 SURVEY OFFICE (USE ONLY)

PERSONNEL

REFERENCE NO. 32 CA

SHEET 15 OF 23

NOTES BARRIER
H.C. MILLER
R.C. BLUBAUGH

DATE 7/1/24
WEATHER SUNNY
TEMP. 70°

ROUTE SR 65
COUNTY WOOD
TOWNSHIP PERRYSBURG
SECTION 75
T 3 N R 12 MI RESERVE

DWG BY BARRIERE PID 101291

TYPE MONUMENT MAG/WASHER

ON SURFACE - BELOW ON

OFFSET $\varnothing$ PAVEMENT 5.7' LT LT : RT

TO EDGE PAVEMENT

STATION: 1151+82

HORIZ.DATUM: NAD83 (2011)


GEOID: 18

GRID: NORTHING: 703578.847


EASTING: 1673155.060

LDP: NORTHING: 525692.317

EASTING: 183261.45

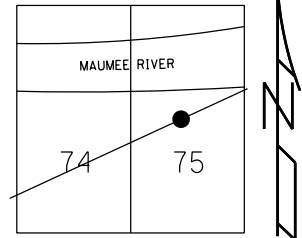

RECORD:
ORIGIN UNKNOWN
9/14/05, DCH
FD MAG/WASHER
REF32CA
5-8-23, TDN
10/12/23, TDN
FD MAG/WASH
REF32CA
7/1/24, JAM

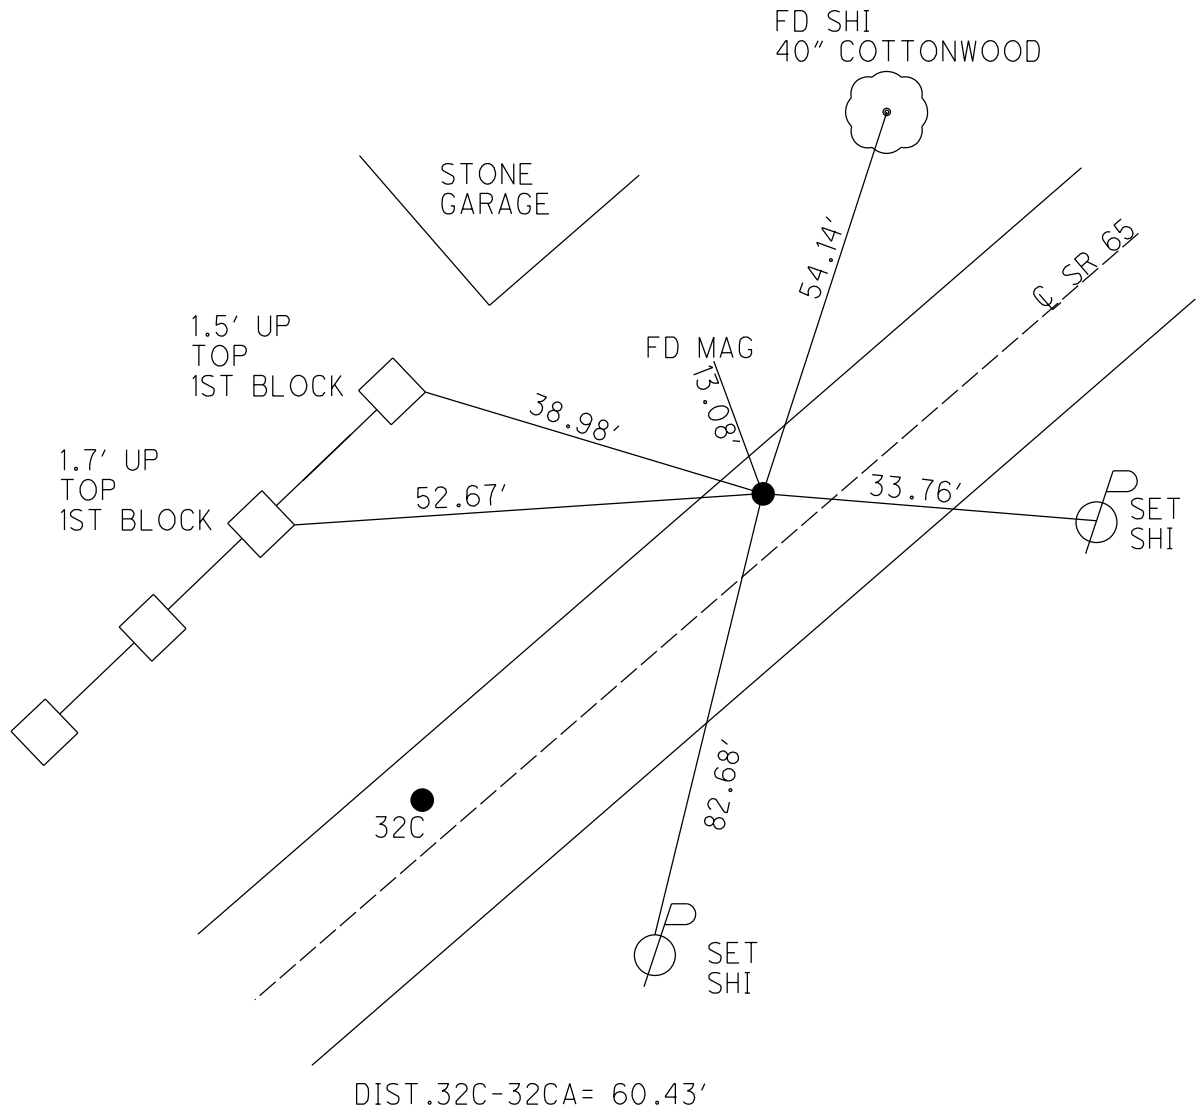

O.D.O.T. DISTRICT 2 SURVEY OFFICE (USE ONLY)

PERSONNEL

REFERENCE NO. 32 CA

SHEET 13 OF 21

NOTES AUBLE

DATE 5-8-23

ROUTE SR 65H.C. NIESE

WEATHER CLOUDY

COUNTY WOOD

R.C. AUBLE

TEMP. 55° F

TOWNSHIP PERRYSBURGDWG BY RHOADESPID PAVING TRAIN

T 3 12 MILE RESERVE

TYPE MONUMENT MAG/WASHER

ON SURFACE - ~~BELOW~~ _____ ON

OFFSET @ PAVEMENT 5.7' LT : RT


6.2' TO LT EDGE PAVEMENT

STATION: 1151+82

HORZ.DATUM: NAD83 2011

GEOID: NAVD88 2018

GRID: NORTHING: 703578.847

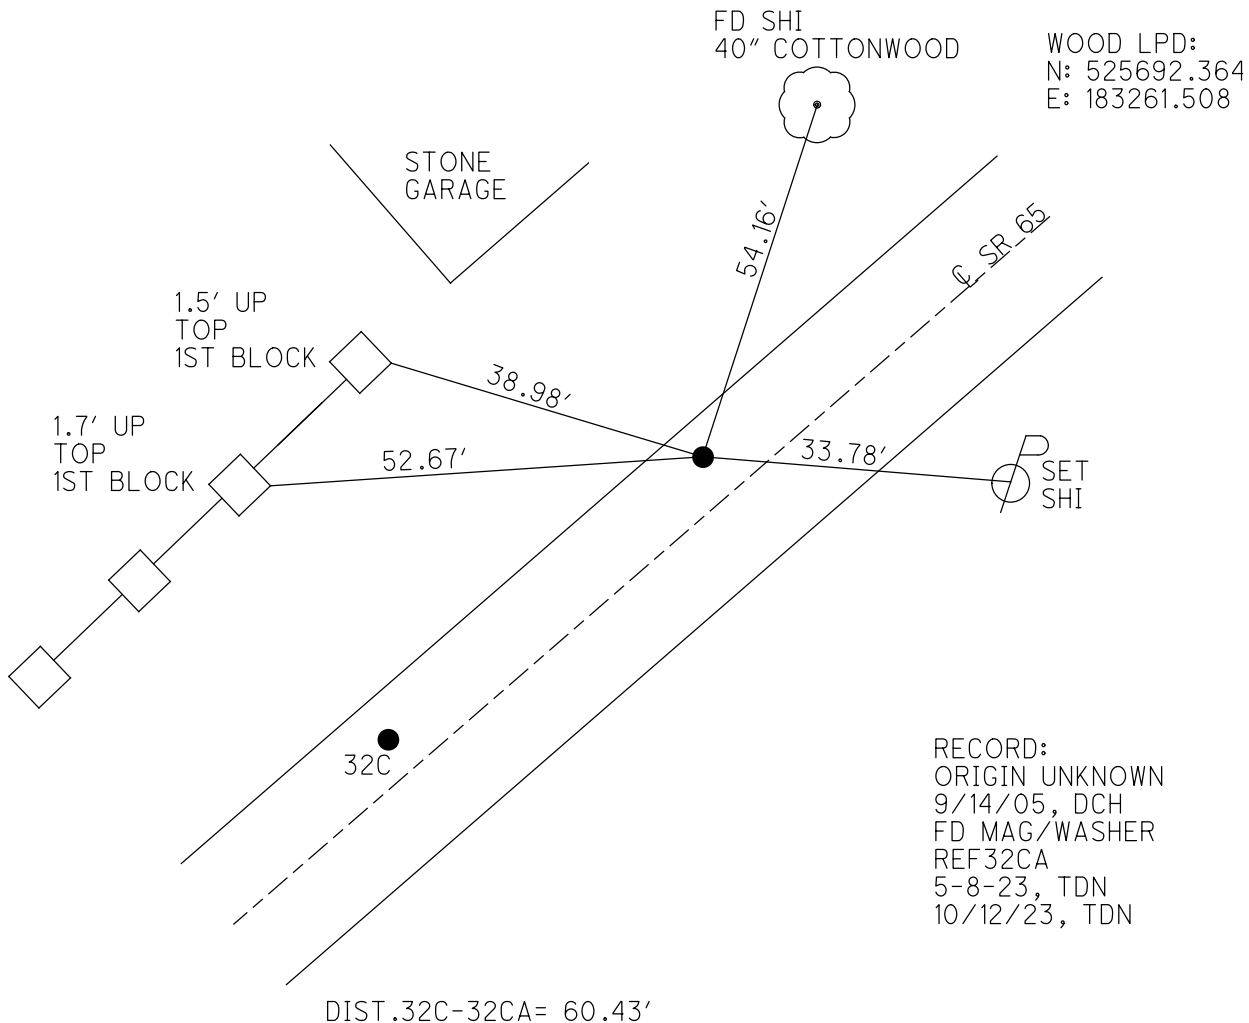EASTING: 1673155.060

O.D.O.T. DISTRICT 2 SURVEY OFFICE

PERSONNEL

REFERENCE NO. 32-C SHEET 13 OF 14

NOTES

HUSS

DATE

9-14-05

ROUTE

S.R. 65

H.C.

NUHFER

WEATHER

SUNNY

COUNTY

WOOD

R.C.

HOMAN

TEMP.

76°

TOWNSHIP PERRYSBURG

SECTION RIVER TRACT

~~T-7-N R-1-E~~

Town 3, 12 mile Res.

TYPE MONUMENT

PK NAIL

ON SURFACE - ~~BELOW~~

ON

LEFT - ~~Q PAVT~~ RIGHT

A 8.5' LT

B 5.7' LT


TO LT EDGE PAVEMENT

A 3.7'

B 6.2'

S.L.M.

A 1151+22 B 1151+82

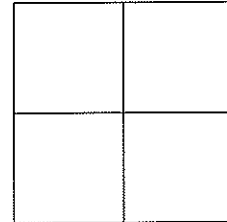

RECORD

PT A

SET PK NAIL OVER

BRASS MON

STA 147+39.55 (1937)

DELTA=06°28' RT.

PT B

ORIGIN UNKNOWN

SET N&S

SW/S

40" COTTONWOOD

SET MAG NAILS

& WASHERS

10-27-05

SAH

FD N&S

S/S

12"

STONE GARAGE

TOP OF 1st
BLOCK 2.4' UP

BOTTOM OF
2nd BLOCK
2.5' UP


BOTTOM OF
2nd BLOCK
2.5' UP

BOTTOM OF
2nd BLOCK
2.5' UP

PAVEMENT

SET N&S
NW/S

SET N&S
W/S

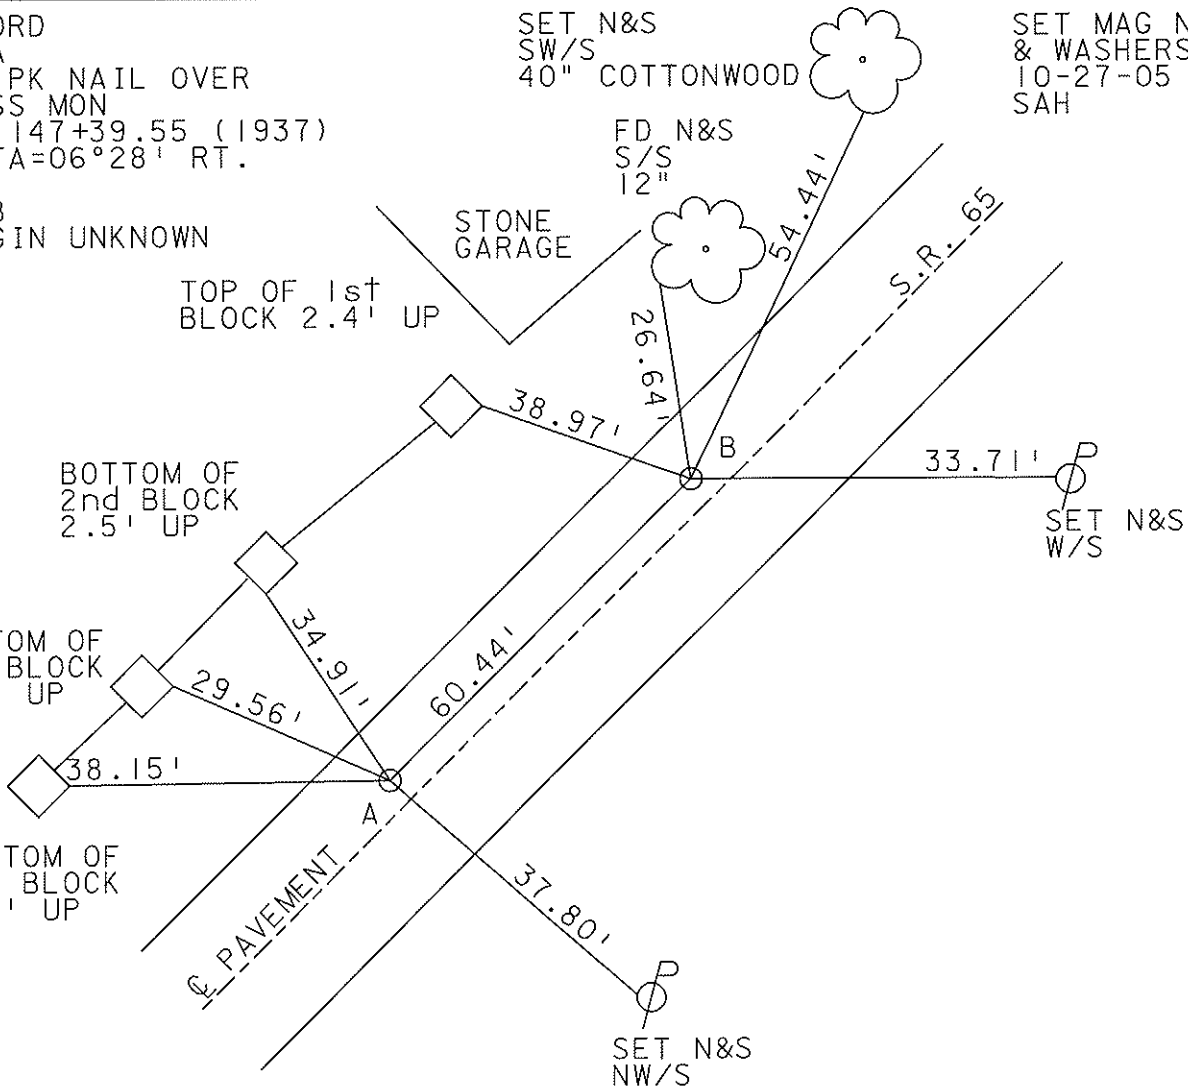

O.D.O.T. DISTRICT 2 SURVEY OFFICE

PERSONNEL

REFERENCE NO. 32 C

SHEET OF

NOTES BARNHISEL

H.C. Reed

DATE 5-3-88

ROUTE 65

R.C. koehrke

WEATHER Sunny

COUNTY WOOD

HOFFMAN

TEMP. +62°

TOWNSHIP Perrysburg

SECTION R.T. 75

T. 8 N. R. 11 E


TYPE MONUMENT P.K. NAILS

ON SURFACE - BELOW yes

LEFT - CL PAV'T. - RIGHT PT A 8.9 PT B 6.4

(A) 6.5
(B) 9.5 TO 4 EDGE PAVEMENT

S.L.M. 1151+22

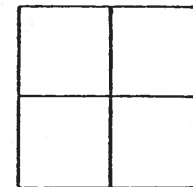

Pt. A.

RECORD

Set P.K. NAIL OVER

BRASS MON.

1937 STA: 147+39.55

$\Delta = 60 - 28' \text{ Rt}$

Pt. B.

RECORD

Set P.K. NAIL &

ORIGIN UNKNOWN

Set P.K's & Washers


8-29-88

m.B.

STONE
GARAGE

TOP OF 1st Block - 2.4 up

Bottom of 2nd Block
2.5 up.

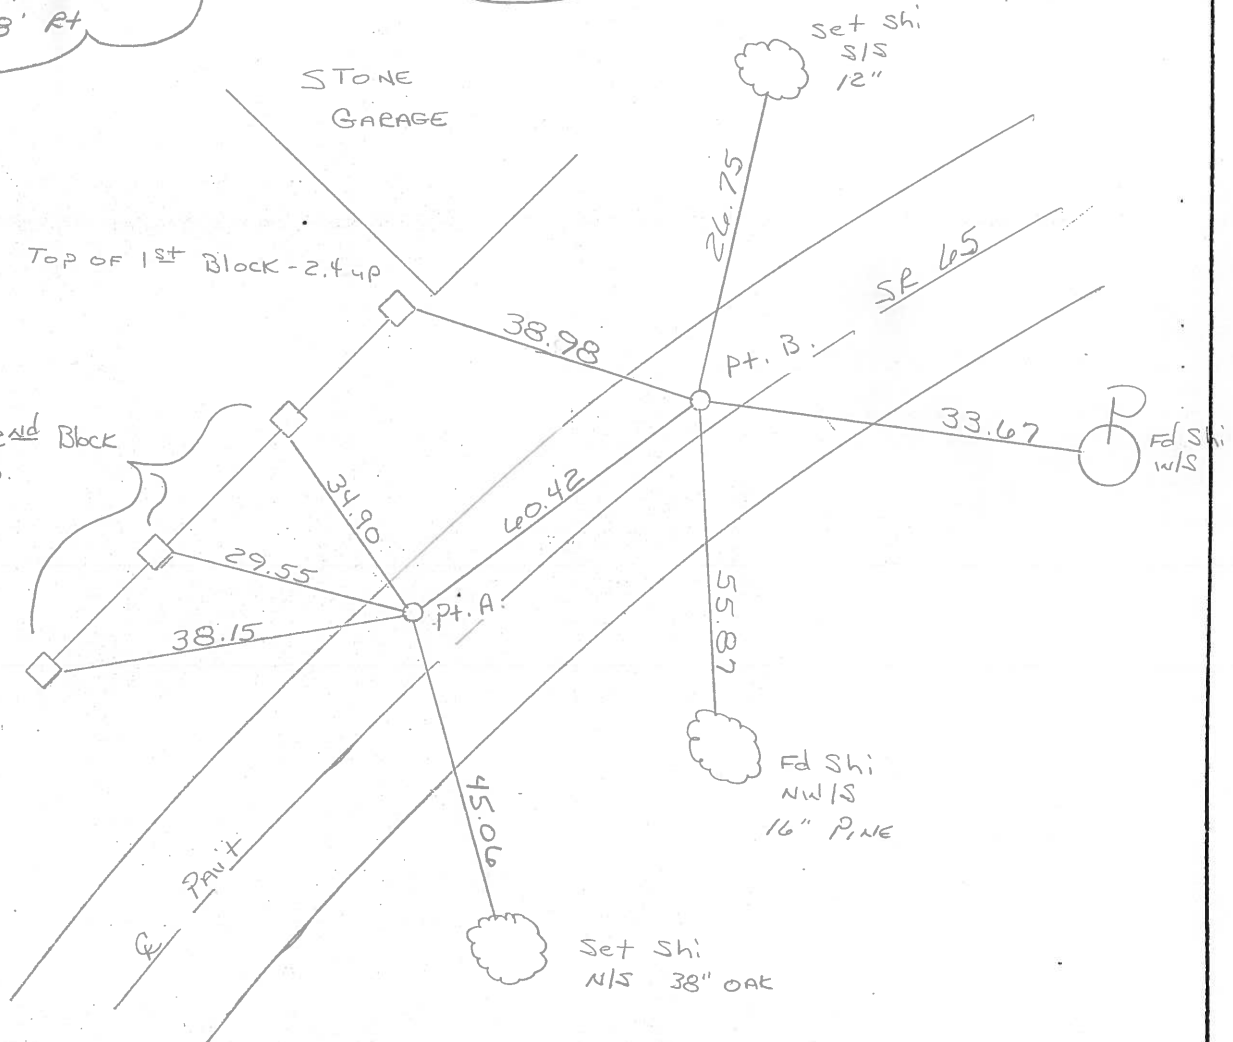

O.D.O.T. DISTRICT 2 SURVEY OFFICE

SHEET

OF

County Wood S.R. 65

Township _____

Section _____

T N, R E

Personnel L. Stone

R. Michalak

P. Neuser


D. Curtis

H. Moad


Date 17 Nov. 80

Weather Cloudy

Temp. 37°

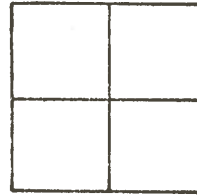

REF. NO. 32 C

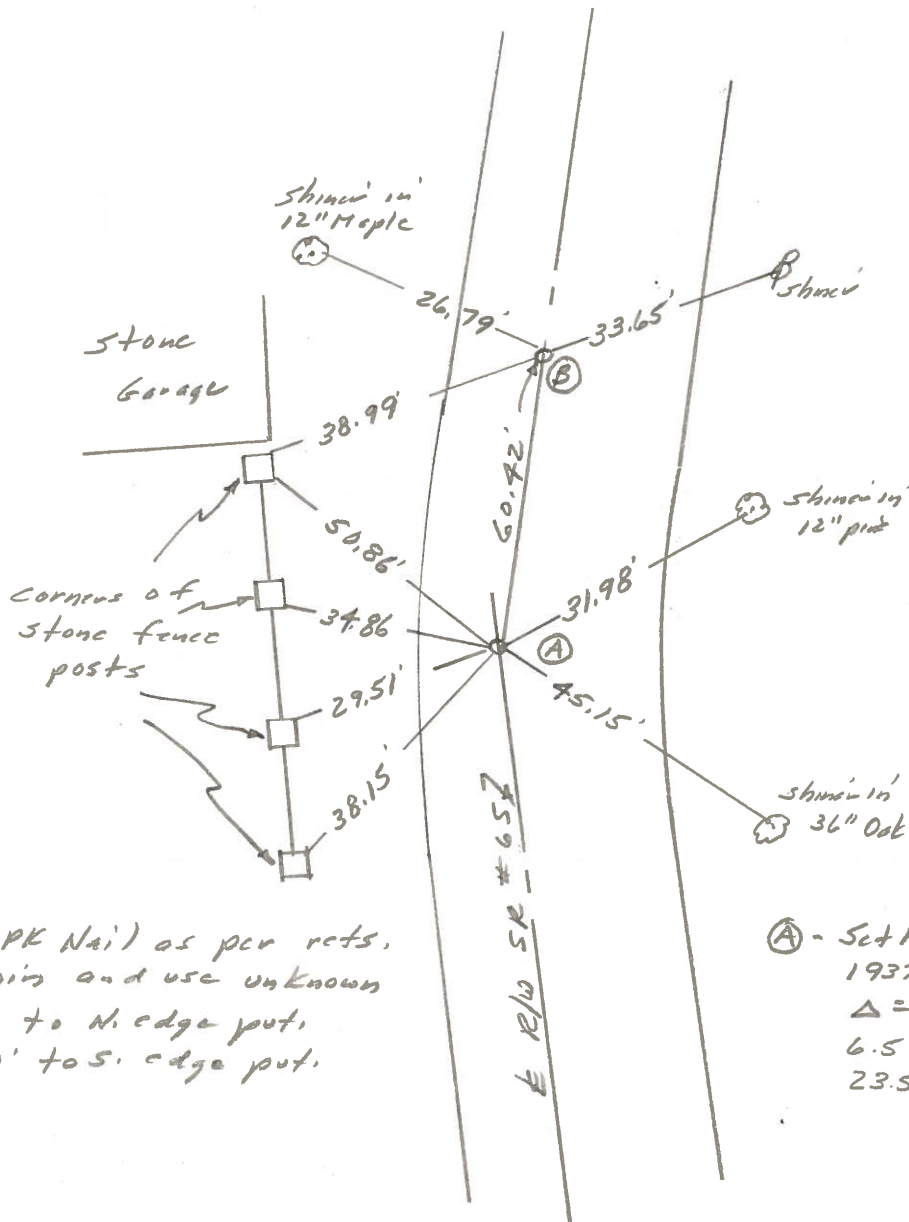

Ⓑ - Set PK Nail as per rets.
Origin and use unknown
9.5' to N. edge put.
21.0' to S. edge put.

Ⓐ - Set PK Nail over Brass Mon.
1937 Sta. 147+39.55
 $\Delta = 6^{\circ} 28' \text{ Rt.}$
6.5' to N. edge put.
23.5' to S. edge put.

ODOT DISTRICT 2 SURVEY OFFICE

Sht. 19 of 20
S.R. 65

County WOOD

Date 8-1-78

Township PERRYSBURG

Weather CLEAR

Section _____



Temp. +73°

T. N, R. E

Personnel BURNSIDE

BOWERS

32-C

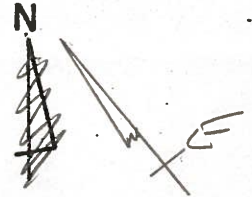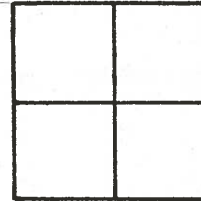

FD. P.K.
ORIGIN & USE
UNKNOWN

