

O.D.O.T. DISTRICT 2 SURVEY OFFICE (USE ONLY)

PERSONNEL

REFERENCE NO. 32 CB

SHEET 16 OF 23

NOTES BARRIERE
H.C. MILLER
R.C. BLUBAUGH

DATE 7/1/24
WEATHER SUNNY
TEMP. 68°

ROUTE SR 65
COUNTY WOOD
TOWNSHIP PERRYSBURG
SECTION 75
T 3 N R 12 MI RESERVE

DWG BY BARRIERE PID 101291

TYPE MONUMENT MAG SHANK

ON SURFACE - BELOW ON

OFFSET $\varnothing$ PAVEMENT 0.3' LT LT : RT

TO EDGE PAVEMENT

STATION: 1160+35

HORIZ.DATUM: NAD83 (2011)


GEOID: 18

GRID: NORTHING: 704083.837


EASTING: 1673837.423

LDP: NORTHING: 526206.366

EASTING: 183937.184

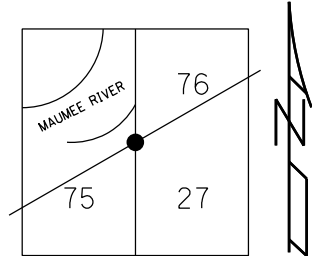

RECORD:
ORIGIN UNKNOWN
FD P.K.NAIL
9/14/05, DCH
SET MAG/WASHER
10/27/05, SAH
FD MAG SHANK
REF32CB
5/8/23, TDN
10/12/23, TDN
FD MAG SHANK
REF32CB
7/1/24, JAM

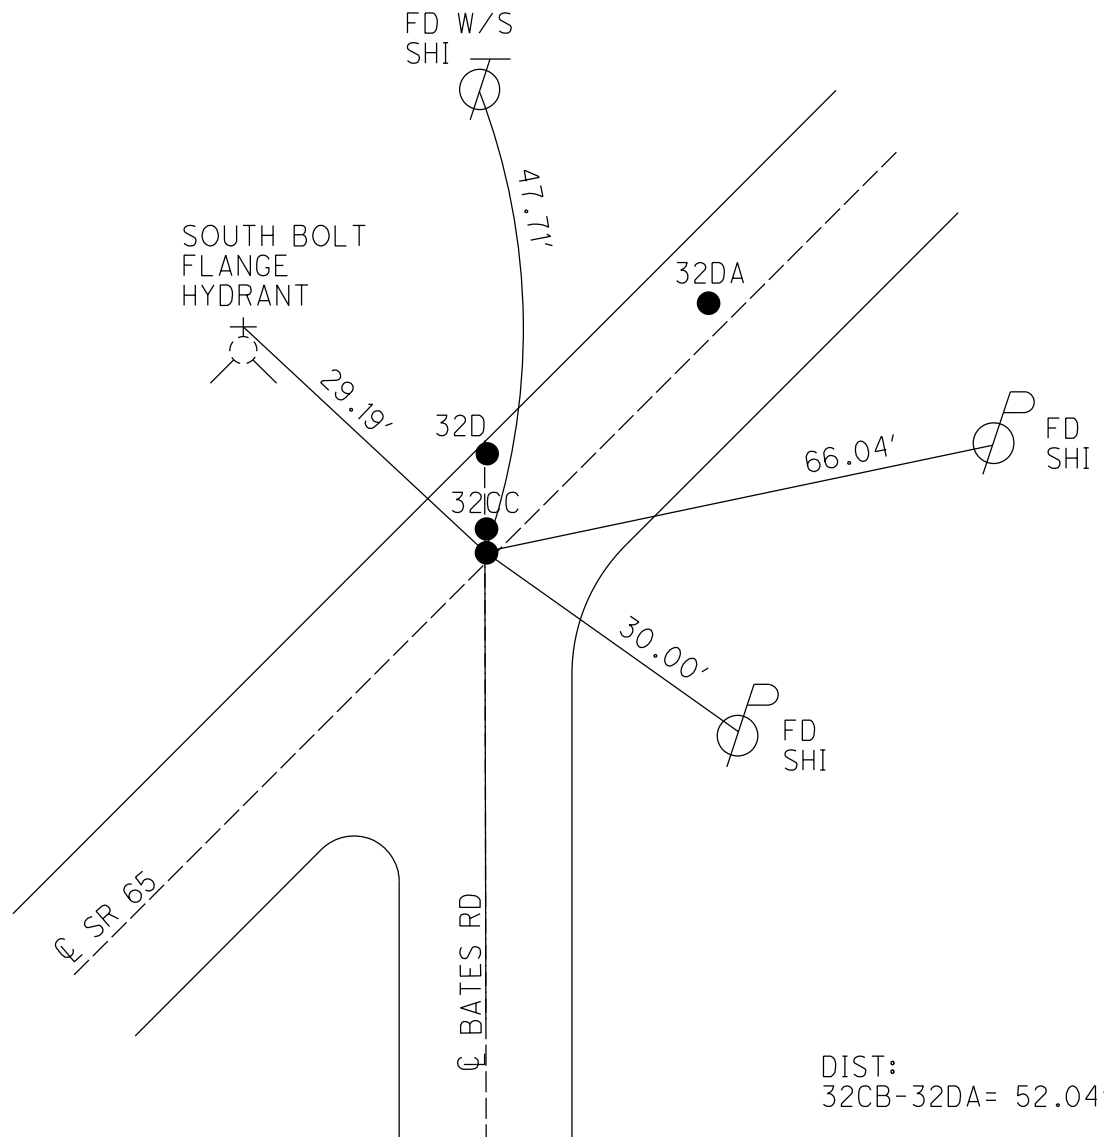

PERSONNEL

REFERENCE NO. 32 CB

SHEET 14 OF 21

NOTES AUBLE

DATE 5-8-23

ROUTE SR 65

H.C. NIESE

WEATHER CLOUDY

COUNTY WOOD

R.C. AUBLE

TEMP. 55° F

TOWNSHIP PERRYSBURGSECTION RT 75DWG BY RHOADESPID PAVING TRAIN

T_3

12 MILE RESERVE

TYPE MONUMENT MAG SHANK

ON SURFACE - ~~BELOW~~ _____ ON

OFFSET @ PAVEMENT 0.3' LT : RT


10.8' TO LT EDGE PAVEMENT

STATION: 1160+35

HORZ.DATUM: NAD83 2011


GEOID: NAVD88 2018

GRID: NORTHING: 704083.837

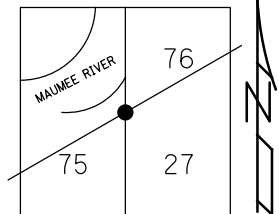EASTING: 1673837.423

RECORD:
ORIGIN UNKNOWN
FD P.K.NAIL
9/14/05, DCH
SET MAG/WASHER
10/27/05, SAH
FD MAG SHANK
REF32CB
5/8/23, TDN
10/12/23, TDN

WOOD LPD:
N: 526206.336
E: 183937.179

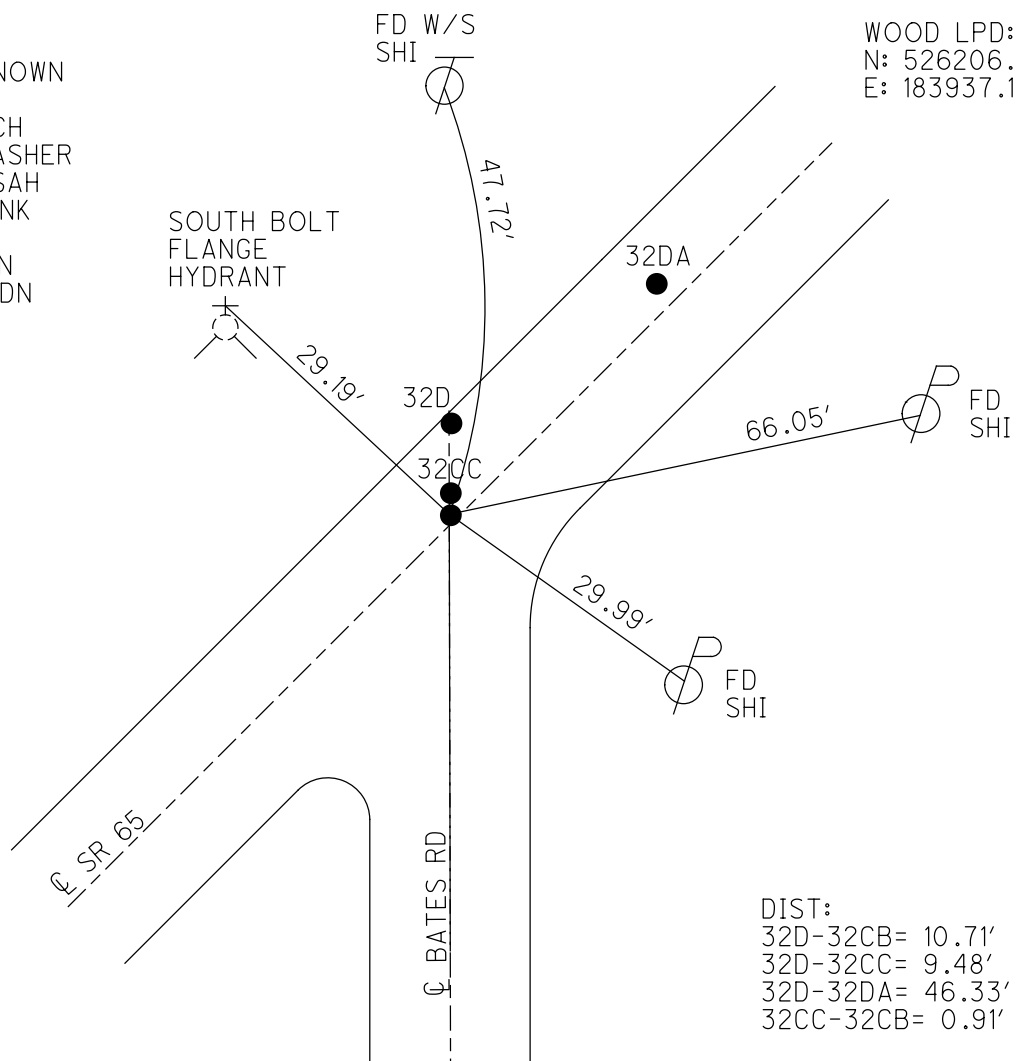

DIST:
32D-32CB= 10.71'
32D-32CC= 9.48'
32D-32DA= 46.33'
32CC-32CB= 0.91'

O.D.O.T. DISTRICT 2 SURVEY OFFICE

PERSONNEL

REFERENCE NO. 32-D

SHEET 14 OF 14

NOTES

HUSS

DATE

9-14-05

ROUTE

S.R. 65

H.C.

NUHFER

WEATHER

SUNNY

COUNTY

WOOD

R.C.

HOMAN

TEMP.

78°

TOWNSHIP

PERRYSBURG

SECTION

RIVER TRACT

~~T-7-N R-11-E~~

Town 3, 12 mile Res.

TYPE MONUMENT

A- IRON PIN B-SM RR SPIKE

ON SURFACE - ~~BELOW~~

C & D PK NAILS

LEFT - ~~C PART~~ RIGHT

A-6" DOWN B, C, & D ON SURFACE

TO LT EDGE PAVEMENT

A-10.9' LT B-1.2' LT


C-1.2' LT D-0.3' LT

S.L.M.

A-1.0' B-10.9'

C-9.9' D-10.8'

A 1160+35

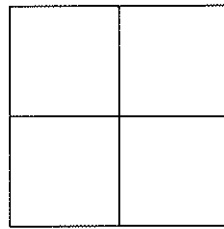

RECORD

PT A SET PK NAIL @ BATES RD

STA 156+49.15 (1937)

DELTA= 0°0'

RECORD PT B

STA 157+0085

PT C & D


ORIGIN UNKNOWN

SET MAG NAILS

& WASHERS

10-27-05

SAH

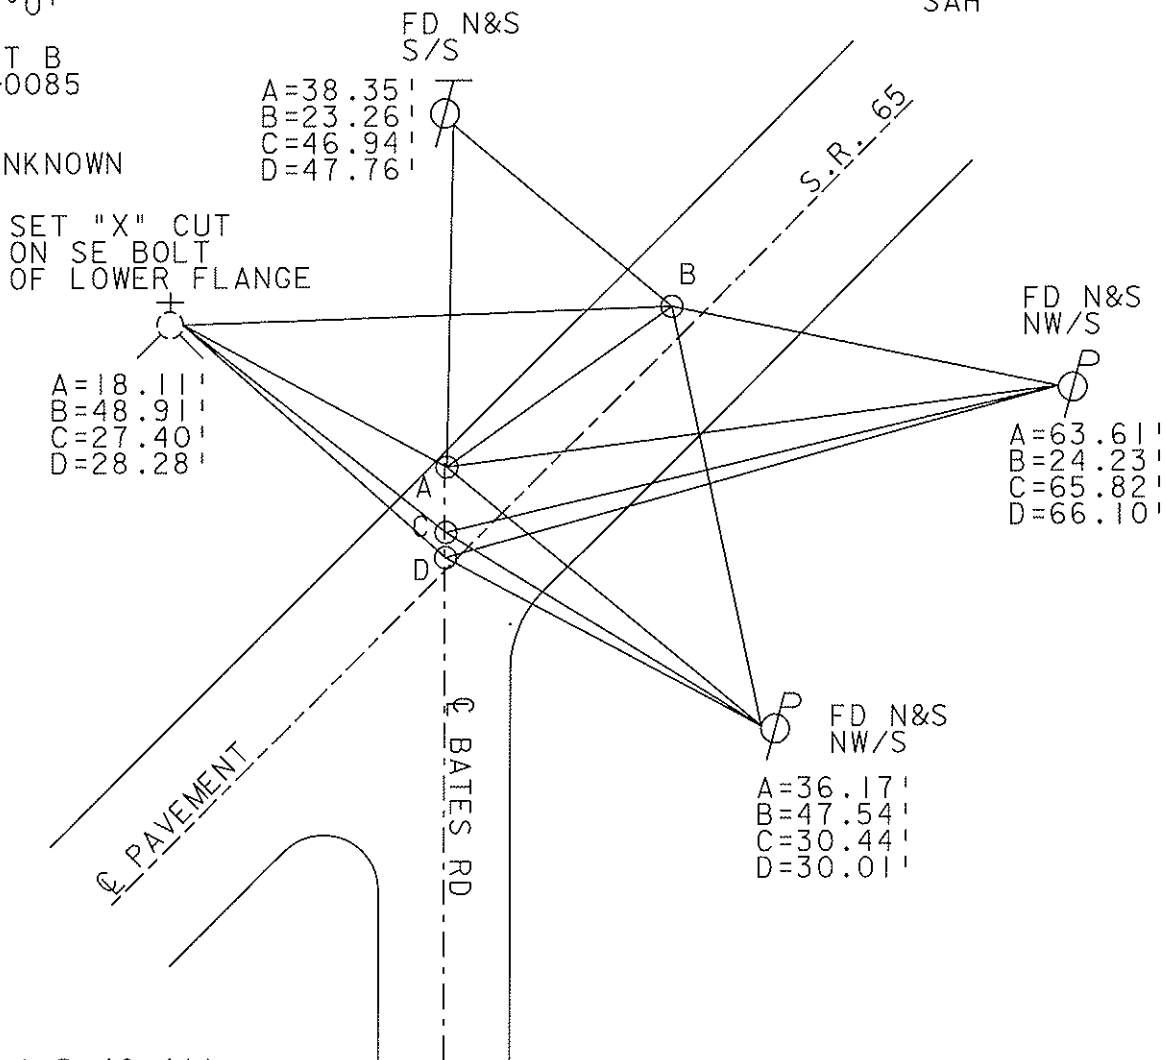

DISTANCE A-B=46.41'

DISTANCE C-D=0.91'

O.D.O.T. DISTRICT 2 SURVEY OFFICE

PERSONNEL

REFERENCE NO. 32 D

SHEET OF

NOTES BARNHISEL

H.C. Reed

DATE 5-3-88

ROUTE 65

R.C. Loehrke

WEATHER SUNNY

COUNTY Wood

HOFFMAN

TEMP. +62°

TOWNSHIP Perryburg

SECTION R.T. 75 & 76

T 8 N R 11 E


TYPE MONUMENT Pt A P.K. Pt B. 2" lead plug

ON SURFACE - BELOW surface 4" below

LEFT- & PAV'T. - RIGHT 11.1 1.0

A. 4.0
B. 13.9 TO Lt EDGE PAVEMENT

S.L.M. Pt A 1160+35

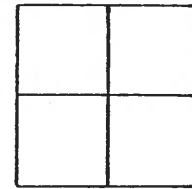

RECORD Pt. "A"
Set P.K. NAIL & BATES RD
1937 STA: 156+49.15
Δ = 0°-0'

Pt. "A" Set P.K. & Washer
Pt. "B" Set Sm RR Spk
8-29-88
m.B.

RECORD Pt. "B"
STA: 157+00.85

Fd Drill hole
14 TOP FLANG
S/S

cut "x" is
conc curb
OF C.B.

set Shi
S/S


Pt B S.R. 65

set Shi
NW/S

set Shi
NW/S

& PAV't

& Bates Rd

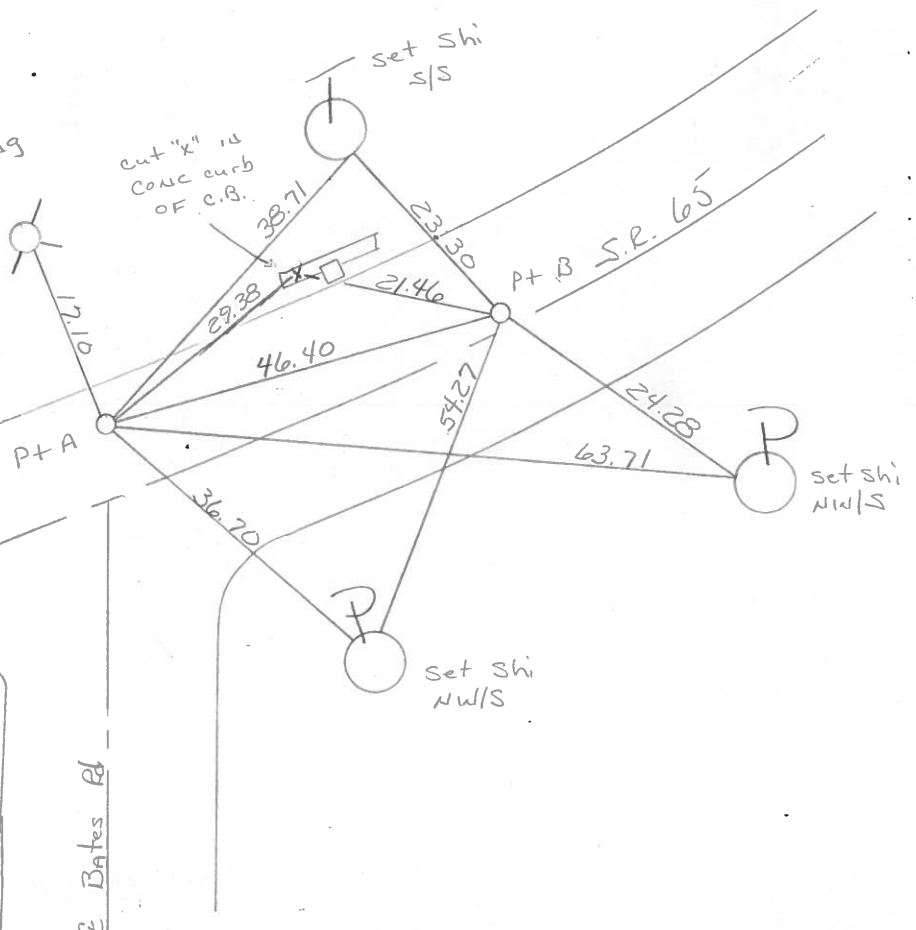

O.D.O.T. DISTRICT 2 SURVEY OFFICE

SHEET _____ OF _____

County Wood S.R. 65

Date 17 Nov. 80

Township _____


Weather Cloudy

Section _____

Temp. 57°

T N, R E

Personnel J. Stone

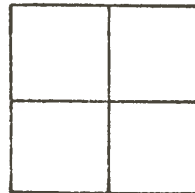


R. Michalak

P. Neuser

D. Curtis

H. Mead

REF. NO. 32D

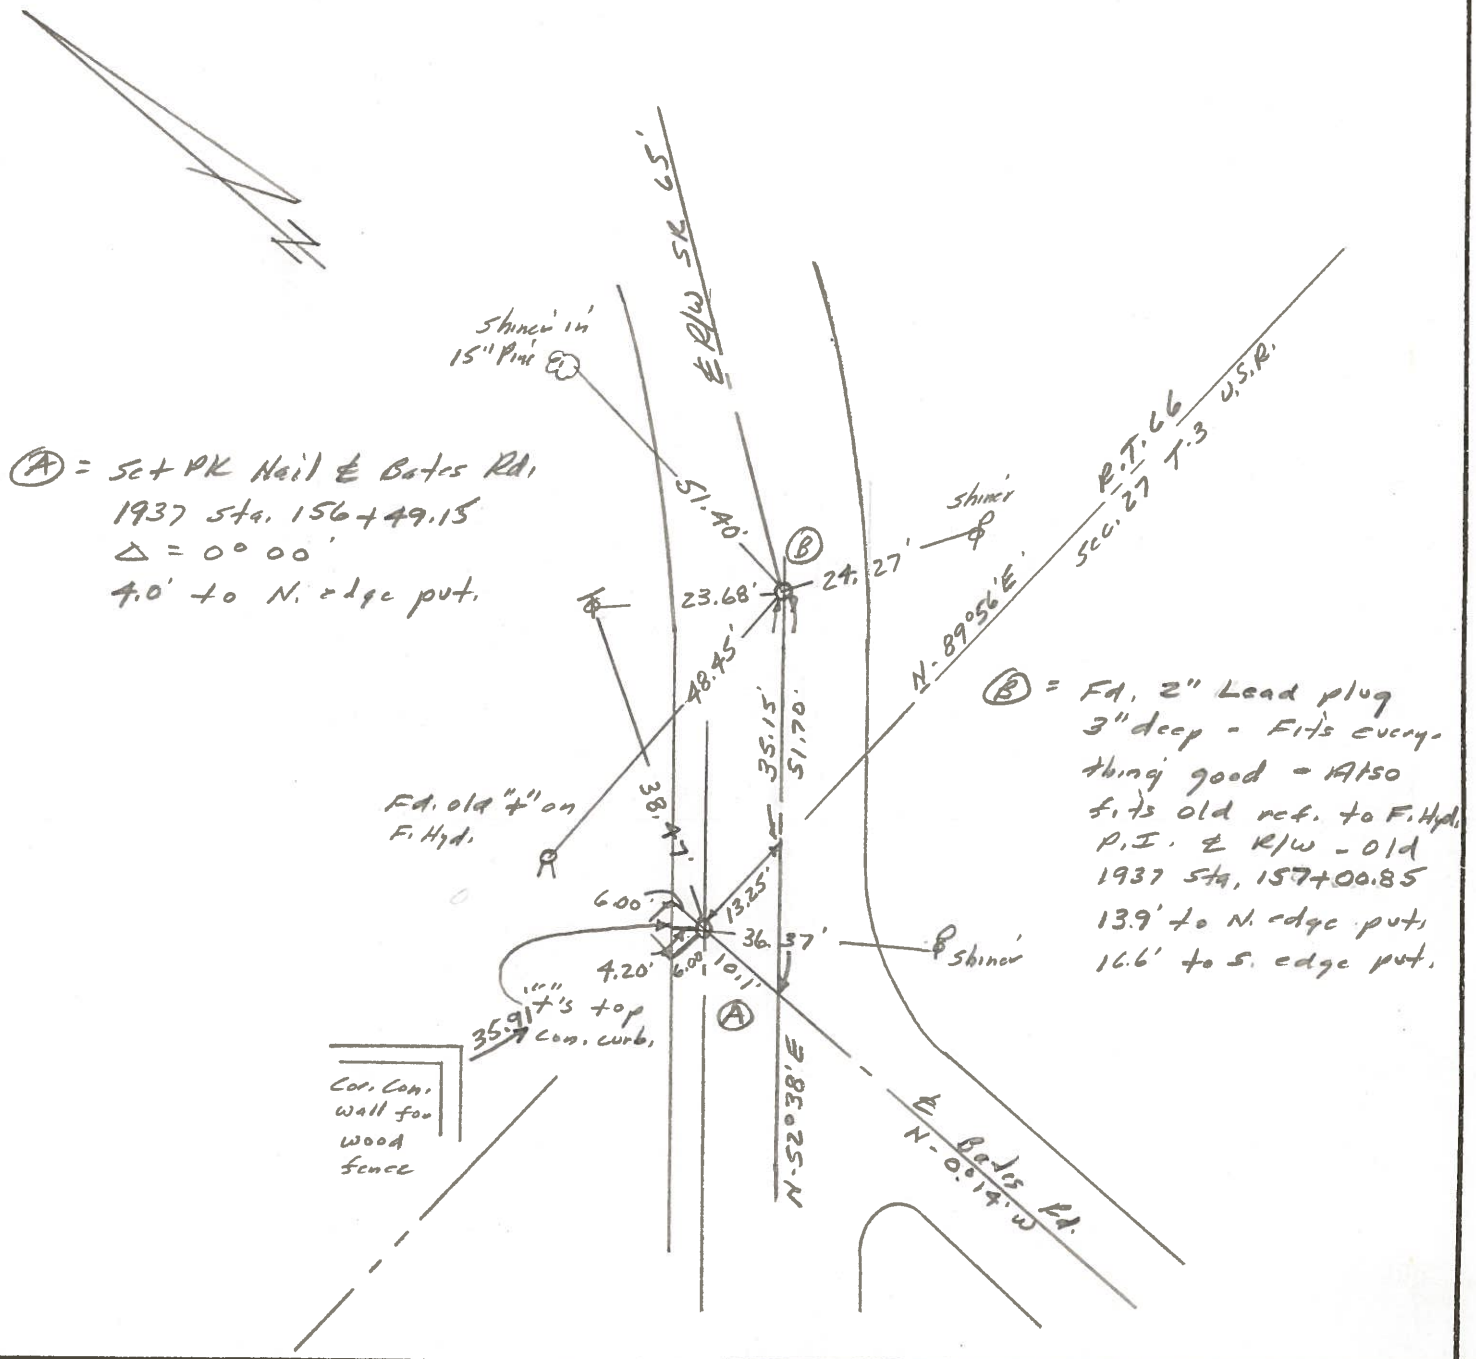

Q.D.O.T. DISTRICT 2 SURVEY OFFICE

Sht. 20 of 20
5-2-65

County WOOD

Township PERRYSBURG

Section _____

T N, R E

Personnel BURNSIDE



BOWERS

32-D

Date 8-1-78

Weather CLEAR

Temp. +78°

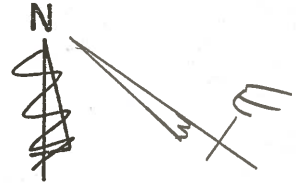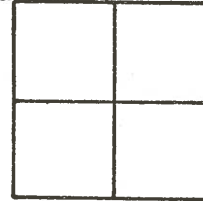

#34

P.I. Sta 157+00.85
 $\Delta = 8^{\circ}03' \text{ LT.}$

SHI.

38.47

17.04

6.00

4.20

6.00

10.1

36.37

13.25

156+65.70

N-89°56'E

N-44°35'E

156+49.15

N-52°38'E

60' R/W

60' R/W

FD. 1/2" Bolt
OVER I.P.I.U

FACE FIRE
HYD @ GND

4" TOP STONE
CORNER

COR. OF
CONC. WALL
FOR WOOD
FENCE

RIVER TRACT 76
RIVER TRACT 75

RIVER TRACT 76
SEC. 27, T, 3, U.S.P.

BATES RD.
N-0°-14'-W

PERSONNEL TITLE PERSONNEL TITLE

COUNTY Wood

DATE

S. R. 65

WEATHER

SEC.

TEMP.

DESCRIPTION

LEFT

CENTER LINE

RIGHT

JOB NO.

Fd. P.K.

32-D

Replaced Log Bolt
8-24-65

Shi. 8' Locust

35.37

12.05'
Near Edge
Fire Hydr.

35.94

Near Cor. Conc.
Base Wood fence

Note fd iron Pin below P.K.

X in Curb W. 6.0
X " " N.W. 4.20
X " " N. 6.0

47.61'

Shi. 18" Twin Elm

Bates Rd.

Fd. P.K.

OK
8-24-65

35

Colony Rd.

Shi. in
Cable pole

25.92'

35.22'

74.37'

43.29'

Shi. in
Cable Pole

31.90'

57.95'

45.90'

27.20'

Shi.

Pshi.

LIME CITY RD.

PERSONNEL TITLE PERSONNEL TITLE

COUNTY

Wood

DATE

S. R.

#65

WEATHER

SEC. C.

TEMP.

DESCRIPTION

LEFT

CENTER LINE

RIGHT

JOB NO.

#

#763

Sta. 85+02.65

Brass plate in pav't.

X in iron fence cor. post N.P.L. 41.6

Beat spike in 12' Elm S.S.E. 51.8

Iron cor. post S.S.W. 90.0

#764

Sta. 114+07.85

Brass plate in pav't.

3rd iron fence post N. 34.0

X iron cor. post N.N.W. 30.1

Nail in 8" pine W. 51.8

#765

Sta. 147+39.12

(New) brass plate

Shiner in 30" oak N.N.W. 29.9

Shiner in 24" oak W. 61.2

Shiner in 14" catalpa S. 90.1

#766

Sta. approximately 156+55

Iron bolt

River Track #75 & 76

X base fire Hyd. N.N.W. 17.0

Shiner in 16" locust W. 63.3

Shiner in 24" Elm S.S.E. 60.9

#767

Sta. 157+00.85

P.L. Brass Plate in pav't.

Shiner in 12" cherry N.N.W. 30.0

X base fire Hyd. W. 48.5

Shiner in 40" Elm E.S.E. 76.5

Shiner in 24" Elm S.S.E. 49.6