

O.D.O.T. DISTRICT 2 SURVEY OFFICE (USE ONLY)

PERSONNEL

REFERENCE NO. 32 CC

SHEET 16 OF 23

NOTES BARRIERE
H.C. MILLER
R.C. BLUBAUGH

DATE 7/1/24
WEATHER SUNNY
TEMP. 68°

ROUTE SR 65
COUNTY WOOD
TOWNSHIP PERRYSBURG
SECTION 75

DWG BY BARRIERE PID 101291

T 3 N R 12 MI RESERVE

TYPE MONUMENT MAG/WASHER

ON SURFACE - BELOW ON

OFFSET $\angle$ PAVEMENT 1.2' LT LT : RT

TO EDGE PAVEMENT

STATION: 1160+35

HORIZ.DATUM: NAD83 (2011)


GEOID: 18

GRID: NORTHING: 704084.736

EASTING: 1673837.378


LDP: NORTHING: 526207.253

EASTING: 183937.153

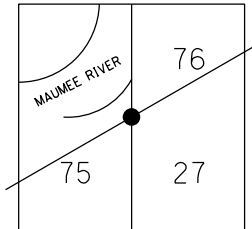

RECORD:

ORIGIN UNKNOWN
FD P.K.NAIL
9/14/05, DCH
SET MAG/WASHER
10/27/05, SAH
FD MAG/WASHER
REF32CC
5/8/23, TDN
10/12/23, TDN
FD MAG/WASH
REF32CC
7/1/24, JAM

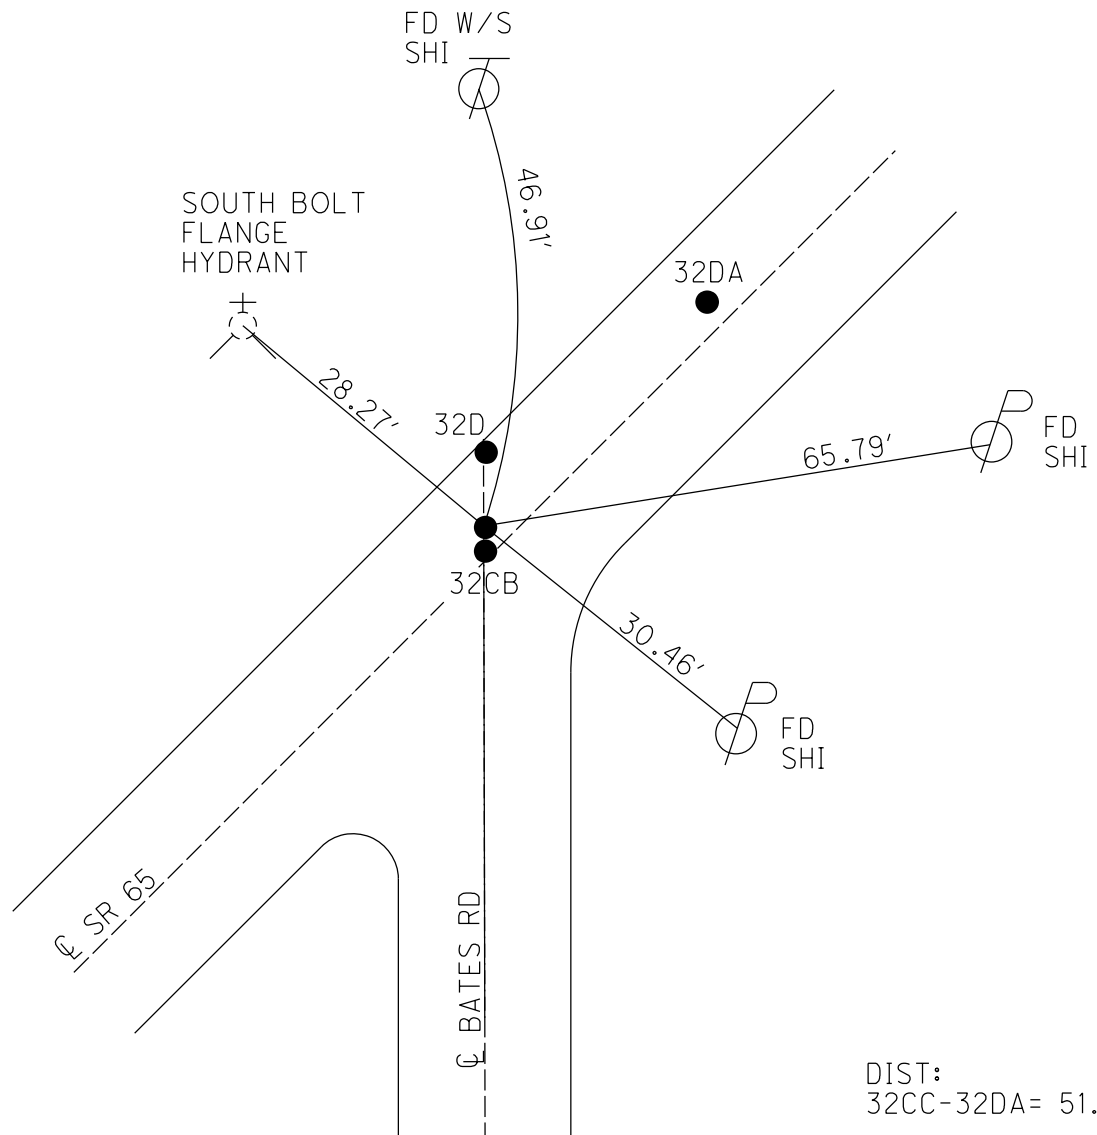

DIST:
32CC-32DA= 51.51'

O.D.O.T. DISTRICT 2 SURVEY OFFICE (USE ONLY)

PERSONNEL

REFERENCE NO. 32 CC

SHEET 15 OF 21

NOTES AUBLE

DATE 5-8-23

ROUTE SR 65

H.C. NIESE

WEATHER CLOUDY

COUNTY WOOD

R.C. AUBLE

TEMP. 55° F

TOWNSHIP PERRYSBURG

SECTION RT 75

DWG BY RHOADES

PID PAVING TRAIN

T 3

12 MILE RESERVE

TYPE MONUMENT MAG/WASHER

ON SURFACE - ~~BELOW~~ ON

OFFSET CL PAVEMENT 1.2' LT : RT

9.9' TO LT EDGE PAVEMENT


STATION: 1160+35

HORIZ.DATUM: NAD83 2011

GEOID: NAVD88 2018


GRID: NORTHING: 704084.736

EASTING: 1673837.378

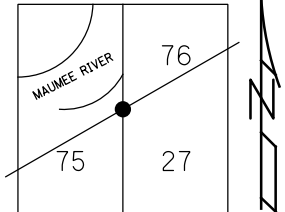

RECORD:
ORIGIN UNKNOWN
FD P.K.NAIL
9/14/05, DCH
SET MAG/WASHER
10/27/05, SAH
FD MAG/WASHER
REF32CC
5/8/23, TDN
10/12/23, TDN

WOOD LPD:
N: 526207.235
E: 183937.122

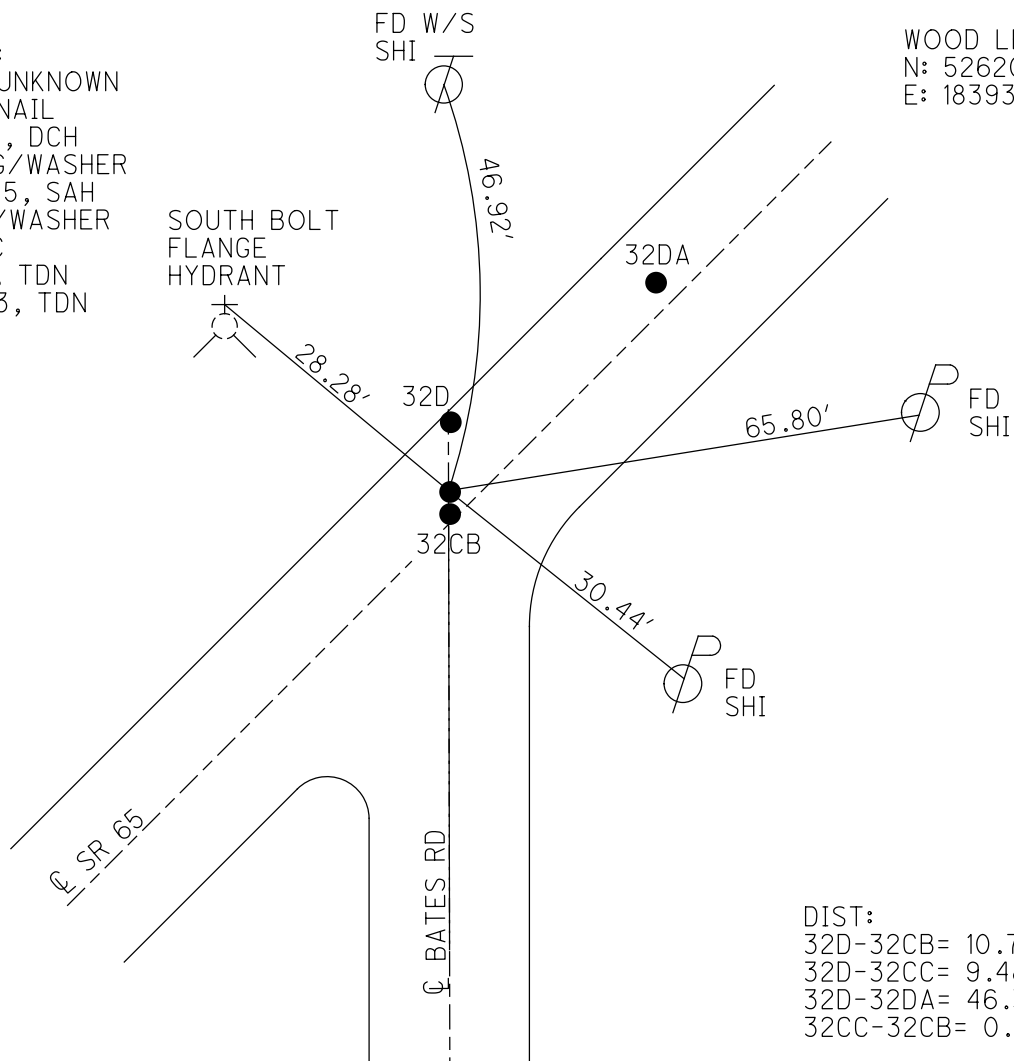

DIST:
32D-32CB= 10.71'
32D-32CC= 9.48'
32D-32DA= 46.33'
32CC-32CB= 0.91'

O.D.O.T. DISTRICT 2 SURVEY OFFICE

PERSONNEL

REFERENCE NO. 32-D

SHEET 14 OF 14

NOTES

HUSS

DATE

9-14-05

ROUTE

S.R. 65

H.C.

NUHFER

WEATHER

SUNNY

COUNTY

WOOD

R.C.

HOMAN

TEMP.

78°

TOWNSHIP

PERRYSBURG

SECTION

RIVER TRACT

~~T-7-N R-11-E~~

Town 3, 12 mile Res.

TYPE MONUMENT

A- IRON PIN B-SM RR SPIKE

ON SURFACE - ~~BELOW~~

C & D PK NAILS

LEFT - ~~C PART~~ RIGHT


A-6" DOWN
B, C, & D ON SURFACE
A-10.9' LT B-1.2' LT
C-1.2' LT D-0.3' LT

TO LT EDGE PAVEMENT

A-1.0' B-10.9'
C-9.9' D-10.8'

S.L.M.

A 1160+35

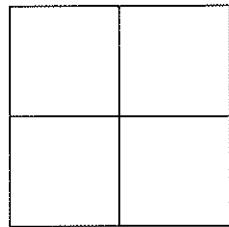

RECORD
PT A SET PK NAIL @ BATES RD
STA 156+49.15 (1937)
DELTA= 0°0'

SET MAG NAILS
& WASHERS
10-27-05
SAH

RECORD PT B
STA 157+0085

PT C & D
ORIGIN UNKNOWN

SET "X" CUT
ON SE BOLT
OF LOWER FLANGE

A=18.11'
B=48.91'
C=27.40'
D=28.28'

A=38.35'
B=23.26'
C=46.94'
D=47.76'

FD N&S
S/S

S.R. 65

FD N&S
NW/S

A=63.61'
B=24.23'
C=65.82'
D=66.10'

FD N&S
NW/S

A=36.17'
B=47.54'
C=30.44'
D=30.01'

PAVEMENT

BATES RD

DISTANCE A-B=46.41'
DISTANCE C-D=0.91'

O.D.O.T. DISTRICT 2 SURVEY OFFICE

PERSONNEL

REFERENCE NO. 32 D

SHEET OF

NOTES BARNHISEL

H.C. Reed

DATE 5-3-88

ROUTE 65

R.C. Loehrke

WEATHER SUNNY

COUNTY Wood

HOFFMAN

TEMP. +62°

TOWNSHIP Perryburg

SECTION R.T. 75 & 76

T 8 N R 11 E


TYPE MONUMENT Pt A P.K. Pt B. 2" lead plug

ON SURFACE - BELOW surface 4" below

LEFT- & PAV'T. - RIGHT 11.1 1.0

A. 4.0
B. 13.9 TO Lt EDGE PAVEMENT

S.L.M. Pt A 1160+35

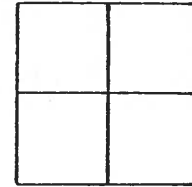

RECORD Pt. "A"
Set P.K. NAIL & BATES RD
1937 STA: 156+49.15
Δ = 0°-0'

Pt. "A" Set P.K. & Washer
Pt. "B" Set Sm RR Spk
8-29-88
m.B.

RECORD Pt. "B"
STA: 157+00.85

Fd Drill hole
14 TOP FLANG
S/S

cut "x" is
conc curb
OF C.B.

set Shi
S/S


Pt B S.R. 65

set Shi
NW/S

set Shi
NW/S

& PAV't

& Bates Rd

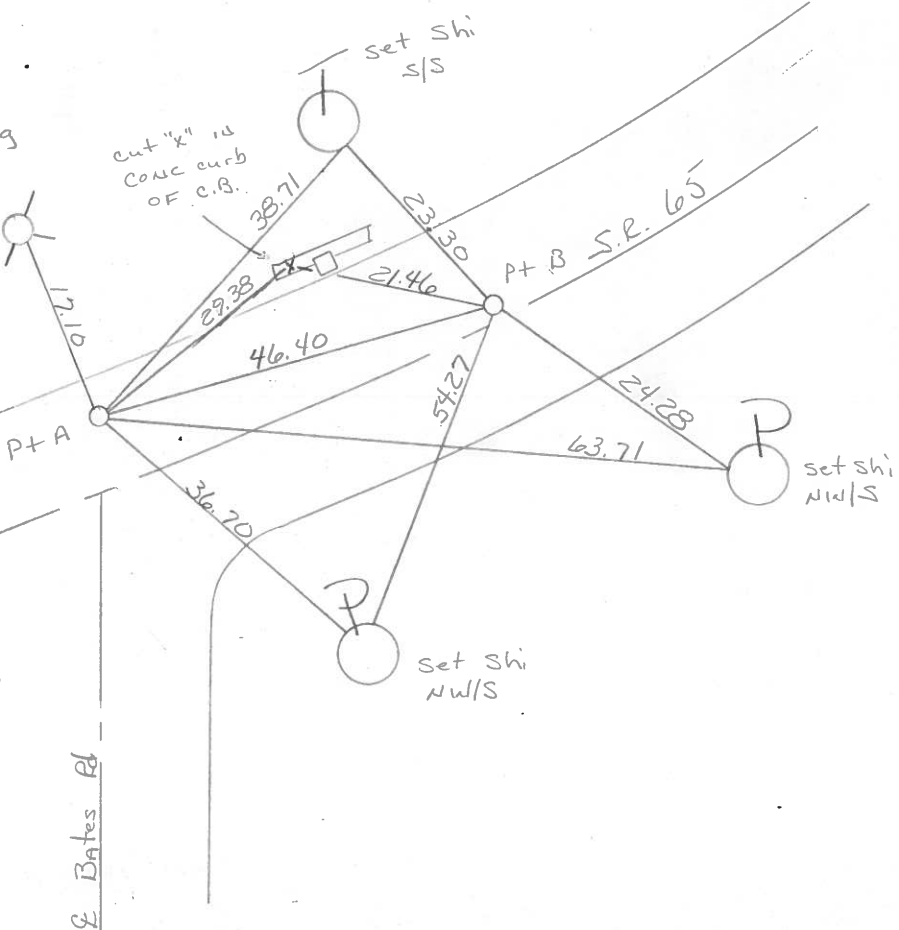

O.D.O.T. DISTRICT 2 SURVEY OFFICE

SHEET _____ OF _____

County Wood S.R. 65

Date 17 Nov. 80

Township _____


Weather Cloudy

Section _____

Temp. 57°

T N, R E

Personnel J. Stone

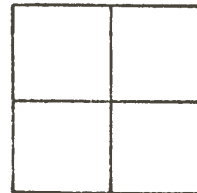


R. Michalak

P. Neuser

D. Curtis

H. Mead

REF. NO. 32D

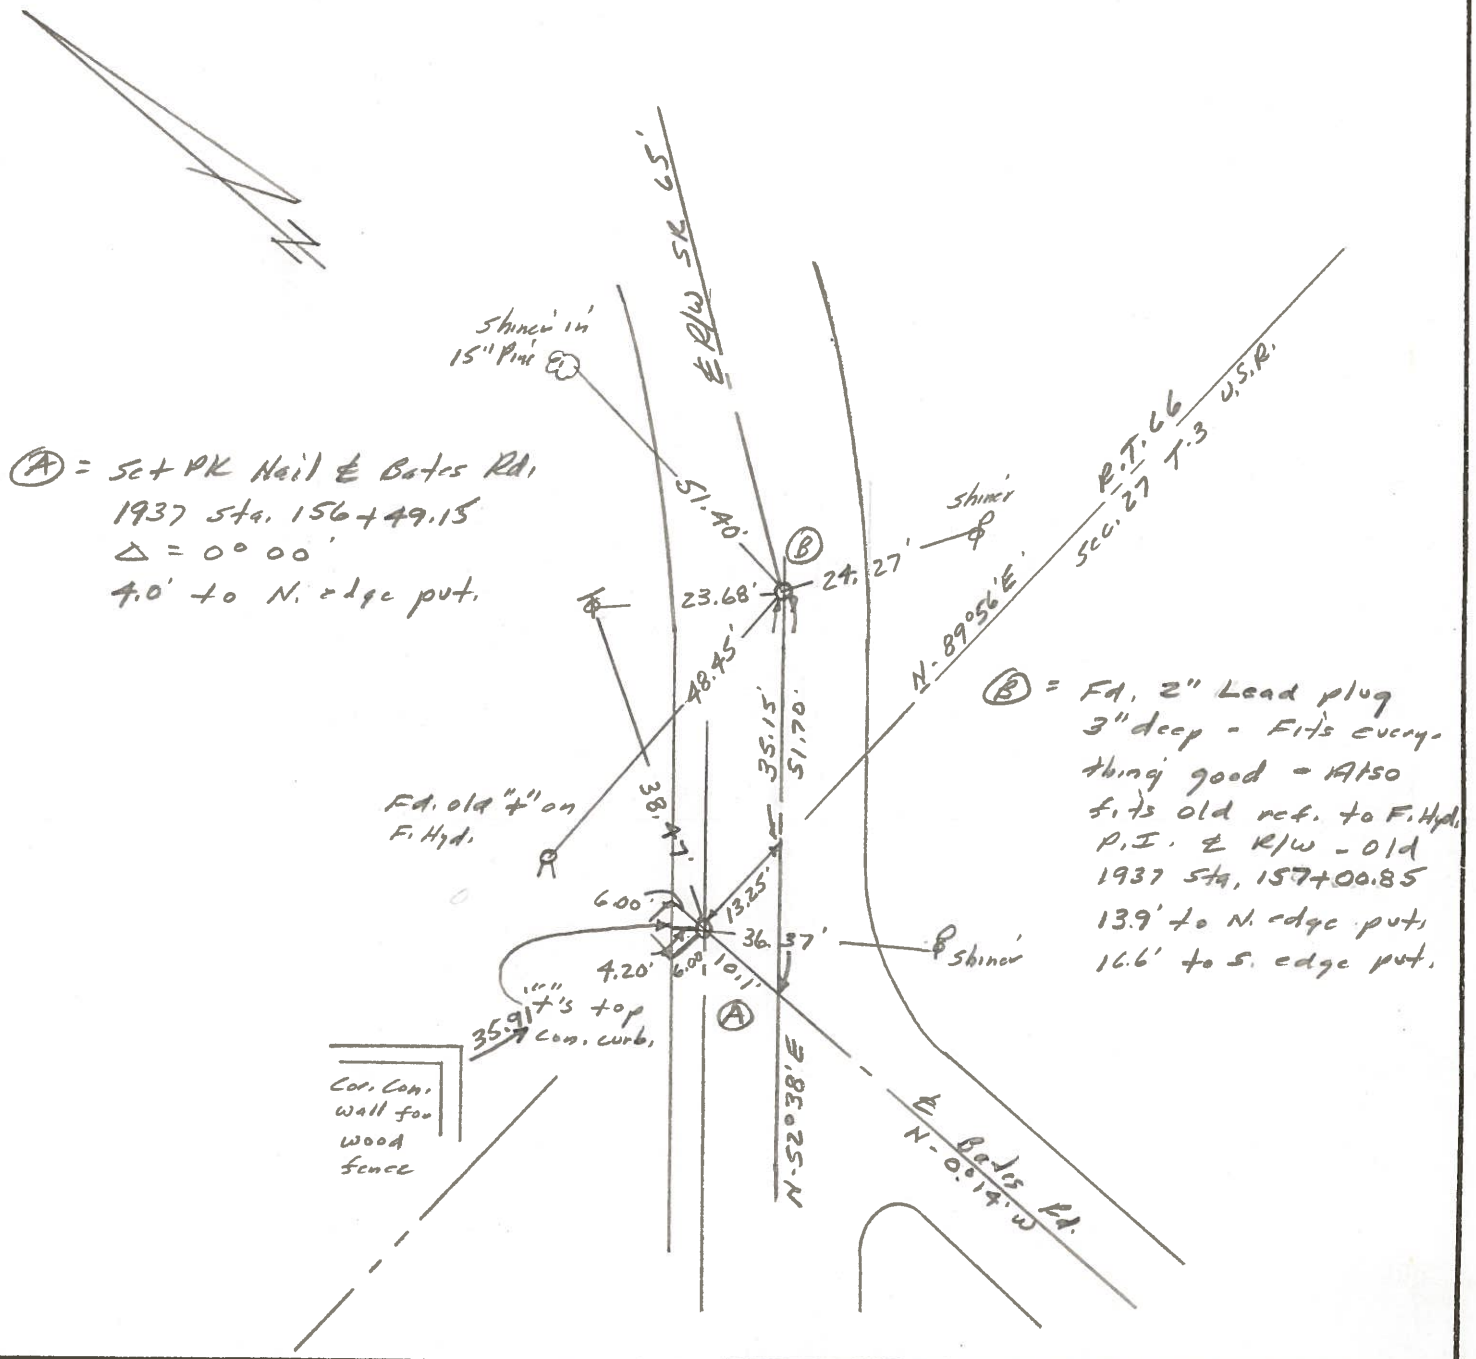

Q.D.O.T. DISTRICT 2 SURVEY OFFICE

Sht. 20 of 20
5-2-65

County WOOD

Township PERRYSBURG

Section _____

T N, R E

Personnel BURNSIDE



BOWERS

32-D

Date 8-1-78

Weather CLEAR

Temp. +78°

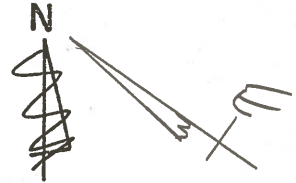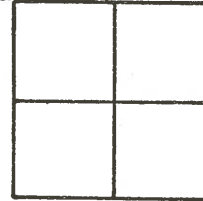

#34

P.I. Sta 157+00.85
 $\Delta = 8^{\circ}03'LT.$

SHI.

38.47

17.04

6.00

4.20

6.00

13.25

10.1

36.37

SHI.

35.91

60' R/W

N-52°38'E

156+49.15

BATES RD.

N-0°14'W

156+65.70

N-89°56'E

156+65.70

RIVER TRACT #16

SEC. 27, T, 3, U.S.P.

N-44°35'E

156+65.70

FACE FIRE HYD @ GND

4" TOP STONE CURB

COR. OF CONC. WALL FOR WOOD FENCE

FD. 1/2" BOLT OVER I.P.I.U

RIVER TRACT #6

RIVER TRACT #5

PERSONNEL TITLE PERSONNEL TITLE

COUNTY Wood

DATE

S. R. 65

WEATHER

SEC.

TEMP.

DESCRIPTION

LEFT

CENTER LINE

RIGHT

JOB NO.

Fd. P.K.

32-D

Replaced Log Bolt
8-24-65

Shi. 8' Locust

35.37

12.05'
Near Edge
Fire Hydr.

35.94

Near Cor. Conc.
Base Wood fence

Note fd iron Pin below P.K.

X in Curb W. 6.0
X " " N.W. 4.20
X " " N. 6.0

47.61'

Shi. 18" Twin Elm

Bates Rd.

Fd. P.K.

OK
8-24-65

Fd. P.K.

35

Colony Rd.

Shi. in
Cable pole

25.92'

35.22'

Shi. in
Cable Pole

74.37'

43.29'

31.90'

57.95'

45.90'

27.20'

LIME CITY RD.

PERSONNEL TITLE PERSONNEL TITLE

COUNTY

Wood

DATE

S. R.

#65

WEATHER

SEC. C.

TEMP.

DESCRIPTION

LEFT

CENTER LINE

RIGHT

JOB NO.

#

#763

Sta. 85+02.65

Brass plate in pav't.

X in iron fence cor. post N.P.L. 41.6

Beat spike in 12' Elm S.S.E. 51.8

Iron cor. post S.S.W. 90.0

#764

Sta. 114+07.85

Brass plate in pav't.

3rd iron fence post N. 34.0

X iron cor. post N.N.W. 30.1

Nail in 8" pine W. 51.8

#765

Sta. 147+39.12

(New) brass plate

Shiner in 30" oak N.N.W. 29.5

Shiner in 24" oak W. 61.2

Shiner in 14" catalpa S. 90.1

#766

Sta. approximately 156+55

Iron bolt

River Track #75 & 76

X base fire Hyd. N.N.W. 17.0

Shiner in 16" locust W. 63.3

Shiner in 24' Elm S.S.E. 60.9

#767

Sta. 157+00.85

P.L. Brass Plate in pav't.

Shiner in 12" cherry N.N.W. 30.0

X base fire Hyd. W. 48.5

Shiner in 40' Elm E.S.E. 76.5

Shiner in 24' Elm S.S.E. 49.6