

O.D.O.T. DISTRICT 2 SURVEY OFFICE (USE ONLY)

PERSONNEL

REFERENCE NO. 32 DA

SHEET 19 OF 23

NOTES BARRIERE
H.C. MILLER
R.C. BLUBAUGH

DATE 7/1/24
WEATHER SUNNY
TEMP. 68°

ROUTE SR 65
COUNTY WOOD
TOWNSHIP PERRYSBURG
SECTION 75

DWG BY BARRIERE PID 101291

T 3 N R 12 MI RESERVE

TYPE MONUMENT MAG/WASHER

ON SURFACE - BELOW ON

OFFSET $\varnothing$ PAVEMENT 1.2' LT LT : RT

TO EDGE PAVEMENT

STATION: 1160+87

HORZ.DATUM: NAD83 (2011)


GEOID: 18

GRID: NORTHING: 704115.381

EASTING: 1673878.811


LDP: NORTHING: 526238.456

EASTING: 183978.187

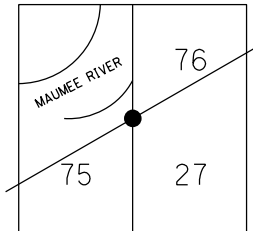

RECORD:

P.I.
STA.157+00.85
FD SM.R.R.SPIKE
9/14/05, DCH
SET MAG/WASHER
10/27/05, SAH
FD MAG/WASHER
REF32DA
5/8/23, TDN
10/12/23, TDN
FD MAG/WASH
REF32DA
7/1/24, JAM

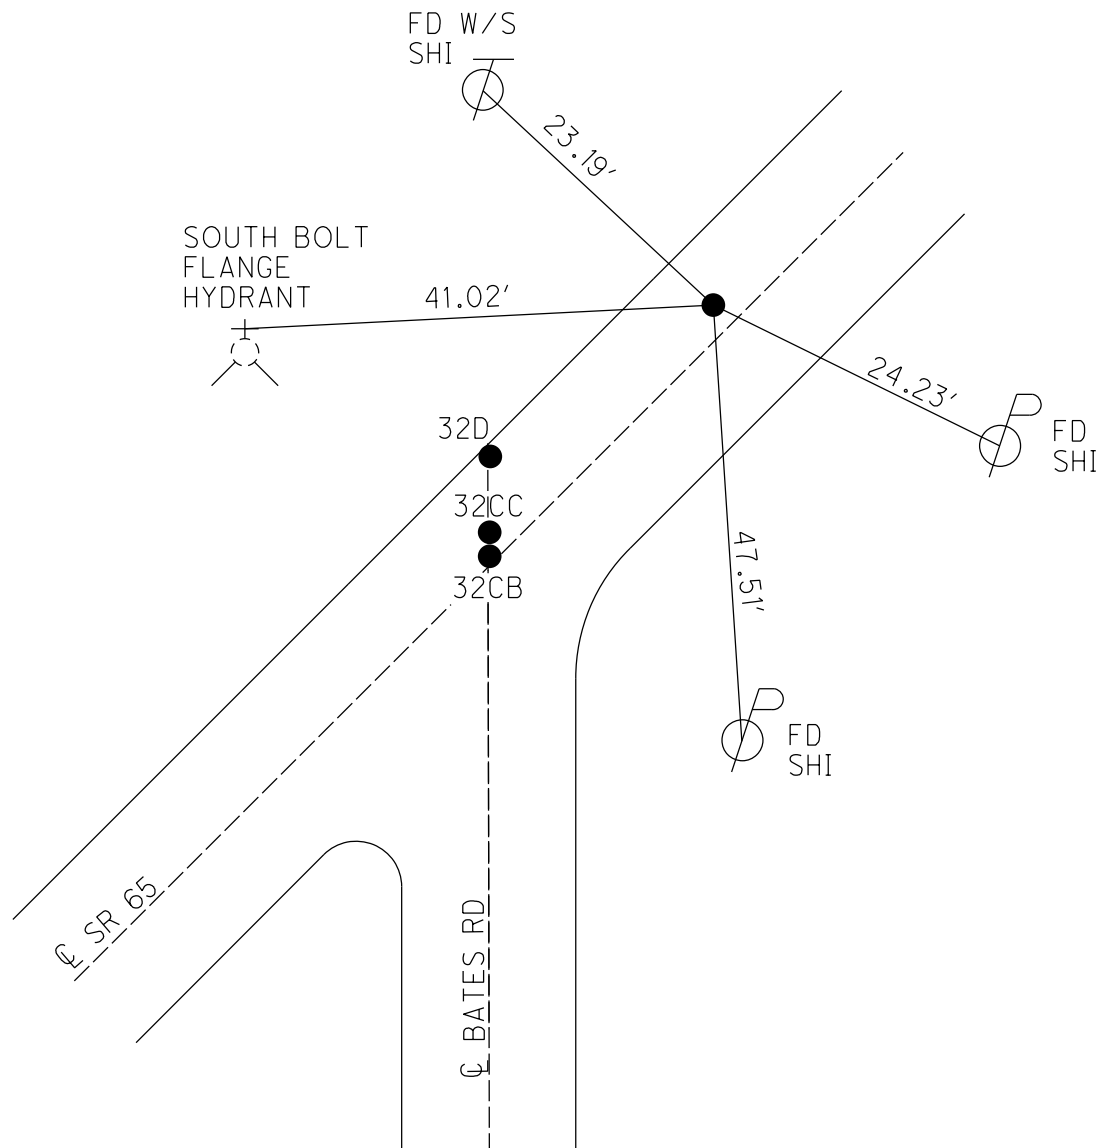

O.D.O.T. DISTRICT 2 SURVEY OFFICE (USE ONLY)

PERSONNEL

REFERENCE NO. 32 DA

SHEET 17 OF 21

NOTES AUBLE

DATE 5-8-23

ROUTE SR 65

H.C. NIESE

WEATHER CLOUDY

COUNTY WOOD

R.C. AUBLE

TEMP. 55° F

TOWNSHIP PERRYSBURG

SECTION RT 76

DWG BY RHOADES

PID PAVING TRAIN

T 3

12 MILE RESERVE

TYPE MONUMENT MAG/WASHER

ON SURFACE - ~~BELOW~~ ON

OFFSET CL PAVEMENT 1.2' LT : RT

10.9' TO LT EDGE PAVEMENT


STATION: 1160+87

HORZ.DATUM: NAD83 2011

GEOID: NAVD88 2018

GRID: NORTHING: 704115.381

EASTING: 1673878.811

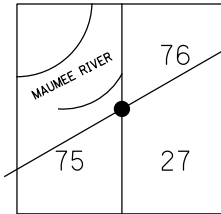

RECORD:

STA.157+00.85
FD SM.R.R.SPIKE
9/14/05, DCH
SET MAG/WASHER
10/27/05, SAH
FD MAG/WASHER
REF32DA
5/8/23, TDN
10/12/23, TDN

FD W/S
SHI

WOOD LPD:
N: 526238.425
E: 183978.148

SOUTH BOLT
FLANGE
HYDRANT

41.03'

23.68'

24.22'

32D

32CC

32CB

47.51'
FD
SHI

CL SR 65

CL BATES RD

DIST:

32D-32CB= 10.71'
32D-32CC= 9.48'
32D-32DA= 46.33'
32CC-32CB= 0.91'

O.D.O.T. DISTRICT 2 SURVEY OFFICE

PERSONNEL

REFERENCE NO. 32-D

SHEET 14 OF 14

NOTES

HUSS

DATE

9-14-05

ROUTE

S.R. 65

H.C.

NUHFER

WEATHER

SUNNY

COUNTY

WOOD

R.C.

HOMAN

TEMP.

78°

TOWNSHIP

PERRYSBURG

SECTION

RIVER TRACT

~~T-7-N R-11-E~~

Town 3, 12 mile Res.

TYPE MONUMENT

A- IRON PIN B-SM RR SPIKE

ON SURFACE - ~~BELOW~~

C & D PK NAILS

LEFT - ~~C PART~~ RIGHT


A-6" DOWN
B, C, & D ON SURFACE
A-10.9' LT B-1.2' LT
C-1.2' LT D-0.3' LT

TO LT EDGE PAVEMENT

A-1.0' B-10.9'
C-9.9' D-10.8'

S.L.M.

A 1160+35

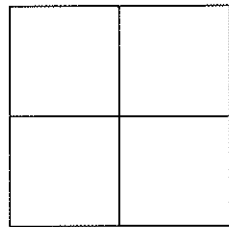

RECORD
PT A SET PK NAIL @ BATES RD
STA 156+49.15 (1937)
DELTA= 0°0'

SET MAG NAILS
& WASHERS
10-27-05
SAH

RECORD PT B
STA 157+0085

PT C & D
ORIGIN UNKNOWN

SET "X" CUT
ON SE BOLT
OF LOWER FLANGE

A=18.11'
B=48.91'
C=27.40'
D=28.28'

A=38.35'
B=23.26'
C=46.94'
D=47.76'

FD N&S
S/S

S.R. 65

FD N&S
NW/S

A=63.61'
B=24.23'
C=65.82'
D=66.10'

FD N&S
NW/S

A=36.17'
B=47.54'
C=30.44'
D=30.01'

PAVEMENT

BATES RD

DISTANCE A-B=46.41'
DISTANCE C-D=0.91'

O.D.O.T. DISTRICT 2 SURVEY OFFICE

PERSONNEL

REFERENCE NO. 32 D

SHEET OF

NOTES BARNHISEL

H.C. Reed

R.C. Loehrke

Hoffman

DATE 5-3-88

WEATHER SUNNY

TEMP. +62°

ROUTE 65

COUNTY Wood

TOWNSHIP Perryburg

SECTION R.T. 75 & 76

T 8 N R 11 E


TYPE MONUMENT Pt A P.K. Pt B. 2" lead plug

ON SURFACE - BELOW surface 4" below

LEFT- & PAV'T. - RIGHT 11.1 1.0

A. 4.0
B. 13.9 TO Lt EDGE PAVEMENT

S.L.M. Pt A 1160+35

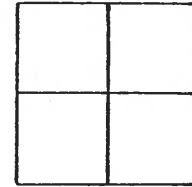

RECORD Pt. "A"
Set P.K. NAIL & BATES RD
1937 STA: 156+49.15
Δ = 0°-0'

Pt. "A" Set P.K. & Washer
Pt. "B" Set Sm RR Spk
8-29-88
m.B.

RECORD Pt. "B"
STA: 157+00.85

Fd Drill hole
14 TOP FLANG
S/S

cut "x" is
conc curb
OF C.B.

set Shi
S/S


Pt B S.R. 65

set Shi
NW/S

set Shi
NW/S

& PAV't

& Bates Rd

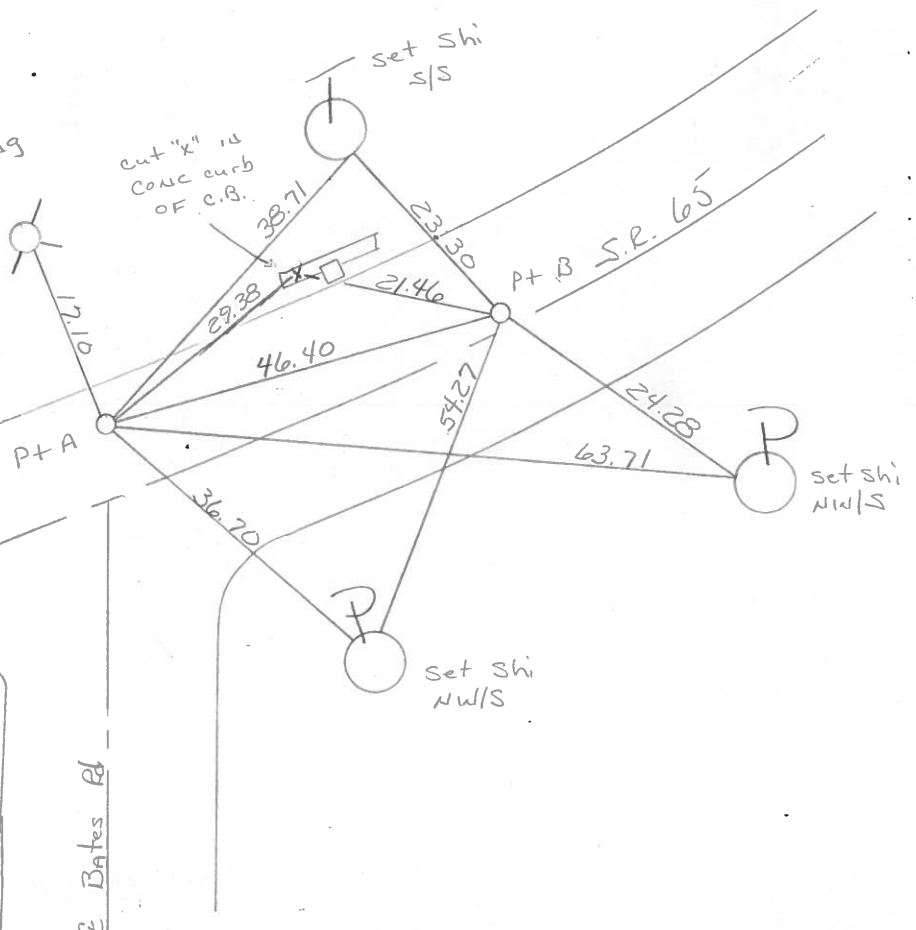

SHEET _____ OF _____

Date 17 Nov. 80

Weather cloudy

Temp. 37°


4

P. Neusch

D. Curtis'

H. Reed

REF. NO. 32D

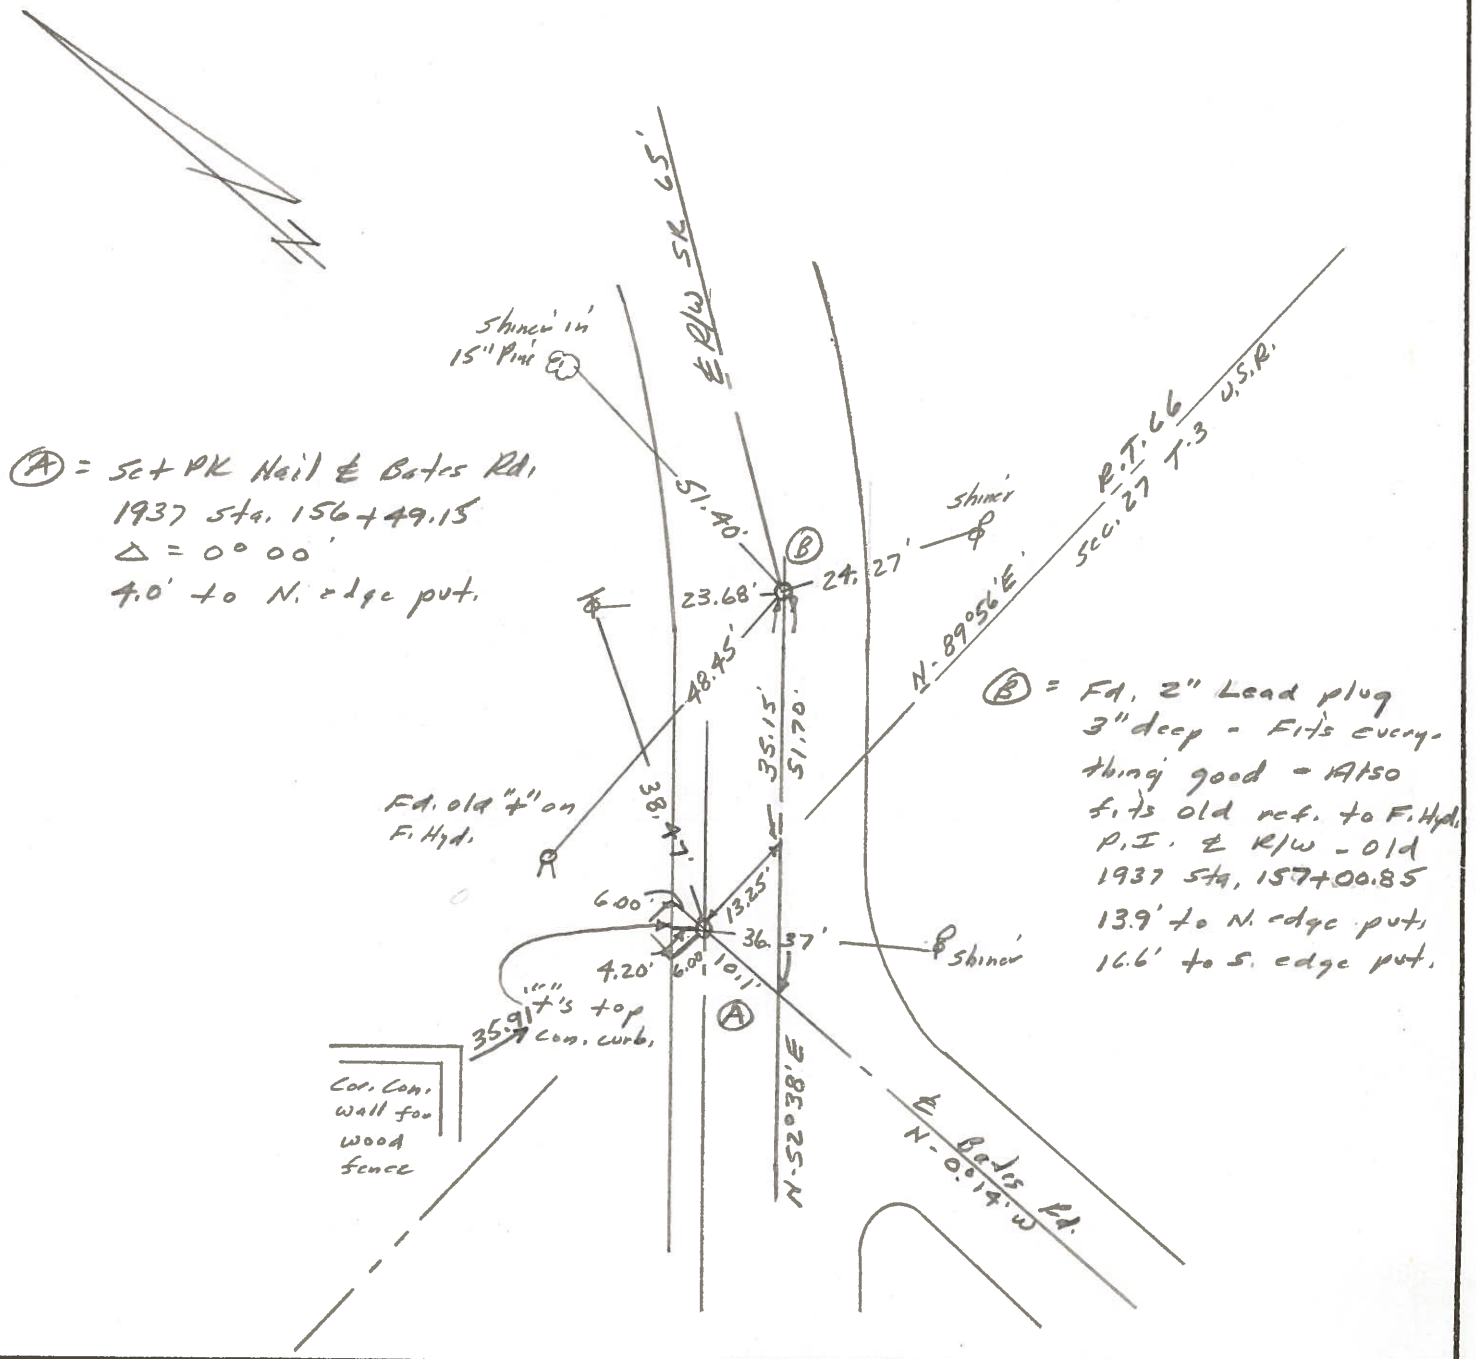

Q.D.O.T. DISTRICT 2 SURVEY OFFICE

Sht. 20 of 20
5-2-65

County WOOD

Date 8-1-78

Township PERRYSBURG



Weather CLEAR

Section _____

Temp. +78°

T N, R E

Personnel BURNSIDE

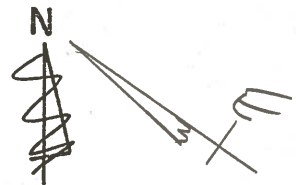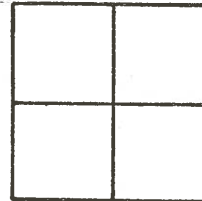


32-D

#34

P.I. Sta 157+00.85
 $\Delta = 8^{\circ}03'LT.$

FD. 1/2" Bolt
OVER I.P.I.U

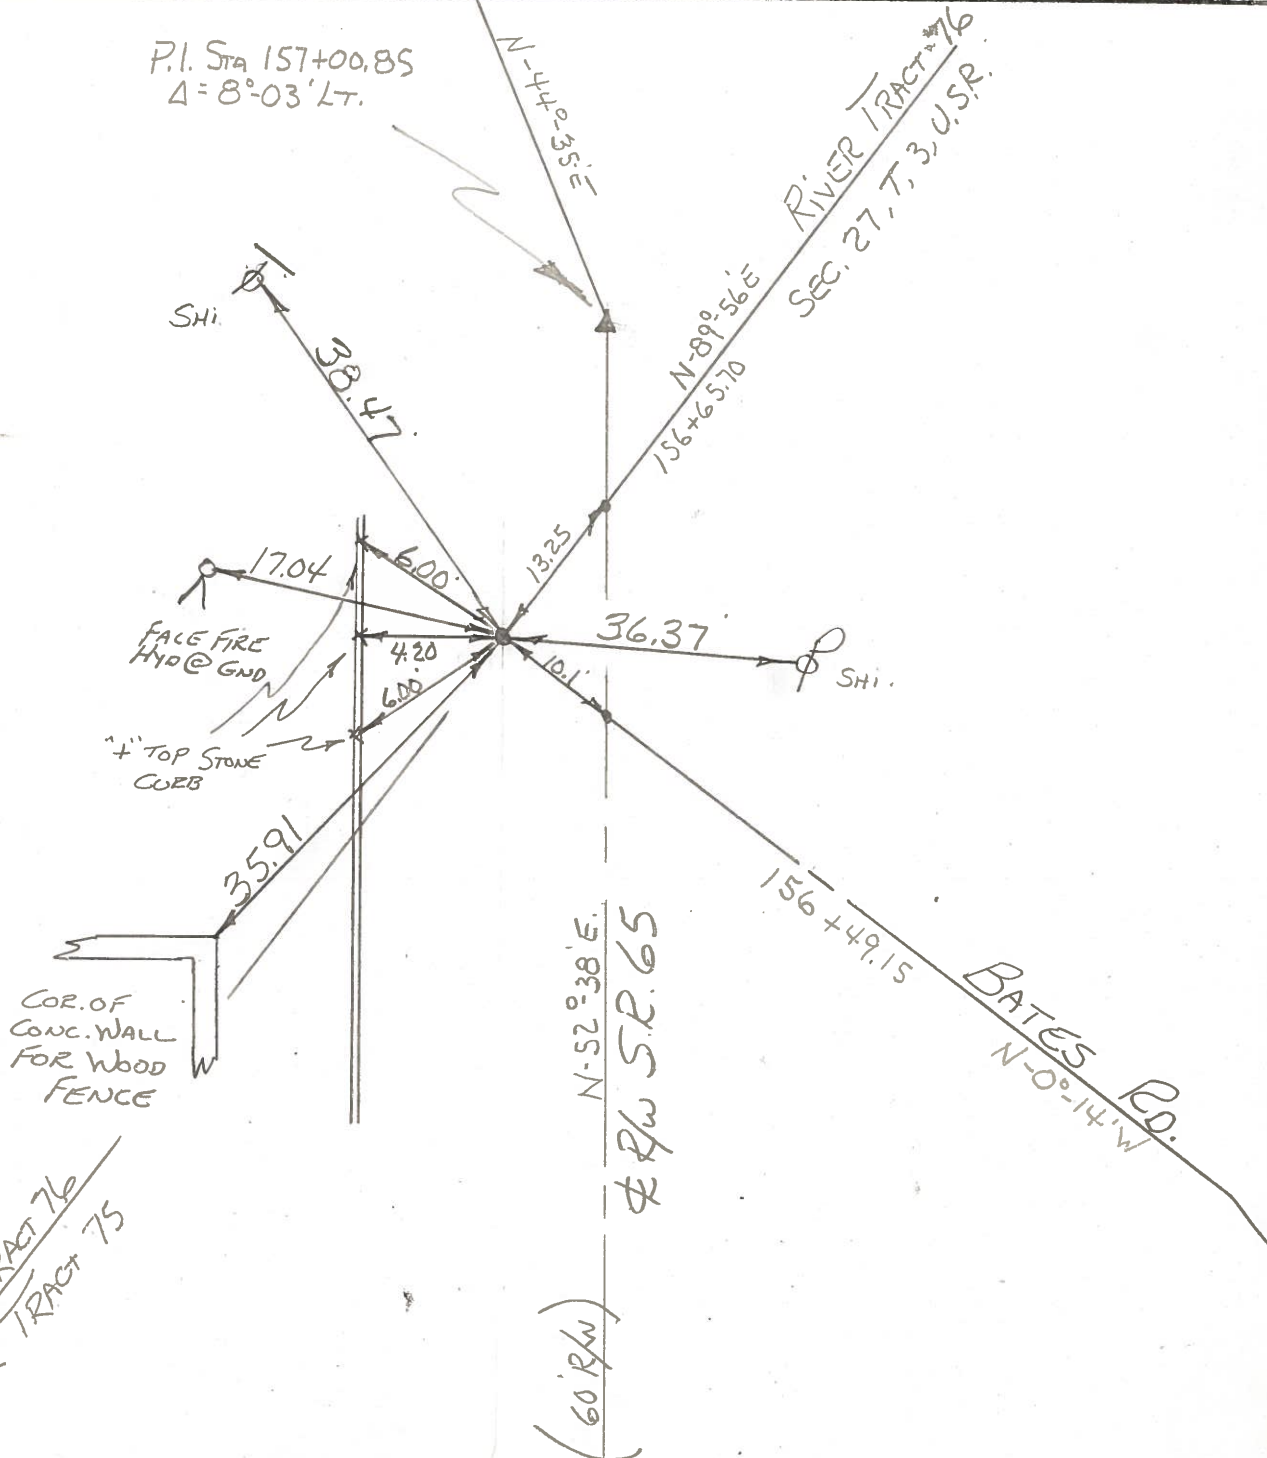

PERSONNEL TITLE PERSONNEL TITLE

COUNTY Wood

DATE

S. R. 65

WEATHER

SEC.

TEMP.

DESCRIPTION

LEFT

CENTER LINE

RIGHT

JOB NO.

Fd. P.K.

32-D

Replaced Log Bolt
8-24-65

Shi. 8' Locust

35.37

12.05'
Near Edge
Fire Hydr.

35.94

Near Cor. Conc.
Base Wood fence

Note fd iron Pin below P.K.

X in Curb W. 6.0
X " " N.W. 4.20
X " " N. 6.0

47.61'

Shi. 18" Twin Elm

Bates Rd.

Fd. P.K.

OK
8-24-65

Fd. P.K.

35

Colony Rd.

Shi. in
Cable pole

Shi. in
Cable Pole

25.92'

35.22'

74.37'

43.29'

31.90'

57.95'

45.90'

27.20'

34.96'

LIME CITY RD.

PERSONNEL TITLE PERSONNEL TITLE

COUNTY

Wood

DATE

S. R.

#65

WEATHER

SEC. C.

TEMP.

DESCRIPTION

LEFT

CENTER LINE

RIGHT

JOB NO.

#

#763

Sta. 85+02.65

Brass plate in pav't.

X in iron fence cor. post N.P.L. 41.6

Beat spike in 12' Elm S.S.E. 51.8

Iron cor. post S.S.W. 90.0

#764

Sta. 114+07.85

Brass plate in pav't.

3rd iron fence post N. 34.0

X iron cor. post N.N.W. 30.1

Nail in 8" pine W. 51.8

#765

Sta. 147+39.12

(New) brass plate

Shiner in 30" oak N.N.W. 29.5

Shiner in 24" oak W. 61.2

Shiner in 14" catalpa S. 90.1

#766

Sta. approximately 156+55

Iron bolt

River Track #75 & 76

X base fire Hyd. N.N.W. 17.0

Shiner in 16" locust W. 63.3

Shiner in 24' Elm S.S.E. 60.9

#767

Sta. 157+00.85

P.L. Brass Plate in pav't.

Shiner in 12" cherry N.N.W. 30.0

X base fire Hyd. W. 48.5

Shiner in 40' Elm E.S.E. 76.5

Shiner in 24' Elm S.S.E. 49.6