

O.D.O.T. DISTRICT 2 SURVEY OFFICE (USE ONLY)

PERSONNEL

REFERENCE NO. 35

SHEET 20 OF 23

NOTES BARRIERE
H.C. MILLER
R.C. BLUBAUGH

DATE 7/1/24
WEATHER SUNNY
TEMP. 68°

ROUTE SR 65
COUNTY WOOD
TOWNSHIP PERRYSBURG
SECTION 78

DWG BY BARRIERE PID 101291

T 8 N N 11 E

TYPE MONUMENT MAG/WASHER

ON SURFACE - BELOW ON

OFFSET $\varnothing$ PAVEMENT 5.8' LT LT : RT

TO EDGE PAVEMENT

STATION: 1198+18

HORIZ.DATUM: NAD83 (2011)

GEOID: 18

GRID: NORTHING: 706739.871


EASTING: 1676540.680

LDP: NORTHING: 528897.886


EASTING: 186605.235

79	80	81	82	83
78	●			
77				
76				

SEC 23

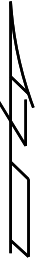

RECORD:
FD P.K. NAIL
4/24/91, MB
SET PK/WASHER
5-31-91, MB
CITY OF ROSSFORD
TO SET MONBOX
FD MONBOX
W/1" IPIN & DIMPLE
REF35
10-5-21, DSA
FD MONBOX
REF35
7/1/24, JAM

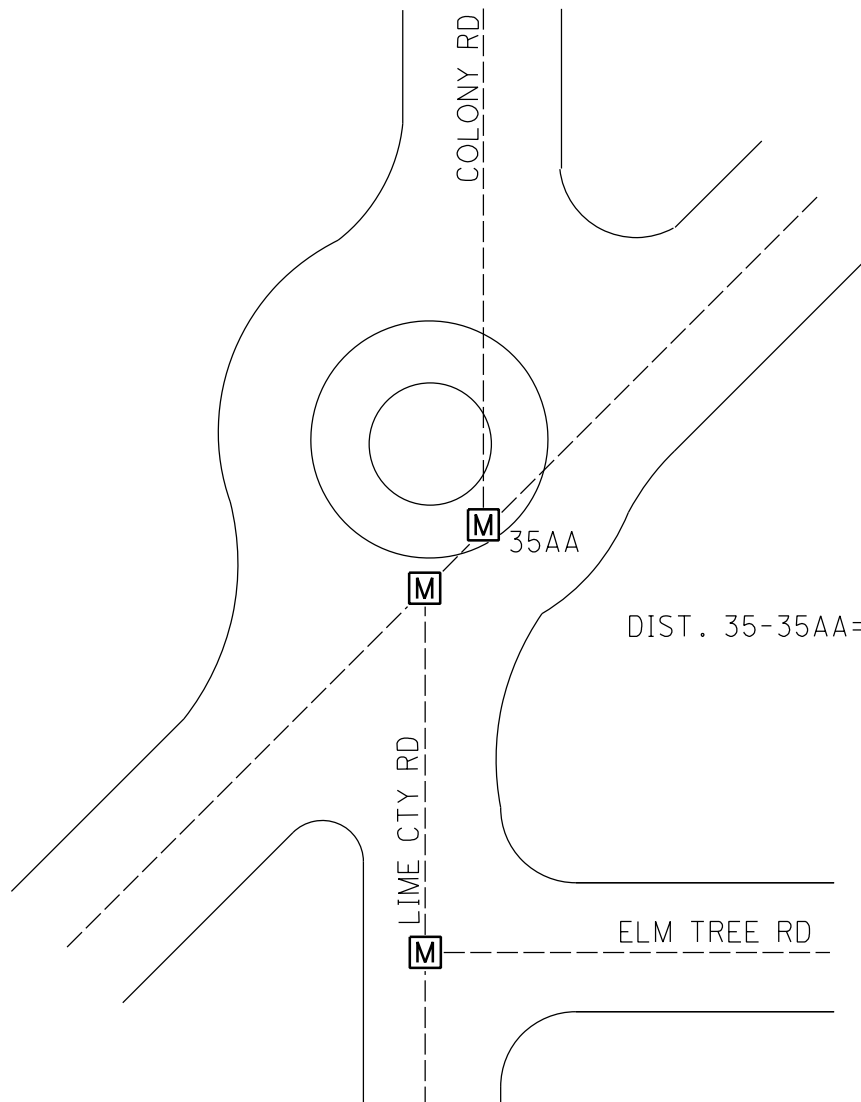

FD MONBOX
W/1" IPIN
N = 706631.394
E = 1676539.652

O.D.O.T. DISTRICT 2 SURVEY OFFICE (USE ONLY)

PERSONNEL

REFERENCE NO. 35

SHEET 9 OF 12

NOTES BARNHISEL

DATE 4-24-91

ROUTE SR 65

H.C. LOEHEKE

WEATHER CLOUDY

COUNTY WOOD

R.C. HOFFMAN

TEMP. 58° F

TOWNSHIP ROSSFORD

SECTION RT 78 | 80

DWG BY AUBLE

PID 90674

T 8 N

N 11 E

TYPE MONUMENT PK NAIL

ON SURFACE - ~~BELOW~~ ON

OFFSET Q PAVEMENT 5.8' LT : RT

- TO - EDGE PAVEMENT

STATION: 1198+18

HORZ.DATUM: NAD83 (2011)

GEOID: 18

GRID: NORTHING: 706739.871


EASTING: 1676540.680

79	80	81	82	83
78	●			
77	●			
76				

SEC
23



RECORD:
FD P.K. NAIL
4/24/91, MB
SET PK/WASHER
5-31-91, MB
CITY OF ROSSFORD
TO SET MONBOX
FD MONBOX
W/1" IPIN & DIMPLE
REF35
10-5-21, DSA

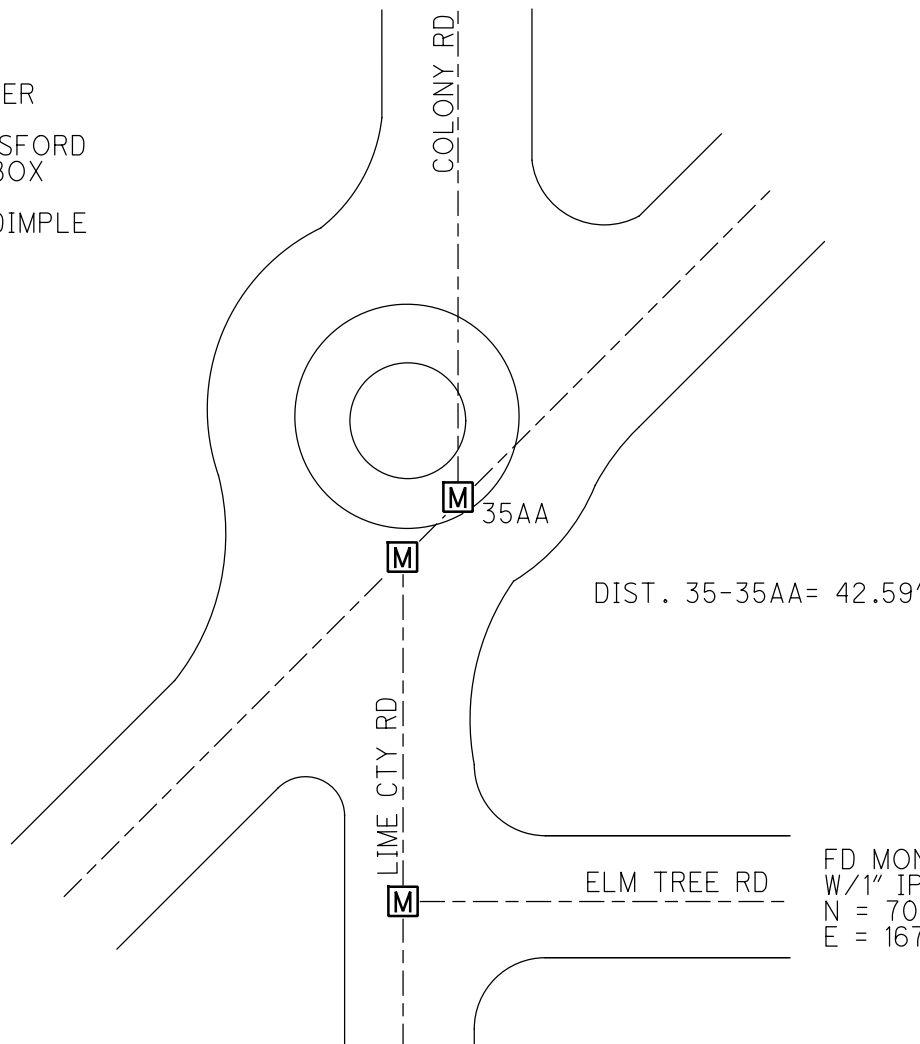

FD MONBOX
W/1" IPIN
N = 706631.394
E = 1676539.652

O.D.O.T. DISTRICT 2 SURVEY OFFICE

PERSONNEL

REFERENCE NO. 35

SHEET _____ OF _____

NOTES BARNHISEL

H.C. Loehke

R.C. Hoffman

DATE 4-24-91

WEATHER Cloudy

TEMP. + 58°

ROUTE Lo5

COUNTY Wood

TOWNSHIP ROSCFORDSECTION E.T. 78130

T S N R U E

Lucas Co. N



TYPE MONUMENT P.K. NAILS

ON SURFACE - BELOW yes

LEFT - C PAV'T. - RIGHT 5.8 5.8

22.8 TO LT EDGE PAVEMENT

S.L.M. 1198+18 PT "A"

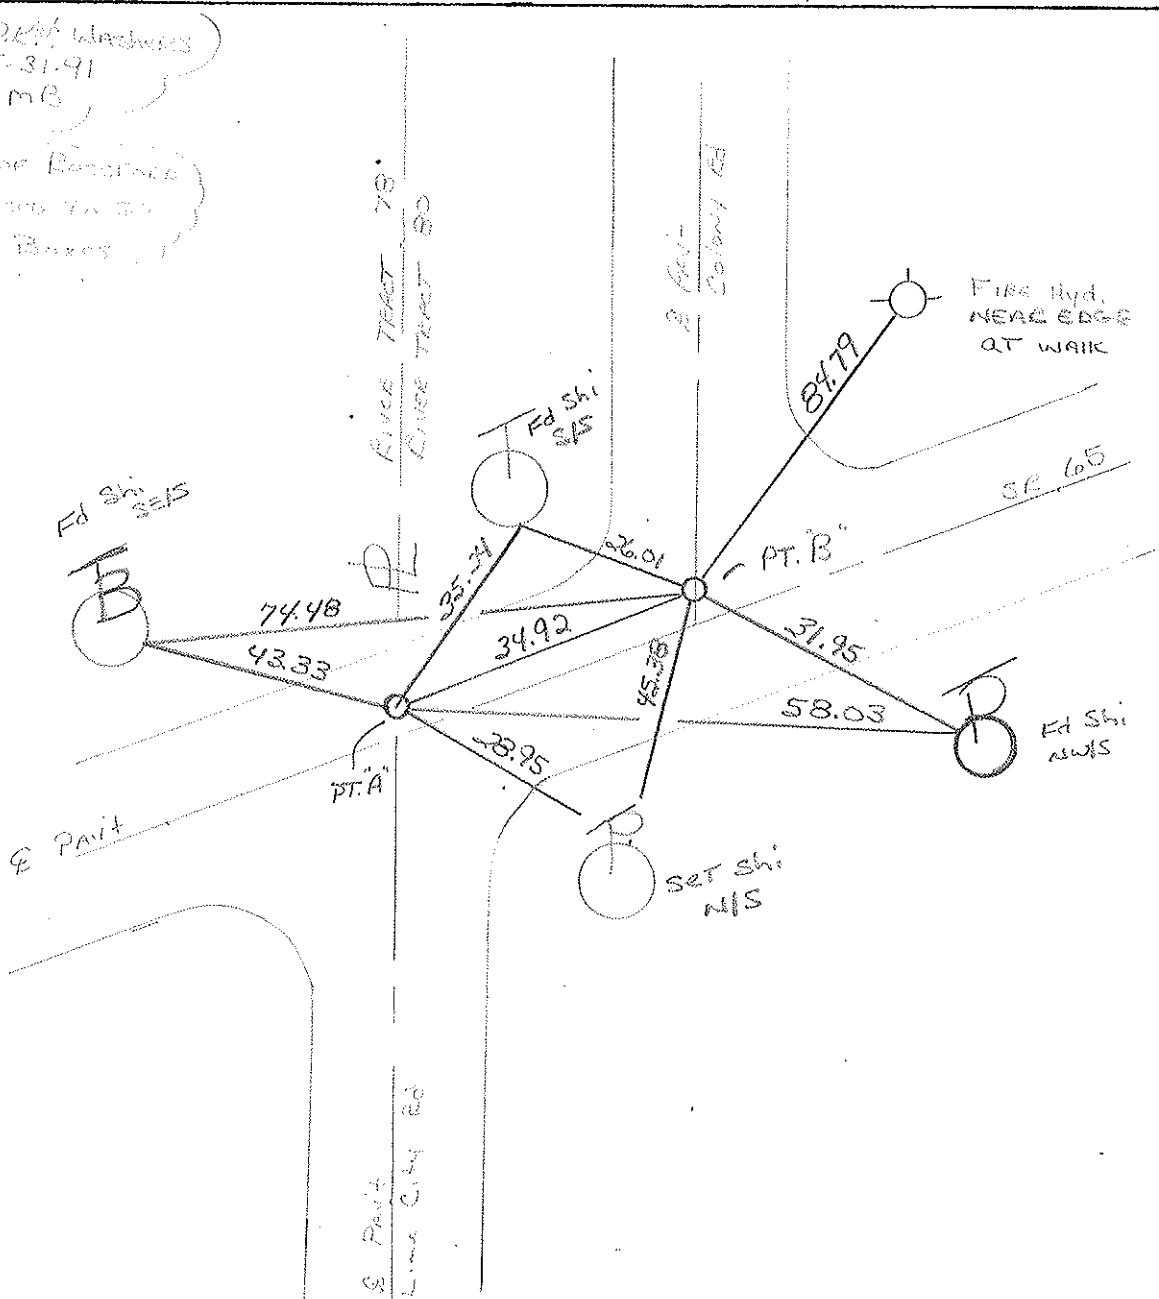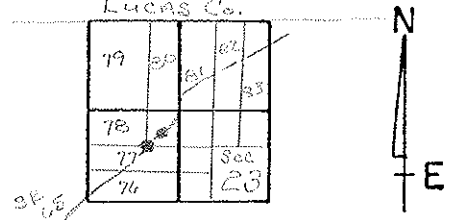

Q.D.O.T. DISTRICT 2 SURVEY OFFICE

SHEET ____ OF ____

County WOOD S.R. 65

Date 9-8-76

Township ROSSFORD, O.

Weather CLEAR

Section R.T. - 78-80


Temp. 90°

T8N, R11E

Personnel BURNSIDE

BOWERS


MEAD

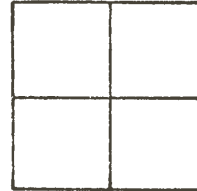

#35

NOTE:

STATIONING FROM
STATE PLAN - 1934
AND FIELD BOOK # WOO-113

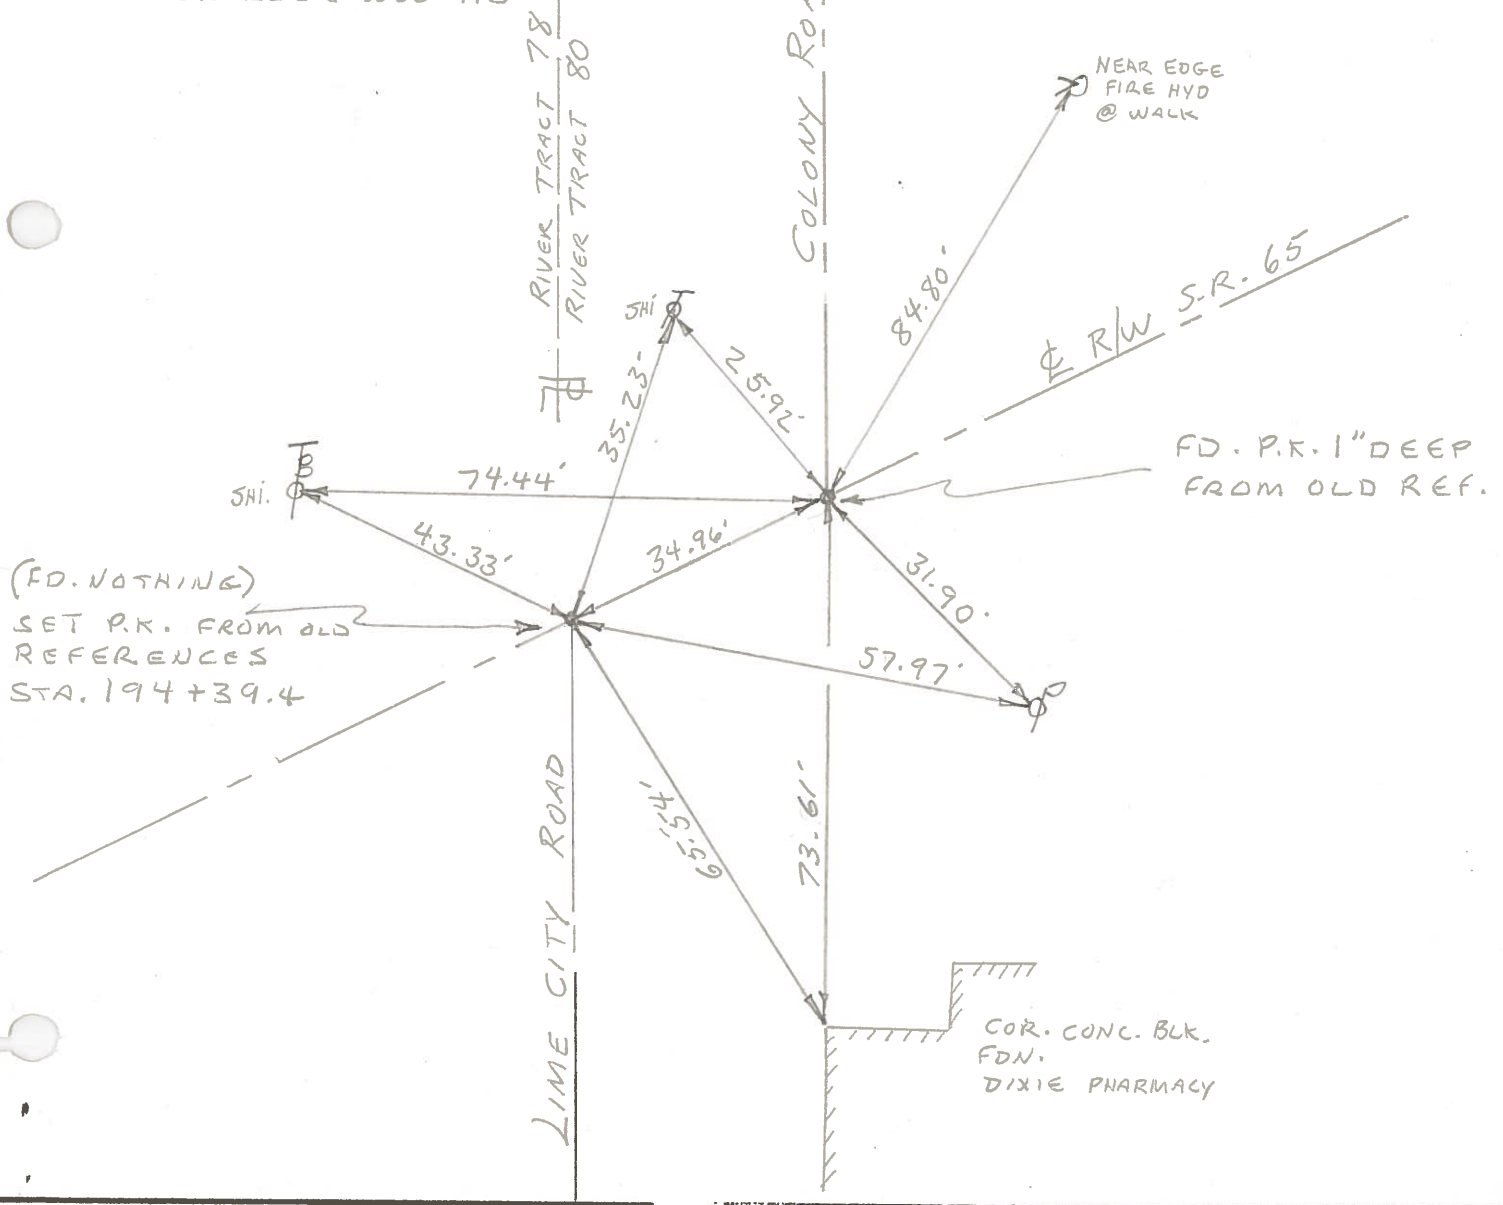

SHEET NO. _____

PERSONNEL	TITLE	PERSONNEL	TITLE
1	2	3	4
5	6	7	8
9	10	11	12
13	14	15	16
17	18	19	20
21	22	23	24
25	26	27	28
29	30	31	32
33	34	35	36
37	38	39	40
41	42	43	44
45	46	47	48
49	50	51	52
53	54	55	56
57	58	59	60
61	62	63	64
65	66	67	68
69	70	71	72
73	74	75	76
77	78	79	80
81	82	83	84
85	86	87	88
89	90	91	92
93	94	95	96
97	98	99	100

COUNTY Wood DATE Aug. 23, 1971

Granata #65 S. R. WEATHER Fair

S. R. 90 WEATHER 1 day

anyo _____ 10^0 's

Jackson _____ SEC. _____ TEMP. 80

20 M 20# SEC. TEMP.

SEC. _____ TEMP. _____ 82


TEMP. 80 _____

DESCRIPTION Reference Mon. on S.R. 65 JOB NO.

LEFT

CENTER LINE

RIGHT

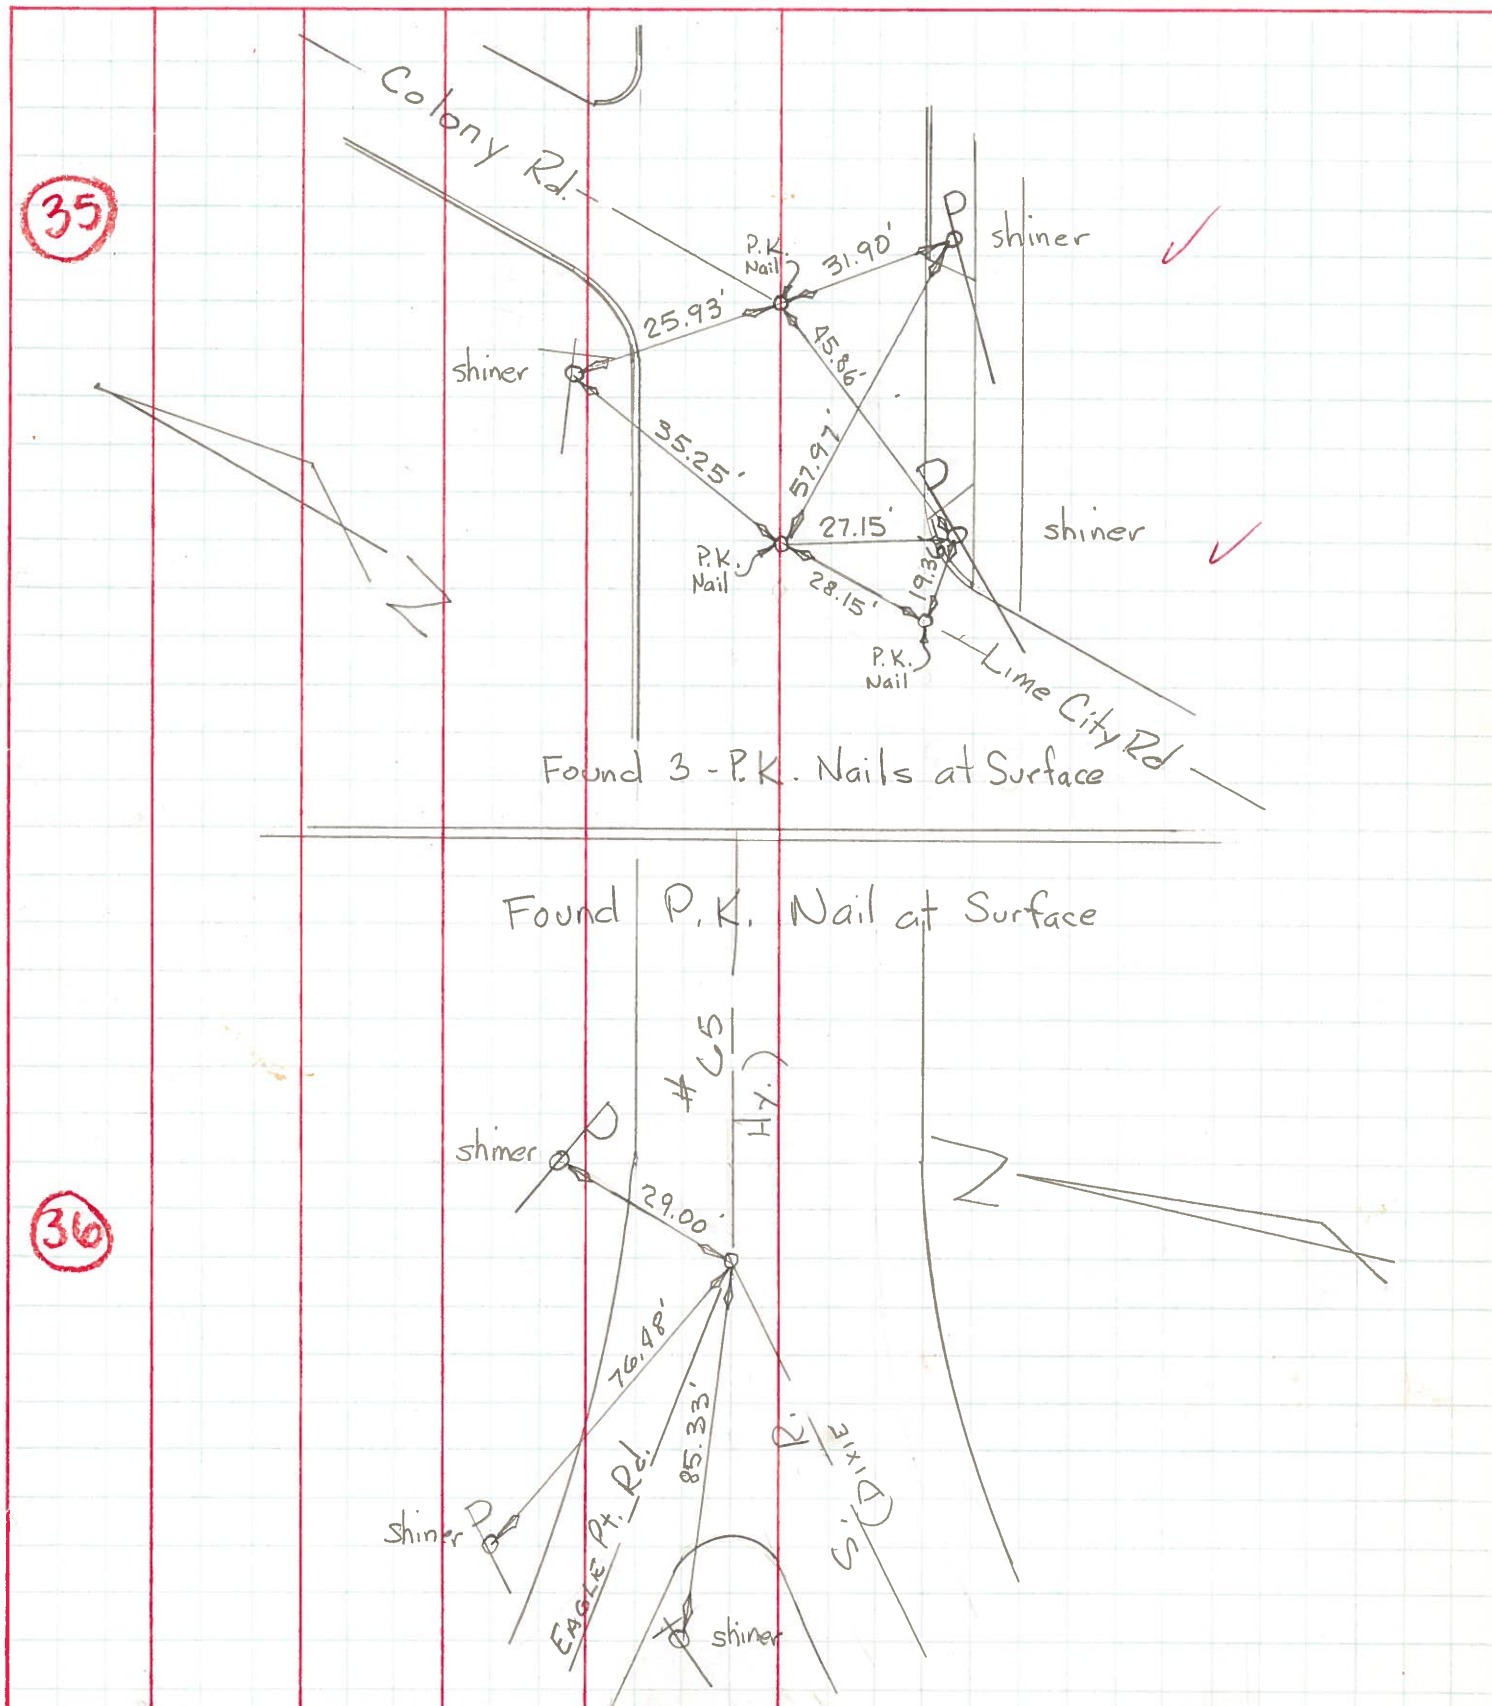

PERSONNEL

TITLE

PERSONNEL

TITLE

COUNTY

Wood

DATE

S. R.

65

WEATHER

SEC.

TEMP.

DESCRIPTION

LEFT

CENTER LINE

RIGHT

JOB NO.

Fd. P.K.

(32-D)

Replaced Log Bolt
5-24-65.

Shi 8' Coast

Shi 17' 6" 17.5
Near Top
Blue H 10.

Near Cor. conc.
Blue wood fence

Use fd iron Pin below P.K.

with { X in Curb w. 6.0
X " " NW 4.20
X " " N. 6.0

Shi 18' 7" in Elm

Bates Rd

Fd. P.K.

OK
8-24-65

Fd. P.K.

(35)

Shi. in
Cable poleShi. in
Cable Pole

Shi.

Shi.

LIME CITY Rd