

O.D.O.T. DISTRICT 2 SURVEY OFFICE (USE ONLY)

PERSONNEL

REFERENCE NO. A

SHEET 1 OF 30

NOTES O'DONNELL

DATE 9/13/19

ROUTE SR 105

H.C. -----

WEATHER -----

COUNTY WOOD

R.C. -----

TEMP. -----

TOWNSHIP CENTER

SECTION 20

DWG BY BALBAUGH PID 101007

T 5 N R 11 E

TYPE MONUMENT CMON

ON SURFACE - BELOW -

OFFSET Q PAVEMENT - LT : RT

- TO - EDGE PAVEMENT


STATION: 20+38.08

HORZ.DATUM: NAD83(2011)

GEOID: 2012A


GRID: NORTHING: 624134.539

EASTING: 1662801.316

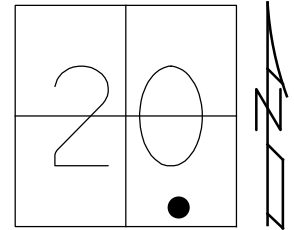

RECORD:
FD CMON
REFA1
9/13/19, JFO

NOTE: SR 64 REF 0

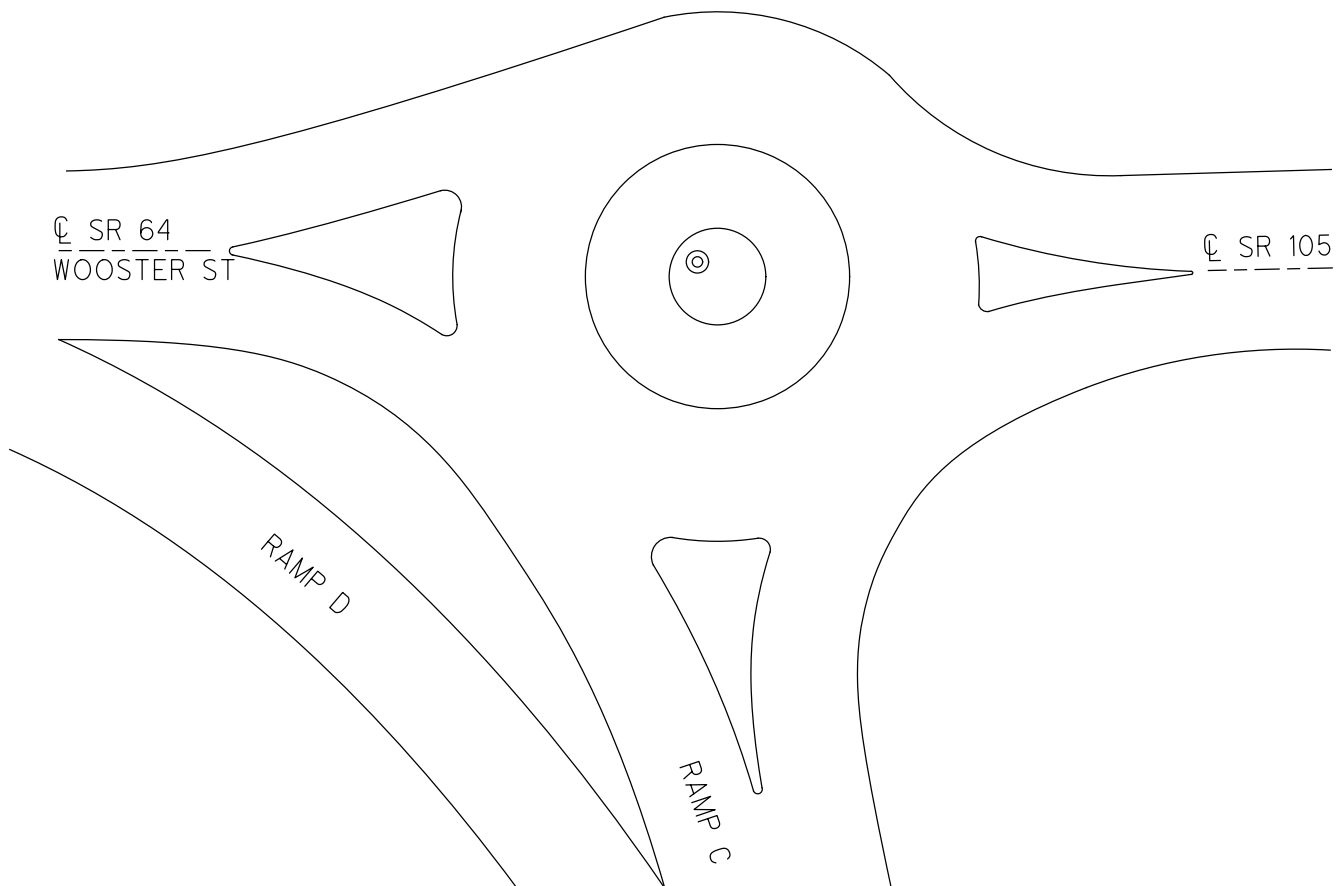

O.D.O.T. DISTRICT 2 SURVEY OFFICE (USE ONLY)

PERSONNEL

REFERENCE NO. B

SHEET 2 OF 30

NOTES MOSER

DATE 4/6/02

ROUTE SR 105

H.C. HOMAN

WEATHER PT CLOUDY

COUNTY WOOD

R.C. ROUSOS
CANTERBURY

TEMP. 40°

TOWNSHIP CENTER

DWG BY NIESE PID 101007

SECTION 20

T 5 N R 11 E

TYPE MONUMENT MONBOX

ON SURFACE - ~~BELOW~~ ON

OFFSET CL PAVEMENT 1.5' ~~LT~~ : RT

10.0' TO RT EDGE PAVEMENT


STATION: 25+93.18

HORIZ.DATUM: NAD83(2011)


GEOID: 2012A

GRID: NORTHING: 624123.469

EASTING: 1663356.256

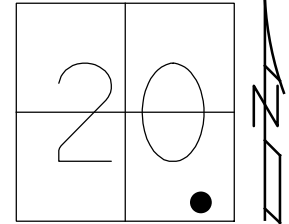

RECORD:
FD MONBOX
W/1" IPIN
REFB1
8/13/19, JFO

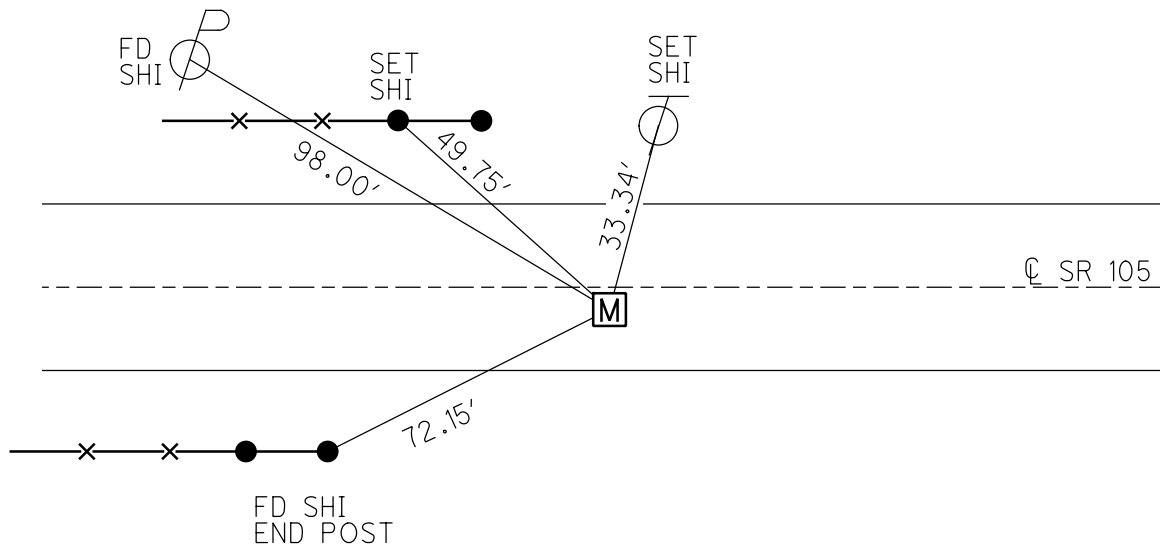

O.D.O.T. DISTRICT 2 SURVEY OFFICE (USE ONLY)

PERSONNEL

REFERENCE NO. C

SHEET 3 OF 30

NOTES MOSER
H.C. HOMAN
R.C. ROUSOS
CANTERBURY

DATE 4/6/02
WEATHER PT CLOUDY
TEMP. 40°

ROUTE SR 105
COUNTY WOOD
TOWNSHIP CENTER
SECTION 21
T 5 N R 11 E

DWG BY NIESE PID 101007

TYPE MONUMENT P.K./WASHER

ON SURFACE - ~~BELOW~~ ON

OFFSET Q PAVEMENT ON LT : RT

- TO - EDGE PAVEMENT



STATION: 30+20.52

HORZ.DATUM: NAD83(2011)

GEOID: 2012A

GRID: NORTHING: 624114.607

EASTING: 1663783.458

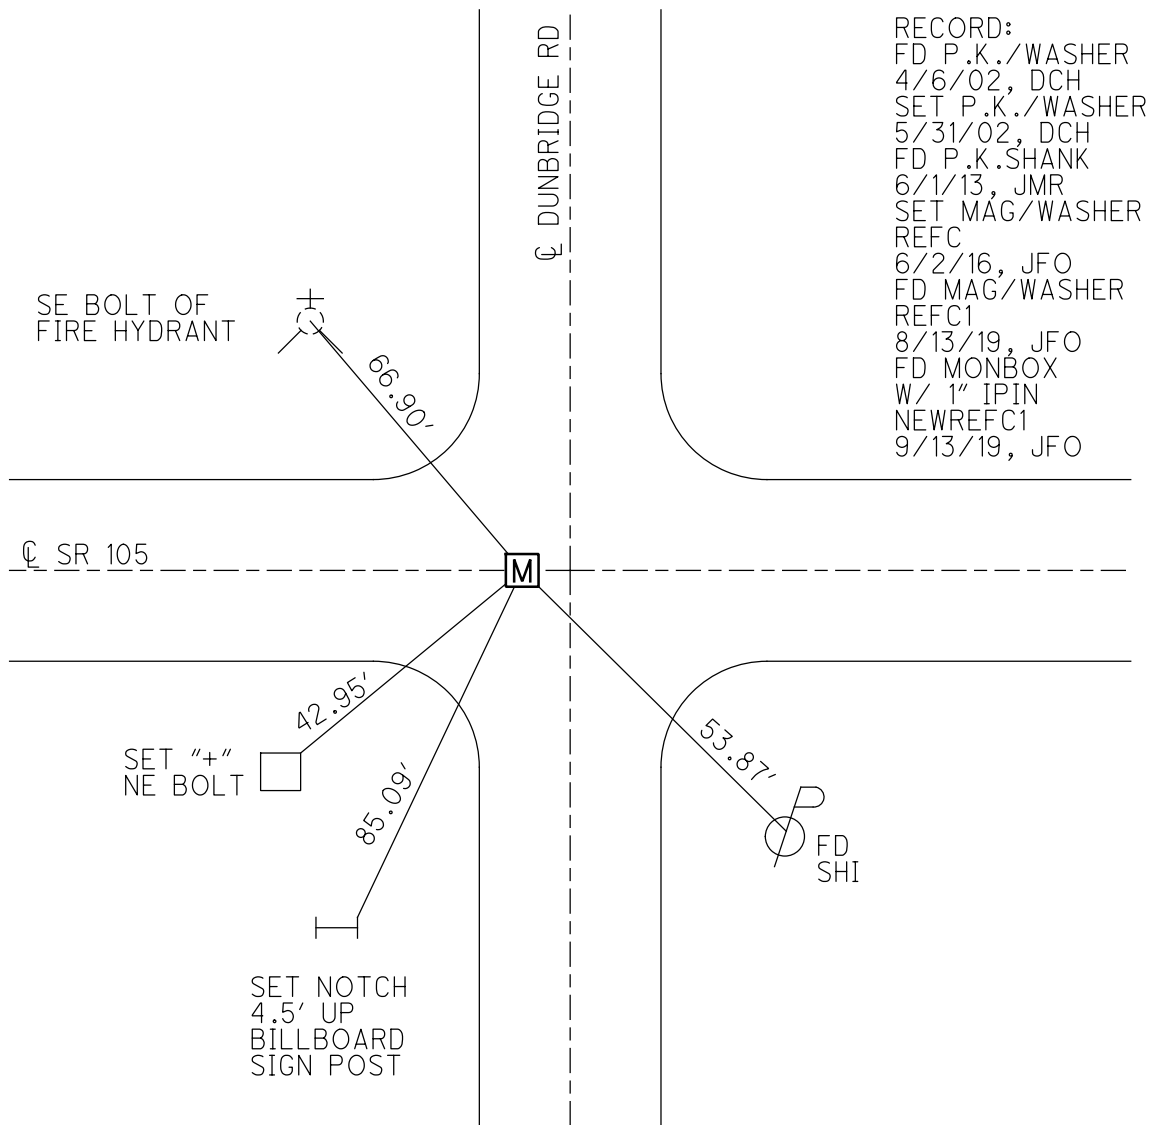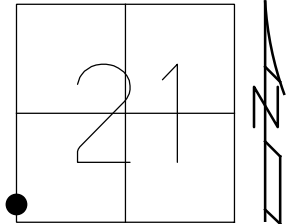


RECORD:
FD P.K./WASHER
4/6/02, DCH
SET P.K./WASHER
5/31/02, DCH
FD P.K.SHANK
6/1/13, JMR
SET MAG/WASHER
REFC
6/2/16, JFO
FD MAG/WASHER
REFC1
8/13/19, JFO
FD MONBOX
W/ 1" IPIN
NEWREFC1
9/13/19, JFO

O.D.O.T. DISTRICT 2 SURVEY OFFICE (USE ONLY)


PERSONNEL	REFERENCE NO. <u>C 1</u>	SHEET <u>3</u> OF <u>28</u>
NOTES	DATE <u>9/9/16</u>	ROUTE <u>SR 105</u>
H.C. <u>RHOADES</u>	WEATHER <u>FAIR</u>	COUNTY <u>WOOD</u>
R.C. <u>O'DONNELL</u>	TEMP. <u>76°</u>	TOWNSHIP <u>CENTER</u>
		SECTION <u>21</u>
		<u>T 5 N R 11 E</u>

TYPE MONUMENT P.K./WASHER
 ON SURFACE - ~~BELOW~~ ON
~~LEFT~~ - CL PAV'T - RIGHT 4.6'
7' TO RT EDGE PAVEMENT
 S.L.M. 49+11

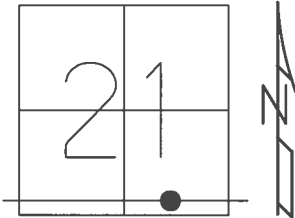

GRID: NORTHING: 624058.634 EASTING: 1666391.349


RECORD:
 ORIGIN UNKNOWN
 FD P.K./WASHER
 4/6/02, DCH
 SET P.K./WASHER
 5/31/02, DCH
 FD P.K./WASHER
 REFC1
 6/2/16, JFO

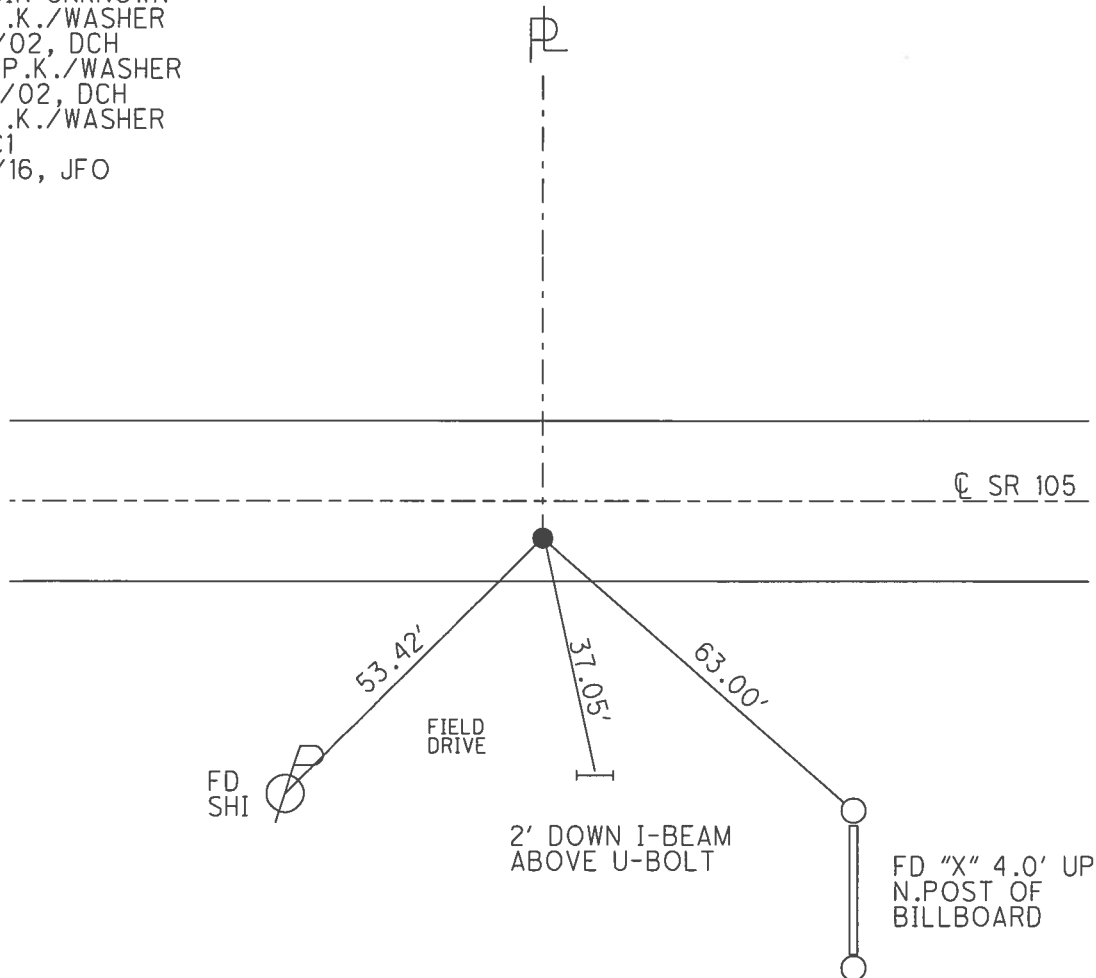

O.D.O.T. DISTRICT 2 SURVEY OFFICE (USE ONLY)


PERSONNEL _____ REFERENCE NO. D SHEET 4 OF 28
 NOTES RHOADES DATE 9/9/16 ROUTE SR 105
 H.C. O'DONNELL WEATHER FAIR COUNTY WOOD
 R.C. RHOADES TEMP. 76° TOWNSHIP CENTER
 SECTION 21
 T 5 N R 11 E

TYPE MONUMENT P.K./WASHER
 ON SURFACE - ~~BELOW~~ ON _____
~~LEFT~~ - CL PAV'T - RIGHT 8.6', 11' W OF CL N
 - TO - EDGE PAVEMENT
 S.L.M. 76+02

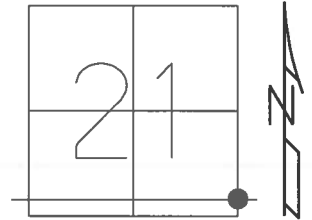

GRID: NORTHING: 624000.295 EASTING: 1669079.759

RECORD:
 80 RDS. N. OF SE.
 COR. SEC. 21
 CENTER TWP.
 FD P.K./WASHER
 4/6/02, DCH
 SET P.K./WASHER
 5/31/02, DCH
 FD P.K./WASHER
 6/1/16, JMR
 REFD
 6/2/16, JFO
 FD 6" HOLE
 9/9/16
 SET MAG/WASHER
 NEWREFD
 10/5/16, JFO

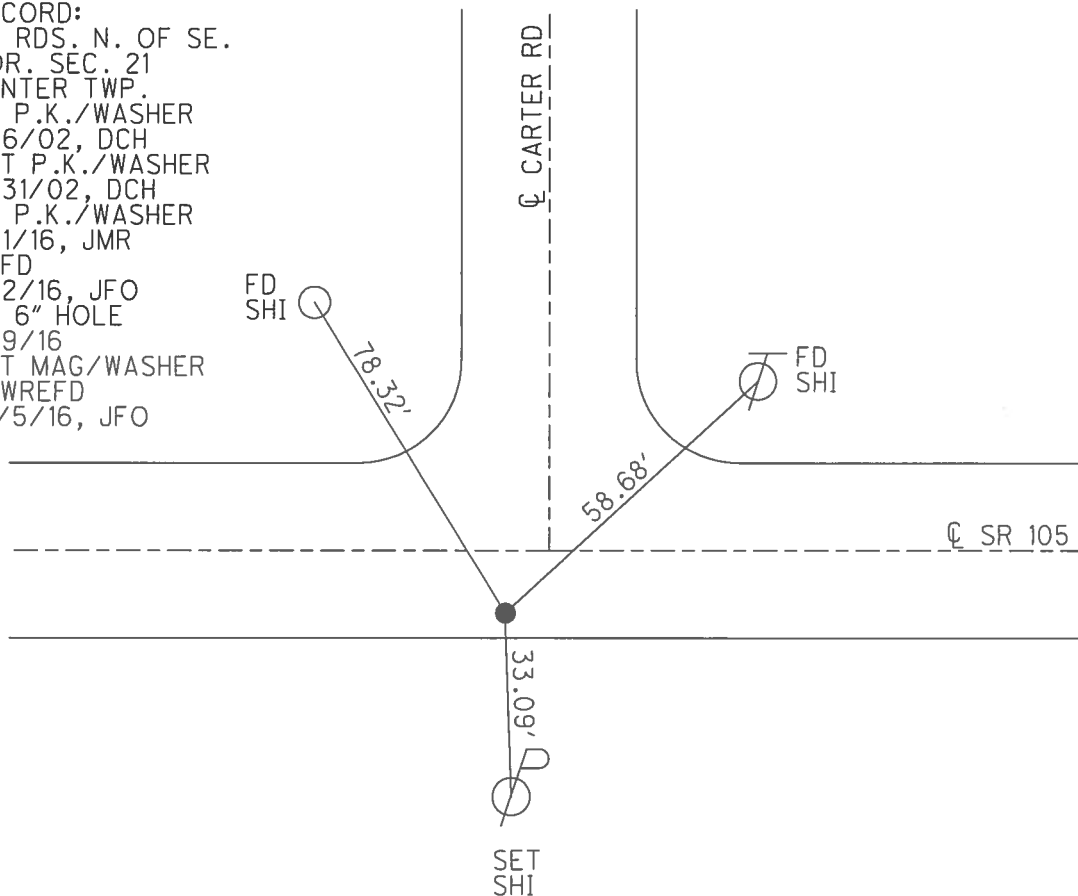

O.D.O.T. DISTRICT 2 SURVEY OFFICE (USE ONLY)

PERSONNEL	REFERENCE NO. <u>E</u>	SHEET <u>5</u> OF <u>28</u>
NOTES	DATE <u>9/9/16</u>	ROUTE <u>SR 105</u>
H.C. <u>RHOADES</u>	WEATHER <u>FAIR</u>	COUNTY <u>WOOD</u>
R.C. <u>RHOADES</u>	TEMP. <u>76°</u>	TOWNSHIP <u>CENTER</u>
		SECTION <u>22</u>
		T <u>5</u> N R <u>11</u> E

TYPE MONUMENT MAG/WASHER


ON SURFACE - ~~BELOW~~ ON

~~LEFT~~ - CL PAV'T - RIGHT 13.7', 3.5' E OF CL


2.5' TO RT EDGE PAVEMENT

S.L.M. 102+77

GRID: NORTHING: 623916.313 EASTING: 1671754.306

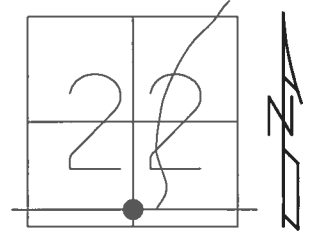

RECORD:
 80 RDS. N. OF S.
 POST SEC. 22
 CENTER TWP.
 FD P.K./WASHER
 4/6/02, DCH
 FD P.K./WASHER
 4/6/02, DCH
 SET P.K./WASHER
 5/31/02, DCH
 FD P.K.SHANK
 6/16/16, JMR
 SET MAG/WASHER
 REFE
 6/26/16, JFO
 UNCOVERED
 1 1/2" DOWN
 5/23/17, JFO

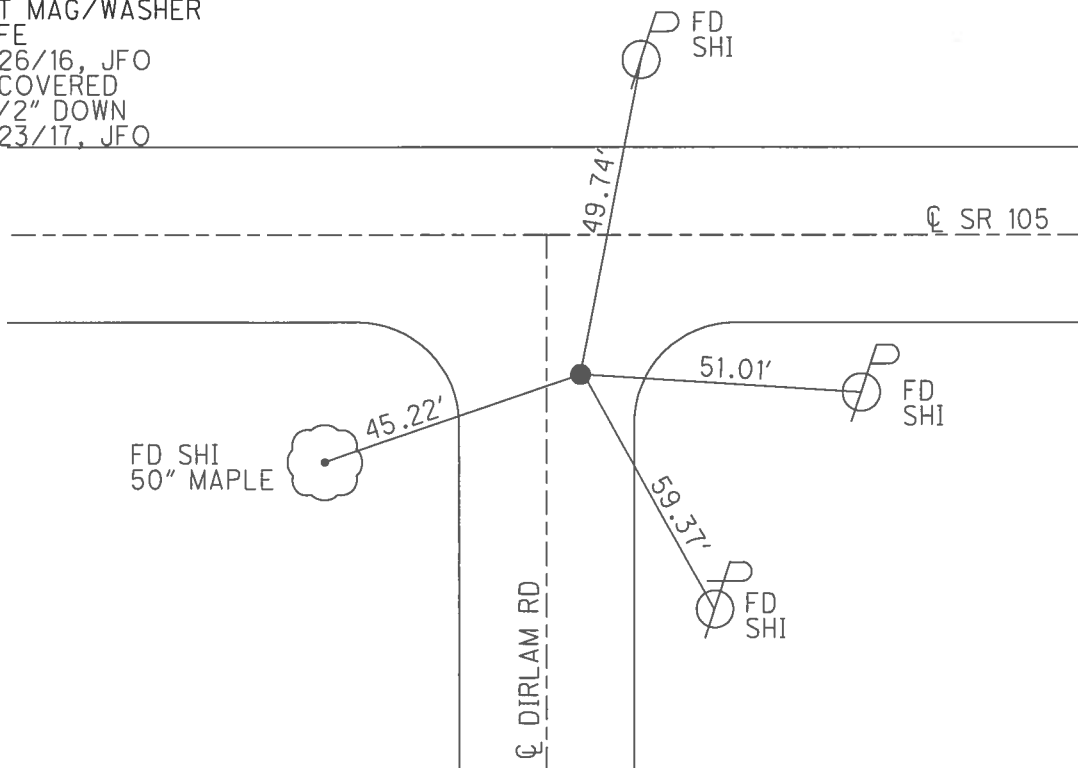

O.D.O.T. DISTRICT 2 SURVEY OFFICE (USE ONLY)

PERSONNEL

REFERENCE NO. F

SHEET 6 OF 28

NOTES ASTON

DATE 4/12/2024

ROUTE SR 105

H.C. MILLER

WEATHER CLOUDY

COUNTY WOOD

R.C. NIESE

TEMP. 30°

TOWNSHIP CENTER

SECTION 22

DWG BY _____ PID NO PID

T 5 N R 11 E

TYPE MONUMENT MAG & WASHER

ON SURFACE - BELOW ON

OFFSET Q PAVEMENT 0.5' ~~LT~~ : RT

11.2' TO RT EDGE PAVEMENT


STATION: 107+49

HORZ.DATUM: LDP:WOOD


GEOID: 18

GRID: NORTHING: 623917.784

EASTING: 1672227.236

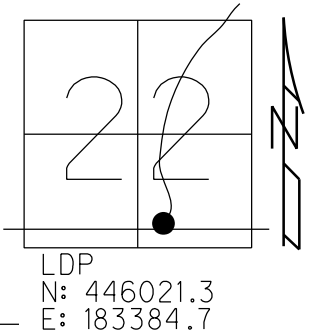

RECORD:
FD P.K./WASHER
4/6/02, DCH
SET P.K./WASHER
5-31-02, DCH
FD R.R.SPIKE
6" DOWN
REF F
6/2/16, JFO
SET MAG/WASHER
NEWREF F
10/5/16, JFO
FD MAG/W
REF F
4-12-24/ JAM

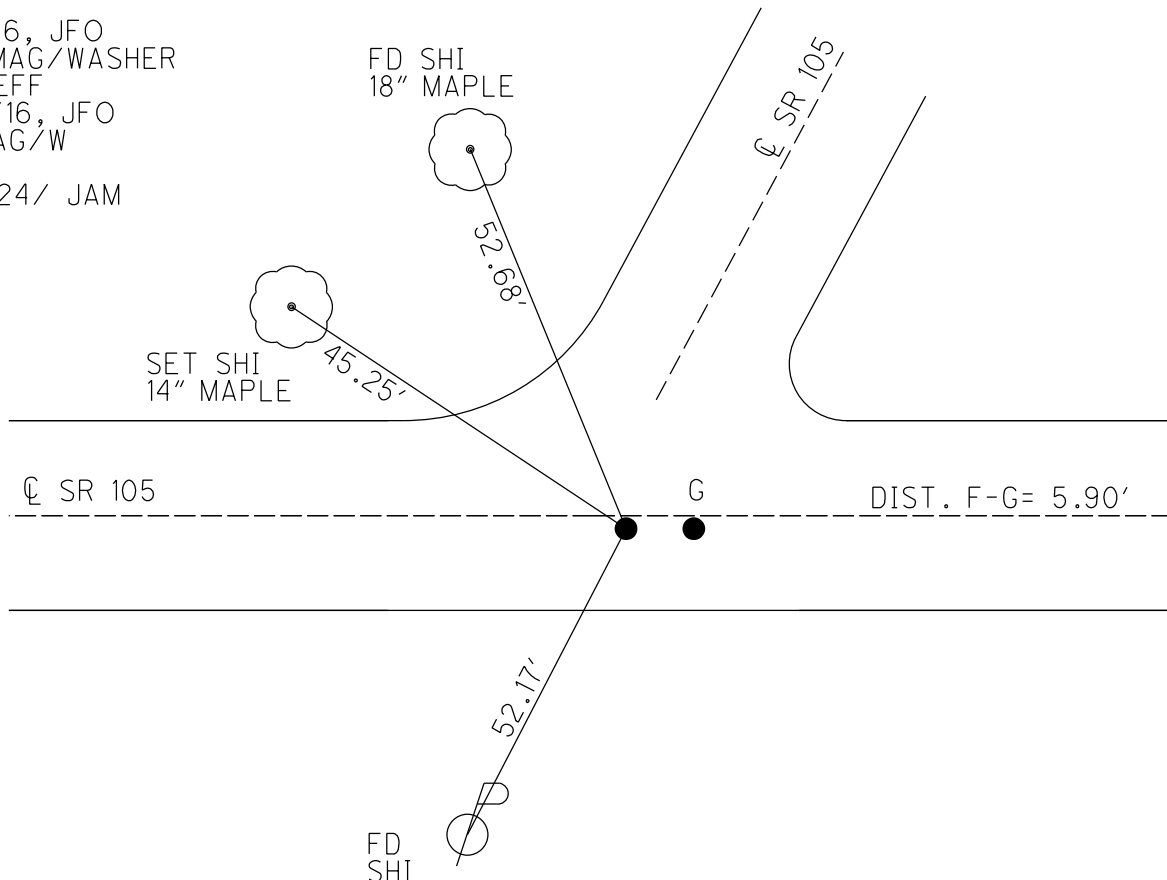

O.D.O.T. DISTRICT 2 SURVEY OFFICE (USE ONLY)

PERSONNEL

REFERENCE NO. G

SHEET 8 OF 30

NOTES

MOSER

DATE

4/6/02

ROUTE

SR 105

H.C.

HOMAN

WEATHER

PT CLOUDY

COUNTY

WOOD

R.C.

ROUSOS

TEMP.

40

TOWNSHIP

CENTER

CANTERBURY

SECTION

22

T 5 N R 11 E

TYPE MONUMENT P.K./WASHER


ON SURFACE - ~~BELOW~~ ON

~~LEFT~~ - C PAV'T - RIGHT 0.5'

11.2' TO RT EDGE PAVEMENT

S.L.M. 107+49

GRID: NORTHING: _____ EASTING: _____

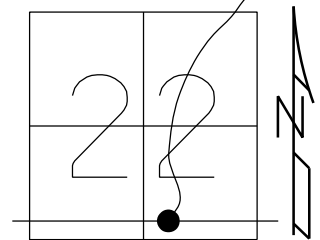

RECORD:

SET P.K./WASHER


5-31-02, DCH

D.N.F.

6/2/16, JFO

D.N.F.

4-12-24, JAM

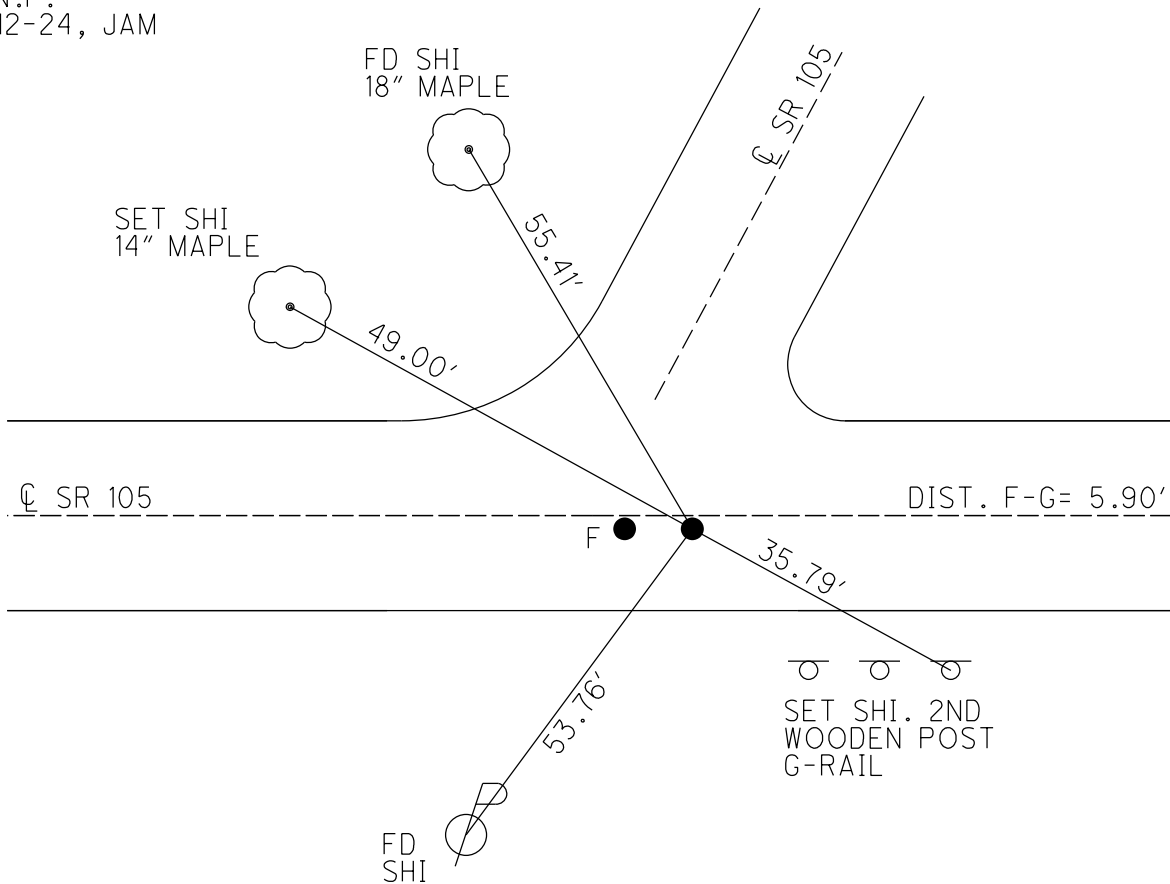

O.D.O.T. DISTRICT 2 SURVEY OFFICE (USE ONLY)

PERSONNEL

REFERENCE NO. 1

SHEET 8 OF 28

NOTES ASTON

DATE 4/12/2024

ROUTE SR 105

H.C. MILLER

WEATHER CLOUDY

COUNTY WOOD

R.C. NIESE

TEMP. 30°

TOWNSHIP CENTER

SECTION 22

DWG BY _____ PID NO PID

T 5 N R 11 E

TYPE MONUMENT 1" IPIPE

~~ON SURFACE~~ - BELOW 8"

OFFSET Q PAVEMENT 20.7' LT : RT

9.1' TO RT EDGE PAVEMENT


STATION: 107+44

HORIZ.DATUM: LDP:WOOD

GEOID: 18


GRID: NORTHING: 623898.247

EASTING: 1672232.362

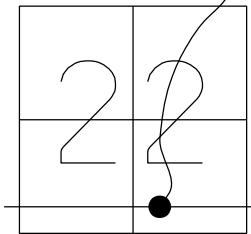

LDP
N: 446001.8
E: 183390.0

RECORD: 1972
SET 1" IPIPE
AS PER PLAN
STA: 107+71.20
FD 1" IPIPE
6" DOWN
REF1
6/2/16, JFO
FD 1" IPIPE
9" DOWN
REF1
4-12-24, JAM

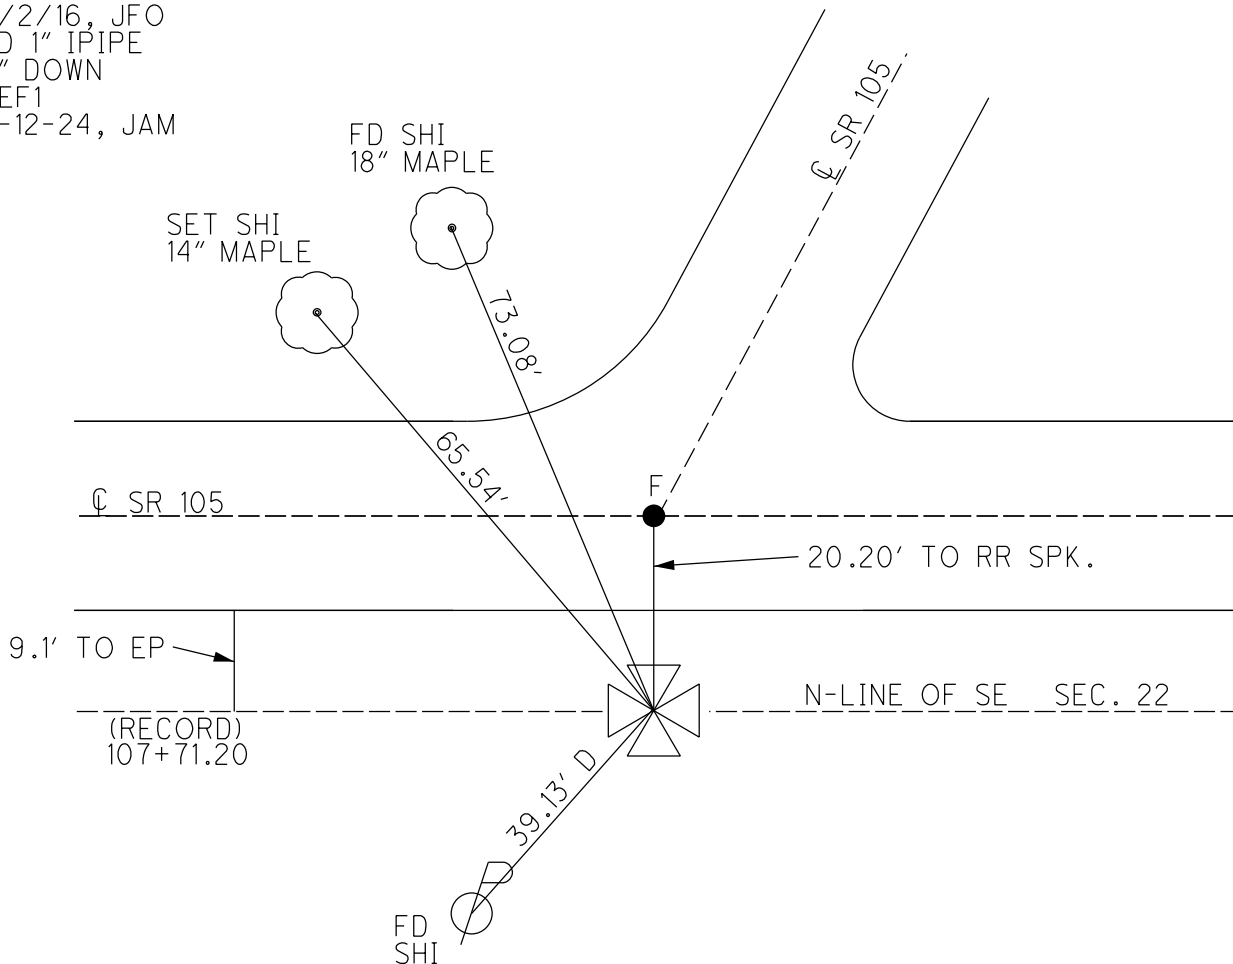

O.D.O.T. DISTRICT 2 SURVEY OFFICE (USE ONLY)

PERSONNEL

REFERENCE NO. 2

SHEET 9 OF 30

NOTES ASTON

DATE 4/12/2024

ROUTE SR 105

H.C. MILLER

WEATHER CLOUDY

COUNTY WOOD

R.C. NIESE

TEMP. 30°

TOWNSHIP CENTER

SECTION 22

DWG BY _____ PID NO PID

T 5 N R 11 E

TYPE MONUMENT 1/2" IPIN

ON SURFACE - BELOW 6"

OFFSET Q PAVEMENT 13.1' RT : RT

3.2' TO RT EDGE PAVEMENT


STATION: 109+19

HORZ.DATUM: LDP:WOOD


GEOID: 18

GRID: NORTHING: 624079.692

EASTING: 1672299.317

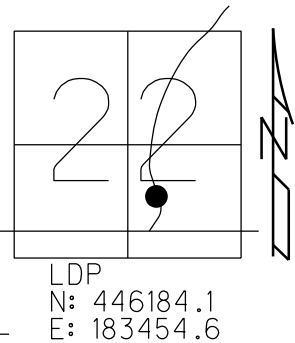

RECORD: P.I.
STA. 109+64.46
 $\Delta = 15^\circ 44' \text{ LT}$
FD 1/2" IPIN
8" DOWN
REF2
6/2/16, JFO
FD 1/2" IPIN
8" DOWN
REF2
4/12/24, JAM

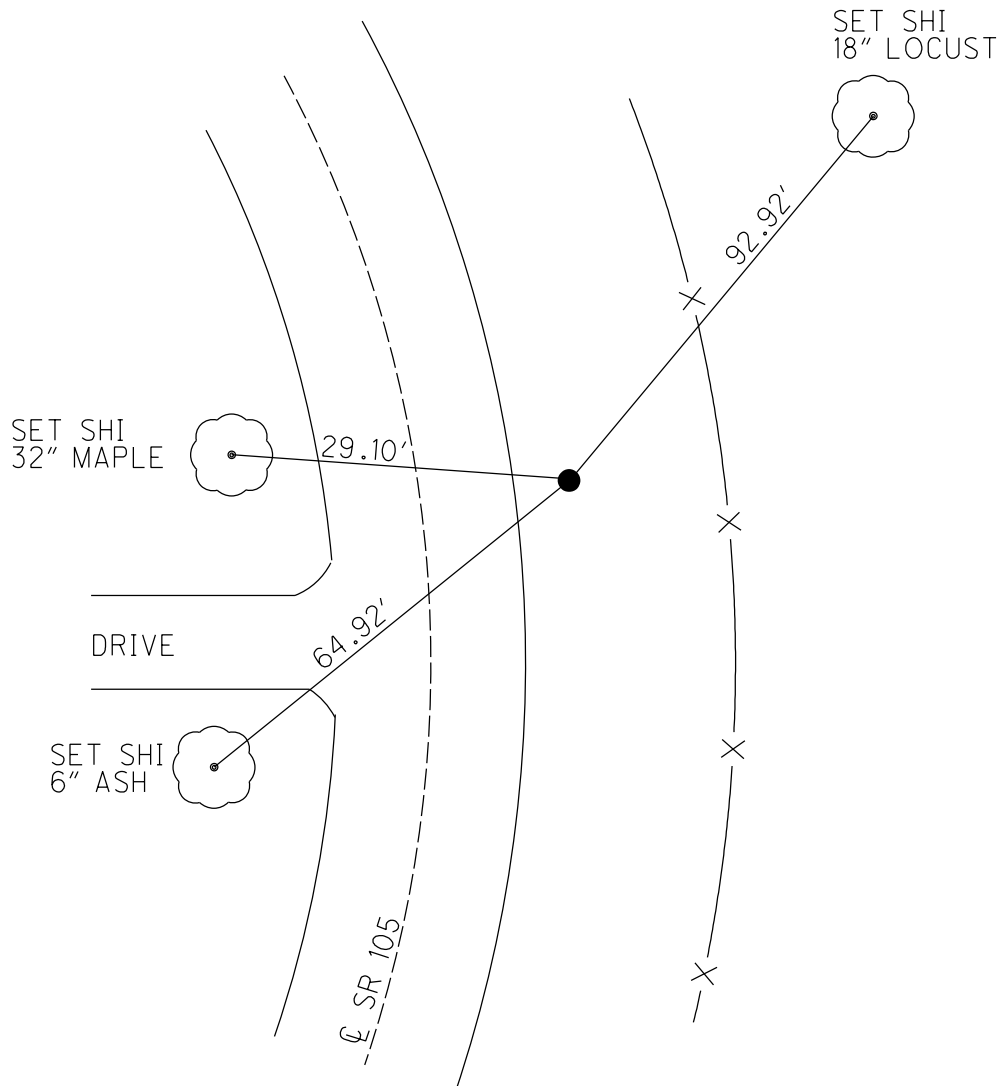

O.D.O.T. DISTRICT 2 SURVEY OFFICE (USE ONLY)

PERSONNEL

REFERENCE NO. 3

SHEET 10 OF 30

NOTES ASTON
H.C. MILLER
R.C. NIESE

DATE 4/12/2024
WEATHER CLOUDY
TEMP. 30°

ROUTE SR 105
COUNTY WOOD
TOWNSHIP CENTER
SECTION 22
T 5 N R 11 E

DWG BY _____ PID NO PID

TYPE MONUMENT P.K./ WASHER

ON SURFACE - BELOW ON

OFFSET Q PAVEMENT 3.2' LT : ~~RT~~
6.4' TO LT EDGE PAVEMENT


STATION: 109+19

HORZ.DATUM: LDP:WOOD


GEOID: 18

GRID: NORTHING: 624613.823

EASTING: 1672340.0574

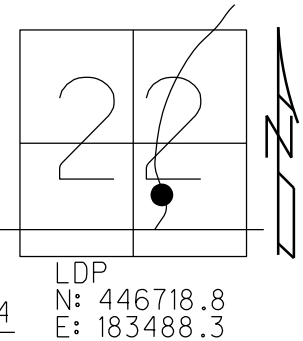

RECORD: P.I.
STA. 115+00.00
 $\Delta = 11^\circ 58' \text{ RT}$
FD P.K./WASHER
4/13/02, MB
SET P.K./WASHER
5/31/02, DCH
FD P.K./WASHER
REF3
6/2/16, JFO
UNCOVERED 1" DOWN
5/23/17, JFO
FD PK/W DOWN 1"
REF3
4/12/24, JAM

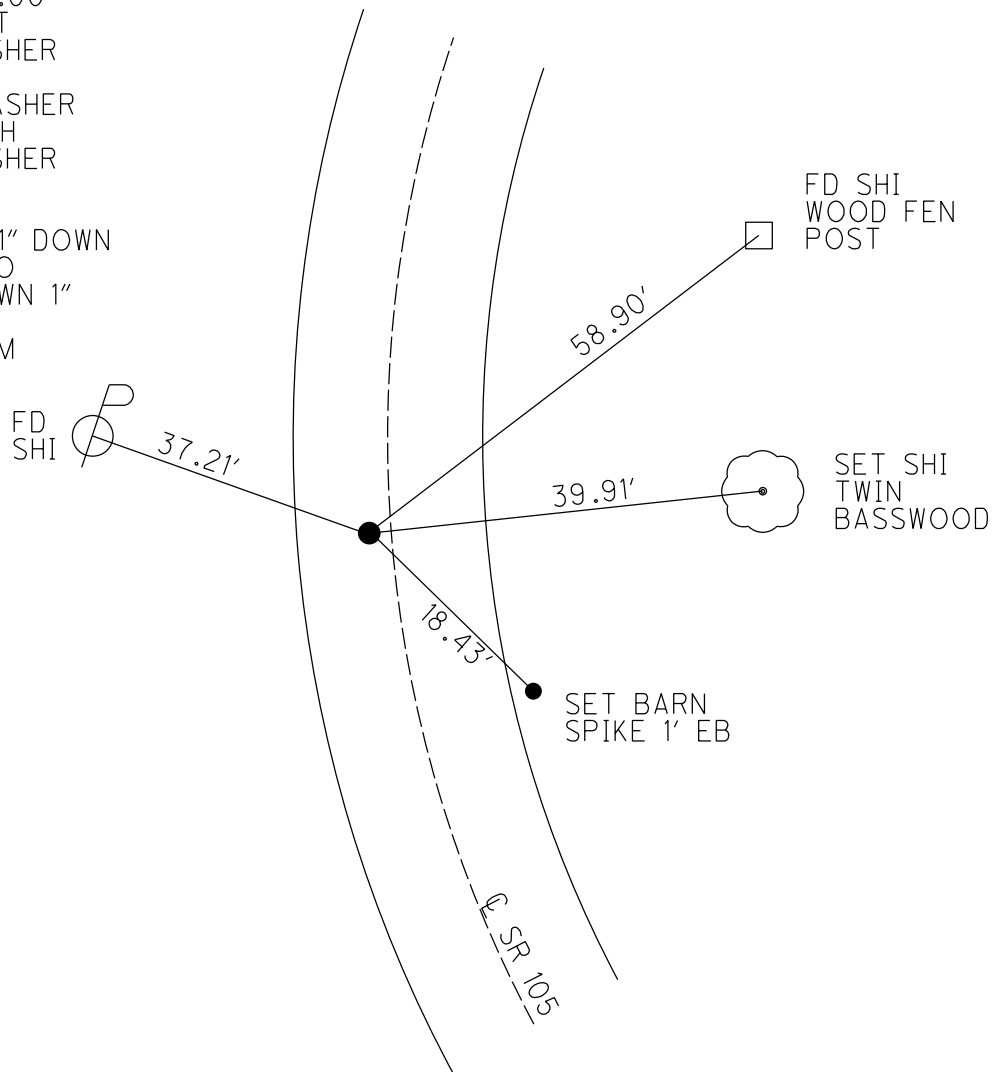

O.D.O.T. DISTRICT 2 SURVEY OFFICE (USE ONLY)

PERSONNEL

REFERENCE NO. 4

SHEET 12 OF 30

NOTES ASTON

DATE 4/12/24

ROUTE SR 105

H.C. MILLER

WEATHER CLOUDY

COUNTY WOOD

R.C. NIESE

TEMP. 30°

TOWNSHIP CENTER

SECTION 22

DWG BY _____ PID NO PID

T 5 N R 11 E

TYPE MONUMENT P.K./ WASHER

ON SURFACE - BELOW ON

OFFSET Q PAVEMENT 0.4' LT : RT

9.5' TO RT EDGE PAVEMENT


STATION: 116+27

HORZ.DATUM: LDP: WOOD


GEOID: 18

GRID: NORTHING: 624778.638

EASTING: 1672388.494

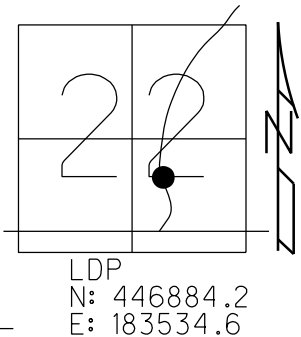

RECORD: P.I.
STA. 116+71.85
 $\Delta = 2^\circ 31' 40''$ RT
FD P.K./WASHER
4/13/02, MB
SET P.K./WASHER
5/31/02, DCH
FD P.K./WASHER
REF 4]6/2/16, JFO
UNCOVERED 1 1/2" DOWN
5/23/17, JFO
FD RUST SPOT
REF 4
4-12-24, TDN

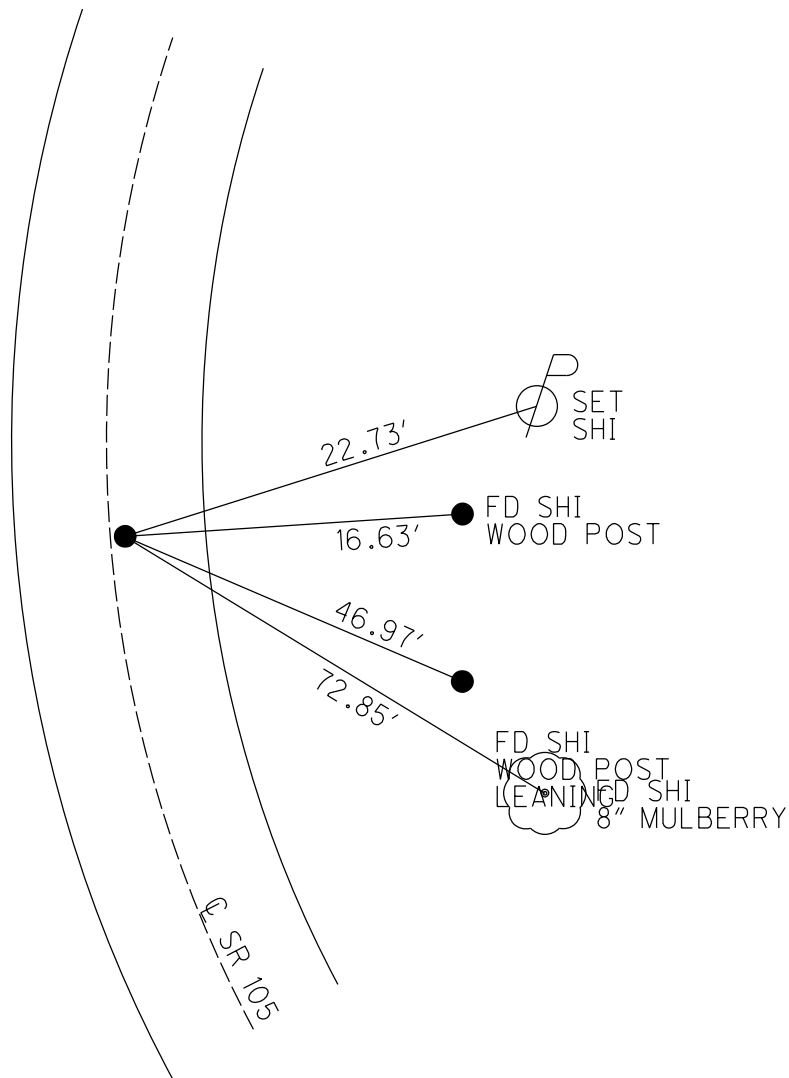

O.D.O.T. DISTRICT 2 SURVEY OFFICE (USE ONLY)

PERSONNEL

REFERENCE NO. 5

SHEET 13 OF 30

NOTES ASTON

DATE 4/22/24

ROUTE SR 105

H.C. MILLER

WEATHER BREEZY

COUNTY WOOD

R.C. NIESE

TEMP. 50°

TOWNSHIP CENTER

SECTION 22

DWG BY _____ PID NO PID

T 5 N R 11 E

TYPE MONUMENT MINI MAG/ WASHER

ON SURFACE - BELOW ON

OFFSET Q PAVEMENT 2.7' LT : ~~RT~~
7' TO LT EDGE PAVEMENT


STATION: 117+65

HORZ.DATUM: LDP:WOOD


GEOID: 18

GRID: NORTHING: 624910.033

EASTING: 1672433.494

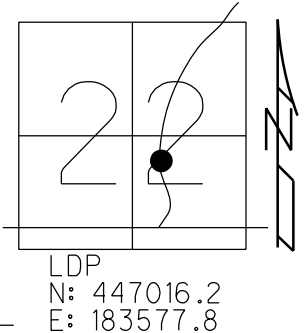

RECORD: P.I.
STA. 118+10.85
 $\Delta = 5^{\circ} 24' 20''$ RT
FD P.K./WASHER
4/15/02, MC
SET P.K./WASHER
6/12/02, DCH
FD P.K./WASHER
REF5
6/2/16, JFO
SET 1" MAG/WASHER
NEWREF5
6/20/17, JFO
FD MINI MAG/W
REF5
4-22-24, TDN

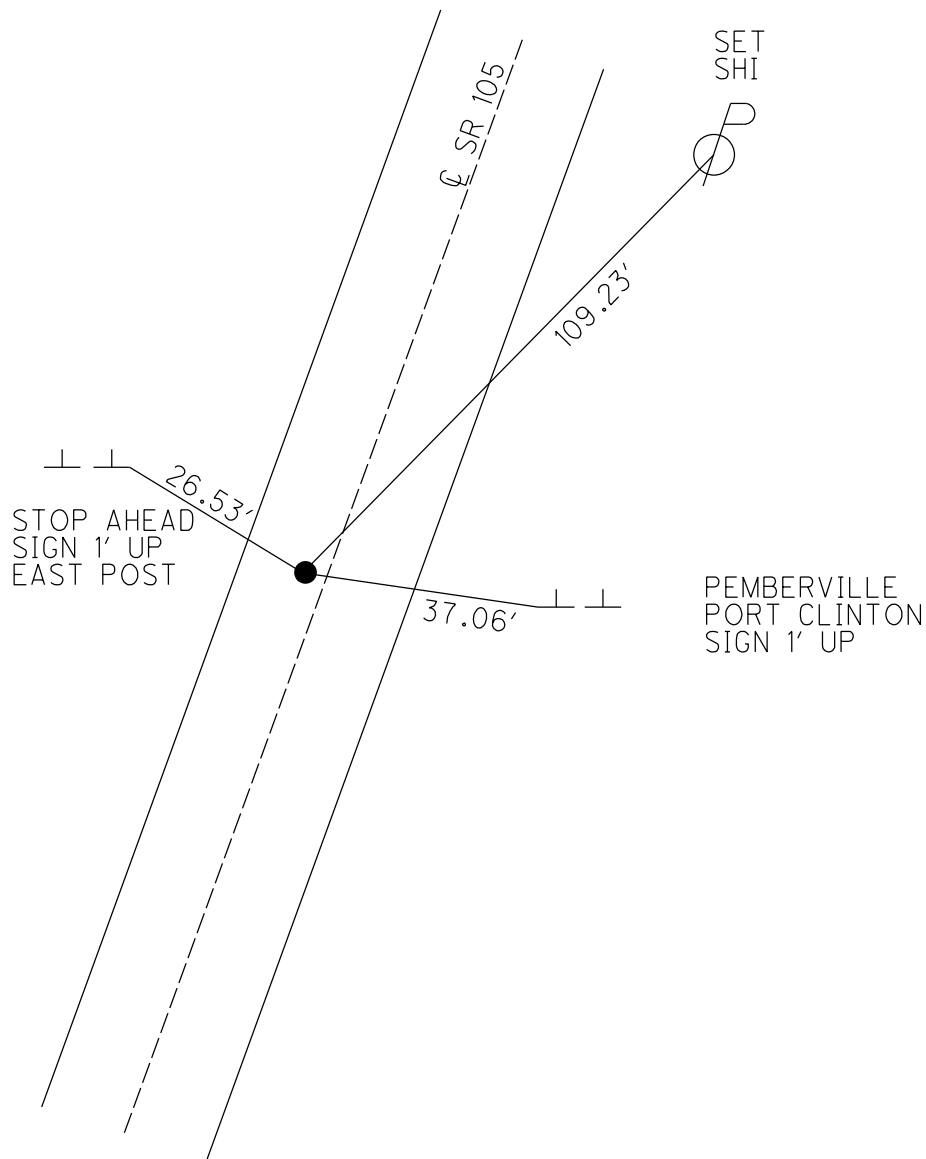

O.D.O.T. DISTRICT 2 SURVEY OFFICE (USE ONLY)

PERSONNEL

REFERENCE NO. 6

SHEET 13 OF 28

NOTES ASTON

DATE 4/22/2024

ROUTE SR 105

H.C. MILLER

WEATHER BREEZY

COUNTY WOOD

R.C. NIESE

TEMP. 30°

TOWNSHIP CENTER

SECTION 22

DWG BY _____ PID NO PID

T 5 N R 11 E

TYPE MONUMENT MAG/ WASHER

ON SURFACE - BELOW ON

OFFSET Q PAVEMENT 0.6' ± : RT

9.5' TO RT EDGE PAVEMENT


STATION: 120+91

HORZ.DATUM: LDP:WOOD


GEOID: 18

GRID: NORTHING: 625206.738

EASTING: 1672567.627

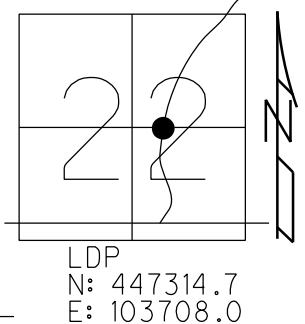

RECORD: P.I.
STA. 121+36.38
 $\Delta = 1^\circ 54'$ RT
FD P.K./WASHER
4/15/02, MB
SET P.K./WASHER
6/12/02, DCH
FD
P.K./WASHER
REF6
6/2/16, JFO
SET 1" MAG/WASHER
NEWREF6
6/20/17, JFO
FD 1" MAG/W
REF6
4-22-24, TDN

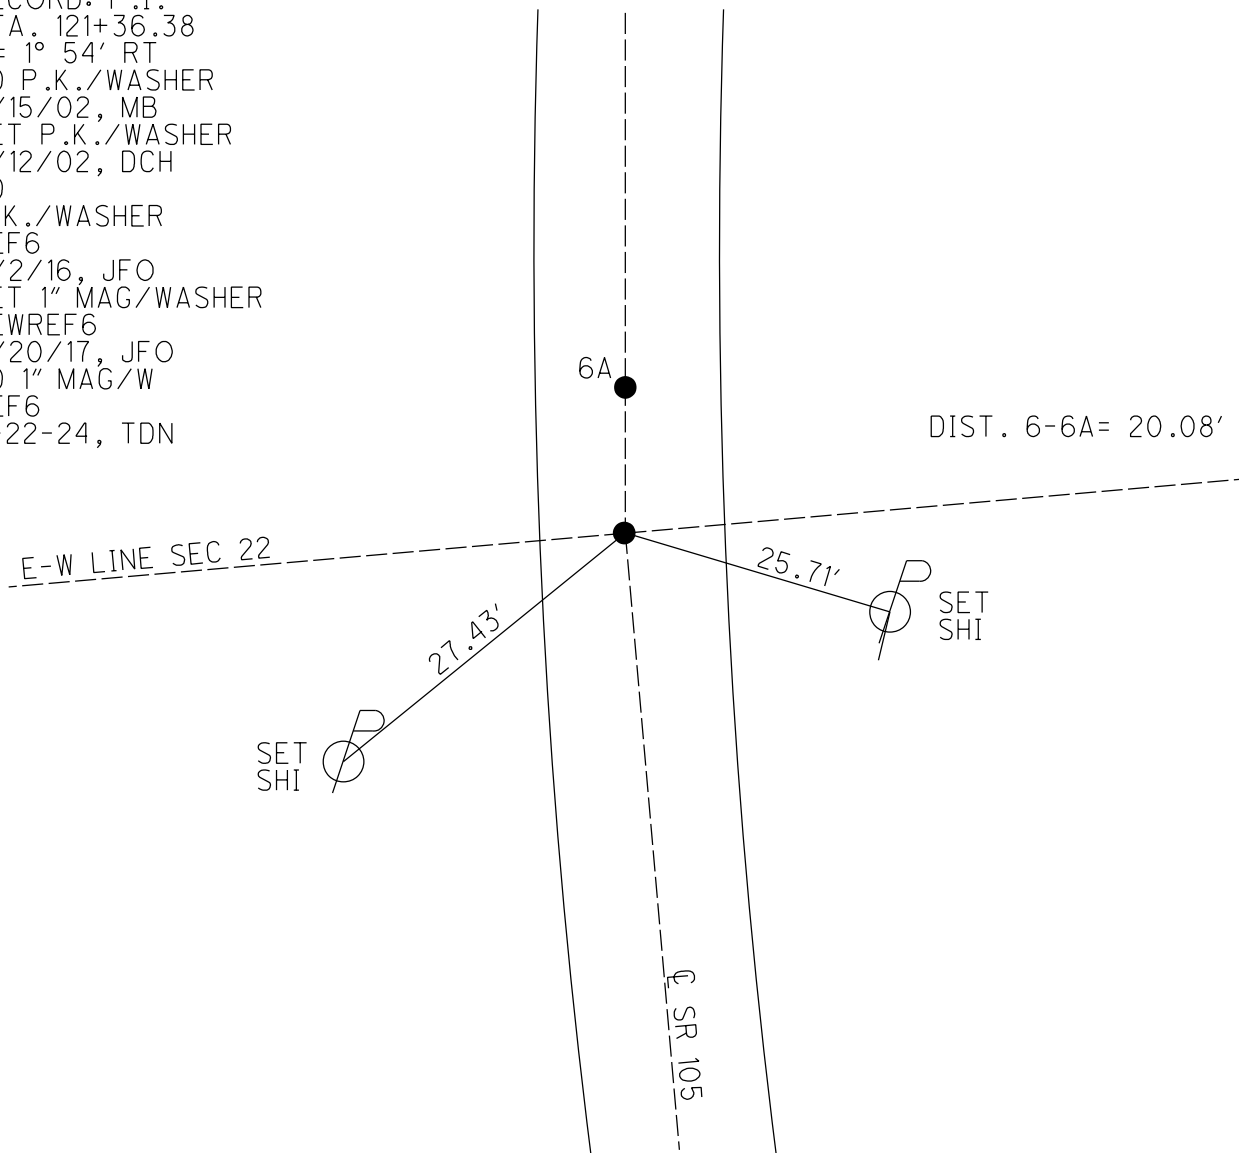

O.D.O.T. DISTRICT 2 SURVEY OFFICE (USE ONLY)

PERSONNEL

REFERENCE NO. 6A

SHEET 14 OF 28

NOTES ASTON

DATE 4/22/2024

ROUTE SR 105

H.C. MILLER

WEATHER BREEZY

COUNTY WOOD

R.C. NIESE

TEMP. 30°

TOWNSHIP CENTER

SECTION 22

DWG BY _____ PID NO PID

T 5 N R 11 E

TYPE MONUMENT MAG/ WASHER

ON SURFACE - BELOW ON

OFFSET Q PAVEMENT 0.7' ~~LT~~ : RT

9.5' TO RT EDGE PAVEMENT


STATION: 121+11

HORIZ.DATUM: LDP:WOOD

GEOID: 18


GRID: NORTHING: 625224.776

EASTING: 1672576.407

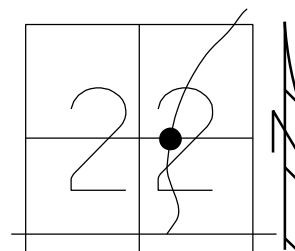

LDP
N: 447332.9
E: 183716.6

RECORD:
ORIGIN UNKNOWN
FD BOAT SPIKE
2" DOWN
4/15/02, MB
SET P.K./WASHER
6/12/02, DCH
FD P.K.NAIL
REF A6
6/2/16, JFO
SET 1" MAG/WASHER
NEW REF A6
6/20/17, JFO
FD 1" MAG/W
REF 6A
4-22-24, TDN

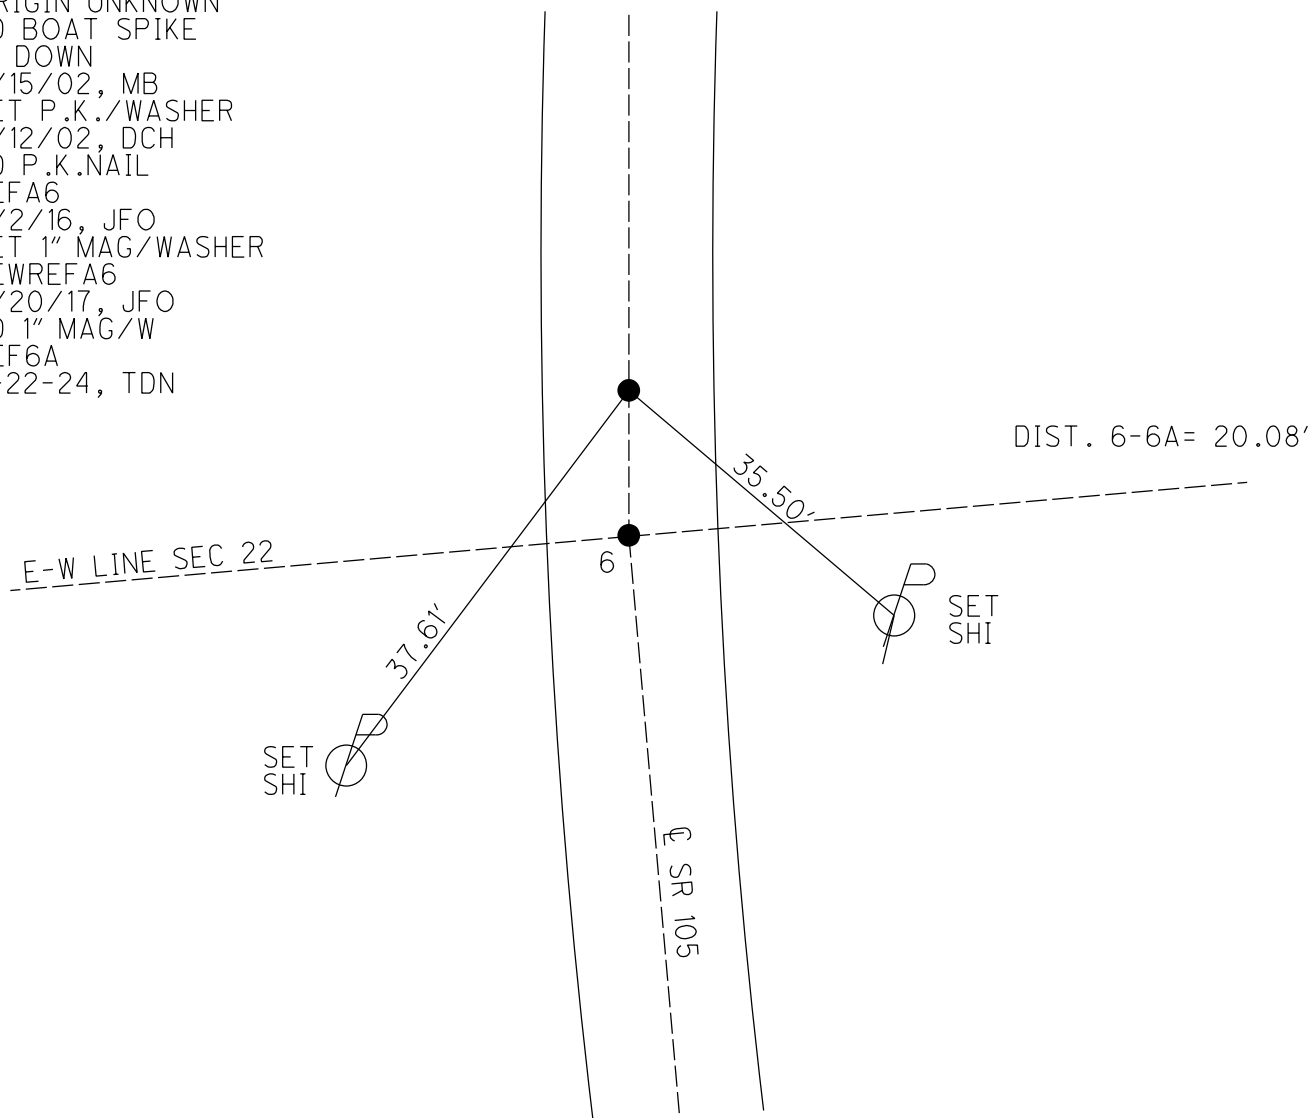

O.D.O.T. DISTRICT 2 SURVEY OFFICE (USE ONLY)

PERSONNEL

REFERENCE NO. 7

SHEET 16 OF 28

NOTES ASTON

DATE 4/22/2024

ROUTE SR 105

H.C. MILLER

WEATHER BREEZY

COUNTY WOOD

R.C. NIESE

TEMP. 30°

TOWNSHIP CENTER

SECTION 22

DWG BY _____ PID NO PID

T 5 N R 11 E

TYPE MONUMENT MAG/ WASHER

ON SURFACE - BELOW ON

OFFSET Q PAVEMENT 0.5' LT : RT

10.2' TO EDGE PAVEMENT


STATION: 120+91

HORIZ.DATUM: LDP:WOOD

GEOID: 18


GRID: NORTHING: 625820.226

EASTING: 1672869.668

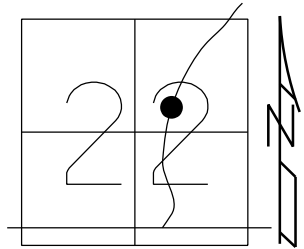

LDP
N: 447932.2
E: 184002.0

RECORD: P.I.
STA. 128+20.28
 $\Delta = 0^\circ 38' \text{ LT}$
FD P.K./WASHER
4/15/02, MB
SET P.K./WASHER
6/12/02, DCH
FD P.K.SHANK
SET MAG/WASHER
REF7
6/2/16, JFO
SET 1" MAG/WASHER
6/20/17, JFO
FD 1" MAG/ W
REF8
4-22-24, TDN

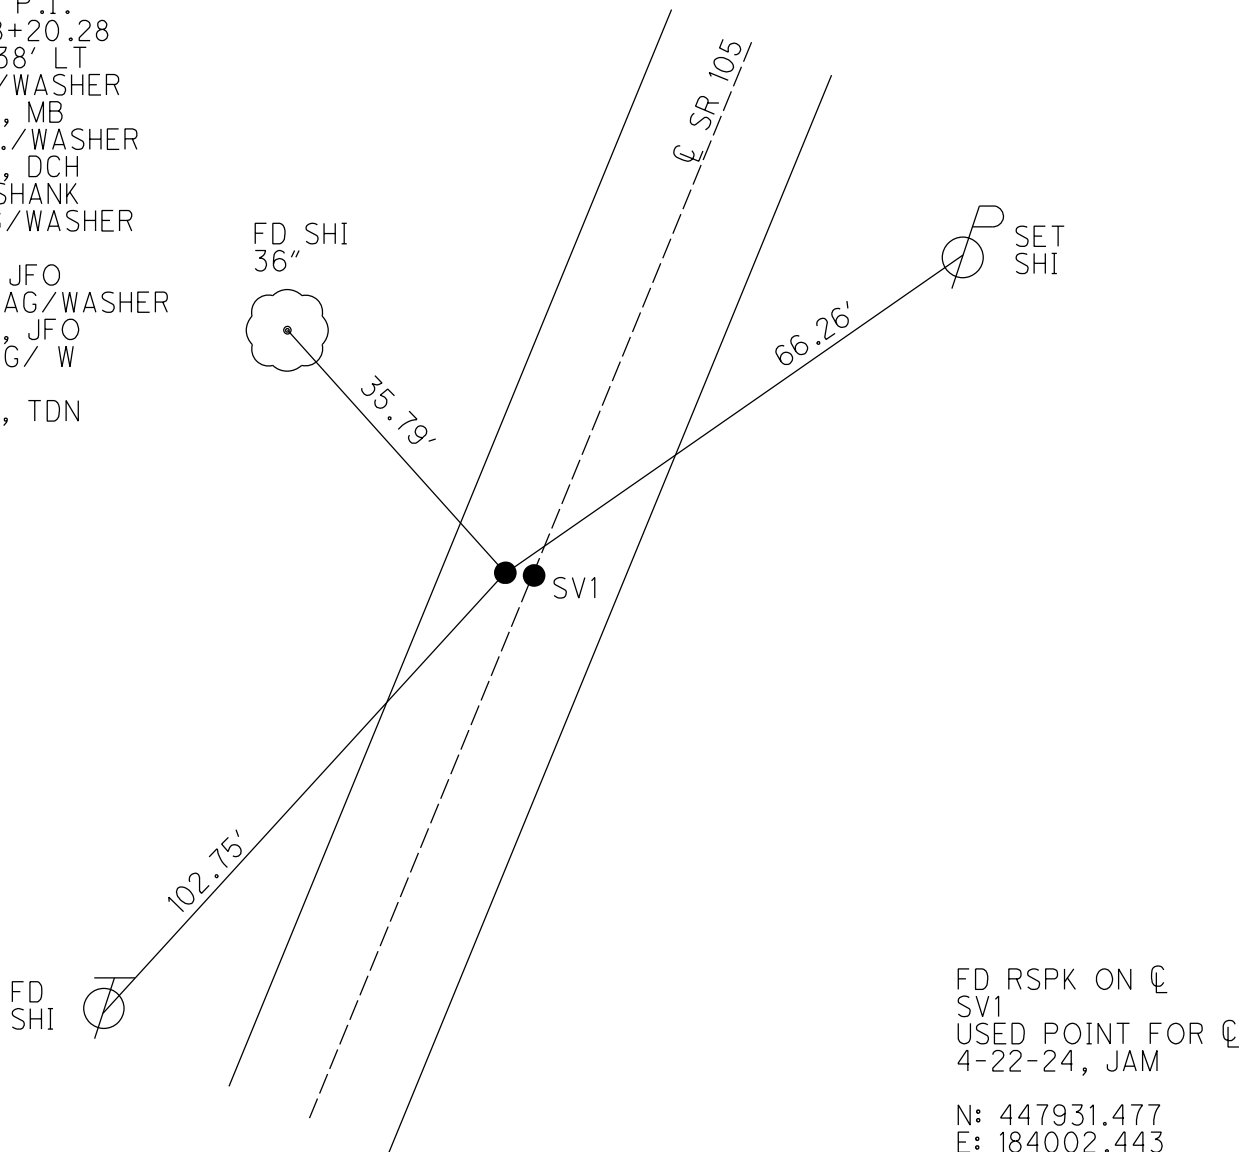

FD RSPK ON Q
SV1
USED POINT FOR Q
4-22-24, JAM

N: 447931.477
E: 184002.443

O.D.O.T. DISTRICT 2 SURVEY OFFICE (USE ONLY)

PERSONNEL

REFERENCE NO. 8

SHEET 18 OF 28

NOTES ASTON

DATE 4/22/2024

ROUTE SR 105

H.C. MILLER

WEATHER BREEZY

COUNTY WOOD

R.C. NIESE

TEMP. 30°

TOWNSHIP CENTER

SECTION 22

DWG BY _____ PID NO PID

T 5 N R 11 E

TYPE MONUMENT MAG/ WASHER

ON SURFACE - BELOW ON

OFFSET CL PAVEMENT 0.5' ± : RT

9.7' TO RT EDGE PAVEMENT


STATION: 132+61

HORIZ.DATUM: LDP:WOOD


GEOID: 18

GRID: NORTHING: 626257.492

EASTING: 1673079.012

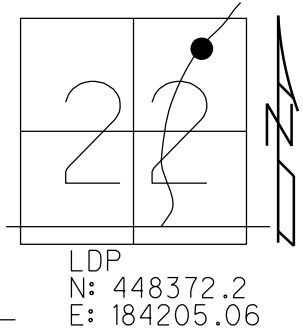

RECORD: P.I.
STA: 133+05.10
 $\Delta = 0^\circ 50' \text{ RT}$
FD P.K./WASHER
4/15/02, MB
SET P.K./WASHER
6/12/02, DCH
FD P.K./WASHER
REF8
6/2/16, JFO
SET 1" MAG/WASHER
NEWREF8
10/5/16, JFO
FD 1" MAG/ W
REF8
4-22-24, TDN

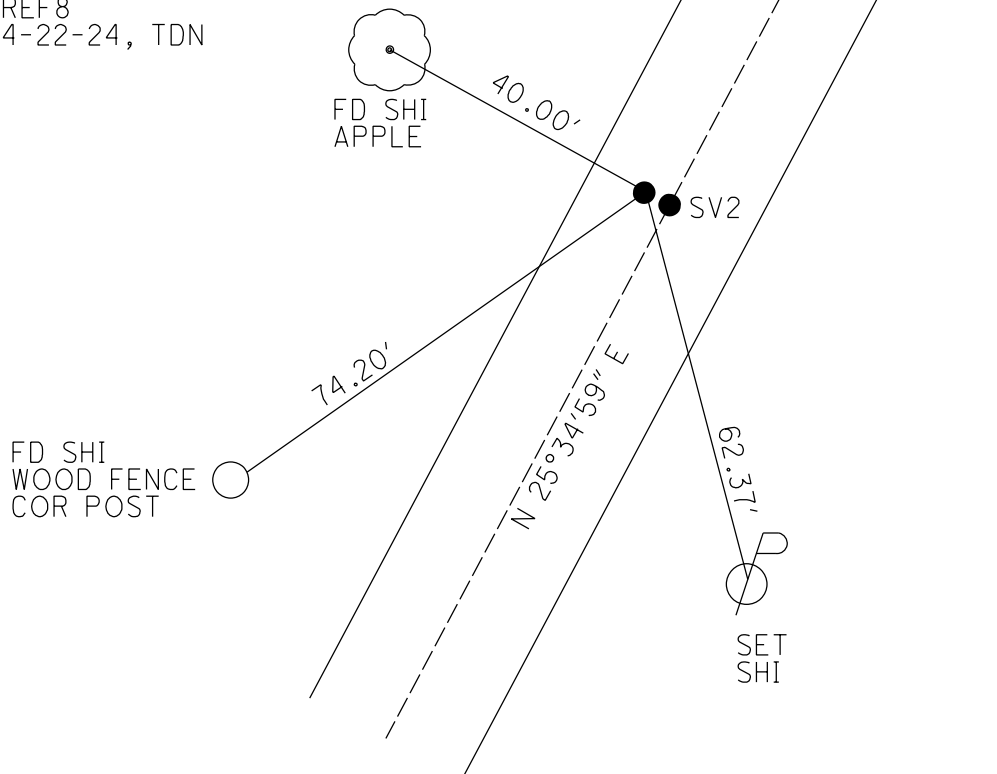

FD RSPK ON CL
SV2
USED POINT FOR CL
4-22-24, JAM

N: 448371.543
E: 184205.888

O.D.O.T. DISTRICT 2 SURVEY OFFICE (USE ONLY)

PERSONNEL

REFERENCE NO. 9

SHEET 20 OF 28

NOTES ASTON

DATE 4/22/2024

ROUTE SR 105

H.C. MILLER

WEATHER BREEZY

COUNTY WOOD

R.C. NIESE

TEMP. 30°

TOWNSHIP CENTER

SECTION 22

DWG BY _____ PID NO PID

T 5 N R 11 E

TYPE MONUMENT IPIPE

ON SURFACE - BELOW 18"

OFFSET $\varnothing$ PAVEMENT 44.2' LT : ~~RT~~

_____ TO _____ EDGE PAVEMENT


STATION: 139.05

HORZ.DATUM: LDP:WOOD

GEOID: 18


GRID: NORTHING: _____

EASTING: _____

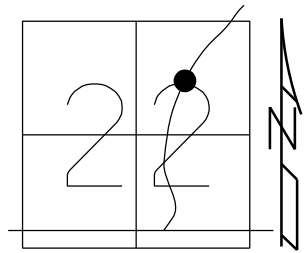

LDP
N: 448956.2
E: 184486.0

RECORD: P.I.
STA. 139+52.87
 $\Delta = 41^{\circ} 35' 40''$ RT
FD 1.5" IPIPE
18" DOWN
D.N.F.
6/2/16, JFO
FD IPIPE
18" DOWN
4-22-24, JAM

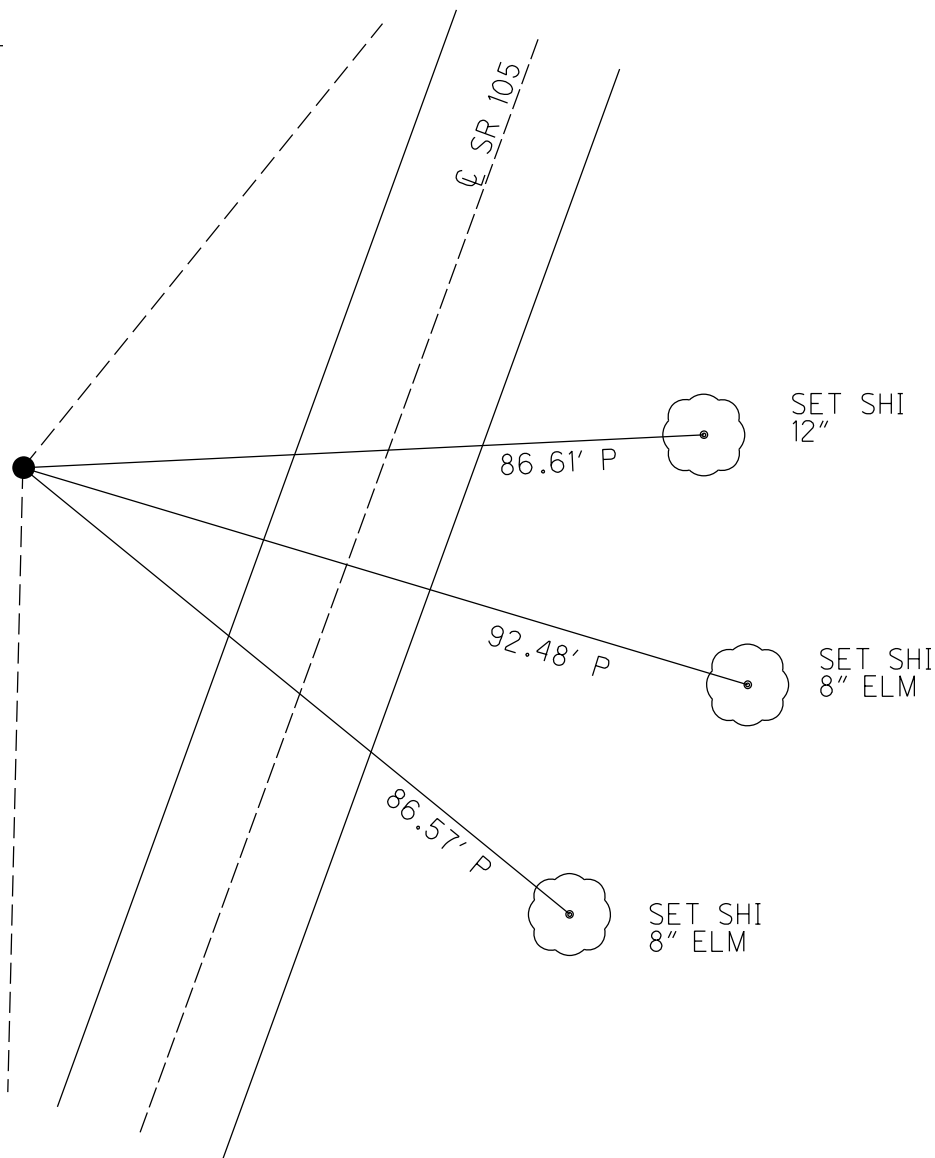

O.D.O.T. DISTRICT 2 SURVEY OFFICE (USE ONLY)

PERSONNEL

REFERENCE NO. 10

SHEET 21 OF 28

NOTES ASTON

DATE 4/22/2024

ROUTE SR 105

H.C. MILLER

WEATHER BREEZY

COUNTY WOOD

R.C. NIESE

TEMP. 30°

TOWNSHIP CENTERSECTION 22

DWG BY _____ PID NO PID

T_5_N R_11_E

TYPE MONUMENT MAG/ WASHER

ON SURFACE - BELOW _____ ON _____

OFFSET @ PAVEMENT 6.3' ~~LT~~ : RT

3.4' TO RT EDGE PAVEMENT

STATION: 143+51

HORZ.DATUM: LDP:WOOD


GEOID: 18

GRID: NORTHING: 627011.679

EASTING: 1673797.642

```
LDP
N: 449135.8
E: 184914.3
```

RECORD: P.I.
STA. 144+17.20
 $\Delta = 16^{\circ} 36' 20''$ LT
FD P.K./WASHER
4/15/02, MB
SET P.K./WASHER
6/12/02, DCH
FD P.K./WASHER
4" DOWN
REF10
6/2/16, JFO
SET MAG/WASHER
NEWREF10
10/5/19, JFO
FD MAG/W
REF10
4-22-24, TDN

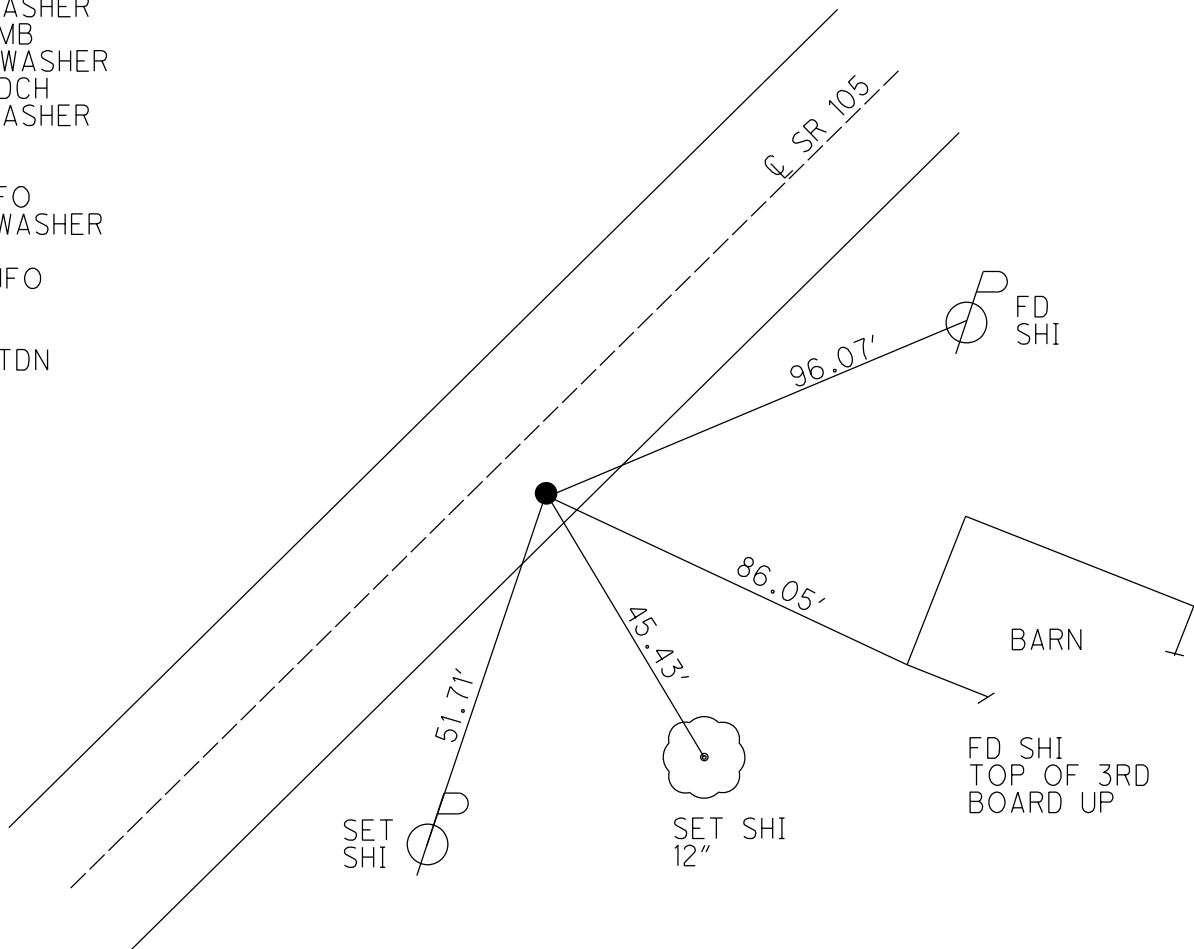

O.D.O.T. DISTRICT 2 SURVEY OFFICE (USE ONLY)

PERSONNEL

REFERENCE NO. 11

SHEET 22 OF 28

NOTES ASTON

DATE 4/22/2024

ROUTE SR 105

H.C. MILLER

WEATHER BREEZY

COUNTY WOOD

R.C. NIESE

TEMP. 30°

TOWNSHIP CENTER

SECTION 22

DWG BY _____ PID NO PID

T 5 N R 11 E

TYPE MONUMENT MAG/ WASHER

ON SURFACE - BELOW ON

OFFSET Q PAVEMENT 11.8' ± : RT

1.5' TO RT EDGE PAVEMENT


STATION: 149+98

HORIZ.DATUM: LDP:WOOD

GEOID: 18


GRID: NORTHING: 627416.352

EASTING: 1674304.651

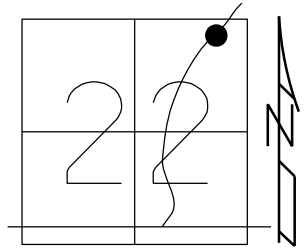

LDP
N: 449547.2
E: 185415.9

RECORD: P.I.
STA. 150+65.86
 $\Delta = 22^\circ 07' 20''$ LT
FD P.K./WASHER
4/15/02, MB
SET P.K./WASHER
5/28/02, DCH
FD P.K./WASHER
REF11
6/2/16, JFO
SET 1" MAG/WASHER
NEWREF11
6/20/17, JFO
FD MAG/W
REF11
4-22-24, TDN

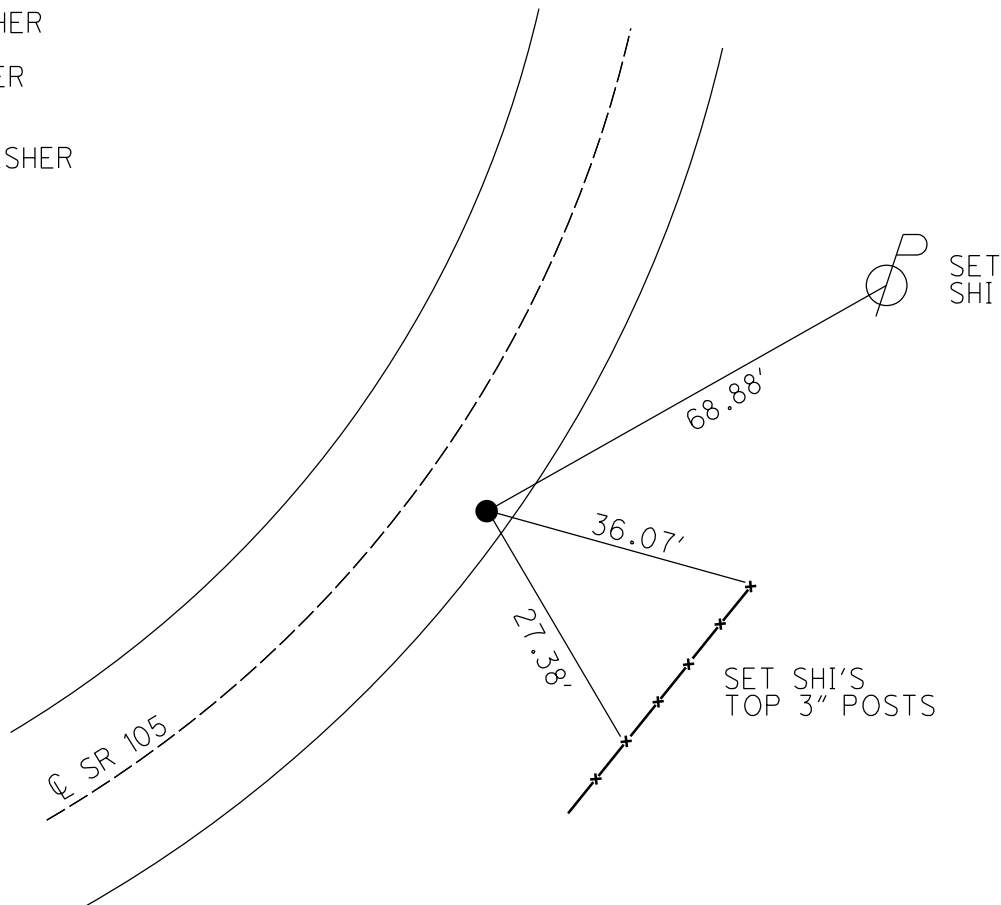

O.D.O.T. DISTRICT 2 SURVEY OFFICE (USE ONLY)

PERSONNEL

REFERENCE NO. 12

SHEET 23 OF 28

NOTES ASTON

DATE 4/22/2024

ROUTE SR 105

H.C. MILLER

WEATHER BREEZY

COUNTY WOOD

R.C. NIESE

TEMP. 30°

TOWNSHIP CENTER

SECTION 22

DWG BY _____ PID NO PID

T 5 N R 11 E

TYPE MONUMENT MAG/ WASHER

ON SURFACE - BELOW ON

OFFSET Q PAVEMENT 0.45' ~~LT~~ : RT

9.4' TO LT EDGE PAVEMENT


STATION: 152+86

HORIZ.DATUM: LDP:WOOD

GEOID: 18


GRID: NORTHING: 627277.637

EASTING: 1674451.107

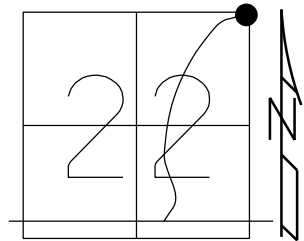

LDP
N: 449810.4
E: 185558.9

RECORD: P.O.T.
STA. 153+65.35
FD P.K./WASHER
4/15/02, MB
SET P.K./WASHER
6/12/02, DCH
FD P.K./WASHER
REF12
6/2/16, JFO
SET MAG/WASHER
NEWREF12
6/20/17, JFO
FD MAG/W
REF 12
4-22-24, JAM

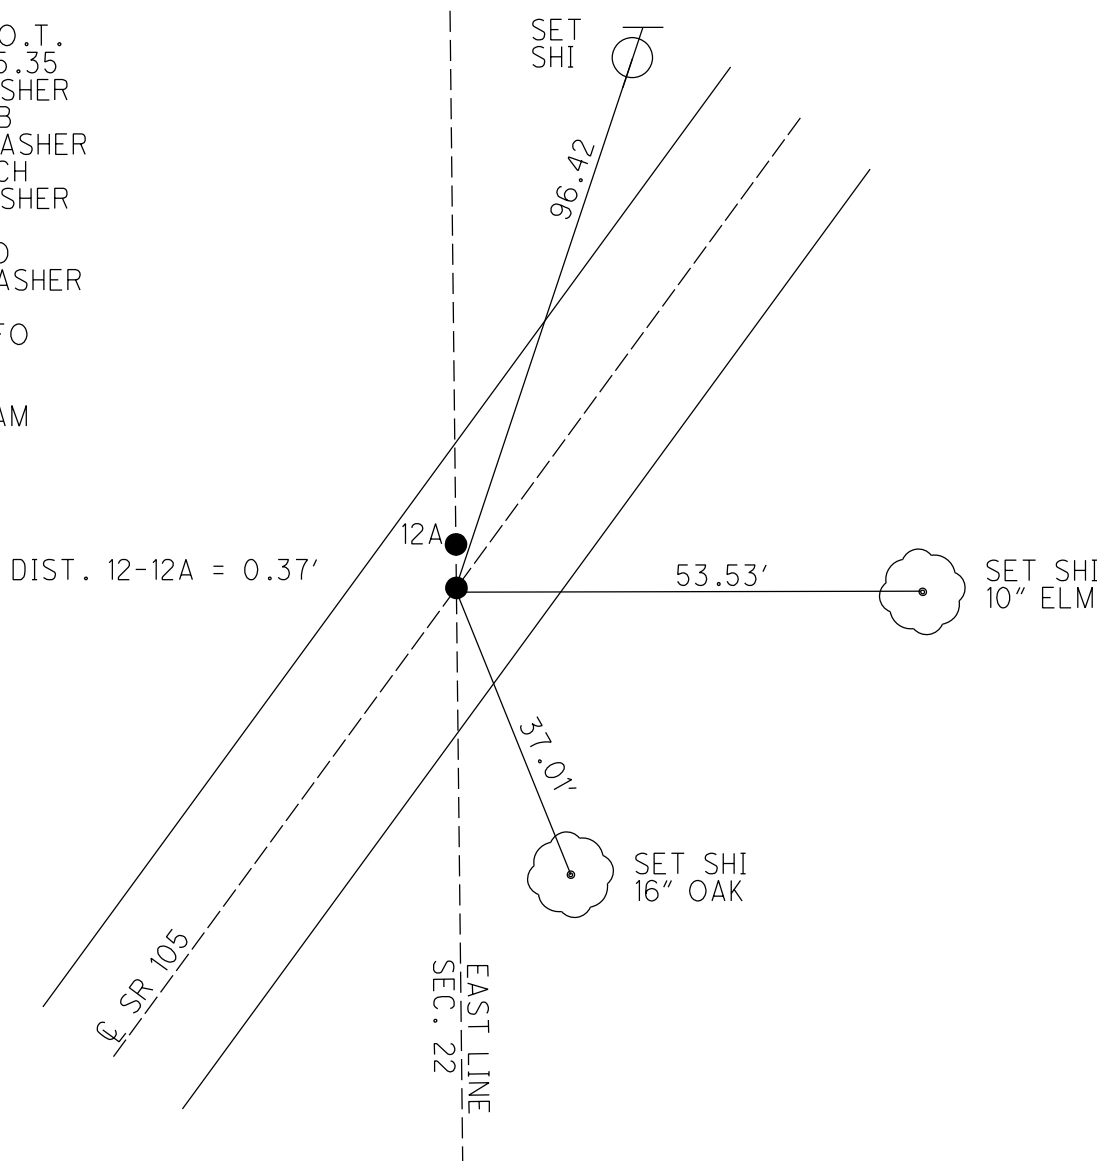

O.D.O.T. DISTRICT 2 SURVEY OFFICE (USE ONLY)

PERSONNEL

REFERENCE NO. 12A

SHEET 24 OF 28

NOTES ASTON

DATE 4/22/2024

ROUTE SR 105

H.C. MILLER

WEATHER BREEZY

COUNTY WOOD

R.C. NIESE

TEMP. 30°

TOWNSHIP CENTER

SECTION 22

DWG BY _____ PID NO PID

T 5 N R 11 E

TYPE MONUMENT MAG/ WASHER

ON SURFACE - BELOW ON

OFFSET Q PAVEMENT 0.7' ~~LT~~ : RT

9.1' TO LT EDGE PAVEMENT


STATION: 153+00

HORIZ.DATUM: LDP:WOOD


GEOID: 18

GRID: NORTHING: 627678.020

EASTING: 1674450.970

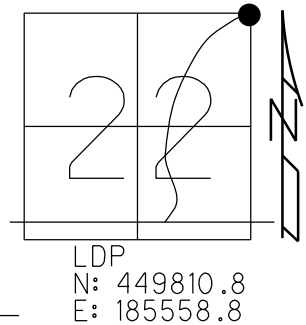

RECORD:
FD P.K./WASHER
4/15/02, MB
SET P.K./WASHER
6/12/02, DCH
FD P.K./WASHER
REFA12
6/2/16, JFO
SET MAG/WASHER
NEWREFA12
6/20/17, JFO
FD MAG/W
REF12A
4-22-24, JAM

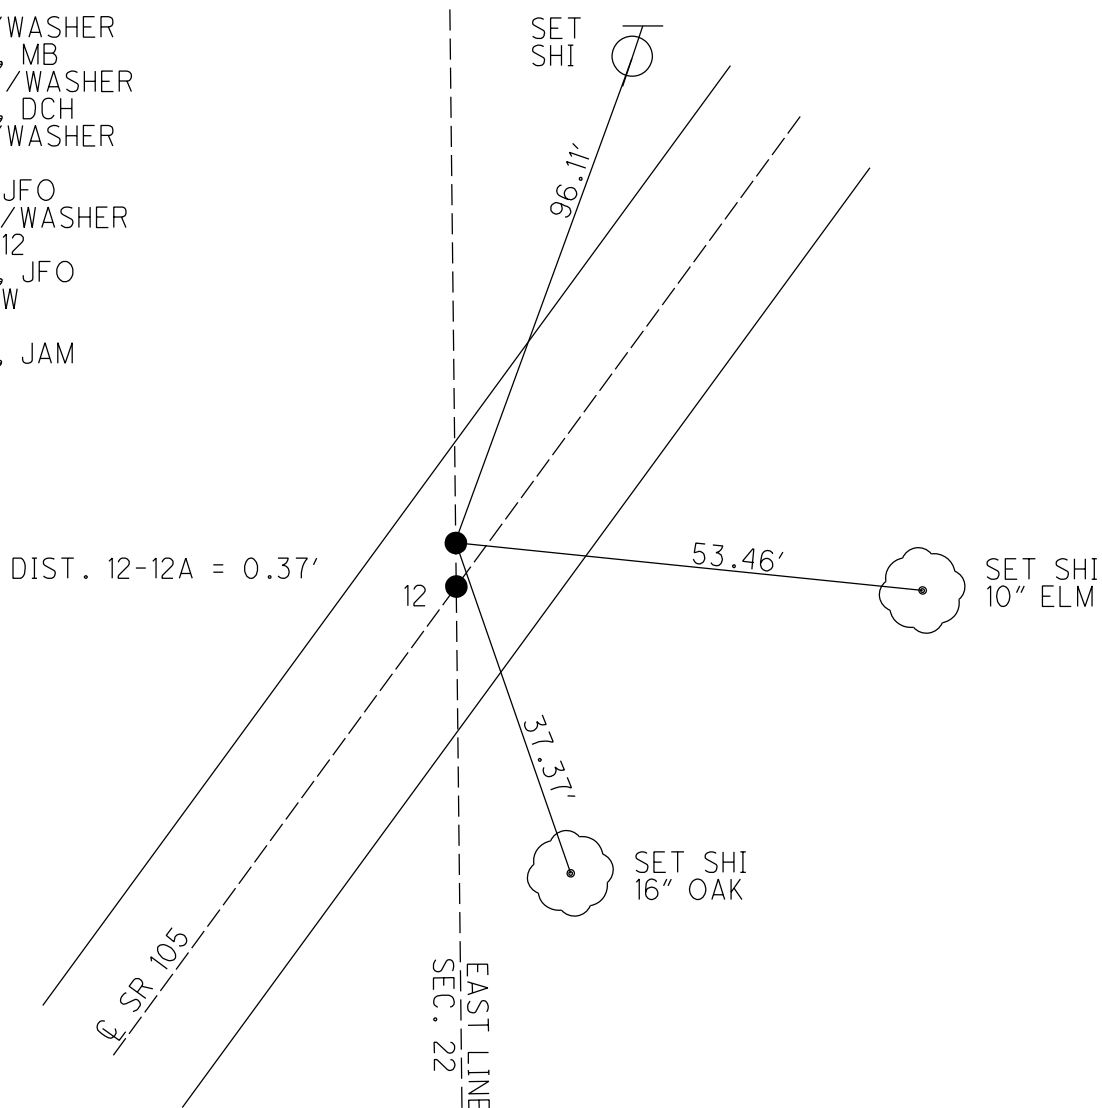

O.D.O.T. DISTRICT 2 SURVEY OFFICE (USE ONLY)

PERSONNEL

REFERENCE NO. 13

SHEET 25 OF 28

NOTES ASTON

DATE 4/22/2024

ROUTE SR 105

H.C. MILLER

WEATHER BREEZY

COUNTY WOOD

R.C. NIESE

TEMP. 30°

TOWNSHIP WEBSTER

SECTION 14

DWG BY PID NO PID

T 5 N R 11 E

TYPE MONUMENT MAG/ WASHER

ON SURFACE - BELOW ON

OFFSET Q PAVEMENT 6.6' ~~LT~~ : RT

4.0' TO RT EDGE PAVEMENT


STATION: 155+02.42

HORIZ.DATUM: LDP:WOOD

GEOID: 18


GRID: NORTHING: 627797.155

EASTING: 1674518.200

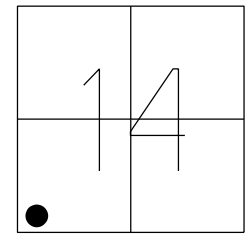

LDP
N: 449930.8
E: 185624.4


RECORD: P.I.
STA.155+02.42
DELTA= 11°37' LT
SET PK AND WASHER
6-12-02 DCH
FD MAG/WASHER
SV3
7/25/12, SDC
D.N.F.
6/2/16, JFO
SET MAG/WASHER
NEWREF13
11/21/16, JFO
FD MAG/W
REF13
4-22-24, JAM

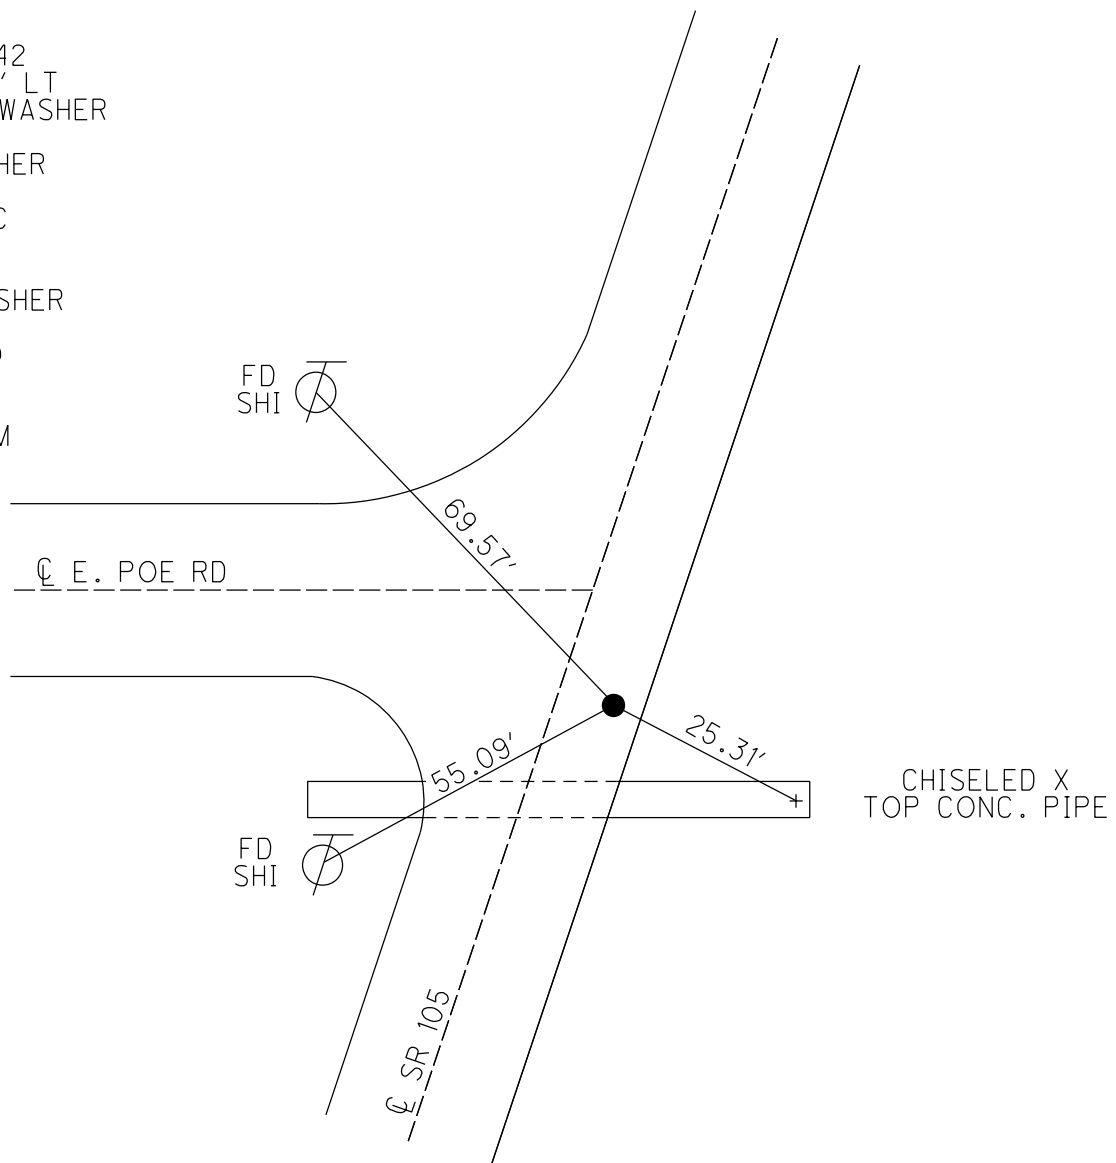


O.D.O.T. DISTRICT 2 SURVEY OFFICE (USE ONLY)

PERSONNEL		REFERENCE NO.	<u>13 A</u>	SHEET	<u>23</u>	OF	<u>28</u>
NOTES	RHOADES	DATE	<u>5/31/17</u>	ROUTE	<u>SR 105</u>		
H.C.	O'DONNELL	WEATHER	<u>WINDY</u>	COUNTY	<u>WOOD</u>		
R.C.	RHOADES	TEMP.	<u>65°</u>	TOWNSHIP	<u>WEBSTER</u>		
				SECTION	<u>14</u>		
				T	<u>5</u>	N	R
							<u>11</u> E

TYPE MONUMENT 1" MAG/WASHER
 ON SURFACE - ~~BELOW~~ ON
 LEFT - Q PAV'T - ~~RIGHT~~ 0.6'
10.85' TO LT EDGE PAVEMENT
 S.L.M. 157+00
 GRID: NORTHING: 627985.615 EASTING: 1674578.240

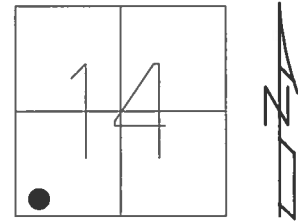


RECORD:
 FD MAG/WASHER
 FINRE06
 7/25/12, SDC
 FD MAG NAIL
 REFA13
 6/3/16, JFO
 SET 1" MAG/WASHER
 5/31/17, JFO

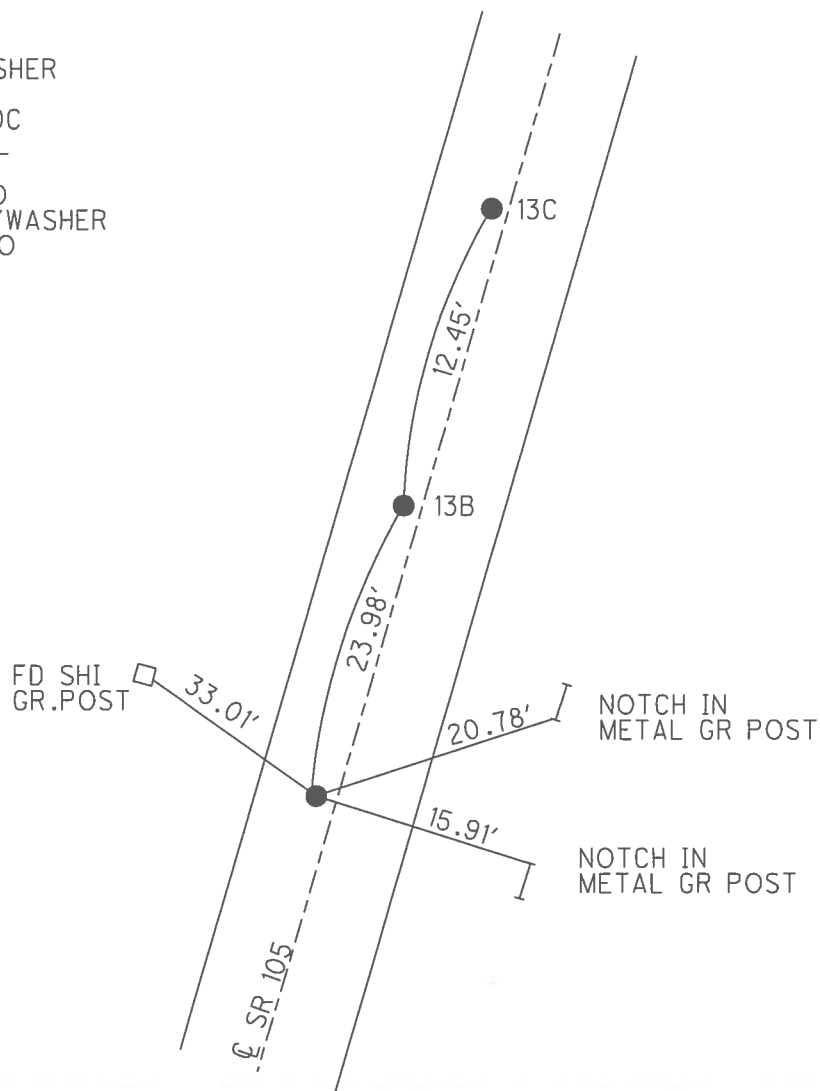

O.D.O.T. DISTRICT 2 SURVEY OFFICE (USE ONLY)


PERSONNEL	REFERENCE NO. <u>13 B</u>	SHEET <u>24</u> OF <u>28</u>
NOTES	DATE <u>5/31/17</u>	ROUTE <u>SR 105</u>
H.C. <u>RHOADES</u>	WEATHER <u>WINDY</u>	COUNTY <u>WOOD</u>
R.C. <u>RHOADES</u>	TEMP. <u>65°</u>	TOWNSHIP <u>WEBSTER</u>
		SECTION <u>14</u>
		T <u>5</u> N R <u>11</u> E

TYPE MONUMENT 1" MAG/WASHER
 ON SURFACE - ~~BELOW~~ ON
 LEFT - CL PAV'T - ~~RIGHT~~ 1.8'
9.8' TO LT EDGE PAVEMENT
 S.L.M. 157+23.87

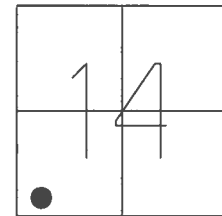

GRID: NORTHING: 628008.367 EASTING: 1674585.446

RECORD:
 FD MAG/WASHER
 FINRE19
 7/25/12, SDC
 FD MAG NAIL
 REFA13
 6/3/16, JFO
 SET 1" MAG/WASHER
 5/31/17, JFO

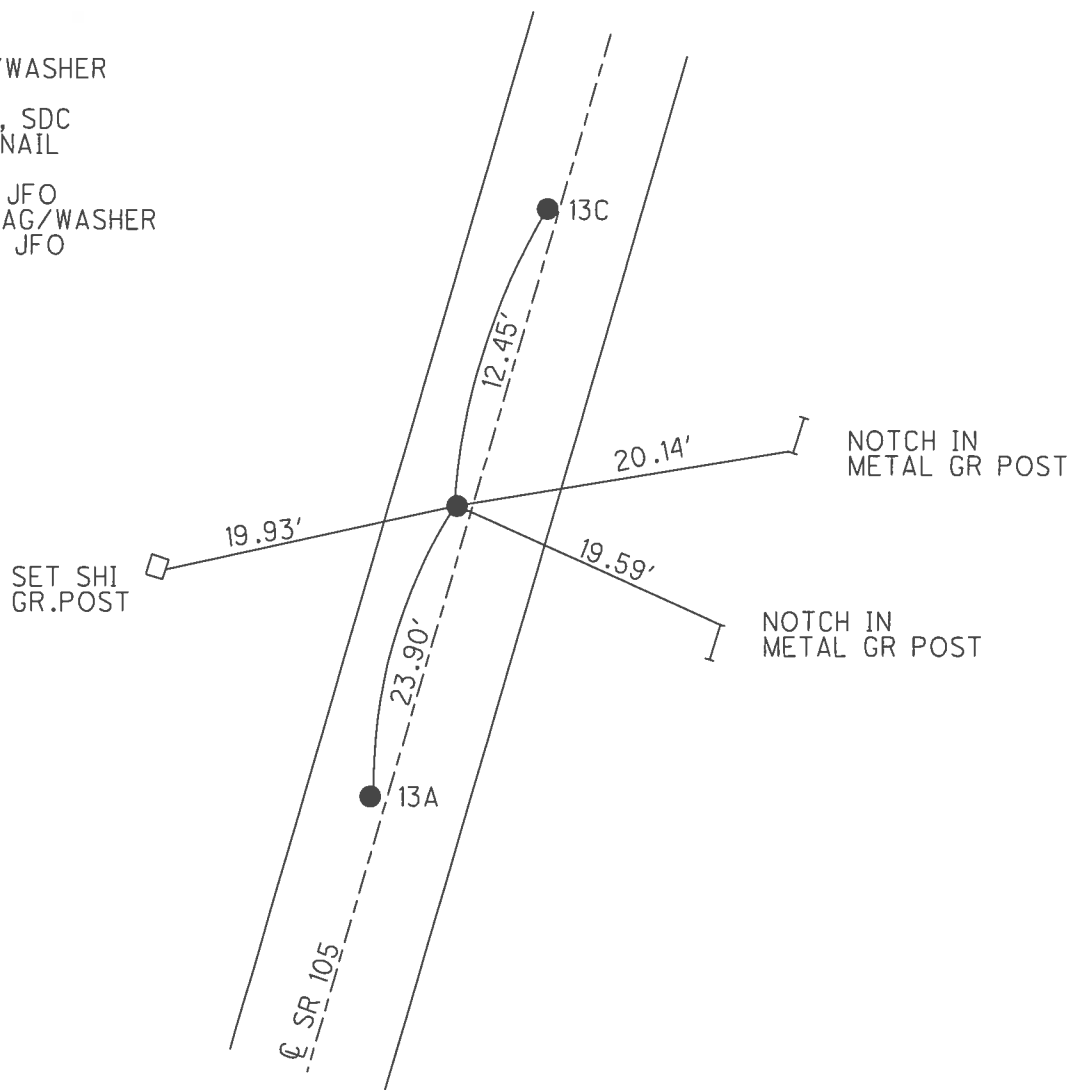


O.D.O.T. DISTRICT 2 SURVEY OFFICE (USE ONLY)


PERSONNEL	REFERENCE NO. <u>13 C</u>	SHEET <u>25</u> OF <u>28</u>	
NOTES	RHOADES	DATE <u>5/31/17</u>	ROUTE <u>SR 105</u>
H.C.	O'DONNELL	WEATHER <u>WINDY</u>	COUNTY <u>WOOD</u>
R.C.	RHOADES	TEMP. <u>65°</u>	TOWNSHIP <u>WEBSTER</u>
			SECTION <u>14</u>
			T <u>5</u> N R <u>11</u> E

TYPE MONUMENT 3/4" MAG/WASHER
 ON SURFACE - ~~BELOW~~ ON
 LEFT - ℄ PAV'T - ~~RIGHT~~ 2.3'
9.45' TO LT EDGE PAVEMENT
 S.L.M. 157+36.31

GRID: NORTHING: 628020.125 EASTING: 1674589.487

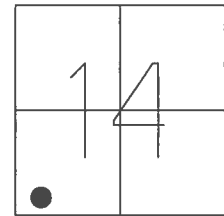

RECORD:
 FD MAG/WASHER
 FINRE17
 7/25/12, SDC
 FD MAG NAIL
 REFC13
 6/3/16, JFO
 SET 1" MAG/WASHER
 5/31/17, JFO

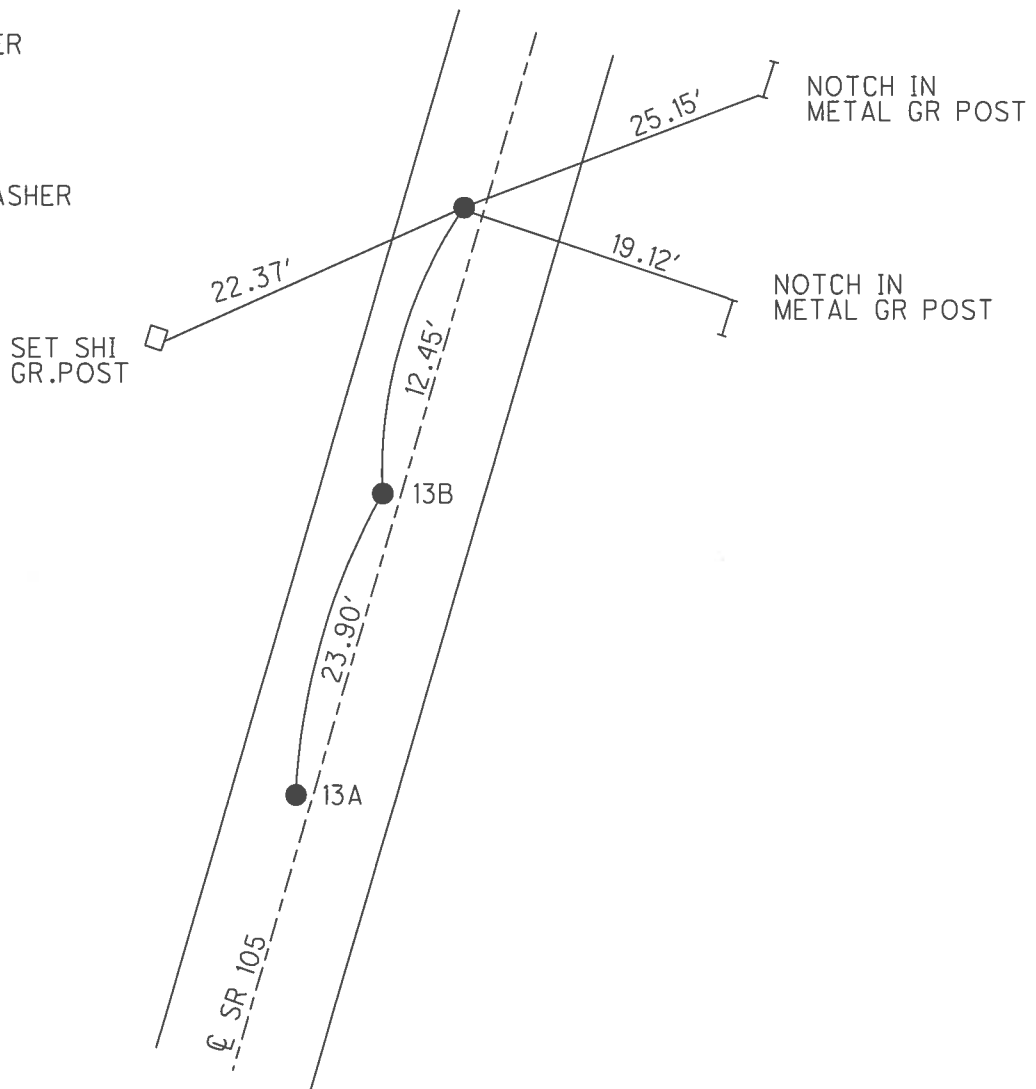

O.D.O.T. DISTRICT 2 SURVEY OFFICE (USE ONLY)

PERSONNEL

REFERENCE NO. 14 SHEET 26 OF 28

NOTES	CODER	DATE	7/25/12	ROUTE	SR 105
H.C.	RHOADES	WEATHER	CLEAR	COUNTY	WOOD
R.C.	COUTCHER	TEMP.	80°	TOWNSHIP	WEBSTER
				SECTION	14
				T <u>5</u> N	R <u>11</u> E

TYPE MONUMENT 1/2" IPIPE


~~ON SURFACE~~ BELOW 6"

LEFT - C PAV'T - RIGHT -


22.05' TO LT EDGE PAVEMENT

S.L.M. 158+65.29

GRID: NORTHING: 628143.166 EASTING: 1674628.281

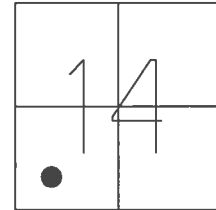

RECORD:
P.I. #12
STA. 158+65.52
 $\Delta = 55^\circ 54' 40''$ RT
FD 1/2" IPIPE
6" DOWN
SV110
7/25/12, SDC
FD IPIN
REF14
6/3/16, JFO

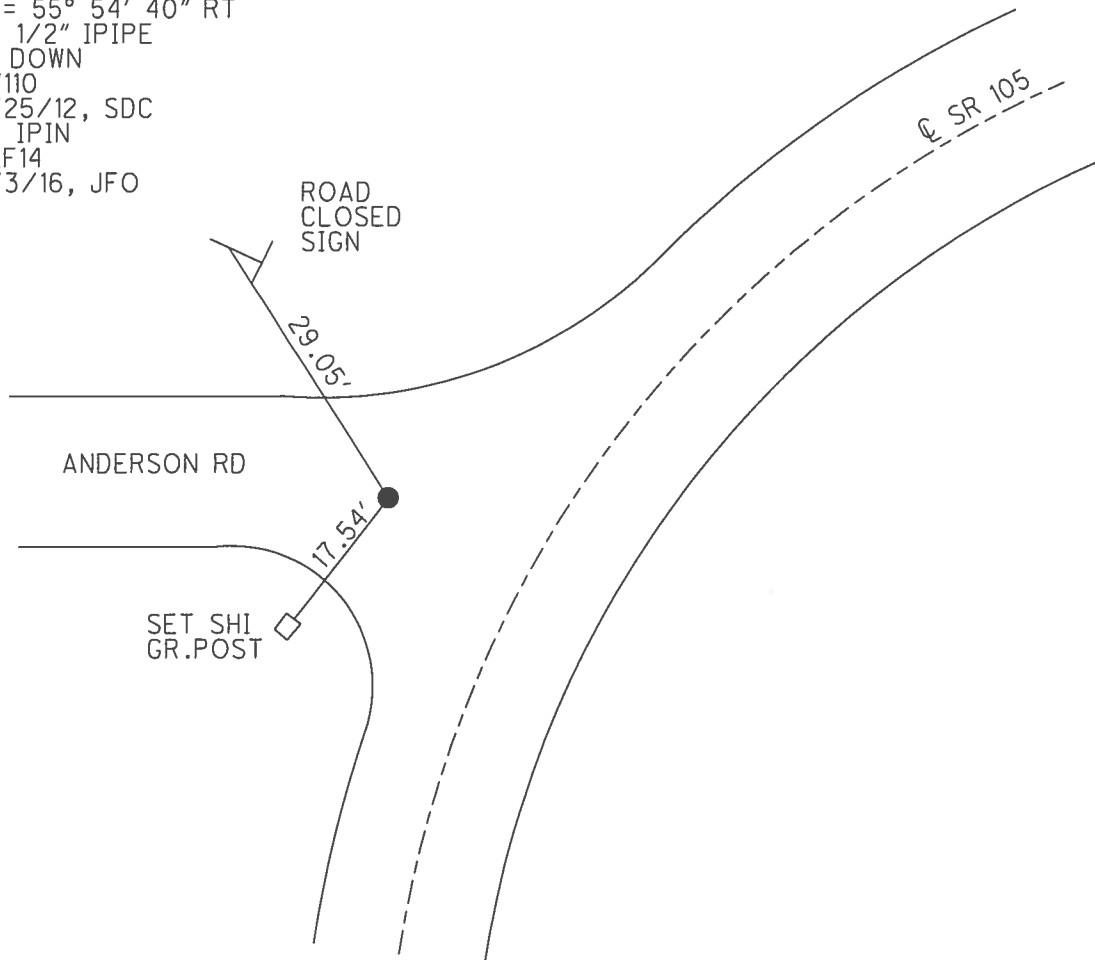


O.D.O.T. DISTRICT 2 SURVEY OFFICE (USE ONLY)


PERSONNEL	REFERENCE NO.	14 A	SHEET	27	OF	28
NOTES	RHOADES	DATE	6/3/17	ROUTE	SR 105	
H.C.	O'DONNELL	WEATHER	FAIR	COUNTY	WOOD	
R.C.	RHOADES	TEMP.	65°	TOWNSHIP	WEBSTER	
				SECTION	14	
				T	5 N R 11 E	

TYPE MONUMENT 1" MAG/WASHER
 ON SURFACE - ~~BELOW~~ ON
 LEFT - CL PAV'T - ~~RIGHT~~ 2.8'
8.56' TO LT EDGE PAVEMENT
 S.L.M. 159+83.87

GRID: NORTHING: 628183.058 EASTING: 1674763.870

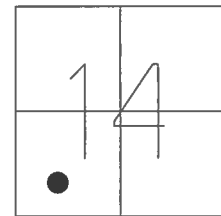

RECORD:
 FD MAG/WASHER
 FINRE20
 7/25/12, SDC
 FD MAG NAIL
 REFA14
 6/2/16, JFO
 SET 3/4" MAG/WASHER
 NEWREFA14
 6/3/17, JFO

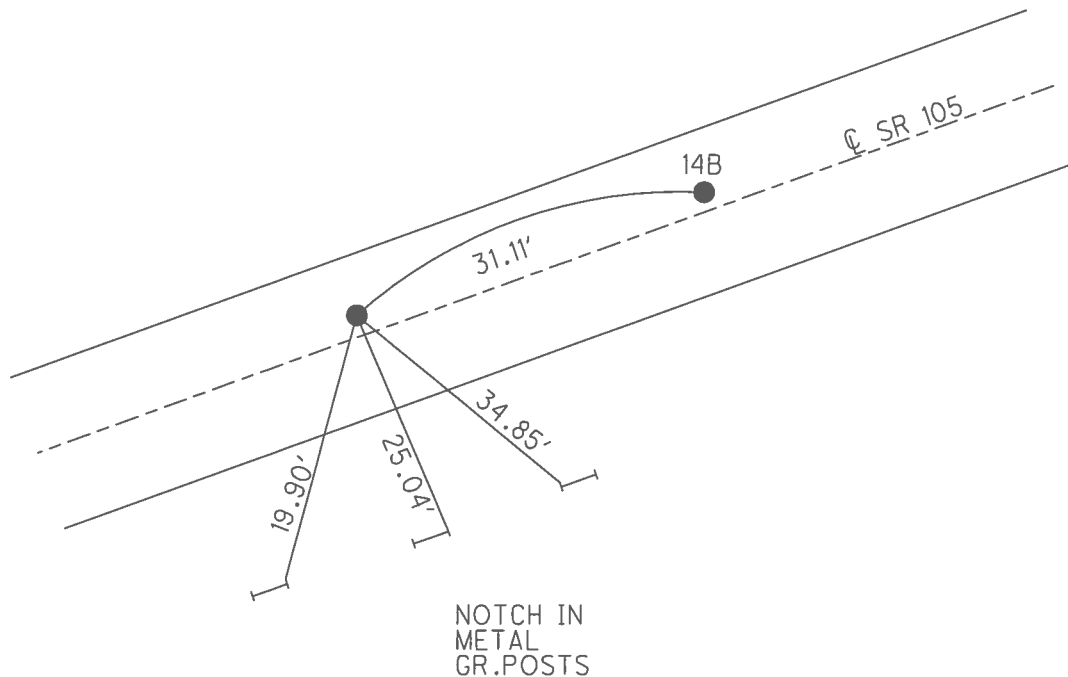

O.D.O.T. DISTRICT 2 SURVEY OFFICE (USE ONLY)

PERSONNEL

REFERENCE NO.

14 B

SHEET

28

OF 28

NOTES

RHOADES

DATE

6/3/17

ROUTE

SR 105

H.C.

O'DONNELL

WEATHER

FAIR

COUNTY

WOOD

R.C.

RHOADES

TEMP.

65°

TOWNSHIP

WEBSTER

SECTION

14

T 5 N

R 11 E

TYPE MONUMENT

1" MAG/WASHER

ON SURFACE - ~~BELOW~~

ON

LEFT - CL PAV'T - ~~RIGHT~~

1.5'


9.8' TO LT EDGE PAVEMENT

S.L.M.

160+15

GRID: NORTHING: 628191.989

EASTING: 1674793.738

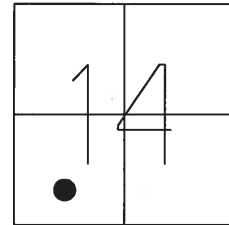

RECORD:

FD MAG/WASHER

FINRE07

7/25/12, SDC

FD MAG NAIL


REFB14

6/2/16, JFO

SET 3/4" MAG/WASHER

NEWREFB14

6/3/17, JFO

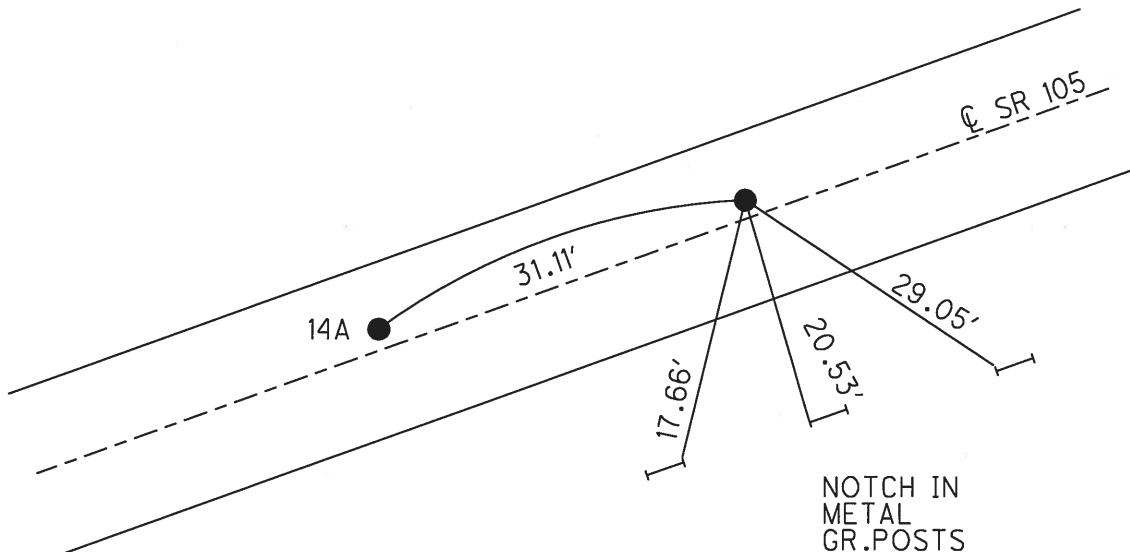

PERSONNEL

REFERENCE NO.

15

SHEET

1

OF 54

NOTES

RHOADES

DATE _____

9/12/16

ROUTE

SR 105

H.C.

O'DONNELL

WEATHER

SUNNY

COUNTY

WOOD

R.C.

RHOADES

TEMP.

55°

TOWNSHIP

WEBSTER

SECTION

14T 5 N R 11 E

TYPE MONUMENT

P.K.NAIL

ON SURFACE - ~~BELOW~~ ON

LEFT - C PAV'T - ~~RIGHT~~ 0.3'

10.3' TO RT EDGE PAVEMENT

S.I. M. 162+23

GRID: NORTHING: 628270.741 EASTING: 1675060.884

RECORD:

SET P.K./WASHER

6/12/02, DCH


FD P.K.NAIL

REF 15

6/2/16, JFO

SET 1" MAG/WASHER


6/2/17, JFO

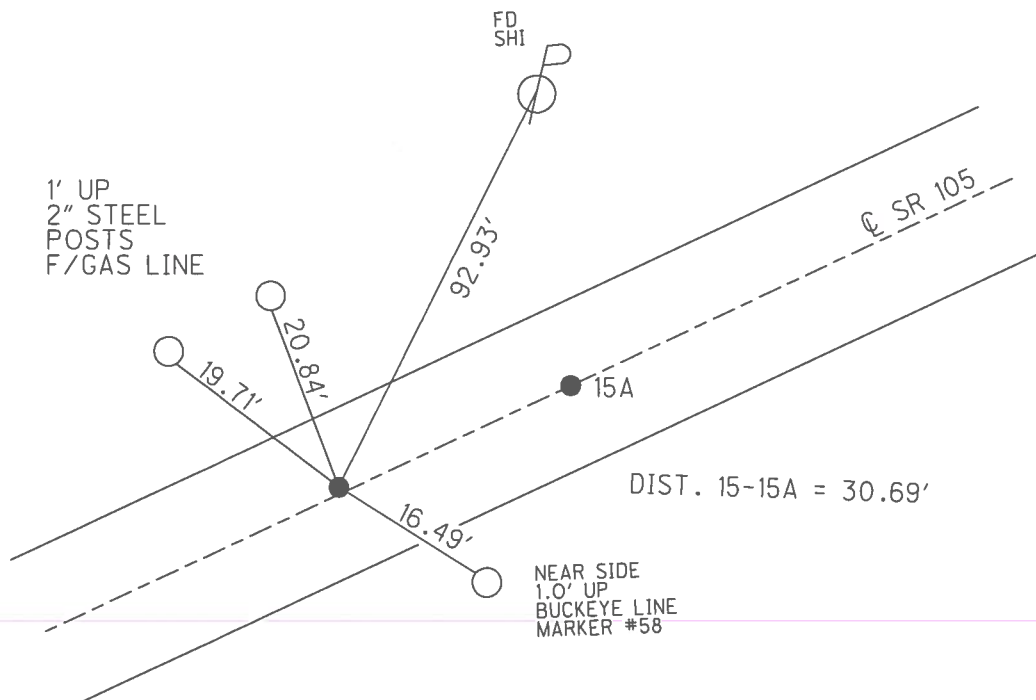

O.D.O.T. DISTRICT 2 SURVEY OFFICE (USE ONLY)


PERSONNEL	REFERENCE NO. <u>15 A</u>	SHEET <u>2</u> OF <u>54</u>
NOTES	DATE <u>9/12/16</u>	ROUTE <u>SR 105</u>
H.C. <u>RHOADES</u>	WEATHER <u>SUNNY</u>	COUNTY <u>WOOD</u>
R.C. <u>RHOADES</u>	TEMP. <u>55°</u>	TOWNSHIP <u>WEBSTER</u>
		SECTION <u>14</u>
		T <u>5</u> N R <u>11</u> E

TYPE MONUMENT P.K.NAIL
 ON SURFACE - BELOW ON
 LEFT - CL PAV'T - RIGHT ON
10' TO RT. EDGE PAVEMENT
 S.L.M. 162+68

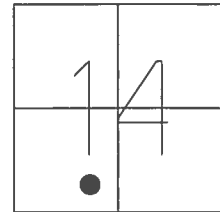

GRID: NORTHING: 628279.323 EASTING: 1675090.337


RECORD:
 SET P.K./WASHER
 6/12/02, DCH
 FD P.K.NAIL
 REFA15
 6/2/16, JFO
 SET 1" MAG/WASHER
 6/2/17, JFO

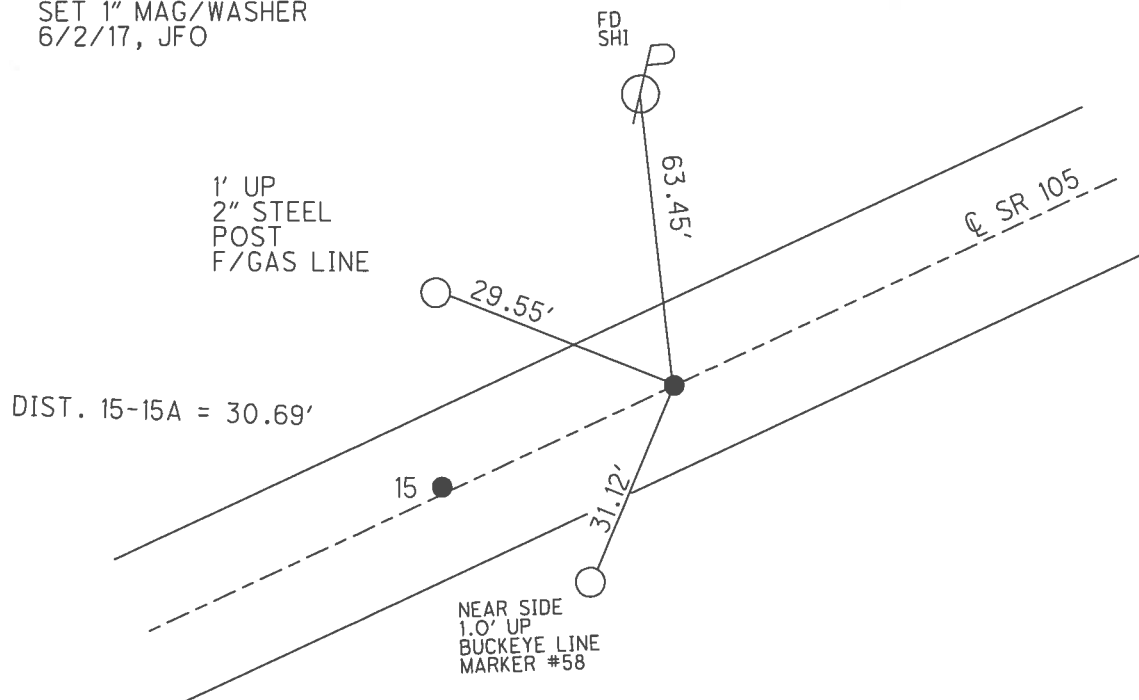

O.D.O.T. DISTRICT 2 SURVEY OFFICE (USE ONLY)


PERSONNEL	REFERENCE NO. <u>15 B</u>	SHEET <u>3</u> OF <u>54</u>
NOTES	DATE <u>9/12/16</u>	ROUTE <u>SR 105</u>
H.C. <u>RHOADES</u>	WEATHER <u>SUNNY</u>	COUNTY <u>WOOD</u>
R.C. <u>O'DONNELL</u>	TEMP. <u>55°</u>	TOWNSHIP <u>WEBSTER</u>
		SECTION <u>14</u>
		T <u>5</u> N R <u>11</u> E

TYPE MONUMENT P.K.NAIL
 ON SURFACE - ~~BELOW~~ ON
~~LEFT~~ - CL PAV'T - RIGHT 0.6'
9.3' TORT EDGE PAVEMENT
 S.L.M. 164+09

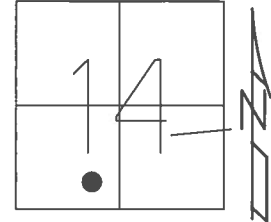

GRID: NORTHING: 628323.579 EASTING: 1675239.559


RECORD: P.I.
 STA. 165+02.80
 $\Delta = 0^\circ 26' 20''$ LT
 SET P.K./WASHER
 6/12/02, DCH
 FD P.K.NAIL
 REFB15
 6/2/16, JFO
 SET 1" MAG/WASHER
 6/2/17, JFO

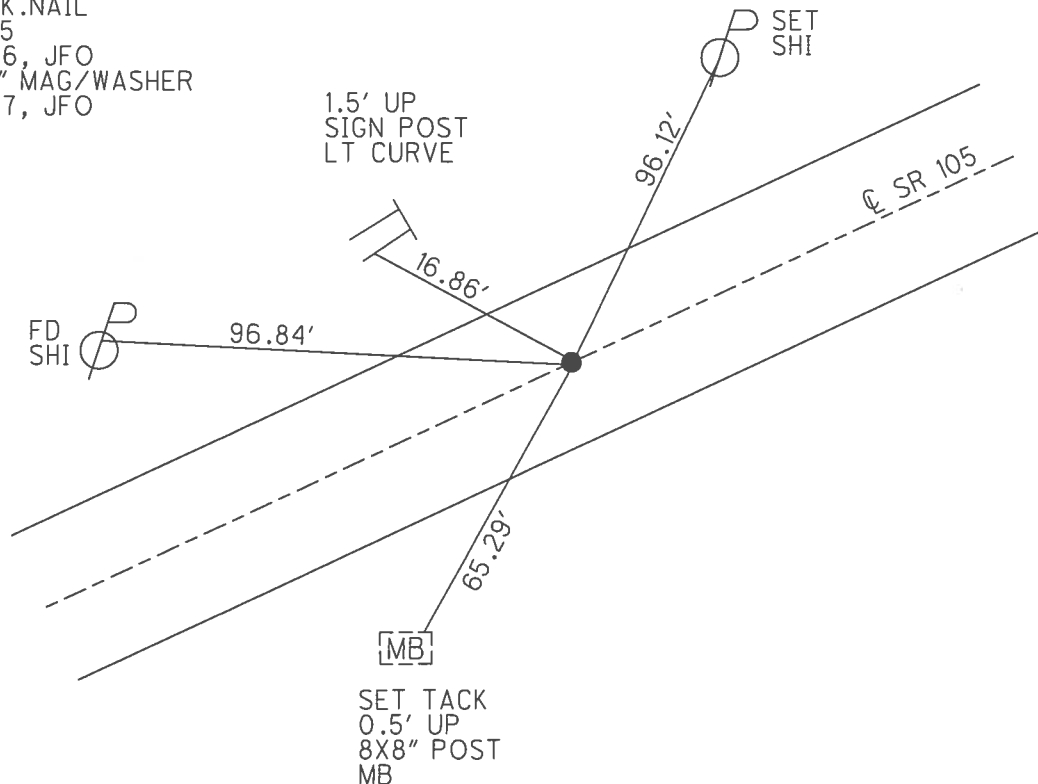

O.D.O.T. DISTRICT 2 SURVEY OFFICE (USE ONLY)


PERSONNEL	REFERENCE NO. <u>16</u>	SHEET <u>4</u> OF <u>54</u>
NOTES	DATE <u>9/12/16</u>	ROUTE <u>SR 105</u>
H.C. <u>RHOADES</u>	WEATHER <u>SUNNY</u>	COUNTY <u>WOOD</u>
R.C. <u>RHOADES</u>	TEMP. <u>55°</u>	TOWNSHIP <u>WEBSTER</u>
		SECTION <u>14</u>
		T <u>5</u> N R <u>11</u> E

TYPE MONUMENT P.K./WASHER
 ON SURFACE - ~~BELOW~~ ON
~~LEFT~~ - Q PAV'T - RIGHT 1.0'
8.6' TO RT EDGE PAVEMENT
 S.L.M. 169+69

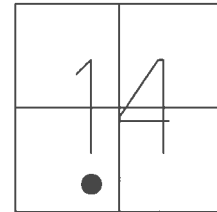

GRID: NORTHING: 628486.611 EASTING: 1675776.615


RECORD: P.I.
 STA.170+64.11
 $\Delta = 15^\circ 53' 20''$ LT
 SET P.K./WASHER
 6/12/02, DCH
 FD P.K.NAIL
 REF16
 6/3/16, JFO
 SET 1" MAG/WASHER
 NEWREF16
 6/20/17, JFO

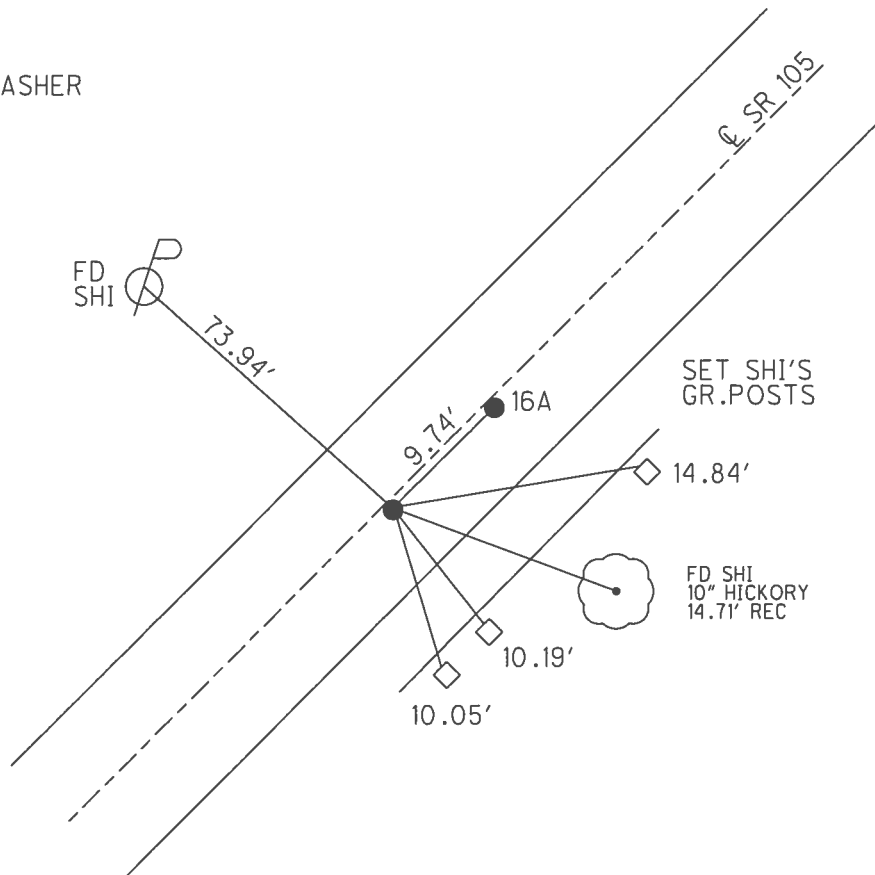

O.D.O.T. DISTRICT 2 SURVEY OFFICE (USE ONLY)


PERSONNEL	REFERENCE NO. <u>16 A</u>	SHEET <u>5</u> OF <u>54</u>
NOTES <u>RHOADES</u>	DATE <u>9/12/16</u>	ROUTE <u>SR 105</u>
H.C. <u>O'DONNELL</u>	WEATHER <u>SUNNY</u>	COUNTY <u>WOOD</u>
R.C. <u>RHOADES</u>	TEMP. <u>55°</u>	TOWNSHIP <u>WEBSTER</u>
		SECTION <u>14</u>
		T <u>5</u> N R <u>11</u> E

TYPE MONUMENT P.K./WASHER
 ON SURFACE - ~~BELOW~~ ON
~~LEFT~~ - Q PAV'T - RIGHT 2.5'
8.6' TORT EDGE PAVEMENT
 S.L.M. 169+79

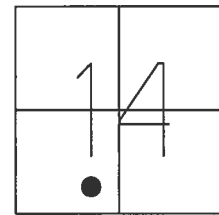

GRID: NORTHING: 628491.895 EASTING: 1675784.776


RECORD:
 SET P.K./WASHER
 6/12/02, DCH
 FD P.K./WASHER
 REFA16
 6/3/16, JFO
 SET 1" MAG/WASHER
 NEWREFA16
 6/20/17, JFO

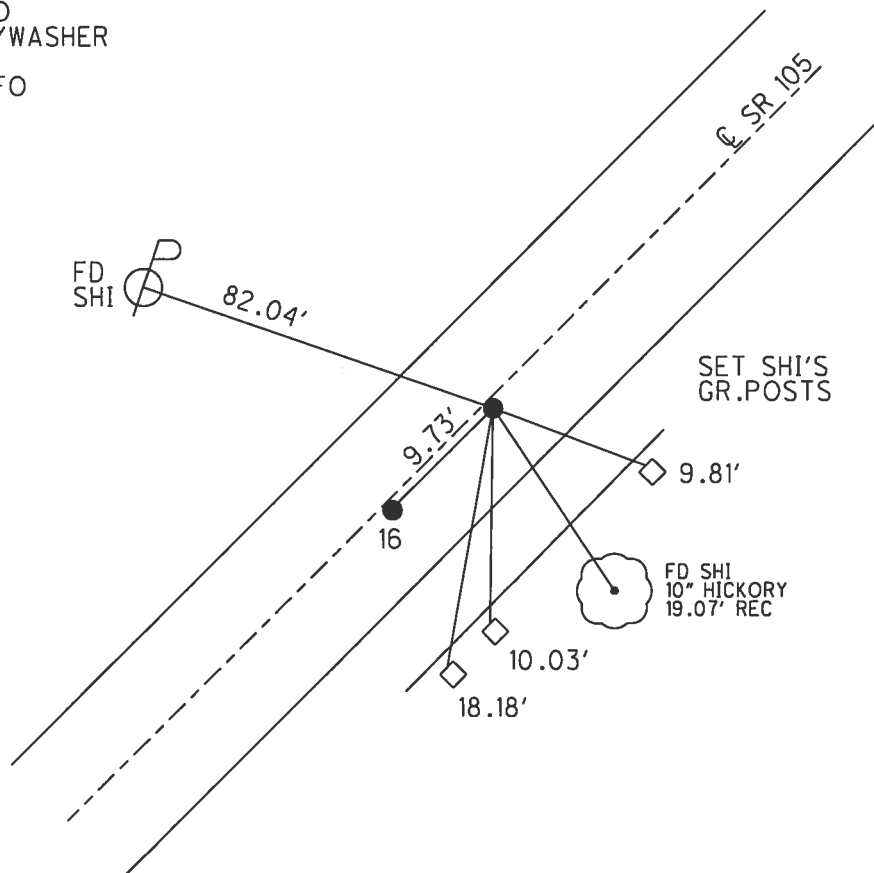

O.D.O.T. DISTRICT 2 SURVEY OFFICE (USE ONLY)


PERSONNEL	REFERENCE NO. <u>17</u>	SHEET <u>6</u> OF <u>54</u>
NOTES	DATE <u>9/12/16</u>	ROUTE <u>SR 105</u>
H.C. <u>RHOADES</u>	WEATHER <u>SUNNY</u>	COUNTY <u>WOOD</u>
R.C. <u>O'DONNELL</u>	TEMP. <u>55°</u>	TOWNSHIP <u>WEBSTER</u>
		SECTION <u>14</u>
		T <u>5</u> N R <u>11</u> E

TYPE MONUMENT P.K./WASHER
 ON SURFACE - ~~BELOW~~ ON
 LEFT - ℄ PAV'T - ~~RIGHT~~ 0.6'
8.5' TO LT EDGE PAVEMENT
 S.L.M. 172+11

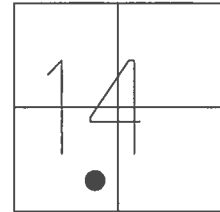

GRID: NORTHING: 628617.619 EASTING: 1675980.362


RECORD: P.I.
 STA. 173+06.39
 $\Delta = 6^{\circ}-13'-20''$ RT.
 FD P.K./WASHER
 4/1/02, KPM
 SET P.K./WASHER
 5/28/02, DCH
 FD P.K./WASHER
 REF17
 6/6/16, JFO
 SET 1" MAG/WASHER
 NEWREF17
 6/20/17, JFO

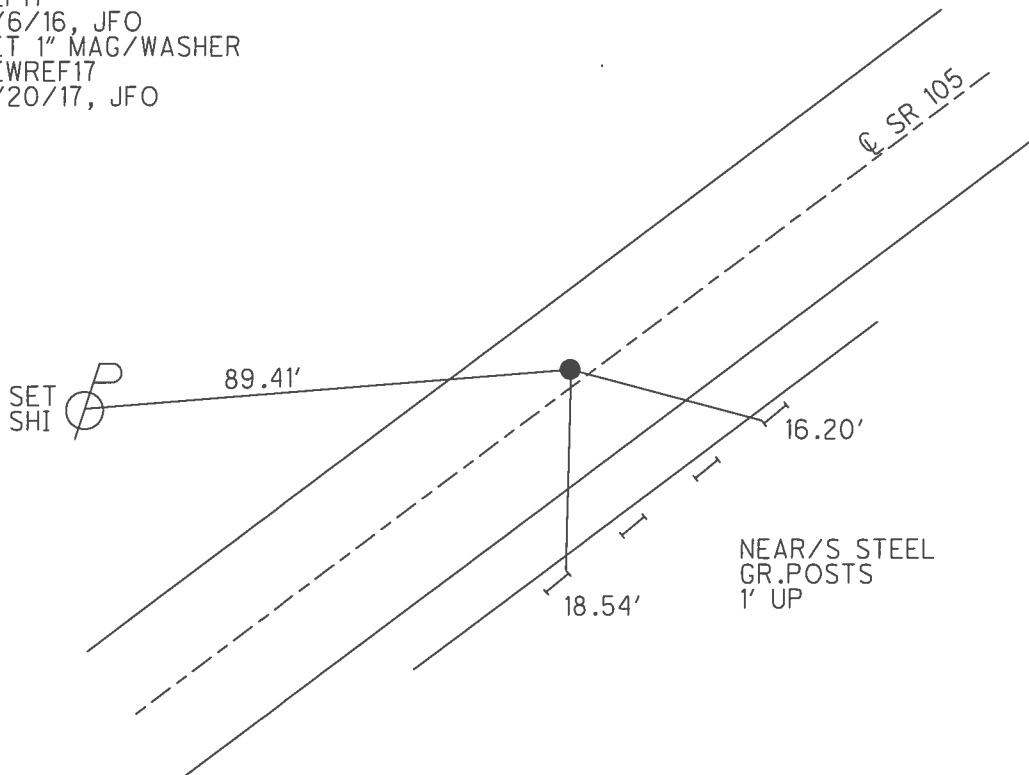

O.D.O.T. DISTRICT 2 SURVEY OFFICE (USE ONLY)


PERSONNEL	REFERENCE NO. <u>18</u>	SHEET <u>7</u> OF <u>54</u>
NOTES	DATE <u>9/12/16</u>	ROUTE <u>SR 105</u>
H.C. <u>RHOADES</u>	WEATHER <u>SUNNY</u>	COUNTY <u>WOOD</u>
R.C. <u>O'DONNELL</u>	TEMP. <u>55°</u>	TOWNSHIP <u>WEBSTER</u>
		SECTION <u>14</u>
		T <u>5</u> N R <u>11</u> E

TYPE MONUMENT P.K./WASHER
 ON SURFACE - ~~BELOW~~ ON
 LEFT - C PAV'T - RIGHT ON
9.8' TO RT EDGE PAVEMENT (BOTH)
 S.L.M. 174+40

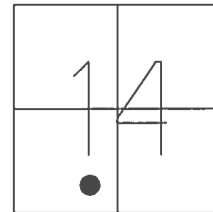

GRID: NORTHING: 628726.416 EASTING: 1676190.674


RECORD:
 ORIGIN UNKNOWN
 FD P.K./WASHER
 4/15/02, MB
 SET P.K./WASHER
 6/12/02, DCH
 FD P.K./WASHER
 REF18
 6/6/16, JFO
 SET 1" MAG/WASHER
 NEWREF18
 6/20/17, JFO

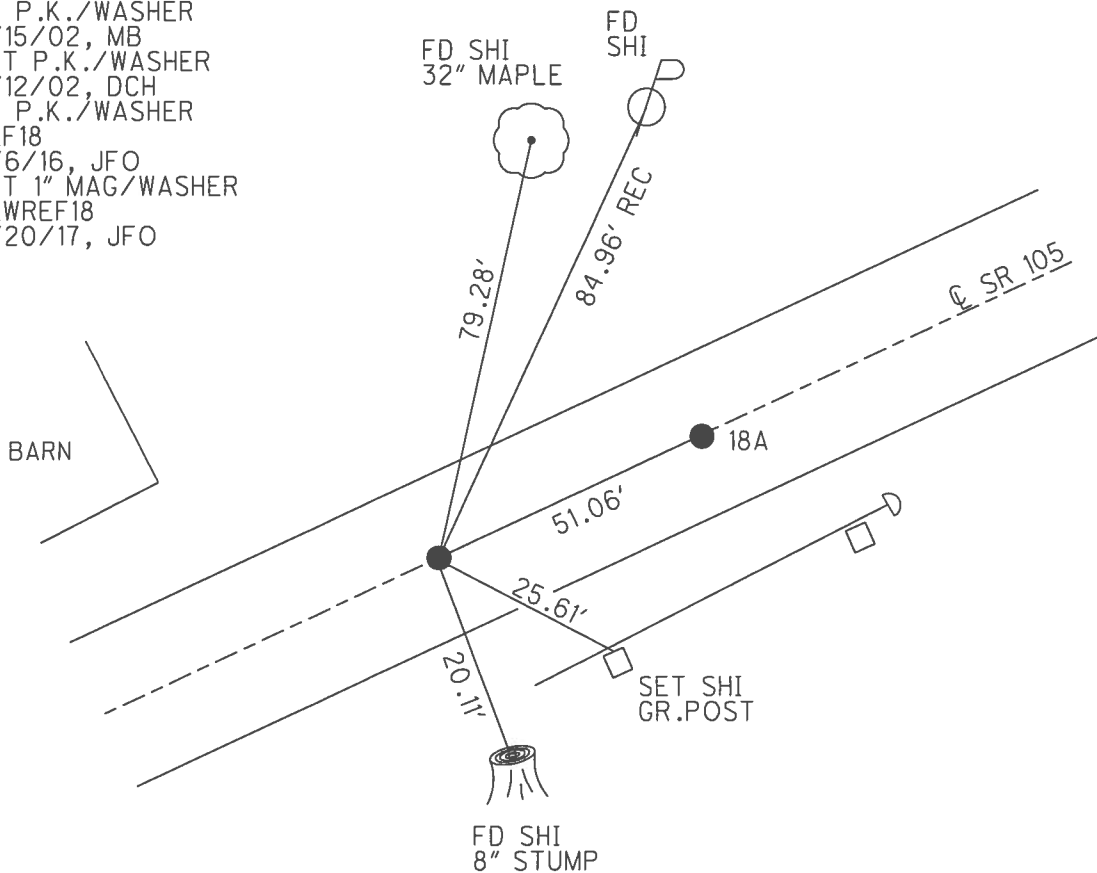

O.D.O.T. DISTRICT 2 SURVEY OFFICE (USE ONLY)


PERSONNEL	REFERENCE NO. <u>18 A</u>	SHEET <u>8</u> OF <u>54</u>
NOTES	DATE <u>9/12/16</u>	ROUTE <u>SR 105</u>
H.C. <u>RHOADES</u>	WEATHER <u>SUNNY</u>	COUNTY <u>WOOD</u>
R.C. <u>RHOADES</u>	TEMP. <u>55°</u>	TOWNSHIP <u>WEBSTER</u>
		SECTION <u>14</u>
		T <u>5</u> N R <u>11</u> E

TYPE MONUMENT P.K./WASHER
 ON SURFACE - ~~BELOW~~ ON
 LEFT - C PAV'T - RIGHT ON
9.8' TO RT EDGE PAVEMENT
 S.L.M. 174+91

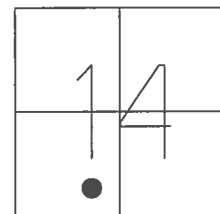

GRID: NORTHING: 628749.693 EASTING: 1676236.094

RECORD: P.I.
 STA. 175+94.19
 $\Delta = 1^{\circ}-34'-40''$ LT
 FD P.K./WASHER
 4/15/02, MB
 SET P.K./WASHER
 6/12/02, DCH
 FD P.K./WASHER
 REFA18
 6/6/16, JFO
 SET 1" MAG/WASHER
 NEWREFA18
 6/20/17, JFO

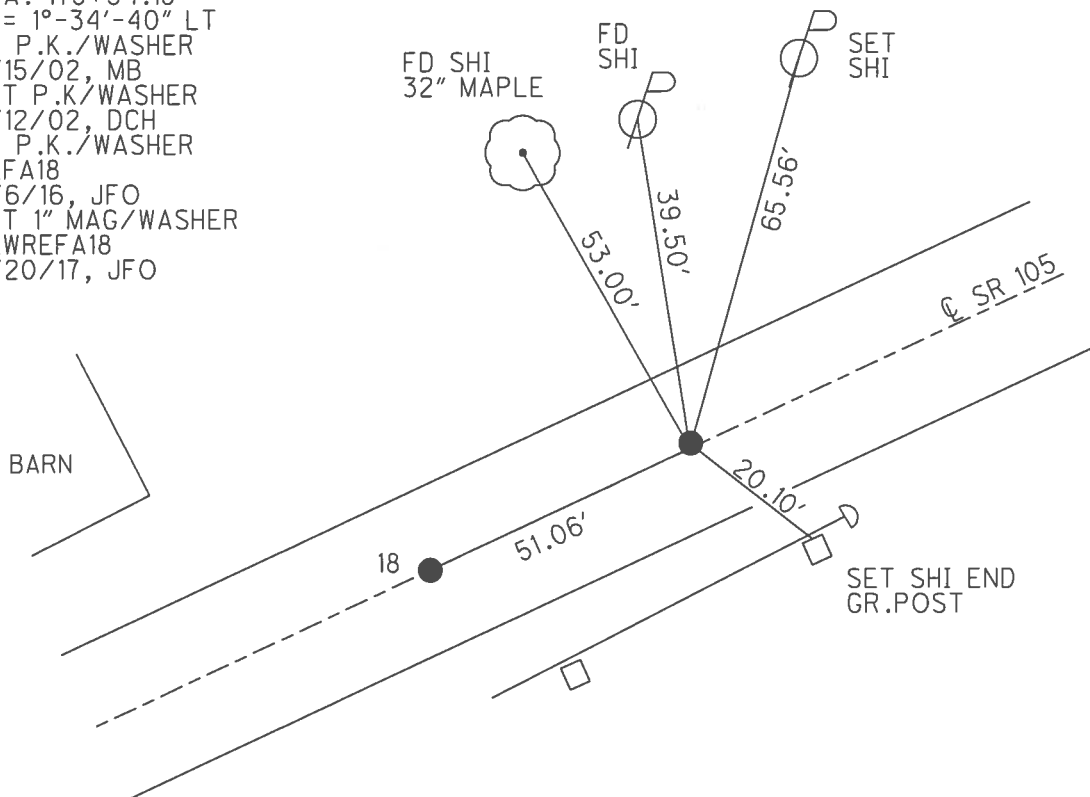

O.D.O.T. DISTRICT 2 SURVEY OFFICE (USE ONLY)

PERSONNEL

REFERENCE NO. 19

SHEET 9 OF 54

NOTES RHOADES

DATE 10/113/17

ROUTE SR 105

H.C. O'DONNELL

WEATHER HAZE

COUNTY WOOD

R.C. FARKAS

TEMP. 59°

TOWNSHIP WEBSTERSECTION 14

T 5 N R 11 E

TYPE MONUMENT 1" MAG/WASHER


ON SURFACE - ~~BELOW~~ ON _____

~~LEFT~~ - C PAV'T - RIGHT 0.4'

9.5' TOTAL EDGE PAVEMENT

S.L.M. 177+31

GRID: NORTHING: 628862.395 EASTING: 1676439.562

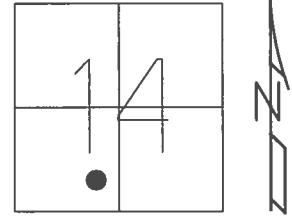

RECORD: P.I.

STA. 178+26.90

$$\Delta = 0^{\circ}-47'-20'' \text{ LT}$$

FD P.K./WASHER

4/15/02, MB
SET BACK (WASHER)

SET P.K./WASHER
C 412 402 DCU

6/12/02, DCH
SET MAC/WASHER


SET MAG/WASHER
REF 12

REF 19

6/6/16, JFO

SET 1" MAG/WASHER


10/13/17, JFO

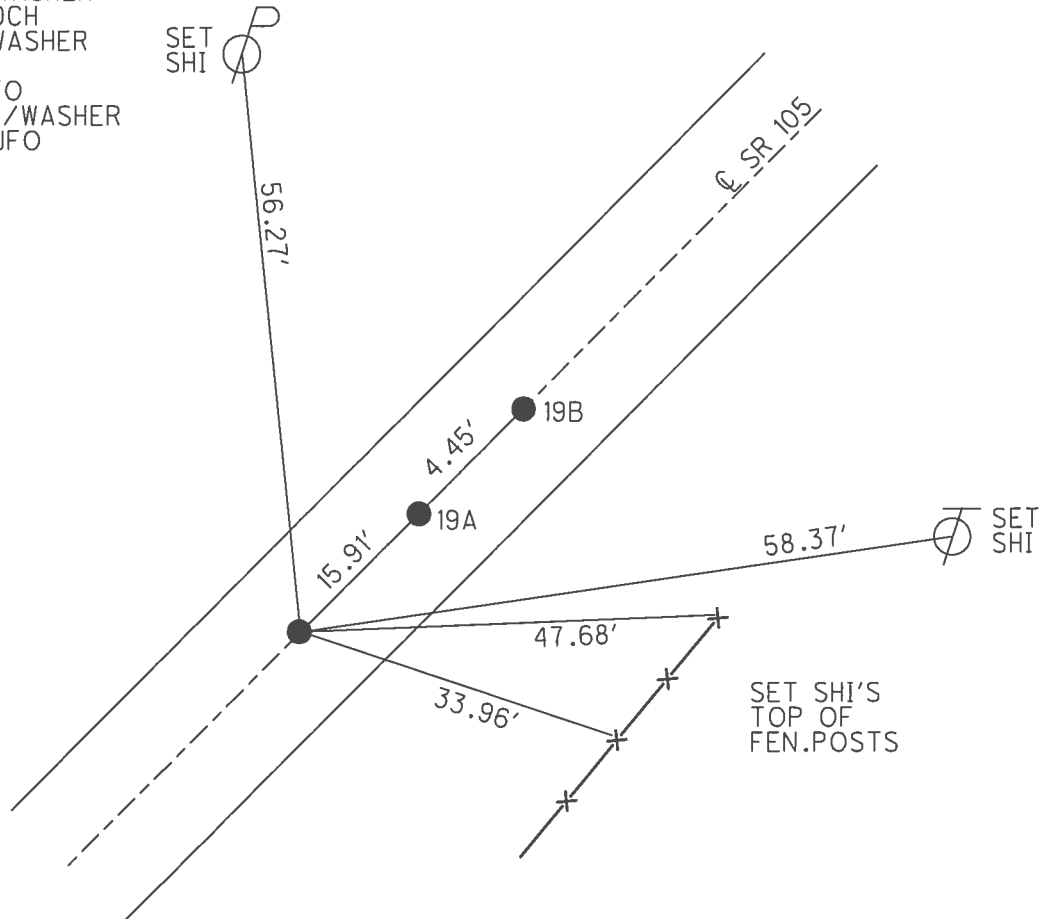

O.D.O.T. DISTRICT 2 SURVEY OFFICE (USE ONLY)


PERSONNEL	REFERENCE NO. <u>19 A</u>	SHEET <u>10</u> OF <u>54</u>
NOTES	DATE <u>10/13/17</u>	ROUTE <u>SR 105</u>
H.C. <u>RHOADES</u>	WEATHER <u>HAZE</u>	COUNTY <u>WOOD</u>
R.C. <u>O'DONNELL</u>	TEMP. <u>59°</u>	TOWNSHIP <u>WEBSTER</u>
		SECTION <u>14</u>
		<u>T 5 N R 11 E</u>

TYPE MONUMENT 1" MAG/WASHER
 ON SURFACE - ~~BELOW~~ ON
 LEFT - CL PAV'T - RIGHT ON
10.9' RT RT EDGE PAVEMENT
 S.L.M. 177+47

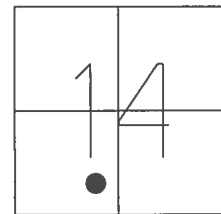

GRID: NORTHING: 628870.380 EASTING: 1676453.340

RECORD:
 FD P.K./WASHER
 4/15/02, MB
 SET P.K./WASHER
 6/12/02, DCH
 FD P.K./WASHER
 REFA19
 6/6/16, JFO
 SET 1" MAG/WASHER
 10/13/17, JFO

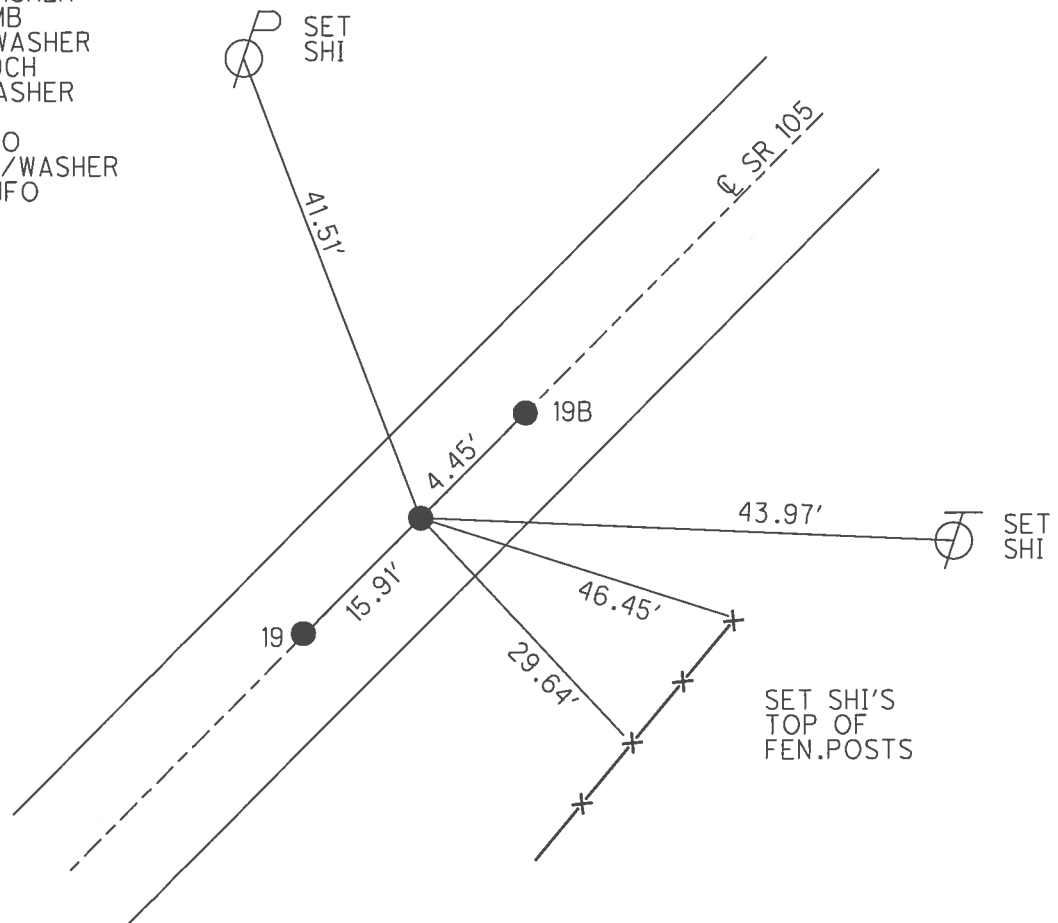


O.D.O.T. DISTRICT 2 SURVEY OFFICE (USE ONLY)


PERSONNEL _____ REFERENCE NO. 19 B SHEET 11 OF 54
 NOTES RHOADES DATE 10/13/17 ROUTE SR 105
 H.C. O'DONNELL WEATHER HAZE COUNTY WOOD
 R.C. FARKAS TEMP. 59° TOWNSHIP WEBSTER
 SECTION 14
 T 5 N R 11 E

TYPE MONUMENT 1" MAG/WASHER
 ON SURFACE - ~~BELOW~~ ON
 LEFT - CL PAV'T - RIGHT ON
10.6' TO RT EDGE PAVEMENT
 S.L.M. 177+51

GRID: NORTHING: 628872.353 EASTING: 1676457.348

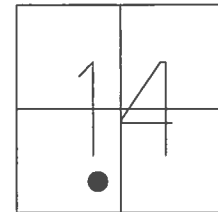


RECORD:
 FD P.K./WASHER
 4/15/02, MB
 SET P.K./WASHER
 6/12/02, DCH
 FD P.K./WASHER
 REFB19
 6/6/16, JFO
 SET 1" MAG/WASHER
 10/13/17, JFO

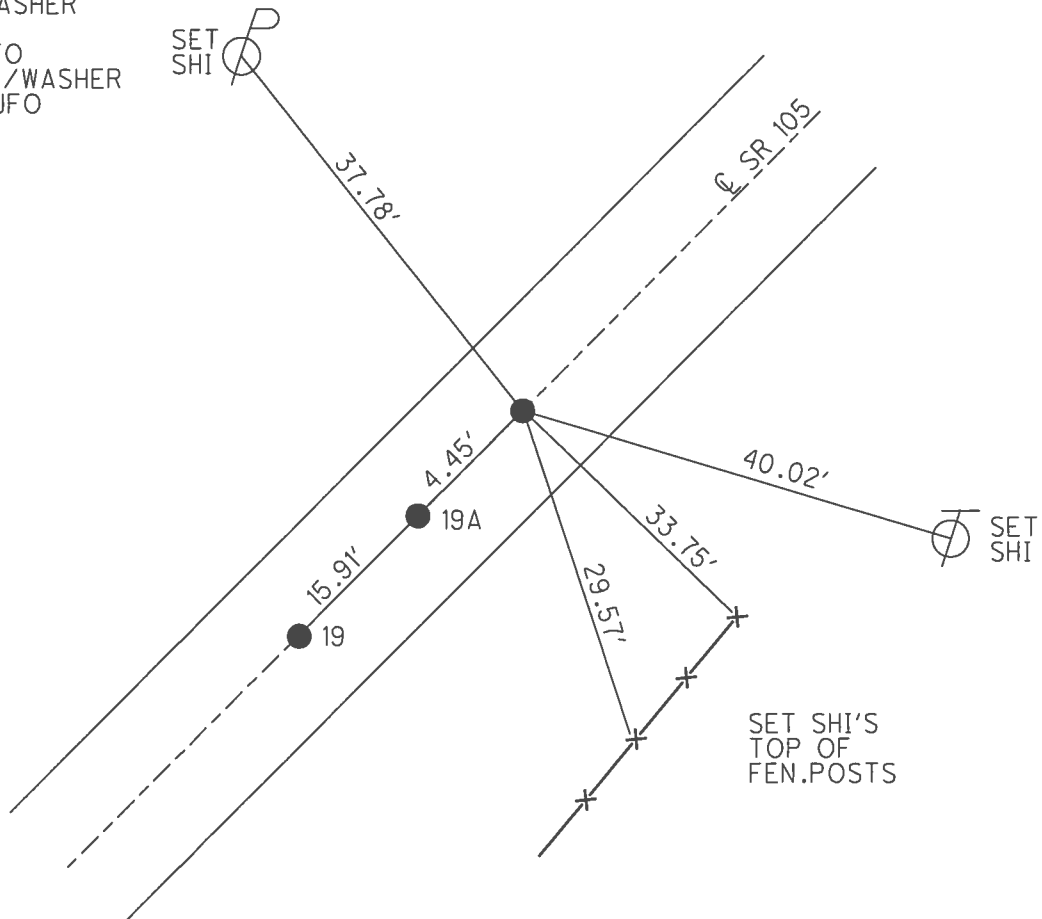

O.D.O.T. DISTRICT 2 SURVEY OFFICE (USE ONLY)


PERSONNEL	REFERENCE NO. <u>20</u>	SHEET <u>12</u> OF <u>54</u>
NOTES	DATE <u>9/12/16</u>	ROUTE <u>SR 105</u>
H.C. <u>RHOADES</u>	WEATHER <u>SUNNY</u>	COUNTY <u>WOOD</u>
R.C. <u>O'DONNELL</u>	TEMP. <u>55°</u>	TOWNSHIP <u>WEBSTER</u>
		SECTION <u>14</u>
		T <u>5</u> N R <u>11</u> E

TYPE MONUMENT P.K.NAIL
 ON SURFACE - ~~BELOW~~ ON
~~LEFT~~ - C PAV'T - RIGHT 4.5'
5.1' TO RT EDGE PAVEMENT
 S.L.M. 179+51

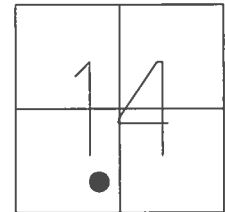

GRID: NORTHING: 628969.895 EASTING: 1676627.702


RECORD: P.I.
 STA. 180+43.57
 $\Delta = 5^{\circ}-53'-20''$ LT
 FD P.K./WASHER
 4/13/02, MB
 SET P.K./WASHER
 6/12/02, DCH
 FD P.K.NAIL
 REF20
 6/6/16, JFO
 SET 1" MAG/WASHER
 10/13/17, JFO

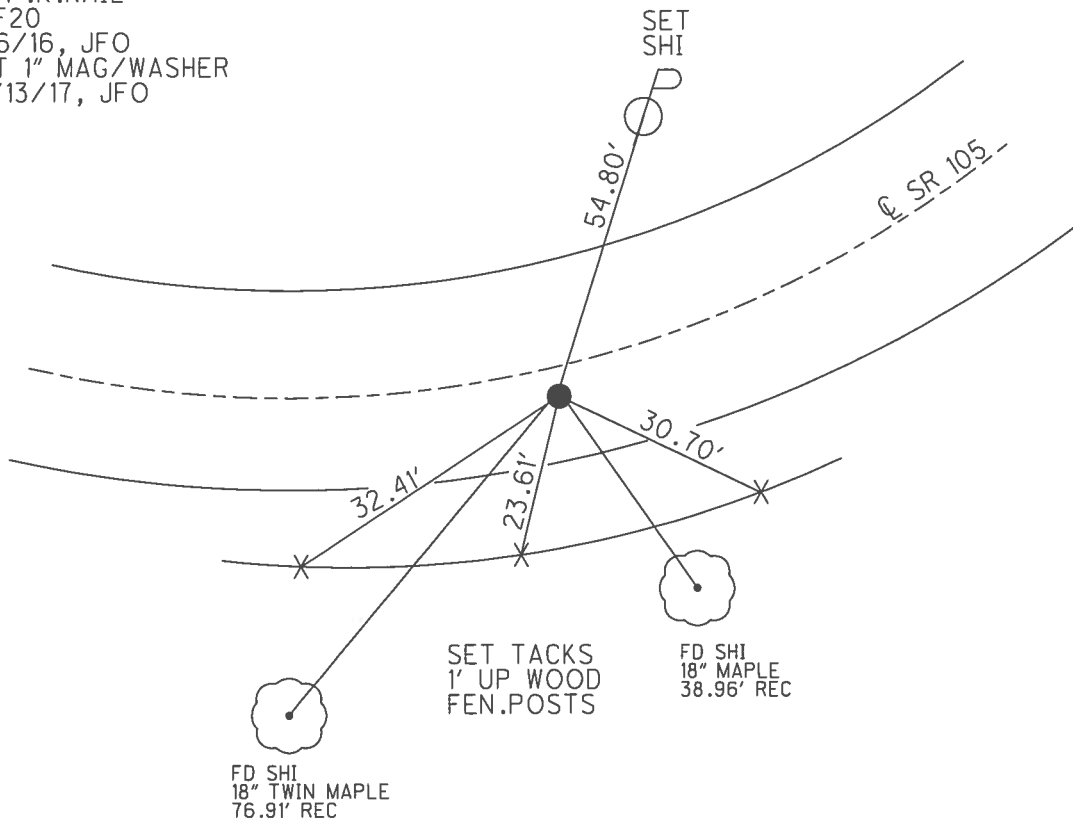

O.D.O.T. DISTRICT 2 SURVEY OFFICE (USE ONLY)


PERSONNEL _____ REFERENCE NO. 21 SHEET 13 OF 54
 NOTES RHOADES DATE 9/12/16 ROUTE SR 105
 H.C. O'DONNELL WEATHER SUNNY COUNTY WOOD
 R.C. TODD TEMP. 55° TOWNSHIP WEBSTER
 SECTION 14
 T 5 N R 11 E

TYPE MONUMENT P.K./WASHER
 ON SURFACE - ~~BELOW~~ ON
 LEFT - C PAV'T - RIGHT ON
11.2' TO RT EDGE PAVEMENT
 S.L.M. 181+95

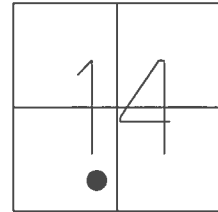

GRID: NORTHING: 629133.005 EASTING: 1676827.346


RECORD:
 ORIGIN UNKNOWN
 FD P.K./WASHER
 4/13/02, MB
 SET P.K./WASHER
 6/12/02, DCH
 FD P.K./WASHER
 REF21
 SET 1" MAG/WASHER
 10/13/17, JFO

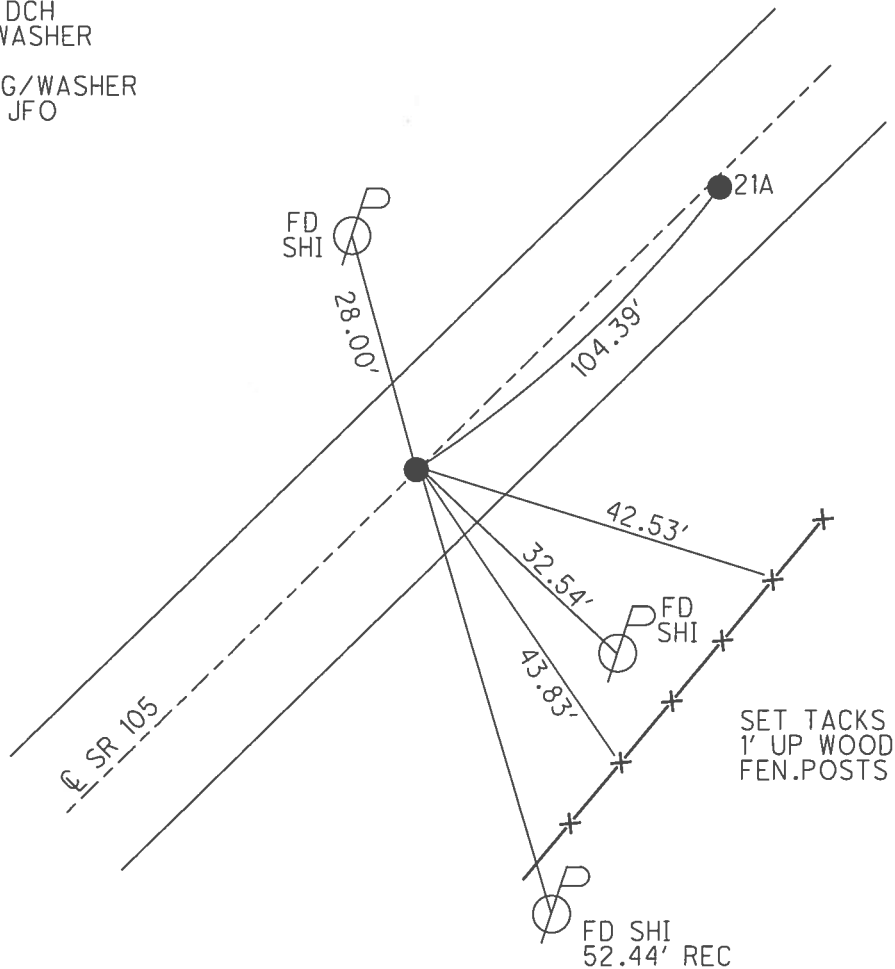

O.D.O.T. DISTRICT 2 SURVEY OFFICE (USE ONLY)


PERSONNEL	REFERENCE NO. <u>21 A</u>	SHEET <u>14</u> OF <u>54</u>
NOTES	DATE <u>9/12/16</u>	ROUTE <u>SR 105</u>
H.C. <u>RHOADES</u>	WEATHER <u>SUNNY</u>	COUNTY <u>WOOD</u>
R.C. <u>O'DONNELL</u>	TEMP. <u>55°</u>	TOWNSHIP <u>WEBSTER</u>
		SECTION <u>14</u>
		<u>T 5 N R 11 E</u>

TYPE MONUMENT P.K./WASHER
 ON SURFACE - ~~BELOW~~ ON
 LEFT - ℄ PAV'T - RIGHT 0.8'
9.9' TO RT. EDGE PAVEMENT
 S.L.M. 182+99

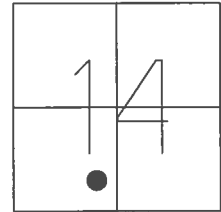

GRID: NORTHING: 629173.808 EASTING: 1676912.170


RECORD: P.I.
 STA. 183+93.58
 $\Delta = 1^{\circ}-24'-20''$ LT.
 FD P.K./WASHER
 4/13/02, DCH
 SET P.K./WASHER
 6/12/02, DCH
 FD P.K./WASHER
 REFA21
 6/6/16, JFO
 SET 1" MAG/WASHER
 10/13/17, JFO

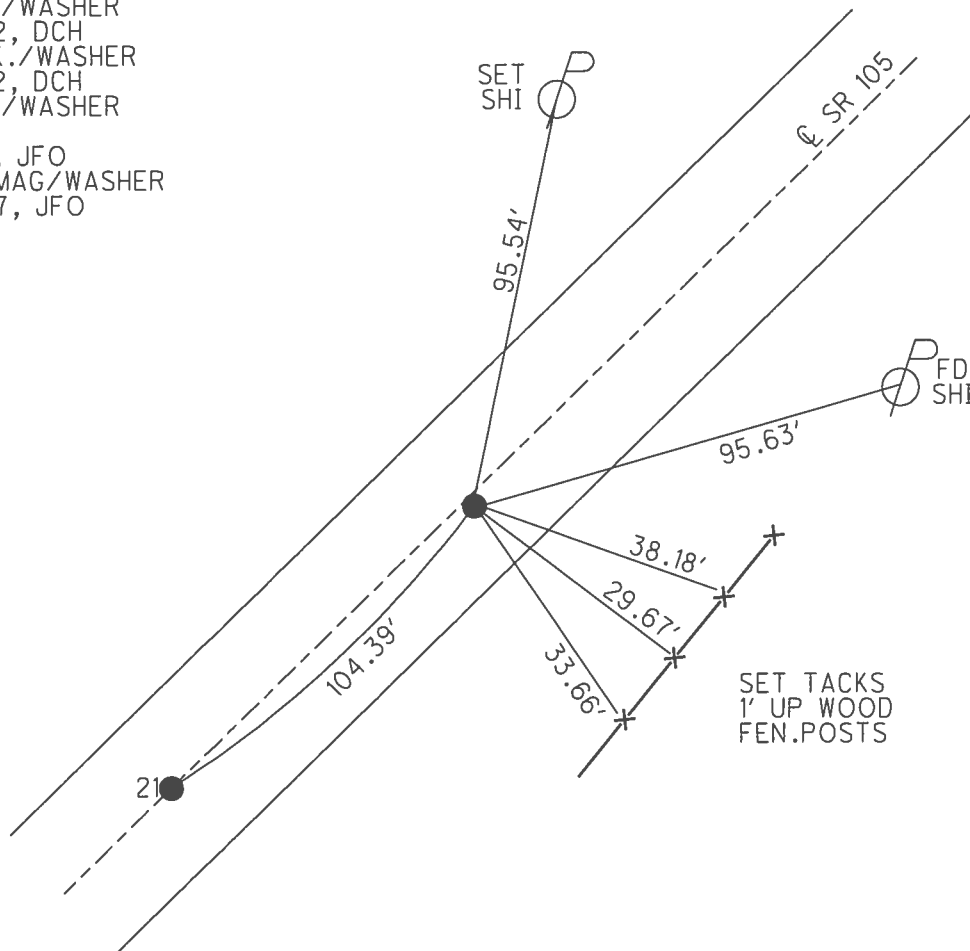

O.D.O.T. DISTRICT 2 SURVEY OFFICE (USE ONLY)


PERSONNEL _____ REFERENCE NO. 22 SHEET 15 OF 54
 NOTES RHOADES DATE 9/12/16 ROUTE SR 105
 H.C. O'DONNELL WEATHER SUNNY COUNTY WOOD
 R.C. TODD TEMP. 55° TOWNSHIP WEBSTER
 SECTION 14
 T 5 N R 11 E

TYPE MONUMENT P.K./WASHER
 ON SURFACE - ~~BELOW~~ ON
 LEFT - ℄ PAV'T - RIGHT ON
10' TO RT EDGE PAVEMENT
 S.L.M. 185+64

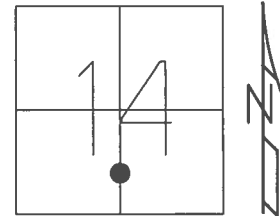

GRID: NORTHING: 629333.759 EASTING: 1677124.241


RECORD: P.I.
 STA. 186+59.18
 $\Delta = 2^{\circ}-5'-20''$ LT
 FD P.K./WASHER
 4/13/02, DCH
 SET P.K./WASHER
 6/13/02, DCH
 FD P.K./WASHER
 REF22
 6/6/16, JFO
 SET 1" MAG/WASHER
 10/13/17, JFO

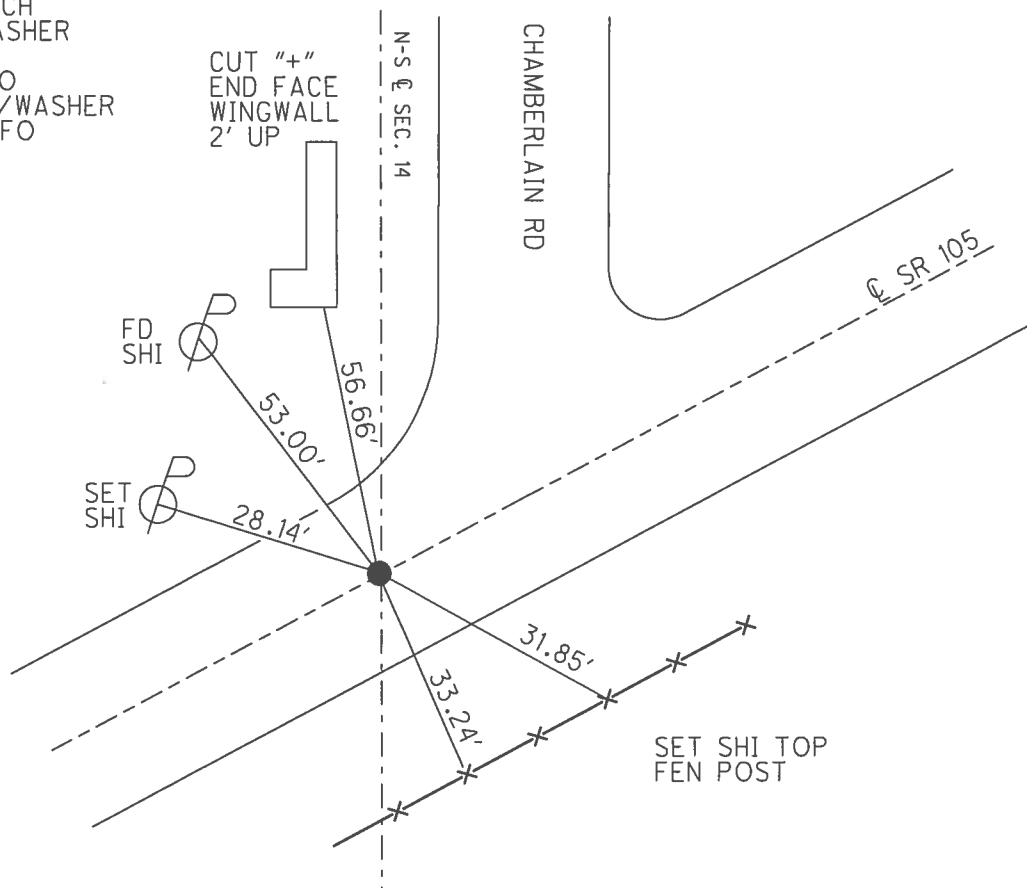

O.D.O.T. DISTRICT 2 SURVEY OFFICE (USE ONLY)


PERSONNEL	REFERENCE NO. <u>23</u>	SHEET <u>16</u> OF <u>54</u>
NOTES	DATE <u>9/12/16</u>	ROUTE <u>SR 105</u>
H.C. <u>RHOADES</u>	WEATHER <u>SUNNY</u>	COUNTY <u>WOOD</u>
R.C. <u>O'DONNELL</u>	TEMP. <u>76°</u>	TOWNSHIP <u>WEBSTER</u>
		SECTION <u>14</u>
		T <u>5</u> N R <u>11</u> E

TYPE MONUMENT P.K./WASHER
 ON SURFACE - ~~BELOW~~ ON
 LEFT - Q PAV'T - ~~RIGHT~~ 1'
10' TO RT EDGE PAVEMENT
 S.L.M. 188+64

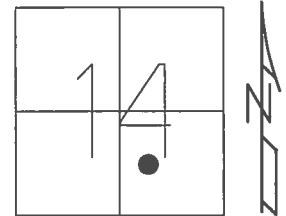

GRID: NORTHING: 629523.169 EASTING: 1677357.038


RECORD: P.I.
 STA. 189+59.36
 $\Delta = 0^\circ - 36' - 40''$ LT
 FD P.K./WASHER
 4/13/02, DCH
 SET P.K./WASHER
 5/28/02, DCH
 FD P.K./WASHER
 REF23
 6/6/16, JFO
 SET 1" MAG/WASHER
 10/13/17, JFO

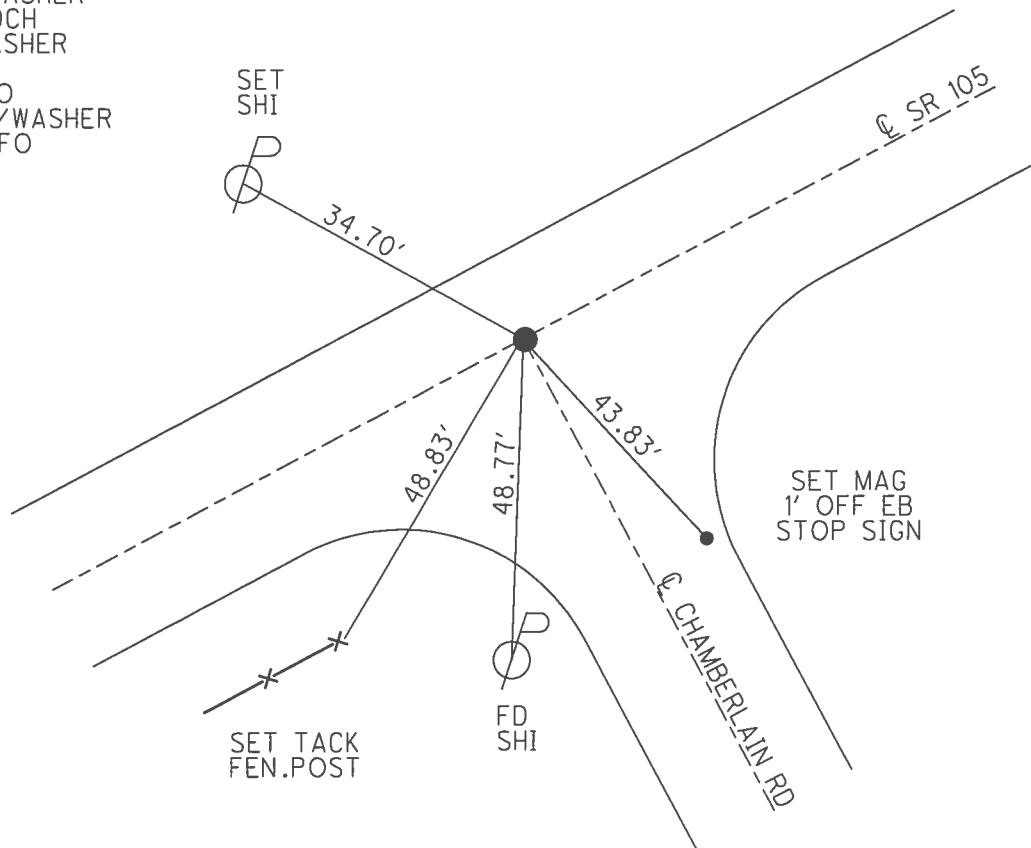


O.D.O.T. DISTRICT 2 SURVEY OFFICE (USE ONLY)

PERSONNEL	REFERENCE NO. <u>23 A</u>	SHEET <u>17</u> OF <u>54</u>
NOTES <u>O'DONNELL</u>	DATE <u>6/6/16</u>	ROUTE <u>SR 105</u>
H.C. <u>O'DONNELL</u>	WEATHER <u>SUNNY</u>	COUNTY <u>WOOD</u>
R.C. <u>TODD</u>	TEMP. <u>75°</u>	TOWNSHIP <u>WEBSTER</u>
		SECTION <u>14</u>
		T <u>5</u> N R <u>11</u> E

TYPE MONUMENT R.R.SPIKE
~~ON SURFACE~~ - BELOW 6"
 LEFT - ℄ PAV'T - ~~RIGHT~~ 0.8'
11.1' TO RT EDGE PAVEMENT
 S.L.M. 194+68

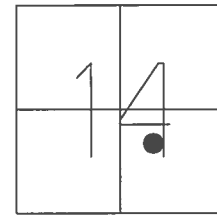


RECORD:
 ORIGIN UNKNOWN
 FD P.K.NAIL
 4/13/02, DCH
 SET P.K./WASHER
 5/28/02, DCH
 FD R.R.SPIKE
 6" DOWN
 REFA23
 6/6/16, JFO
 SET MAG/WASHER
 NEWREFA23
 11/21/16, JFO

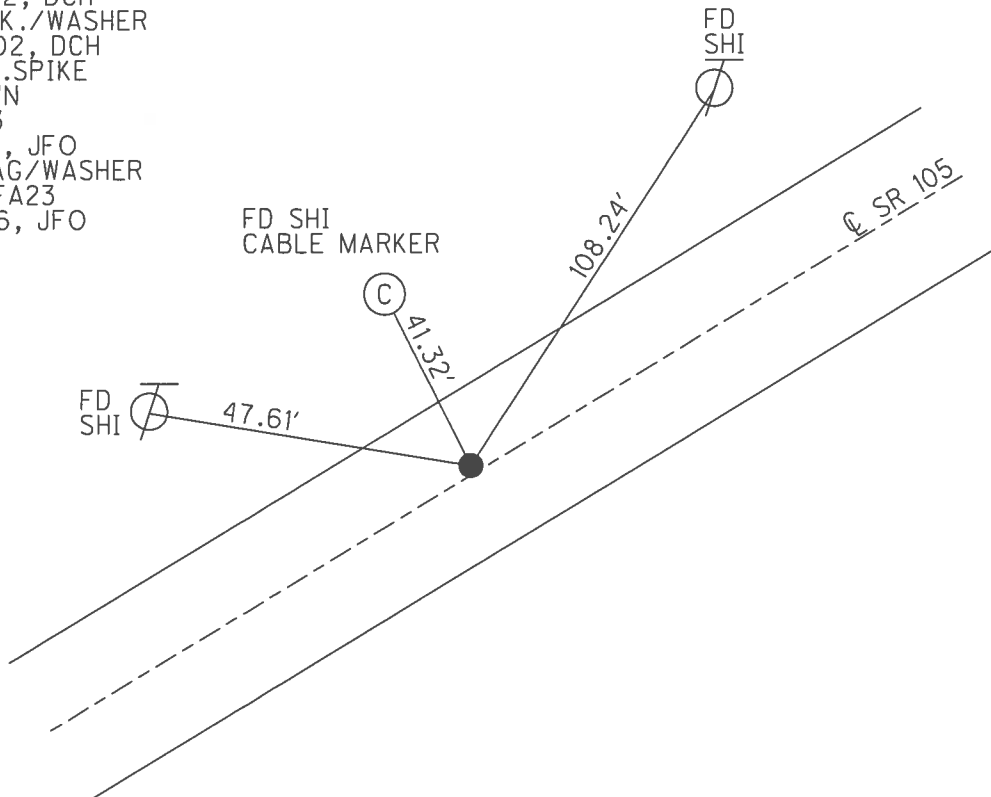

O.D.O.T. DISTRICT 2 SURVEY OFFICE (USE ONLY)


PERSONNEL	REFERENCE NO. <u>23 B</u>	SHEET <u>18</u> OF <u>54</u>
NOTES <u>O'DONNELL</u>	DATE <u>6/6/16</u>	ROUTE <u>SR 105</u>
H.C. <u>O'DONNELL</u>	WEATHER <u>SUNNY</u>	COUNTY <u>WOOD</u>
R.C. <u>TODD</u>	TEMP. <u>76°</u>	TOWNSHIP <u>WEBSTER</u>
		SECTION <u>14</u>
		<u>T 5 N R 11 E</u>

TYPE MONUMENT R.R.SPIKE
 ON SURFACE - ~~BELOW~~ 6"
~~LEFT~~ - Q PAV'T - RIGHT 0.8'
9.4' TO LT EDGE PAVEMENT
 S.L.M. 198+60

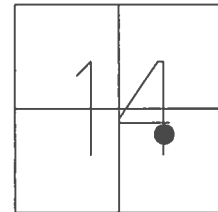

GRID: NORTHING: 630159.975 EASTING: 1678122.283


RECORD:
 FD P.K./WASHER
 4/15/02, DCH
 SET P.K./WASHER
 5/28/02, DCH
 FD R.R.SPIKE
 6" DOWN
 REFB23
 6/6/16, JFO
 SET MAG/WASHER
 NEWREFB23
 11/21/16, JFO

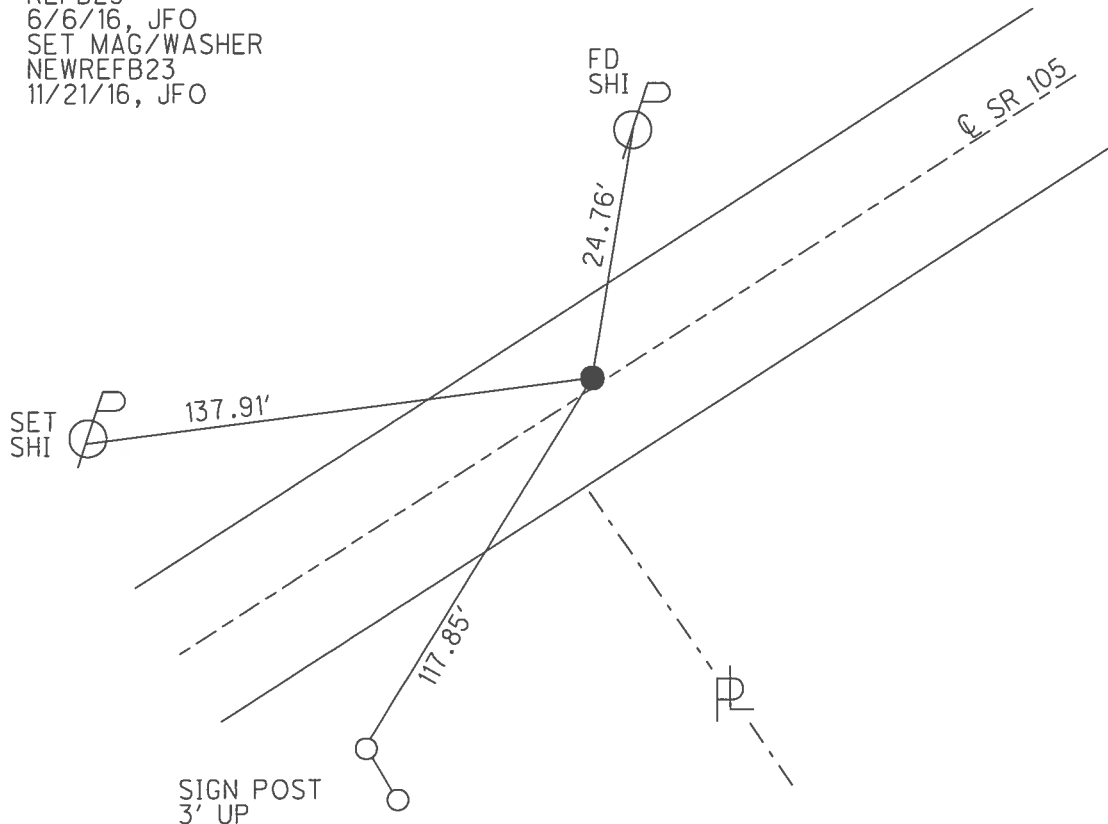

O.D.O.T. DISTRICT 2 SURVEY OFFICE (USE ONLY)


PERSONNEL _____ REFERENCE NO. 24 SHEET 19 OF 54
 NOTES ROUSOS _____ DATE 4/13/02 ROUTE SR 105
 H.C. HOMAN _____ WEATHER SUNNY COUNTY WOOD
 R.C. BROWN _____ TEMP. 52° TOWNSHIP WEBSTER
 _____ SECTION 14
 _____ T 5 N R 11 E

TYPE MONUMENT IPIN
 ON SURFACE - ~~BELOW~~ ON
 LEFT - Q PAV'T - ~~RIGHT~~ 23.6'
12.9' TO N EDGE PAVEMENT
 S.L.M. 202+58

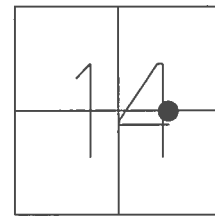

GRID: NORTHING: 630415.127 EASTING: 1678474.792


RECORD: P.I.
 STA. 203+55.17
 $\Delta = 41^{\circ}-10'-00''$ RT
 FD IPIN
 ON SURFACE
 4/13/02, DCH
 SET P.K./WASHER
 5/28/02, DCH
 FD P.K./WASHER
 REF24
 6/6/16, JFO

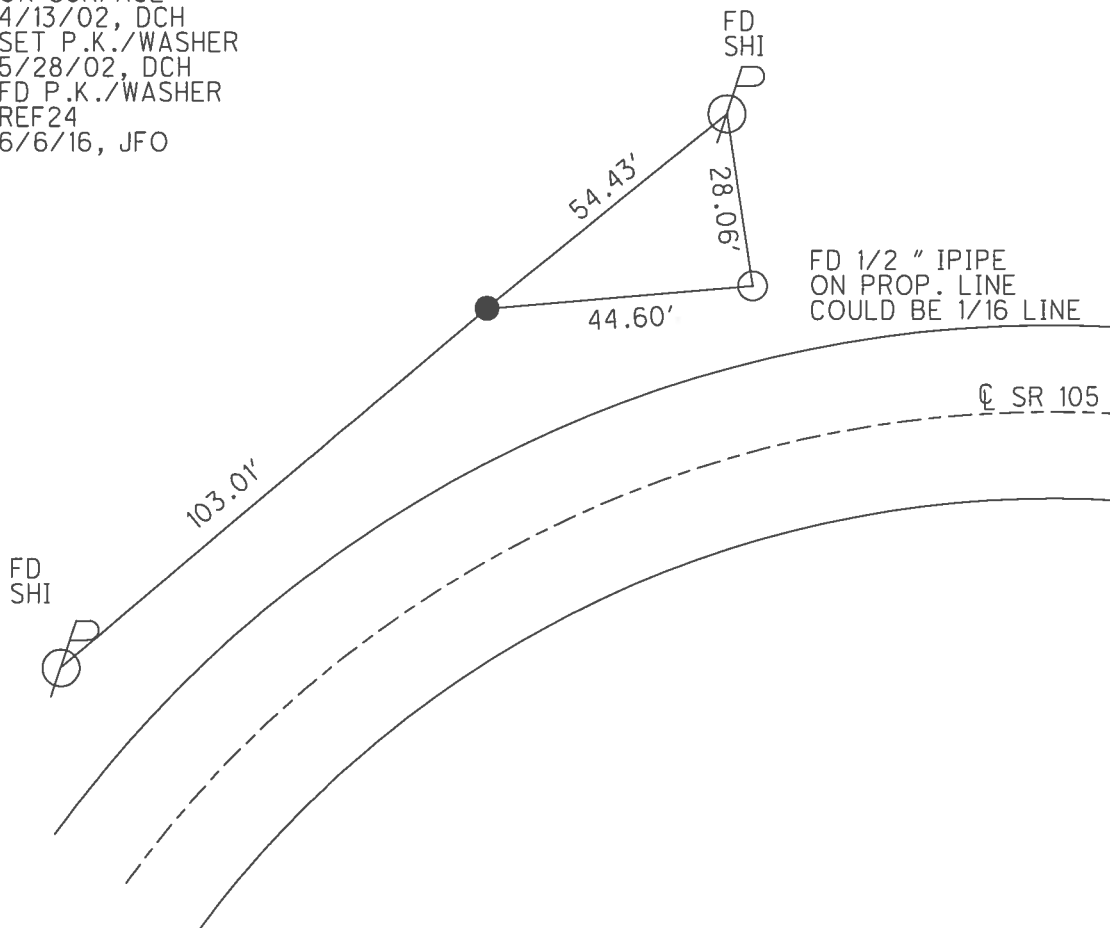

O.D.O.T. DISTRICT 2 SURVEY OFFICE (USE ONLY)


PERSONNEL	REFERENCE NO. <u>24 A</u>	SHEET <u>20</u> OF <u>54</u>
NOTES	O'DONNELL	DATE <u>6/6/16</u>
H.C.	O'DONNELL	WEATHER <u>SUNNY</u>
R.C.	TODD	TEMP. <u>80°</u>
		ROUTE <u>SR 105</u>
		COUNTY <u>WOOD</u>
		TOWNSHIP <u>WEBSTER</u>
		SECTION <u>14</u>
		T <u>5</u> N R <u>11</u> E

TYPE MONUMENT P.K./WASHER
~~ON SURFACE~~ - BELOW 3"
 LEFT - CL PAV'T - ~~RIGHT~~ 2'
8' TO LT EDGE PAVEMENT
 S.L.M. 206+14

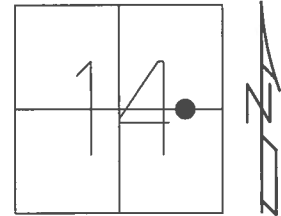

GRID: NORTHING: 630406.545 EASTING: 1678795.015


RECORD:
 FD P.K./WASHER
 4/15/02, DCH
 SET P.K./WASHER
 5/28/02, DCH
 FD P.K./WASHER
 REFA24
 6/6/16, JFO
 SET MAG/WASHER
 NEWREFA24
 11/21/16, JFO

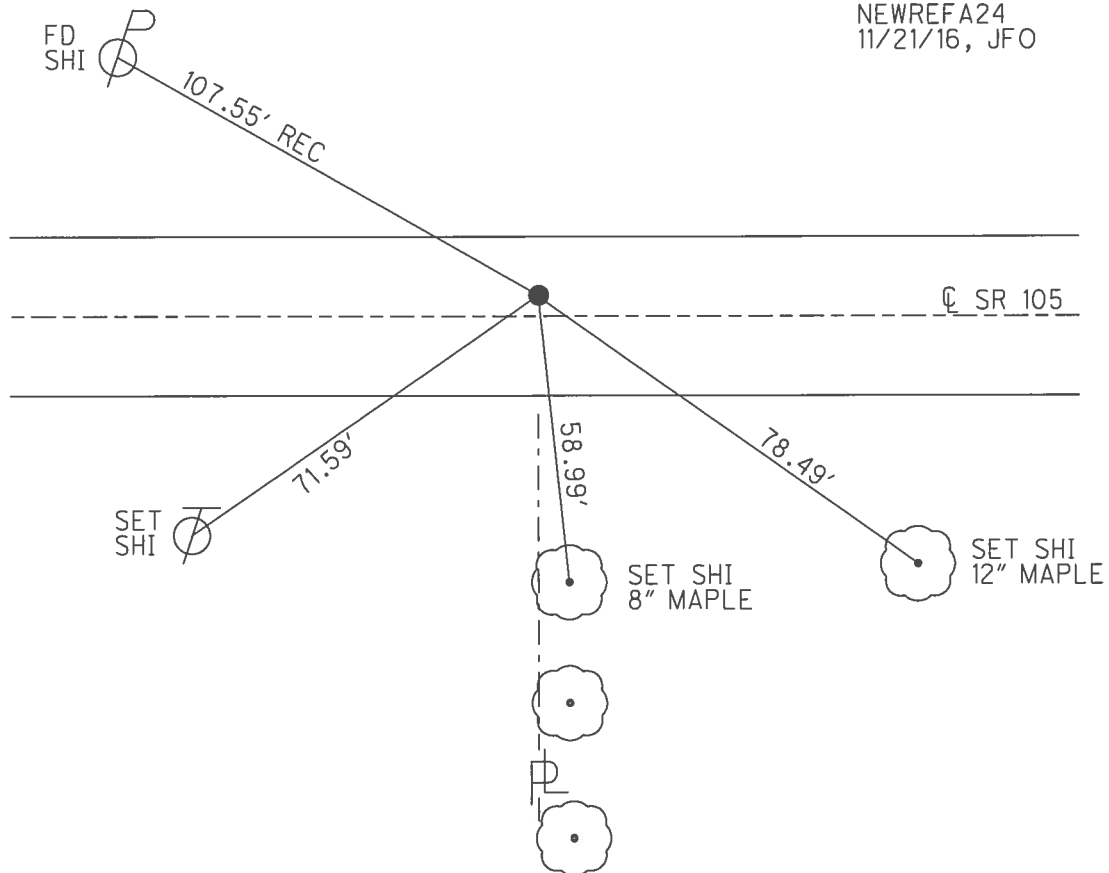

O.D.O.T. DISTRICT 2 SURVEY OFFICE (USE ONLY)


PERSONNEL	REFERENCE NO. <u>24 B</u>	SHEET <u>21</u> OF <u>54</u>
NOTES	DATE <u>9/12/16</u>	ROUTE <u>SR 105</u>
H.C. <u>RHOADES</u>	WEATHER <u>SUNNY</u>	COUNTY <u>WOOD</u>
R.C. <u>O'DONNELL</u>	TEMP. <u>76°</u>	TOWNSHIP <u>WEBSTER</u>
		SECTION <u>14</u>
		T <u>5</u> N R <u>11</u> E

TYPE MONUMENT P.K./WASHER
 ON SURFACE - ~~BELOW~~ ON
 LEFT - CL PAV'T - ~~RIGHT~~ 2'
12.2' TO RT EDGE PAVEMENT
 S.L.M. 210+80

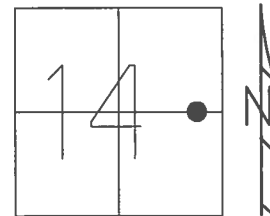

GRID: NORTHING: 630395.008 EASTING: 1679259.869


RECORD:
 FD P.K./WASHER
 4/14/02, DCH
 SET P.K./WASHER
 6/13/02, DCH
 FD P.K./WASHER
 REFB24
 6/6/16, JFO
 SET 1" MAG/WASHER
 10/13/17, JFO

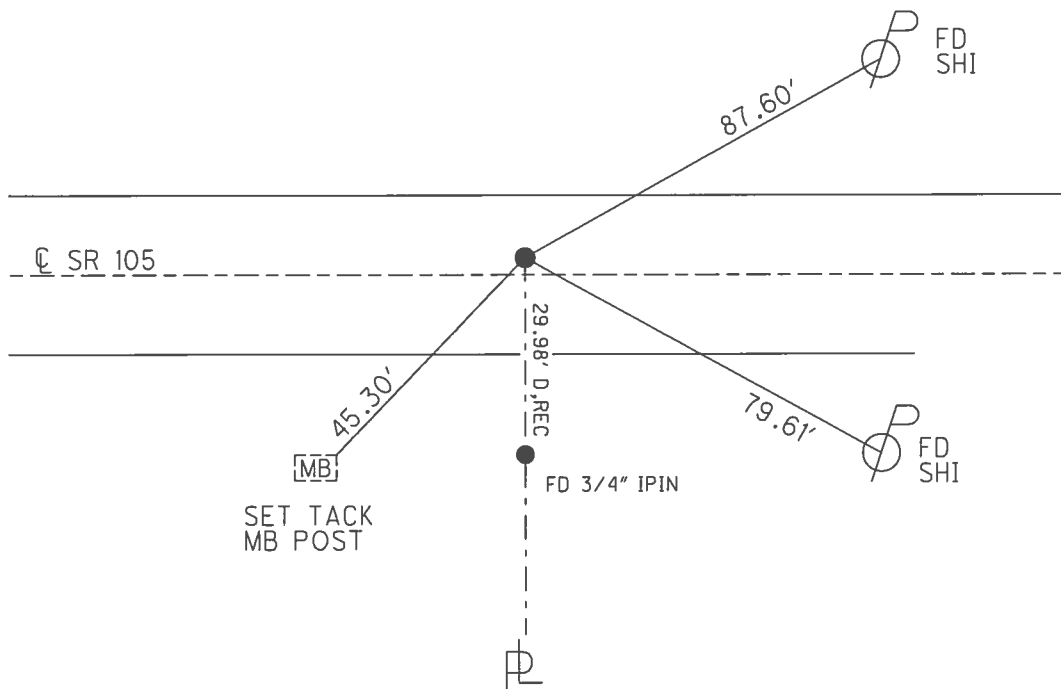

O.D.O.T. DISTRICT 2 SURVEY OFFICE (USE ONLY)


PERSONNEL	REFERENCE NO. <u>24 C</u>	SHEET <u>22</u> OF <u>54</u>	
NOTES	O'DONNELL	DATE <u>6/9/16</u>	ROUTE <u>SR 105</u>
H.C.	O'DONNELL	WEATHER <u>SUNNY</u>	COUNTY <u>WOOD</u>
R.C.	TODD	TEMP. <u>60°</u>	TOWNSHIP <u>WEBSTER</u>
			SECTION <u>14</u>
			T <u>5</u> N R <u>11</u> E

TYPE MONUMENT R.R.SPIKE
~~ON SURFACE~~ - BELOW 6"
 LEFT - C PAV'T - ~~RIGHT~~ 4'
14.4' TO RT EDGE PAVEMENT
 S.L.M. 213+53

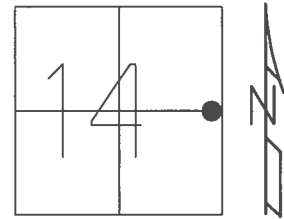

GRID: NORTHING: 630388.240 EASTING: 1679534.641


RECORD:
 FD P.K./WASHER
 4/14/02, DCH
 SET P.K./WASHER
 6/13/02, DCH
 FD R.R.SPIKE
 6" DOWN
 REFC24
 6/9/16, JFO
 SET MAG/WASHER
 NEWREFC24
 11/21/16, JFO

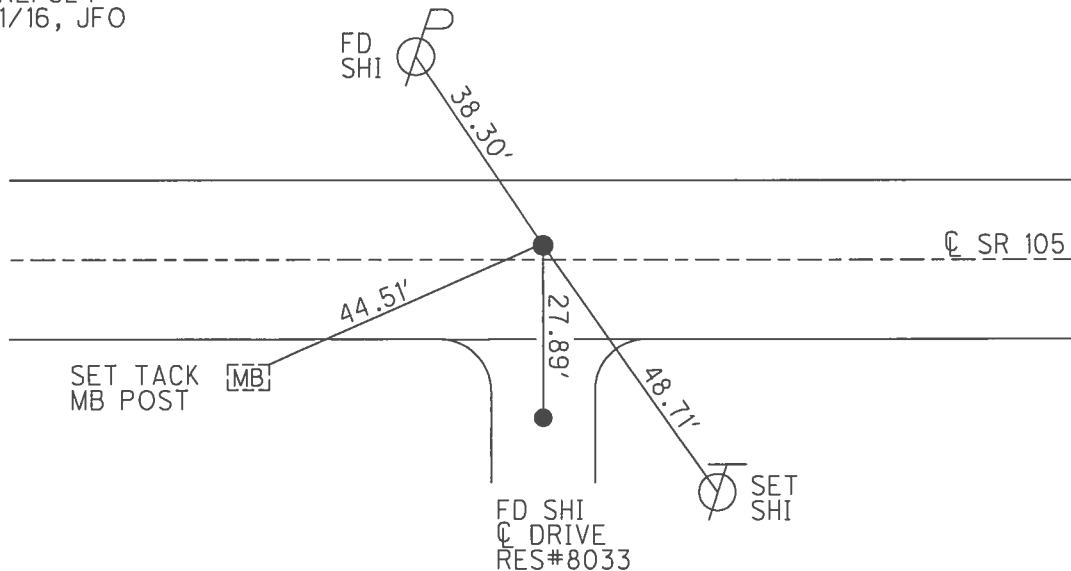

O.D.O.T. DISTRICT 2 SURVEY OFFICE (USE ONLY)


PERSONNEL	REFERENCE NO. <u>25</u>	SHEET <u>23</u> OF <u>54</u>
NOTES	O'DONNELL	DATE <u>6/9/16</u>
H.C.	O'DONNELL	ROUTE <u>SR 105</u>
R.C.	TODD	COUNTY <u>WOOD</u>
		TOWNSHIP <u>WEBSTER</u>
		SECTION <u>14</u>
		T <u>5</u> N R <u>11</u> E

TYPE MONUMENT MAG/WASHER
 ON SURFACE - ~~BELOW~~ ON
 LEFT - ℄ PAV'T - ~~RIGHT~~ 6.9'
17' TO RT EDGE PAVEMENT
 S.L.M. 216+30

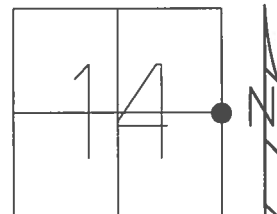

GRID: NORTHING: 630381.344 EASTING: 1679809.623


RECORD: P.I.
 STA. 217+35.19
 $\Delta = 1^{\circ}-09'-20''$ LT.
 QUARTER CORNER
 FOR SEC. 14 & 13
 FD P.K./WASHER
 4/6/02, DCH
 SET P.K./WASHER
 6/13/02, DCH
 FD P.K./WASHER
 REF25
 6/9/16, JFO
 SET 1" MAG/WASHER
 10/13/17, JFO

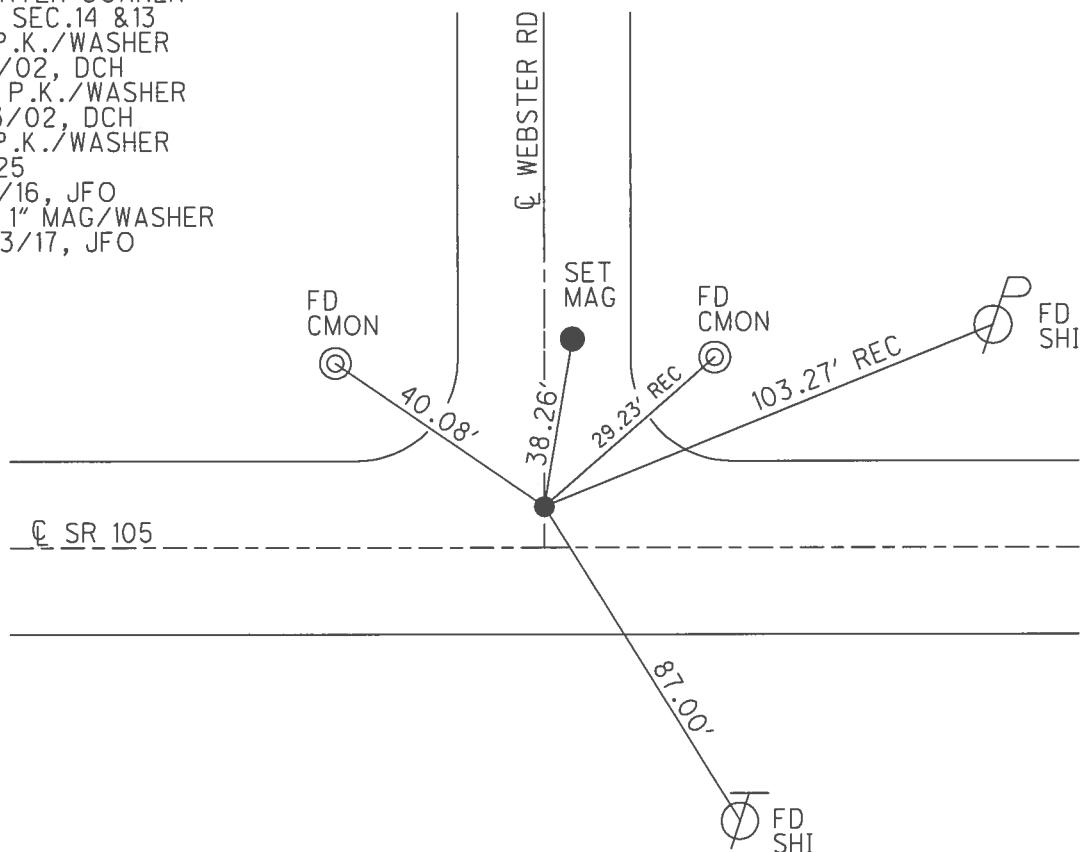

O.D.O.T. DISTRICT 2 SURVEY OFFICE (USE ONLY)


PERSONNEL	REFERENCE NO. <u>26</u>	SHEET <u>24</u> OF <u>54</u>
NOTES	DATE <u>8/26/91</u>	ROUTE <u>SR 105</u>
H.C. <u>VAN DUSEN</u>	WEATHER <u>SUNNY</u>	COUNTY <u>WOOD</u>
R.C. <u>BARNHISEL</u>	TEMP. <u>85°</u>	TOWNSHIP <u>WEBSTER</u>
		SECTION <u>13</u>
		T <u>5</u> N R <u>11</u> E

TYPE MONUMENT 3/4" IPIN
~~ON SURFACE~~ - BELOW 5"
~~LEFT~~ - CL PAV'T - RIGHT 6.2'
5.4' TO S EDGE PAVEMENT
 S.L.M. 217+58

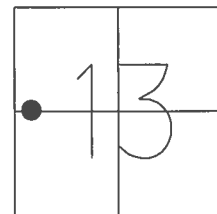

GRID: NORTHING: _____ EASTING: _____


RECORD: P.I.
 STA. 218+67.27
 $\Delta = 31^{\circ}-42'-20''$ LT
 SET 3/4" IPIN, 4" DOWN
 FR/1973 NOTES
 BY I.STONE
 5/27/82, SWH
 D.N.F.
 6/9/16, JFO

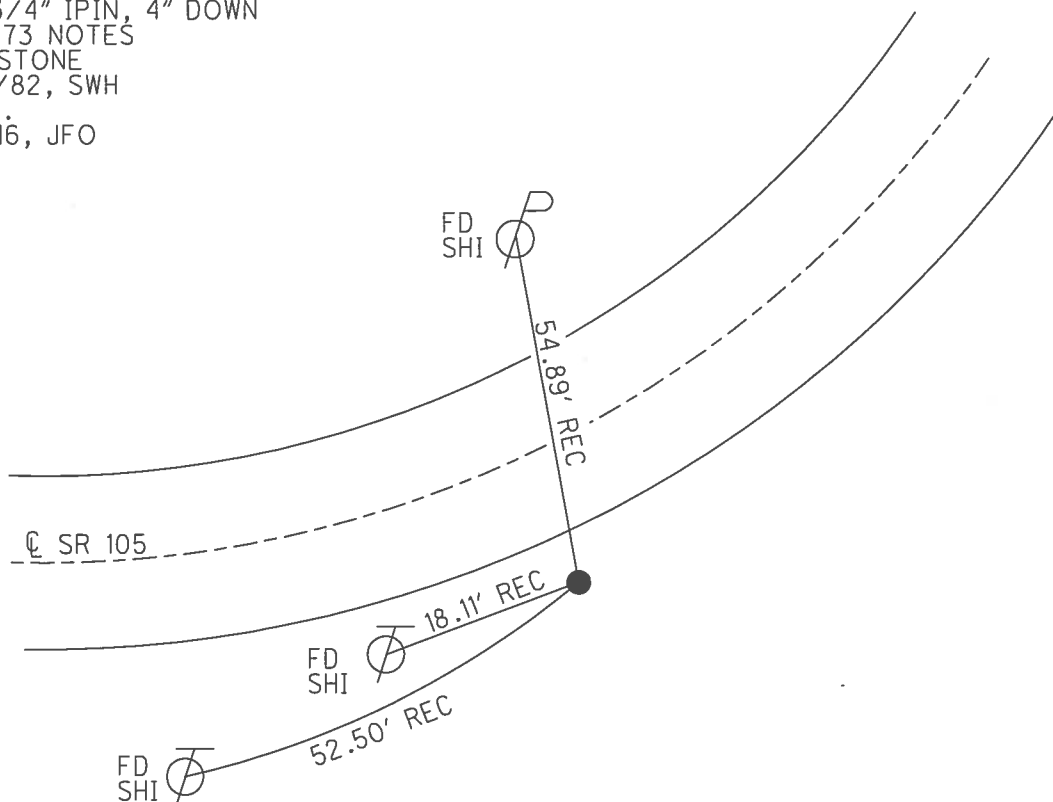

O.D.O.T. DISTRICT 2 SURVEY OFFICE (USE ONLY)


PERSONNEL	REFERENCE NO. <u>27</u>	SHEET <u>25</u> OF <u>54</u>
NOTES	DATE <u>9/12/16</u>	ROUTE <u>SR 105</u>
H.C. <u>RHOADES</u>	WEATHER <u>SUNNY</u>	COUNTY <u>WOOD</u>
R.C. <u>O'DONNELL</u>	TEMP. <u>75°</u>	TOWNSHIP <u>WEBSTER</u>
		SECTION <u>13</u>
		T <u>5</u> N R <u>11</u> E

TYPE MONUMENT P.K./WASHER
 ON SURFACE - ~~BELOW~~ ON
~~LEFT~~ - CL PAV'T - RIGHT 5.5'
5' TO S EDGE PAVEMENT
 S.L.M. 222+59

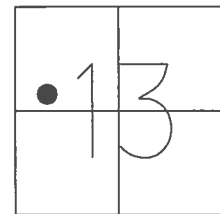

GRID: NORTHING: 630642.415 EASTING: 1680369.826


RECORD: P.I.
 STA. 223+69.18
 $\Delta = 7^\circ - 11' \text{ LT}$
 FD P.K./WASHER
 4/16/02, DCH
 SET P.K./WASHER
 6/13/02, DCH
 SET MAG/WASHER
 REF27
 6/9/16, JFO
 SET 1" MAG/WASHER
 10/13/17, JFO

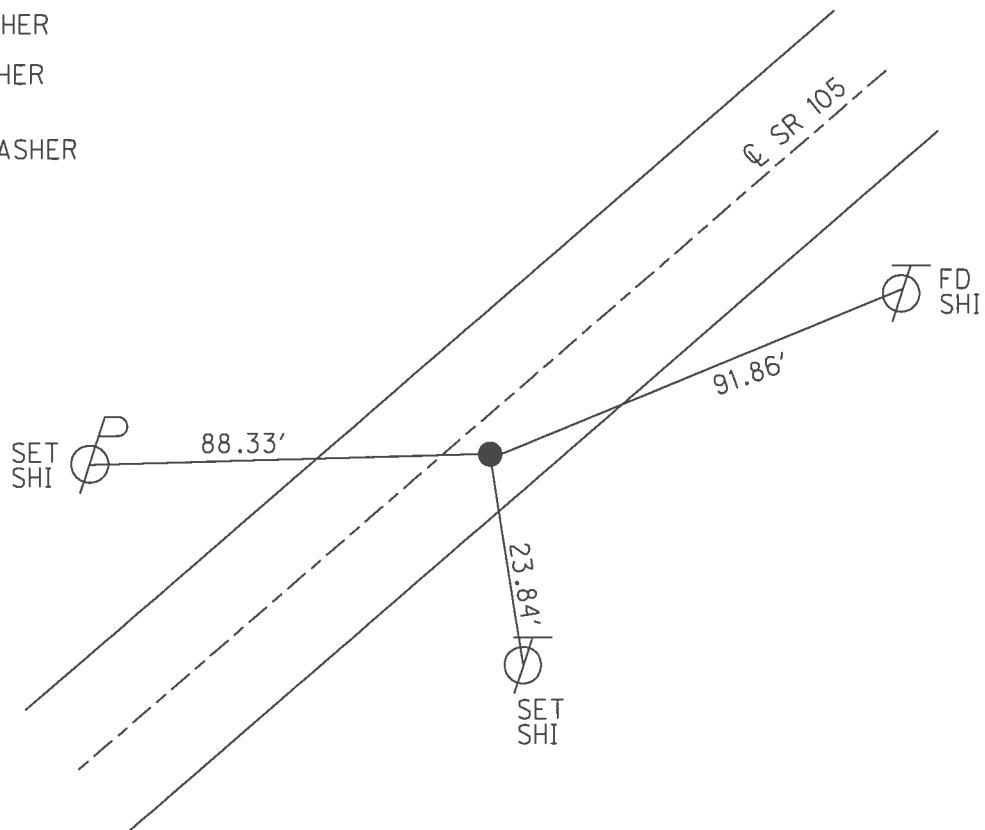

O.D.O.T. DISTRICT 2 SURVEY OFFICE (USE ONLY)


PERSONNEL	REFERENCE NO. <u>28</u>	SHEET <u>26</u> OF <u>54</u>
NOTES	DATE <u>9/12/16</u>	ROUTE <u>SR 105</u>
H.C. <u>RHOADES</u>	WEATHER <u>SUNNY</u>	COUNTY <u>WOOD</u>
R.C. <u>O'DONNELL</u>	TEMP. <u>76°</u>	TOWNSHIP <u>WEBSTER</u>
		SECTION <u>13</u>
		T <u>5</u> N R <u>11</u> E

TYPE MONUMENT P.K./WASHER
 ON SURFACE - ~~BELOW~~ ON
 LEFT - C PAV'T - ~~RIGHT~~ 0.5'
11.1' TO RT EDGE PAVEMENT
 S.L.M. 229+14

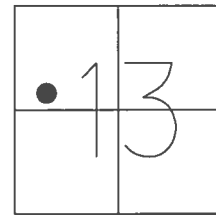

GRID: NORTHING: 631051.879 EASTING: 1680882.183

RECORD: P.O.T.
 STA. 230+25.13
 $\Delta = 0^{\circ}-00'-00''$
 PER 1949 PLAN
 SET R.R.SPIKE 1973
 FD P.K./WASHER
 4/16/02, DCH
 SET P.K./WASHER
 6/13/02, DCH
 FD P.K./WASHER
 REF28
 6/9/16, JFO
 SET 1" MAG/WASHER
 10/13/17, JFO

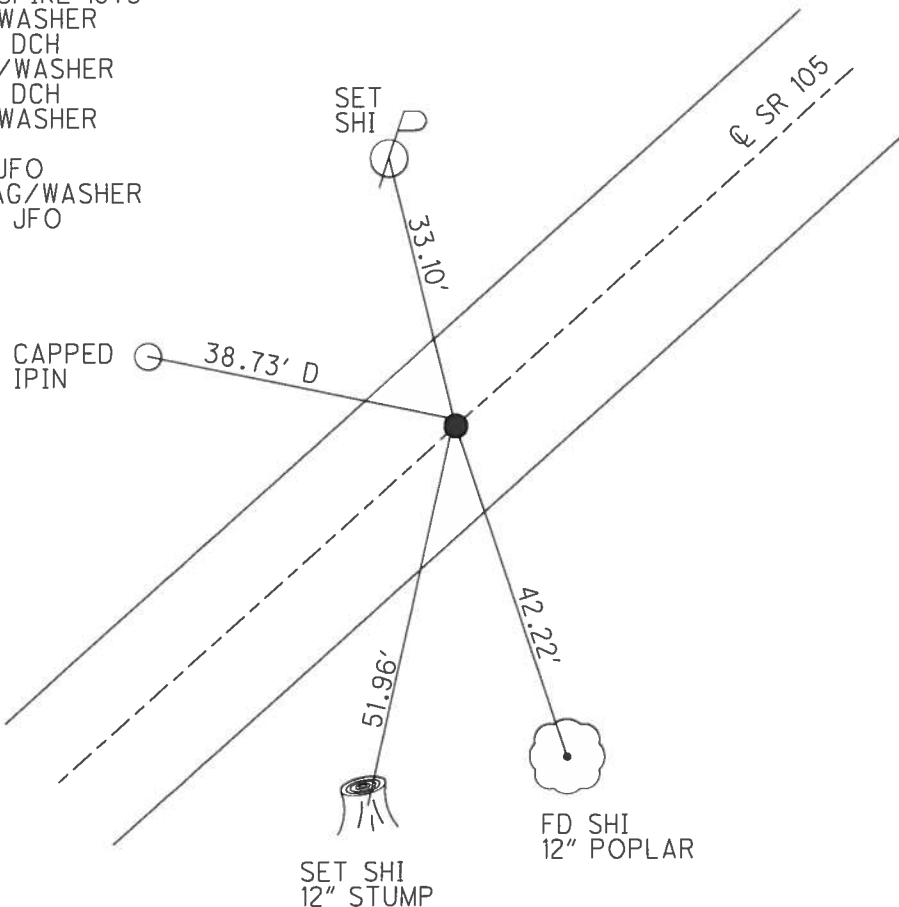


O.D.O.T. DISTRICT 2 SURVEY OFFICE (USE ONLY)


PERSONNEL _____ REFERENCE NO. 29 SHEET 27 OF 54
 NOTES RHOADES DATE 9/13/16 ROUTE SR 105
 H.C. O'DONNELL WEATHER FAIR COUNTY WOOD
 R.C. TODD TEMP. 58° TOWNSHIP WEBSTER
 SECTION 13
 T 5 N R 11 E

TYPE MONUMENT P.K./WASHER
 ON SURFACE - ~~BELOW~~ ON
 LEFT - ℄ PAV'T - ~~RIGHT~~ 9.5'
0.6' TO LT EDGE PAVEMENT
 S.L.M. 235+36

GRID: NORTHING: 631440.098 EASTING: 1681368.026

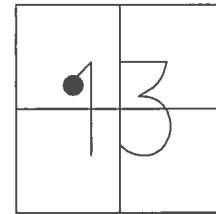


RECORD: P.I.
 STA. 236+47.24
 $\Delta = 16^\circ-30'-00''$ RT
 FD P.K./WASHER
 4/16/02, DCH
 SET P.K./WASHER
 5/28/02, DCH
 FD P.K./WASHER
 REF29
 6/9/16, JFO
 SET 1" MAG/WASHER
 10/13/17, JFO

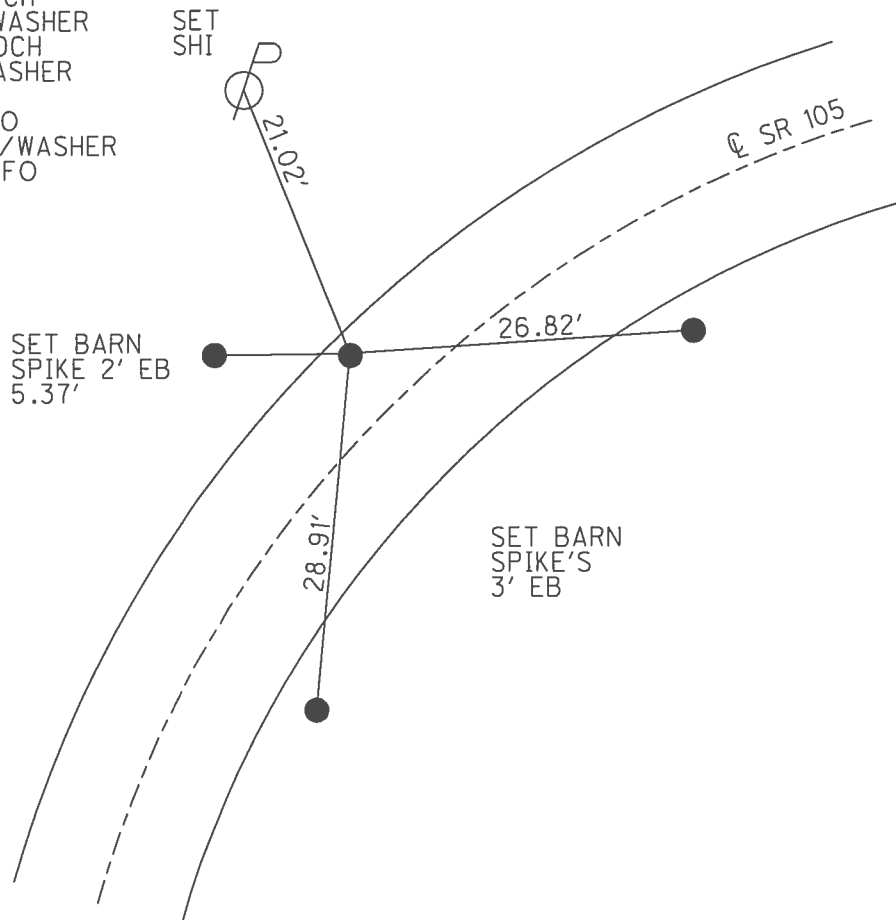

O.D.O.T. DISTRICT 2 SURVEY OFFICE (USE ONLY)


PERSONNEL	REFERENCE NO. <u>30</u>	SHEET <u>28</u> OF <u>54</u>
NOTES	DATE <u>10/13/17</u>	ROUTE <u>SR 105</u>
H.C. <u>RHOADES</u>	WEATHER <u>HAZE</u>	COUNTY <u>WOOD</u>
R.C. <u>O'DONNELL</u>	TEMP. <u>59°</u>	TOWNSHIP <u>WEBSTER</u>
		SECTION <u>13</u>
		T <u>5</u> N R <u>11</u> E

TYPE MONUMENT 1" MAG/WASHER
 ON SURFACE - ~~BELOW~~ ON
~~LEFT~~ - C PAV'T - RIGHT 3.7'
6.5' TO RT EDGE PAVEMENT
 S.L.M. 239+36

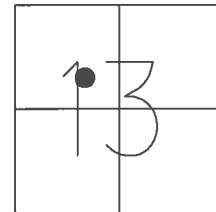

GRID: NORTHING: 631591.178 EASTING: 1681739.647


RECORD: P.I.
 STA. 240+48.41
 $\Delta = 3^{\circ}-45'-00''$ LT
 FD P.K./WASHER
 4/16/02,
 SET P.K./WASHER
 5/31/02, DCH
 SET MAG/WASHER
 REF 30
 6/9/16, JFO
 SET 1" MAG/WASHER
 10/13/17, JFO

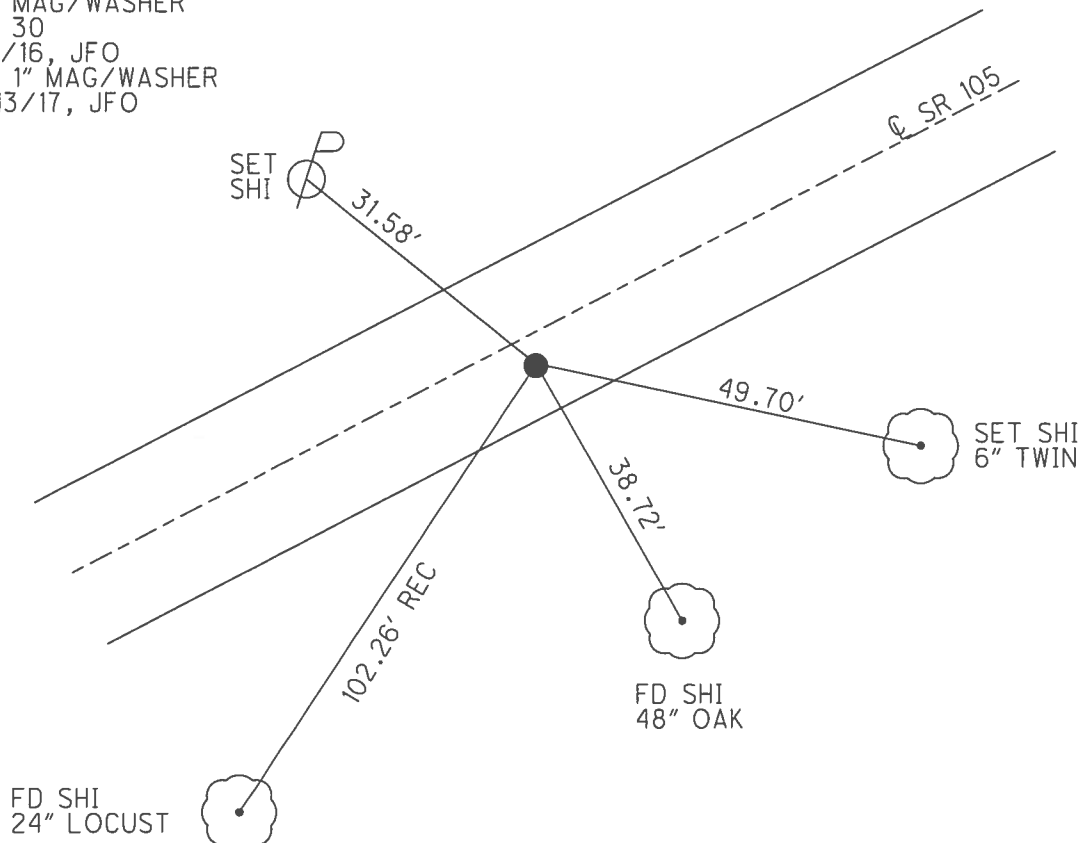

O.D.O.T. DISTRICT 2 SURVEY OFFICE (USE ONLY)


PERSONNEL	REFERENCE NO. <u>31</u>	SHEET <u>29</u> OF <u>54</u>
NOTES	DATE <u>9/13/16</u>	ROUTE <u>SR 105</u>
H.C. <u>RHOADES</u>	WEATHER <u>FAIR</u>	COUNTY <u>WOOD</u>
R.C. <u>O'DONNELL</u>	TEMP. <u>58°</u>	TOWNSHIP <u>WEBSTER</u>
		SECTION <u>13</u>
		T <u>5</u> N R <u>11</u> E

TYPE MONUMENT P.K./WASHER
 ON SURFACE - ~~BELOW~~ ON
~~LEFT~~ - Q PAV'T - RIGHT 2.5'
8.2' TO RT EDGE PAVEMENT
 S.L.M. 242+04

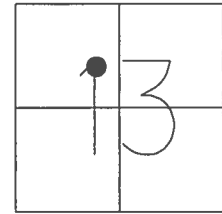

GRID: NORTHING: 631708.323 EASTING: 1681981.136


RECORD: P.I.
 STA. 243+16.87
 $\Delta = 6^\circ - 10' - 00''$ LT
 FD P.K./WASHER
 4/16/02, DCH
 SET P.K./WASHER
 5/31/02, DCH
 FD P.K./WASHER
 REF31
 6/9/16, JFO
 SET 1" MAG/WASHER
 10/13/17, JFO

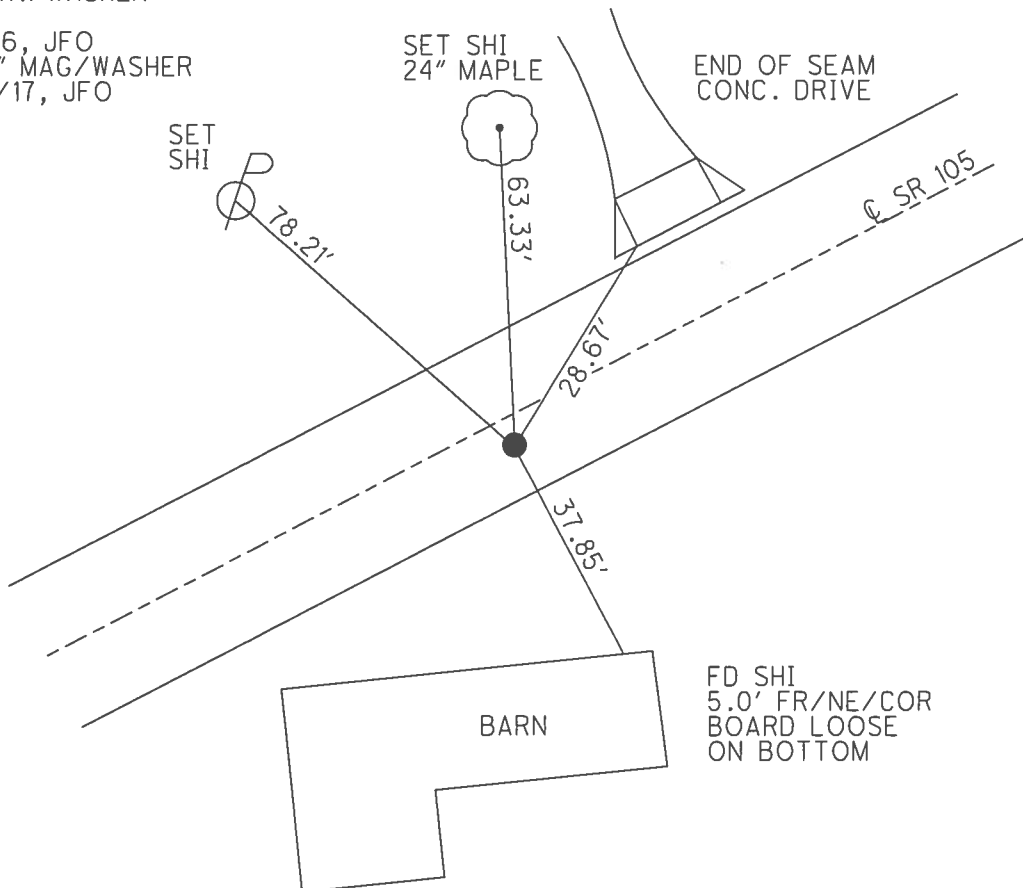

O.D.O.T. DISTRICT 2 SURVEY OFFICE (USE ONLY)


PERSONNEL	REFERENCE NO. <u>32</u>	SHEET <u>30</u> OF <u>54</u>	
NOTES	RHOADES	DATE <u>9/13/16</u>	ROUTE <u>SR 105</u>
H.C.	O'DONNELL	WEATHER <u>FAIR</u>	COUNTY <u>WOOD</u>
R.C.	TODD	TEMP. <u>58°</u>	TOWNSHIP <u>WEBSTER</u>
			SECTION <u>13</u>
			T <u>5</u> N R <u>11</u> E

TYPE MONUMENT P.K./WASHER
 ON SURFACE - ~~BELOW~~ ON
 LEFT - ℄ PAV'T - ~~RIGHT~~ 9.6"
1.3' TO LT EDGE PAVEMENT
 S.L.M. 244+50

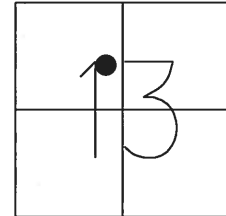

GRID: NORTHING: 631839.047 EASTING: 1682189.740


RECORD: P.I.
 STA. 245+63.14
 $\Delta = 27^{\circ}-06'-20''$ RT
 FD P.K./WASHER
 4/16/02, DCH
 SET P.K./WASHER
 5/31/02, DCH
 FD P.K./WASHER
 REFA32
 6/9/16, JFO
 SET 1" MAG/WASHER
 10/13/17, JFO

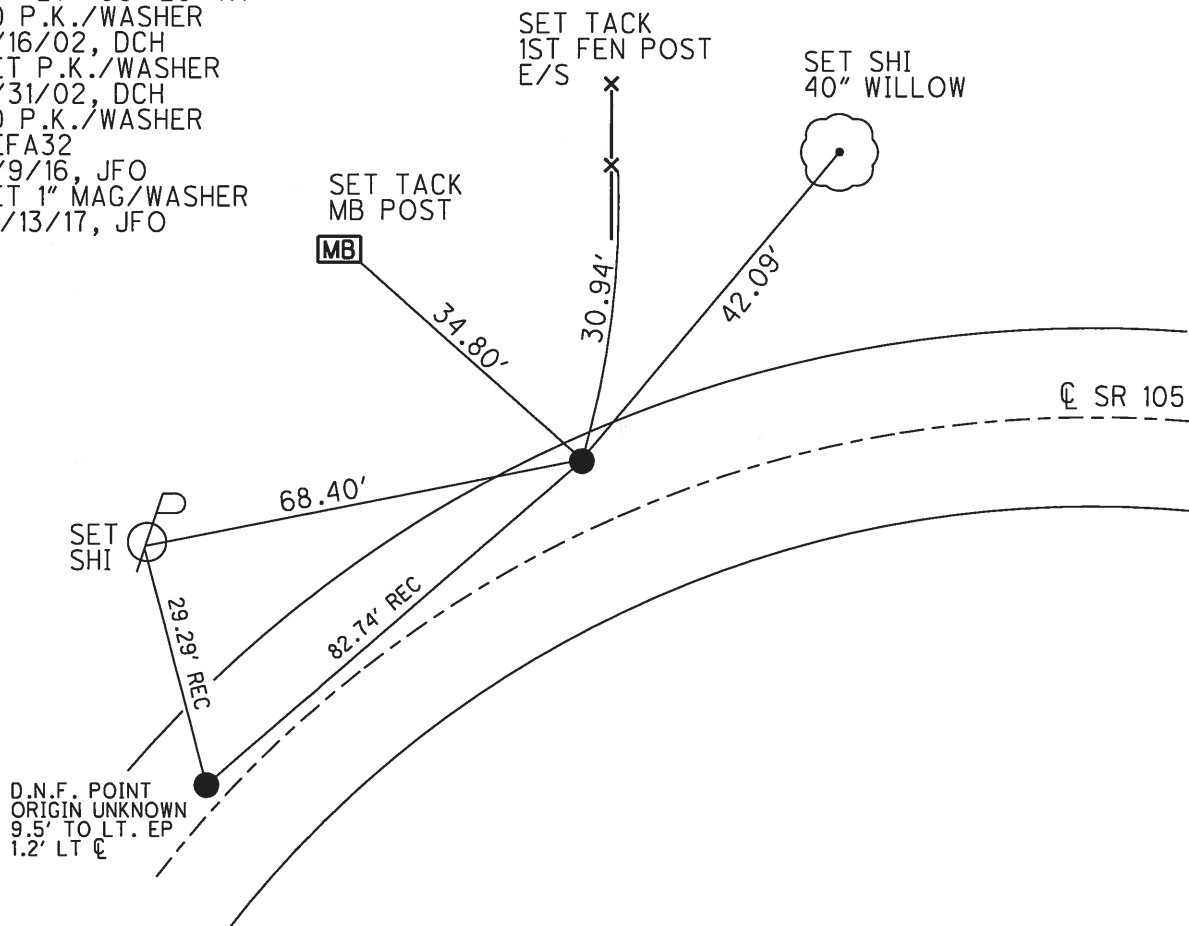


O.D.O.T. DISTRICT 2 SURVEY OFFICE (USE ONLY)

PERSONNEL	REFERENCE NO. <u>33</u>	SHEET <u>31</u> OF <u>54</u>
NOTES	DATE <u>10/13/17</u>	ROUTE <u>SR 105</u>
H.C. <u>RHOADES</u>	WEATHER <u>HAZE</u>	COUNTY <u>WOOD</u>
R.C. <u>O'DONNELL</u>	TEMP. <u>59°</u>	TOWNSHIP <u>WEBSTER</u>
		SECTION <u>13</u>
		T <u>5</u> N R <u>11</u> E

TYPE MONUMENT 1" MAG/WASHER
 ON SURFACE - ~~BELOW~~ ON
 LEFT - CL PAV'T - ~~RIGHT~~ 9'
2' TO LT EDGE PAVEMENT
 S.L.M. 247+33

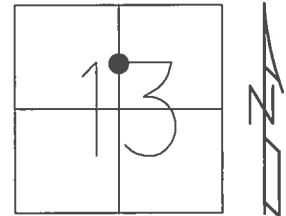

GRID: NORTHING: 631863.500 EASTING: 1682474.220

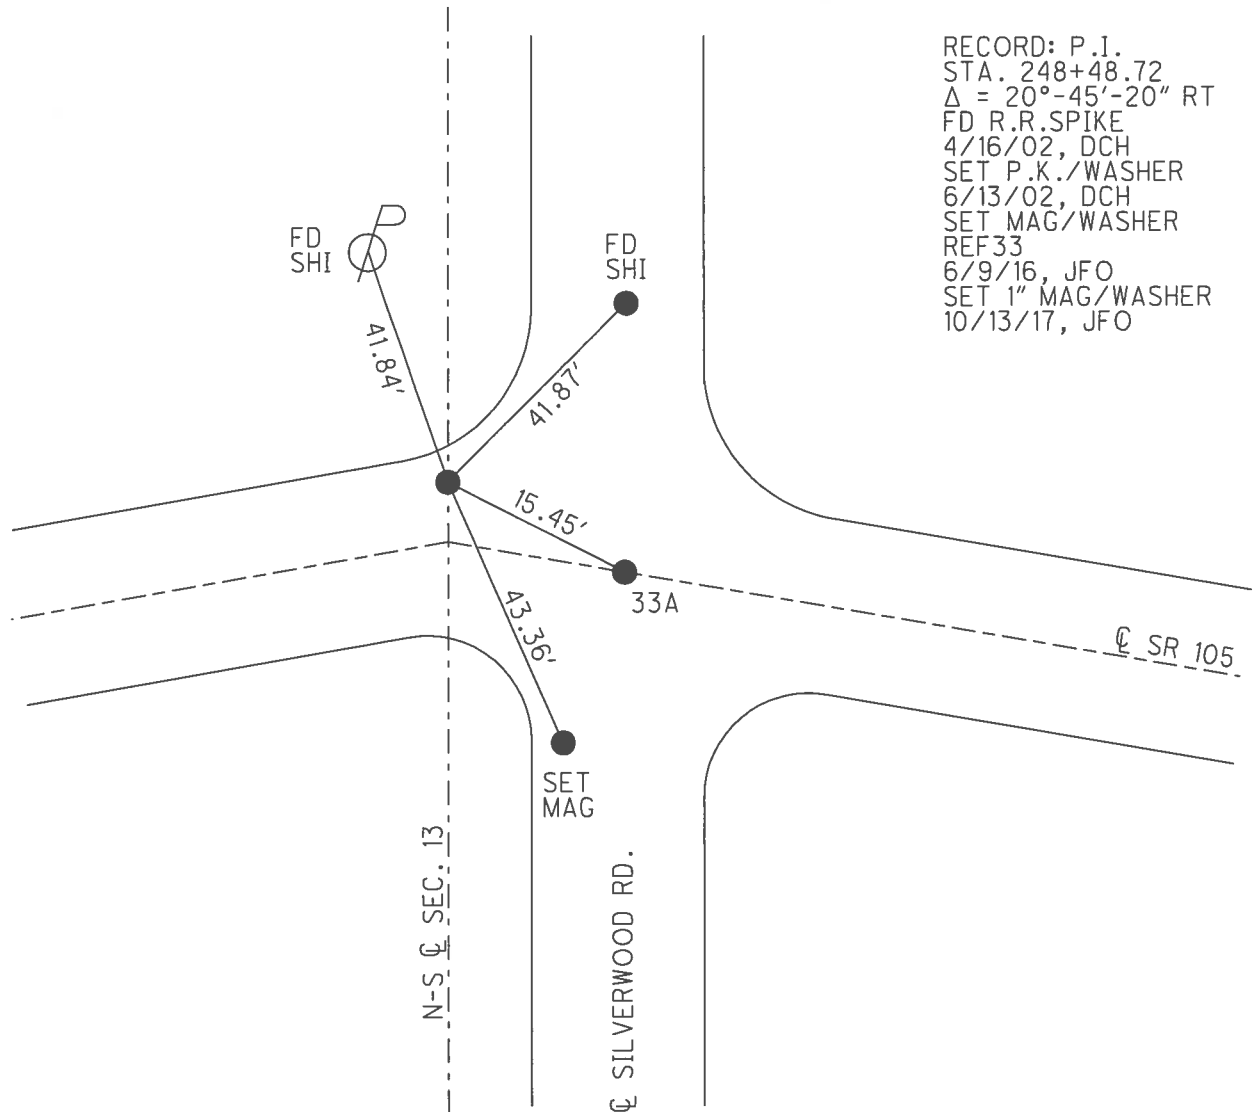

O.D.O.T. DISTRICT 2 SURVEY OFFICE (USE ONLY)

PERSONNEL

REFERENCE NO.

33 A SHEET 32 OF 54

NOTES RHOADESDATE 10/13/17ROUTE SR 105

H.C. O'DONNELL

WEATHER HAZE

COUNTY WOOD

R.C. FARKAS

TEMP. 59°

TOWNSHIP WEBSTER

SECTION 13

T 5 N R 11 E

TYPE MONUMENT 1" MAG/WASHER



ON SURFACE - ~~BELOW~~ _____ ON

LEFT - C PAV'T - ~~RIGHT~~ 4.5'

____TO____ EDGE PAVEMENT

S.L.M. 247+48

GRID: NORTHING: 631857.190 EASTING: 1682488.342

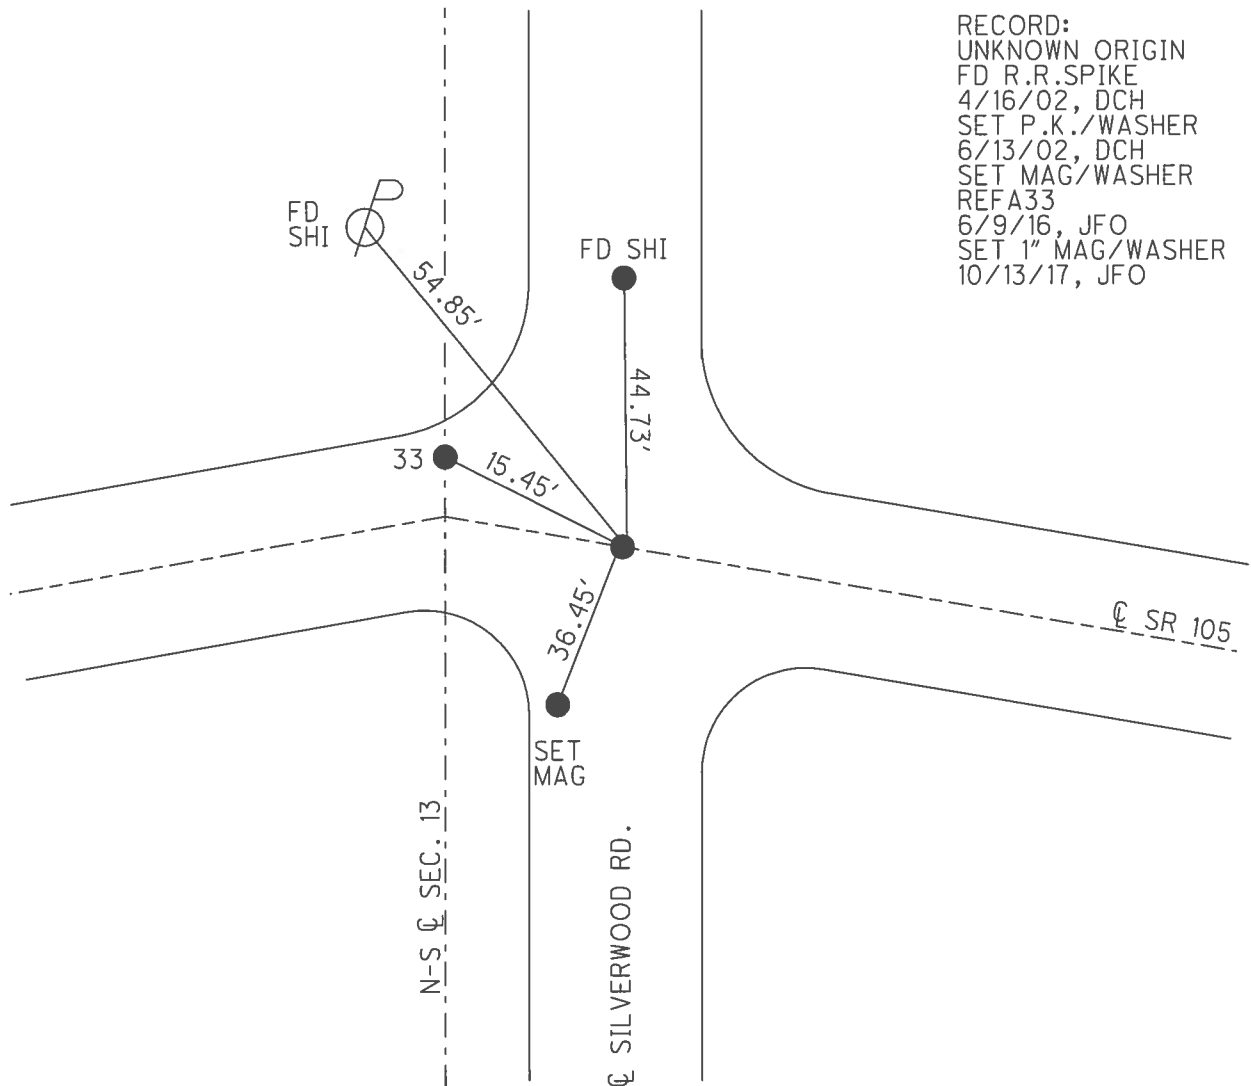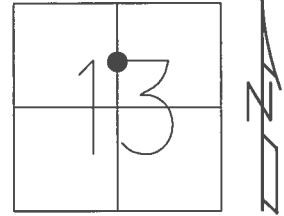

RECORD:
UNKNOWN ORIGIN
FD R.R.SPIKE
4/16/02, DCH
SET P.K./WASHER
6/13/02, DCH
SET MAG/WASHER
REFA33
6/9/16, JFO
SET 1" MAG/WASHER
10/13/17, JFO

O.D.O.T. DISTRICT 2 SURVEY OFFICE (USE ONLY)

PERSONNEL

REFERENCE NO. 34

SHEET 33 OF 54


NOTES RHOADES
H.C. O'DONNELL
R.C. FARKAS

DATE 10/17/17
WEATHER FAIR
TEMP. 65°

ROUTE SR 105
COUNTY WOOD
TOWNSHIP WEBSTER
SECTION 13


T 5 N R 11 E

TYPE MONUMENT 1' MAG/WASHER
ON SURFACE - ~~BELOW~~ ON
~~LEFT~~ - C PAV'T - RIGHT 3.5'
3.5' TO S EDGE PAVEMENT
S.L.M. 249+45

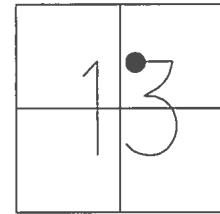

GRID: NORTHING: 631805.487 EASTING: 1682679.045


RECORD: P.I.
STA. 250+61.50
 $\Delta = 12^\circ-51'-20''$ LT
FD P.K./WASHER
4/14/02, DCH
SET P.K./WASHER
5/31/02, DCH
FD MAG/WASHER
REF34
6/9/16, JFO
SET 1" MAG/WASHER
10/17/17, JFO

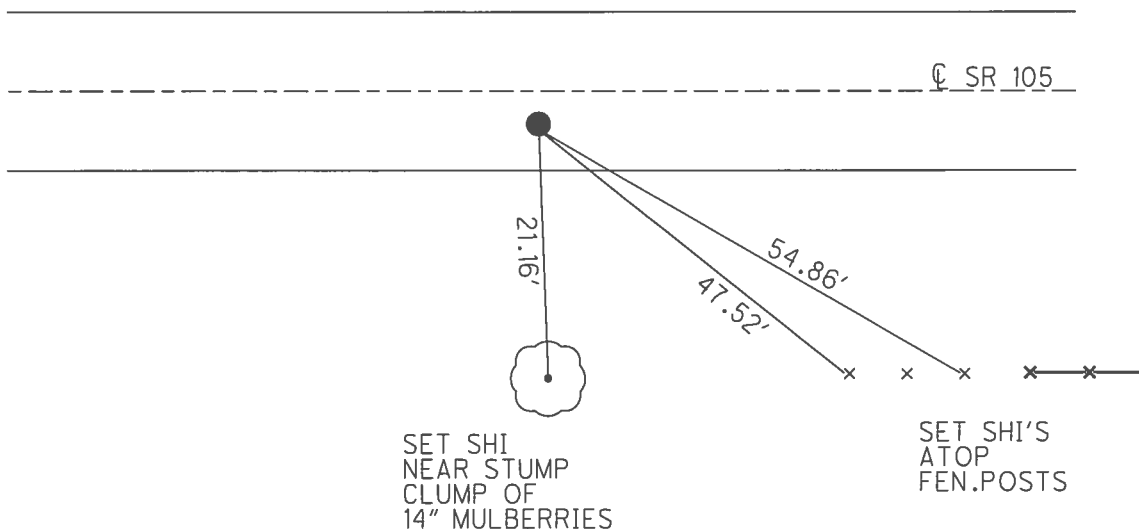

O.D.O.T. DISTRICT 2 SURVEY OFFICE (USE ONLY)


PERSONNEL	REFERENCE NO. <u>35</u>	SHEET <u>34</u> OF <u>54</u>
NOTES	DATE <u>10/17/17</u>	ROUTE <u>SR 105</u>
H.C. <u>RHOADES</u>	WEATHER <u>FAIR</u>	COUNTY <u>WOOD</u>
R.C. <u>O'DONNELL</u>	TEMP. <u>65°</u>	TOWNSHIP <u>WEBSTER</u>
		SECTION <u>13</u>
		T <u>5</u> N R <u>11</u> E

TYPE MONUMENT 1" MAG/WASHER
 ON SURFACE - ~~BELOW~~ ON
~~LEFT~~ - CL PAV'T - RIGHT 1.9'
8.6' TO S EDGE PAVEMENT
 S.L.M. 252+53

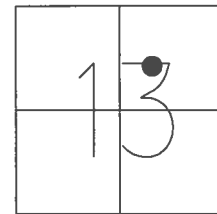

GRID: NORTHING: 631789.494 EASTING: 1682985.819

RECORD: P.I.
 STA. 253+68.69
 $\Delta = 3^\circ-10'-20''$ LT
 FD P.K./WASHER
 4/15/02, DCH
 SET P.K./WASHER
 6/13/02, DCH
 FD P.K.SHANK
 SET MAG/WASHER
 REF35
 6/9/16, JFO
 SET 1" MAG/WASHER
 10/17/17, JFO

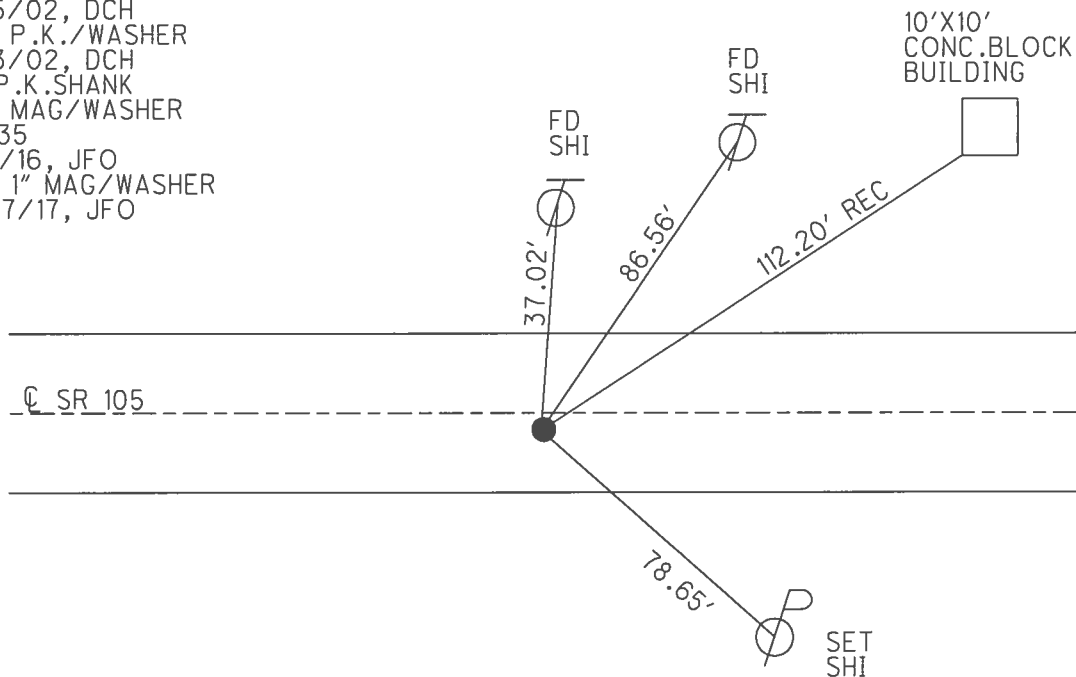


O.D.O.T. DISTRICT 2 SURVEY OFFICE (USE ONLY)

PERSONNEL	REFERENCE NO. <u>35 A</u>	SHEET <u>35</u> OF <u>54</u>
NOTES <u>RHOADES</u>	DATE <u>9/13/16</u>	ROUTE <u>SR 105</u>
H.C. <u>O'DONNELL</u>	WEATHER <u>SUNNY</u>	COUNTY <u>WOOD</u>
R.C. <u>TODD</u>	TEMP. <u>58°</u>	TOWNSHIP <u>WEBSTER</u>
		SECTION <u>13</u>
		T <u>5</u> N R <u>11</u> E


TYPE MONUMENT P.K./WASHER
 ON SURFACE - ~~BELOW~~ ON
~~LEFT~~ - Q PAV'T - RIGHT 11.2'
ON TO S EDGE PAVEMENT
 S.L.M. 255+69

GRID: NORTHING: 631780.034 EASTING: 1683302.154

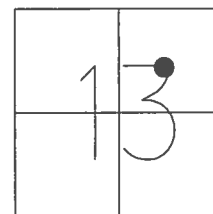

RECORD:
 ORIGIN UNKNOWN
 FD P.K./WASHER
 4/15/02, DCH
 SET P.K./WASHER
 5/28/02, DCH
 FD P.K./WASHER
 REFA35
 6/10/16, JFO
 SET 1" MAG/WASHER
 10/17/17, JFO


STEEL PIPE
 FD NOTCH NEAR/S
 4" PIPE CASTING
 1' UP

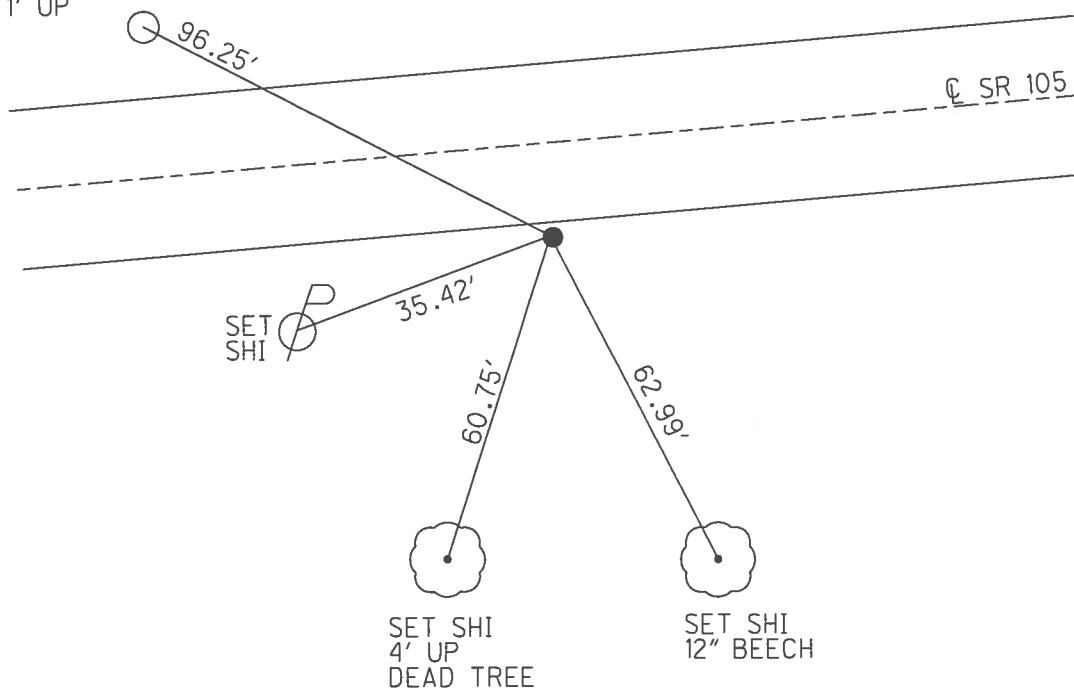

O.D.O.T. DISTRICT 2 SURVEY OFFICE (USE ONLY)


PERSONNEL	REFERENCE NO. <u>36</u>	SHEET <u>36</u> OF <u>54</u>
NOTES	DATE <u>10/17/17</u>	ROUTE <u>SR 105</u>
H.C. <u>RHOADES</u>	WEATHER <u>FAIR</u>	COUNTY <u>WOOD</u>
R.C. <u>O'DONNELL</u>	TEMP. <u>65°</u>	TOWNSHIP <u>WEBSTER</u>
		SECTION <u>13</u>
		T <u>5</u> N R <u>11</u> E

TYPE MONUMENT 1" MAG/WASHER
 ON SURFACE - ~~BELOW~~ ON
~~LEFT~~ - Q PAV'T - RIGHT 6'
4.4' TO S EDGE PAVEMENT
 S.L.M. 257+40

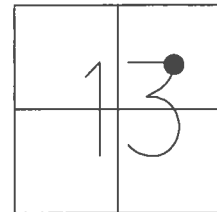

GRID: NORTHING: 631791.292 EASTING: 1683474.259


RECORD: P.I.
 STA. 258+57.05
 $\Delta = 8^{\circ}-30'-20''$ LT
 FD P.K./WASHER
 4/15/02, DCH
 SET P.K./WASHER
 5/31/02, DCH
 SET MAG/WASHER
 REF36
 6/10/16, JFO
 SET 1" MAG/WASHER
 10/17/17, JFO

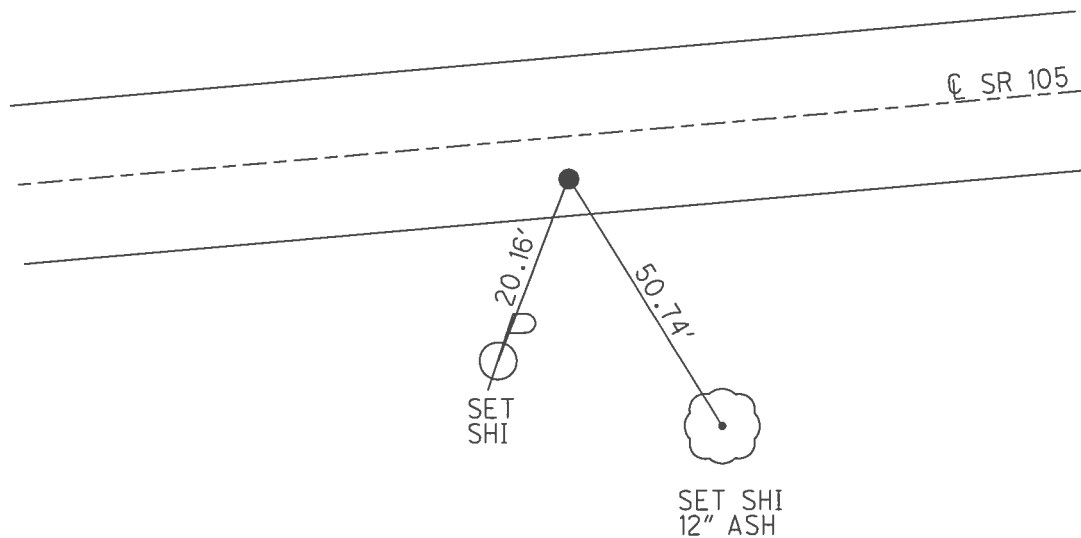

O.D.O.T. DISTRICT 2 SURVEY OFFICE (USE ONLY)

PERSONNEL	REFERENCE NO. <u>37</u>	SHEET <u>37</u> OF <u>54</u>
NOTES	DATE <u>10/17/17</u>	ROUTE <u>SR 105</u>
H.C. <u>RHOADES</u>	WEATHER <u>FAIR</u>	COUNTY <u>WOOD</u>
R.C. <u>O'DONNELL</u>	TEMP. <u>65°</u>	TOWNSHIP <u>WEBSTER</u>
		SECTION <u>13</u>
		T <u>5</u> N R <u>11</u> E


TYPE MONUMENT 1" MAG/WASHER
 ON SURFACE - ~~BELOW~~ ON
~~LEFT~~ - CL PAV'T - RIGHT 9'
1.2' TO RT EDGE PAVEMENT
 S.L.M. 266+15

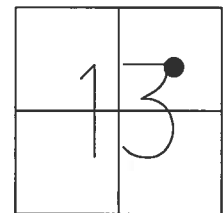

GRID: NORTHING: 631923.403 EASTING: 1684338.324

RECORD: P.I.
 STA. 267+31.16
 $\Delta = 12^\circ-30'-00''$ LT
 FD P.K./WASHER
 4/15/02, DCH
 SET P.K./WASHER
 5/28/02, DCH
 FD P.K./WASHER
 REF37
 6/10/16, JFO
 SET 1" MAG/WASHER
 NEWREF37
 10/17/17, JFO


BOTTOM BOLT
 ADDRESS SIGN
 ON MB "7065"

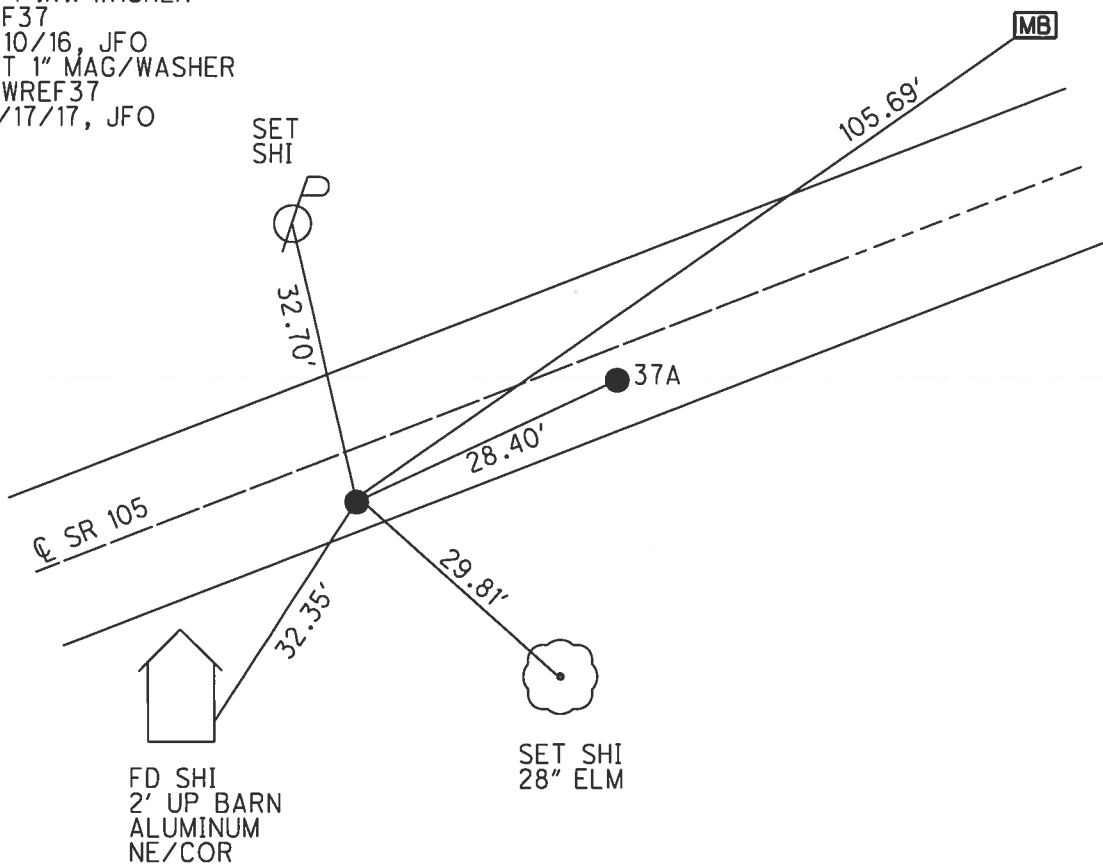

O.D.O.T. DISTRICT 2 SURVEY OFFICE (USE ONLY)

PERSONNEL	REFERENCE NO. <u>37 A</u>	SHEET <u>38</u> OF <u>54</u>	
NOTES	RHOADES	DATE <u>10/17/17</u>	ROUTE <u>SR 105</u>
H.C.	O'DONNELL	WEATHER <u>FAIR</u>	COUNTY <u>WOOD</u>
R.C.	FARKAS	TEMP. <u>65°</u>	TOWNSHIP <u>WEBSTER</u>
			SECTION <u>13</u>
			T <u>5</u> N R <u>11</u> E


TYPE MONUMENT 1" MAG/WASHER
 ON SURFACE - ~~BELOW~~ ON
~~LEFT~~ - Q PAV'T - RIGHT 5.8'
4.8' TO RT EDGE PAVEMENT
 S.L.M. 266+44

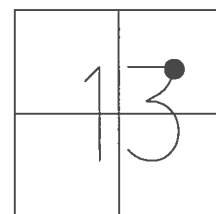

GRID: NORTHING: 631933.772 EASTING: 1684364.737

RECORD:
 ORIGIN UNKNOWN
 FD P.K./WASHER
 4/15/02, DCH
 SET P.K./WASHER
 5/28/02, DCH
 FD P.K.NAIL
 REFA37
 6/10/16, JFO
 SET 1" MAG/WASHER
 NEWREFA37
 10/17/17, JFO


BOTTOM BOLT
 ADDRESS SIGN
 ON MB "7065"

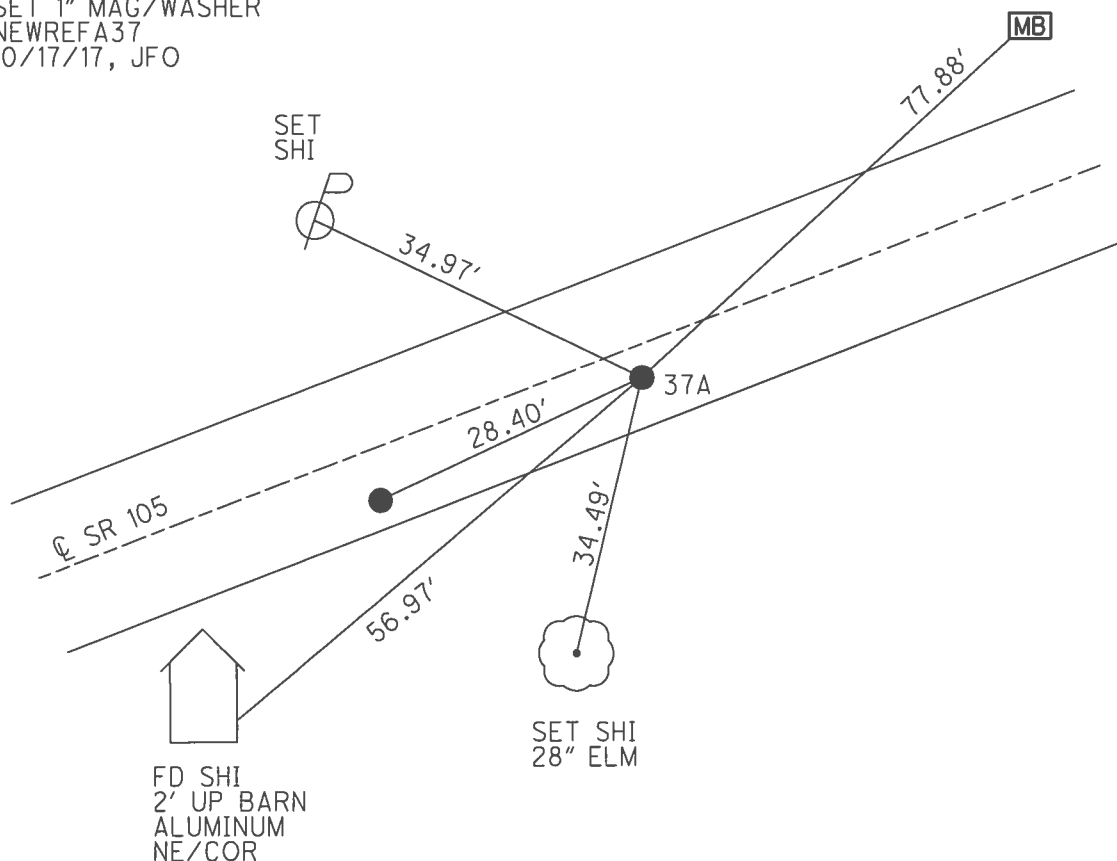

O.D.O.T. DISTRICT 2 SURVEY OFFICE (USE ONLY)


PERSONNEL _____ REFERENCE NO. 38 SHEET 39 OF 54
 NOTES LONG DATE 8/27/91 ROUTE SR 105
 H.C. VAN DUSEN WEATHER SUNNY COUNTY WOOD
 R.C. BARNHISEL TEMP. 85° TOWNSHIP WEBSTER
 _____ SECTION 13
 _____ T 5 N R 11 E

TYPE MONUMENT 1/2" IPIN
 ON SURFACE - ~~BELOW~~ 6"
~~LEFT~~ - Q PAV'T - RIGHT 15.6'
5' TO S EDGE PAVEMENT
 S.L.M. 271+68

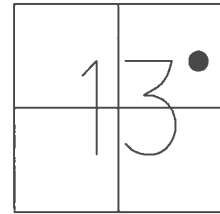

GRID: NORTHING: 632122.237 EASTING: 1684850.577


RECORD: P.I.
 STA. 272+86.73
 $\Delta = 18^\circ-17'-00''$ LT
 FD 1/2" IPIN
 2" DOWN
 REF38
 9/13/16, JFO

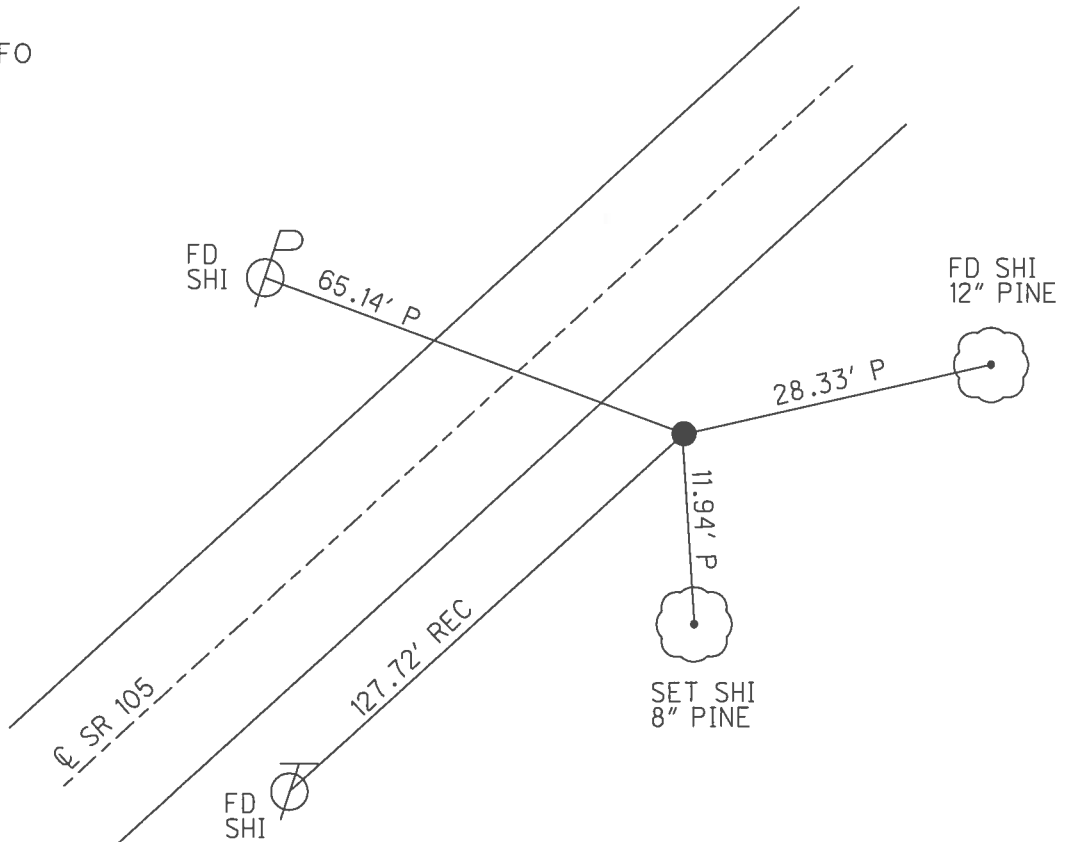

O.D.O.T. DISTRICT 2 SURVEY OFFICE (USE ONLY)


PERSONNEL _____ REFERENCE NO. 39 SHEET 40 OF 54
 NOTES RHOADES DATE 9/13/16 ROUTE SR 105
 H.C. O'DONNELL WEATHER FAIR COUNTY WOOD
 R.C. TODD TEMP. 58° TOWNSHIP WEBSTER
 SECTION 13
 T 5 N R 11 E

TYPE MONUMENT P.K.NAIL
 ON SURFACE - ~~BELOW~~ ON
~~LEFT~~ - CL PAV'T - RIGHT 2'
8.5' TO RT EDGE PAVEMENT
 S.L.M. 274+02

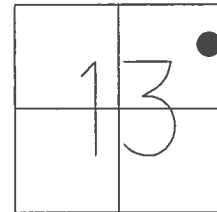

GRID: NORTHING: 632274.062 EASTING: 1685037.757


RECORD:
 ORIGIN UNKNOWN
 FD P.K.NAIL
 SET P.K./WASHER
 6/13/02, DCH
 SET MAG/WASHER
 REFB39
 6/10/16, JFO
 SET 1" MAG/WASHER
 10/17/17, JFO

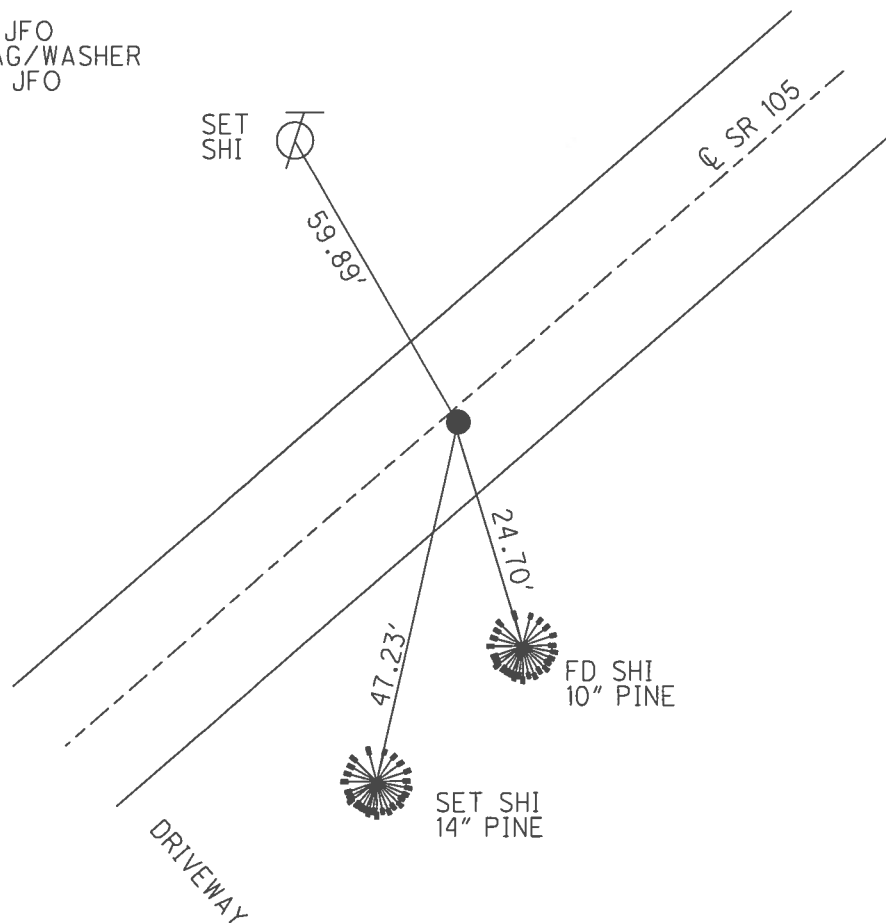

O.D.O.T. DISTRICT 2 SURVEY OFFICE (USE ONLY)


PERSONNEL	REFERENCE NO. <u>39 A</u>	SHEET <u>41</u> OF <u>54</u>
NOTES	DATE <u>9/13/16</u>	ROUTE <u>SR 105</u>
H.C. <u>O'DONNELL</u>	WEATHER <u>FAIR</u>	COUNTY <u>WOOD</u>
R.C. <u>TODD</u>	TEMP. <u>58°</u>	TOWNSHIP <u>WEBSTER</u>
		SECTION <u>13</u>
		T <u>5</u> N R <u>11</u> E

TYPE MONUMENT P.K.NAIL
 ON SURFACE - ~~BELOW~~ ON
~~LEFT~~ - CL PAV'T - RIGHT 1.1'
9' TO RT EDGE PAVEMENT
 S.L.M. 275+37

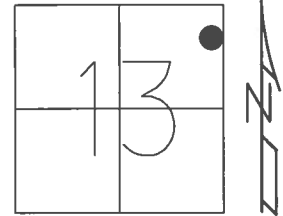

GRID: NORTHING: 632359.733 EASTING: 1685141.750


RECORD: P.O.T.
 STA. 276+56.63
 FD P.K./WASHER
 4/15/02, DCH
 SET P.K./WASHER
 6/13/02, DCH
 FD P.K.NAIL
 REF39
 6/10/16, JFO
 SET 1" MAG/WASHER
 10/17/17, JFO

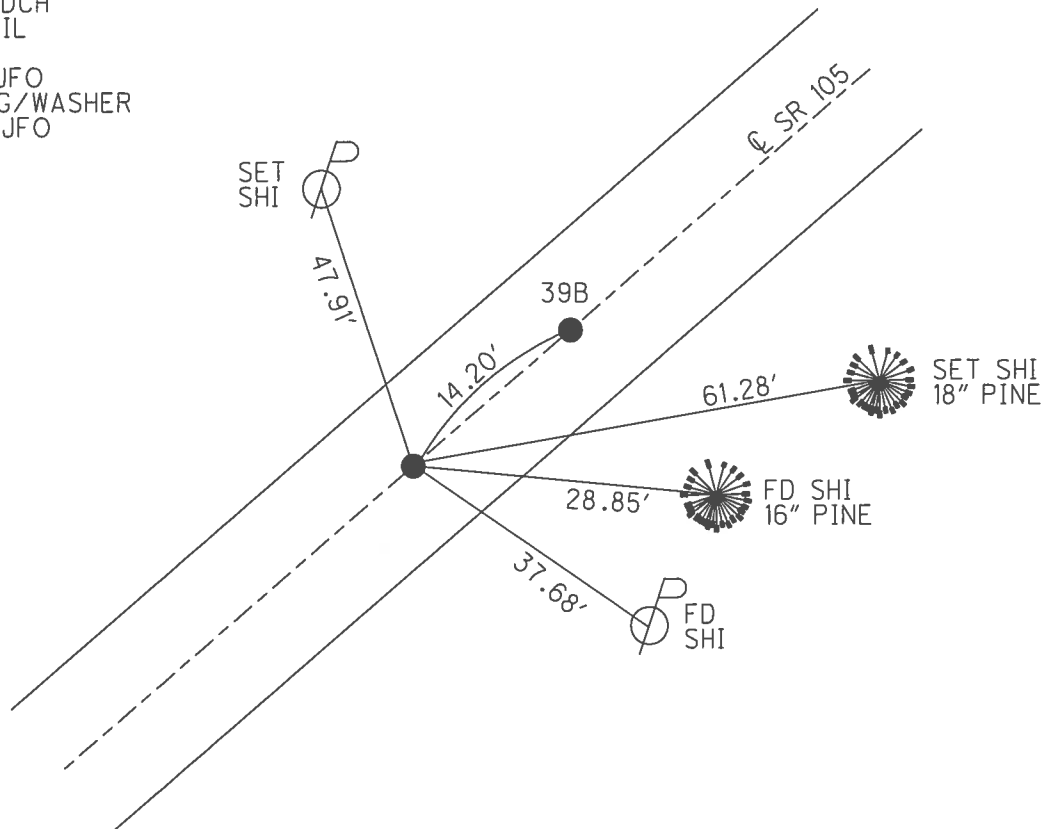

O.D.O.T. DISTRICT 2 SURVEY OFFICE (USE ONLY)


PERSONNEL	REFERENCE NO. <u>39 B</u>	SHEET <u>42</u> OF <u>54</u>
NOTES	DATE <u>9/13/16</u>	ROUTE <u>SR 105</u>
H.C. <u>RHOADES</u>	WEATHER <u>FAIR</u>	COUNTY <u>WOOD</u>
R.C. <u>O'DONNELL</u>	TEMP. <u>58°</u>	TOWNSHIP <u>WEBSTER</u>
		SECTION <u>13</u>
		T <u>5</u> N R <u>11</u> E

TYPE MONUMENT MAG/WASHER
 ON SURFACE - ~~BELOW~~ ON
~~LEFT~~ - CL PAV'T - RIGHT 1.1'
9' TORT EDGE PAVEMENT
 S.L.M. 275+51

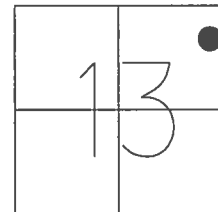

GRID: NORTHING: 632368.682 EASTING: 1685152.754


RECORD: P.O.T.
 STA. 276+70.80
 FD P.K./WASHER
 4/15/02, DCH
 SET P.K./WASHER
 6/13/02, DCH
 FD P.K.SHANK
 SET MAG/WASHER
 REFA39
 6/10/16, JFO
 SET 1" MAG/WASHER
 10/17/17, JFO

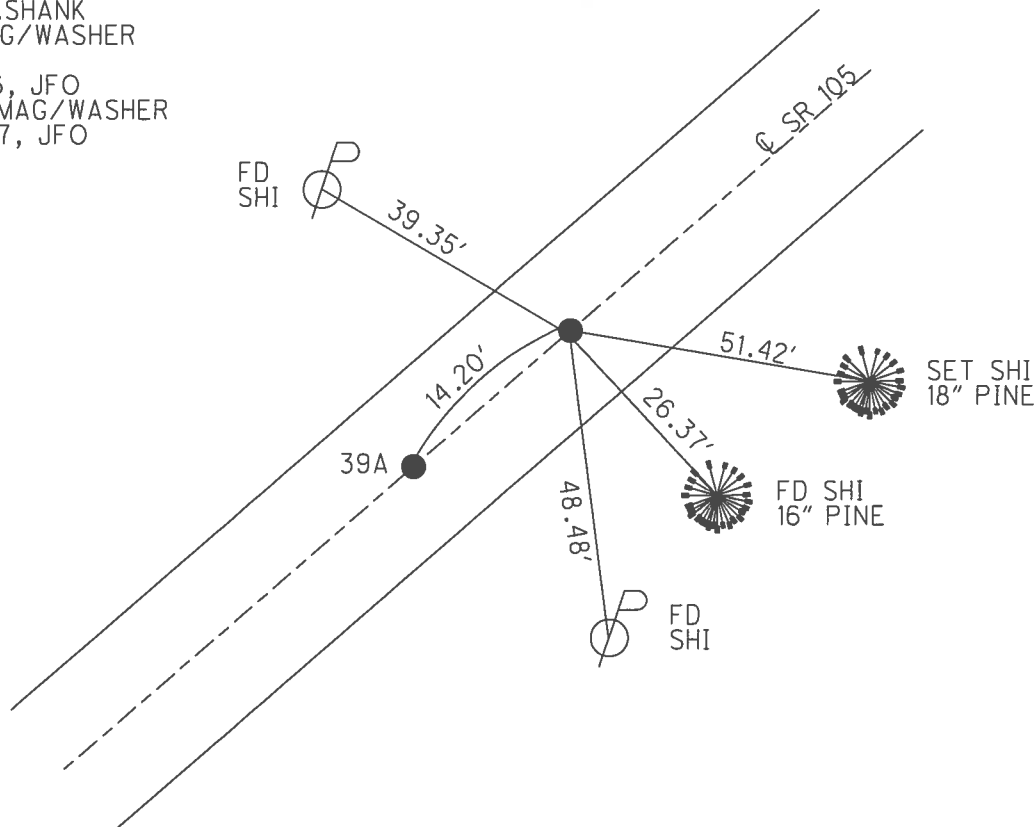

O.D.O.T. DISTRICT 2 SURVEY OFFICE (USE ONLY)


PERSONNEL	REFERENCE NO. <u>40</u>	SHEET <u>43</u> OF <u>54</u>
NOTES	DATE <u>9/13/16</u>	ROUTE <u>SR 105</u>
H.C. <u>RHOADES</u>	WEATHER <u>FAIR</u>	COUNTY <u>WOOD</u>
R.C. <u>O'DONNELL</u>	TEMP. <u>58°</u>	TOWNSHIP <u>WEBSTER</u>
		SECTION <u>13</u>
		T <u>5</u> N R <u>11</u> E

TYPE MONUMENT P.K./WASHER
 ON SURFACE - ~~BELOW~~ ON
~~LEFT~~ - C PAV'T - RIGHT 0.6'
9.4' TO RT EDGE PAVEMENT
 S.L.M. 276+76

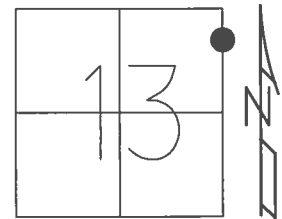

GRID: NORTHING: 632448.172 EASTING: 1685249.169

RECORD: P.O.T.
 STA. 277+95.78
 FD P.K./WASHER
 4/15/02, DCH
 SET P.K./WASHER
 6/13/02, DCH
 FD P.K./WASHER
 REF40
 6/10/16, JFO
 SET 1" MAG/WASHER
 NEWREF40
 10/17/17, JFO

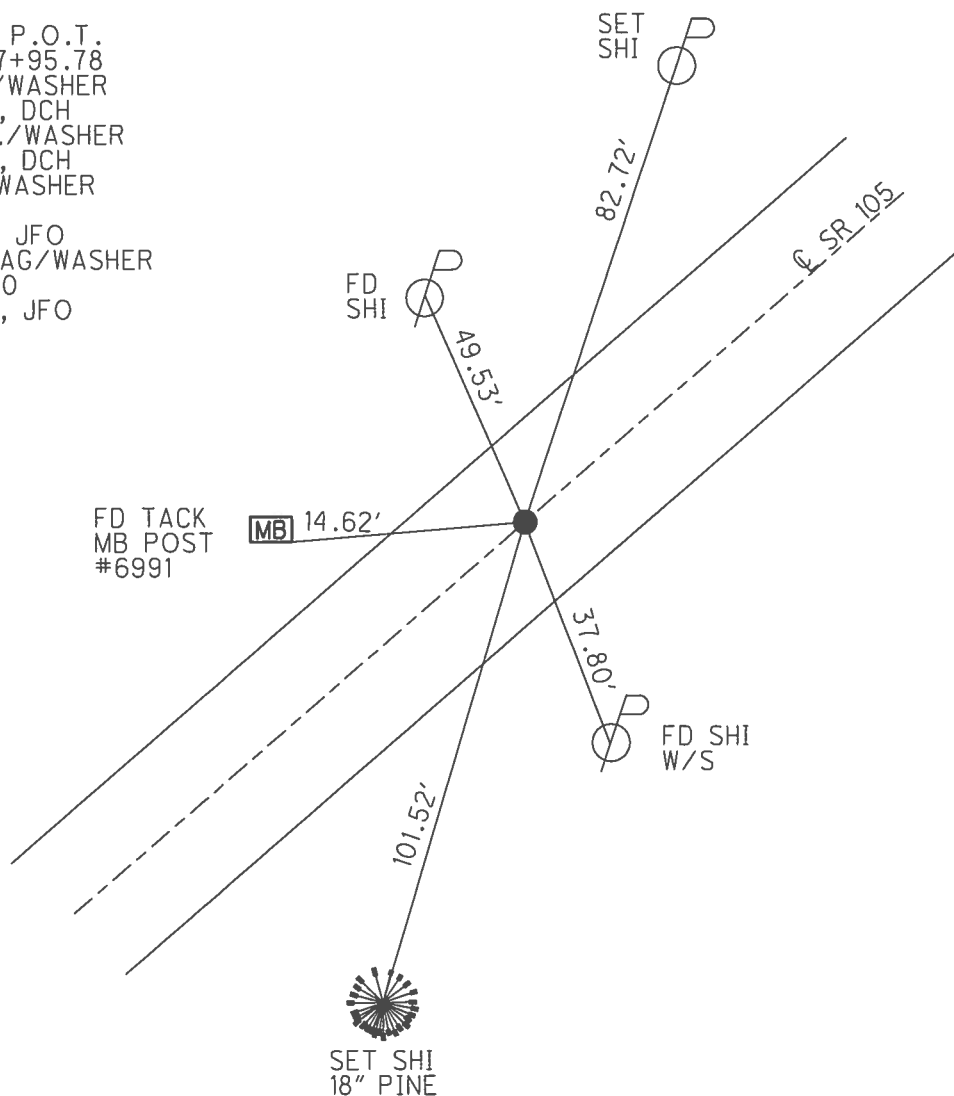


O.D.O.T. DISTRICT 2 SURVEY OFFICE (USE ONLY)


PERSONNEL	REFERENCE NO. <u>41</u>	SHEET <u>44</u> OF <u>54</u>
NOTES	DATE <u>9/13/16</u>	ROUTE <u>SR 105</u>
H.C. <u>RHOADES</u>	WEATHER <u>FAIR</u>	COUNTY <u>WOOD</u>
R.C. <u>O'DONNELL</u>	TEMP. <u>58°</u>	TOWNSHIP <u>WEBSTER</u>
		SECTION <u>7</u>
		T <u>5</u> N R <u>11</u> E

TYPE MONUMENT P.K.NAIL
 ON SURFACE - ~~BELOW~~ ON
~~LEFT~~ - CL PAV'T - RIGHT 3.5'
6.7' TO S EDGE PAVEMENT
 S.L.M. 279+69

GRID: NORTHING: 632631.086 EASTING: 1685471.097

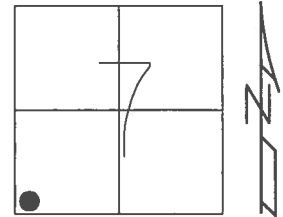


RECORD: P.I.
 STA. 280+89.22
 $\Delta = 2^\circ 23' 00''$ LT
 FD P.K./WASHER
 4/15/02, DCH
 SET P.K./WASHER
 5/31/02, DCH
 FD P.K.NAIL
 REF41
 6/10/16, JFO
 SET 1" MAG/WASHER
 NEWREF41
 10/17/17, JFO

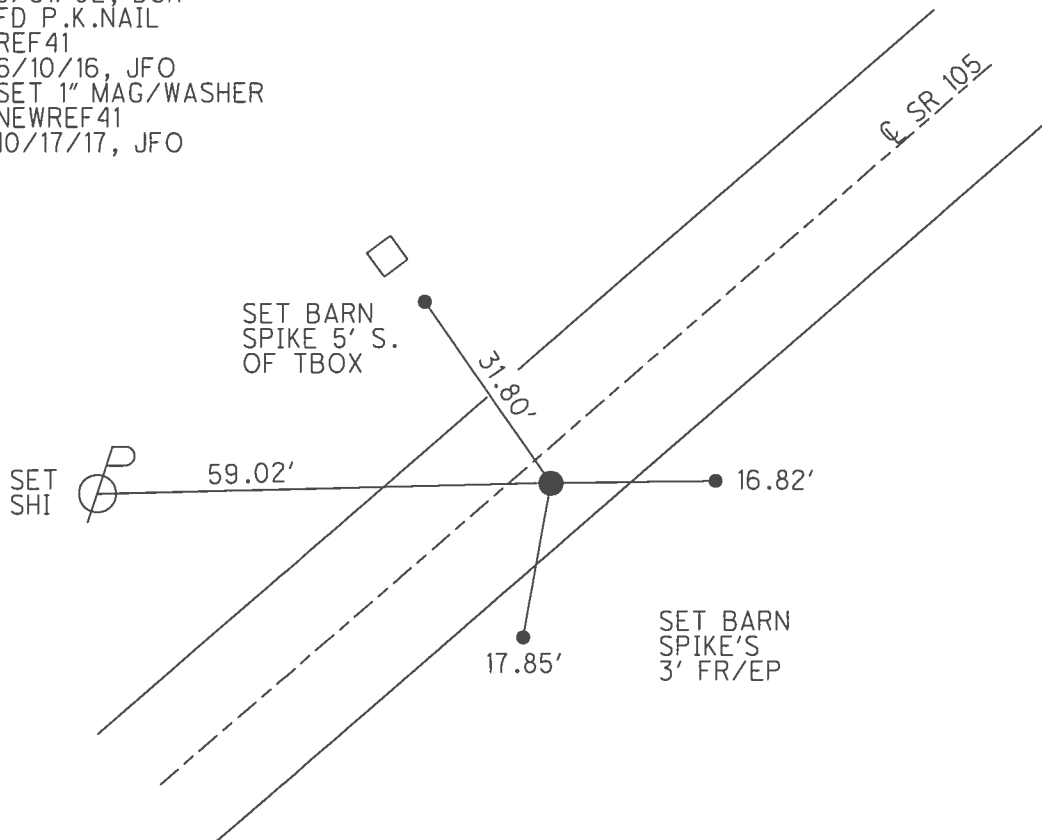

O.D.O.T. DISTRICT 2 SURVEY OFFICE (USE ONLY)


PERSONNEL	REFERENCE NO. <u>42</u>	SHEET <u>45</u> OF <u>54</u>
NOTES	DATE <u>9/13/16</u>	ROUTE <u>SR 105</u>
H.C. <u>RHOADES</u>	WEATHER <u>FAIR</u>	COUNTY <u>WOOD</u>
R.C. <u>O'DONNELL</u>	TEMP. <u>58°</u>	TOWNSHIP <u>WEBSTER</u>
		SECTION <u>7</u>
		T <u>5</u> N R <u>11</u> E

TYPE MONUMENT P.K./WASHER
 ON SURFACE - ~~BELOW~~ ON
 LEFT - C PAV'T - ~~RIGHT~~ 9.5'
1.2' TO LT EDGE PAVEMENT
 S.L.M. 285+51

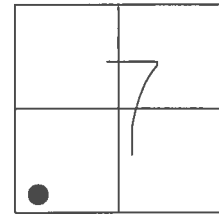

GRID: NORTHING: 633023.783 EASTING: 1685909.580


RECORD: P.I.
 STA. 286+71.80
 $\Delta = 14^\circ 44' 20''$ RT
 FD P.K./WASHER
 4/15/02, DCH
 SET P.K./WASHER
 6/13/02, DCH
 FD P.K./WASHER
 REF42
 6/10/16, JFO
 SET 1" MAG/WASHER
 10/17/17, JFO

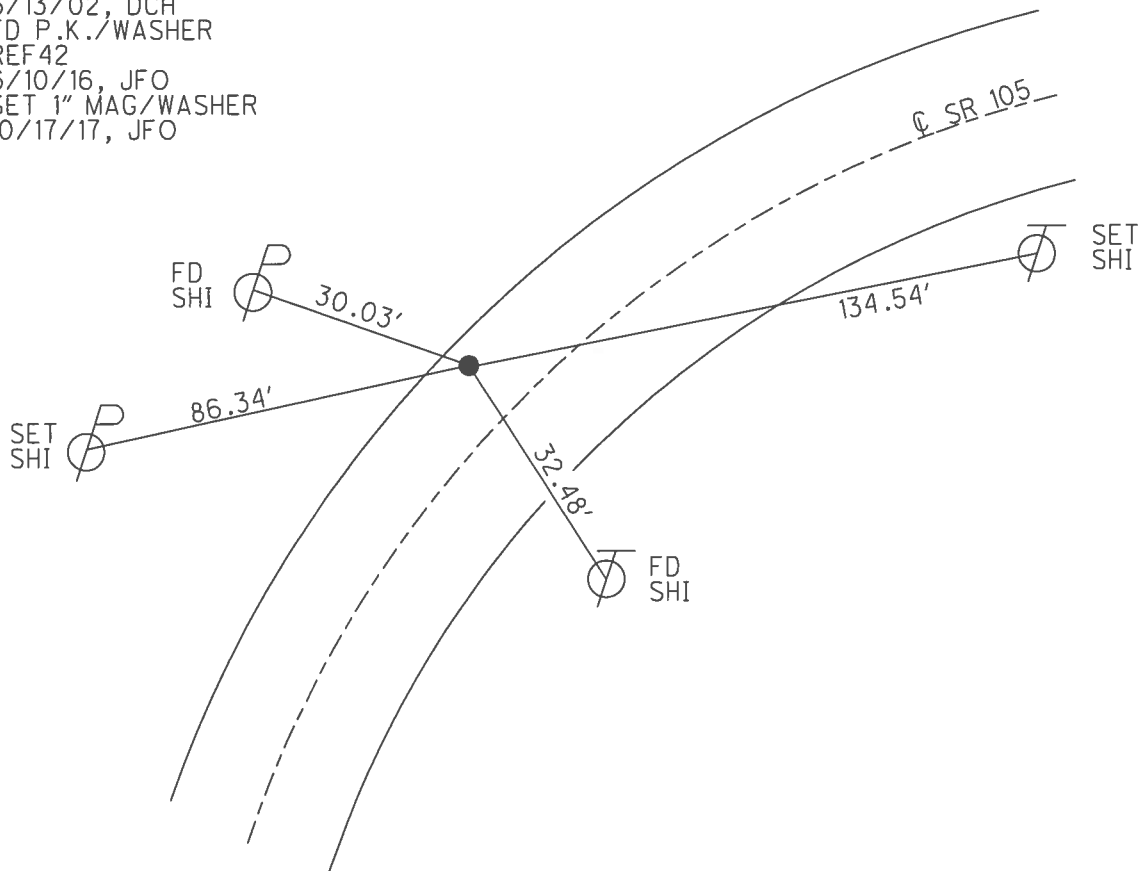

O.D.O.T. DISTRICT 2 SURVEY OFFICE (USE ONLY)


PERSONNEL	REFERENCE NO. <u>43</u>	SHEET <u>46</u> OF <u>54</u>
NOTES	DATE <u>9/13/16</u>	ROUTE <u>SR 105</u>
H.C. <u>RHOADES</u>	WEATHER <u>FAIR</u>	COUNTY <u>WOOD</u>
R.C. <u>O'DONNELL</u>	TEMP. <u>58°</u>	TOWNSHIP <u>WEBSTER</u>
		SECTION <u>7</u>
		<u>T 5 N R 11 E</u>

TYPE MONUMENT P.K.NAIL
 ON SURFACE - ~~BELOW~~ ON
 LEFT - ℄ PAV'T - RIGHT ON
9.9' TO RT EDGE PAVEMENT
 S.L.M. 290+80

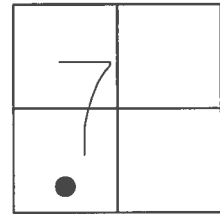

GRID: NORTHING: 633264.686 EASTING: 1686379.633


RECORD: P.O.T.
 STA. 291+99.90
 FD P.K./WASHER
 4/15/02, DCH
 SET P.K./WASHER
 6/13/02, DCH
 FD P.K.NAIL
 REF43
 6/10/16, JFO
 SET 1" MAG/WASHER
 8/2/17, DCH

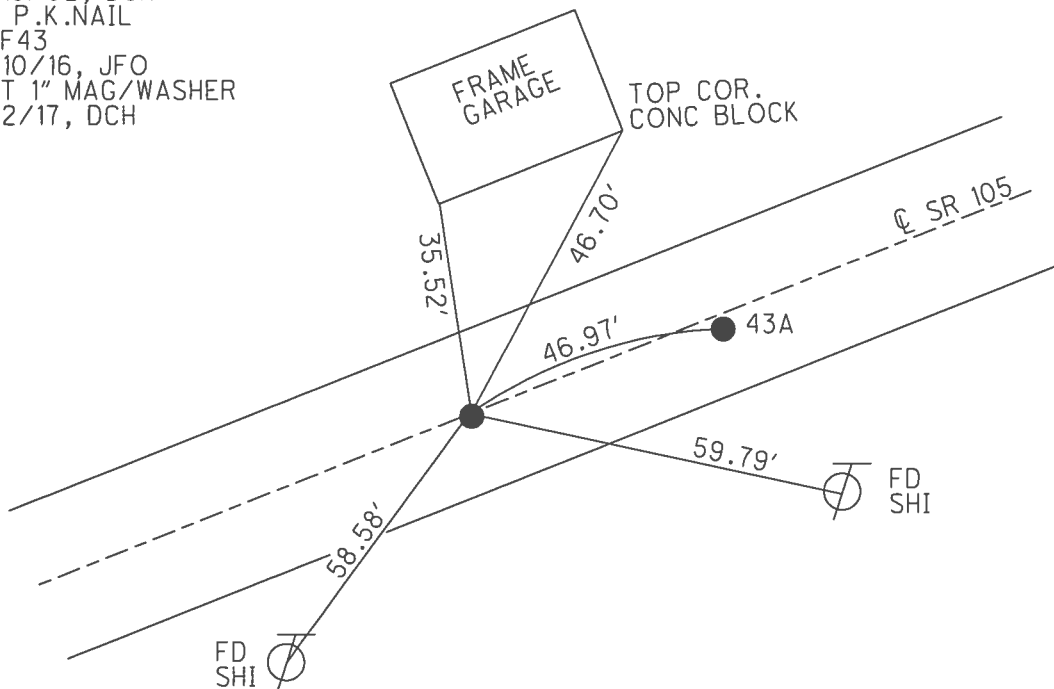

O.D.O.T. DISTRICT 2 SURVEY OFFICE (USE ONLY)


PERSONNEL	REFERENCE NO. <u>43 A</u>	SHEET <u>47</u> OF <u>54</u>
NOTES	DATE <u>9/13/16</u>	ROUTE <u>SR 105</u>
H.C. <u>RHOADES</u>	WEATHER <u>FAIR</u>	COUNTY <u>WOOD</u>
R.C. <u>O'DONNELL</u>	TEMP. <u>58°</u>	TOWNSHIP <u>WEBSTER</u>
		SECTION <u>7</u>
		T <u>5</u> N R <u>11</u> E

TYPE MONUMENT MAG/WASHER
 ON SURFACE - ~~BELOW~~ ON
~~LEFT~~ - CL PAV'T - RIGHT 1.9'
8.9' TORT EDGE PAVEMENT
 S.L.M. 291+27

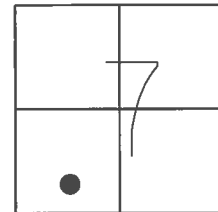

GRID: NORTHING: 633285.950 EASTING: 1686421.504

RECORD: PI
 STA. 292+46.86
 $\Delta = 1^\circ 10' 40''$ LT
 FD P.K./WASHER
 4/15/02, DCH
 SET P.K./WASHER
 6/13/02, DCH
 SET MAG/WASHER
 REFA43
 6/10/16, JFO
 SET 1" MAG/WASHER
 8/2/17, DCH

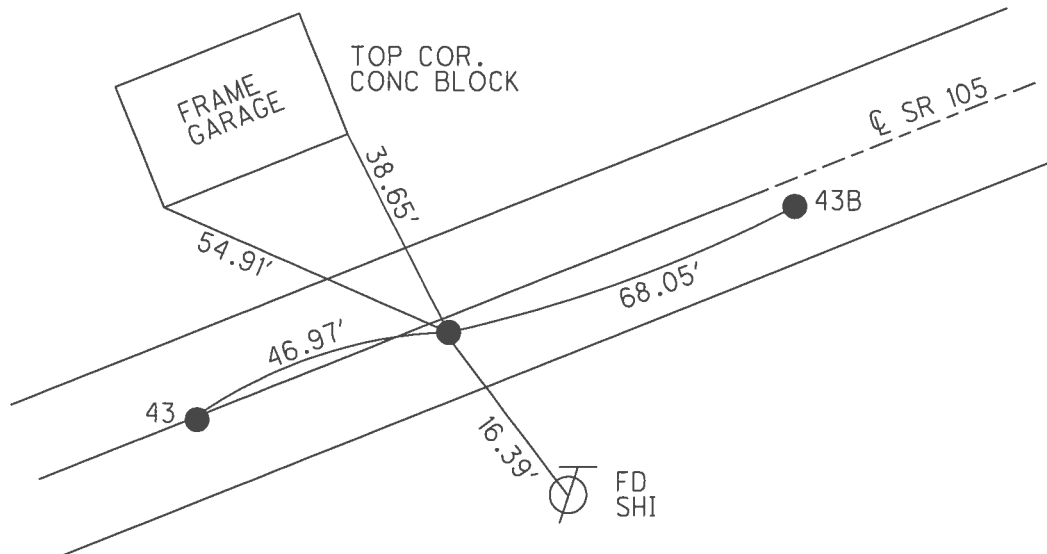

O.D.O.T. DISTRICT 2 SURVEY OFFICE (USE ONLY)

PERSONNEL

REFERENCE NO.

43 B

SHEET

48

OF 54

NOTES

RHOADES

DATE

9/13/16

ROUTE

SR 105

H.C.

O'DONNELL

WEATHER

FAIR

COUNTY

WOOD

R.C.

TODD

TEMP.

58°

TOWNSHIP

WEBSTER

SECTION

7

T 5 N R 11 E

TYPE MONUMENT

P.K.NAIL

ON SURFACE - BELOW

ON

LEFT - C PAV'T - RIGHT


2.2'

7.7' TORT EDGE PAVEMENT



S.L.M.

291+95

GRID: NORTHING: 633318.338 EASTING: 1686481.342

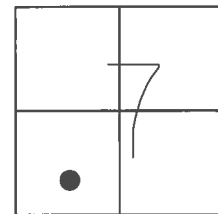

RECORD: P.I.
STA. 293+14.86
 $\Delta = 7^{\circ} 56' 20''$ LT
FD P.K./WASHER
4/15/02, DCH
SET P.K./WASHER
6/13/02, DCH
FD P.K.NAIL
REFB43
6/10/16, JFO
SET 1" MAG/WASHER
8/2/17, DCH

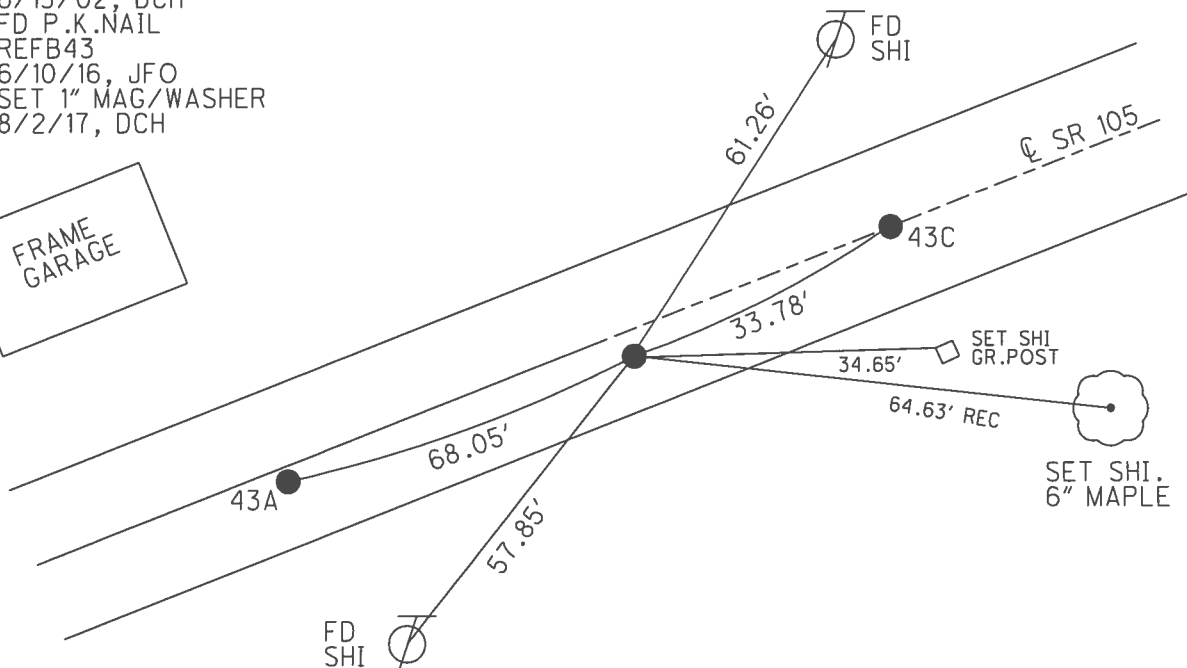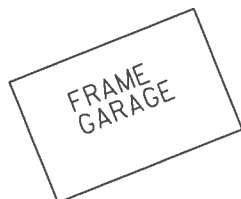

O.D.O.T. DISTRICT 2 SURVEY OFFICE (USE ONLY)

PERSONNEL

REFERENCE NO. 43 C

SHEET 49 OF 54

NOTES RHOADES

DATE 4/15/02

ROUTE SR 105

H.C. O'DONNELL

WEATHER SUNNY

COUNTY WOOD

R.C. TODD

TEMP. 74°

TOWNSHIP WEBSTER

SECTION 7

T 5 N R 11 E

TYPE MONUMENT MAG/WASHER


ON SURFACE - BELOW ON

LEFT - Q PAV'T - RIGHT -


- TO - EDGE PAVEMENT

S.L.M. 292+29

GRID: NORTHING: 633338.270 EASTING: 1686508.606

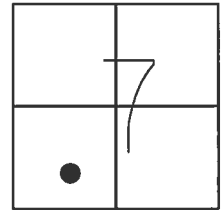


RECORD: P.O.T.
STA 293+48.65
FD P.K./WASHER
4/15/02, DCH
SET P.K./WASHER
6/13/02, DCH
SET MAG/WASHER
REFC43
6/10/16, JFO
SET 1" MAG/WASHER
8/2/17, DCH

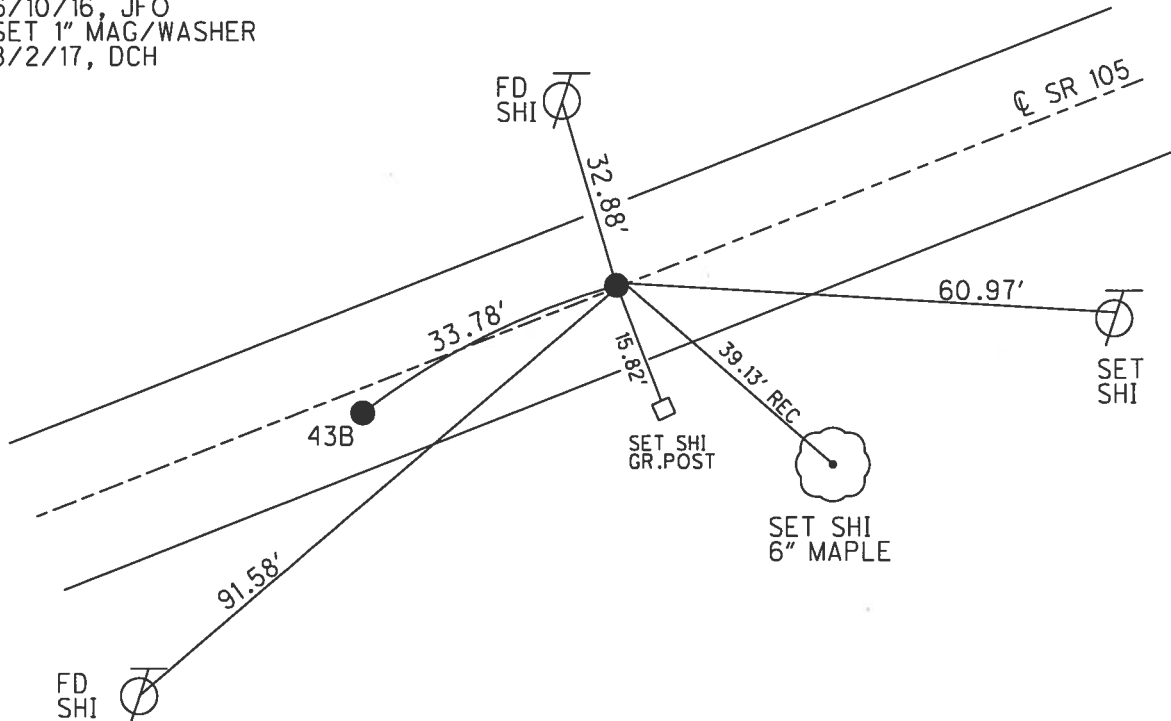

O.D.O.T. DISTRICT 2 SURVEY OFFICE (USE ONLY)


PERSONNEL _____ REFERENCE NO. 44 SHEET 50 OF 54
 NOTES RHOADES DATE 9/13/16 ROUTE SR 105
 H.C. O'DONNELL WEATHER SUNNY COUNTY WOOD
 R.C. TODD TEMP. 76° TOWNSHIP WEBSTER
 SECTION 7
 T 5 N R 11 E

TYPE MONUMENT P.K.NAIL
 ON SURFACE - ~~BELOW~~ ON
~~LEFT~~ - C PAV'T - RIGHT 1'
9.2' TO RT EDGE PAVEMENT
 S.L.M. 293+96

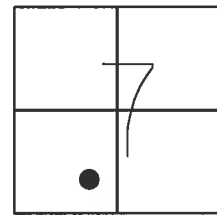

GRID: NORTHING: 633437.845 EASTING: 1686644.804


RECORD: P.I.
 STA. 295+17.31
 $\Delta = 1^\circ 05' 20''$ LT
 FD P.K./WASHER
 4/15/02, DCH
 SET P.K./WASHER
 6/13/02, DCH
 FD P.K.NAIL
 REF44
 6/10/16, JFO
 SET 1" MAG/WASHER
 8/2/17, DCH

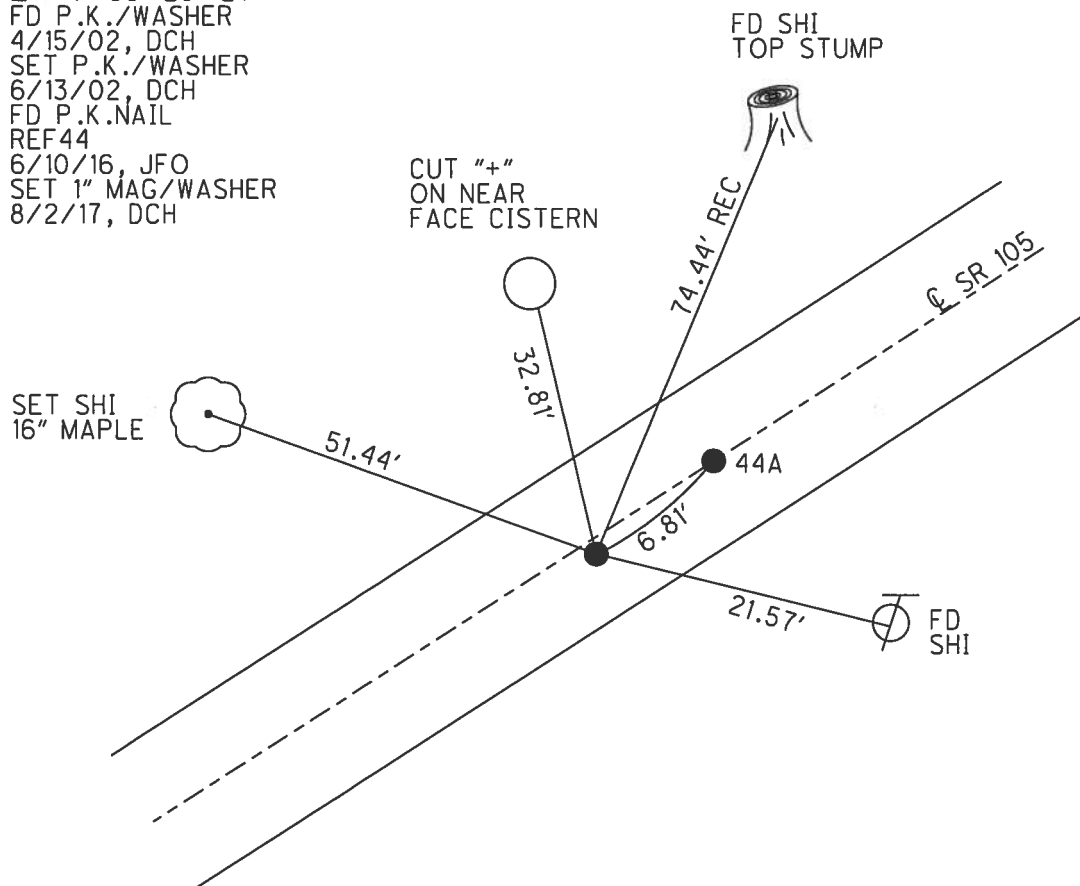

O.D.O.T. DISTRICT 2 SURVEY OFFICE (USE ONLY)


PERSONNEL _____ REFERENCE NO. 44 A SHEET 51 OF 54
 NOTES RHOADES DATE 9/13/16 ROUTE SR 105
 H.C. O'DONNELL WEATHER SUNNY COUNTY WOOD
 R.C. TODD TEMP. 76° TOWNSHIP WEBSTER
 _____ SECTION 7
 _____ T 5 N R 11 E

TYPE MONUMENT P.K./WASHER
 ON SURFACE - ~~BELOW~~ ON
~~LEFT~~ - CL PAV'T - RIGHT -
- TO - EDGE PAVEMENT
 S.L.M. 294+03

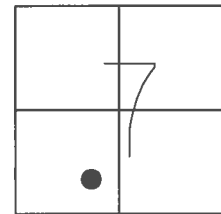

GRID: NORTHING: 633441.951 EASTING: 1686650.218

RECORD:
 FD P.K./WASHER
 4/15/02, DCH
 SET P.K./WASHER
 6/13/02, DCH
 FD P.K./WASHER
 REFA44
 6/10/16, JFO
 SET 1" MAG/WASHER
 8/2/17, DCH


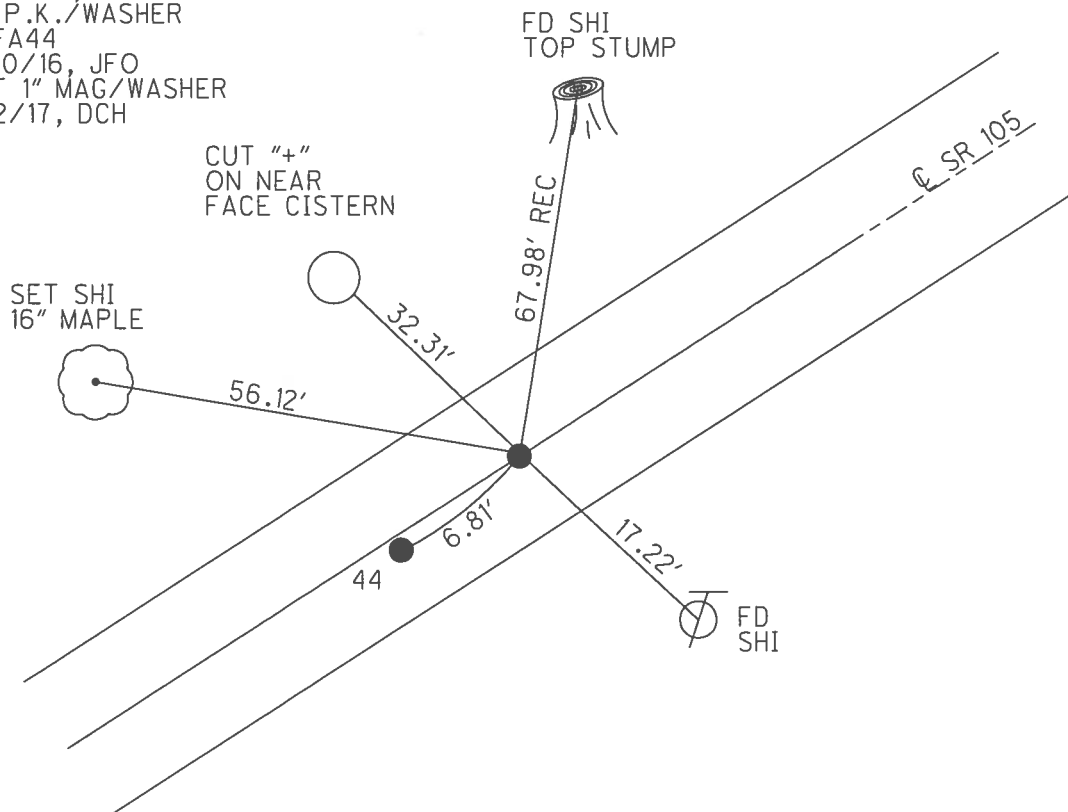


O.D.O.T. DISTRICT 2 SURVEY OFFICE (USE ONLY)

PERSONNEL	REFERENCE NO. <u>45</u>	SHEET <u>52</u> OF <u>54</u>	
NOTES	LONG <u> </u>	DATE <u>8/27/91</u>	ROUTE <u>SR 105</u>
H.C.	VAN DUSEN	WEATHER <u>SUNNY</u>	COUNTY <u>WOOD</u>
R.C.	BARNHISEL	TEMP. <u>92°</u>	TOWNSHIP <u>WEBSTER</u>
			SECTION <u>7</u>
			T <u>5</u> N R <u>11</u> E

TYPE MONUMENT 3/4" IPIN
 ON SURFACE - ~~BELOW~~ 5"
 LEFT - CL PAV'T - ~~RIGHT~~ 24.8'
15.2' LT TO LT EDGE PAVEMENT
 S.L.M. 299+58

GRID: NORTHING: 633782.780 EASTING: 1687097.297

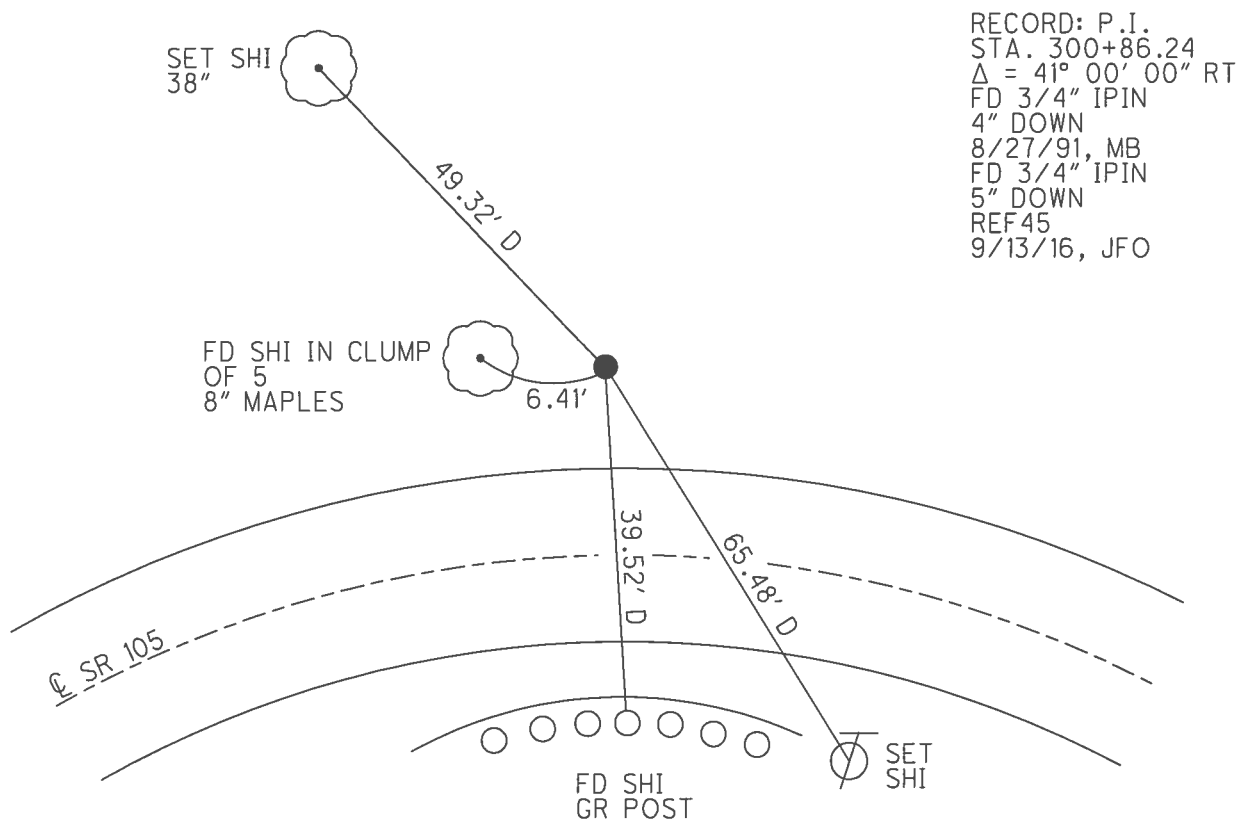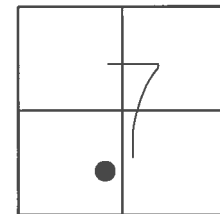

O.D.O.T. DISTRICT 2 SURVEY OFFICE (USE ONLY)

PERSONNEL	REFERENCE NO. <u>46</u>	SHEET <u>53</u> OF <u>54</u>
NOTES	DATE <u>4/15/02</u>	ROUTE <u>SR 105</u>
H.C. <u>ROUSOS</u>	WEATHER <u>SUNNY</u>	COUNTY <u>WOOD</u>
R.C. <u>HOMAN</u>	TEMP. <u>76°</u>	TOWNSHIP <u>WEBSTER</u>
		SECTION <u>7</u>
		T <u>5</u> N R <u>11</u> E

TYPE MONUMENT R.R.SPIKE


~~ON SURFACE~~ - BELOW 2 1/2"

~~LEFT~~ - Q PAV'T - RIGHT 13'

3.2' RT TO RT EDGE PAVEMENT


S.L.M. 302+01

GRID: NORTHING: 633766.791 EASTING: 1687346.260

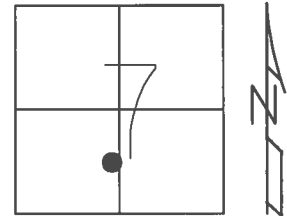

RECORD: P.I.
 STA. 303+35.64
 $\Delta = 36^\circ 12' 20''$ LT
 FD R.R.SPIKE
 2 1/2" DOWN
 4/15/02, DCH
 FD LG.R.R.SPIKE
 6" DOWN
 REF 46
 9/13/16, JFO
 FD UNDER NEW GRAVEL
 12/20/16, JFO

CURVE DATA:
 $\Delta = 36^\circ 12' 20''$ LT
 $D = 25^\circ$
 $T = 74.92$
 $R = 229.18'$
 $E = 11.94$
 $L = 144.82'$

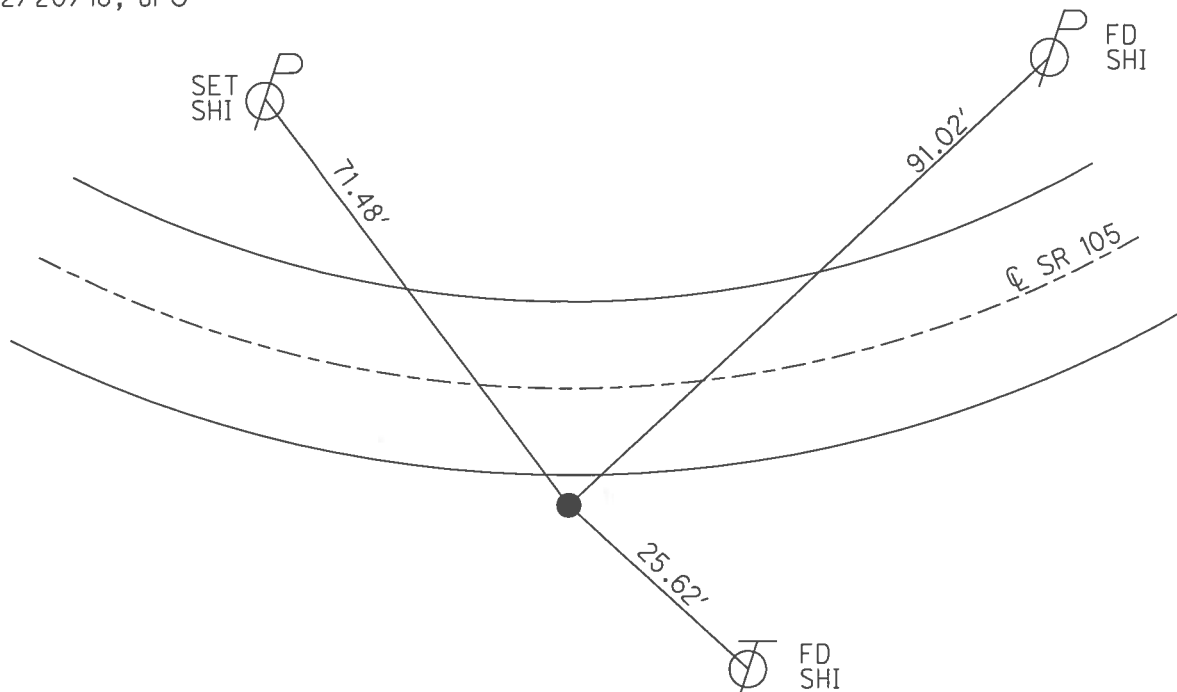

O.D.O.T. DISTRICT 2 SURVEY OFFICE (USE ONLY)

PERSONNEL

REFERENCE NO.

47

SHEET

54

OF 54

NOTES

POORE

DATE

8/2/17

ROUTE

SR 105

H.C.

HOMAN

WEATHER

SUNNY

COUNTY

WOOD

R.C.

CARSON

TEMP.

83°

TOWNSHIP

WEBSTER

RHOADES

SECTION

7

T 5 N R 11 E

TYPE MONUMENT 1" MAG/WASHER


ON SURFACE - ~~BELOW~~ ON

LEFT - ~~Q~~ PAV'T - ~~RIGHT~~ 1.2'


8.9' TO LT EDGE PAVEMENT

S.L.M. 303+61

GRID: NORTHING: 633854.965 EASTING: 1687484.384

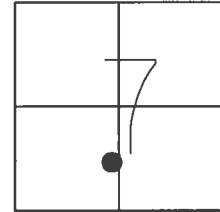

RECORD: P.O.T.
STA. 304+99.54
FD P.K./WASHER
4/15/02, DCH
SET P.K./WASHER
6/13/02, DCH
SET MAG/WASHER
REF47
6/10/16, JFO
SET 1" MAG/WASHER
8/2/17, DCH

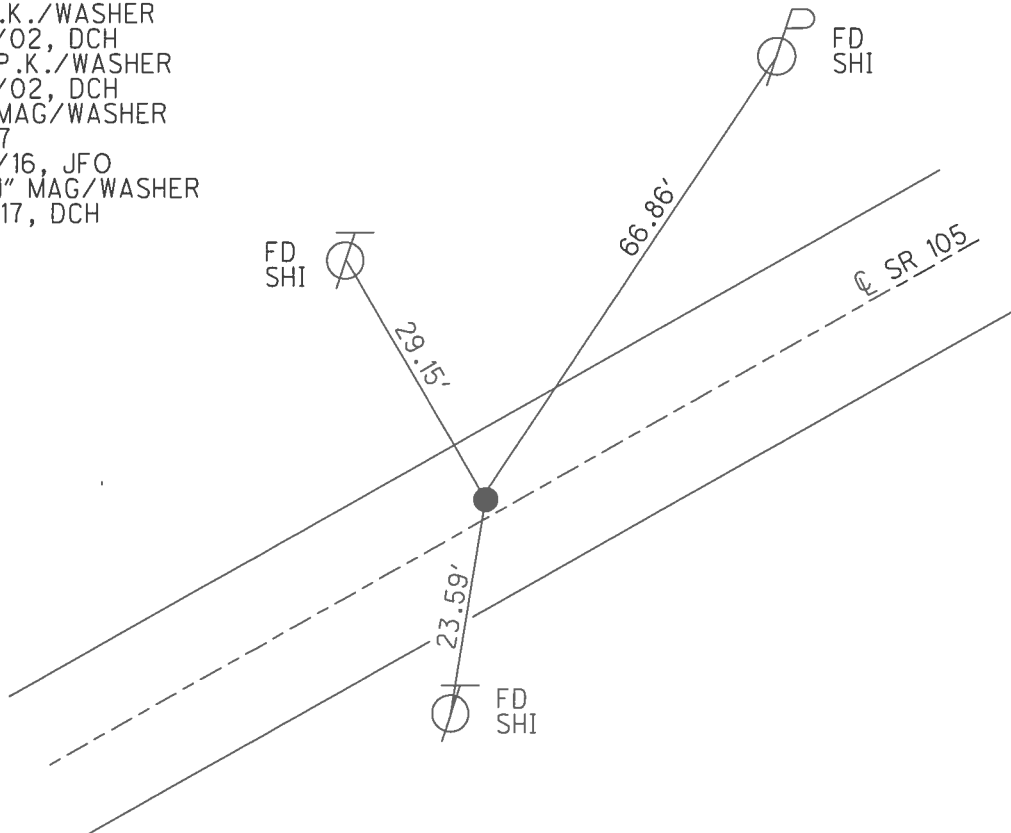

O.D.O.T. DISTRICT 2 SURVEY OFFICE (USE ONLY)

PERSONNEL

REFERENCE NO. 50

SHEET 1 OF 33

NOTES AUBLE

DATE 5/23/23

ROUTE SR 105

H.C. NIESE

WEATHER CLEAR

COUNTY WOOD

R.C. AUBLE

TEMP. 63°

TOWNSHIP WEBSTER

SECTION 7

DWG BY RHOADES

PID PAVING TRAIN

T 5 N R 12 E

TYPE MONUMENT MAG NAIL

ON SURFACE - ~~BELOW~~ ON

OFFSET 6.2' LT : ~~RT~~

- TO - EDGE PAVEMENT


STATION: 307+82.4

HORZ.DATUM: NAD83 2011

GEOID: NAVD88 2018

GRID: NORTHING: 634071.996


EASTING: 1687824.984

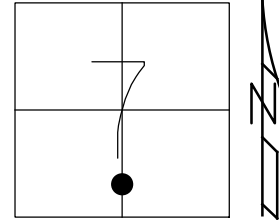

RECORD:
SET P.K./WASHER
6/13/02, DCH
FD P.K./WASHER
SV56
7/21/11, MC
SET MAG/WASHER
RN8
12/7/11, SAH
FD MAG/WASHER
REF50
6/10/16, JFO
FD MAG NAIL
REF56
5/23/23, TDN

WOOD LPD:
N: 456381.120
E: 198848.212

NOTE:
REF 56 SR 199

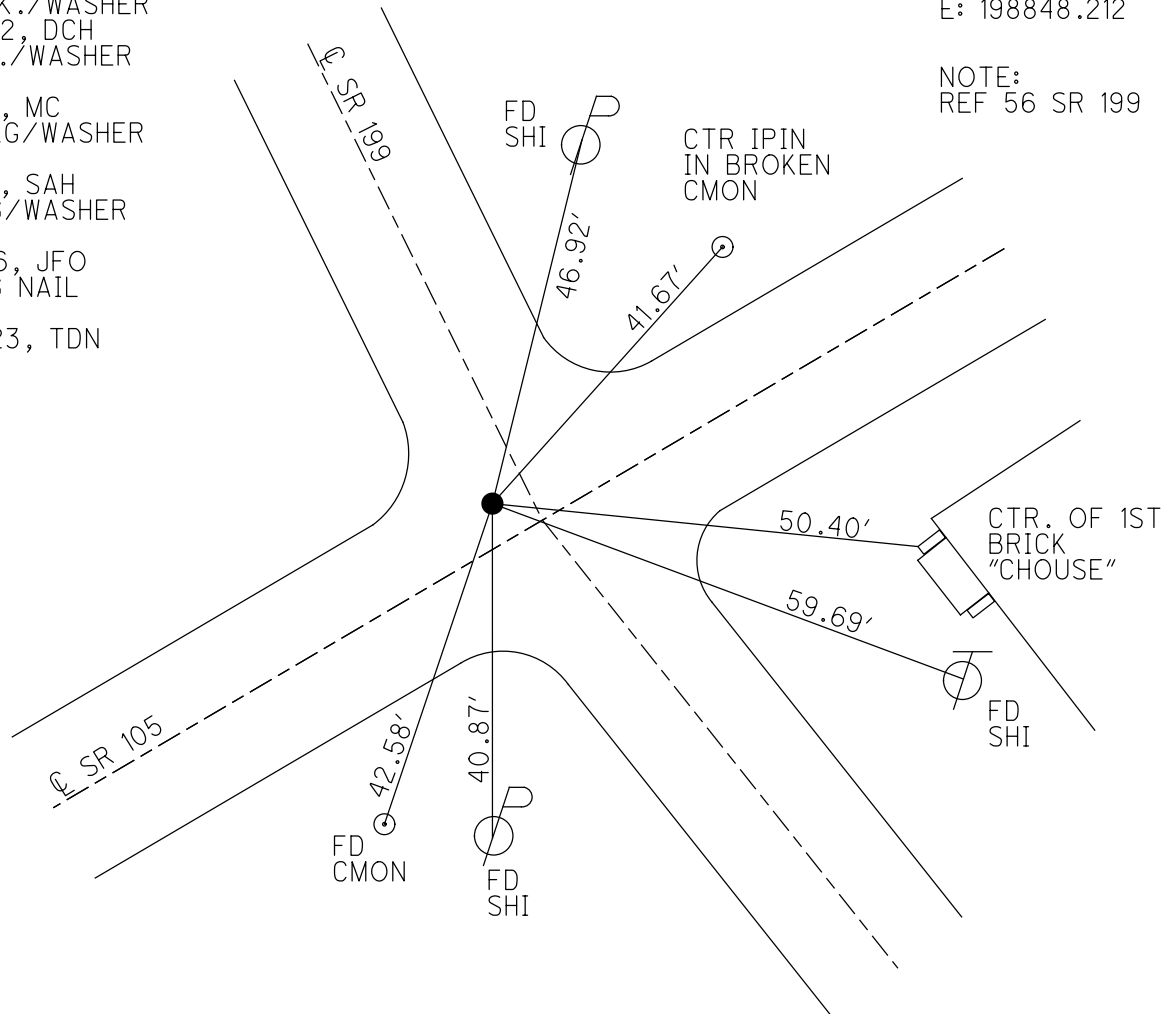

O.D.O.T. DISTRICT 2 SURVEY OFFICE (USE ONLY)

PERSONNEL

REFERENCE NO. 51

SHEET 2 OF 33

NOTES RHOADES

DATE 6/12/13

ROUTE SR 105

H.C. CODER

WEATHER FAIR

COUNTY WOOD

R.C. RHOADES

TEMP. 68°

TOWNSHIP WEBSTER

SECTION 7

T 5 N R 12 E

TYPE MONUMENT P.K./WASHER


ON SURFACE - ~~BELOW~~ ON

~~LEFT~~ - Q PAV'T - RIGHT 2.7'

5.7' TO RT EDGE PAVEMENT

S.L.M. 310+95

Grid: Northing: 634219.191 Easting: 1688133.354

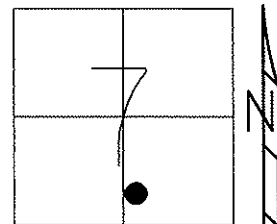


RECORD P.O.T.
STA. 312+45.00

SET P.K./WASHER
6/13/02, DCH

FD P.K./WASHER
GPS, REF51
10/11/11, RJL

SET MAG/WASHER
GPS, FINREF51
10/3/13, SDC

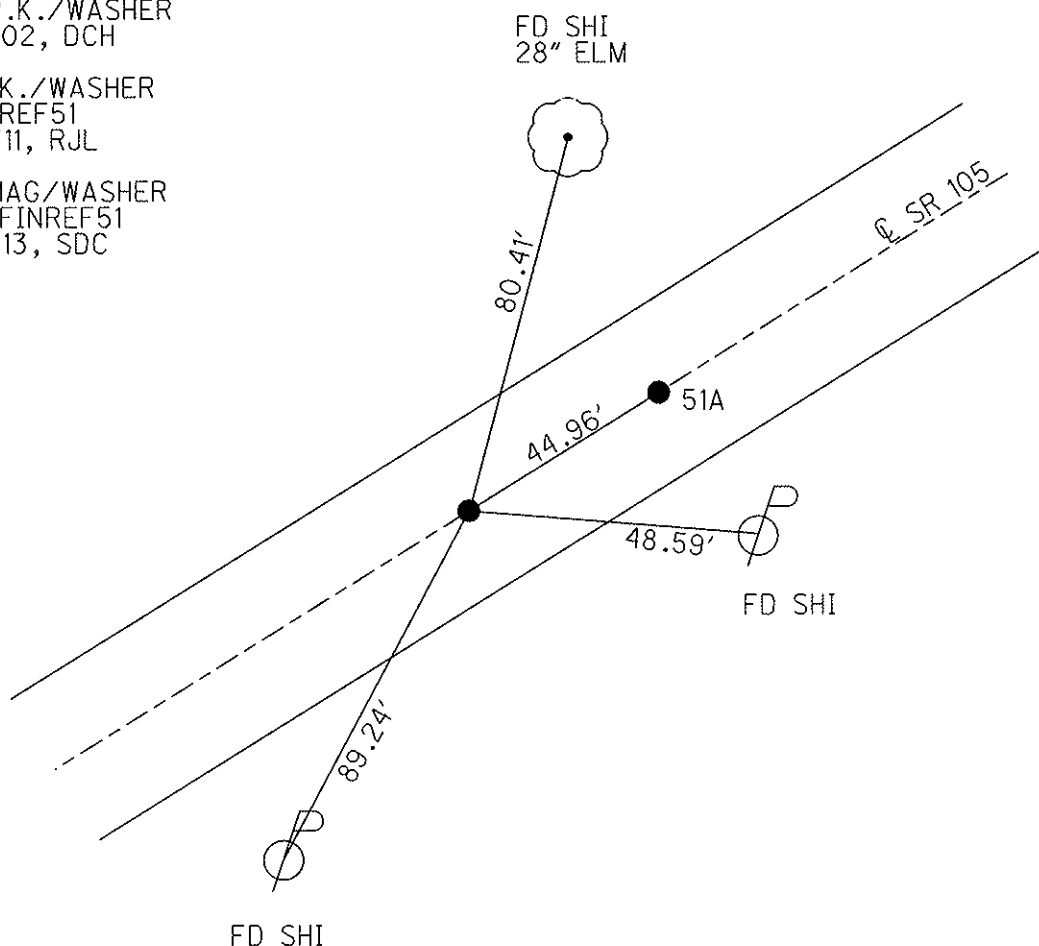

O.D.O.T. DISTRICT 2 SURVEY OFFICE (USE ONLY)

PERSONNEL

REFERENCE NO. 51 A

SHEET 3 OF 33

NOTES RHOADES

DATE 6/12/13

ROUTE SR 105

H.C. CODER

WEATHER FAIR

COUNTY WOOD

R.C. RHOADES

TEMP. 68°

TOWNSHIP WEBSTER

SECTION 7

T 5 N R 12 E

TYPE MONUMENT P.K./WASHER


ON SURFACE - ~~BELOW~~ ON

LEFT - C PAV'T - ~~RIGHT~~ 5.4'

4.8' TO RT EDGE PAVEMENT

S.L.M. 311+40

Grid: Northing: 634238.604 Easting: 1688173.821

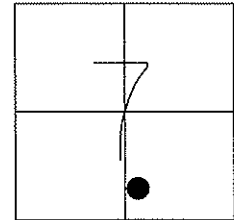


RECORD P.I. #44
STA. 312+89.88

SET P.K./WASHER
6/13/02, DCH

FD P.K./WASHER
GPS, REFA51
10/11/11, RJL

SET MAG/WASHER
GPS, FINREFA51
10/3/13, SDC

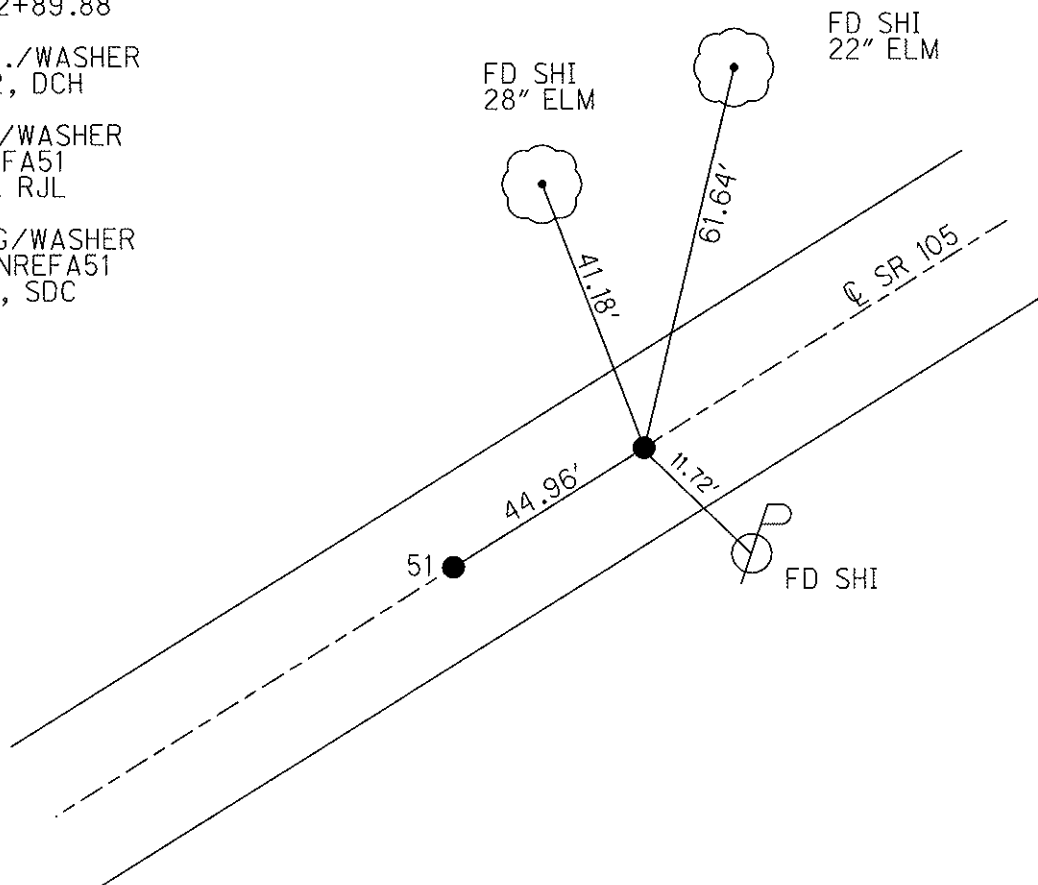

O.D.O.T. DISTRICT 2 SURVEY OFFICE (USE ONLY)

PERSONNEL

REFERENCE NO. 52

SHEET 4 OF 33

NOTES RHOADES

DATE 6/12/13

ROUTE SR 105

H.C. _____ CODER _____

WEATHER FAIR

COUNTY WOOD

R.C. RHOADES

TEMP. 68°

TOWNSHIP WEBSTER

SECTION 7

T 5 N R 12 E

TYPE MONUMENT P.K./WASHER


ON SURFACE - ~~BELOW~~ ON _____

LEFT - C PAV'T - ~~RIGHT~~ 6.0'

____ TO ____ EDGE PAVEMENT

S.L.M. 314+63

Grid: Northing: 634422.573 Easting: 1688440.087

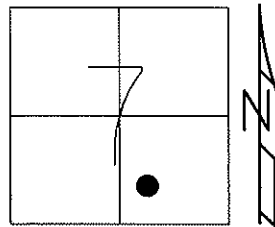

RECORD P.I.#35

STA. 316+13.75

$$\Delta = 13^{\circ} 06' 20''$$

SET P.K./WASHER

6/3/02, DCH

FD P.K./WASHER


GPS, REF52

10/11/11, RJL

SET MAG/WASHER

GPS, FINREF52

10/3/13, SDC

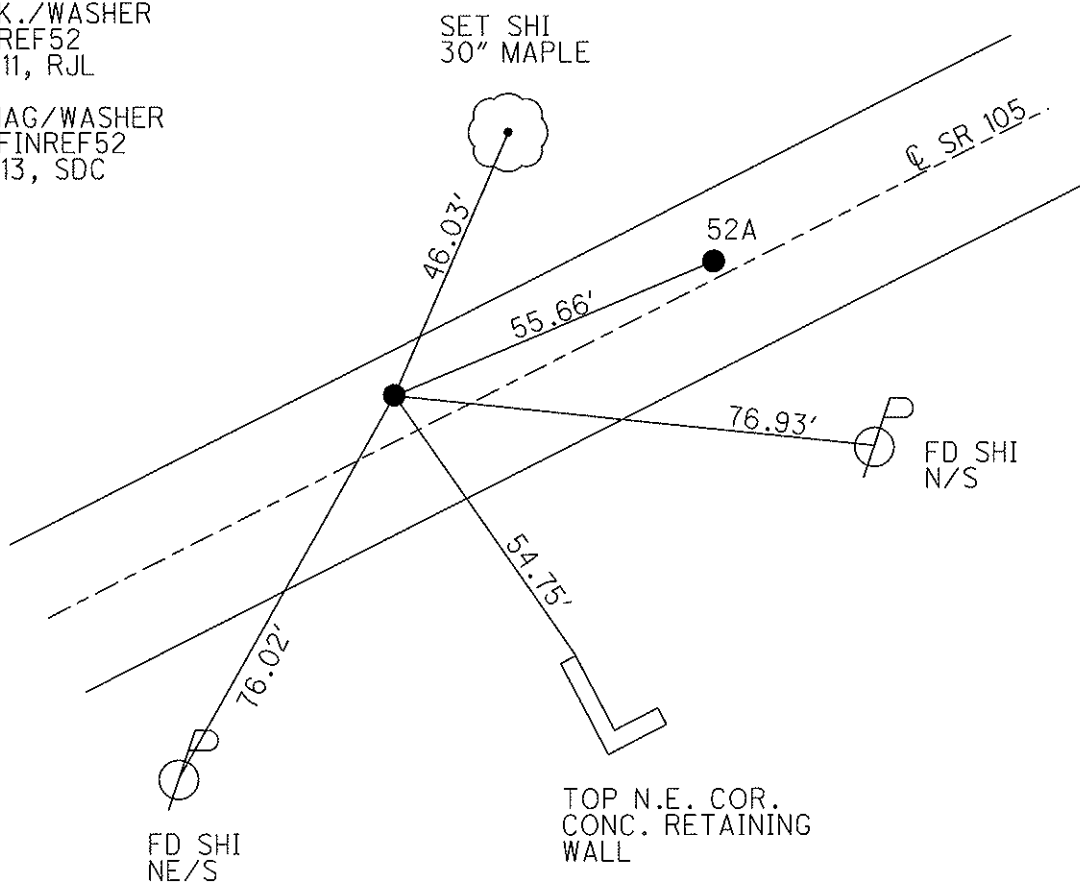

O.D.O.T. DISTRICT 2 SURVEY OFFICE (USE ONLY)

PERSONNEL

REFERENCE NO. 52 A

SHEET 5 OF 33

NOTES RHOADES

DATE 6/12/13

ROUTE SR 105

H.C. CODER

WEATHER FAIR

COUNTY WOOD

R.C. RHOADES

TEMP. 68°

TOWNSHIP WEBSTER

SECTION 7

T 5 N R 12 E

TYPE MONUMENT P.K./WASHER


ON SURFACE - ~~BELOW~~ ON

LEFT - Q PAV'T - ~~RIGHT~~ 1.0'

9.0' TO LT EDGE PAVEMENT

S.L.M. 315+18

Grid: Northing: 634442.956 Easting: 1688491.839

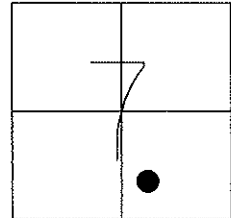


ORIGIN UNKNOWN

SET P.K./WASHER
6/13/02, DCH

FD P.K./WASHER
GPS, REFA52
10/11/11, RJL

SET MAG/WASHER
GPS, FINREFA52
10/3/13, SDC

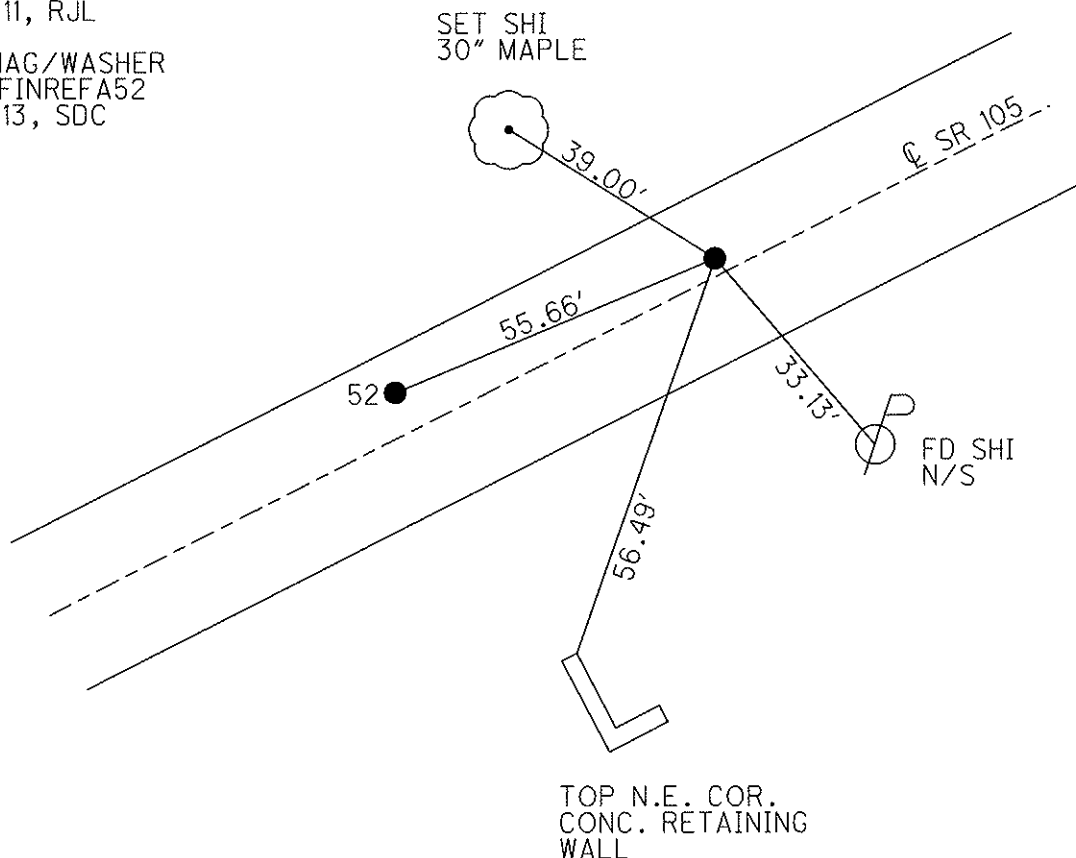

O.D.O.T. DISTRICT 2 SURVEY OFFICE (USE ONLY)

PERSONNEL

REFERENCE NO. 53

SHEET 6 OF 33

NOTES NIESE

DATE 5/19/23

ROUTE SR 105

H.C. AUBLE

WEATHER SUNNY

COUNTY WOOD

R.C. NIESE

TEMP. 70°

TOWNSHIP WEBSTER

SECTION 7

DWG BY RHOADES

PID PAVING TRAIN

T 5 N R 12 E

TYPE MONUMENT P.K./WASHER

ON SURFACE - ~~BELOW~~ ON

OFFSET Q PAVEMENT 1.5' LT : ~~RT~~

- TO - EDGE PAVEMENT


STATION: 317+08.88

HORZ.DATUM: NAD83 2011


GEOID: NAVD88 2018

GRID: NORTHING: 634510.067

EASTING: 1688661.355

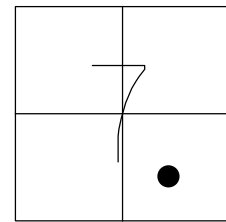

RECORD:
UNKNOWN POINT
SET P.K./WASHER
6/3/02, DCH
FD P.K./WASHER
REF53
10/11/11, RJL
SET MAG/WASHER
FINREF53
10/3/13, SDC
FD P.K./WASHER
REF53
5/19/23, TDN

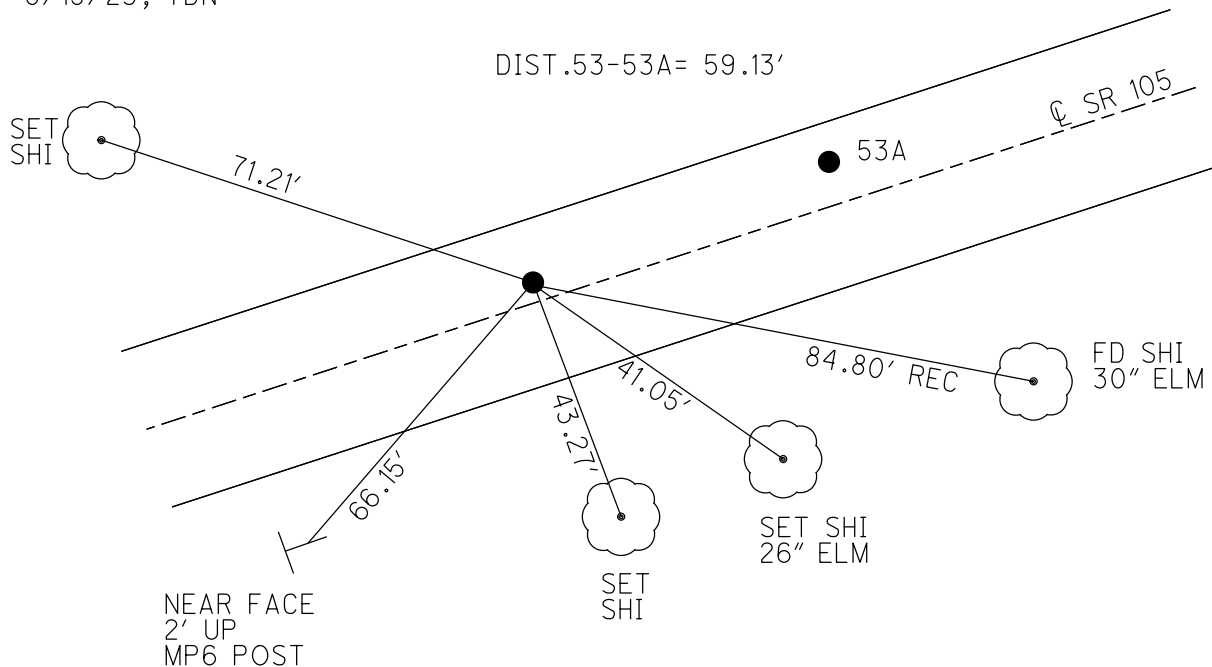

O.D.O.T. DISTRICT 2 SURVEY OFFICE (USE ONLY)

PERSONNEL

REFERENCE NO. 53 A

SHEET 7 OF 33

NOTES NIESE

DATE 5/19/23

ROUTE SR 105

H.C. AUBLE

WEATHER SUNNY

COUNTY WOOD

R.C. NIESE

TEMP. 70°

TOWNSHIP WEBSTER

DWG BY RHOADES

PID PAVING TRAIN

SECTION 7

T 5 N R 12 E

TYPE MONUMENT P.K./WASHER

ON SURFACE - ~~BELOW~~ ON

OFFSET CL PAVEMENT 5.4' LT : ~~RT~~

4.2' TO LT EDGE PAVEMENT


STATION: 317+68

HORZ.DATUM: NAD83 2011


GEOID: NAVD88 2018

GRID: NORTHING: 634531.553

EASTING: 1688716.443

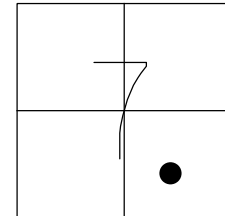

RECORD P.I.#46
STA. 319+10.75
 $\Delta=7^{\circ} 55' 00''$
SET P.K./WASHER
6/3/02, DCH
FD P.K./WASHER
REFA53
10/11/11, RJL
SET MAG/WASHER
FINREFA53
10/3/13, SDC
FD P.K./WASHER
REF53A
5/19/23, TDN

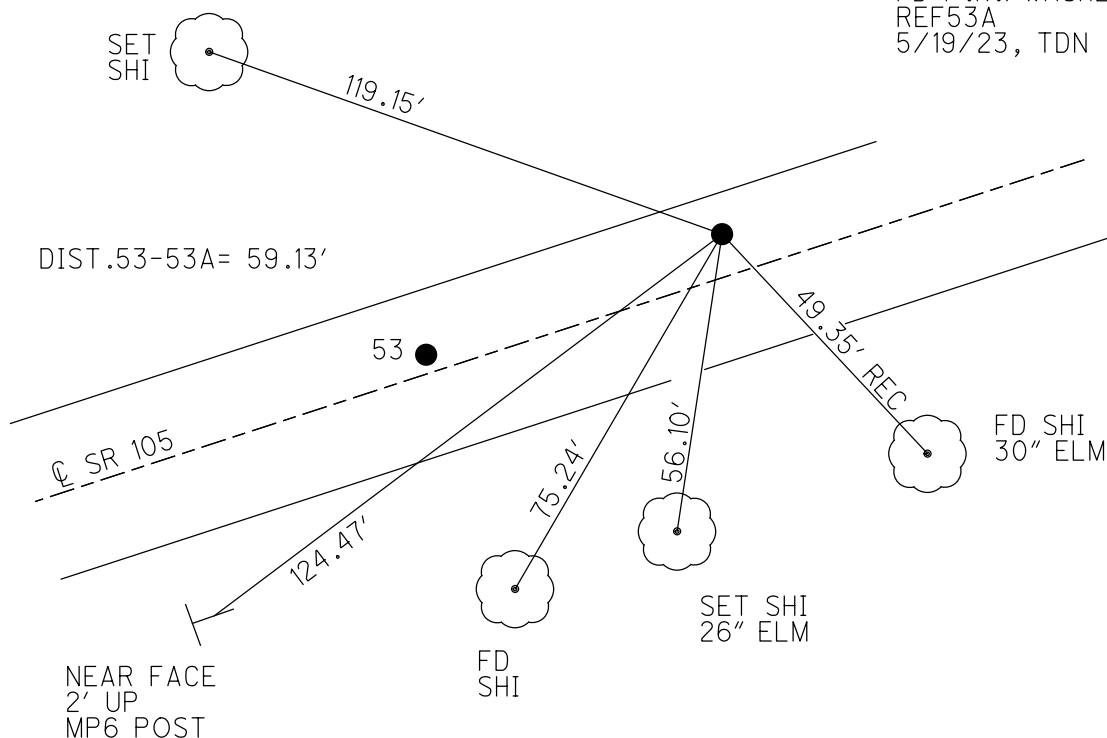

O.D.O.T. DISTRICT 2 SURVEY OFFICE (USE ONLY)

PERSONNEL

REFERENCE NO. 54

SHEET 8 OF 33

NOTES MILLER

DATE 9/19/23

ROUTE SR 105

H.C. MILLER

WEATHER SUNNY

COUNTY WOOD

R.C. RHOADES

TEMP. 65°

TOWNSHIP WEBSTER

DWG BY RHOADES PID PAVETRAIN

SECTION 7

T 5 N R 12 E

TYPE MONUMENT MAG/WASHER

ON SURFACE - ~~BELOW~~ ON

OFFSET CL PAVEMENT 4.6' LT : ~~RT~~

5.6' TO LT EDGE PAVEMENT


STATION: 321+91.86

HORZ.DATUM: NAD83 2011

GEOID: NAVD88 2012A


GRID: NORTHING: 634626.217

EASTING: 1689107.347

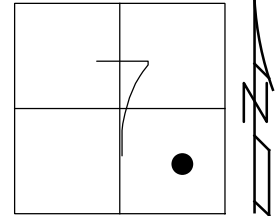

WOOD LDP:
N: 456952.232
E: 200123.275

RECORD P.I.
STA. 323+12.93
 $\Delta=7^{\circ} 31' 20''$ RT
FD P.K./WASHER
8/1/94, CHANEY
SET P.K./WASHER
11/8/94, CL
FD P.K./WASHER
4/16/02, DCH
FD P.K./WASHER
REF54
10/11/11, RJL
6/12/13, SDC
SET MAG/WASHER
FINREF54
10/3/13, SDC
D.N.F.
8/19/22, DSA
SET MAG/WASHER
W/COORDINATES
REF54
9/19/23, JAM

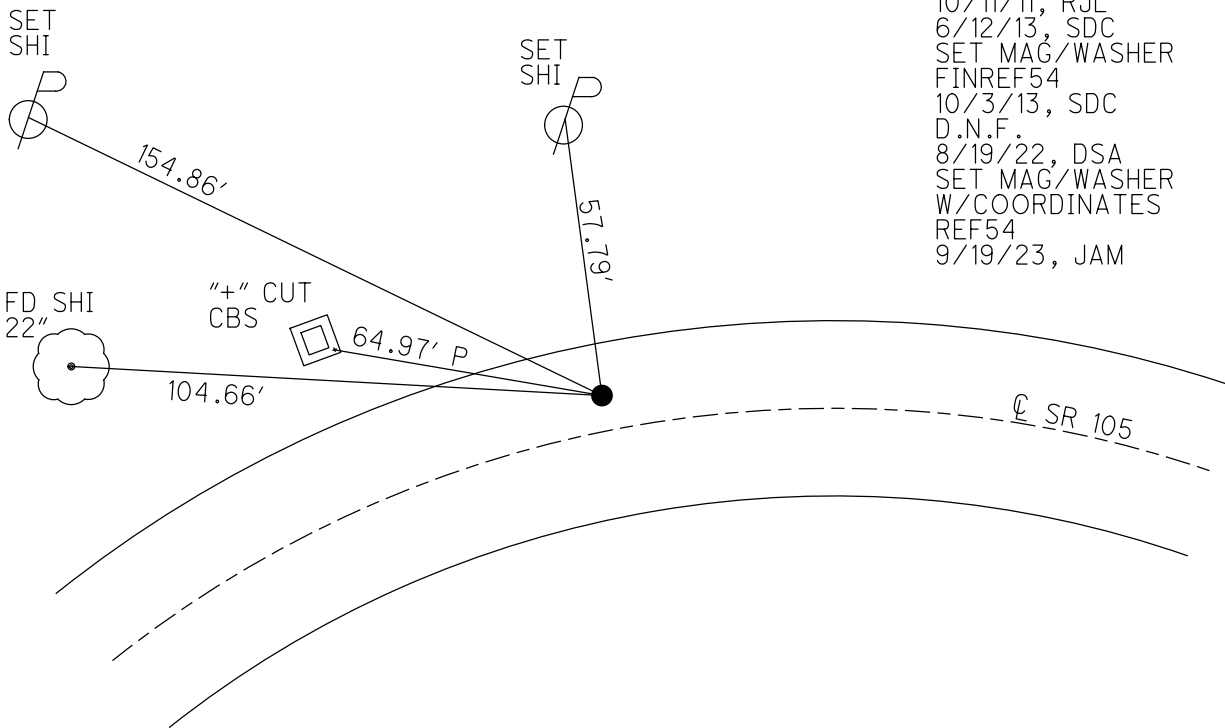

O.D.O.T. DISTRICT 2 SURVEY OFFICE (USE ONLY)

PERSONNEL

REFERENCE NO. 55

SHEET 9 OF 33

NOTES RHOADES

DATE 6/12/13

ROUTE SR 105

H.C. CODER

WEATHER FAIR

COUNTY WOOD

R.C. RHOADES

TEMP. 68°

TOWNSHIP WEBSTER

DWG BY RHOADES

PID PAVETRAIN

SECTION 7

T 5 N R 12 E

TYPE MONUMENT 1/2" IPIN

~~ON SURFACE~~ - BELOW 0.6"

OFFSET CL PAVEMENT 22.2' ~~LT~~ : RT

12' RT TO RT EDGE PAVEMENT


STATION: 330+31.83

HORIZ.DATUM: NAD83


GEOID: NAVD88 2009

GRID: NORTHING: 634715.424

EASTING: 1689942.564

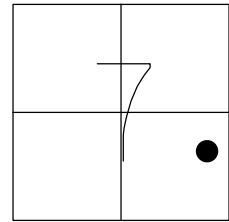

RECORD P.I.
STA. 331+52.97
 $\Delta = 14^{\circ} 30' 00''$
FD 1/2" IPID
"TRAVERSE"
REF55
10/11/11, RJL
6/12/13, SDC

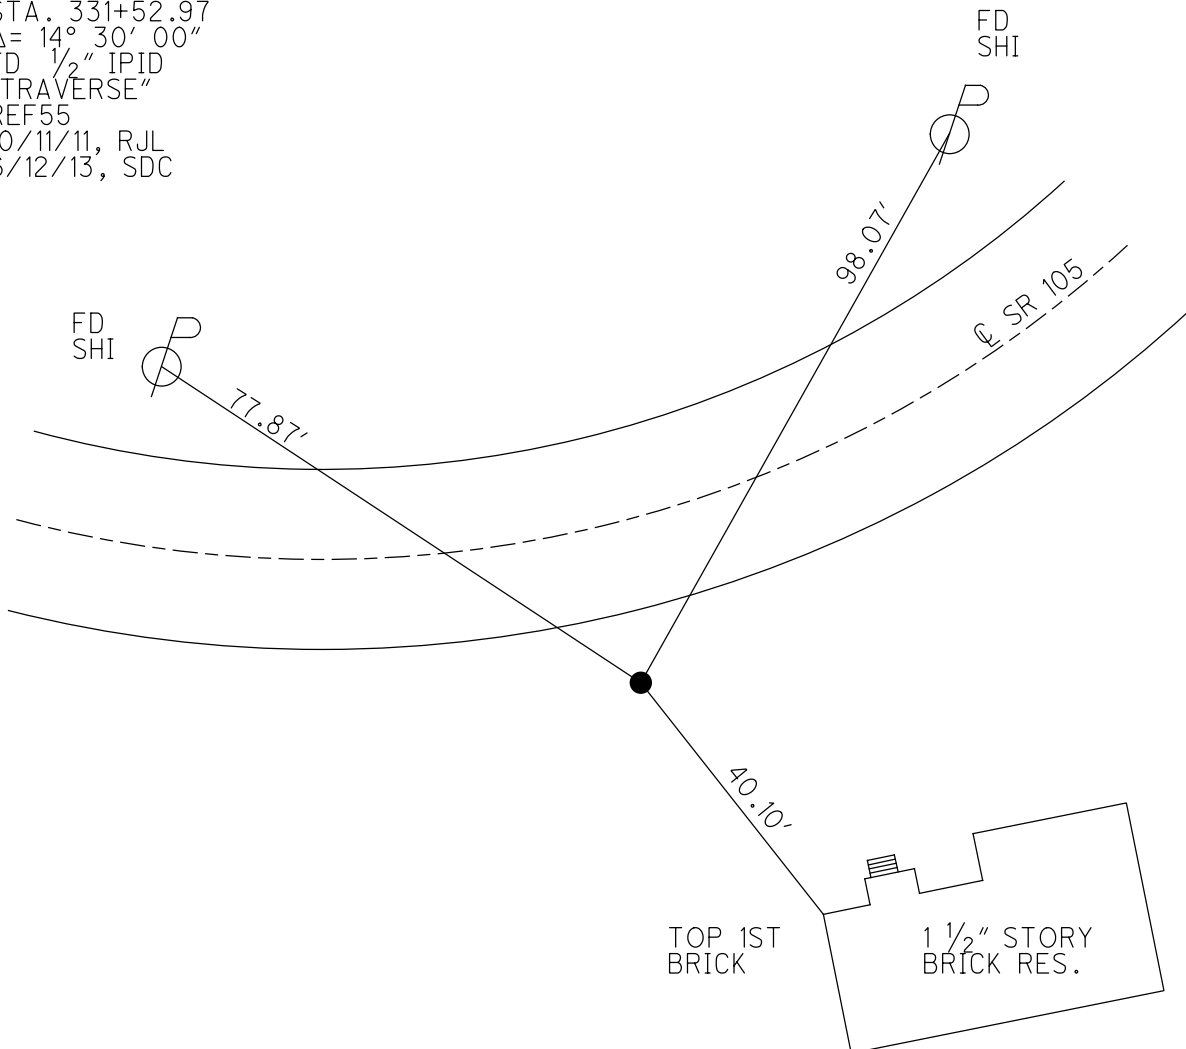

O.D.O.T. DISTRICT 2 SURVEY OFFICE (USE ONLY)

PERSONNEL

REFERENCE NO. 56

SHEET 10 OF 33

NOTES RHOADES

DATE 8/19/22

ROUTE SR 105

H.C. AUBLE

WEATHER SUNNY

COUNTY WOOD

R.C. NIESE

TEMP. 64°

TOWNSHIP WEBSTER

SECTION 7

DWG BY RHOADES

PID PAVETRAIN

T 5 N R 12 E

TYPE MONUMENT P.K./WASHER

~~ON SURFACE~~ - BELOW ON

OFFSET CL PAVEMENT ON ~~LT~~ : RT

12' RT TO RT EDGE PAVEMENT



STATION: 339+48.21

HORZ.DATUM: NAD83 2011

GEOID: NAVD88 2018

GRID: NORTHING: 635037.453

EASTING: 1690800.606

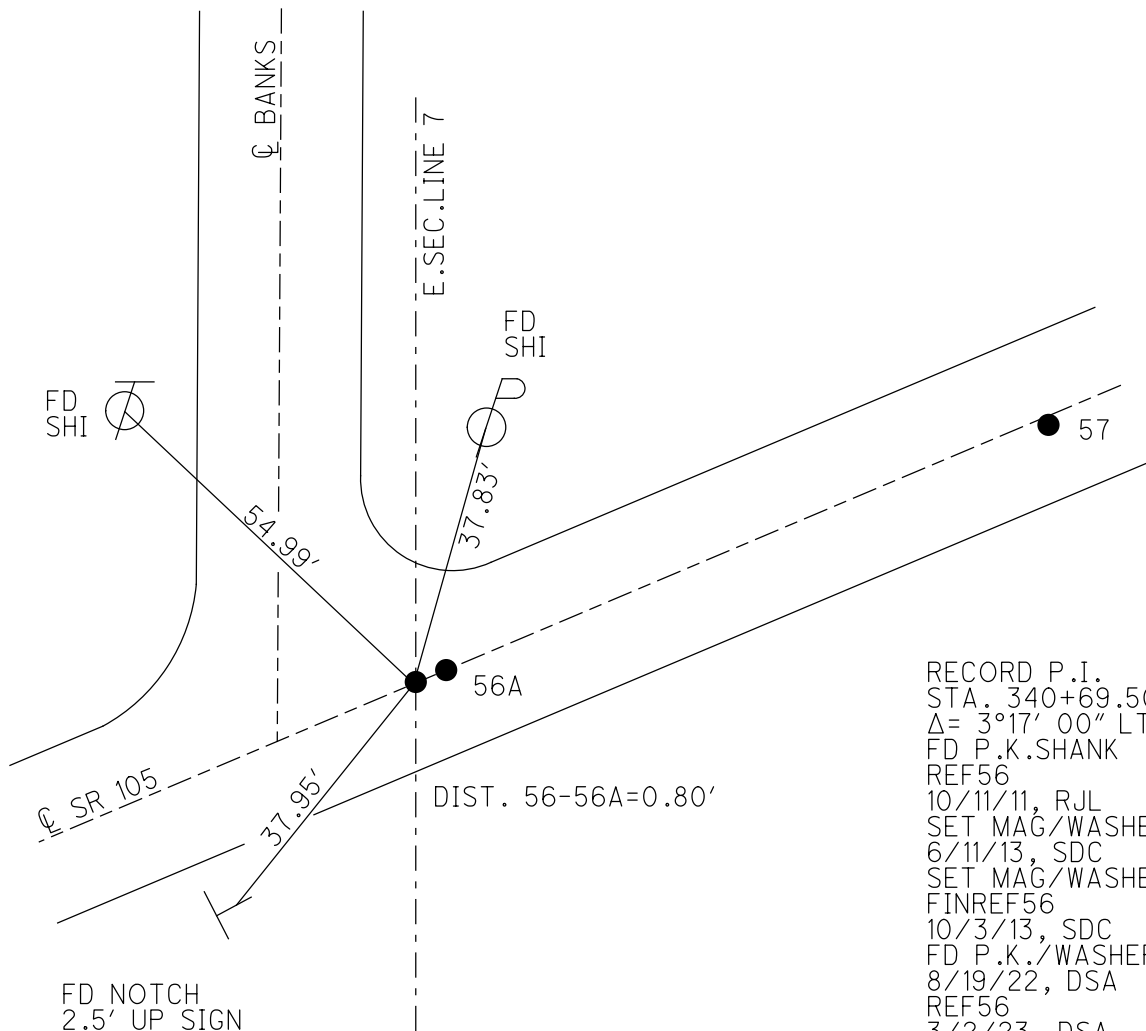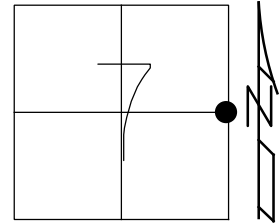

RECORD P.I.
STA. 340+69.50
 $\Delta = 3^\circ 17' 00''$ LT
FD P.K. SHANK
REF56
10/11/11, RJL
SET MAG/WASHER
6/11/13, SDC
SET MAG/WASHER
FINREF56
10/3/13, SDC
FD P.K./WASHER
8/19/22, DSA
REF56
3/2/23, DSA

O.D.O.T. DISTRICT 2 SURVEY OFFICE (USE ONLY)

PERSONNEL

REFERENCE NO. 56 A

SHEET 11 OF 33

NOTES RHOADES

DATE 8/19/22

ROUTE SR 105

H.C. AUBLE

WEATHER SUNNY

COUNTY WOOD

R.C. NIESE

TEMP. 64°

TOWNSHIP WEBSTER

SECTION 8

DWG BY RHOADES

PID PAVETRAIN

T 5 N R 12 E

TYPE MONUMENT P.K./WASHER

ON SURFACE - ~~BELOW~~ ON

OFFSET Q PAVEMENT ON LT : RT

- TO - EDGE PAVEMENT


STATION: 339+49.01

HORZ.DATUM: NAD83 2011


GEOID: NAVD88 2018

GRID: NORTHING: 635037.731

EASTING: 1690801.323

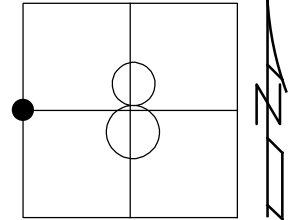

RECORD:
ORIGIN UNKNOWN
FD P.K./WASHER
REFA56
10/11/11, RJL
FD P.K./WASHER
6/11/13, SDC
SET MAG/WASHER
FINREFA56
10/3/13, SDC
FD P.K./WASHER
8/19/22, DSA
REF56A
3/2/23, DSA

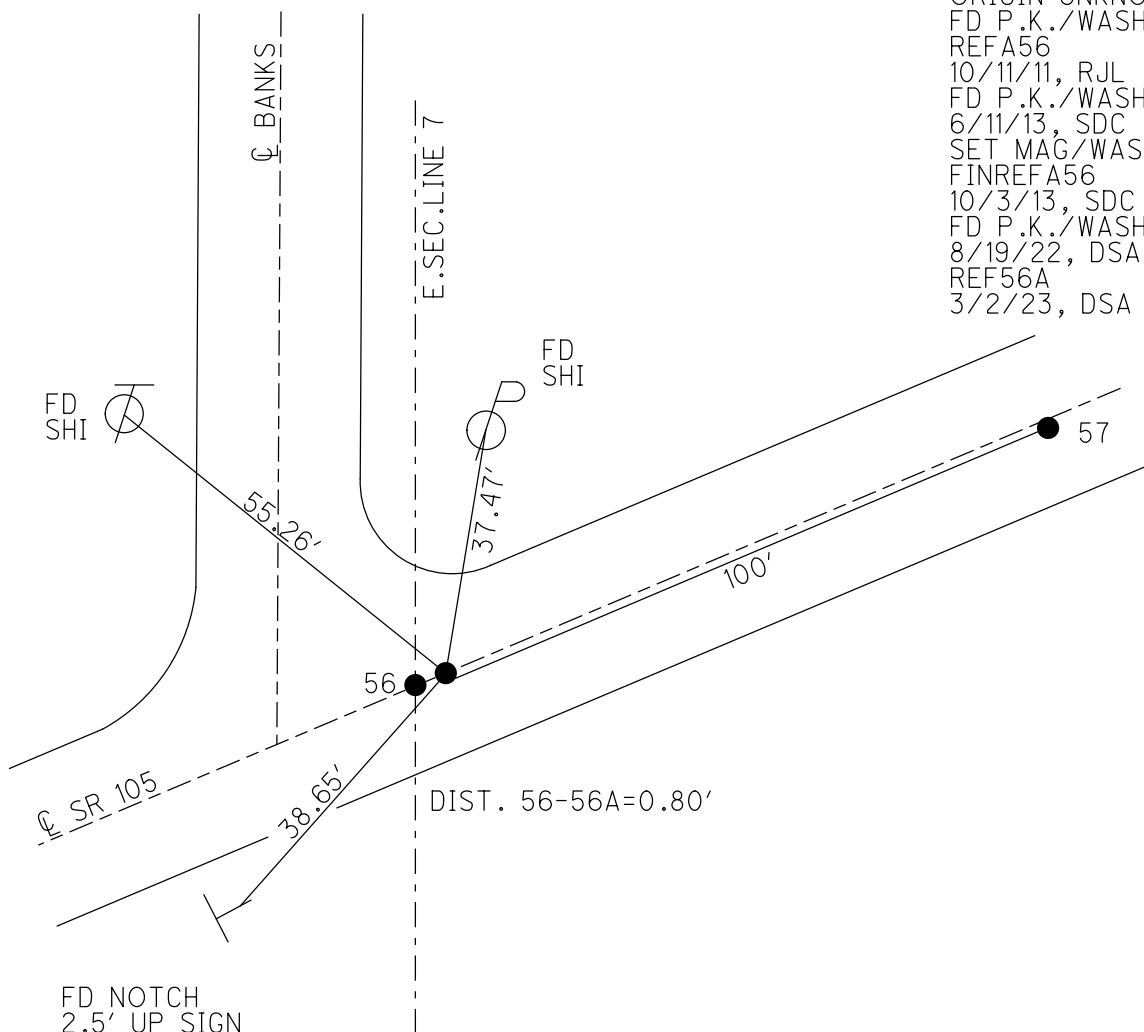

O.D.O.T. DISTRICT 2 SURVEY OFFICE (USE ONLY)

PERSONNEL

REFERENCE NO. 57

SHEET 12 OF 33

NOTES _____ RHOADES

DATE 8/19/22

ROUTE SR 105

H.C. AUBLE

WEATHER SUNNY

COUNTY WOODR.C. NIESE

TEMP. 64°

TOWNSHIP WEBSTER

SECTION

8

T_5_N R_12_E

DWG BY RHOADESPID PAVETRAIN

TYPE MONUMENT MAG/WASHER

ON SURFACE - ~~BELOW~~ ON

OFFSET C PAVEMENT 0.8' ~~LT~~ : RT


____TO____ EDGE PAVEMENT

STATION: 340+49.09


HORZ.DATUM: NAD83 2011

GEOID: NAVD88 2018

GRID: NORTHING: 635078.143

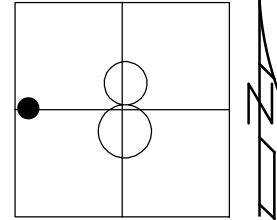EASTING: 1690892.877

RECORD P.I.
STA. 341+70.30
 $\Delta = 5^{\circ}40'20''$ LT
SET AG/WASHER
REF57
10/11/11, RJL
FD MAG/WASHER
6/11/13, SDC
SET MAG/WASHER
FINREF57
10/3/13, SDC
FD MAG/WASHER
8/19/22, DSA
REF57
3/2/23, DSA

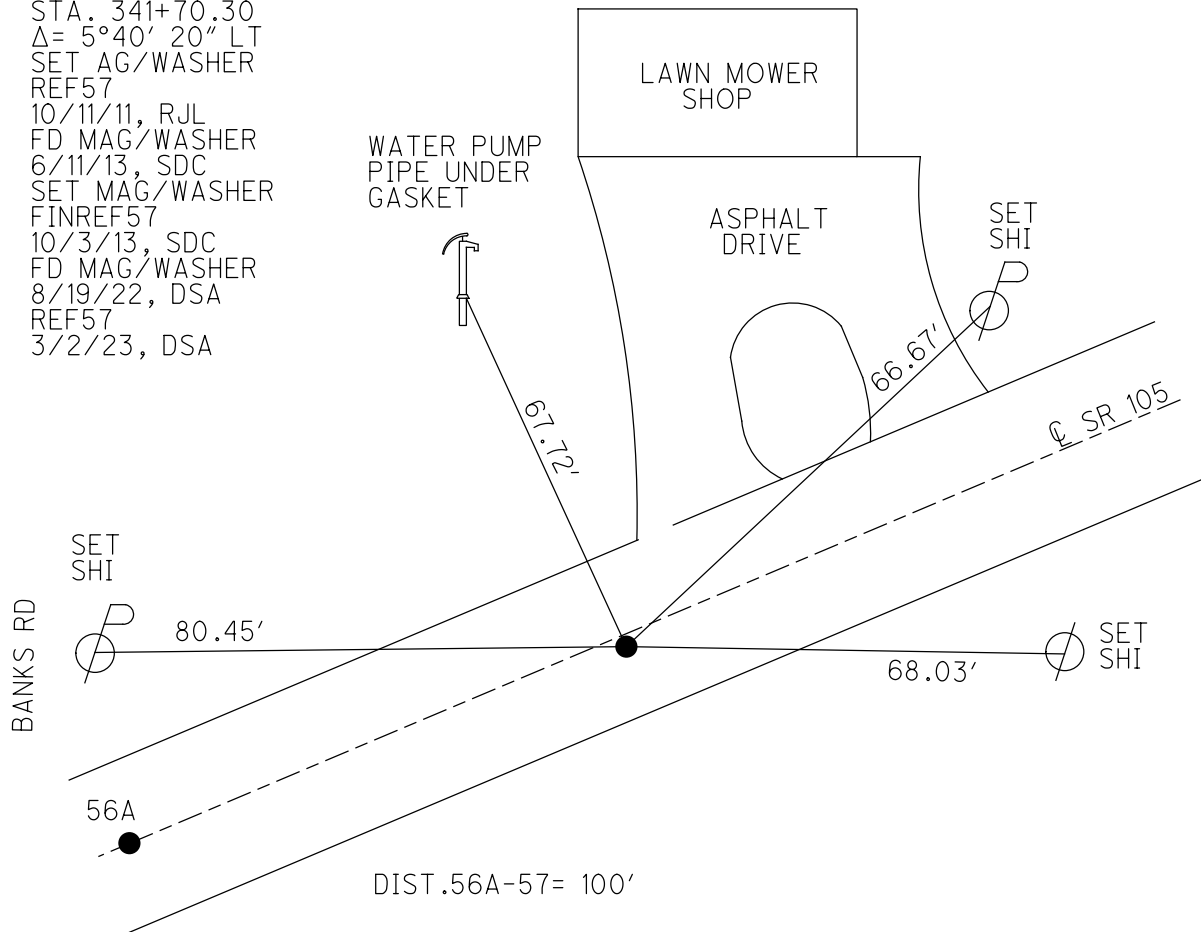

O.D.O.T. DISTRICT 2 SURVEY OFFICE (USE ONLY)

PERSONNEL

REFERENCE NO. 57 A

SHEET 13 OF 33

NOTES CHANEY DATE 8/1/94

H.C. RIPPLE WEATHER FAIR

R.C. BARBOUR TEMP. 80°

ROUTE SR 105

COUNTY WOOD

TOWNSHIP WEBSTER

SECTION 8

DWG BY RHOADES PID

T 5 N R 12 E

TYPE MONUMENT P.K./WASHER

ON SURFACE - ~~BELOW~~ ON


OFFSET Q PAVEMENT ON LT : RT

- TO - EDGE PAVEMENT


STATION: 346+40.85

HORZ.DATUM: GEOID:

GRID: NORTHING: EASTING:

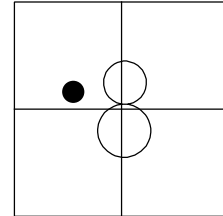

RECORD:
STA. 347+61.76
DNF POINT
10/20/11, RJL

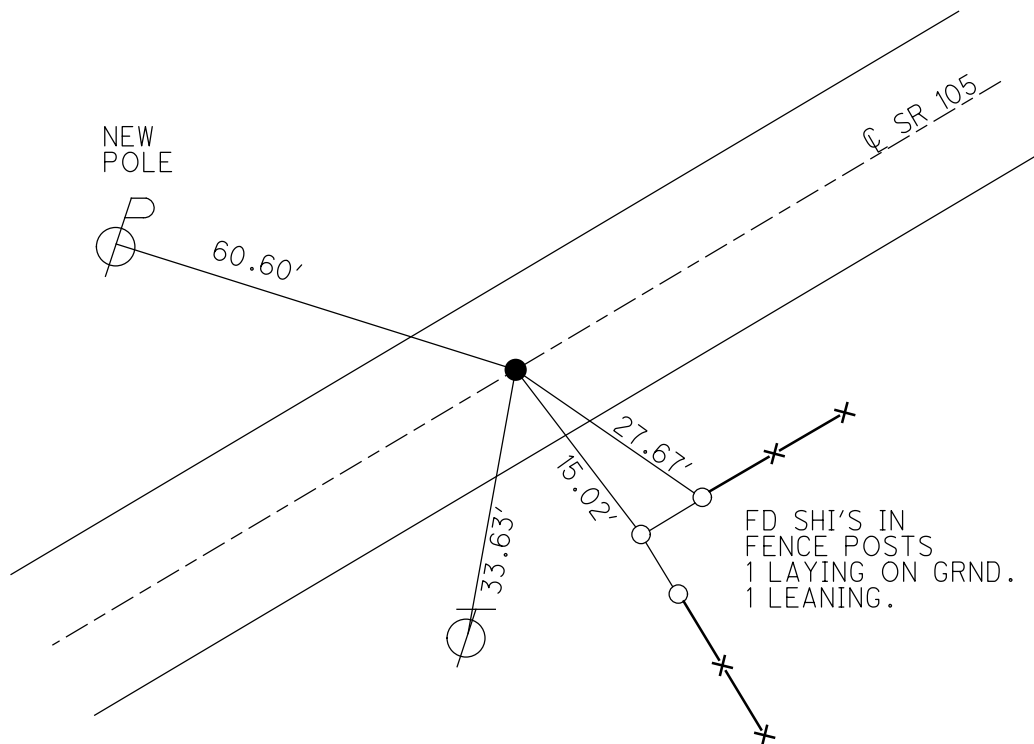

O.D.O.T. DISTRICT 2 SURVEY OFFICE (USE ONLY)

PERSONNEL

REFERENCE NO. 58

SHEET 14 OF 33

NOTES CHANEY

DATE 8/1/94

ROUTE SR 105

H.C. RIPPLE

WEATHER FAIR

COUNTY WOOD

R.C. BARBOUR

TEMP. 80°

TOWNSHIP WEBSTER

DWG BY RHOADES PID

SECTION 8

T 5 N R 12 E

TYPE MONUMENT STAKE

ON SURFACE - ~~BELOW~~ ON



OFFSET CL PAVEMENT - LT : ~~RT~~

143.5' TO LT EDGE PAVEMENT

STATION: 354+87.01

HORZ.DATUM: GEOID:

GRID: NORTHING: EASTING:

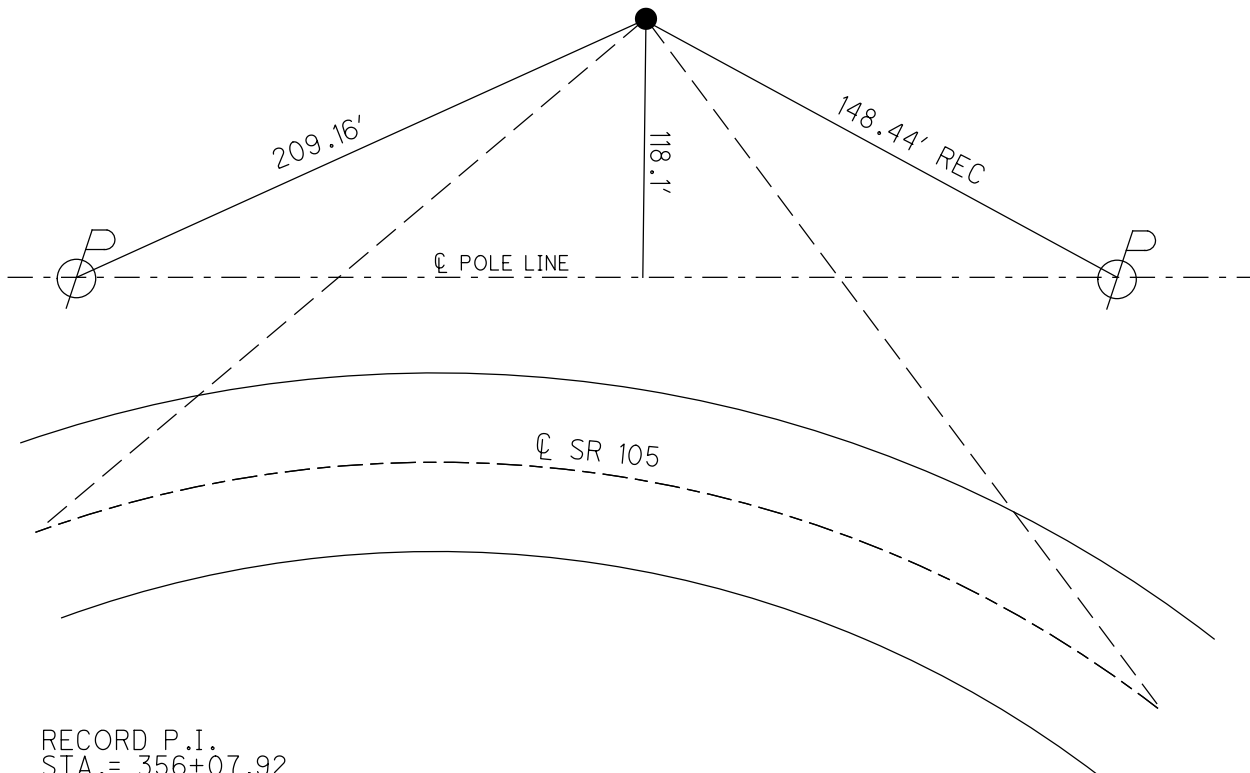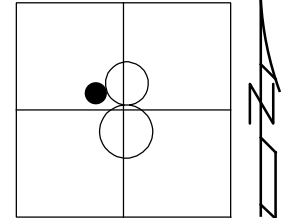

RECORD P.I.
STA.= 356+07.92
DNF POINT, HOWEVER
RECORD TIES DID CROSS
WHEN PULLED. SET STAKE,
143.5' S. TO N. EP. 8/1/94
D.N.F.
10/20/11, RJL

O.D.O.T. DISTRICT 2 SURVEY OFFICE (USE ONLY)

PERSONNEL

REFERENCE NO. 59

SHEET 15 OF 33

NOTES CHANEY

DATE 8/1/94

ROUTE SR 105

H.C. RIPPLE

WEATHER FAIR

COUNTY WOOD

R.C. BARBOUR

TEMP. 80°

TOWNSHIP WEBSTER

SECTION 8

DWG BY RHOADES

PID

T 5 N R 12 E

TYPE MONUMENT 3/4" IPID "ODOT CP"

~~ON SURFACE~~ - BELOW 2"

OFFSET CL PAVEMENT 30' ~~LT~~ : RT

20.2' TO RT EDGE PAVEMENT


STATION: 363+77.66

HORZ.DATUM: NAD83


GEOID: NAVD88 2009

GRID: NORTHING: 635040.236

EASTING: 1692628.631

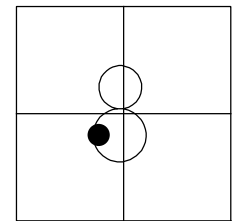

RECORD P.I.
STA. 364+98.57
 $\Delta = 43^\circ 34' 20''$ LT
FD 3/4" IPIPE
8/1/94, RC
FD 3/4" IPID
"ODOT CP"
REFA59
10/20/11, RJL

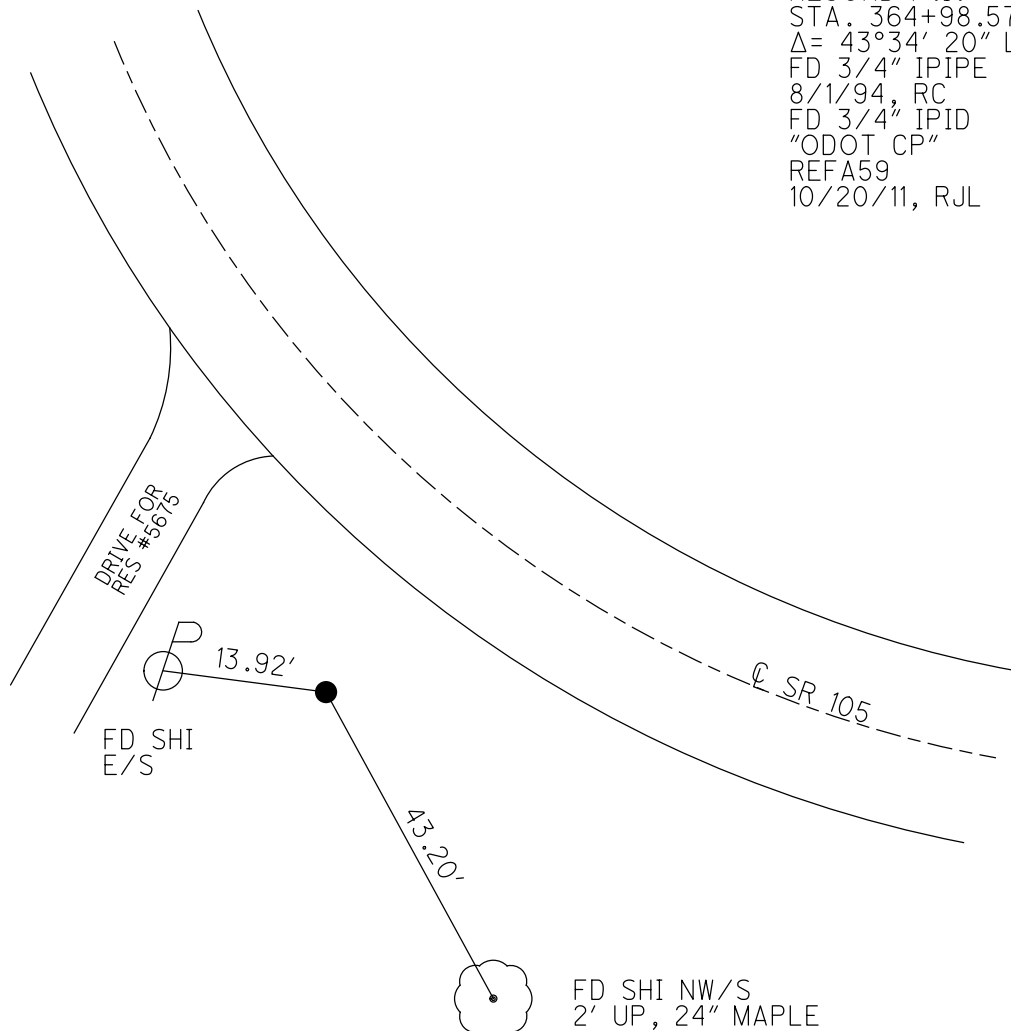

O.D.O.T. DISTRICT 2 SURVEY OFFICE (USE ONLY)

PERSONNEL

REFERENCE NO. 59 A

SHEET 16 OF 33

NOTES RHOADES

DATE 8/18/22

ROUTE SR 105

H.C. AUBLE

WEATHER SUNNY

COUNTY WOOD

R.C. NIESE

TEMP. 80°

TOWNSHIP WEBSTER

SECTION 8

DWG BY RHOADES

PID PAVETRAIN

T 5 N R 12 E

TYPE MONUMENT P.K./WASHER

ON SURFACE - ~~BELOW~~ ON

OFFSET CL PAVEMENT 0.9' ~~LT~~ : RT

9.8' TO RT EDGE PAVEMENT



STATION: 370+16.74

HORZ.DATUM: NAD83 2011

GEOID: NAVD88 2018

GRID: NORTHING: 634847.104

EASTING: 1693442.746

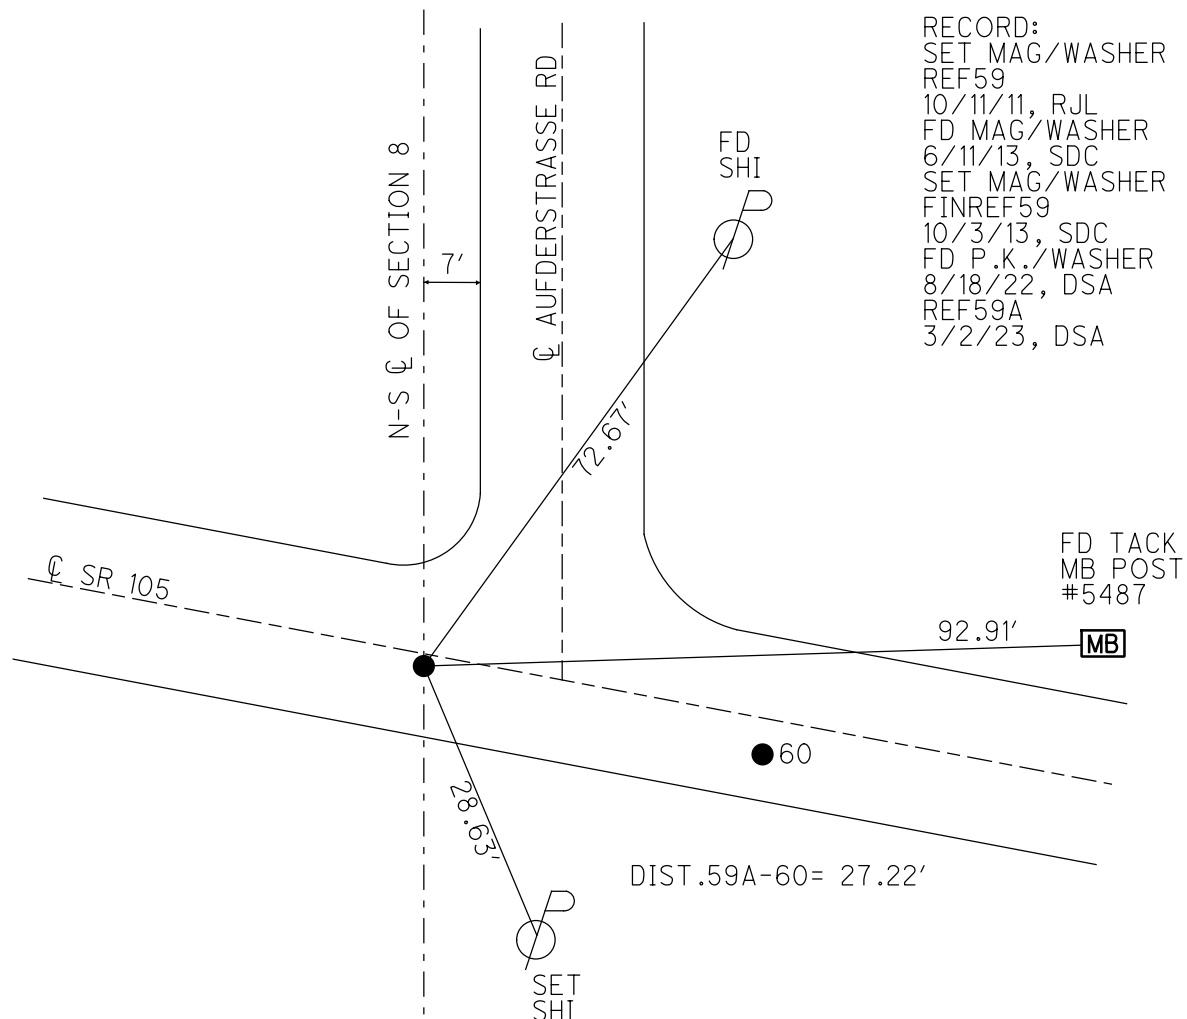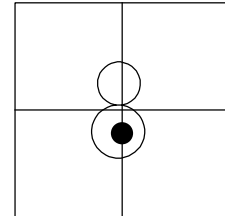

O.D.O.T. DISTRICT 2 SURVEY OFFICE (USE ONLY)

PERSONNEL

REFERENCE NO. 60

SHEET 17 OF 33

NOTES RHOADES

DATE 8/18/22

ROUTE SR 105

H.C. AUBLE

WEATHER SUNNY

COUNTY WOOD

R.C. NIESE

TEMP. 80°

TOWNSHIP WEBSTER

SECTION 8

DWG BY RHOADES

PID PAVETRAIN

T 5 N R 12 E

TYPE MONUMENT P.K./WASHER

ON SURFACE - ~~BELOW~~ ON

OFFSET CL PAVEMENT 3.3' ~~LT~~ : RT

6.5' TO RT EDGE PAVEMENT


STATION: 370+43.85

HORZ.DATUM: NAD83 2011


GEOID: NAVD88 2018

GRID: NORTHING: 634839.741

EASTING: 1693468.941

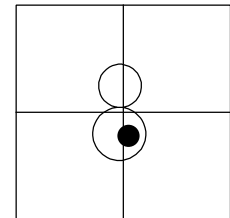

RECORD: P.I.
STA.= 373+62.28
 $\Delta = 8^{\circ}40'00''$ LT
FD P.K. SHANK
REF60
10/11/11, RJL
6/11/13, SDC
SET MAG/WASHER
FINREF60
10/3/13, SDC
FD P.K./WASHER
8/18/22, DSA
REF60
3/2/23, DSA

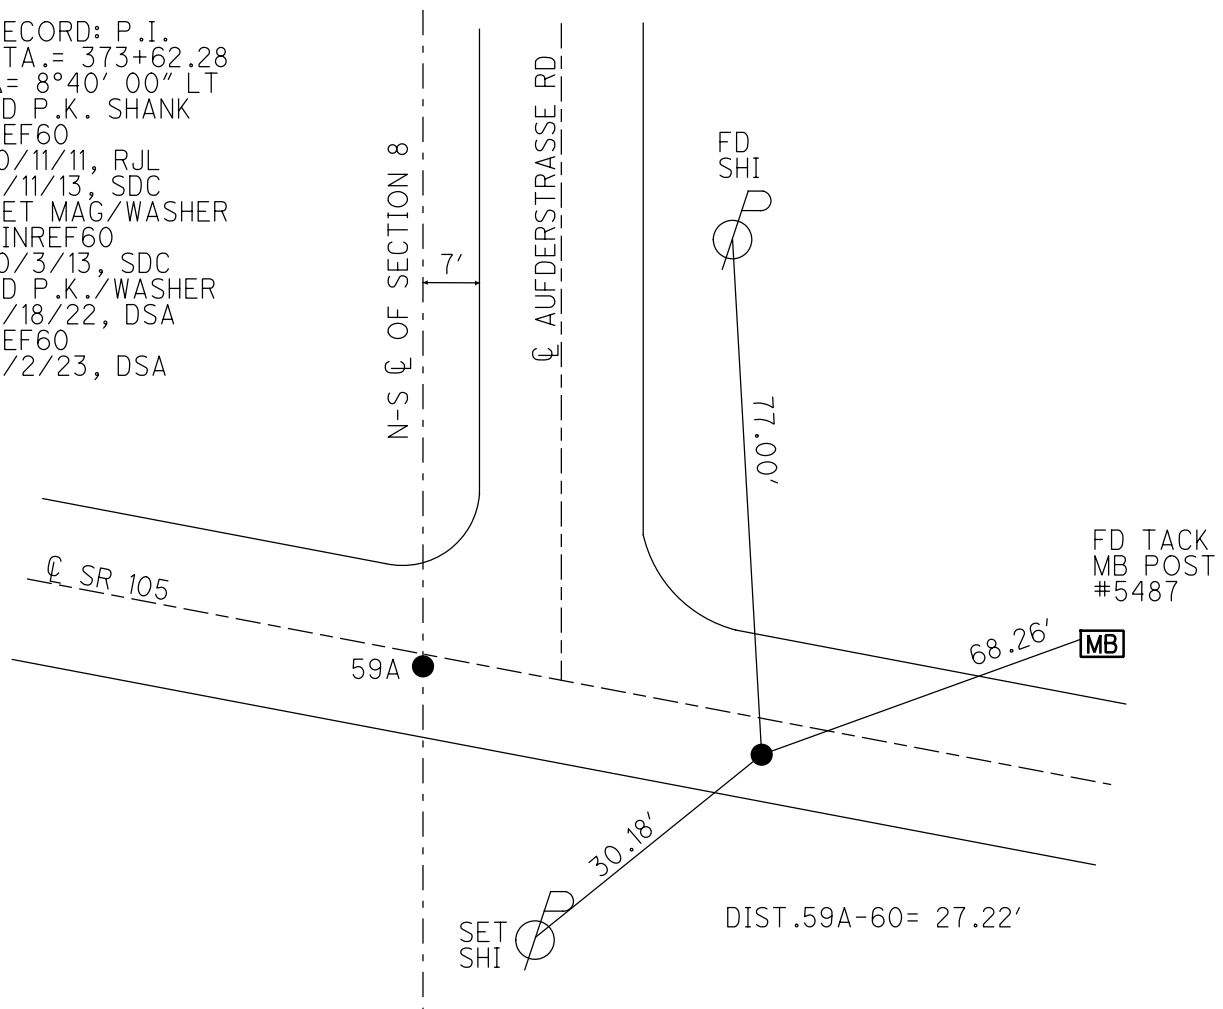

O.D.O.T. DISTRICT 2 SURVEY OFFICE (USE ONLY)

PERSONNEL

REFERENCE NO. 61

SHEET 18 OF 33

NOTES HOMAN

DATE 8/18/22

ROUTE SR 105

H.C. HOMAN

WEATHER SUNNY

COUNTY WOOD

R.C. CODER

TEMP. 80°

TOWNSHIP WEBSTER

DWG BY RHOADES

PID PAVETRAIN

SECTION 8

T 5 N R 12 E

TYPE MONUMENT 1 1/4" IPIPE

~~ON SURFACE~~ - BELOW 1"

OFFSET ¢ PAVEMENT 20.8' ~~LT~~ : RT

9.9' TO RT EDGE PAVEMENT


STATION: 374+95.76

HORZ.DATUM: NAD83


GEOID: NAVD88 2009

GRID: NORTHING: 634802.215

EASTING: 1693919.138

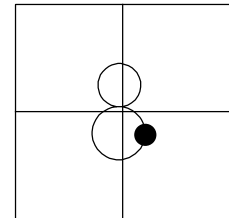

RECORD: P.I.
STA.= 378+14.44
 $\Delta = 29^{\circ}49'20''$ LT
FD 1 1/4" IPIPE
REF61
10/11/11, RJL

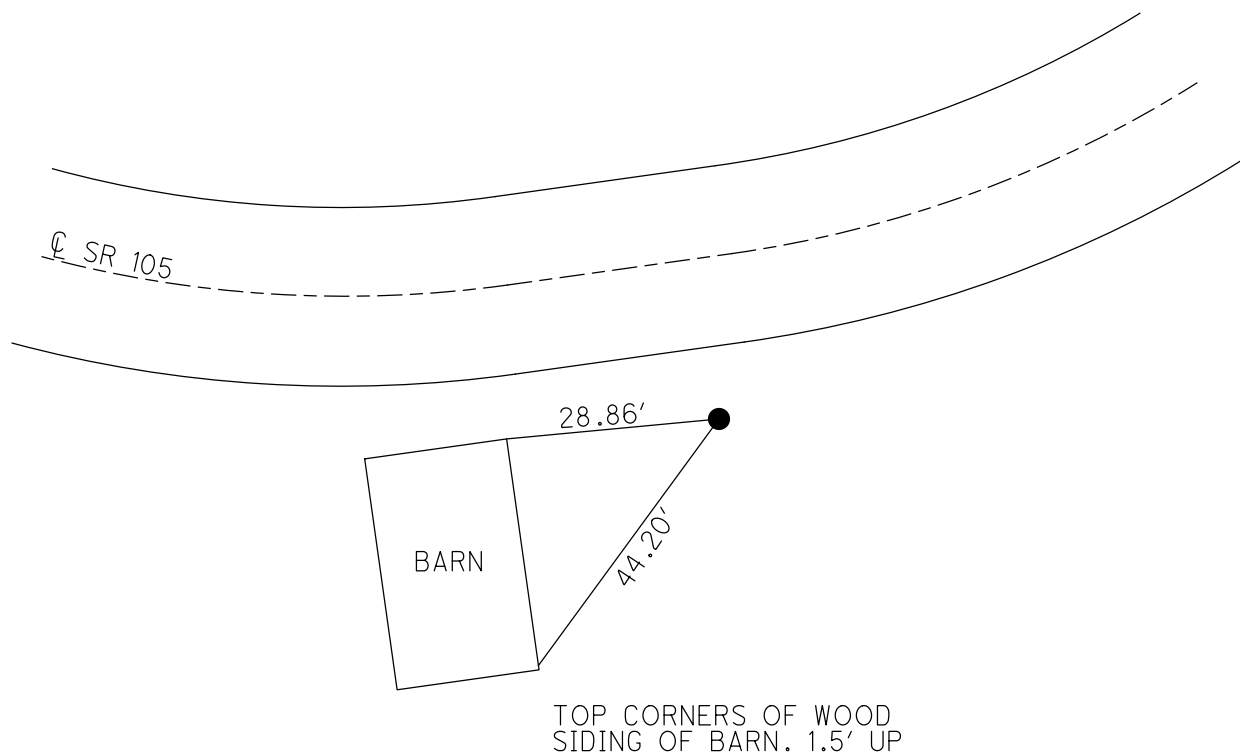

O.D.O.T. DISTRICT 2 SURVEY OFFICE (USE ONLY)

PERSONNEL

REFERENCE NO. 62

SHEET 19 OF 33

NOTES RHOADES

DATE 8/18/22

ROUTE SR 105

H.C. AUBLE

WEATHER SUNNY

COUNTY WOOD

R.C. NIESE

TEMP. 80°

TOWNSHIP WEBSTER

DWG BY RHOADES

PID PAVETRAIN

SECTION 8

T 5 N R 12 E

TYPE MONUMENT MAG/WASHER

ON SURFACE - ~~BELOW~~ ON

OFFSET Q PAVEMENT 6' LT : ~~RT~~

3.5' TO LT EDGE PAVEMENT



STATION: 381+06.64

HORIZ.DATUM: NAD83 2011

GEOID: NAVD88 2018

GRID: NORTHING: 635061.156

EASTING: 1694472.435

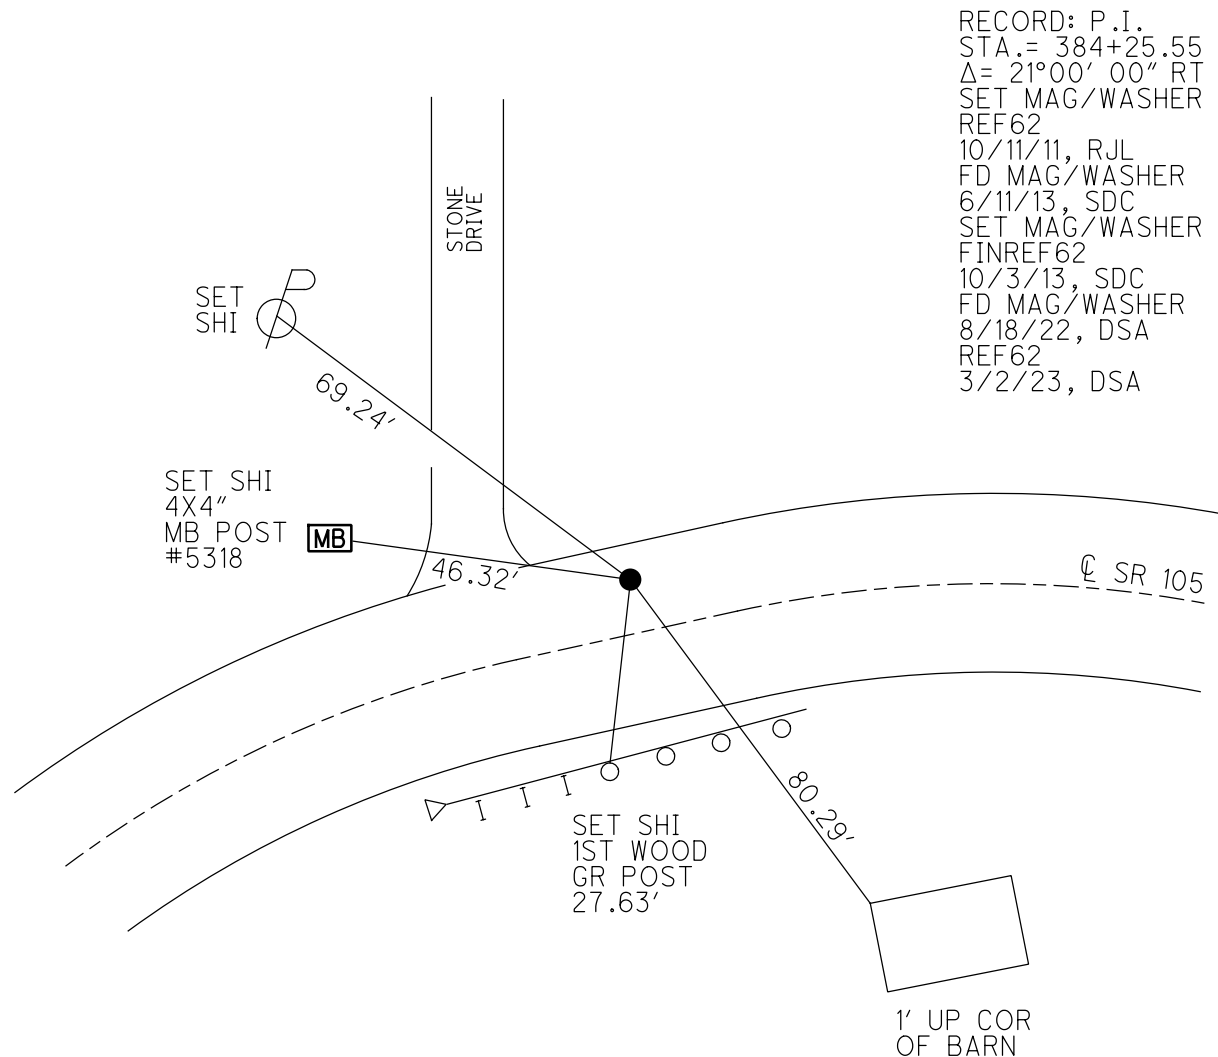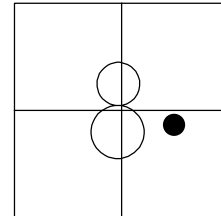

O.D.O.T. DISTRICT 2 SURVEY OFFICE (USE ONLY)

PERSONNEL

REFERENCE NO. 63

SHEET 20 OF 33

NOTES RHOADES

DATE 8/18/22

ROUTE SR 105

H.C. AUBLE

WEATHER SUNNY

COUNTY WOOD

R.C. NIESE

TEMP. 80°

TOWNSHIP WEBSTER

SECTION 8

DWG BY RHOADES

PID PAVETRAIN

T 5 N R 12 E

TYPE MONUMENT MAG/WASHER

ON SURFACE - ~~BELOW~~ ON

OFFSET Q PAVEMENT 10.3' LT : ~~RT~~

0.2' TO LT EDGE PAVEMENT


STATION: 384+97.17

HORZ.DATUM: NAD83 2011


GEOID: NAVD88 2018

GRID: NORTHING: 635105.322

EASTING: 1694860.543

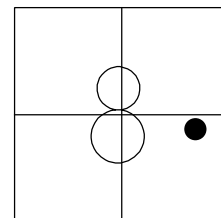

RECORD: P.I.
RE-ESTABLISHED
9/16/88, HOFFMAN
 $\Delta = 18^{\circ}19'51''$ RT
FD P.K./WASHER
REF63
10/11/11, RJL
6/11/13, SDC
SET MAG/WASHER
FINREF63
10/3/13, SDC
FD MAG/WASHER
8/18/22, DSA
REF63
3/2/23, DSA

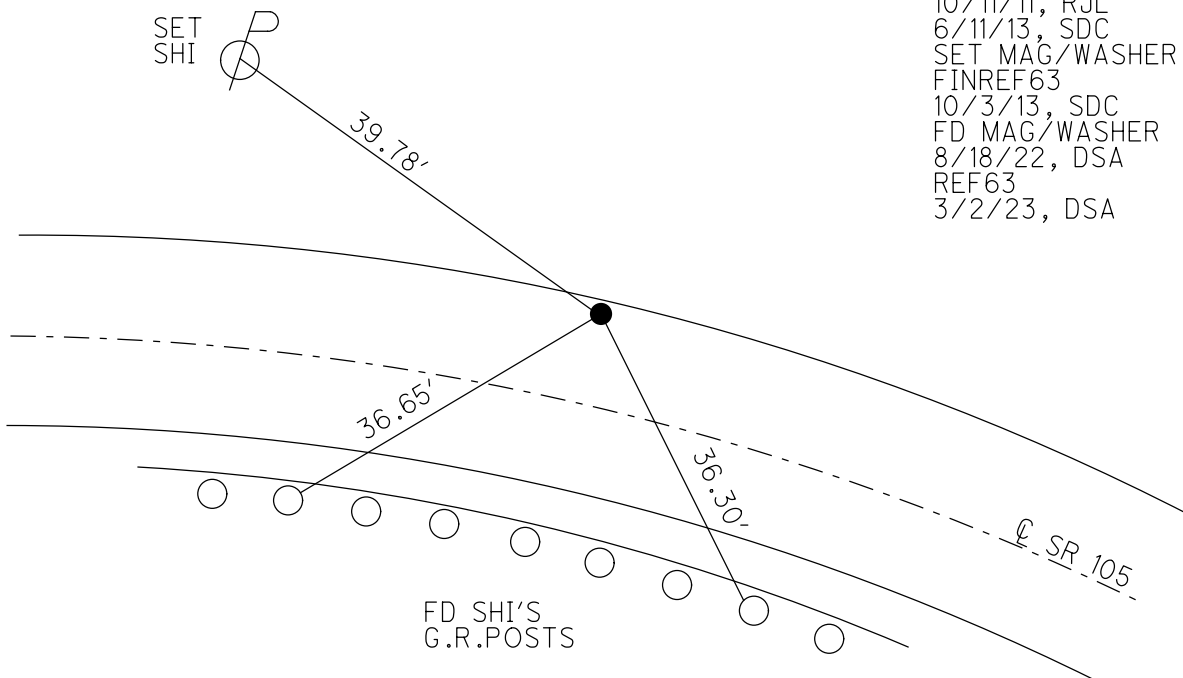

O.D.O.T. DISTRICT 2 SURVEY OFFICE (USE ONLY)

PERSONNEL

REFERENCE NO. 64

SHEET 21 OF 33

NOTES RHOADES

DATE 8/18/22

ROUTE SR 105

H.C. AUBLE

WEATHER SUNNY

COUNTY WOOD

R.C. NIESE

TEMP. 80°

TOWNSHIP WEBSTER

SECTION 8

DWG BY RHOADES PID PAVETRAIN

T 5 N R 12 E

TYPE MONUMENT MAG/WASHER

ON SURFACE - ~~BELOW~~ ON

OFFSET 0.5' TO RT EDGE PAVEMENT


STATION: 388+36.17

HORIZ.DATUM: NAD83 2011


GEOID: NAVD88 2018

GRID: NORTHING: 635035.491

EASTING: 1695192.254

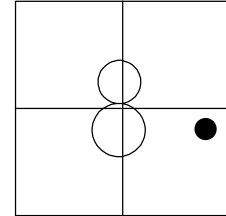

RECORD: P.I.
RE-ESTABLISHED
9/16/88, HOFFMAN
 $\Delta = 21^{\circ}56'15''$ RT
FD P.K.SHANK
REF64
10/11/11, RJL
6/11/13, SDC
SET MAG/WASHER
FINREF64
10/3/13, SDC
FD MAG/WASHER
8/18/22, DSA
REF64
3/2/23, DSA

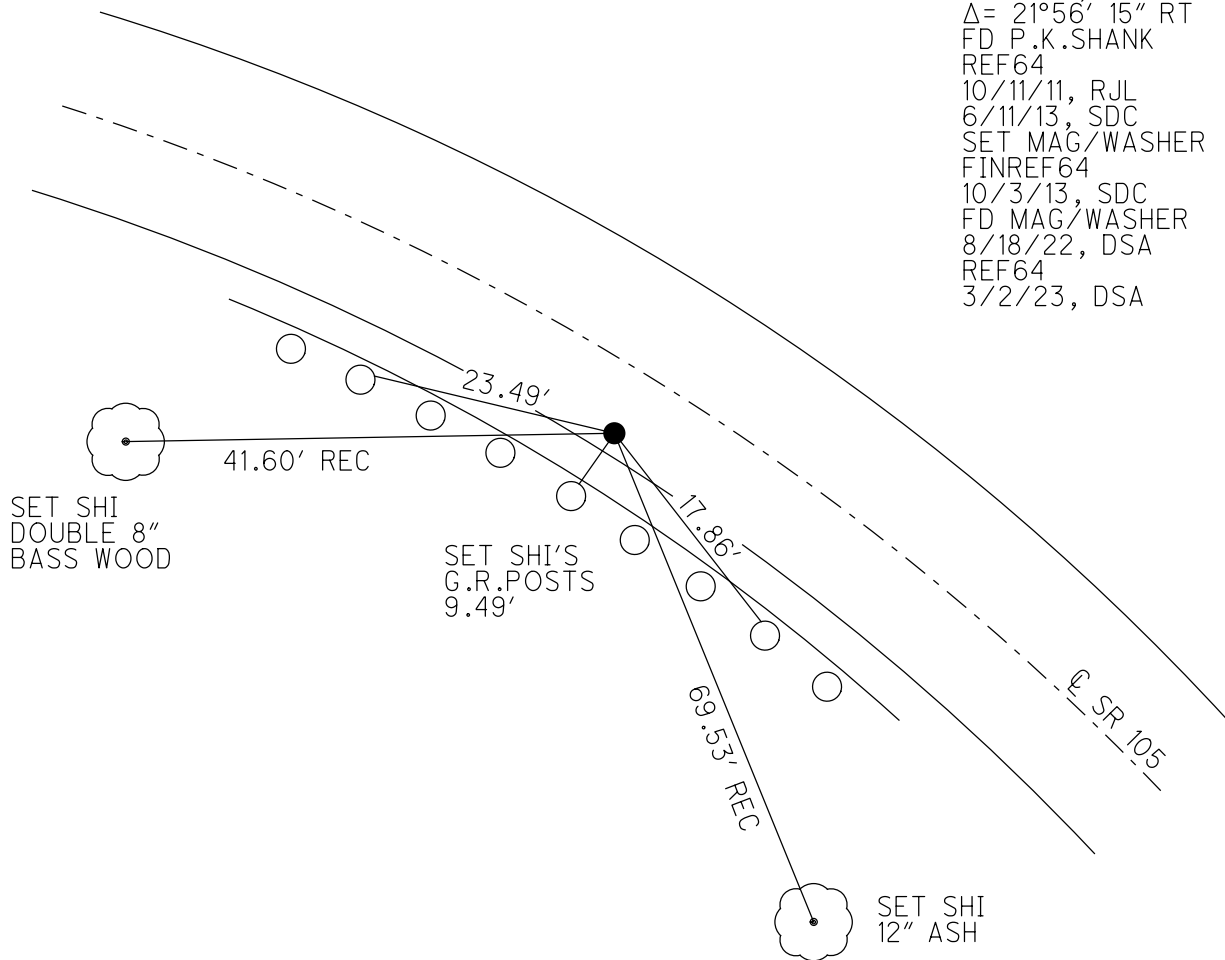

O.D.O.T. DISTRICT 2 SURVEY OFFICE (USE ONLY)

PERSONNEL

REFERENCE NO. 65

SHEET 22 OF 33

NOTES RHOADES

DATE 8/18/22

ROUTE SR 105

H.C. AUBLE

WEATHER SUNNY

COUNTY WOOD

R.C. NIESE

TEMP. 80°

TOWNSHIP WEBSTER

SECTION 8

DWG BY RHOADES PID PAVETRAIN

T 5 N R 12 E

TYPE MONUMENT MAG/WASHER

ON SURFACE - ~~BELOW~~ ON

OFFSET CL PAVEMENT 11.7' ± : RT

0.4' TO RT EDGE PAVEMENT


STATION: 391+24.52

HORIZ.DATUM: NAD83 2011


GEOID: NAVD88 2018

GRID: NORTHING: 634875.159

EASTING: 1695431.925

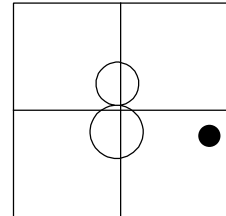

RECORD: P.I.
 $\Delta = 20^{\circ}09'00''$ RT
FD RUSTED P.K.NAIL
SET MAG/WASHER
REF65
10/11/11, RJL
6/11/13, SDC
SET MAG/WASHER
FINREF65
10/3/13, SDC
FD MAG/WASHER
8/18/22, DSA
REF65
3/2/23, DSA

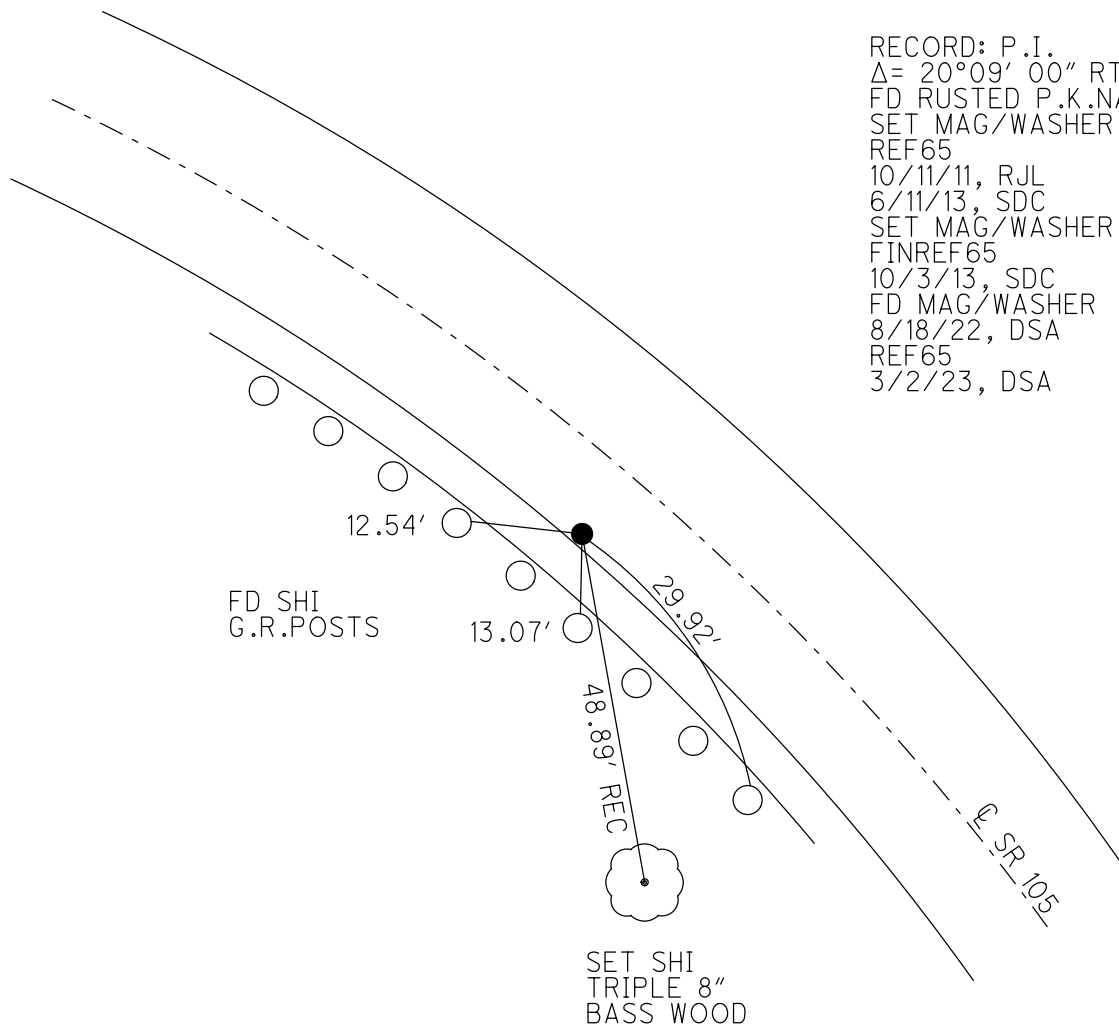

O.D.O.T. DISTRICT 2 SURVEY OFFICE (USE ONLY)

PERSONNEL

REFERENCE NO. 66

SHEET 23 OF 33

NOTES HOMAN

DATE 6/11/13

ROUTE SR 105

H.C. HOMAN

WEATHER PT.CLOUDY

COUNTY WOOD

R.C. CODER

TEMP. 84°

TOWNSHIP WEBSTER

SECTION 8

DWG BY RHOADES

PID

T 5 N R 12 E

TYPE MONUMENT LG.R.R.SPIKE

~~ON SURFACE~~ - BELOW 1/2"

OFFSET Q PAVEMENT - ~~LT~~ : RT

25' TO RT EDGE PAVEMENT


STATION: 394+47.30

HORZ.DATUM: NAD83


GEOID: NAVD88 2009

GRID: NORTHING: 634473.490

EASTING: 1696041.551

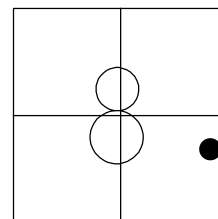

RECORD: P.I.
STA.= 397+60.41
 $\Delta = 32^{\circ}15'20''$ LT
FD LG.R.R.SPIKE
PAINTED YELLOW
REF66
10/11/11, RJL

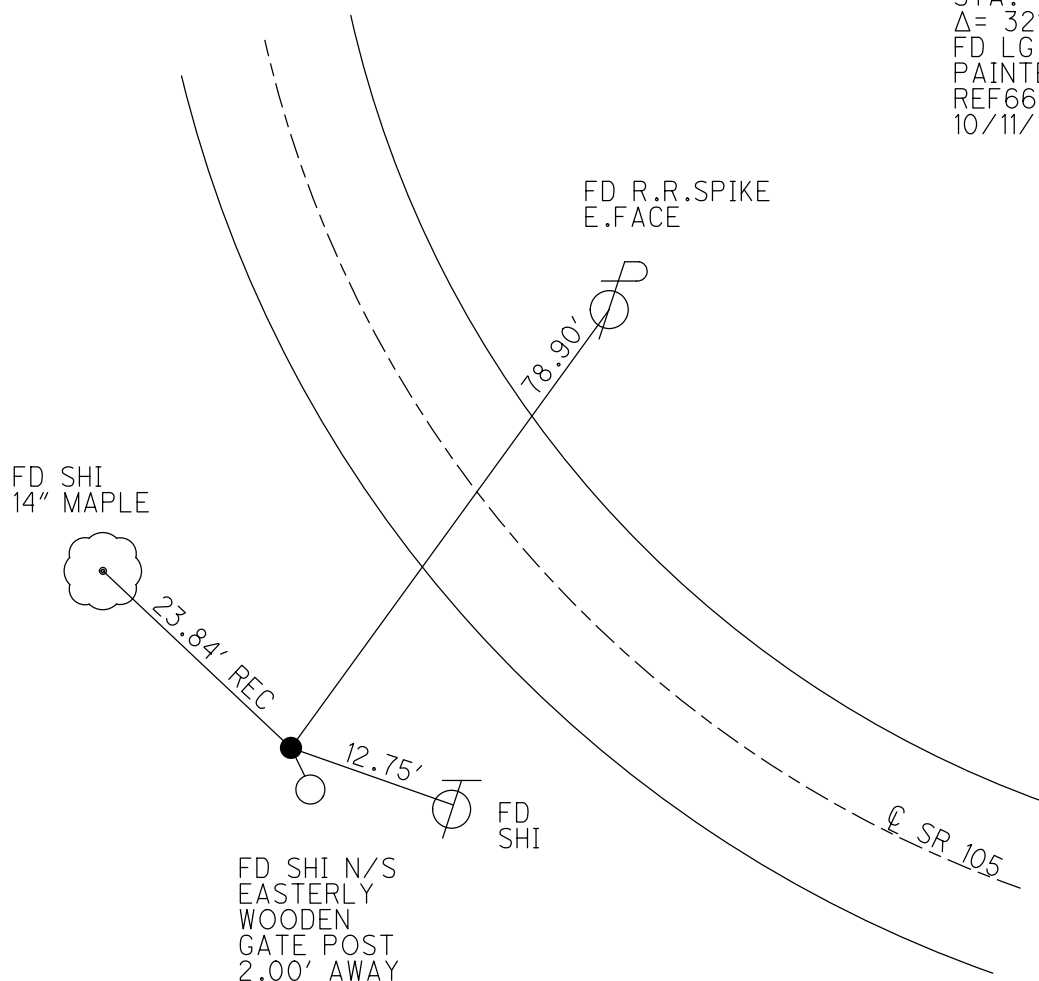

O.D.O.T. DISTRICT 2 SURVEY OFFICE (USE ONLY)

PERSONNEL

REFERENCE NO. 66 A

SHEET 24 OF 33

NOTES RHOADES

DATE 8/18/22

ROUTE SR 105

H.C. AUBLE

WEATHER SUNNY

COUNTY WOOD

R.C. NIESE

TEMP. 74°

TOWNSHIP WEBSTER

SECTION 8

DWG BY RHOADES

PID PAVETRAIN

T 5 N R 12 E

TYPE MONUMENT MAG/WASHER

ON SURFACE - ~~BELOW~~ ON

OFFSET CL PAVEMENT 0.5' ~~LT~~ : RT

10.5' TO RT EDGE PAVEMENT



STATION: 398+85.56

HORZ.DATUM: NAD83 2011

GEOID: NAVD88 2018

GRID: NORTHING: 634473.502

EASTING: 1696041.612

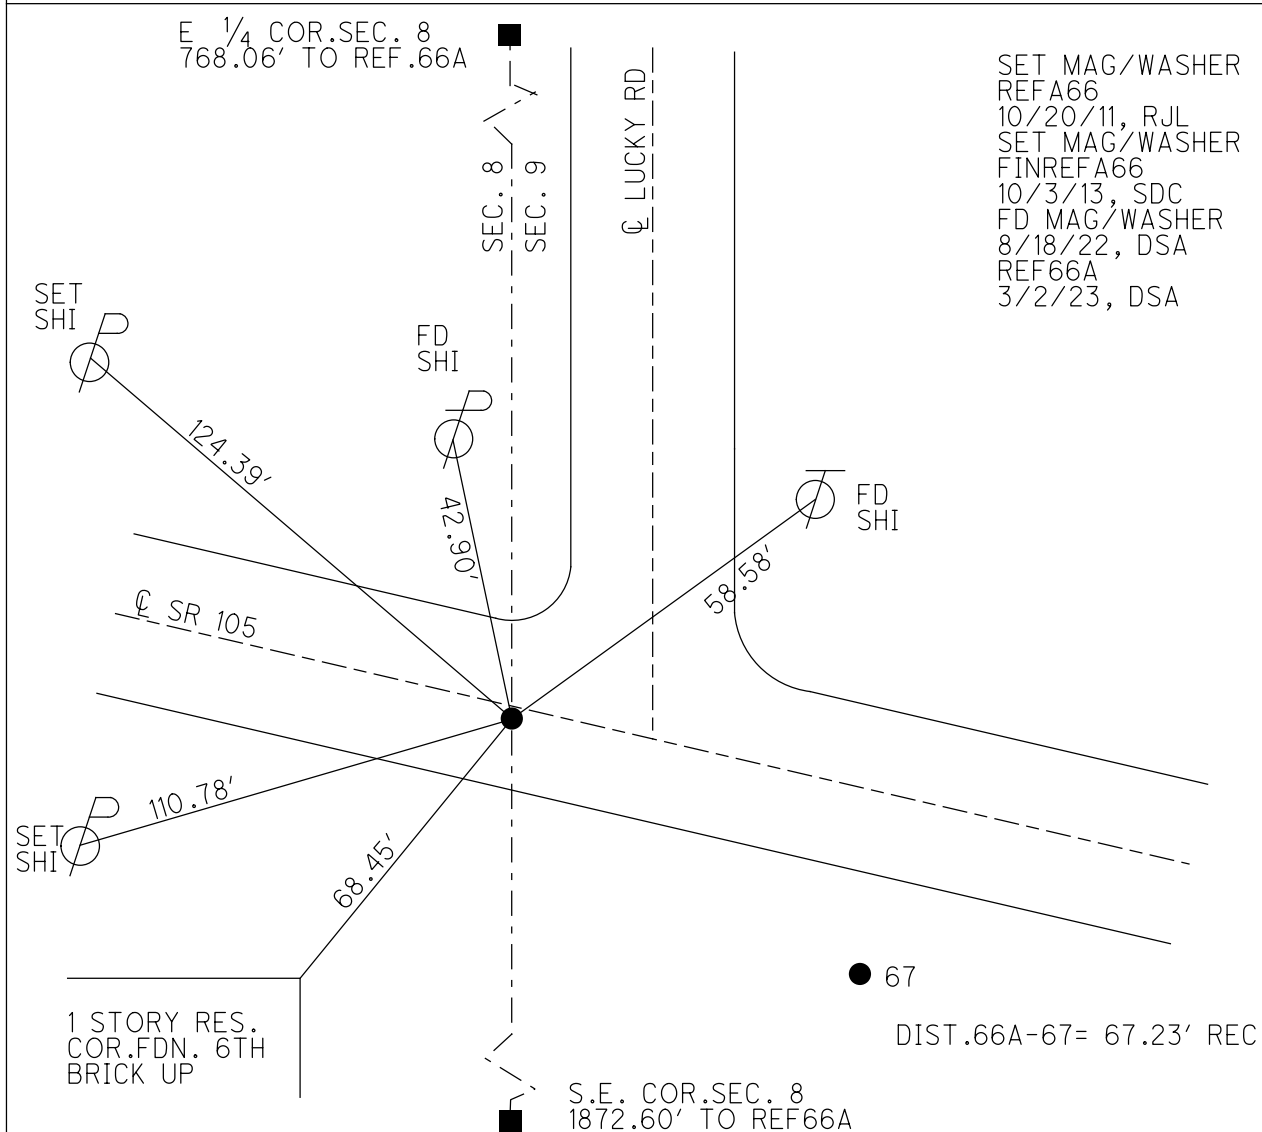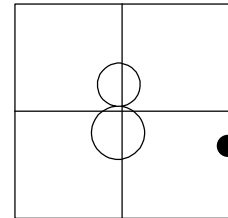

O.D.O.T. DISTRICT 2 SURVEY OFFICE (USE ONLY)

PERSONNEL

REFERENCE NO. 67

SHEET 25 OF 33

NOTES HOMAN

DATE 6/11/13

ROUTE SR 105

H.C. HOMAN

WEATHER SUNNY

COUNTY WOOD

R.C. CODER

TEMP. 84°

TOWNSHIP FREEDOM

SECTION 9

DWG BY RHOADES

PID _____

T 5 N R 12 E

TYPE MONUMENT R.R.SPIKE

~~ON SURFACE~~ - BELOW 0.6'

OFFSET CL PAVEMENT 14.5' ~~LT~~ : RT

5' TO RT EDGE PAVEMENT


STATION: 399+52.90

HORZ.DATUM: NAD83


GEOID: NAVD88 2009

GRID: NORTHING: 634443.799

EASTING: 1696101.850

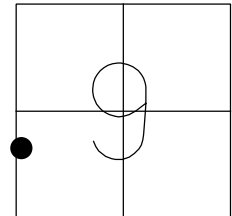

RECORD: P.I.
STA.= 402+65.72
 $\Delta = 16^{\circ}34'00''$ RT
FD R.R.SPIKE
REF67
10/20/11, RJL

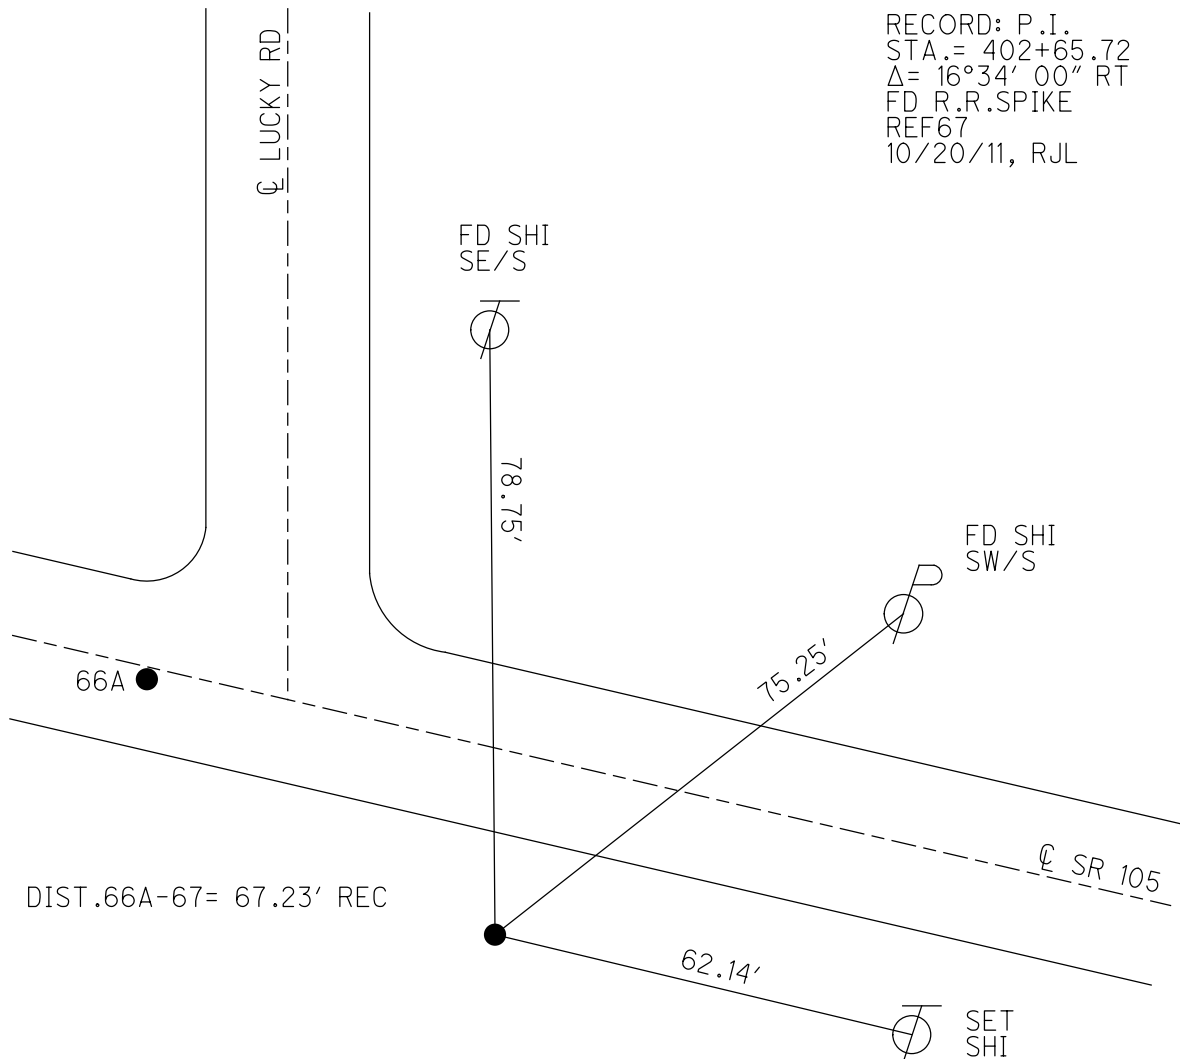

O.D.O.T. DISTRICT 2 SURVEY OFFICE (USE ONLY)

PERSONNEL

REFERENCE NO. 68

SHEET 25 OF 33

NOTES RHOADES

DATE 8/18/22

ROUTE SR 105

H.C. AUBLE

WEATHER SUNNY

COUNTY WOOD

R.C. NIESE

TEMP. 74°

TOWNSHIP FREEDOM

SECTION 9

DWG BY RHOADES

PID PAVETRAIN

T 5 N R 12 E

TYPE MONUMENT MAG/WASHER

ON SURFACE - ~~BELOW~~ ON

OFFSET CL PAVEMENT 8.5' ~~±~~ : RT

1.5' TO LT EDGE PAVEMENT


STATION: 411+81.83

HORZ.DATUM: NAD83 2011


GEOID: NAVD88 2018

GRID: NORTHING: 634364.159

EASTING: 1697328.456

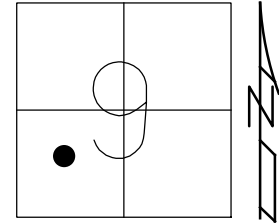

RECORD: P.I.
STA.= 414+95.43
 $\Delta = 10^{\circ}07' 20''$ RT
SET P.K./WASHER
11/8/94, CL
FD P.K.SHANK
REF68
10/11/11, RJL
6/10/13, SDC
SET MAG/WASHER
FINREF68
10/3/13, SDC
FD MAG/WASHER
8/18/22, DSA

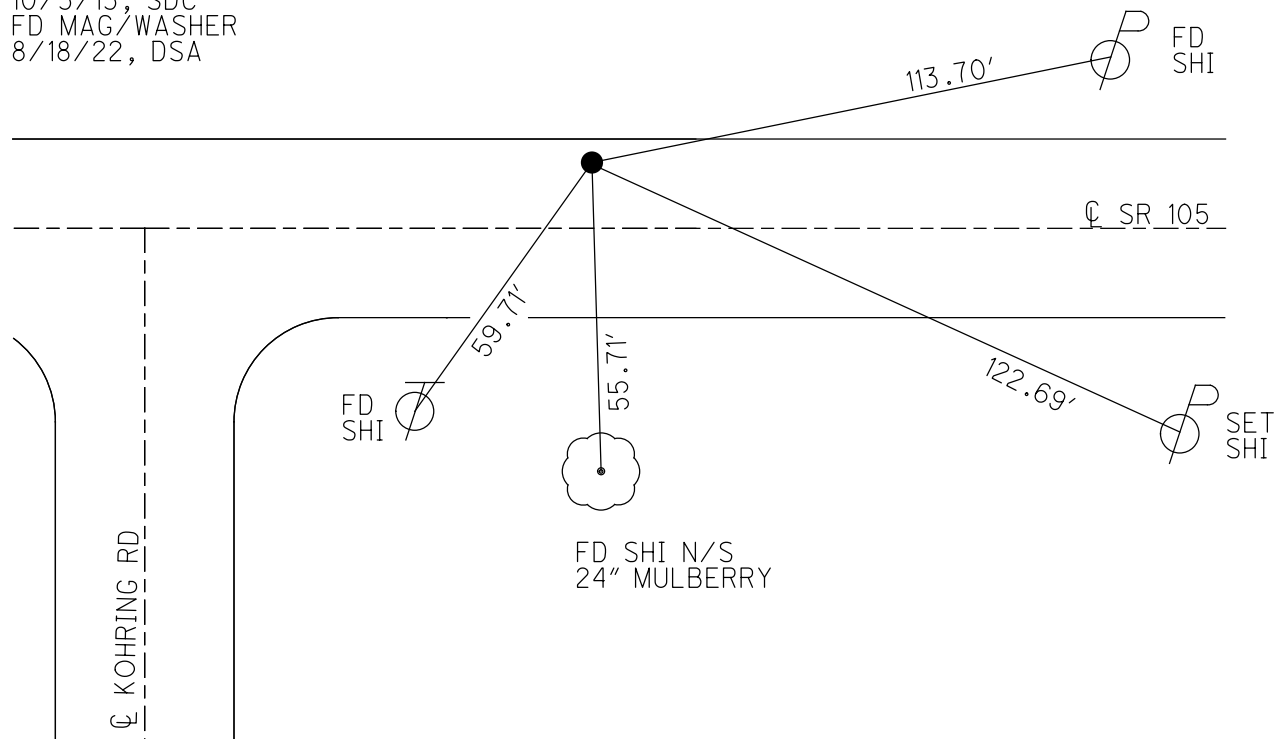

O.D.O.T. DISTRICT 2 SURVEY OFFICE (USE ONLY)

PERSONNEL

REFERENCE NO. 69

SHEET 27 OF 33

NOTES RHOADES

DATE 8/18/22

ROUTE SR 105

H.C. AUBLE

WEATHER SUNNY

COUNTY WOOD

R.C. NIESE

TEMP. 74°

TOWNSHIP FREEDOM

SECTION 9

DWG BY RHOADES

PID PAVETRAIN

T 5 N R 12 E

TYPE MONUMENT MAG/WASHER

ON SURFACE - ~~BELOW~~ ON

OFFSET $\varnothing$ PAVEMENT 3.6' ~~LT~~ : RT

6.8' TO RT EDGE PAVEMENT


STATION: 419+47.60

HORZ.DATUM: NAD83 2011


GEOID: NAVD88 2018

GRID: NORTHING: 634180.712

EASTING: 1698071.851

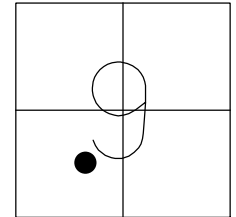

RECORD: P.I.
STA.= 422+61.15
 Δ = 4°14' 20" LT
SET P.K./WASHER
11/8/94, CL
FD P.K./WASHER
REF69
10/11/11, RJL
6/10/13, SDC
SET MAG/WASHER
FINREF69
10/3/13, SDC
FD MAG/WASHER
8/18/22, DSA
REF69
3/2/23, DSA

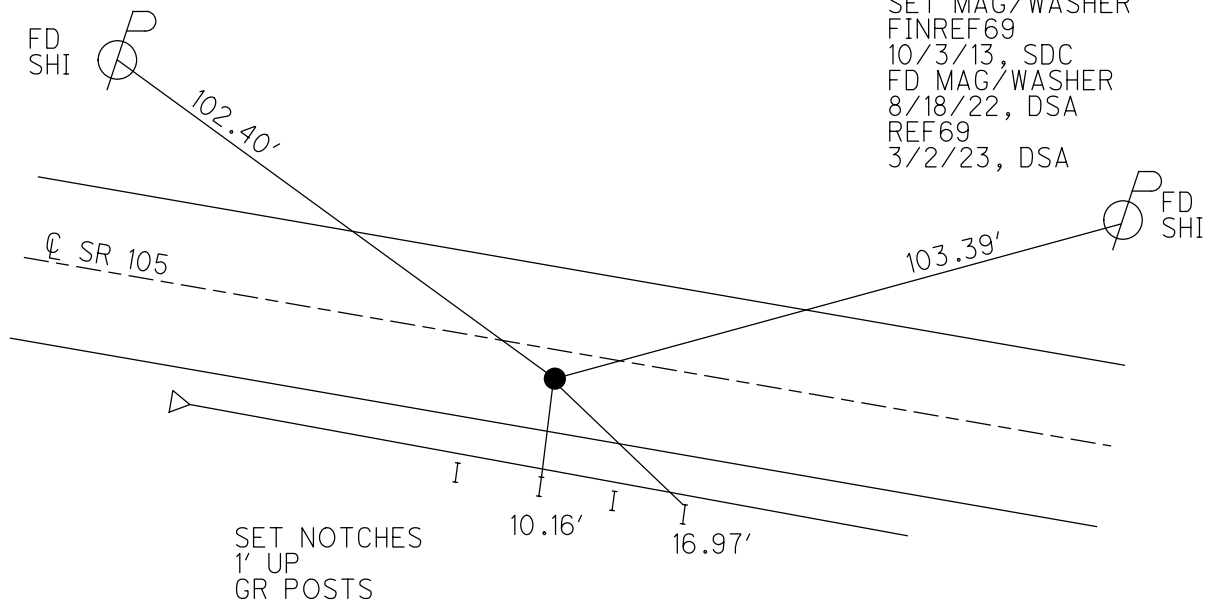

O.D.O.T. DISTRICT 2 SURVEY OFFICE (USE ONLY)

PERSONNEL

REFERENCE NO. 70

SHEET 28 OF 33

NOTES RHOADES

DATE 8/18/22

ROUTE SR 105

H.C. AUBLE

WEATHER SUNNY

COUNTY WOOD

R.C. NIESE

TEMP. 74°

TOWNSHIP FREEDOM

SECTION 9

DWG BY RHOADES

PID PAVETRAIN

T 5 N R 12 E

TYPE MONUMENT MAG/WASHER

ON SURFACE - ~~BELOW~~ ON

OFFSET CL PAVEMENT 9.9' ~~LT~~ : RT

6.8' TO RT EDGE PAVEMENT


STATION: 423+72.36

HORIZ.DATUM: NAD83 2011

GEOID: NAVD88 2018

GRID: NORTHING: 634109.828

EASTING: 1698490.546

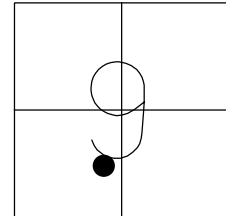

FD
SHI



129.22'

FD
SHI




38.00'

FD "+"
2" IPIPE
2.25' DOWN



69.25' REC

CL SR 105

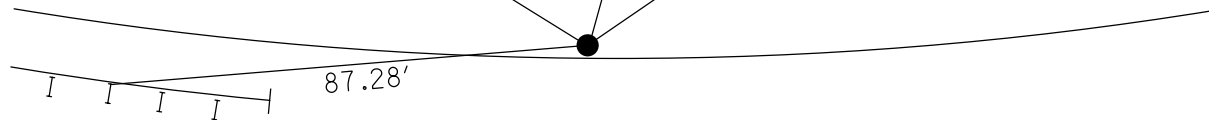

SET NOTCH
1' UP
GR POST

RECORD: P.I.
STA.= 426+85.79
 $\Delta = 16^{\circ}34'20''$ LT
SET P.K./WASHER
11/8/94, CL
SET MAG/WASHER
REF70
10/11/11, RJL
FD MAG/WASHER
6/10/13, SDC
SET MAG/WASHER
FINREF70
10/3/13, SDC
FD MAG/WASHER
8/18/22, DSA
REF70
3/2/23, DSA

O.D.O.T. DISTRICT 2 SURVEY OFFICE (USE ONLY)

PERSONNEL

REFERENCE NO. 71

SHEET 29 OF 33

NOTES RHOADES

DATE 8/18/22

ROUTE SR 105

H.C. AUBLE

WEATHER SUNNY

COUNTY WOOD

R.C. NIESE

TEMP. 74°

TOWNSHIP FREEDOM

SECTION 9

DWG BY RHOADES

PID PAVETRAIN

T 5 N R 12 E

TYPE MONUMENT MAG/WASHER

ON SURFACE - ~~BELOW~~ ON

OFFSET CL PAVEMENT ON LT : RT

9.7' TO LT EDGE PAVEMENT


STATION: 432+40.36

HORZ.DATUM: NAD83 2011


GEOID: NAVD88 2018

GRID: NORTHING: 634215.109

EASTING: 1699352.196

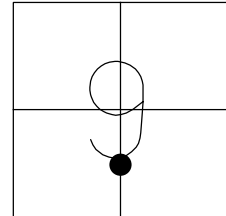

RECORD: P.I.
STA.= 435+54.22
 $\Delta = 0^{\circ}30' 20''$ RT
SET P.K./WASHER
11/8/94, CL
FD P.K./WASHER
REF71
10/11/11, RJL
6/10/13, SDC
SET MAG/WASHER
FINREF71
10/3/13, SDC
FD MAG/WASHER
8/18/22, DSA
REF71
3/2/23, DSA

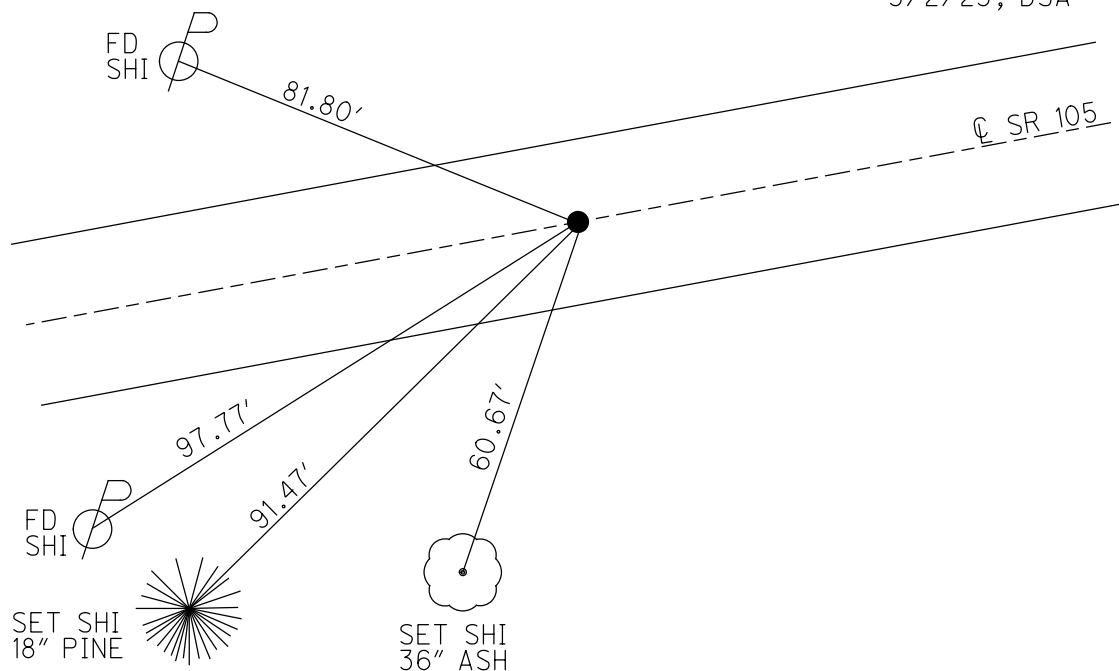

O.D.O.T. DISTRICT 2 SURVEY OFFICE (USE ONLY)

PERSONNEL

REFERENCE NO. 72

SHEET 30 OF 33

NOTES RHOADES

DATE 8/18/22

ROUTE SR 105

H.C. AUBLE

WEATHER SUNNY

COUNTY WOOD

R.C. NIESE

TEMP. 74°

TOWNSHIP FREEDOM

SECTION 9

DWG BY RHOADES

PID PAVETRAIN

T 5 N R 12 E

TYPE MONUMENT MAG/WASHER

ON SURFACE - ~~BELOW~~ ON

OFFSET CL PAVEMENT 10.6' ~~LT~~ : RT

0.7' TO RT EDGE PAVEMENT


STATION: 443+54.85

HORZ.DATUM: NAD83 2011


GEOID: NAVD88 2018

GRID: NORTHING: 634340.513

EASTING: 1700459.616

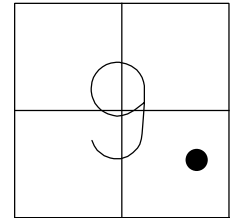

RECORD: P.I.
STA.= 446+68.97
 $\Delta = 10^{\circ}00'00''$ LT
SET P.K./WASHER
11/8/94, CL
SET MAG/WASHER
REF72
10/11/11, RJL
FD MAG/WASHER
6/10/13, SDC
SET MAG/WASHER
FINREF72
10/3/13, SDC
FD MAG/WASHER
8/18/22, DSA
REF72
3/2/23, DSA

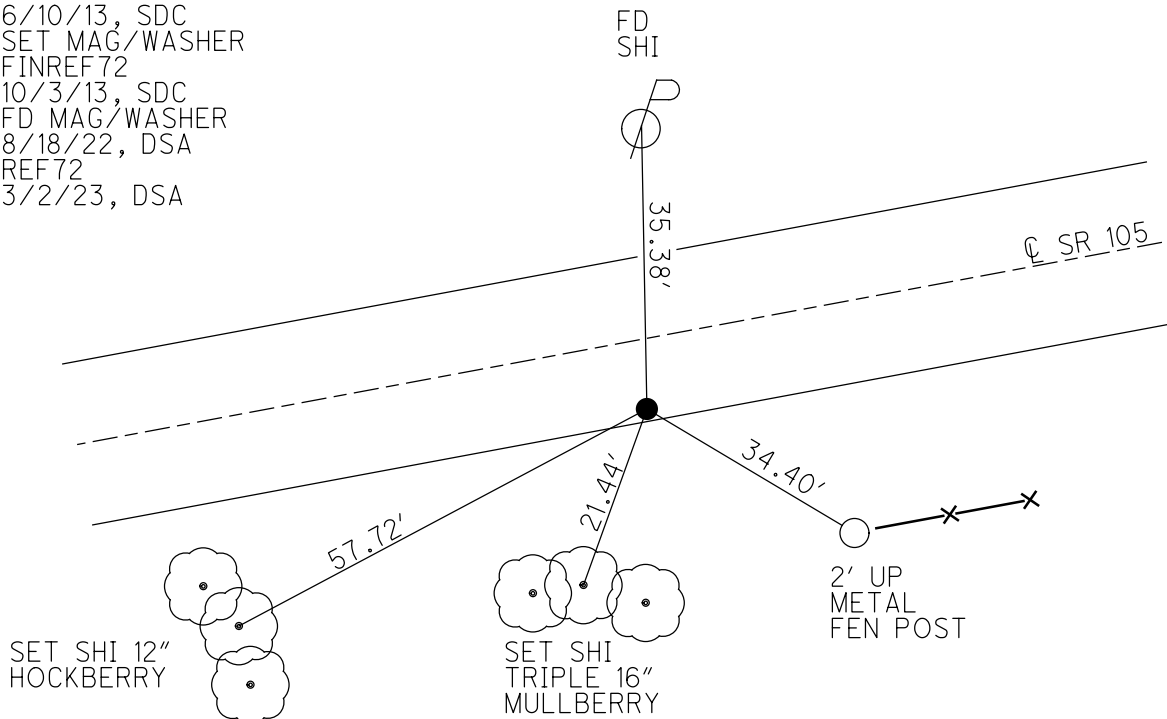

O.D.O.T. DISTRICT 2 SURVEY OFFICE (USE ONLY)

PERSONNEL

REFERENCE NO. 73

SHEET 31 OF 33

NOTES RHOADES

DATE 8/18/22

ROUTE SR 105

H.C. AUBLE

WEATHER SUNNY

COUNTY WOOD

R.C. NIESE

TEMP. 74°

TOWNSHIP FREEDOM

SECTION 9

DWG BY RHOADES

PID PAVETRAIN

T 5 N R 12 E

TYPE MONUMENT MAG/WASHER

ON SURFACE - ~~BELOW~~ ON

OFFSET CL PAVEMENT 0.6' LT : RT

9.7' TO RT EDGE PAVEMENT



STATION: 448+57.29

HORIZ.DATUM: NAD83 2011

GEOID: NAVD88 2018

GRID: NORTHING: 634482.978

EASTING: 1700941.417

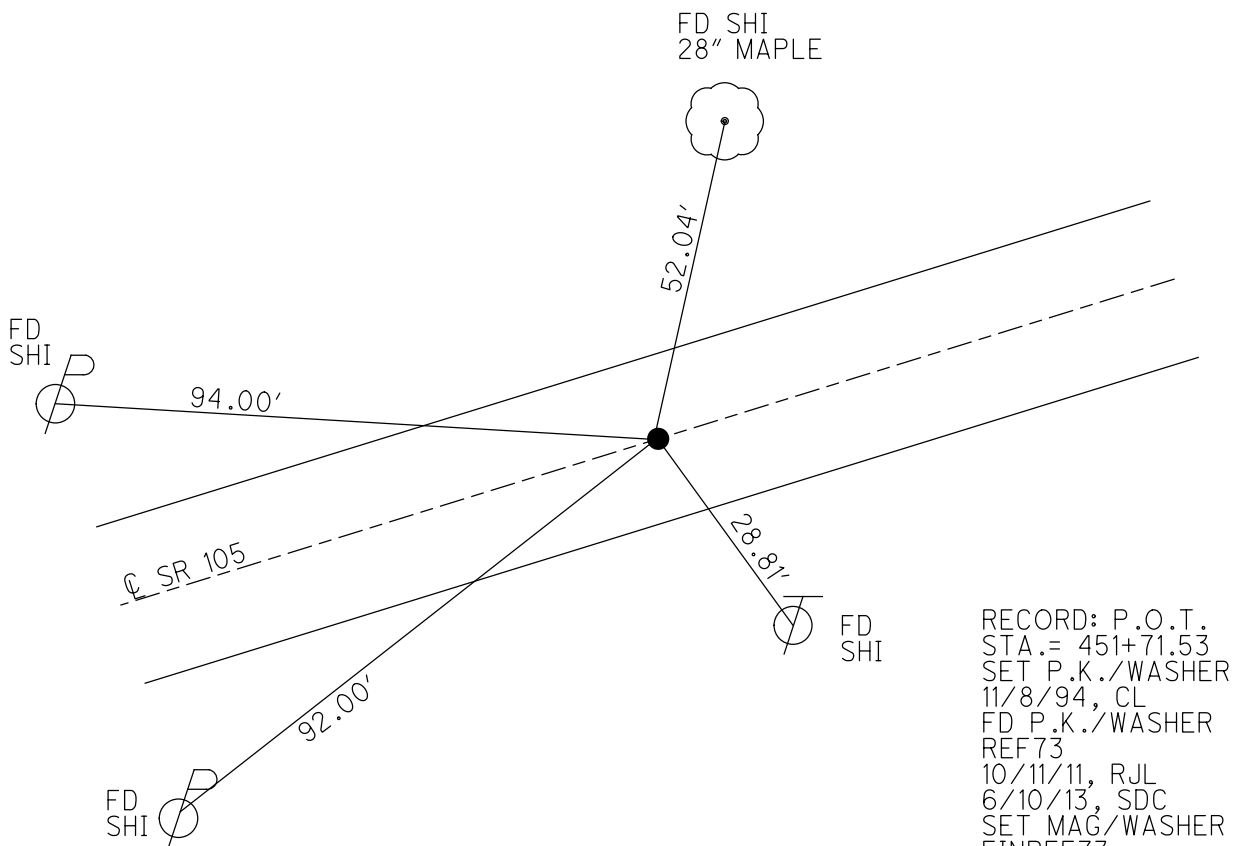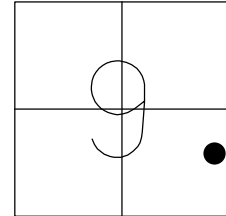

RECORD: P.O.T.
STA.= 451+71.53
SET P.K./WASHER
11/8/94, CL
FD P.K./WASHER
REF73
10/11/11, RJL
6/10/13, SDC
SET MAG/WASHER
FINREF73
10/3/13, SDC
FD MAG/WASHER
8/18/22, DSA
REF73
3/2/23, DSA

O.D.O.T. DISTRICT 2 SURVEY OFFICE (USE ONLY)

PERSONNEL

REFERENCE NO. 73 A

SHEET 32 OF 33

NOTES RHOADES

DATE 8/18/22

ROUTE SR 105

H.C. AUBLE

WEATHER SUNNY

COUNTY WOOD

R.C. NIESE

TEMP. 74°

TOWNSHIP FREEDOM

SECTION 9

DWG BY RHOADES

PID PAVETRAIN

T 5 N R 12 E

TYPE MONUMENT P.K./WASHER

ON SURFACE - ~~BELOW~~ ON

OFFSET CL PAVEMENT 1.1' ~~LT~~ : RT

9.4' TO RT EDGE PAVEMENT


STATION: 450+01.31

HORIZ.DATUM: NAD83 2011


GEOID: NAVD88 2018

GRID: NORTHING: 634521.221

EASTING: 1701070.753

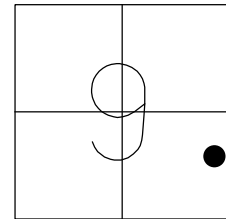

RES.#4054

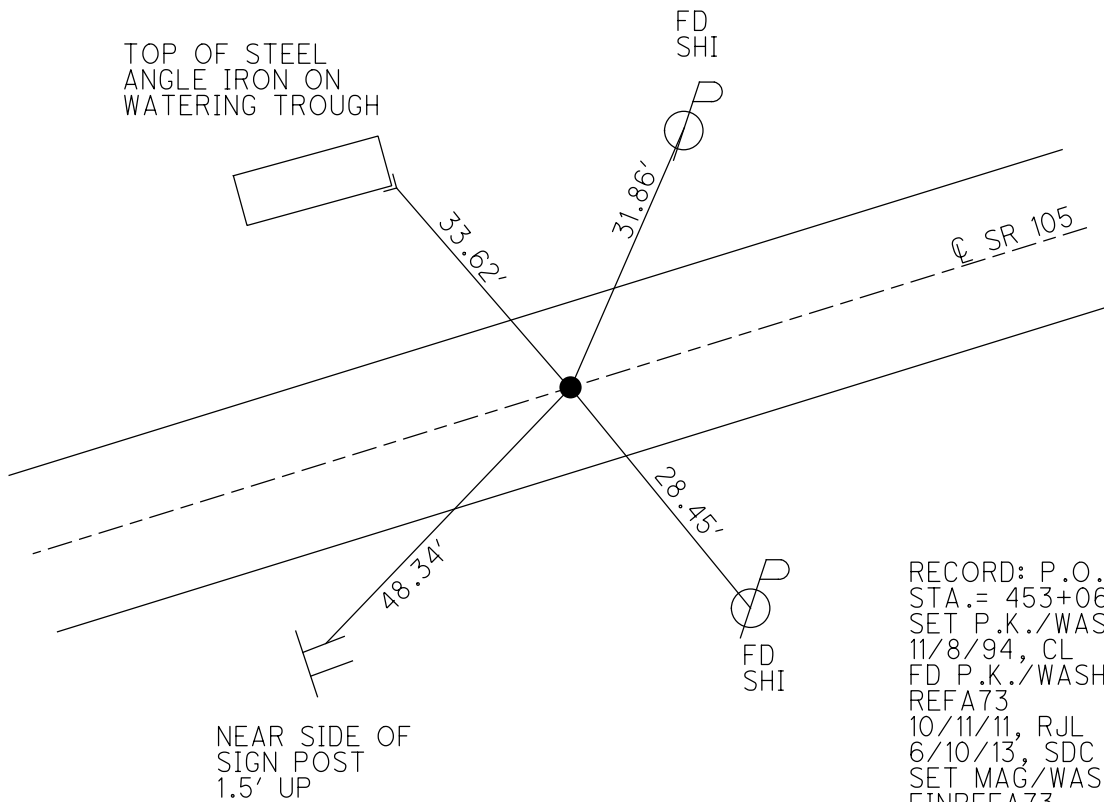

RECORD: P.O.T.
STA.= 453+06.45
SET P.K./WASHER
11/8/94, CL
FD P.K./WASHER
REF A73
10/11/11, RJL
6/10/13, SDC
SET MAG/WASHER
FIN REF A73
10/3/13, SDC
FD P.K./WASHER
8/18/22, DSA
REF 73A
3/2/23, DSA

O.D.O.T. DISTRICT 2 SURVEY OFFICE (USE ONLY)

PERSONNEL

REFERENCE NO. 74

SHEET 33 OF 33

NOTES RHOADES

DATE 8/18/22

ROUTE SR 105

H.C. AUBLE

WEATHER SUNNY

COUNTY WOOD

R.C. NIESE

TEMP. 74°

TOWNSHIP FREEDOM

SECTION 9

DWG BY RHOADES

PID PAVETRAIN

T 5 N R 12 E

TYPE MONUMENT P.K./WASHER

ON SURFACE - ~~BELOW~~ ON

OFFSET Q PAVEMENT 1.1' LT : RT

9.0' TO RT EDGE PAVEMENT


STATION: 452+58.80

HORIZ.DATUM: NAD83 2011


GEOID: NAVD88 2018

GRID: NORTHING: 634608.598

EASTING: 1701322.768

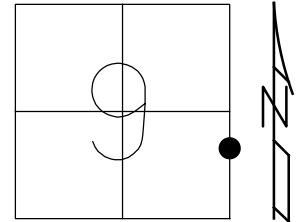


RECORD: P.T.
THE WEST CORP.LINE
OF PEMBERVILLE
STA.= 347+53.83
SET P.K./WASHER
11/14/94, MRC
FD P.K./WASHER
REF74
10/6/11, RJL
6/10/13, SDC
SET MAG/WASHER
FINREF74
10/3/13, SDC
FD MAG/WASHER
9-22-16, DCH
8/18/22, DSA
REF74
3/2/23, DSA

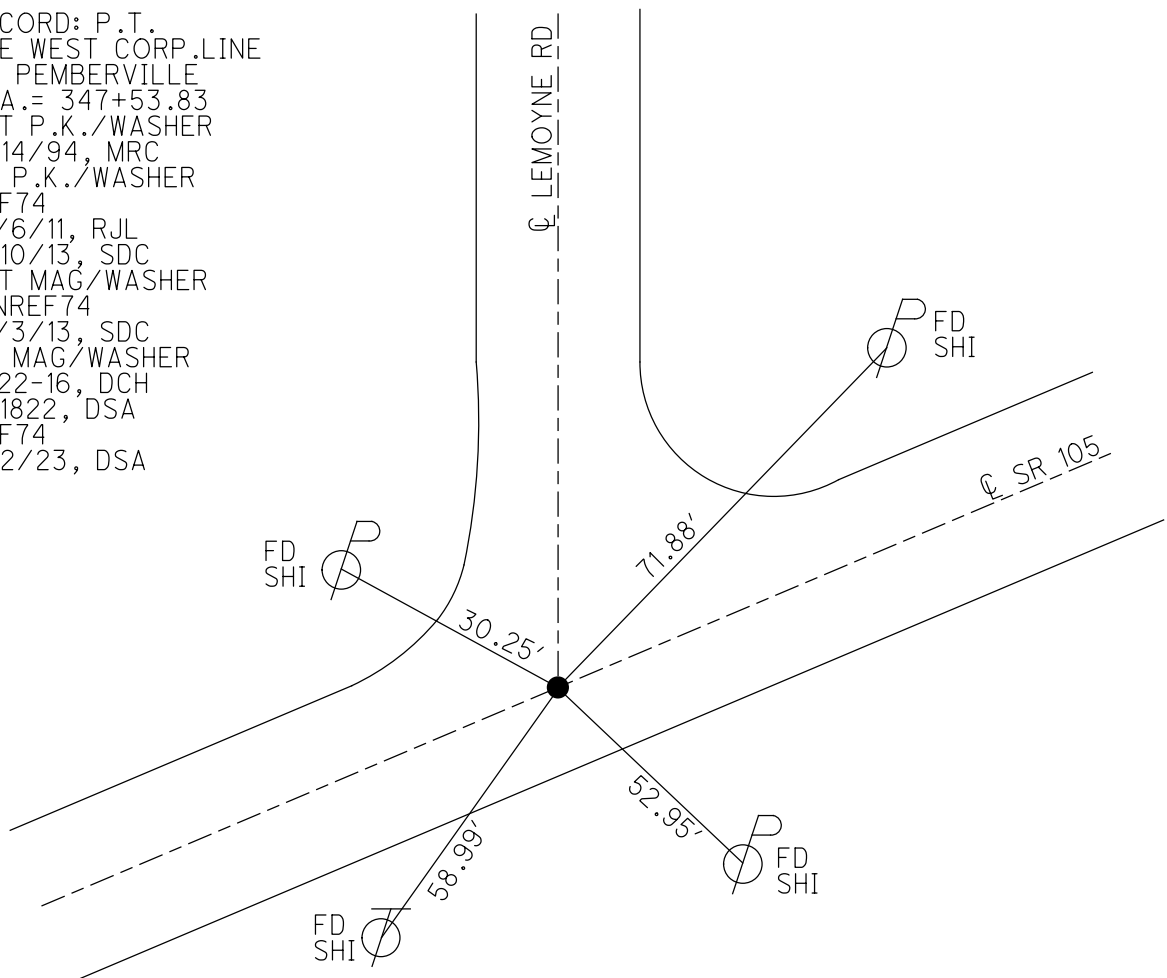

O.D.O.T. DISTRICT 2 SURVEY OFFICE (USE ONLY)

PERSONNEL	REFERENCE NO. <u>75</u>	SHEET <u>1</u> OF <u>17</u>
NOTES	DATE <u>04-25-16</u>	ROUTE <u>SR 105</u>
H.C. <u>LEU</u>	WEATHER <u>PARTLY CLDY</u>	COUNTY <u>WOOD</u>
R.C. <u>HOMAN</u>	TEMP. <u>52°F</u>	TOWNSHIP <u>FREEDOM</u>
		SECTION <u>10</u>
		T <u>5</u> N R <u>12</u> E


TYPE MONUMENT IPIN
 ON SURFACE - ~~BELOW~~ ON
~~LEFT~~ - C PAV'T - RIGHT 1'
8.6' TO RT EDGE PAVEMENT
 S.L.M. 468+92

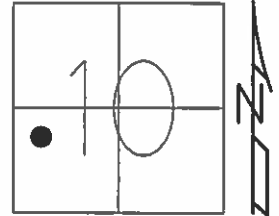

GRID: NORTHING: 635228.0025 EASTING: 1702665.651

RECORD:
 P.O.T. STA 362+32.80


SET MAG/WASHER
 GPS, NEWREF75
 09-22-2016, DCH

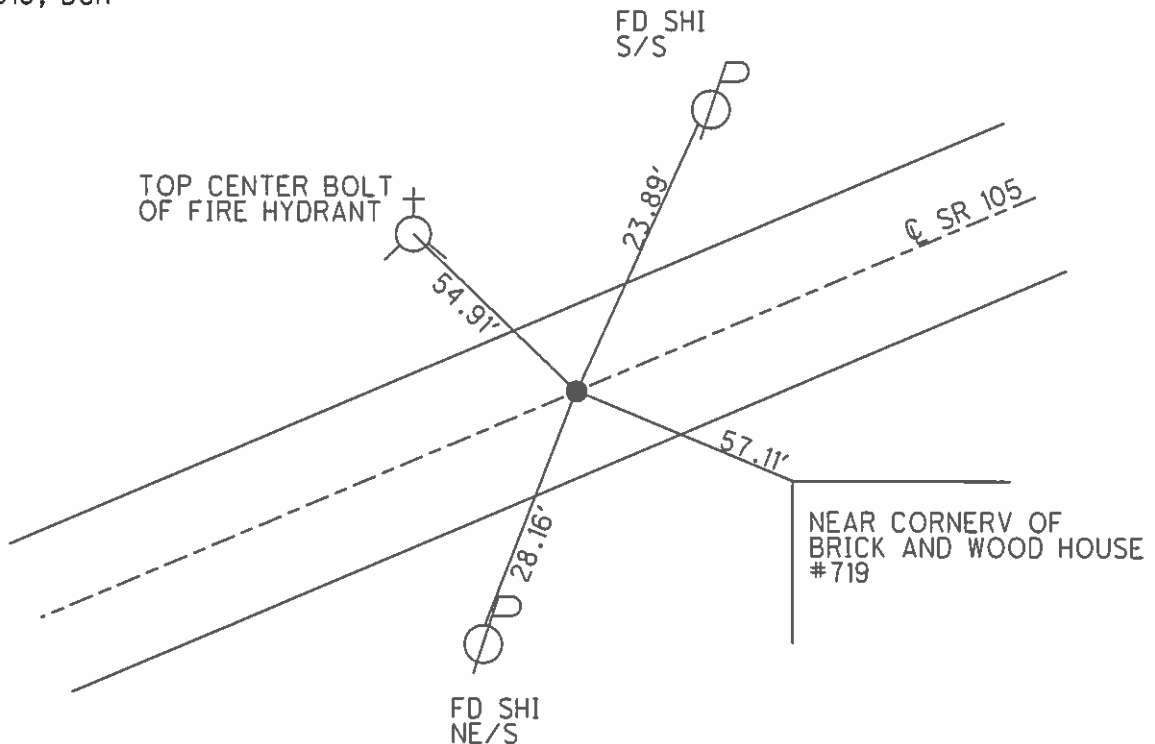

O.D.O.T. DISTRICT 2 SURVEY OFFICE (USE ONLY)


PERSONNEL _____ REFERENCE NO. 76 SHEET 2 OF 17
NOTES LEU DATE 04-25-16 ROUTE SR 105
H.C. HOMAN WEATHER OVERCAST COUNTY WOOD
R.C. LEU TEMP. 52°F TOWNSHIP FREEDOM
SECTION 10
T 5 N R 12 E

TYPE MONUMENT MAG NAIL
ON SURFACE - ~~BELOW~~ ON
LEFT - C PAV'T - RIGHT ON
16.8' TO LT EDGE PAVEMENT
S.L.M. 472+36
GRID: NORTHING: 635376.6704 EASTING: 1702977.111

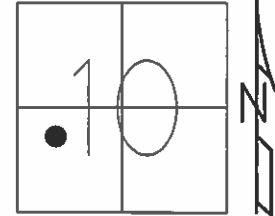

RECORD:
SET PK/WASHER
11-14-94, MRC

SET MAG/WASHER
GPS, NEWREF76
09-22-16, DCH

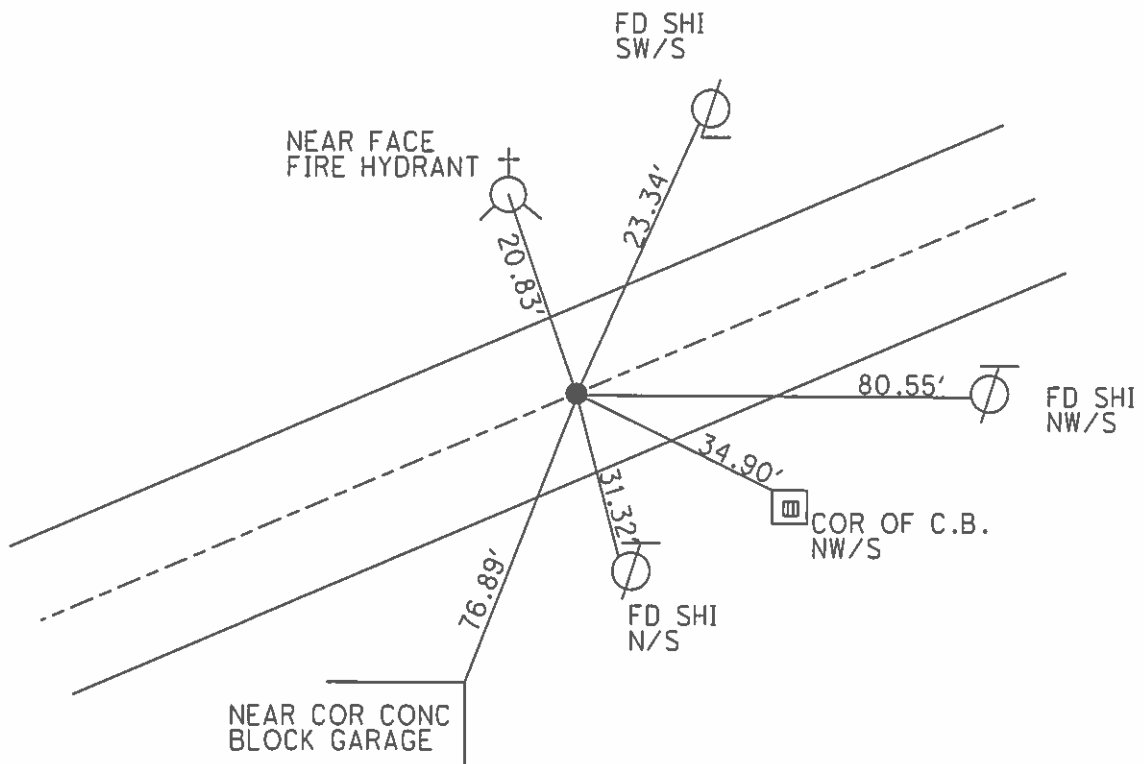


O.D.O.T. DISTRICT 2 SURVEY OFFICE (USE ONLY)

PERSONNEL	REFERENCE NO. <u>77</u>	SHEET <u>3</u> OF <u>17</u>
NOTES	DATE <u>04-25-16</u>	ROUTE <u>SR 105</u>
H.C. <u>LEU</u>	WEATHER <u>OVERCAST</u>	COUNTY <u>WOOD</u>
R.C. <u>HOMAN</u>	TEMP. <u>52°F</u>	TOWNSHIP <u>FREEDOM</u>
		SECTION <u>10</u>
		T <u>5</u> N R <u>12</u> E


TYPE MONUMENT MAG/WASHER
 ON SURFACE - ~~BELOW~~ ON
 LEFT - C PAV'T - RIGHT ON
16.9' TO LT EDGE PAVEMENT
 S.L.M. 479+33

GRID: NORTHING: 635661.8405 EASTING: 1703611.601

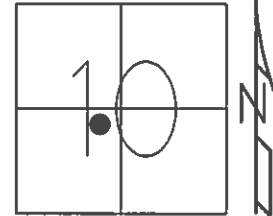

RECORD:
 SET PK/WASHER
 11-14-94, MRC


SET MAG/WASHER
 GPS, NEWREF77
 09-22-16, DCH

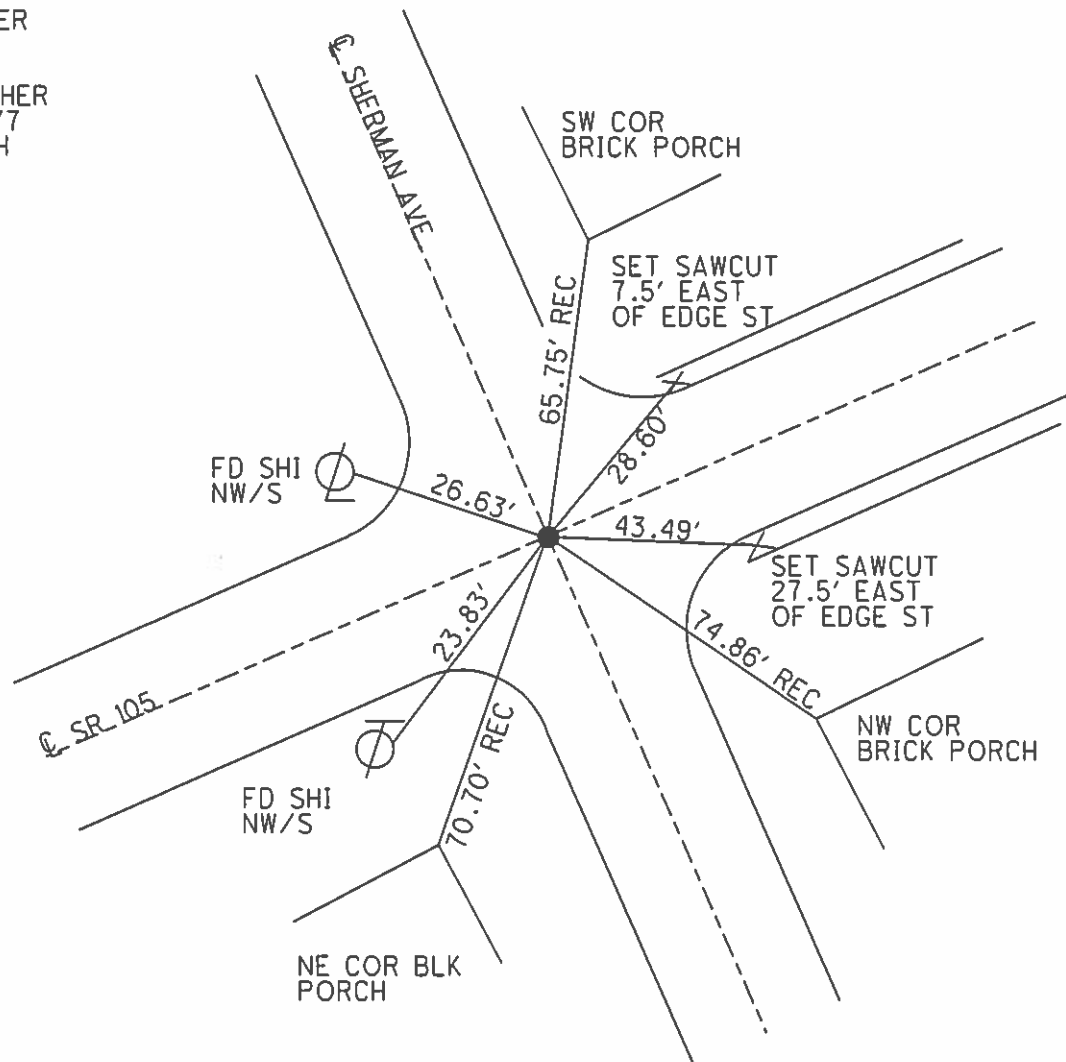

O.D.O.T. DISTRICT 2 SURVEY OFFICE (USE ONLY)

PERSONNEL	REFERENCE NO. <u>78</u>	SHEET <u>4</u> OF <u>17</u>
NOTES	DATE <u>04-25-16</u>	ROUTE <u>SR 105</u>
H.C. <u>LEU</u>	WEATHER <u>PARTLY CLDY</u>	COUNTY <u>WOOD</u>
R.C. <u>LEU</u>	TEMP. <u>52°F</u>	TOWNSHIP <u>FREEDOM</u>
		SECTION <u>10</u>
		T <u>5</u> N R <u>12</u> E

TYPE MONUMENT MAG/WASHER
 ON SURFACE - ~~BELOW~~ ON
 LEFT - C PAV'T - RIGHT ON
8.8' TO RT EDGE PAVEMENT
 S.L.M. 483+61

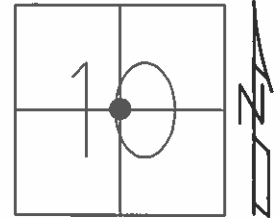


GRID: NORTHING: 635800.6354 EASTING: 1703920.763

RECORD:
 P.I. #69 484+33.20
 $\Delta = 4^\circ 53' 20''$ RT
 PK/WASHER @ SURFACE
 STA 482+72 ON C SR 105
 16.7' TO RT EDGE PAVT

DIST. 78-78A = 89.17'
 78A-78B = 45.46'


SET PK/WASHER
 8-1-1994
 SET MAG/WASHER
 GPS, NEWREF78
 09-22-16, DCH

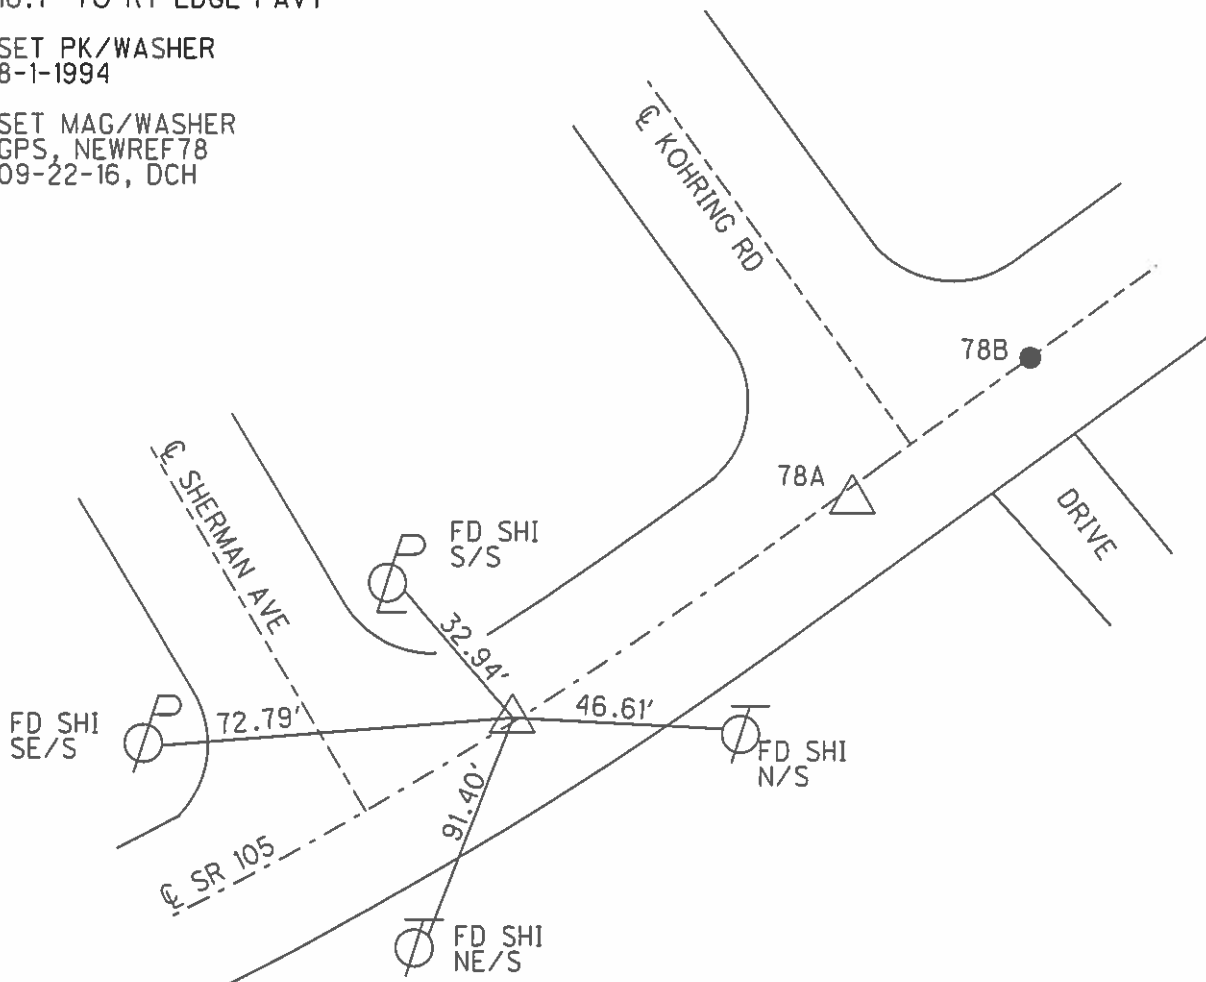

O.D.O.T. DISTRICT 2 SURVEY OFFICE (USE ONLY)

PERSONNEL	REFERENCE NO. <u>78 A</u>	SHEET <u>5</u> OF <u>17</u>
NOTES	DATE <u>04-25-16</u>	ROUTE <u>SR 105</u>
H.C. <u>LEU</u>	WEATHER <u>PARTLY CLDY</u>	COUNTY <u>WOOD</u>
R.C. <u>HOMAN</u>	TEMP. <u>52°F</u>	TOWNSHIP <u>FREEDOM</u>
		SECTION <u>10</u>
		T <u>5</u> N R <u>12</u> E

TYPE MONUMENT PK/WASHER
 ON SURFACE - ~~BELOW~~ ON
 LEFT - C PAV'T - RIGHT ON
8.8' TO RT EDGE PAVEMENT
 S.L.M. 483+61

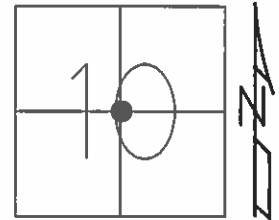


GRID: NORTHING: 635830.3098 EASTING: 1704004.793

RECORD:
 SET PK/WASHER
 8-1-1994

DIST. 78-78A = 89.17'
 78A-78B = 45.46'


SET MAG/WASHER
 GPS, NEWREFA78
 09-22-16, DCH

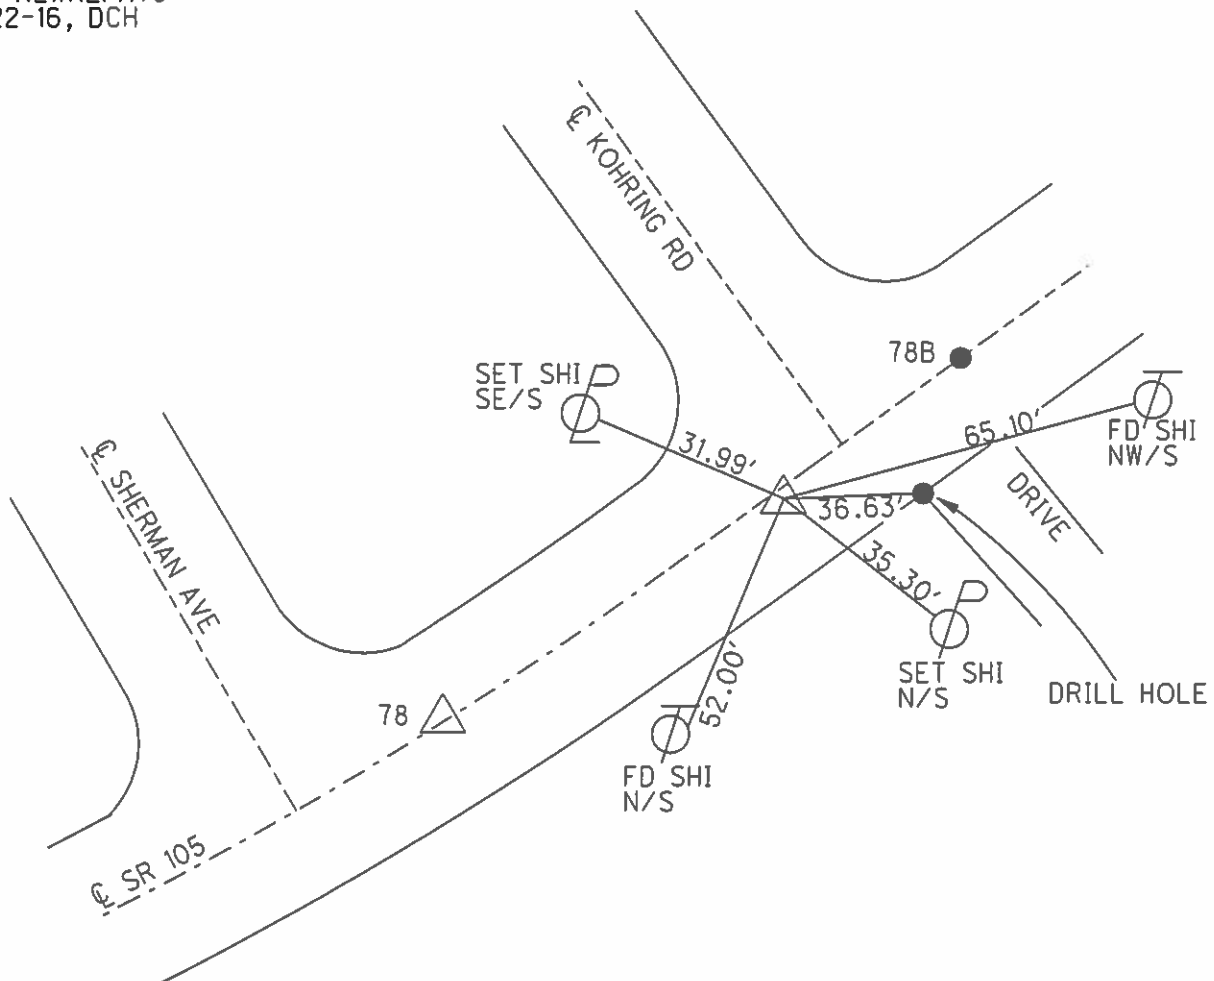

O.D.O.T. DISTRICT 2 SURVEY OFFICE (USE ONLY)

PERSONNEL	REFERENCE NO. <u>78 B</u>	SHEET <u>6</u> OF <u>17</u>
NOTES	DATE <u>04-25-16</u>	ROUTE <u>SR 105</u>
H.C. <u>LEU</u>	WEATHER <u>PARTLY CLDY</u>	COUNTY <u>WOOD</u>
R.C. <u>HOMAN</u>	TEMP. <u>52°F</u>	TOWNSHIP <u>FREEDOM</u>
		SECTION <u>10</u>
		T <u>5</u> N R <u>12</u> E

TYPE MONUMENT MAG/WASHER
 ON SURFACE - ~~BELOW~~ ON
 LEFT - Q PAV'T - RIGHT ON
8.8' TO RT EDGE PAVEMENT
 S.L.M. 483+61

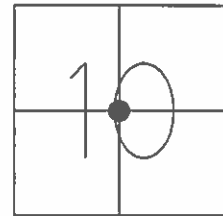


GRID: NORTHING: 635856.1508 EASTING: 1704042.229

RECORD:
 FD BENT PK/WASHER
 4" DOWN
 STA 484+06.47
 7.7' RT Q SR105
 15.3" TO RT CURB

DIST. 78-78A = 89.17'
 78A-78B = 45.46'

SET PK/WASHER
 8-1-1994

SET MAG/WASHER
 GPS, NEWREFB78
 09-22-16, DCH

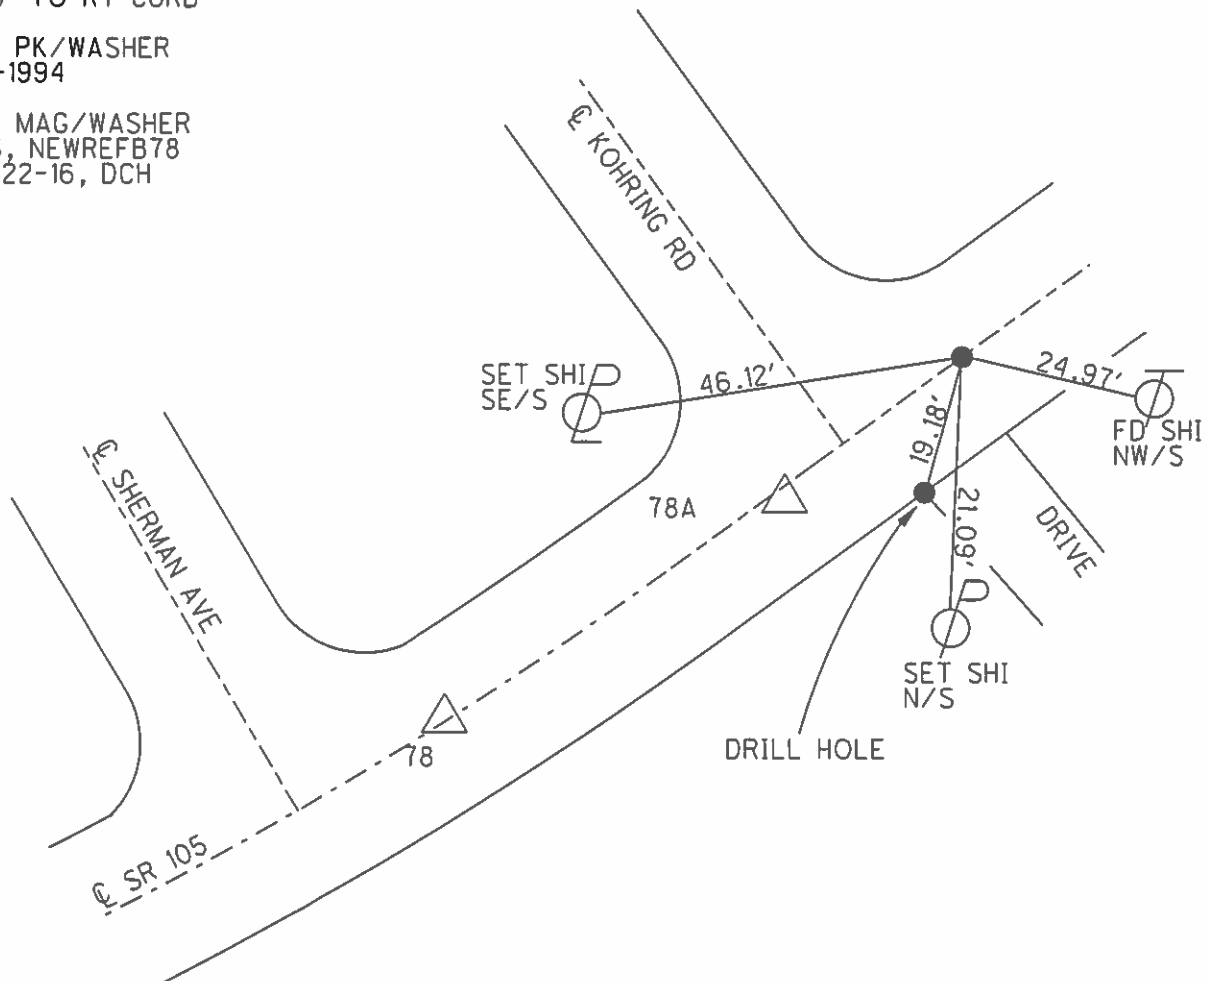

O.D.O.T. DISTRICT 2 SURVEY OFFICE (USE ONLY)

PERSONNEL

REFERENCE NO. 79

SHEET 7 OF 17

NOTES

LEU

DATE

4-25-16

ROUTE

SR 105

H.C.

HOMAN

WEATHER

PARTLY CLDY

COUNTY

WOOD

R.C.

LEU

TEMP.

52°F

TOWNSHIP

FREEDOM

SECTION

10

T 5 N R 12 E

TYPE MONUMENT BOAT SPIKE


ON SURFACE - ~~BELOW~~ ON

LEFT - C PAV'T - RIGHT ON

17.2' TO RT EDGE PAVEMENT

S.L.M. 487+32

GRID: NORTHING: 636040.6743 EASTING: 1704310.712

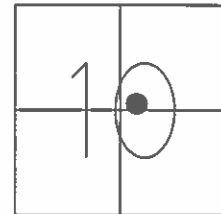


RECORD:

STA. 488+93.54

$\Delta=0^{\circ}00'00''$

SET PK/WASHER
8-1-1994, MRC


SET MAG/WASHER
GPS, NEWREFB79
09-22-16, DCH

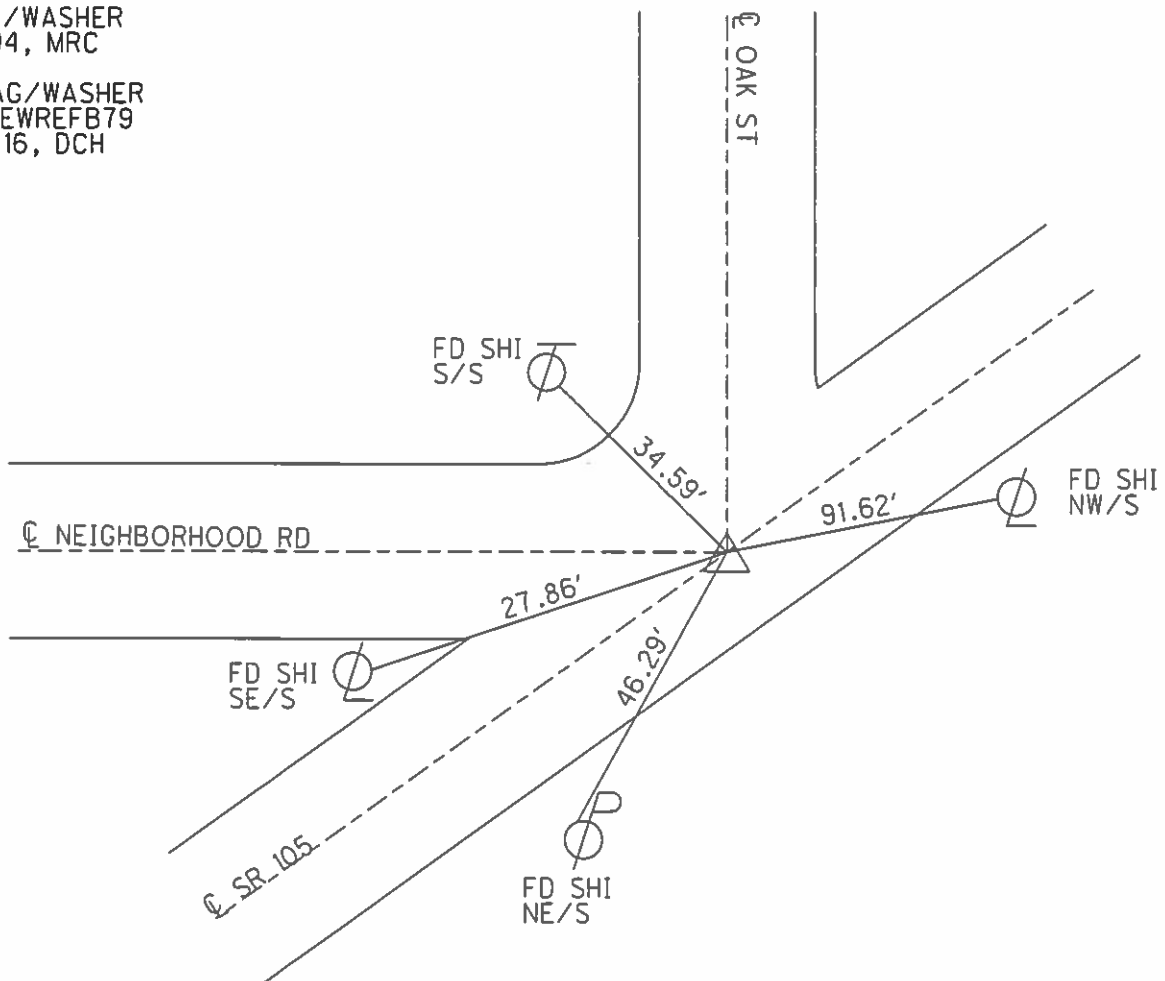

O.D.O.T. DISTRICT 2 SURVEY OFFICE (USE ONLY)

PERSONNEL	REFERENCE NO.	79 A	SHEET	8	OF	17
NOTES	LEU	DATE	04-25-16	ROUTE	SR 105	
H.C.	HOMAN	WEATHER	PARTLY CLDY	COUNTY	WOOD	
R.C.	LEU	TEMP.	52°F	TOWNSHIP	FREEDOM	
				SECTION	10	
				T	5	N
				R	12	E

TYPE MONUMENT MAG/WASHER
ON SURFACE - ~~BELOW~~ ON
LEFT - ϕ PAV'T - RIGHT ON
- TO - EDGE PAVEMENT
S.L.M. 490+37

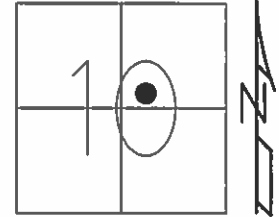


GRID: NORTHING: 636213.3985 EASTING: 1704561.957

RECORD:
STA 490+37
17.4 TO RT OF
EDGE OF PAVEMENT
 $\Delta=0^{\circ}00'$

DIST.
79A-79B = 0.30'
79A-79C = 65.79'
79B-79C = 65.49'

SET PK/WASHER
11-14-94, MRC


SET MAG/WASHER
GPS, NEWREFA79
09-22-16, DCH

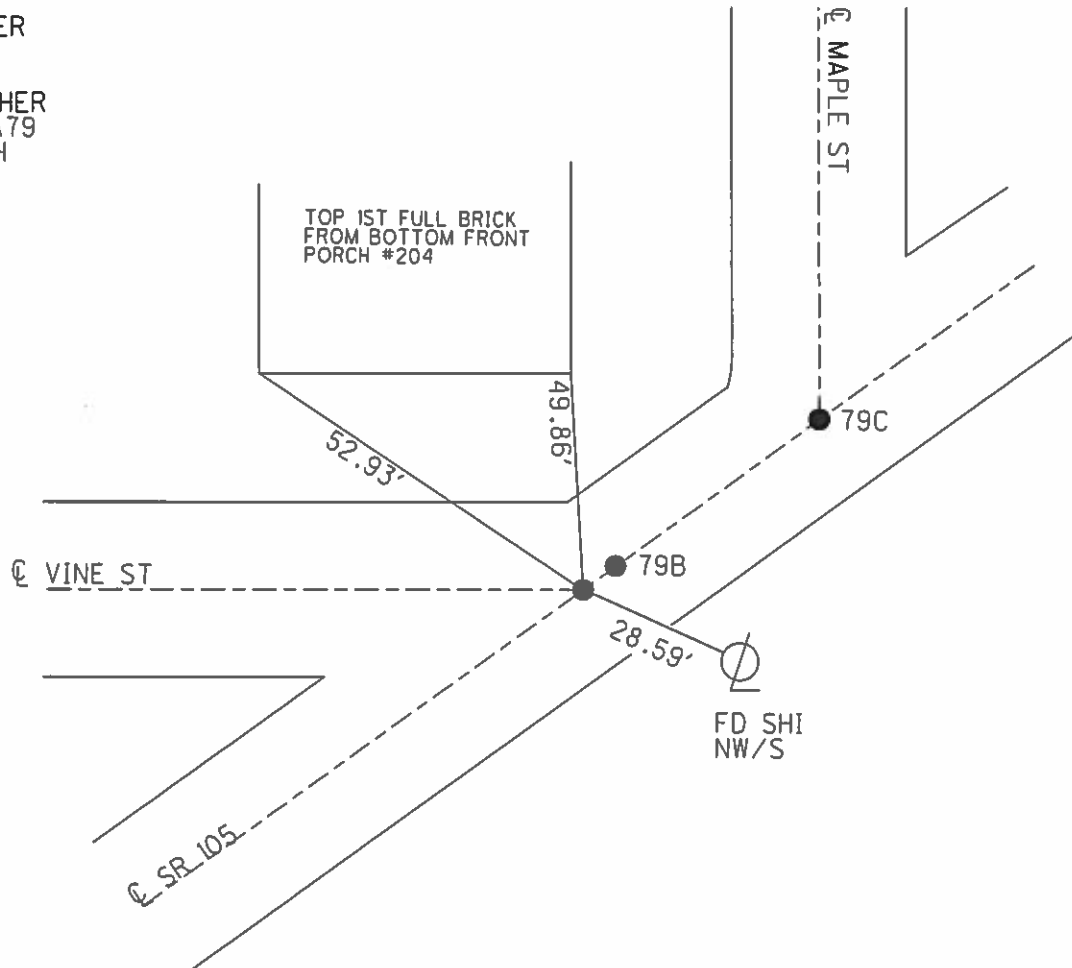

O.D.O.T. DISTRICT 2 SURVEY OFFICE (USE ONLY)

PERSONNEL	REFERENCE NO.	79 B	SHEET	9	OF	17
NOTES	DATE	04-25-16	ROUTE	SR 105		
H.C.	WEATHER	PARTLY CLDY	COUNTY	WOOD		
R.C.	TEMP.	52°F	TOWNSHIP	FREEDOM		
			SECTION	10		
			T	5	N	R 12 E


TYPE MONUMENT MAG NAIL
 ON SURFACE - ~~BELOW~~ ON
 LEFT - Q PAV'T - RIGHT ON
- TO - EDGE PAVEMENT
 S.L.M. 490+37

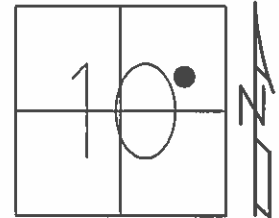

GRID: NORTHING: 636213.5661 EASTING: 1704562.183

RECORD:
 SET MAG/WASHER
 GPS, NEWREFB79
 09-22-16, DCH


DIST.
 79A-79B = 0.30'
 79A-79C = 65.79'
 79B-79C = 65.49'

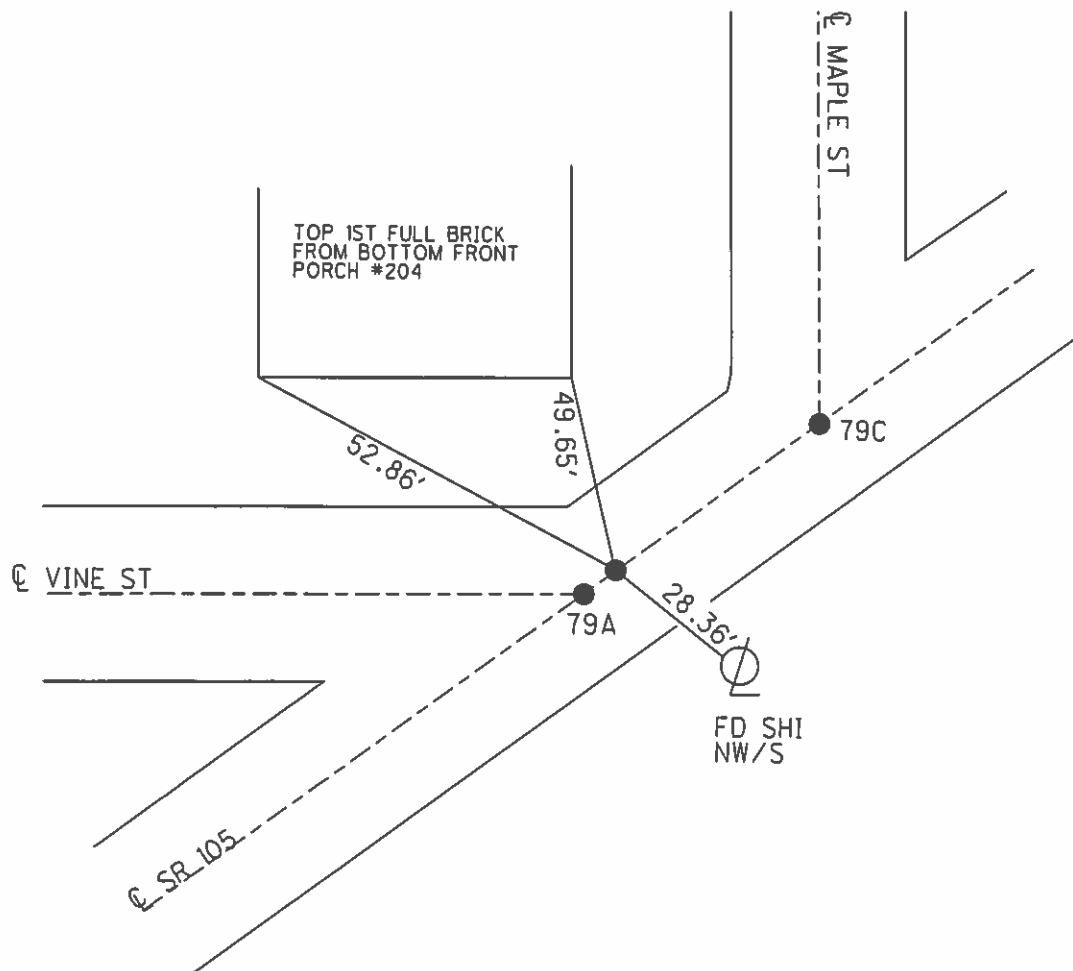

O.D.O.T. DISTRICT 2 SURVEY OFFICE (USE ONLY)

PERSONNEL	REFERENCE NO.	79 C	SHEET	10	OF	17
NOTES	LEU	DATE	4-25-16	ROUTE	SR 105	
H.C.	HOMAN	WEATHER	PARTLY CLDY	COUNTY	WOOD	
R.C.	LEU	TEMP.	52°F	TOWNSHIP	FREEDOM	
				SECTION	10	
				T	5 N	R 12 E

TYPE MONUMENT PK/WASHER
ON SURFACE - ~~BELOW~~ ON
LEFT - Q PAV'T - RIGHT ON
- TO - EDGE PAVEMENT
S.L.M. 490+37
GRID: NORTHING: 636250.5187 EASTING: 1704616.241

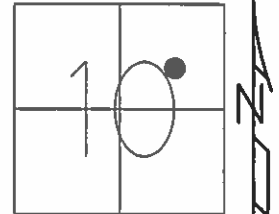


RECORD:
STA 491+02.81
17.3 TO RT OF
EDGE OF PAVEMENT
 $\Delta=0^{\circ}00'$

DIST.
79A-79B = 0.30'
79A-79C = 65.79'
79B-79C = 65.49'

SET PK/WASHER
11-14-94, MRC

SET MAG/WASHER
GPS, NEWREFA79
09-22-16, DCH

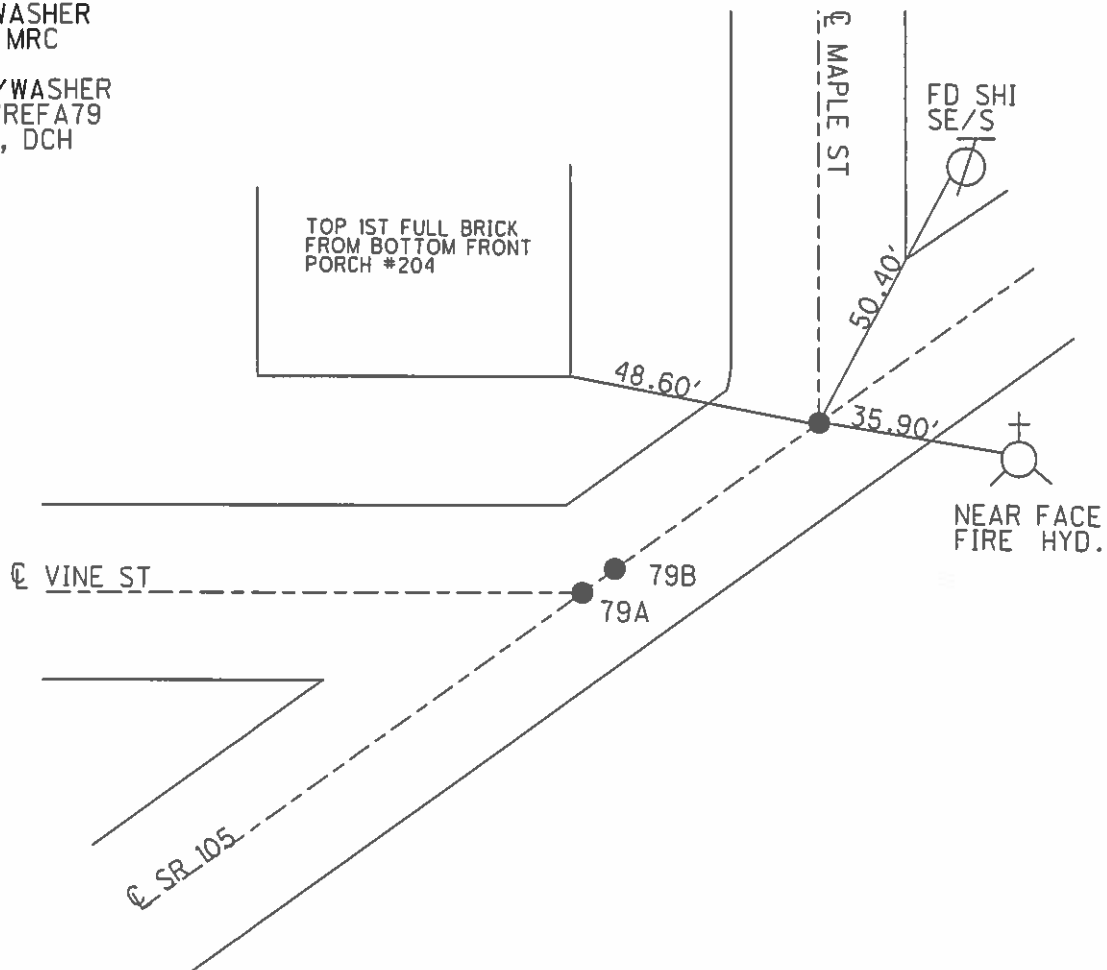

O.D.O.T. DISTRICT 2 SURVEY OFFICE (USE ONLY)

PERSONNEL	REFERENCE NO. <u>80</u>	SHEET <u>11</u> OF <u>17</u>
NOTES	DATE <u>04-25-16</u>	ROUTE <u>SR 105</u>
H.C. <u>LEU</u>	WEATHER <u>PARTLY CLDY</u>	COUNTY <u>WOOD</u>
R.C. <u>LEU</u>	TEMP. <u>52°F</u>	TOWNSHIP <u>FREEDOM</u>
		SECTION <u>10</u>
		T <u>5</u> N R <u>12</u> E

TYPE MONUMENT MON BOX W/STONE W/ DRILL HOLE


ON SURFACE - ~~BELOW~~ ON

LEFT - C PAV'T - RIGHT ON

20.0' TO RT EDGE PAVEMENT

S.L.M. 495+90

GRID: NORTHING: 636526.2422 EASTING: 1705017.099

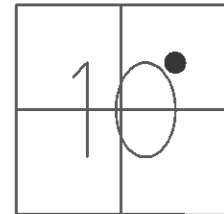


RECORD:
P.I. #71
STA 497+50.93
 $\Delta = 2^\circ 10' 00''$ LT

FD MON BOX
GPS, REF80
04-25-2016

FD MON BOX
W/ STONE
W/ DRILL HOLE
GPS, CKREF80
* MONUMENT WAS DISTRUBED
DURING CONSTRUCTION
09-22-16

SET DRILL HOLE
PRE-CON TIES
GPS, NEWREF80
10-18-2016, DCH, JLL

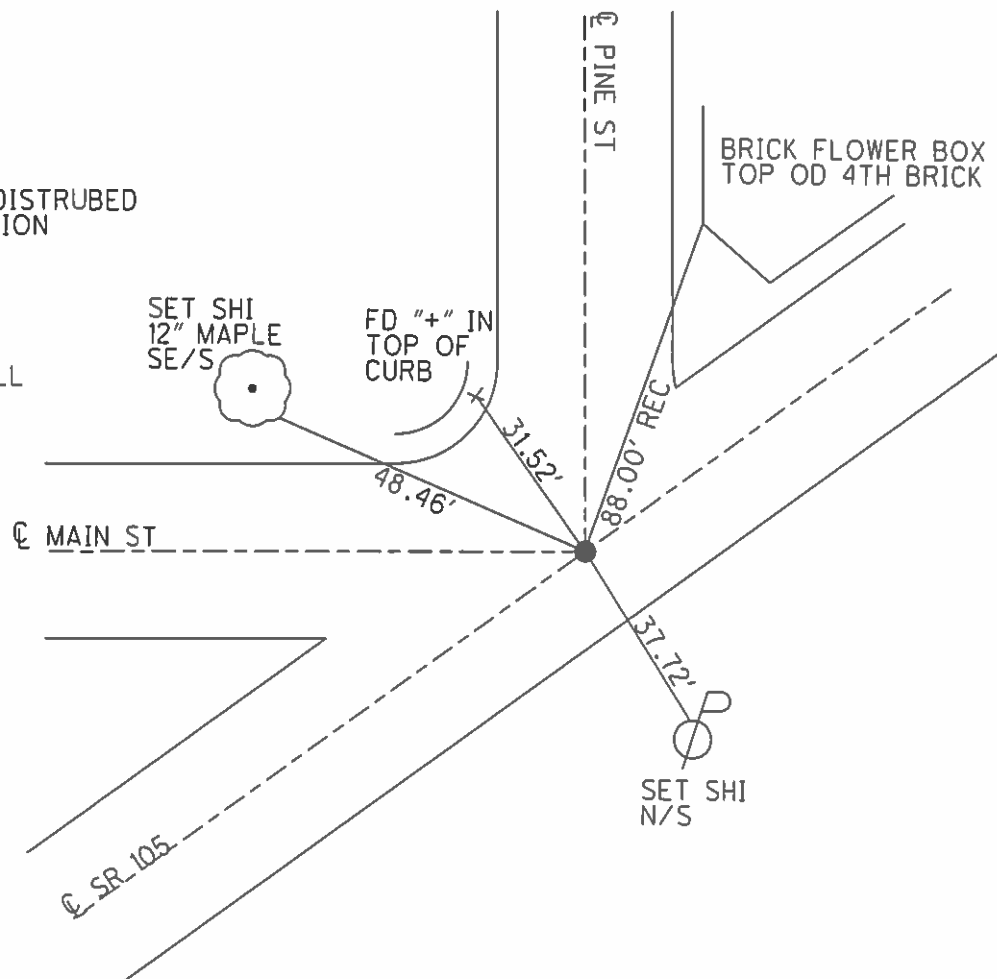

O.D.O.T. DISTRICT 2 SURVEY OFFICE (USE ONLY)

PERSONNEL _____ REFERENCE NO. 80 A SHEET 12 OF 17
NOTES LEU DATE 04-25-16 ROUTE SR 105
H.C. HOMAN WEATHER PARTLY CLDY COUNTY WOOD
R.C. LEU TEMP. 52°F TOWNSHIP FREEDOM
SECTION 10
T 5 N R 12 E

TYPE MONUMENT PK/WASHER


ON SURFACE - ~~BELOW~~ ON

~~LEFT~~ - C PAV'T - RIGHT 5.0'

20.3' TO RT EDGE PAVEMENT

S.L.M. 499+38

GRID: NORTHING: 636734.1195 EASTING: 1705296.173

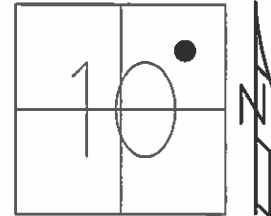


RECORD:
POT STA 500+98.99
 $\Delta=0^{\circ}00'00''$

SET PK/WASHER
11-14-94, MRC

FD PK/WASHER
GPS, REFA80
04-25-16

SET MAG/WASHER
GPS, NEWREFA80
09-22-2016

PHARMACY-SE. COR.
BRICK PILLAR
MIDDLE OF 3RD BIRCK

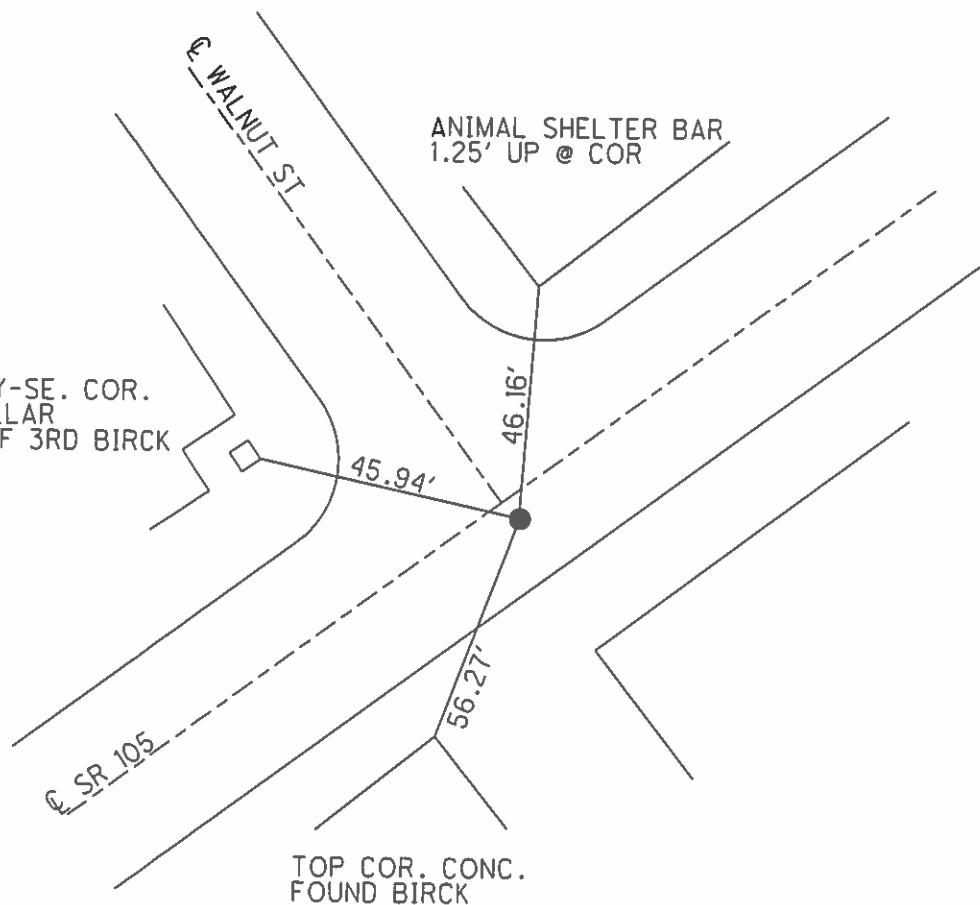

O.D.O.T. DISTRICT 2 SURVEY OFFICE (USE ONLY)

PERSONNEL	REFERENCE NO. <u>81</u>	SHEET <u>13</u> OF <u>17</u>
NOTES	DATE <u>04-25-16</u>	ROUTE <u>SR 105</u>
H.C. <u>LEU</u>	WEATHER <u>PARTLY CLDY</u>	COUNTY <u>WOOD</u>
R.C. <u>HOMAN</u>	TEMP. <u>52°F</u>	TOWNSHIP <u>FREEDOM</u>
		SECTION <u>10</u>
		T <u>5</u> N R <u>12</u> E

TYPE MONUMENT MON BOX W/STONE W/ DRILLHOLE


ON SURFACE - ~~BELOW~~ ON

LEFT - C PAV'T - RIGHT ON

- TO - EDGE PAVEMENT

S.L.M. 501+14

GRID: NORTHING: 636838.4713 EASTING: 1705436.306

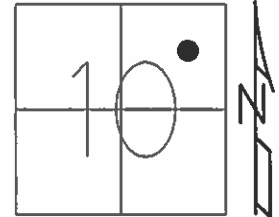


RECORD:
P.I. #72 STA 502+73.83
 $\Delta=0^{\circ}07'00''$ LT

RECORD DIST. 81-81A $\approx 25.7'$

FD MON BOX
W/STONE
W/ DRILL HOLE
GPS, REF81
04-25-16

FD MON BOX
W/ STONE
W/ DRILL HOLE
GPS, CKREF81
09-22-16, DCH
GPS, NEWREF81

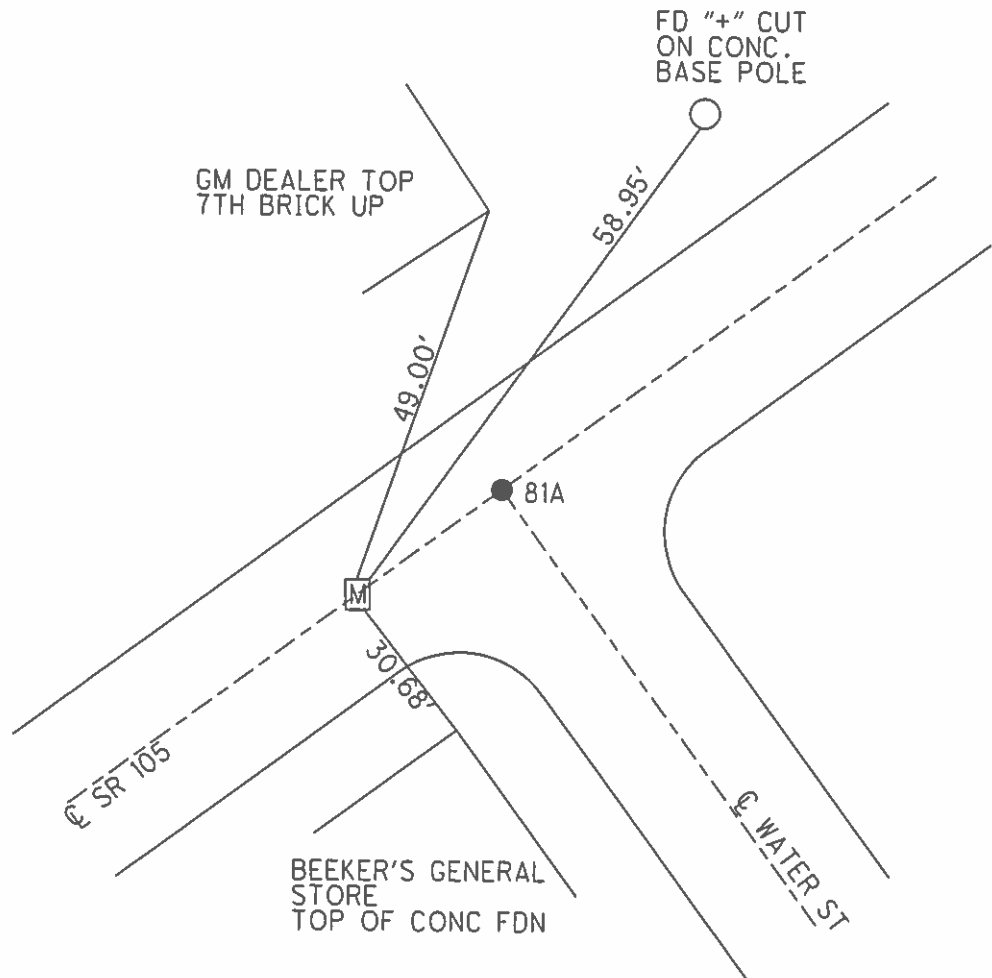

O.D.O.T. DISTRICT 2 SURVEY OFFICE (USE ONLY)

PERSONNEL

REFERENCE NO.

81 A

SHEET

14

OF 17

NOTES

LEU

DATE

04-25-16

ROUTE

SR 105

H.C.

HOMAN

WEATHER

OVERCAST

COUNTY

WOOD

R.C.

LEU

TEMP.

52°F

TOWNSHIP

FREEDOM

SECTION

10

T 5 N

R 12 E

TYPE MONUMENT PK/WASHER

ON SURFACE - ~~BELOW~~ ON


LEFT - C PAV'T - RIGHT ON

- TO - EDGE PAVEMENT

S.L.M. 501+39.7

GRID: NORTHING:

EASTING:

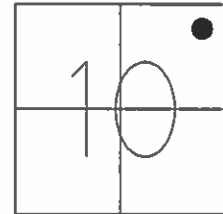

RECORD:

PK AT SURFACE

C OF BOTH PAVT

5' RT C

STA 501+39.7


RECORD DIST. 81-81A = 25.7'

SET PK/WASHER

11-14-94

DNF


04-25-16

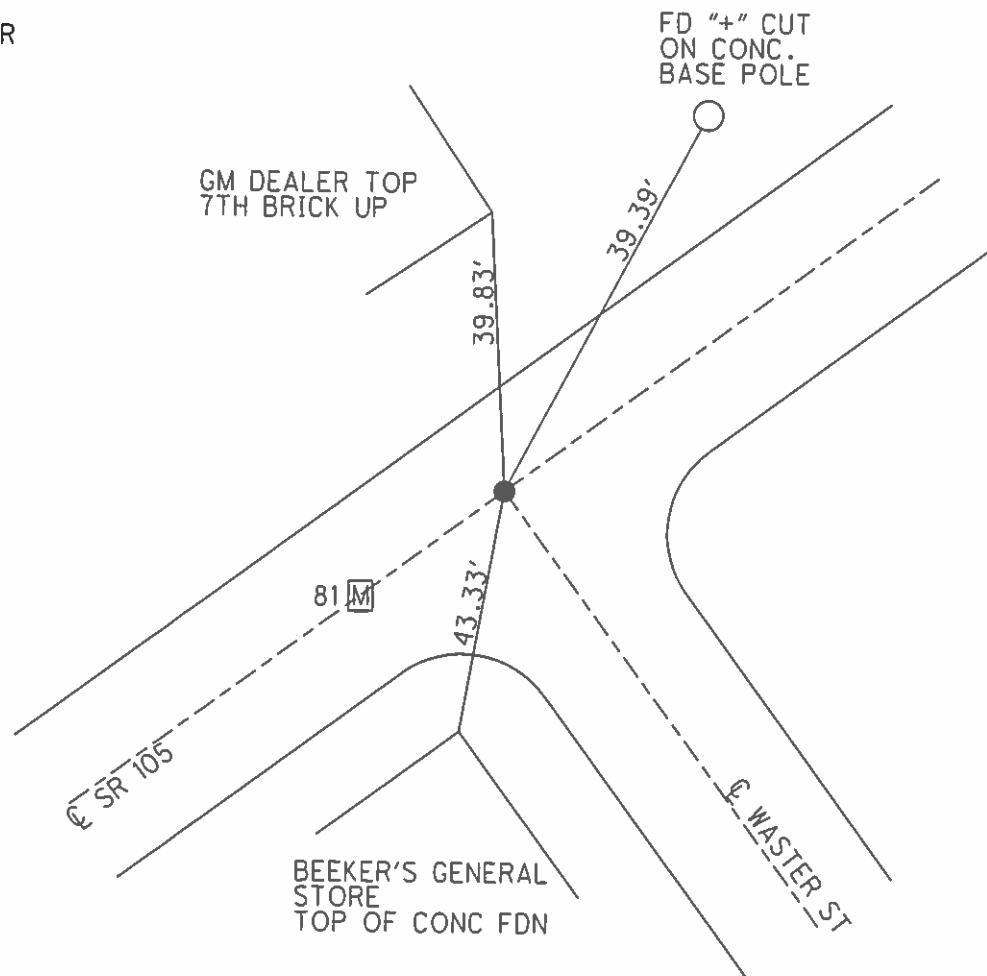

O.D.O.T. DISTRICT 2 SURVEY OFFICE (USE ONLY)

PERSONNEL	REFERENCE NO. <u>82</u>	SHEET <u>15</u> OF <u>17</u>
NOTES	DATE <u>04-25-16</u>	ROUTE <u>SR 105</u>
H.C. <u>LEU</u>	WEATHER <u>OVERCAST</u>	COUNTY <u>WOOD</u>
R.C. <u>HOMAN</u>	TEMP. <u>70°F</u>	TOWNSHIP <u>FREEDOM</u>
		SECTION <u>10</u>
		T <u>5</u> N R <u>12</u> E

TYPE MONUMENT MAG/WASHER
 ON SURFACE - ~~BELOW~~ ON
 LEFT - C PAV'T - RIGHT ON
16' TO RT EDGE PAVEMENT
 S.L.M. 502+27

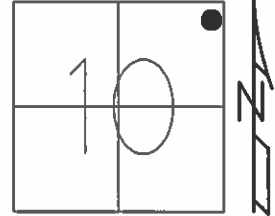


GRID: NORTHING: 636905.7202 EASTING: 1705526.487

RECORD:
 STA 503+86.25
 Δ=0°0'00"

SET PK/WASHER
 11-14-94, MRC

SET MAG/WASHER
 GPS, NEWREF82
 09-22-16 DCH

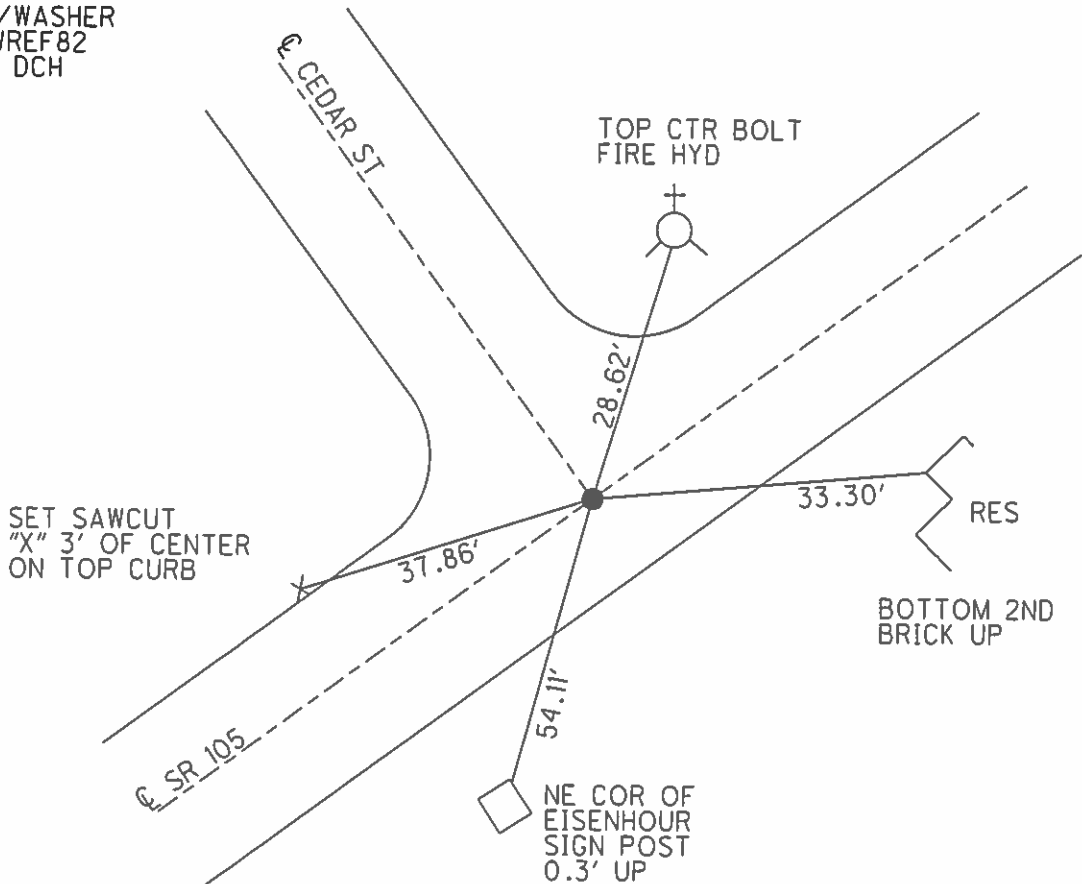

O.D.O.T. DISTRICT 2 SURVEY OFFICE (USE ONLY)

PERSONNEL

REFERENCE NO.

82 A

SHEET

16

OF 17

NOTES

LEU

DATE

04-25-2016

ROUTE

SR 105

H.C.

HOMAN

WEATHER

PARTLY CLDY

COUNTY

WOOD

R.C.

LEU

TEMP.

70°F

TOWNSHIP

FREEDOM

SECTION

10

T 5 N R 12 E

TYPE MONUMENT PK/WASHER


ON SURFACE - ~~BELOW~~ ON

LEFT - ~~Q~~ PAV'T - ~~RIGHT~~ 11.5'

23.3' ~~TORT~~ EDGE PAVEMENT

S.L.M. 514+29

GRID: NORTHING: 637623.185 EASTING: 1706484.828

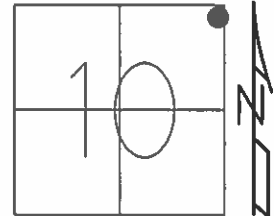

RECORD:

STA 515+83.82

$\Delta=10^{\circ}13'00''$


SET PK/WASHER

11-14-94, MRC

SET MAG/WASHER

GPS, NEWREFA82

09-22-16 DCH

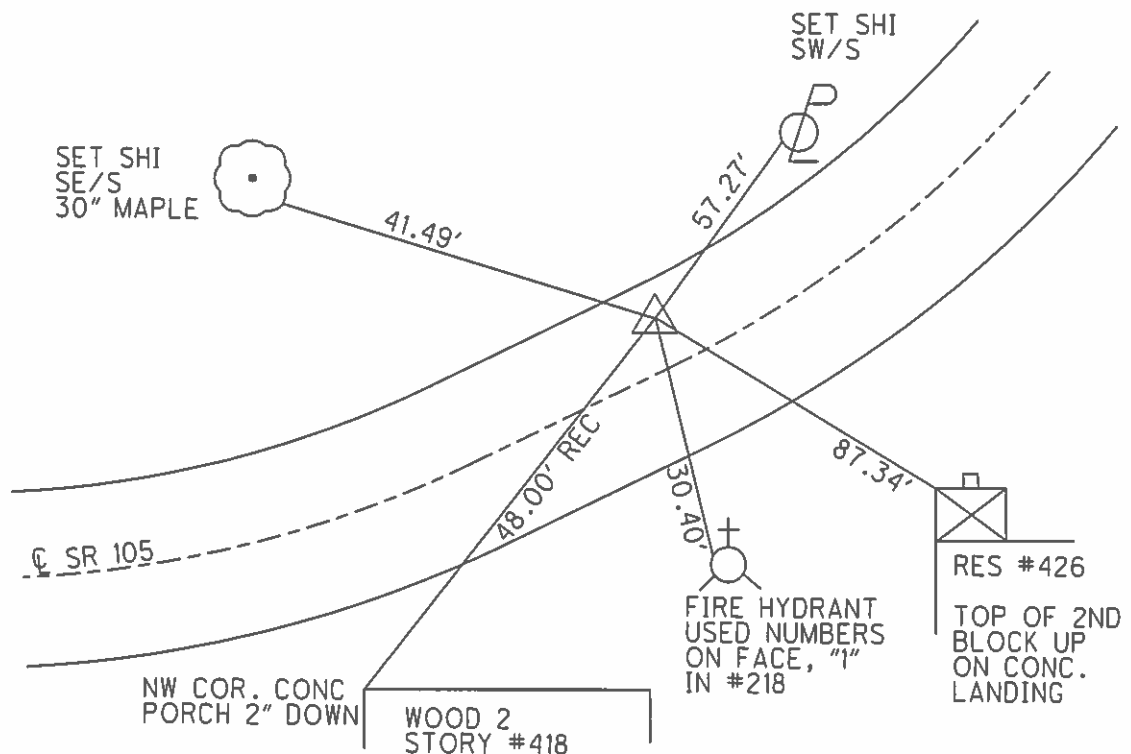


O.D.O.T. DISTRICT 2 SURVEY OFFICE (USE ONLY)

PERSONNEL	REFERENCE NO. <u>83</u>	SHEET <u>17</u> OF <u>17</u>	
NOTES	DATE <u>04-25-16</u>	ROUTE <u>SR 105</u>	
H.C. <u>LEU</u>	WEATHER <u>PARTLY CLDY</u>	COUNTY <u>WOOD</u>	
R.C. <u>HOMAN</u>	TEMP. <u>70°F</u>	TOWNSHIP <u>FREEDOM</u>	
		SECTION <u>10</u>	
		T <u>5</u> N R <u>12</u> E	

TYPE MONUMENT MAG/WASHER
 ON SURFACE - ~~BELOW~~ ON
~~LEFT~~ - Q PAV'T - RIGHT 2.5'
- TO - EDGE PAVEMENT
 S.L.M. 516+67

GRID: NORTHING: 637731.1627 EASTING: 1706700.818

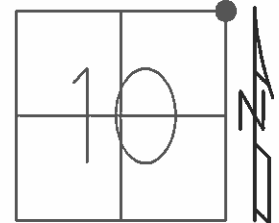

RECORD: P.O.T.
 STA 518+25.16


SET PK/WASHER
 11-17-94, MRC

FD HOLE
 SET MAG/WASHER
 GPS, REF83
 10/11/11, RJL

GPS, REF83
 7/22/15, JFO

FD MAG/WASHER
 09-22-16 DCH


SET MAG/WASHER
 NEWREF83
 9/7/16, JFO

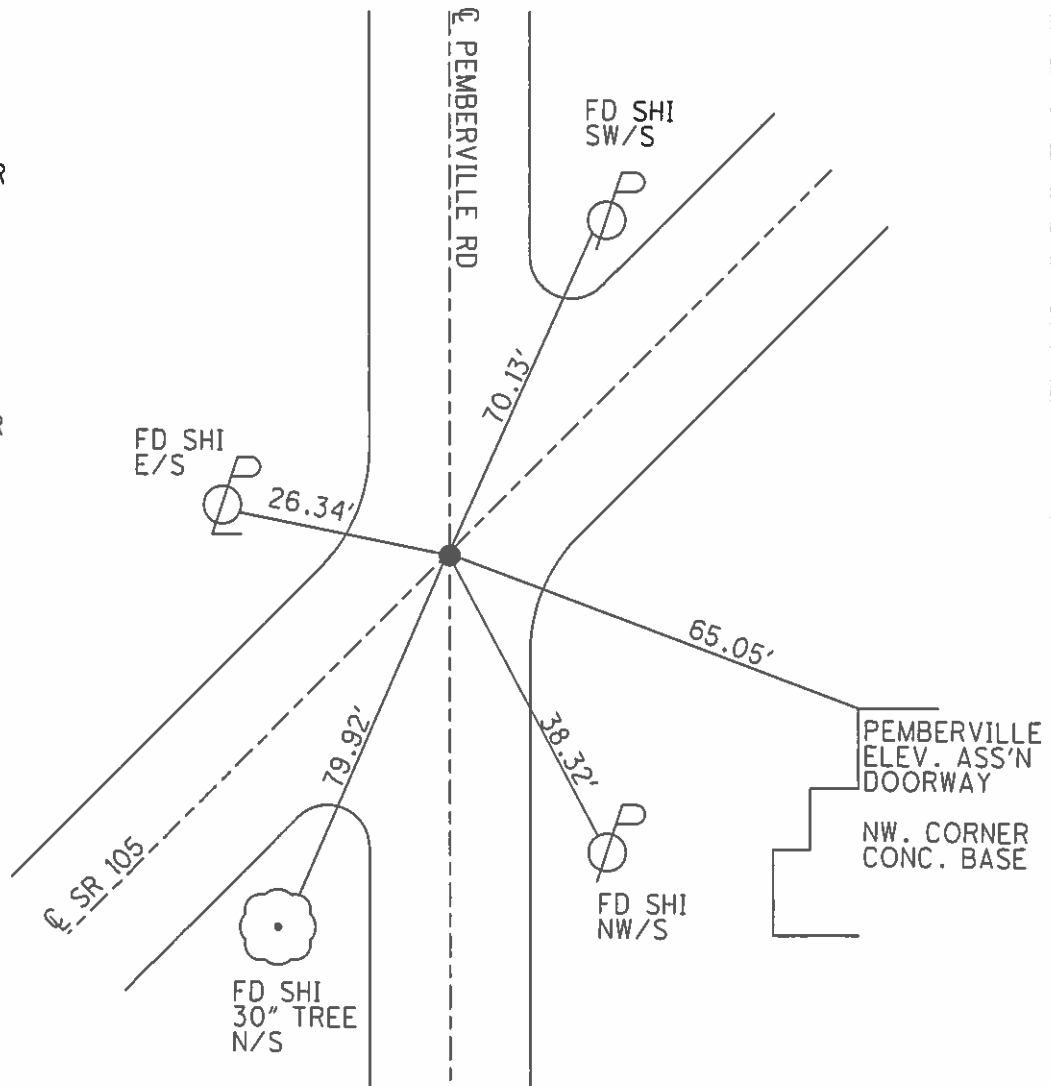

O.D.O.T. DISTRICT 2 SURVEY OFFICE (USE ONLY)

PERSONNEL _____ REFERENCE NO. 84 SHEET 2 OF 13
 NOTES RHOADES DATE 7-22-15 ROUTE SR 105
 H.C. LEU WEATHER CLOUDY COUNTY WOOD
 R.C. O'DONNELL TEMP. 77° TOWNSHIP FREEDOM
 SECTION 2
 T 5 N R 12 E

TYPE MONUMENT PK. NAIL
 ON SURFACE - ~~BELOW~~ ON
~~LEFT~~ - Q PAV'T - RIGHT 0.8'
8.9' TO RT. EDGE PAVEMENT
 S.L.M. 529+81.68
 Grid: Northing: 638374.8865 Easting: 1708025.6102

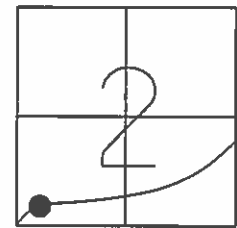

FD. PK/WASHER
 GPS, REF84
 10-11-11, RDY

GPS, REF84
 7-22-15

SET MAG/WASHER
 GPS, NEWREF84
 8-22-16, JFO

RES. #579

TOP CONC.
BLOCK LANDING

SET
SHI



89.08'

70.77'

Q SR 105

FD SHI
SW/S



25.82'

APPARENT PEMBERVILLE CORP LIMIT

47.49'

FD SHI
SW/S



45.20'

CORNER OF
SIDING 1' UP

RES. #2681



O.D.O.T. DISTRICT 2 SURVEY OFFICE (USE ONLY)

PERSONNEL

REFERENCE NO.

85

SHEET

3

OF 13

NOTES

RHOADES

DATE

7-22-15

ROUTE

SR 105

H.C.

LEU

WEATHER

CLOUDY

COUNTY

WOOD

R.C.

O'DONNEL

TEMP.

77°

TOWNSHIP

FREEDOM

SECTION

2

T 5 N

R 12 E

TYPE MONUMENT

1/2" IPIN

~~ON SURFACE~~ - BELOW

3"

LEFT - Q PAV'T - ~~RIGHT~~

14.5'

2.5' N TO N EDGE PAVEMENT

S.L.M.


536+38.68

Grid: Northing:

638652.7317

Easting:

1708620.9183

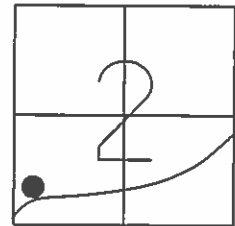

RECORD $\Delta=25^{\circ}38'$

P.I. STA. 536+56.00

FD. 1/2" IPIN

GPS. REF85

10-11-11, RJL


GPS, REF85

7-22-15

FD. 1/2" IPIN

8-22-16, JFO

NO TIES MADE
FOR THIS POINT

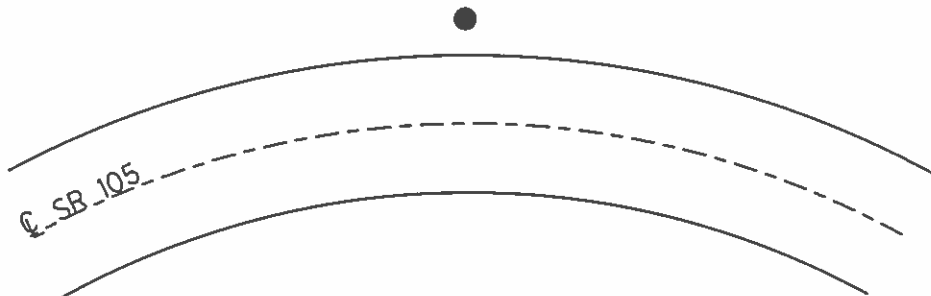

O.D.O.T. DISTRICT 2 SURVEY OFFICE (USE ONLY)

PERSONNEL

REFERENCE NO.

86

SHEET

4

OF 13

NOTES WESTFALL

DATE

10-21-13

ROUTE

SR 105

H.C. WESTFALL

WEATHER

PTLY CLOUDY

COUNTY

WOOD

R.C. LEU

TEMP.

53°F

TOWNSHIP

FREEDOM

SECTION

2

T 5 N R 12 E

TYPE MONUMENT 5/8" IPIN


~~ON SURFACE~~ - BELOW 4"

~~LEFT~~ - CL PAV'T - RIGHT 34.5'

26' TO RT EDGE PAVEMENT

S.L.M. 556+66.49

Grid: Northing: 638630.8630 Easting: 1710648.6110

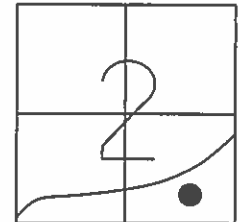

RECORD 559+20.60

$\Delta=46^{\circ}80'60''$


P.I. 77

FD. 5/8" IPIN

GPS, REF86

GPS, REF86

7-22-15

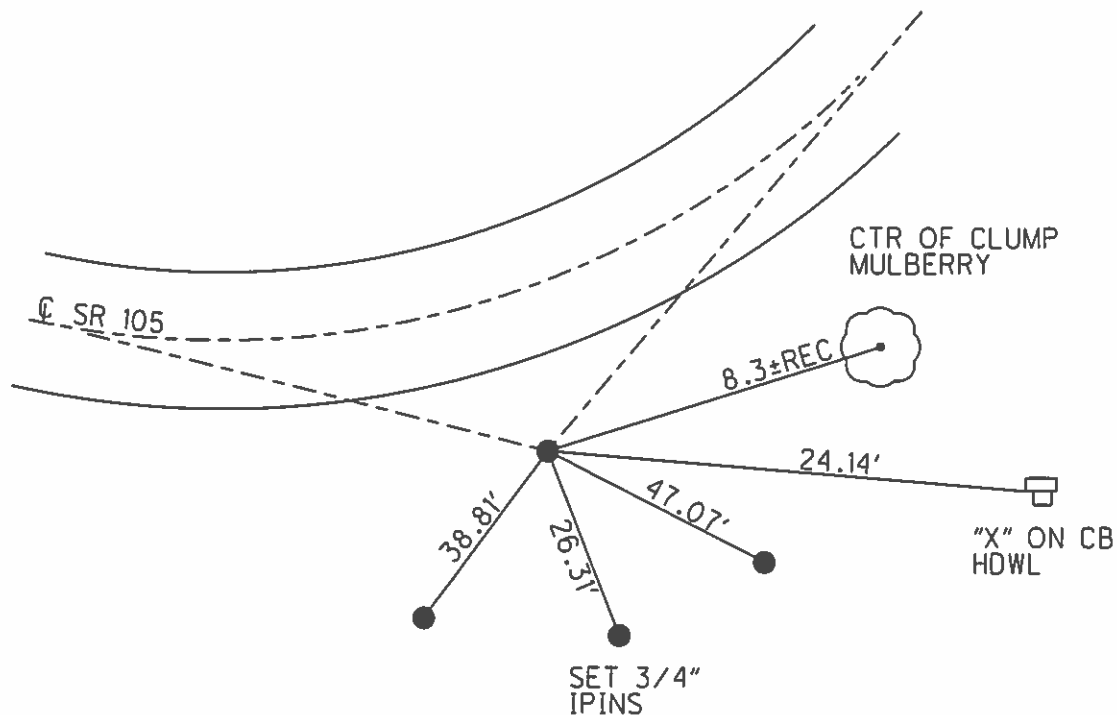

O.D.O.T. DISTRICT 2 SURVEY OFFICE (USE ONLY)

PERSONNEL _____ REFERENCE NO. 87 SHEET 5 OF 13
 NOTES WESTFALL DATE 10-21-13 ROUTE SR 105
 H.C. LEU WEATHER PTLY CLOUDY COUNTY WOOD
 R.C. WESTFALL TEMP. 53°F TOWNSHIP FREEDOM
 SECTION 2
 T 5 N R 12 E

TYPE MONUMENT PK NAIL/WASHER


~~ON SURFACE~~ - BELOW 1/2"

LEFT - CL PAV'T - RIGHT ON

- TO - EDGE PAVEMENT

S.L.M. 575+86.68

Grid: Northing: 640019.2762 Easting: 1711975.0825

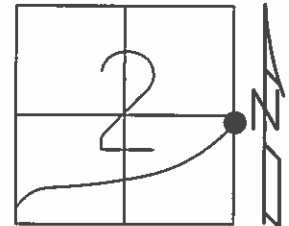

RECORD: P.I. #78
 STA. 578+85.50


SET PK/WASHER
 11-17-94, MRC

PREVENTIVE MAINTENANCE
 CHIP & SEAL 2004
 EXISTING POINT UNCOVERD
 08-10-04, MC

GPS, REF87
 10-21-13, RJL

GPS, REF87
 7-22-15, JLL

SET MAG/WASHER
 GPS, NEWREF87
 9-7-16, JFO

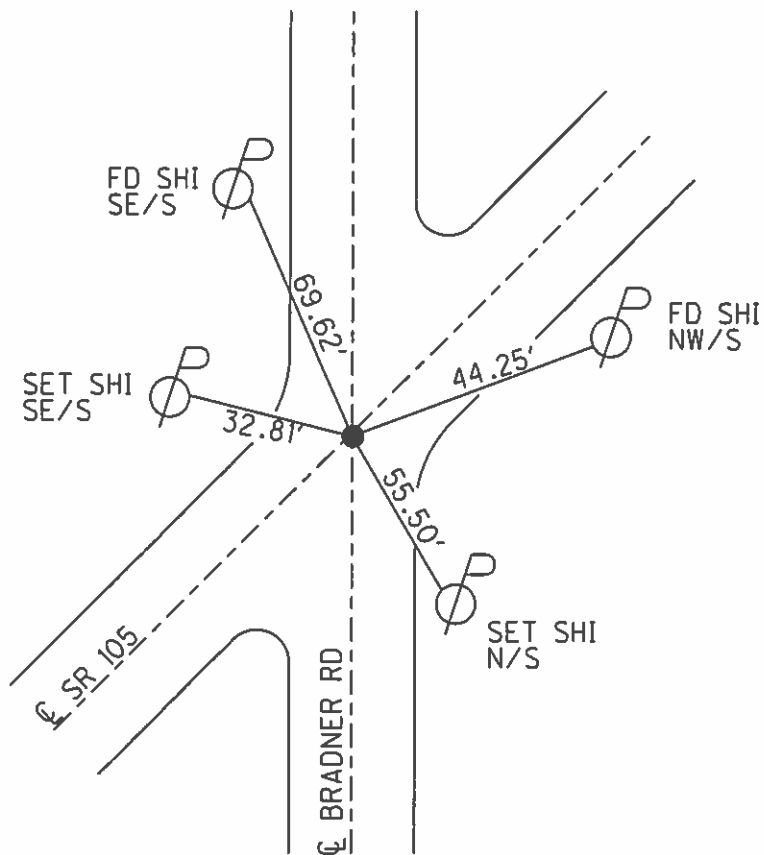

O.D.O.T. DISTRICT 2 SURVEY OFFICE (USE ONLY)

PERSONNEL

REFERENCE NO.

87 A

SHEET

6

OF 13

NOTES WESTFALL

H.C. LEU

R.C. WESTFALL

DATE

10-21-13

WEATHER

PTLY CLOUDY

TEMP.

53°F

ROUTE

SR 105

COUNTY

WOOD

TOWNSHIP

FREEDOM

SECTION

1

T 5 N

R 12 E

TYPE MONUMENT PK NAIL/WASHER


ON SURFACE - BELOW ON

LEFT - $\odot$ PAV'T - RIGHT 1'

11' TO LT EDGE PAVEMENT

S.L.M. 583+76.09

Grid: Northing: 640593.4267 Easting: 1712516.8481

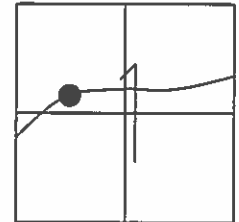

RECORD STA. 586+75.02


SET PK/WASHER
11-17-94, MAC

PREVENTIVE MAINTENANCE
CHIP & SEAL 2004
EXISTING POINT UNCOVERD
08-10-04, MC

FD PK/WASHER
GPS, REF95
10-21-13, RJL

GPS, REFA87
7-22-15, JLL

SET MAG/WASHER
GPS, NEWREFA87
9-7-16, JFO

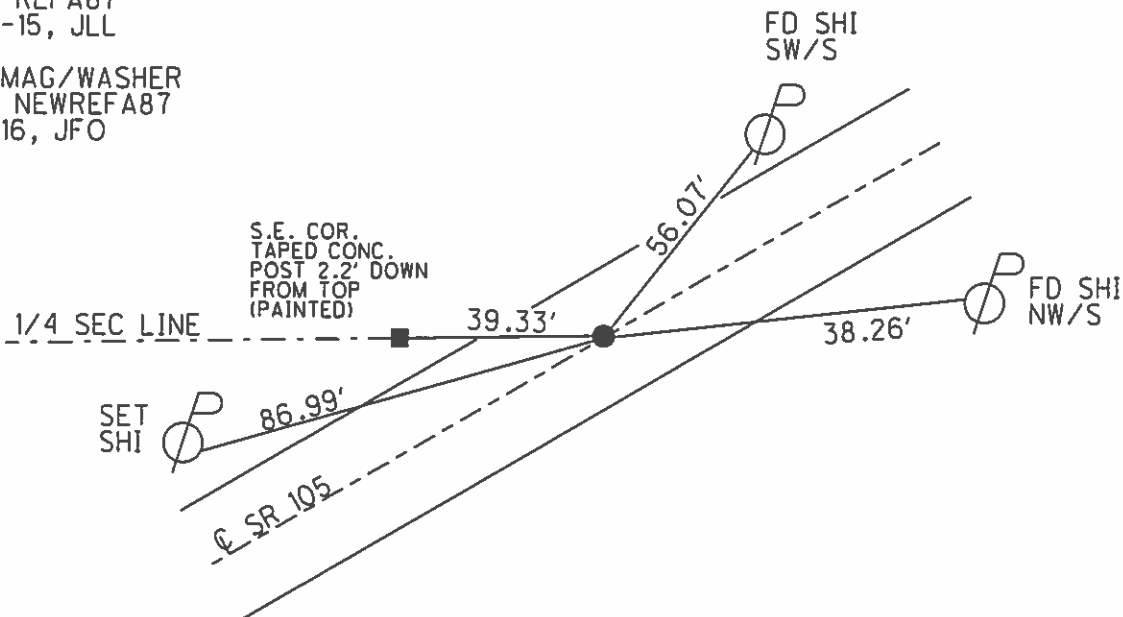

O.D.O.T. DISTRICT 2 SURVEY OFFICE (USE ONLY)

PERSONNEL	REFERENCE NO. <u>88</u>	SHEET <u>7</u> OF <u>13</u>
NOTES <u>WESTFALL</u>	DATE <u>10-21-13</u>	ROUTE <u>SR 105</u>
H.C. <u>LEU</u>	WEATHER <u>PTLY CLOUDY</u>	COUNTY <u>WOOD</u>
R.C. <u>WESTFALL</u>	TEMP. <u>53°F</u>	TOWNSHIP <u>FREEDOM</u>
		SECTION <u>1</u>
		<u>T 5 N R 12 E</u>

TYPE MONUMENT PK NAIL/WASHER


ON SURFACE - ~~BELOW~~ ON

~~LEFT~~ - Q PAV'T - RIGHT 3'

6.3' TO RT EDGE PAVEMENT

S.L.M. 585+27.44

Grid: Northing: 640703.5096 Easting: 1712620.7462

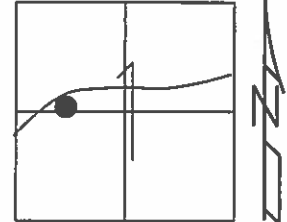

RECORD: P.I. #79
STA. 588+26.58
 $\Delta=4^{\circ}17'20''$ LT


SET PK/WASHER
11-17-94, MRC

PREVENTIVE MAINTENANCE
CHIP & SEAL 2004
EXISTING POINT UNCOVERED
08-10-04, MC

FD PK/WASHER
GPS, REF88
10-21-13, RJL

GPS, REF88
7-27-15, JFO

SET MAG/WASHER
GPS, NEWREF88
9-7-16, JFO

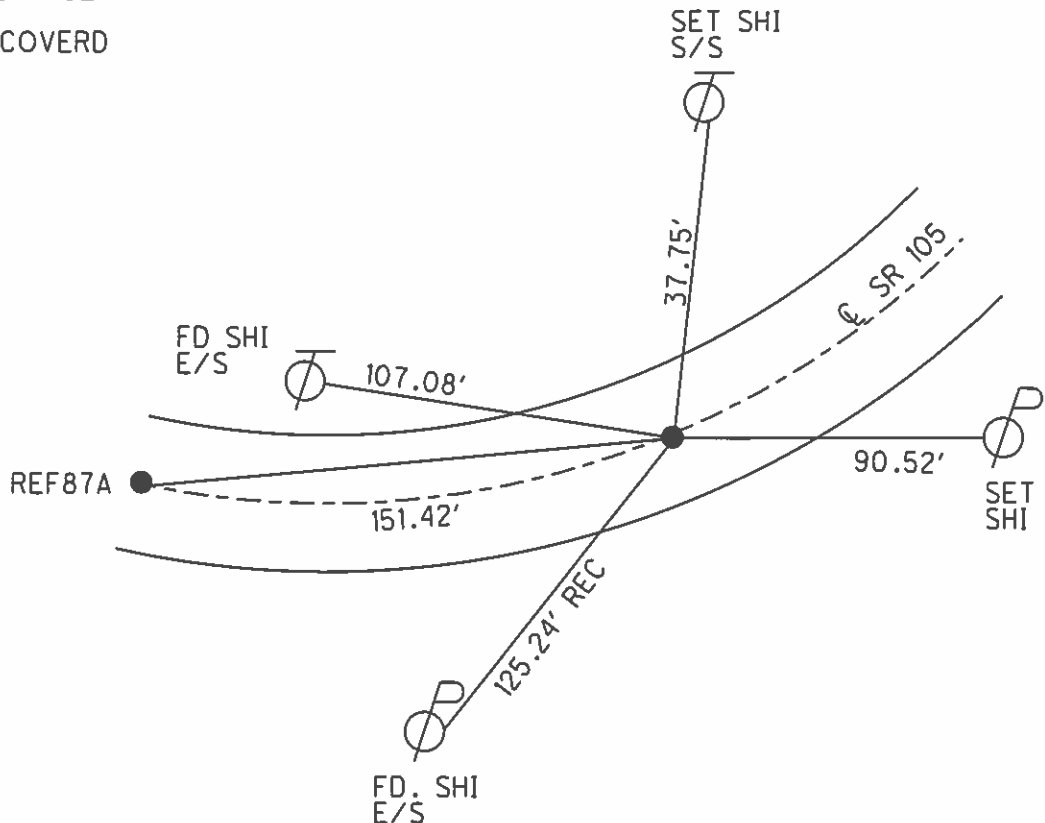

O.D.O.T. DISTRICT 2 SURVEY OFFICE (USE ONLY)

PERSONNEL

REFERENCE NO.

89

SHEET

8

OF 13

NOTES WESTFALL

DATE

10-17-13

ROUTE

SR 105

H.C. LEU

WEATHER

CLOUDY

COUNTY

WOOD

R.C. WESTFALL

TEMP.

47°F

TOWNSHIP

FREEDOM

SECTION

1

T 5 N R 12 E

TYPE MONUMENT 5/8" REBAR


~~ON SURFACE~~ - BELOW 1'

LEFT - C PAV'T - ~~RIGHT~~ 29.5'

20' TO LT EDGE PAVEMENT

S.L.M. 593+05.05

Grid: Northing: 641307.9645 Easting: 1713111.1669

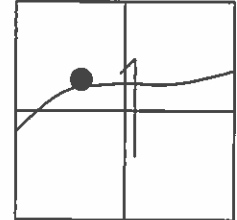

RECORD: STA 596+05.31

P.I. 80

$\Delta = 39^\circ 39' 40''$ RT.


30.0' LT OF C PAVT

GPS, REF89

10-17-13, RJL

GPS, REF89

7-27-15, JFO

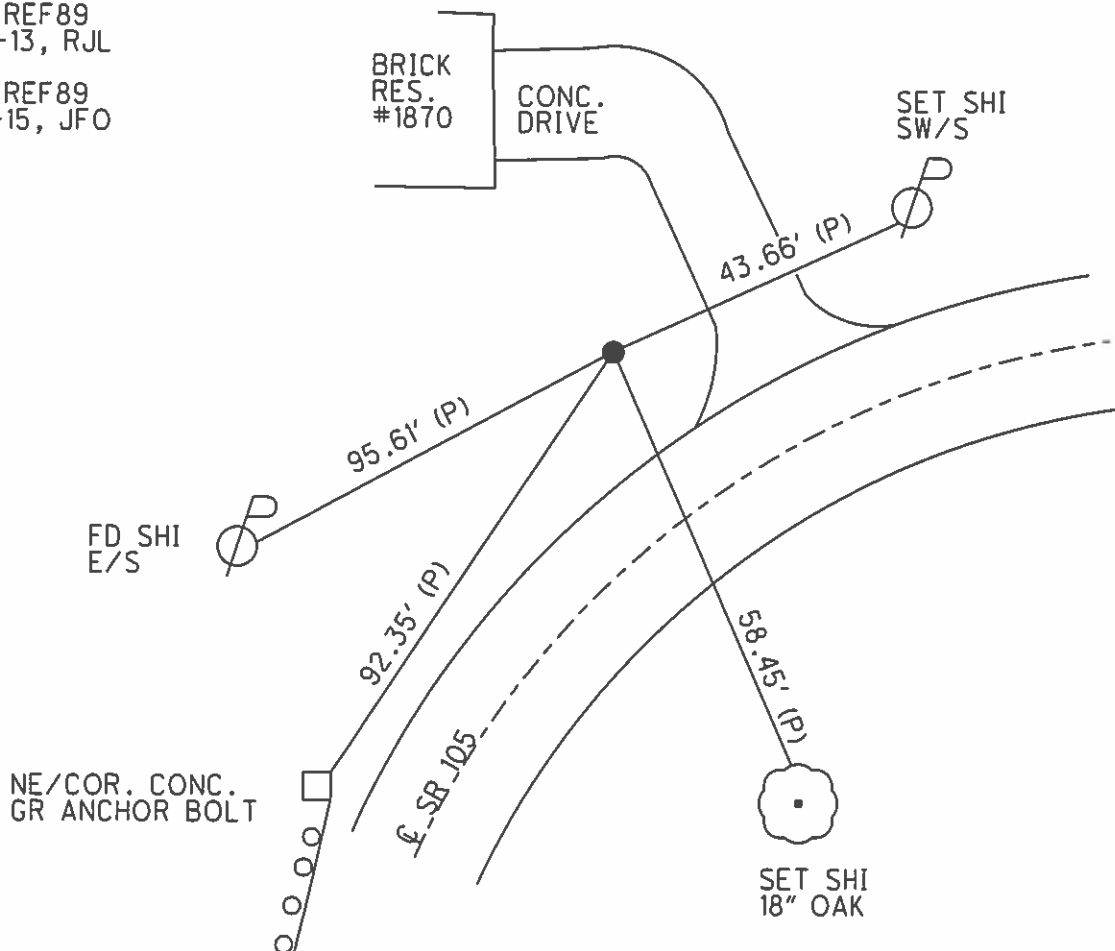

O.D.O.T. DISTRICT 2 SURVEY OFFICE (USE ONLY)

PERSONNEL

REFERENCE NO.

90

SHEET

9

OF 13

NOTES WESTFALL

DATE

10-17-13

ROUTE

SR 105

H.C. LEU

WEATHER

CLOUDY

COUNTY

WOOD

R.C. WESTFALL

TEMP.

47°F

TOWNSHIP

FREEDOM

SECTION

12

T 5 N

R 12 E

TYPE MONUMENT P.K. NAIL


~~ON SURFACE~~ - BELOW 0.1'

LEFT - $\odot$ PAV'T - ~~RIGHT~~ 12'

2' TO LT EDGE PAVEMENT

S.L.M. 599+09.62

Grid: Northing: 641426.5785 Easting: 1713703.2199

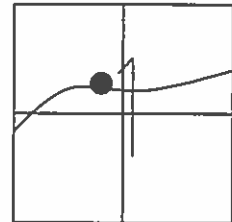


RECORD: STA. 602+09.08 P.I.#81
 $\Delta=8^{\circ}26'40''$

SET 60-0 SPIKE ON
N. EDGE OF PAVED BERM
11-17-94, MRC

GPS, REF90
10-17-13, RJL

FD PK. NAIL
0.1' DOWN
GPS, REF90
7-27-15, JFO

SET MAG NAIL
ON LT. EB
GPS, NEWREF90
9-7-16, JFO

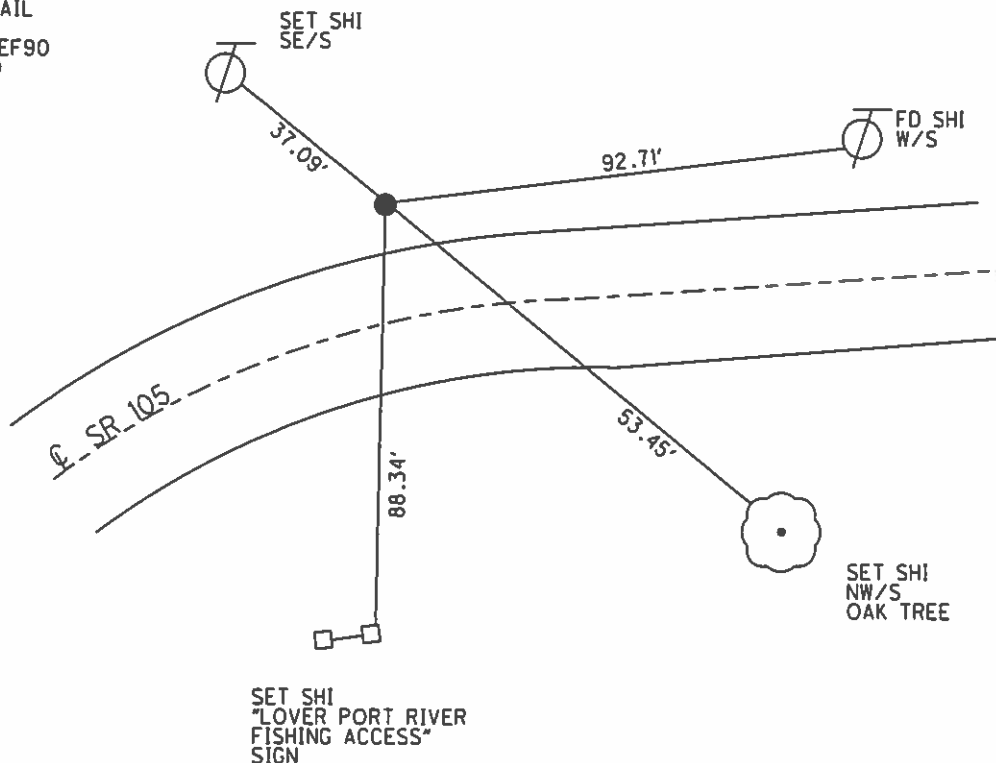

O.D.O.T. DISTRICT 2 SURVEY OFFICE (USE ONLY)

PERSONNEL

REFERENCE NO. 91

SHEET 10 OF 13

NOTES WESTFALL

DATE 10-17-13

ROUTE SR 105

H.C. LEU

WEATHER CLOUDY

COUNTY WOOD

R.C. WESTFALL

TEMP. 47°F

TOWNSHIP FREEDOM

SECTION 1

T 5 N R 12 E

TYPE MONUMENT PK/WASHER


ON SURFACE - ~~BELOW~~ ON

LEFT - Q PAV'T - ~~RIGHT~~ 10.9'

0.2' LT TO LT EDGE PAVEMENT

S.L.M. 604+93.91

Grid: Northing: 641455.2893 Easting: 1714286.8104

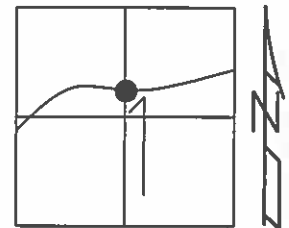

RECORD: STA 607+93.71

P.I. #82

$\Delta 16^{\circ}52'00''$ RT.

SET PK/WASHER

11-17-94, MRC

PREVENTIVE MAINTENANCE

CHIP & SEAL 2004

EXISTING POINT UNCOVERD

08-10-04, MC

GPS, REF91

10-17-13, RJL


GPS, REF91

7-27-15, JFO

SET MAG/WASHER

GPS, NEWREF91


9-7-16, JFO

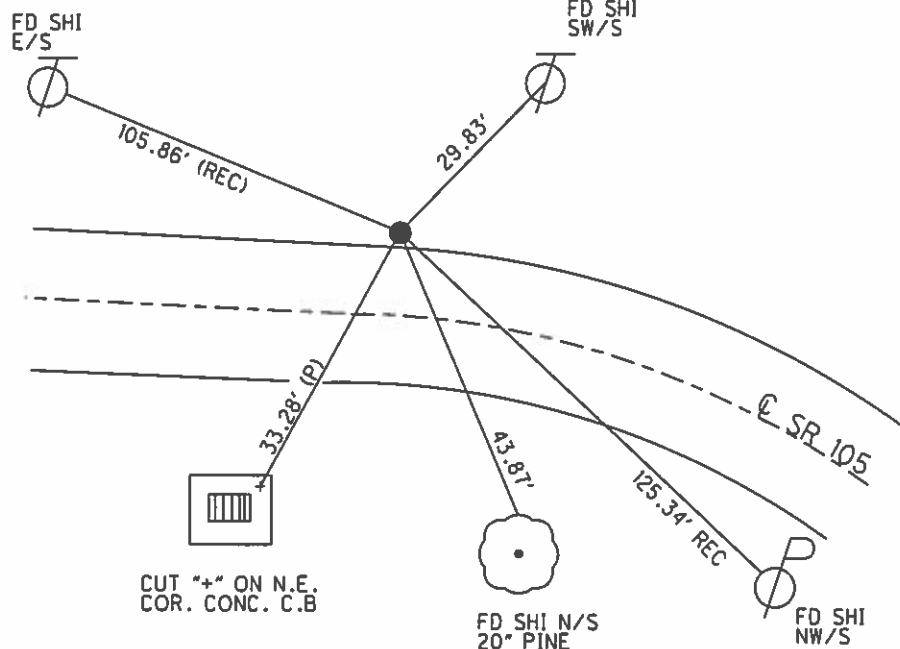

O.D.O.T. DISTRICT 2 SURVEY OFFICE (USE ONLY)

PERSONNEL _____ REFERENCE NO. 92 SHEET 11 OF 13
 NOTES WESTFALL DATE 10-17-13 ROUTE SR 105
 H.C. LEU WEATHER CLOUDY COUNTY WOOD
 R.C. WESTFALL TEMP. 47°F TOWNSHIP FREEDOM
 _____ SECTION 1
 _____ T 5 N R 7 E

TYPE MONUMENT 5/8" IPIN
~~ON SURFACE~~ - BELOW 0.7'
~~LEFT~~ - CL PAV'T - RIGHT 56'
45' TO RT EDGE PAVEMENT
 S.L.M. 615+71.81

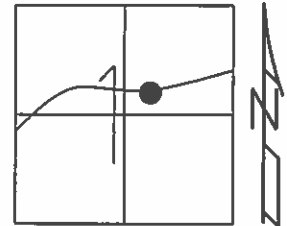


Grid: Northing: 641194.5612 Easting: 1715332.6317

RECORD: STA 618+71.96
 P.I. #83
 $\Delta = 46^\circ 26' 00''$ LT
 POINT LOCATED IN FIELD

FD IPIN
 11-17-94, MRC

GPS, REF92
 10-17-13, RJL

GPS, REF92
 7-27-15, JFO

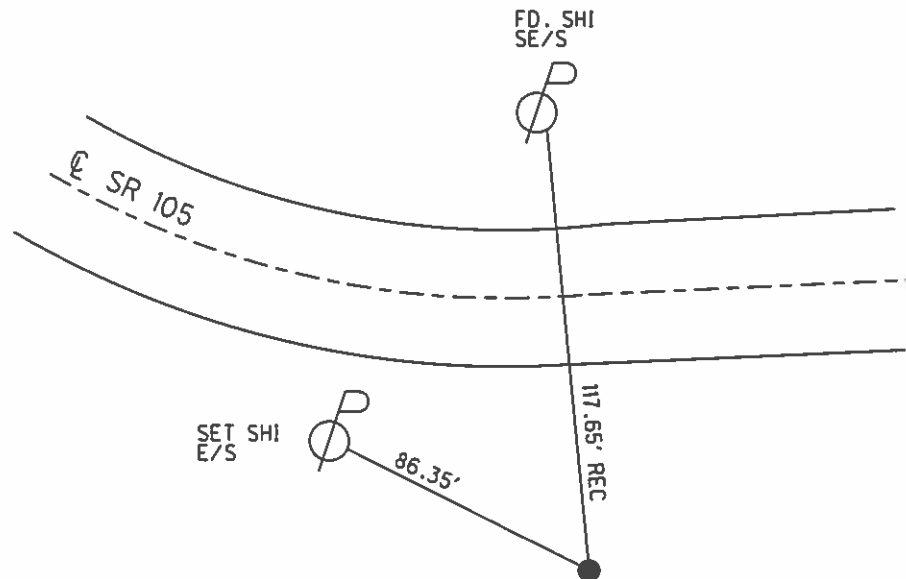


O.D.O.T. DISTRICT 2 SURVEY OFFICE (USE ONLY)

PERSONNEL _____ REFERENCE NO. 93 SHEET 12 OF 13
 NOTES WESTFALL DATE 10-21-13 ROUTE SR 105
 H.C. LEU WEATHER PTLY CLOUDY COUNTY WOOD
 R.C. WESTFALL TEMP. 53°F TOWNSHIP FREEDOM
 _____ SECTION 1
 _____ T 5 N R 12 E

TYPE MONUMENT PK NAIL/WASHER
 ON SURFACE - ~~BELOW~~ ON
 LEFT - ℄ PAV'T - ~~RIGHT~~ 5.0'
4.3' TO LT EDGE PAVEMENT
 S.L.M. 628+02.48

Grid: Northing: 641897.3109 Easting: 1716439.1301

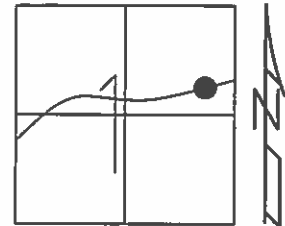

RECORD: STA 631+83.40
 P.I. 84
 $\Delta=7^{\circ}02'00''$


SET PK/WASHER
 11-17-94, MRC

PREVENTIVE MAINTENANCE
 CHIP & SEAL 2004
 EXISTING POINT UNCOVERD
 08-10-04, MC

FD. PK
 GPS, REF93
 10-21-13, RJL

GPS, REF93
 7-27-15, JFO

SET MAG/WASHER
 GPS, NEWREF93
 9-7-16, JFO

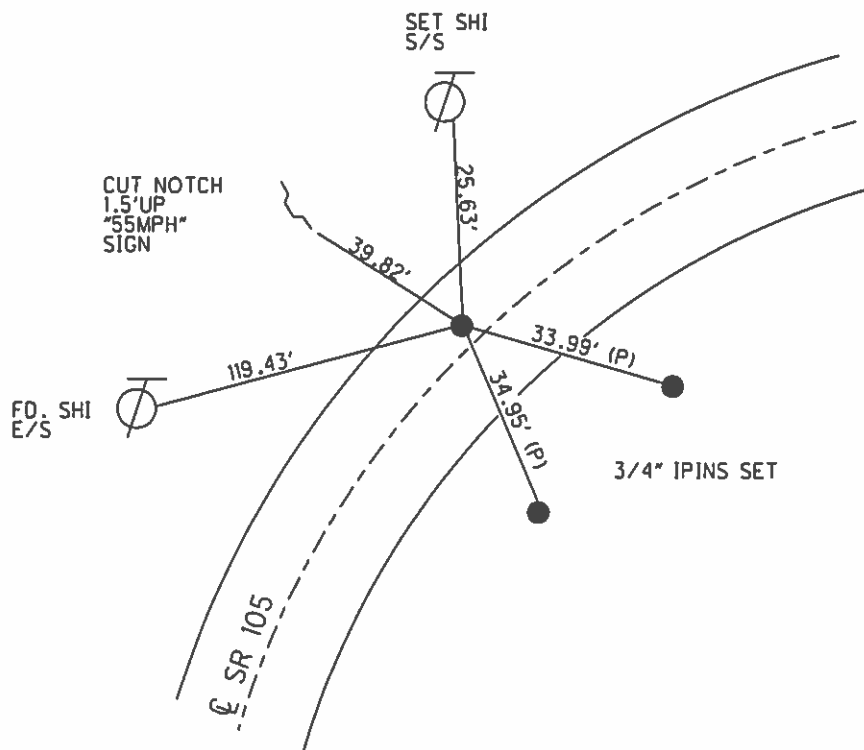

O.D.O.T. DISTRICT 2 SURVEY OFFICE (USE ONLY)

PERSONNEL

REFERENCE NO.

94

SHEET

13

OF 13

NOTES HUSS

DATE

4-20-12

ROUTE

SR 105

H.C. CANTERBURY

WEATHER

CLEAR

COUNTY

WOOD

R.C. HOMAN

TEMP.

62°F

TOWNSHIP

FREEDOM

SECTION

1

T 5 N R 12 E

TYPE MONUMENT LG RR. SPIKE


~~ON SURFACE~~ - BELOW 0.3'

LEFT - ℄ PAV'T - RIGHT ON

- TO - EDGE PAVEMENT

S.L.M. 639+97.55

Grid: Northing: 642375.5228 Easting: 1717446.2929

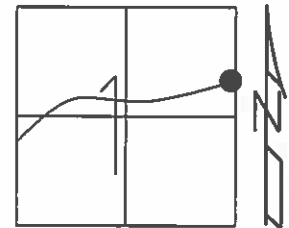

SET SMALL R.R.SPIKE
6/15/90, DJC

NOTE: REF 49- US 23

FD SM.R.R.SPIKE
7/2/10
GPS, CP49
8/10/10, MC

SET MAG/WASHER
12/11/12, SAH
GPS, FIN49
3/13/13, MC

FD MAG/WASHER
REF 94
10/21/13, RJL

