

O.D.O.T. DISTRICT 2 SURVEY OFFICE (USE ONLY)

PERSONNEL

REFERENCE NO. F

SHEET 6 OF 28

NOTES ASTON

DATE 4/12/2024

ROUTE SR 105

H.C. MILLER

WEATHER CLOUDY

COUNTY WOOD

R.C. NIESE

TEMP. 30°

TOWNSHIP CENTER

SECTION 22

DWG BY _____ PID NO PID

T 5 N R 11 E

TYPE MONUMENT MAG & WASHER

ON SURFACE - BELOW ON

OFFSET Q PAVEMENT 0.5' ~~LT~~ : RT

11.2' TO RT EDGE PAVEMENT


STATION: 107+49

HORIZ.DATUM: LDP:WOOD


GEOID: 18

GRID: NORTHING: 623917.784

EASTING: 1672227.236

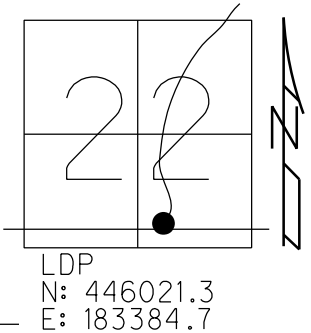


RECORD:
FD P.K./WASHER
4/6/02, DCH
SET P.K./WASHER
5-31-02, DCH
FD R.R.SPIKE
6" DOWN
REF F
6/2/16, JFO
SET MAG/WASHER
NEWREFF
10/5/16, JFO
FD MAG/W
REF F
4-12-24/ JAM

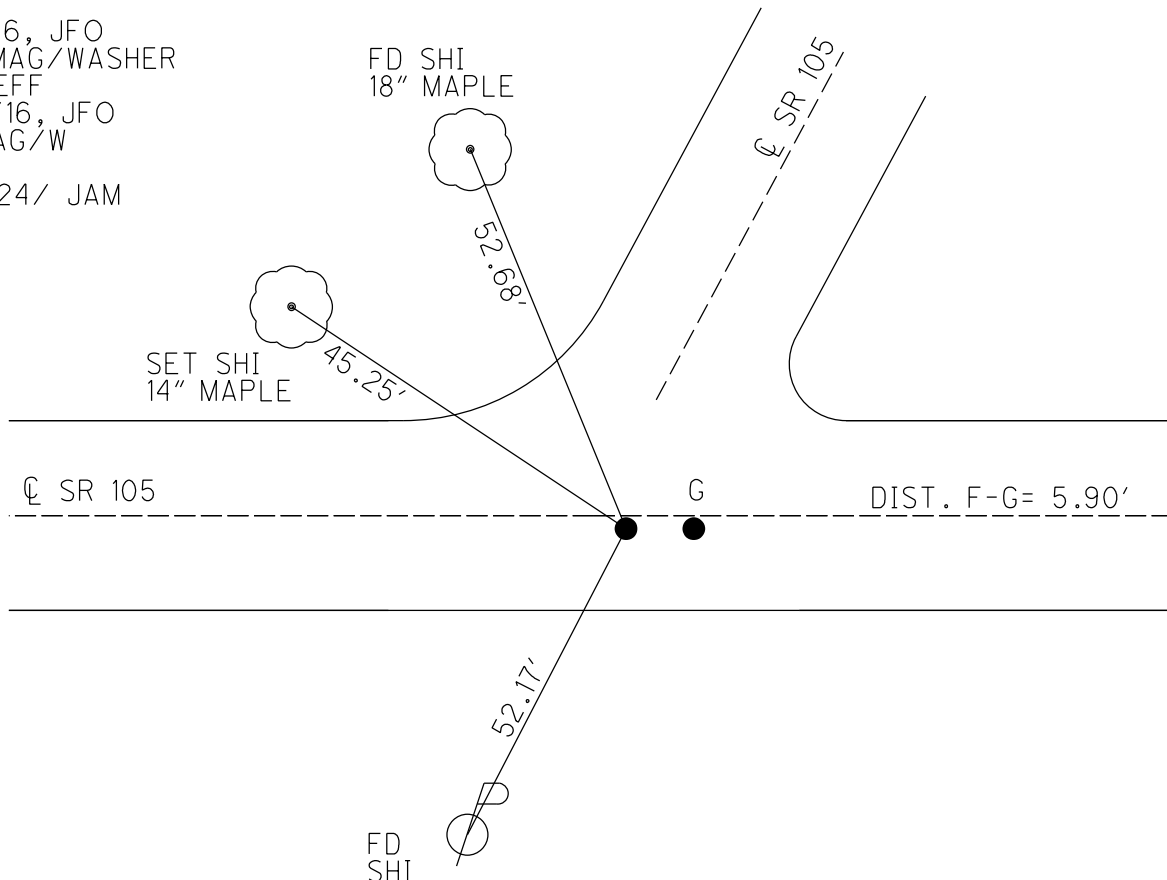

O.D.O.T. DISTRICT 2 SURVEY OFFICE (USE ONLY)


PERSONNEL	REFERENCE NO. <u>F</u>	SHEET <u>6</u> OF <u>28</u>	
NOTES	O'DONNELL	DATE <u>6/2/16</u>	ROUTE <u>SR 105</u>
H.C.	O'DONNELL	WEATHER <u>CLOUDY</u>	COUNTY <u>WOOD</u>
R.C.	KEFFER	TEMP. <u>73°</u>	TOWNSHIP <u>CENTER</u>
			SECTION <u>22</u>
			T <u>5</u> N R <u>11</u> E

TYPE MONUMENT R.R.SPIKE
~~ON SURFACE~~ - BELOW 2"
~~LEFT~~ - ℄ PAV'T - RIGHT 0.5'
11.2' TO RT EDGE PAVEMENT
 S.L.M. 107+49

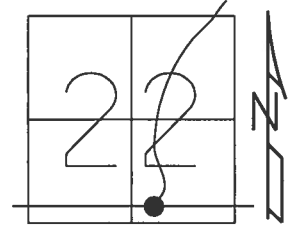

GRID: NORTHING: 623917.784 EASTING: 1672227.236


RECORD:
 FD P.K./WASHER
 4/6/02, DCH
 SET P.K./WASHER
 5-31-02, DCH
 FD R.R.SPIKE
 6" DOWN
 REFF
 6/2/16, JFO
 SET MAG/WASHER
 NEWREFF
 10/5/16, JFO

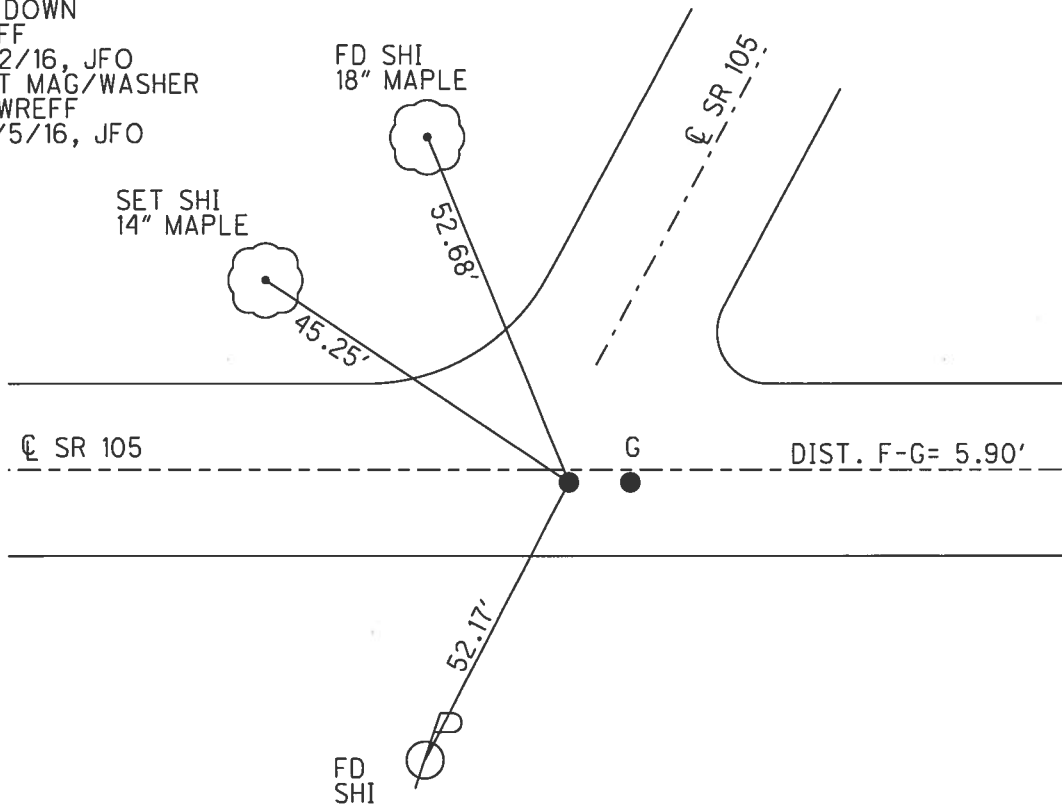

O.D.O.T. DISTRICT 2 SURVEY OFFICE (USE ONLY)


PERSONNEL	REFERENCE NO. <u>F</u>	SHEET <u>6</u> OF <u>21</u>	
NOTES	DATE <u>4/6/02</u>	ROUTE <u>SR 105</u>	
H.C. <u>MOSER</u>	WEATHER <u>PT CLOUDY</u>	COUNTY <u>WOOD</u>	
R.C. <u>HOMAN</u>	TEMP. <u>40°</u>	TOWNSHIP <u>CENTER</u>	
<u>ROUSOS</u>		SECTION <u>22</u>	
<u>CANTERBURY</u>		T <u>5</u> N R <u>11</u> E	

TYPE MONUMENT P.K./WASKER
~~ON SURFACE~~ - BELOW 2"
~~LEFT~~ - Q PAV'T - RIGHT 0.5'
11.2' TO RT EDGE PAVEMENT
 S.L.M. 107+49

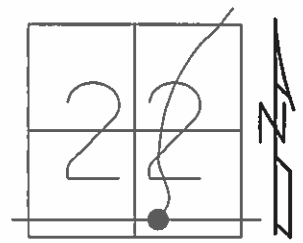

GRID: NORTHING: _____ EASTING: _____

RECORD:
 SET P.K./WASHER
 5-31-02, DCH

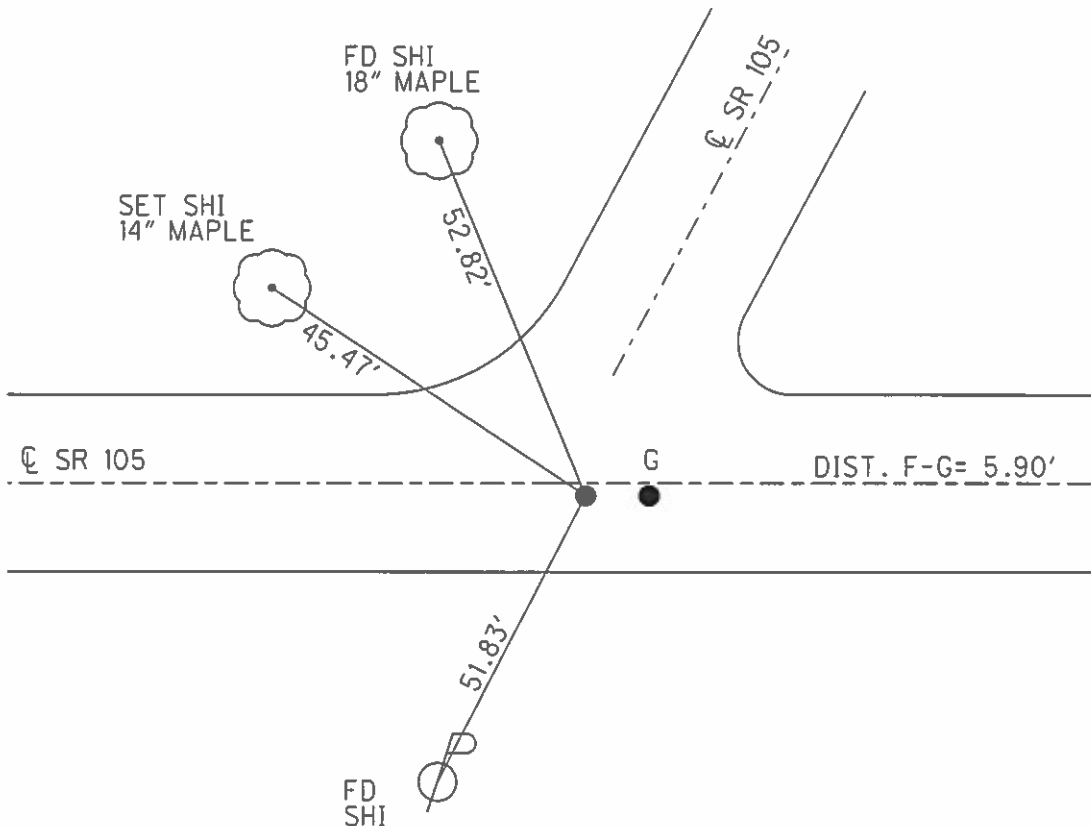

O.D.O.T. DISTRICT 2 SURVEY OFFICE

PERSONNEL

REFERENCE NO. F

SHEET 5 OF 57

NOTES LONG

H.C. VAN DUSEN

R.C. BARNHISEL

DATE 8-12-91

WEATHER SUNNY

TEMP. 85°

ROUTE 105

COUNTY WOOD

TOWNSHIP CENTER

SECTION 22

T 5 N R 11 E

TYPE MONUMENT PK&WASHER


ON SURFACE - BELOW - YES

LEFT- & PAV'T. - RIGHT - 0.5'


11.2' TORT EDGE PAVEMENT

S.L.M. 107+44

5.2 EAST OF & S.R. 105 N.E.

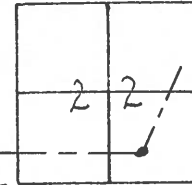


SET PK&WASHER
 4-8-92
 BVD

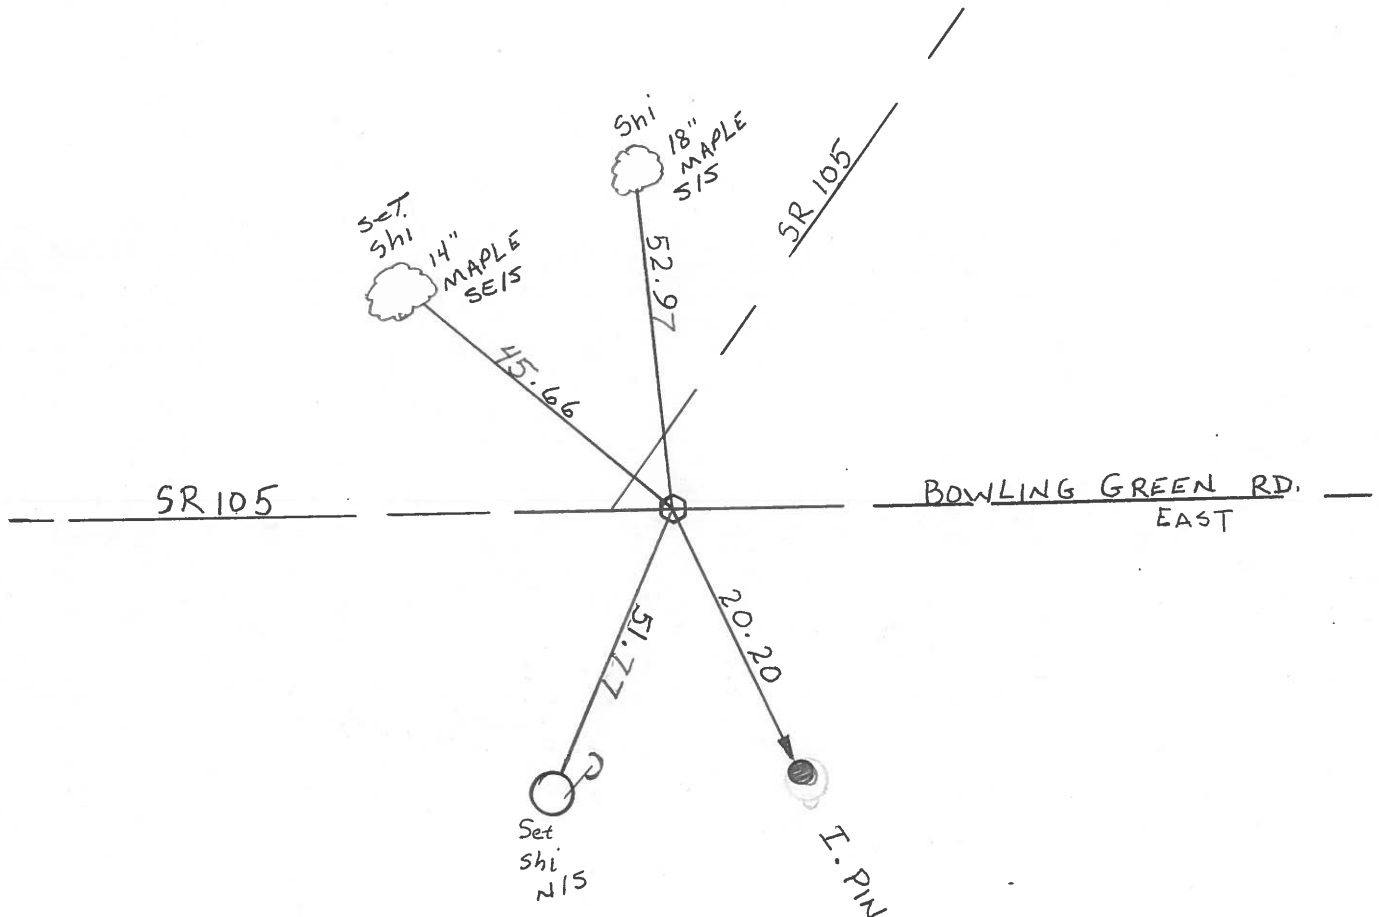

County Wood S.R. 105Township CenterSection 22

TSN, RILE

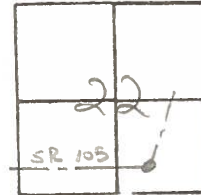Personnel LoffmanLOEHRE H.C.HOUSEHOLDER R.C.BARANISZ P.Date 8-16-84Weather clearTemp. 75°

"F"

Fd R.R. Spk @ surface
ON & past SR 105 West
10.0' to Rt EP


SLM 107+49

5.2' EAST of & past SR 105 N.E.

Set P.K./washer


9-27-84

SWX

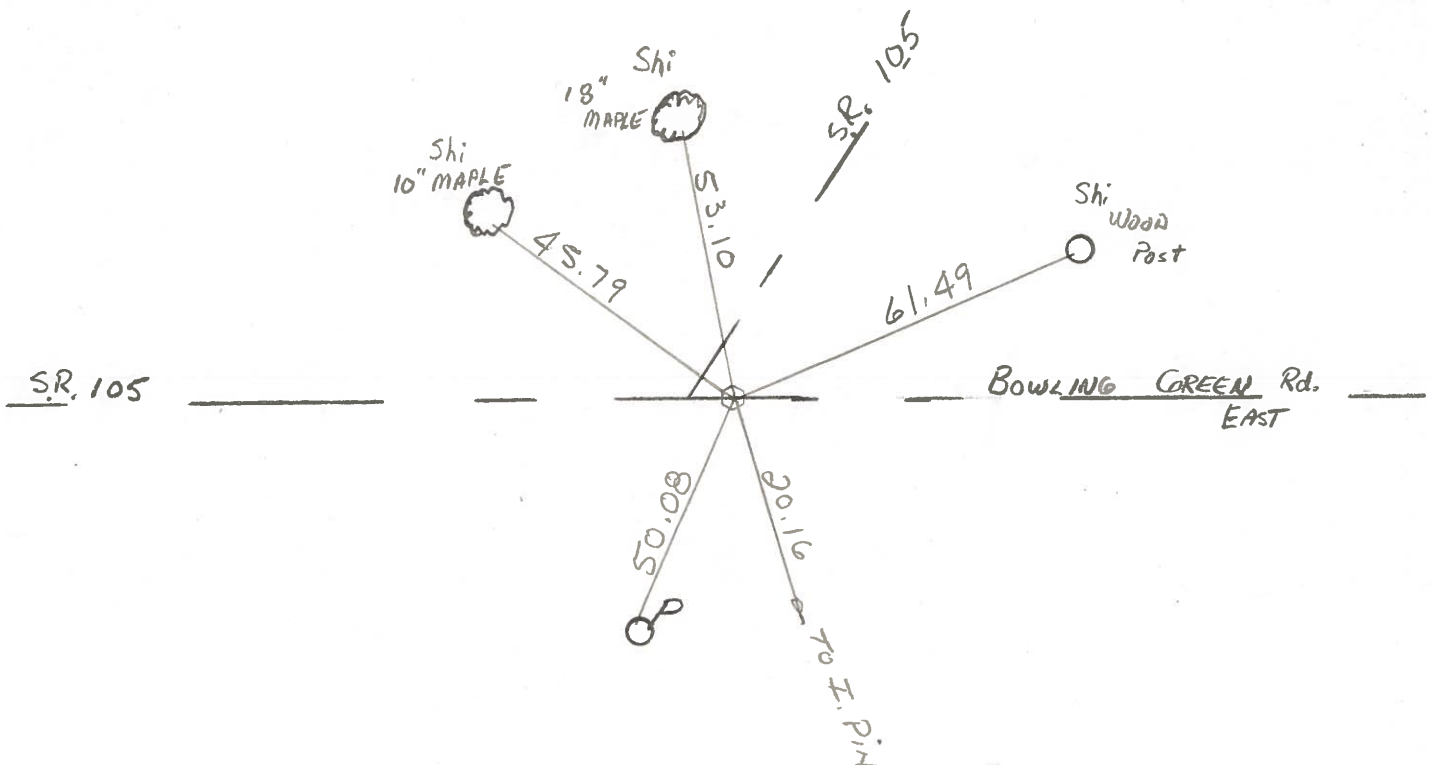


Q.D.O.T. DISTRICT 2 SURVEY OFFICE

SHEET _____ OF _____

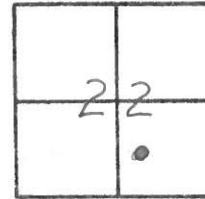County WOOD S.R. 105Township CENTERSection 22T 5 N, R 11 EPersonnel HOFFMANLOEHRKEHOUSE HOLDERDate 4-19-82Weather CLEARTemp. +65°

"F"

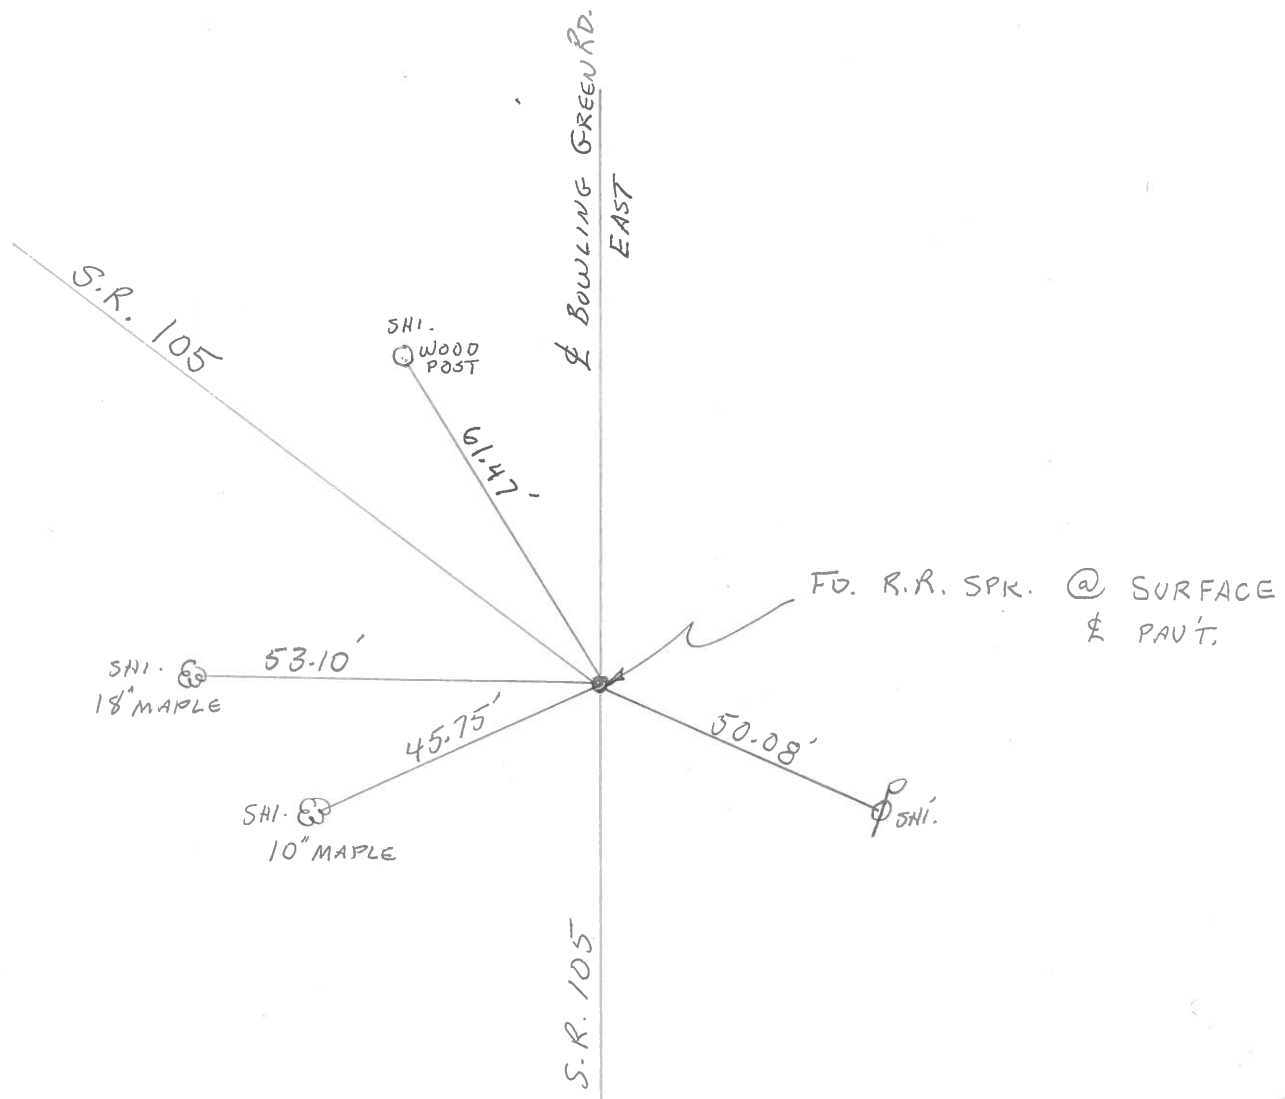

O.D.O.T. DISTRICT 2 SURVEY OFFICE

SHEET

OF

County WOOD S.R. 105

Date 6-10-71

Township CENTER

Weather CLEAR

Section 22

Temp. +72°

TSN, R1/E


Personnel BURNSIDE

SMITH

BOWERS


HOLCOMBE

ROCCINI

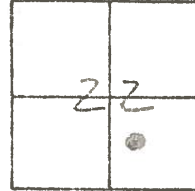

"F"

4-19-82
+65°
SWH

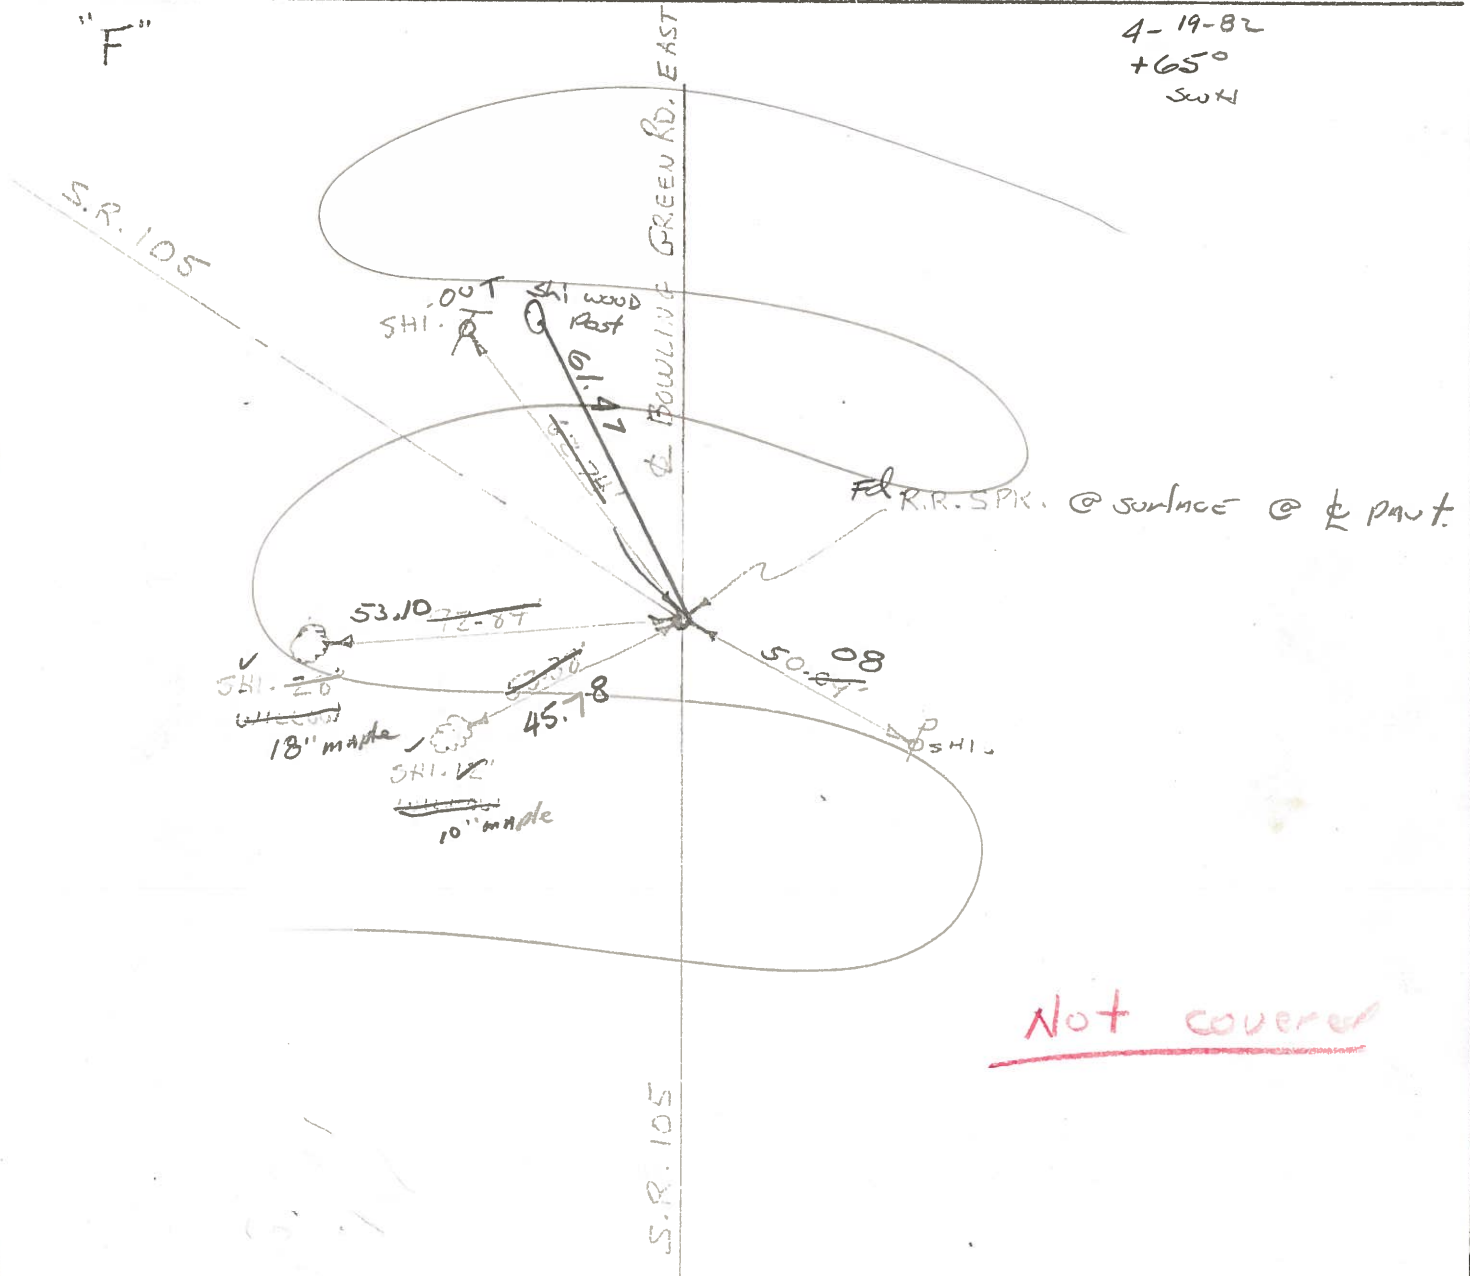

Not covered

PERSONNEL TITLE PERSONNEL TITLE

COUNTY Wood

DATE OK-4-3-58

S.R. U.S.#6

WEATHER 8-24-62
11-1-62
2-28-68
8-21-69

SEC.

TEMP.

DESCRIPTION

LEFT

CENTER LINE

RIGHT

JOB NO.

Sta. 132+31.15
80. Eds. N. of 5/4 post sec.
22 Center Twp. T5N-R11E
Small R.P. Spike set
Dir lam Ed.


OK. 51.92' E.S.E. To Shiner in P. Pole 51.85'
OK. 66.00' N.N.W. to Shiner in T.P. 66.05'
61.64' S.S.E. " " " T.P. 61.60'
45.74' S.W. " " in 34" maple 45.84'
N. to E. of Const. 14.00'
S.W. to N.E. Cor. house @ Cistern 88.35'
N.N.E. To Shiner in P. Pole 46.90'

24" Willow 46.85'
12" Maple 53.41'
OK. 53.41'

Inter section SR#105 &
U.S.#6 R.P. Spike

#31

#31A

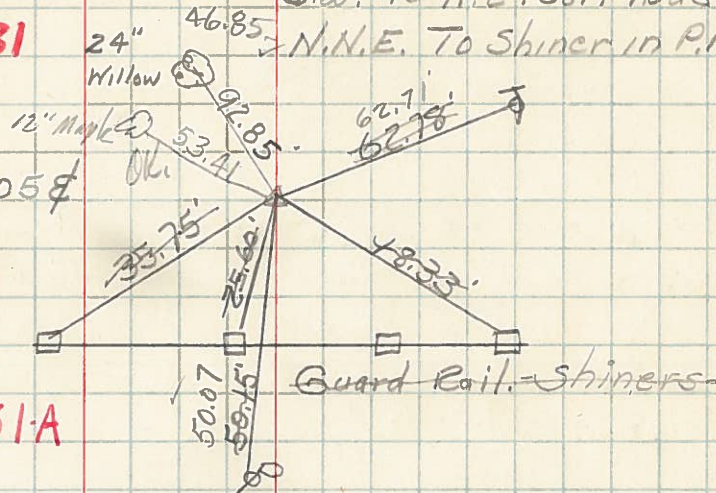

Sta. 159+03.7
E 1/4 post SE 1/4 sec. 22
center twp. T5N-R11E
10' Lt & survey Ed. iron pipe

OK. 36.63' W. to Shiner in 10' Ash 36.80'
OK. 85.90' N.W. " " " T.P. 85.78'
OK. 33.81' E. " " " Cor. fence post 33.81'
OK. 8.50' N.E. " " " 6" Elm. 8.50'
OK. 33.13' West to Shiner in T.P.

#32

Sta. 171+47.08
N.E. cor. sec. 27 Center
Twp. T5N-R11E. Ed. mon.
set boat spk. 10' Lt & survey
(Ed. 3/4 I. Rod 3.3' E. of E. Edge Pavt.)

OK. 9.84' N.E. to shi. in G.P. post 9.84'
OK. 12.67' N.E. to conc. wit. mon. W. Dch. Bank 12.65'
OK. 5.90' S.E. to shi. in Guard rail post 5.90'
OK. 46.34' E. to shi. in W. Post stile 46.34'
OK. 56.65' W. to steel sign post (Buck) 56.65'
OK. 40.00' E. to 1/2" Iron pin Survey Point 40.00'
OK. 47.80' E. to Shiner in W. Bill Board Post 47.80'

#33