

O.D.O.T. DISTRICT 2 SURVEY OFFICE (USE ONLY)

PERSONNEL

REFERENCE NO. G

SHEET 8 OF 30

NOTES

MOSER

DATE

4/6/02

ROUTE

SR 105

H.C.

HOMAN

WEATHER

PT CLOUDY

COUNTY

WOOD

R.C.

ROUSOS

TEMP.

40

TOWNSHIP

CENTER

CANTERBURY

SECTION

22

T 5 N R 11 E

TYPE MONUMENT P.K./WASHER


ON SURFACE - ~~BELOW~~ ON

~~LEFT~~ - C PAV'T - RIGHT 0.5'

11.2' TO RT EDGE PAVEMENT

S.L.M. 107+49

GRID: NORTHING: _____ EASTING: _____

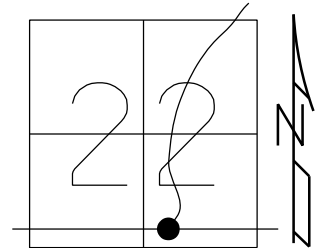

RECORD:

SET P.K./WASHER


5-31-02, DCH

D.N.F.

6/2/16, JFO

D.N.F.

4-12-24, JAM

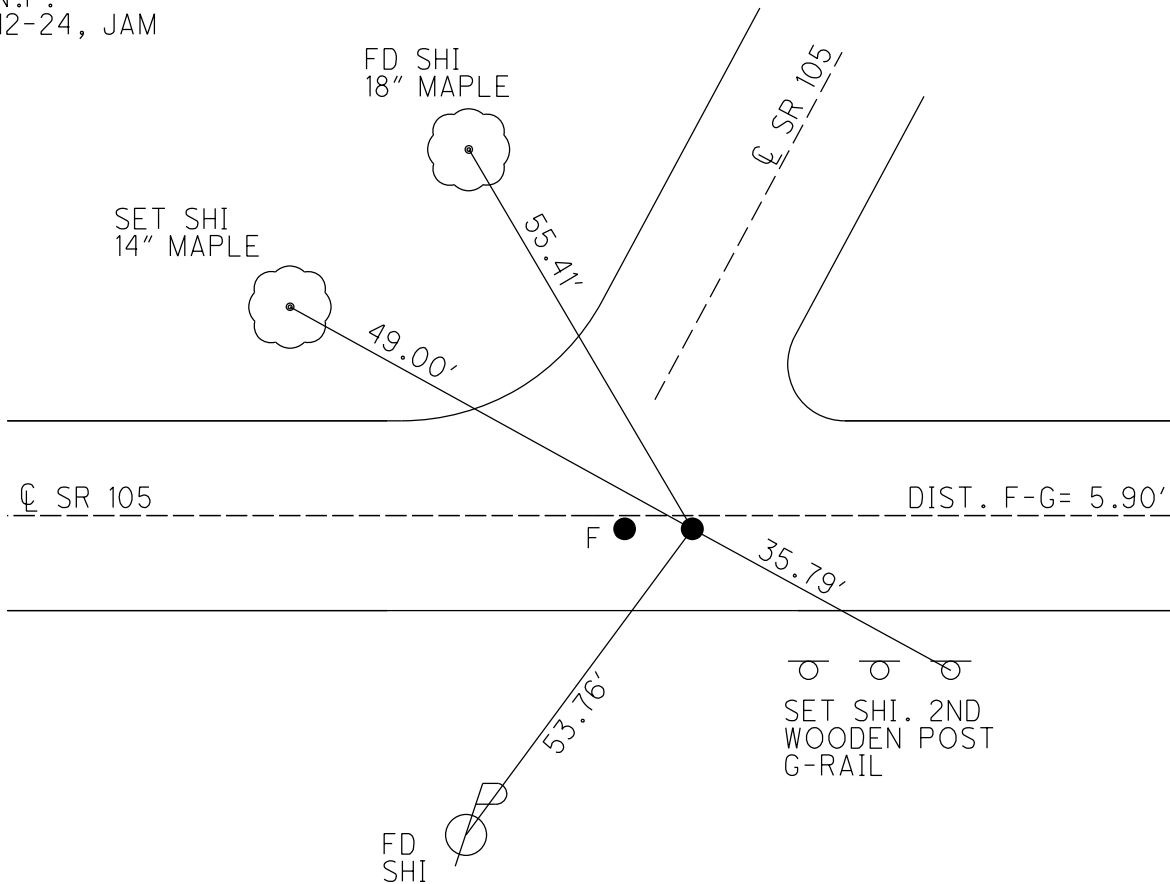


O.D.O.T. DISTRICT 2 SURVEY OFFICE (USE ONLY)

PERSONNEL REFERENCE NO. G SHEET 7 OF 28


NOTES MOSER DATE 4/6/02 ROUTE SR 105
H.C. HOMAN WEATHER PT CLOUDY COUNTY WOOD
R.C. ROUSOS TEMP. 40 TOWNSHIP CENTER
CANTERBURY SECTION 22
T 5 N R 11 E

TYPE MONUMENT P.K./WASHER
ON SURFACE - ~~BELOW~~ ON
~~LEFT~~ - C PAV'T - RIGHT 0.5'
11.2' TO RT EDGE PAVEMENT
S.L.M. 107+49

GRID: NORTHING: EASTING:

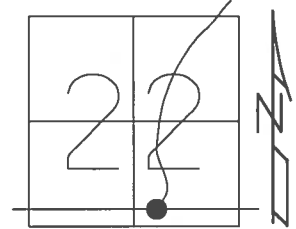


RECORD:
SET P.K./WASHER
5-31-02, DCH
D.N.F.
6/2/16, JFO

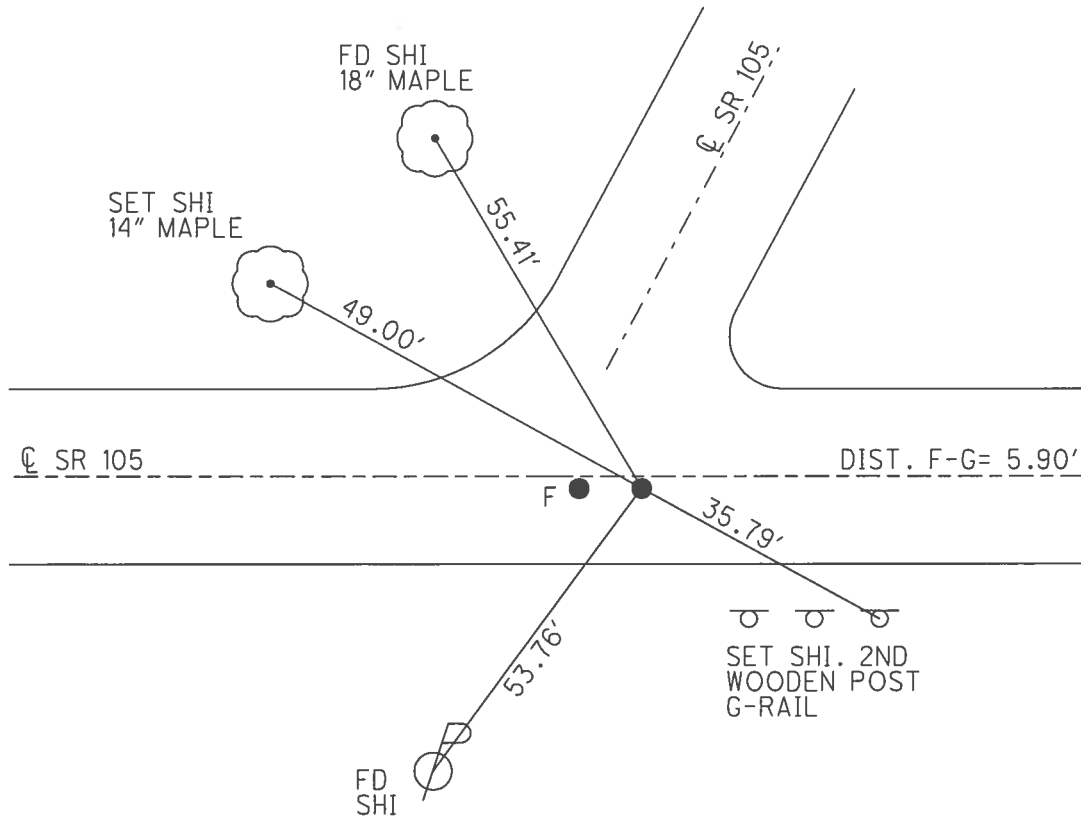

O.D.O.T. DISTRICT 2 SURVEY OFFICE (USE ONLY)

PERSONNEL	REFERENCE NO. <u>G</u>	SHEET <u>7</u> OF <u>21</u>
NOTES	DATE <u>4/6/02</u>	ROUTE <u>SR 105</u>
H.C. <u>MOSER</u>	WEATHER <u>PT CLOUDY</u>	COUNTY <u>WOOD</u>
R.C. <u>HOMAN</u>	TEMP. <u>40</u>	TOWNSHIP <u>CENTER</u>
<u>ROUSOS</u>		SECTION <u>22</u>
<u>CANTERBURY</u>		T <u>5</u> N R <u>11</u> E

TYPE MONUMENT P.K./WASHER
 ON SURFACE - ~~BELOW~~ ON
~~LEFT~~ - ℄ PAV'T - RIGHT 0.5'
11.2' TO RT EDGE PAVEMENT
 S.L.M. 107+49

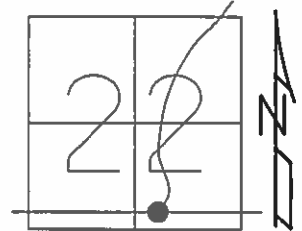

GRID: NORTHING: _____ EASTING: _____

RECORD:
 SET P.K./WASHER
 5-31-02, DCH

