


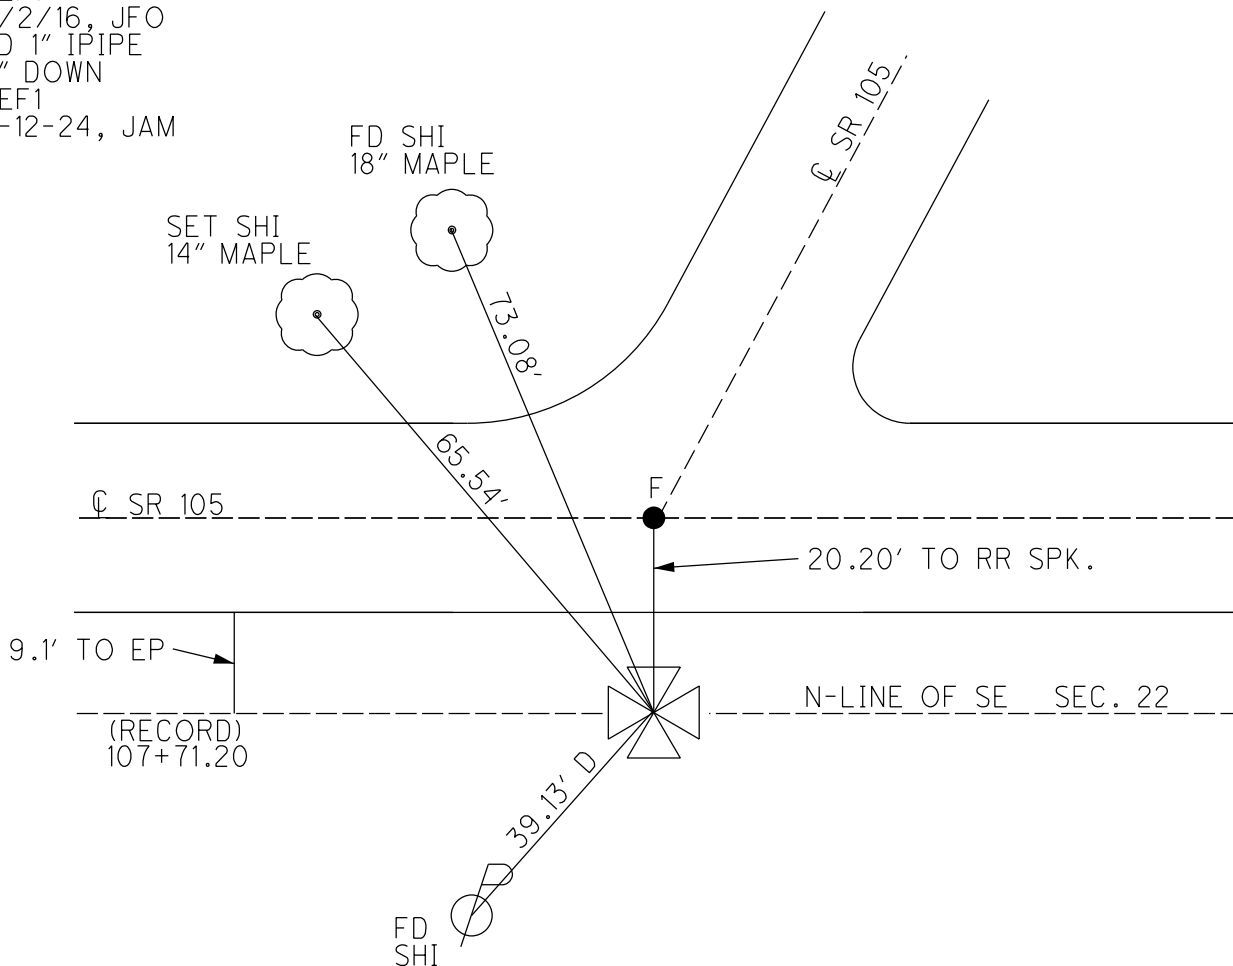


O.D.O.T. DISTRICT 2 SURVEY OFFICE (USE ONLY)


PERSONNEL	REFERENCE NO. <u>1</u>	SHEET <u>8</u> OF <u>28</u>
NOTES	DATE <u>4/6/02</u>	ROUTE <u>SR 105</u>
H.C. <u>MOSER</u>	WEATHER <u>PT CLOUDY</u>	COUNTY <u>WOOD</u>
R.C. <u>HOMAN</u>	TEMP. <u>40°</u>	TOWNSHIP <u>CENTER</u>
<u>ROUSOS</u>		SECTION <u>22</u>
<u>CANTERBURY</u>		T <u>5</u> N R <u>11</u> E

TYPE MONUMENT 1" IPIPE
~~ON SURFACE~~ - BELOW 8"
~~LEFT~~ - CL PAV'T - RIGHT 20.7'
9.1' TO RT EDGE PAVEMENT
 S.L.M. 107+44

GRID: NORTHING: 623898.247 EASTING: 1672232.362

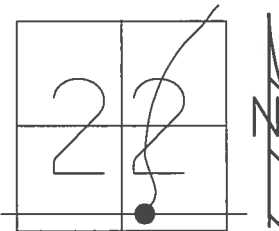


RECORD: 1972
 SET 1" IPIPE
 AS PER PLAN
 STA: 107+71.20
 FD 1" IPIPE
 6" DOWN
 REF1
 6/2/16, JFO

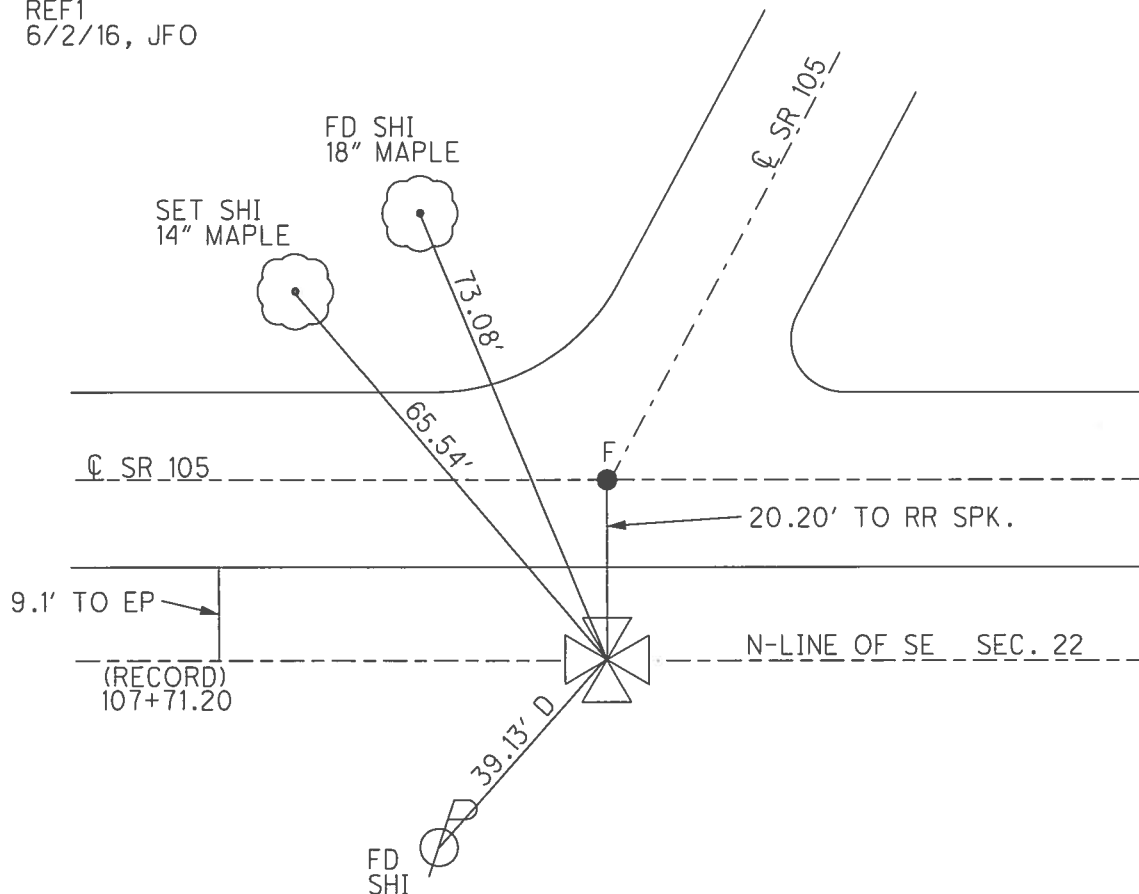

O.D.O.T. DISTRICT 2 SURVEY OFFICE (USE ONLY)


PERSONNEL	REFERENCE NO. <u>1</u>	SHEET <u>8</u> OF <u>21</u>
NOTES	DATE <u>4/6/02</u>	ROUTE <u>SR 105</u>
H.C. <u>HOMAN</u>	WEATHER <u>PT CLOUDY</u>	COUNTY <u>WOOD</u>
R.C. <u>ROUSOS</u>	TEMP. <u>40°</u>	TOWNSHIP <u>CENTER</u>
<u>CANTERBURY</u>		SECTION <u>22</u>
		T <u>5</u> N R <u>11</u> E

TYPE MONUMENT 1" IPIPE
~~ON SURFACE~~ - BELOW 8"
~~LEFT~~ - Q PAV'T - RIGHT 20.7'
9.1' TO RT EDGE PAVEMENT
 S.L.M. 107+44

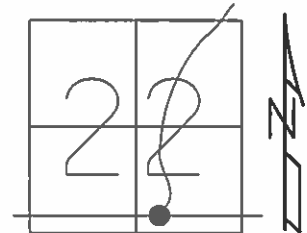

GRID: NORTHING: _____ EASTING: _____

RECORD: 1972
 SET 1" IPIPE
 AS PER PLAN
 STA: 107+71.20

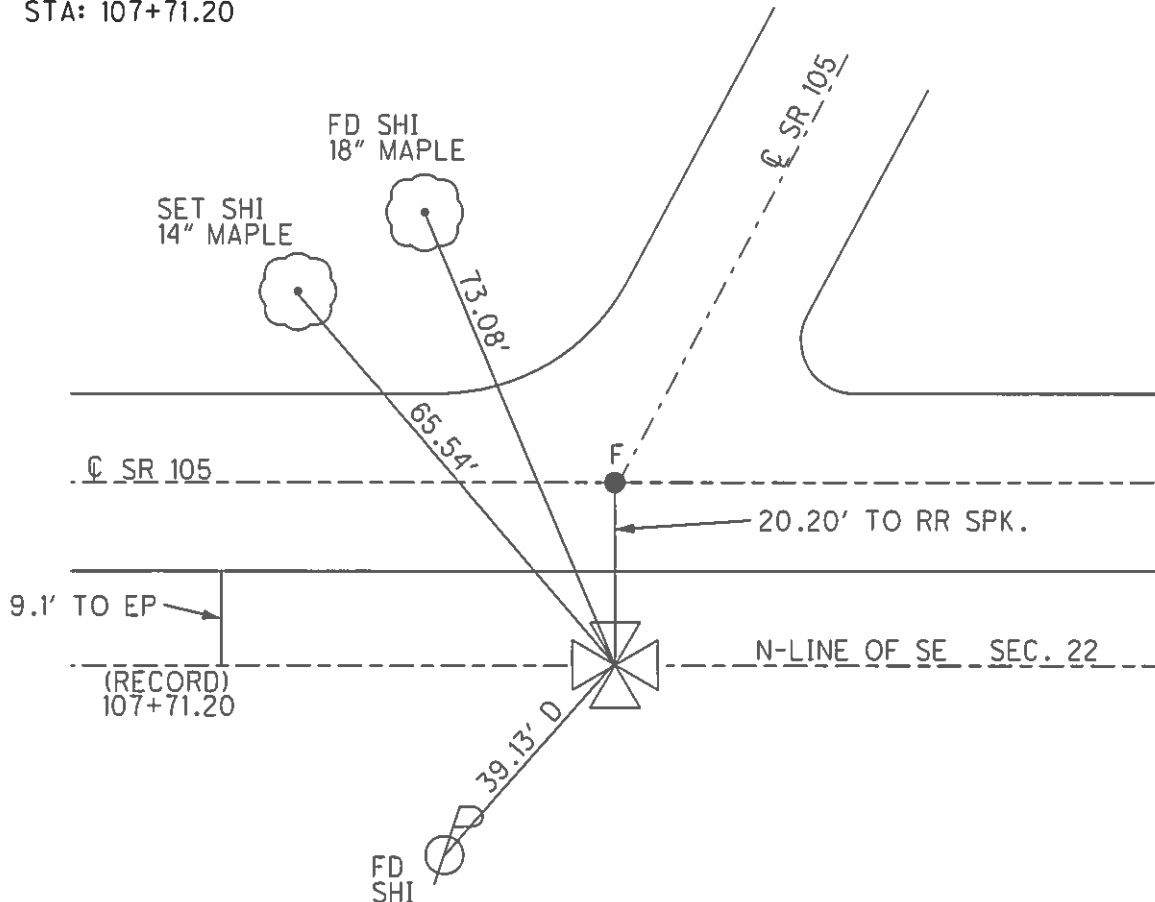

O.D.O.T. DISTRICT 2 SURVEY OFFICE

PERSONNEL

REFERENCE NO. 1

SHEET 6 OF 57

NOTES LONG

H.C. VAN DUSEN

R.C. BARNHISEL

DATE 8-12-91

WEATHER SUNNY

TEMP. 85'

ROUTE 105

COUNTY WOOD

TOWNSHIP CENTER

SECTION 22

T 5 N R 11 E



TYPE MONUMENT 1" IRON PIPE

ON SURFACE - ~~BELOW~~ YES

~~LEFT~~ - C PAV'T. - RIGHT 20.7

9.1 FORT OF EDGE PAVEMENT

S.L.M. 107 + 44

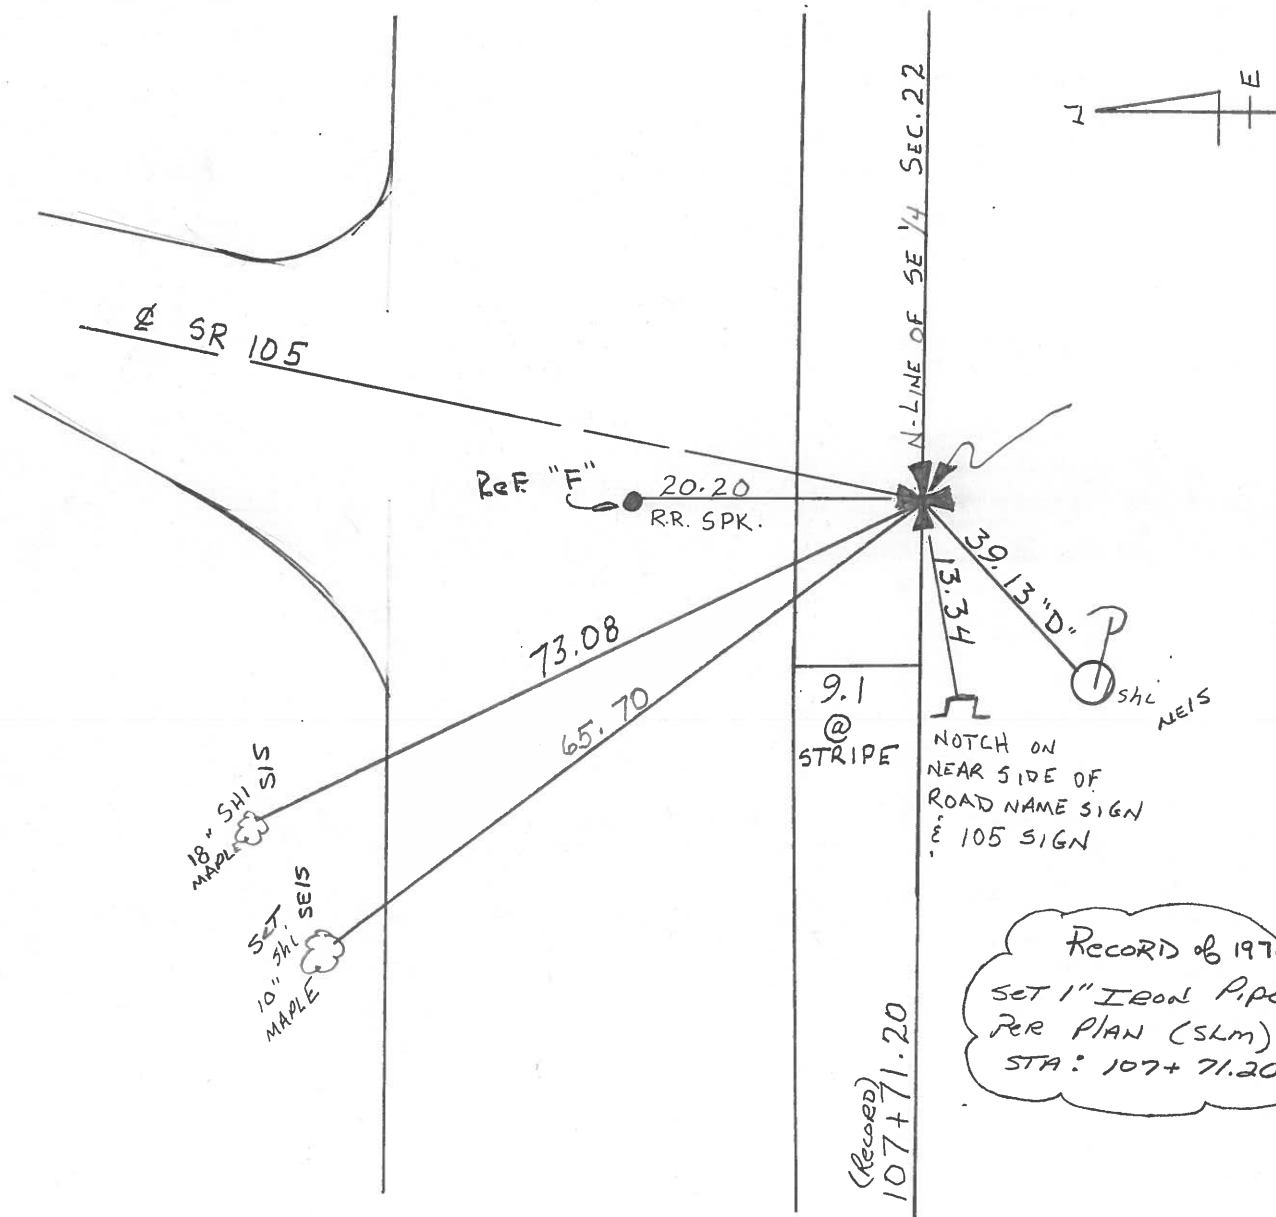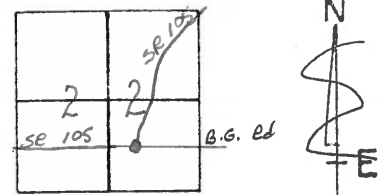

Q.D.O.T. DISTRICT 2 SURVEY OFFICE

SHEET _____ OF _____

County WOOD S.R. 105

Township CENTER

Section 22

T N, R E

Personnel HOFFMAN


LOENRKE

HOUSEHOLDER


Date 4-19-82

Weather CLEAR

Temp. +65°

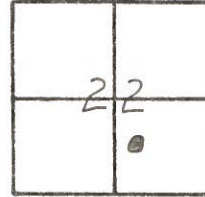

#1

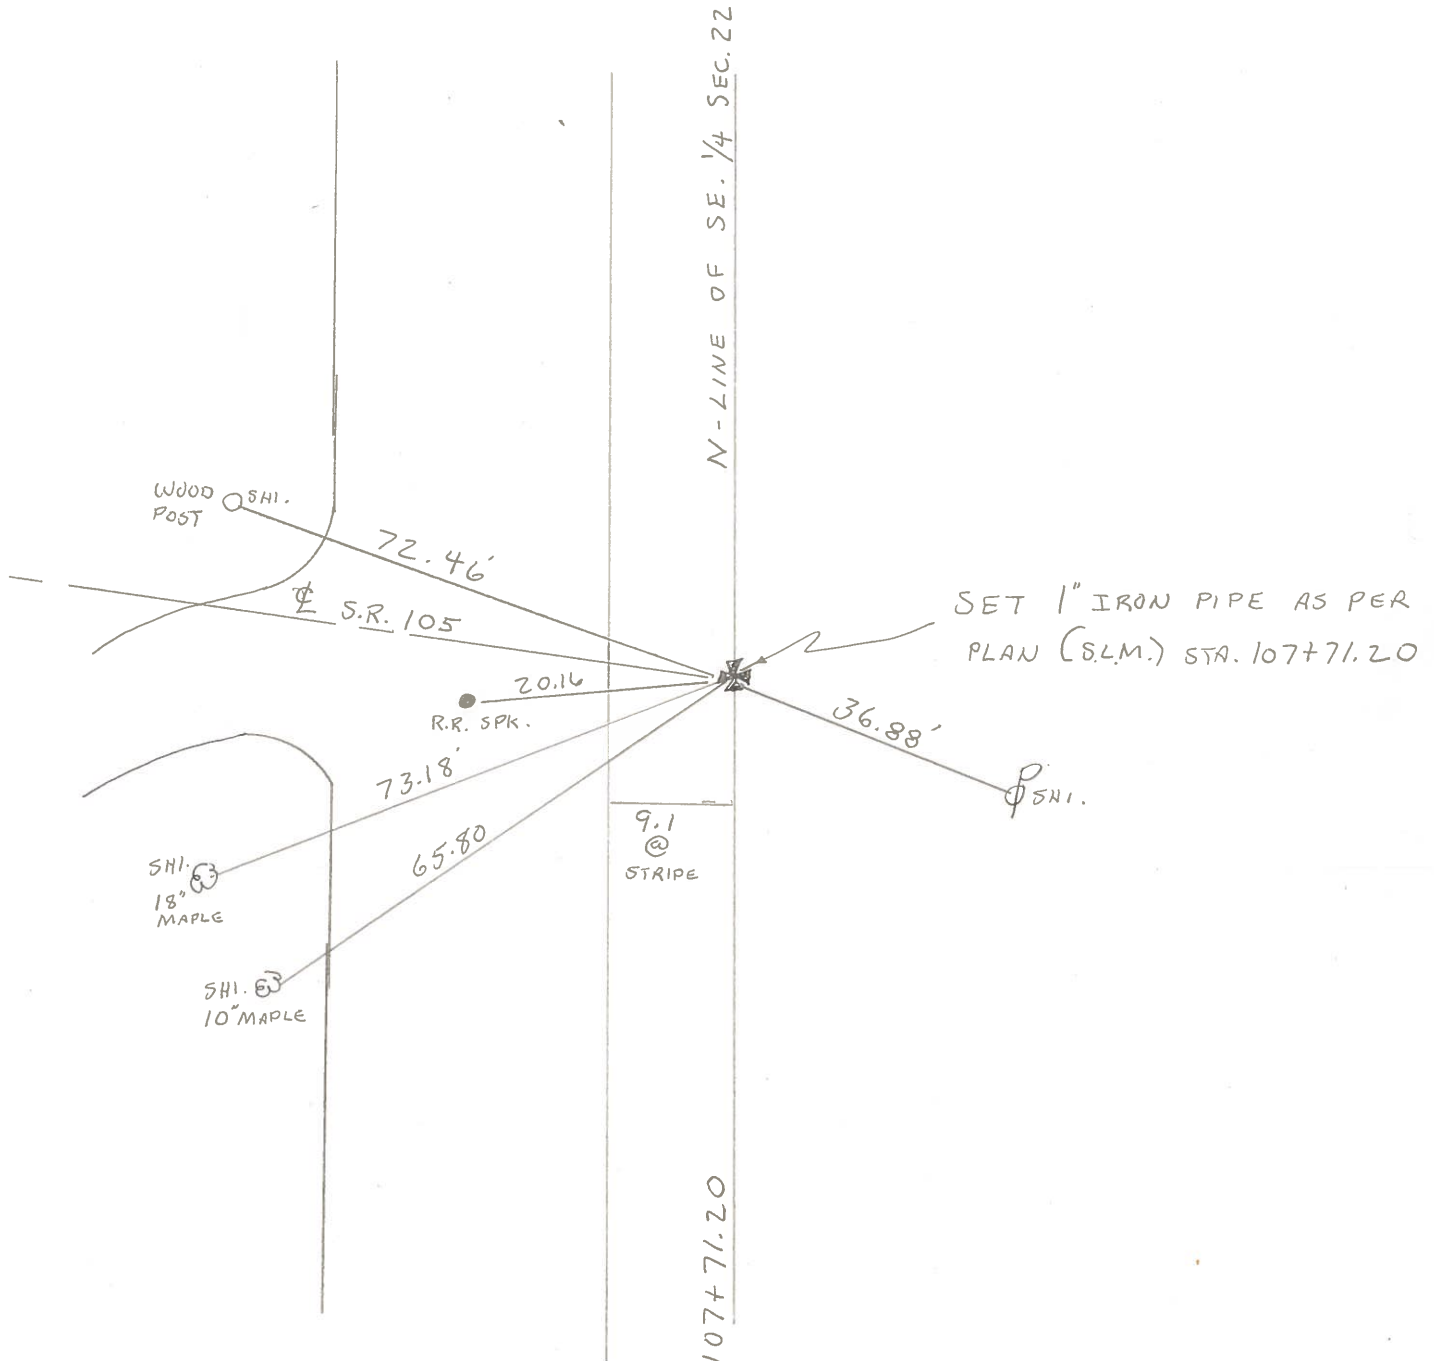

PERSONNEL	TITLE	PERSONNEL	TITLE
Stone	Notes		
Michalak	R.C.		
Dennis	H.C.		
Curtis	M		

COUNTY Wood DATE 25 Aug. 72
 S. R. # 105 WEATHER Humid
 SEC. 22 TEMP. 85°

DESCRIPTION References to Control Points JOB NO. _____

LEFT CENTER LINE RIGHT

