

O.D.O.T. DISTRICT 2 SURVEY OFFICE (USE ONLY)

PERSONNEL

REFERENCE NO. 2

SHEET 9 OF 30

NOTES ASTON

DATE 4/12/2024

ROUTE SR 105

H.C. MILLER

WEATHER CLOUDY

COUNTY WOOD

R.C. NIESE

TEMP. 30°

TOWNSHIP CENTER

SECTION 22

DWG BY _____ PID NO PID

T 5 N R 11 E

TYPE MONUMENT 1/2" IPIN

ON SURFACE - BELOW 6"

OFFSET Q PAVEMENT 13.1' LT : RT

3.2' TO RT EDGE PAVEMENT


STATION: 109+19

HORZ.DATUM: LDP:WOOD


GEOID: 18

GRID: NORTHING: 624079.692

EASTING: 1672299.317

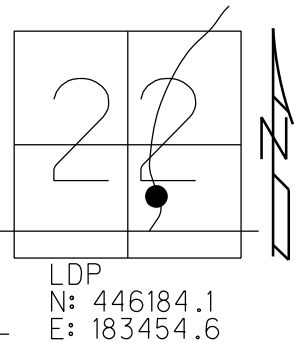

RECORD: P.I.
STA. 109+64.46
 $\Delta = 15^\circ 44' \text{ LT}$
FD 1/2" IPIN
8" DOWN
REF2
6/2/16, JFO
FD 1/2" IPIN
8" DOWN
REF2
4/12/24, JAM

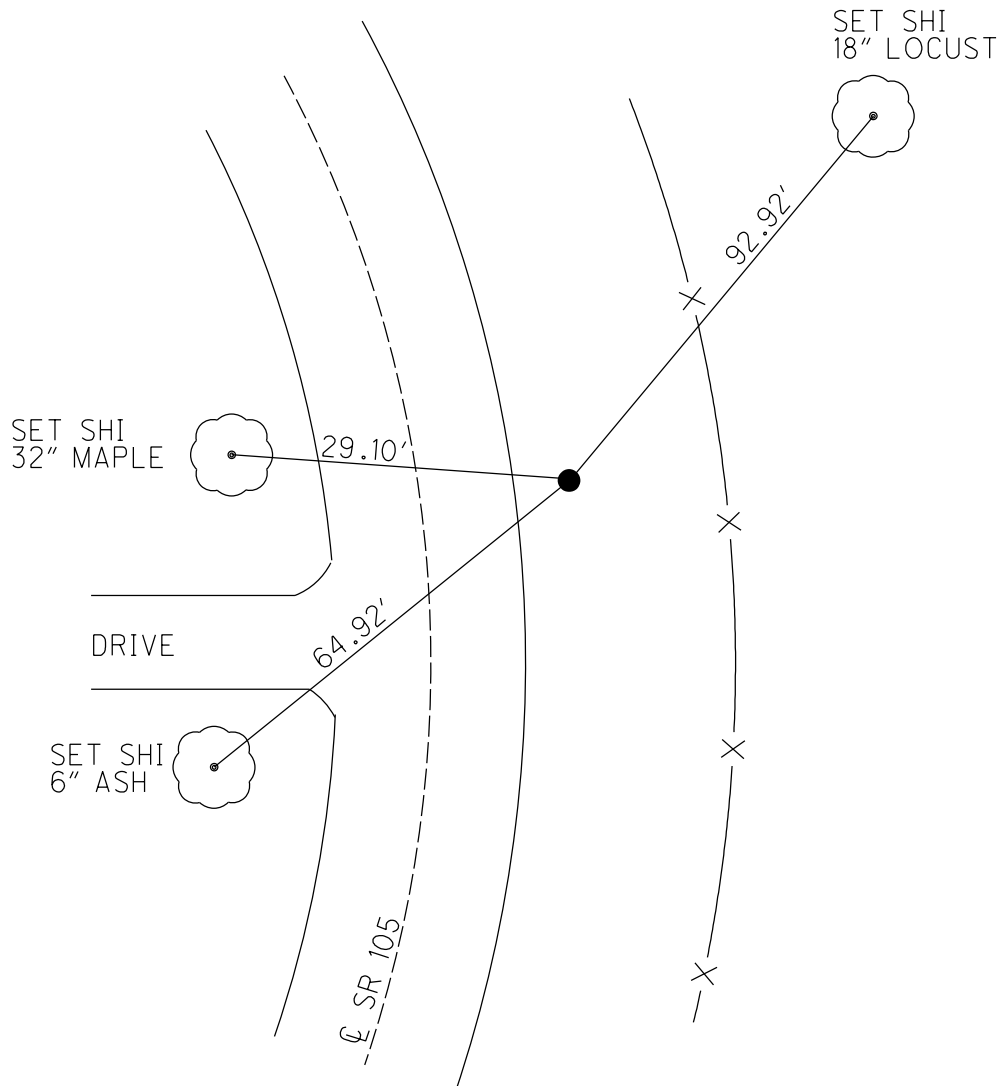

O.D.O.T. DISTRICT 2 SURVEY OFFICE (USE ONLY)

PERSONNEL	REFERENCE NO. <u>2</u>	SHEET <u>9</u> OF <u>28</u>
NOTES	DATE <u>4/13/02</u>	ROUTE <u>SR 105</u>
H.C. <u>BARNHISEL</u>	WEATHER <u>CLOUDY</u>	COUNTY <u>WOOD</u>
R.C. <u>HUSS</u>	TEMP. <u>60°</u>	TOWNSHIP <u>CENTER</u>
		SECTION <u>22</u>
		T <u>5</u> N R <u>11</u> E

TYPE MONUMENT IPIN


~~ON SURFACE~~ - BELOW 6"

~~LEFT~~ - CL PAV'T - RIGHT 13.1'


3.2' TO RT EDGE PAVEMENT

S.L.M. 109+19

GRID: NORTHING: 624079.692 EASTING: 1672299.317

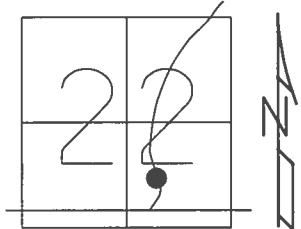

RECORD: P.I.
 STA. 109+64.46
 $\Delta = 15^\circ 44'$ LT
 FD 1/2" IPIN
 8" DOWN
 REF2
 6/2/16, JFO

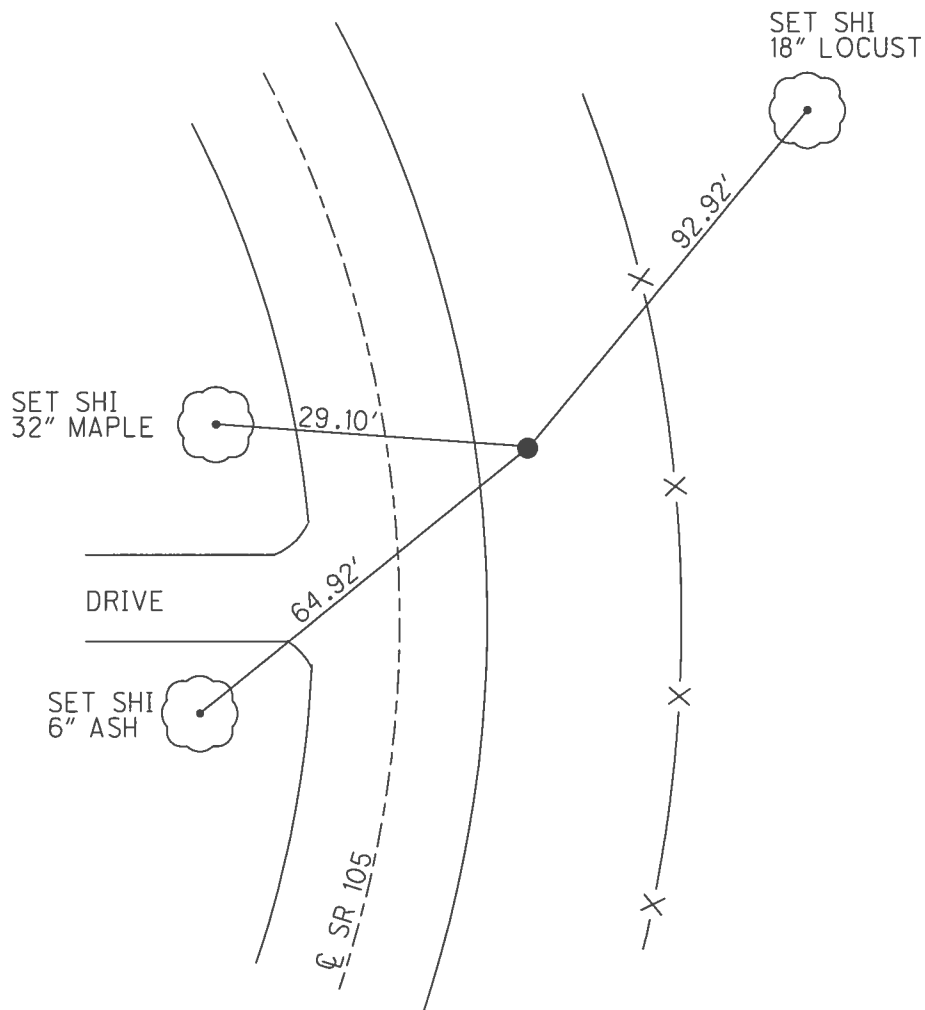

O.D.O.T. DISTRICT 2 SURVEY OFFICE (USE ONLY)

PERSONNEL		REFERENCE NO.	<u>2</u>	SHEET	<u>9</u>	OF	<u>21</u>
NOTES	<u>MOSER</u>	DATE	<u>4/13/02</u>	ROUTE	<u>SR 105</u>		
H.C.	<u>BARNHISEL</u>	WEATHER	<u>CLOUDY</u>	COUNTY	<u>WOOD</u>		
R.C.	<u>HUSS</u>	TEMP.	<u>60°</u>	TOWNSHIP	<u>CENTER</u>		
				SECTION	<u>22</u>		
				T	<u>5</u>	N	R
						<u>11</u>	E


TYPE MONUMENT IPIN

~~ON SURFACE~~ - BELOW 6"

~~LEFT~~ - CL PAV'T - RIGHT 13.1'


3.2' TO RT EDGE PAVEMENT

S.L.M. 109+19

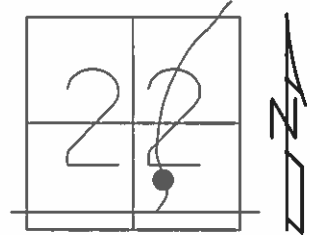

GRID: NORTHING: _____ EASTING: _____

RECORD: P.I.
STA. 109+64.46
 $\Delta = 15^\circ 44' \text{ LT}$

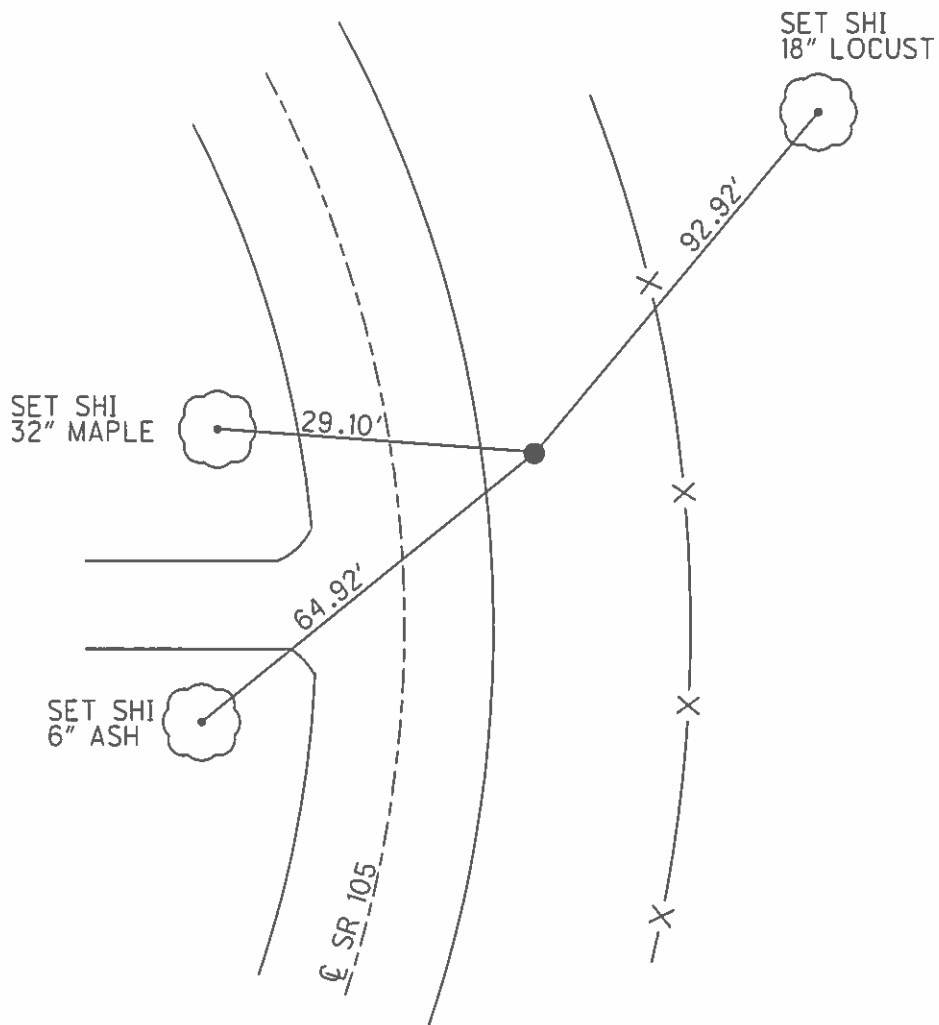

O.D.O.T. DISTRICT 2 SURVEY OFFICE

PERSONNEL

REFERENCE NO. 2

SHEET 7 OF 57

NOTES BARNHISEL

H.C. VAN DUSEN

R.C. BARNHISEL

DATE 8-15-91

WEATHER SUNNY

TEMP. +85°

ROUTE 105

COUNTY WOOD

TOWNSHIP CENTER

SECTION 22

T 5 N R 11 E


TYPE MONUMENT IRON PIPE

ON SURFACE - BELOW YES

LEFT - & PAV'T. - RIGHT 13.5

3.5' OF RT EDGE PAVEMENT

S.L.M. 109 + 19

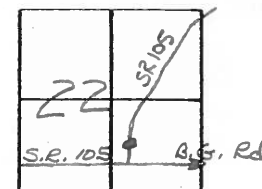


RECORD

P.I. #1

STA: 109+64.46

$\Delta = 15^\circ 44' \text{ LT}$

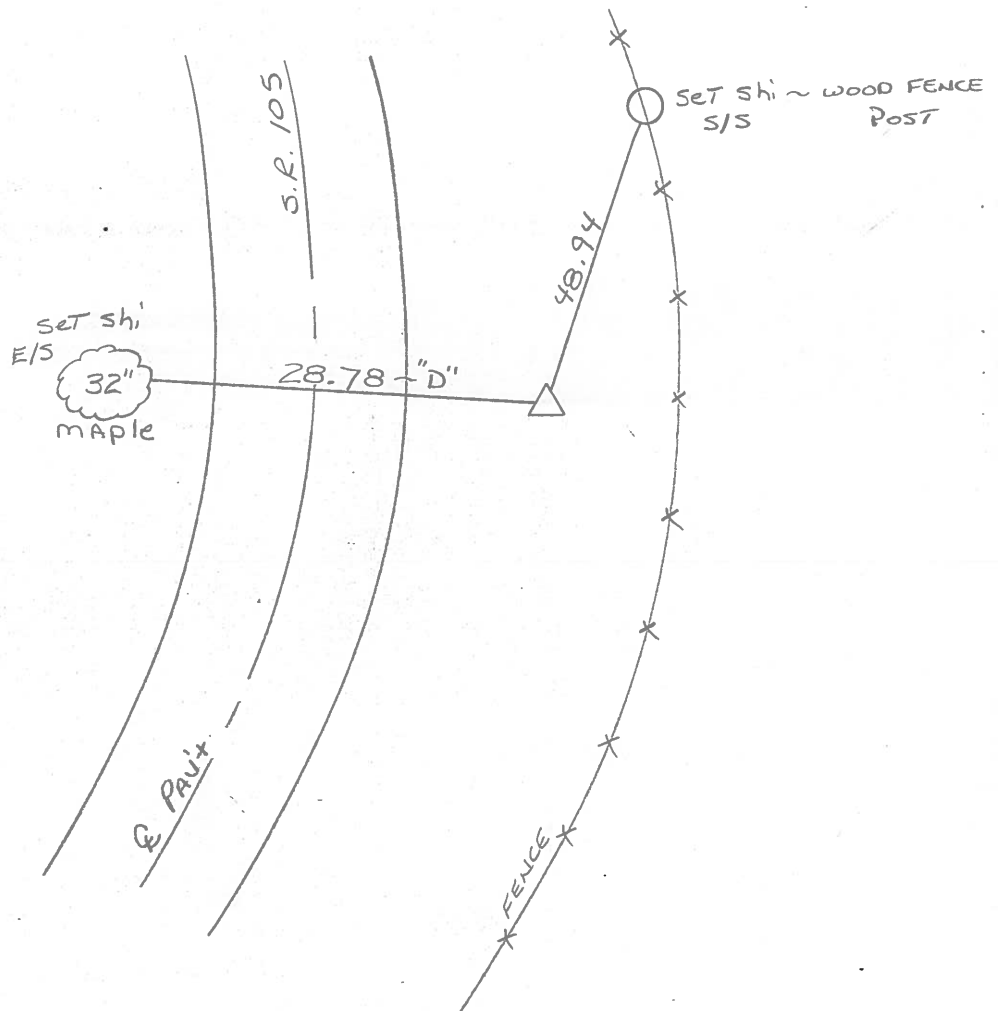

Q.D.O.T. DISTRICT 2 SURVEY OFFICE

SHEET _____ OF _____

County WOOD S.R. 105

Township CENTER

Section 22

T, N, R, E

Personnel HOFFMAN


LOEHRKE

HOUSE HOLDER


Date 4-19-82

Weather CLEAR

Temp. +65°

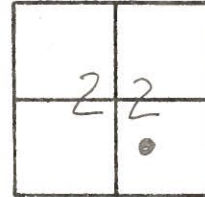

#2

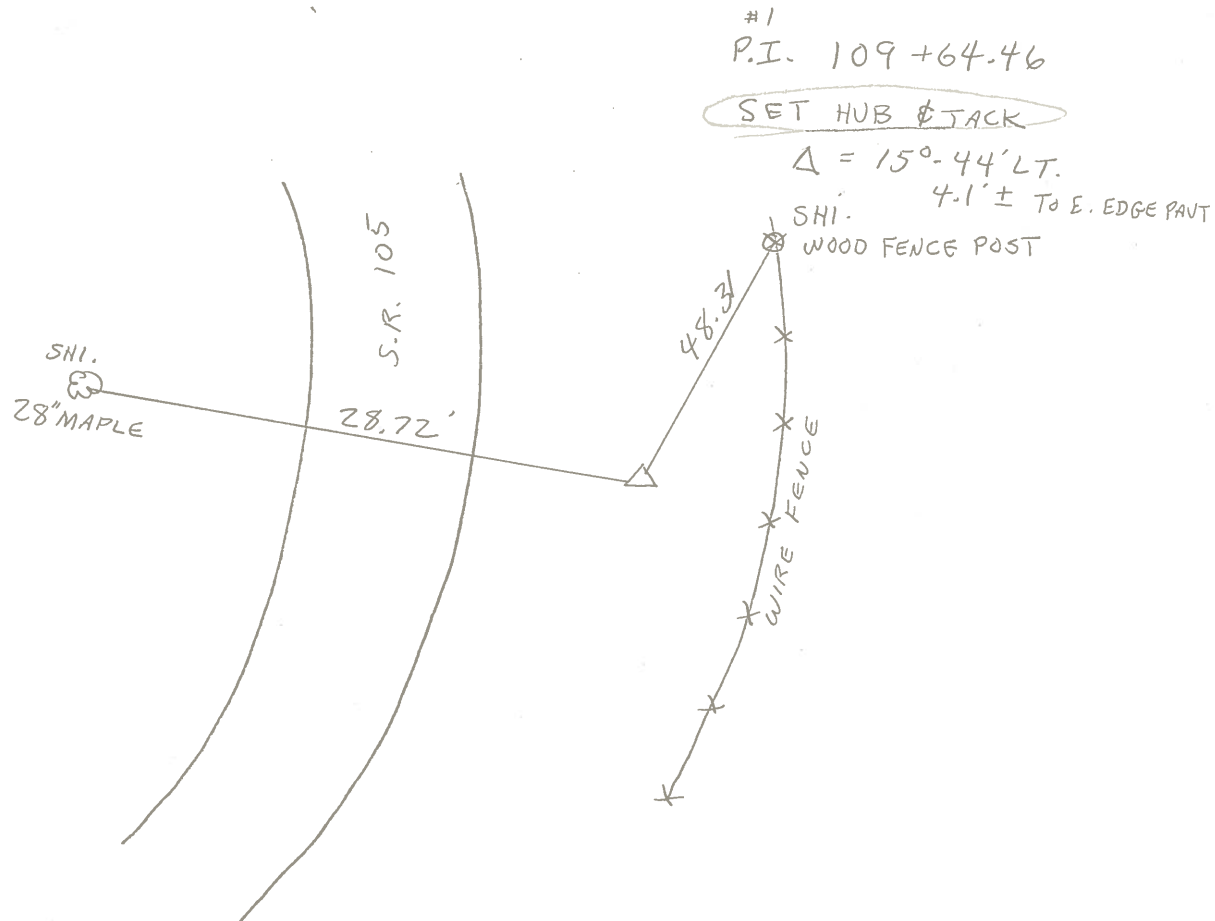

PERSONNEL	TITLE	PERSONNEL	TITLE	COUNTY	DATE	WEATHER	TEMP.
Stone	Notes			Wood	25 Aug. 72	Humid	85°
Mihalak	R.C.			S. R. # 105			
Dennis	H.C.			SEC. 22			
Curtis	RS						

DESCRIPTION *References to Control Points* JOB NO.

