

O.D.O.T. DISTRICT 2 SURVEY OFFICE (USE ONLY)

PERSONNEL

REFERENCE NO. 3

SHEET 10 OF 30

NOTES ASTON
H.C. MILLER
R.C. NIESE

DATE 4/12/2024
WEATHER CLOUDY
TEMP. 30°

ROUTE SR 105
COUNTY WOOD
TOWNSHIP CENTER
SECTION 22
T 5 N R 11 E

DWG BY _____ PID NO PID

TYPE MONUMENT P.K./ WASHER

ON SURFACE - BELOW ON

OFFSET Q PAVEMENT 3.2' LT : ~~RT~~
6.4' TO LT EDGE PAVEMENT


STATION: 109+19

HORZ.DATUM: LDP:WOOD


GEOID: 18

GRID: NORTHING: 624613.823

EASTING: 1672340.0574

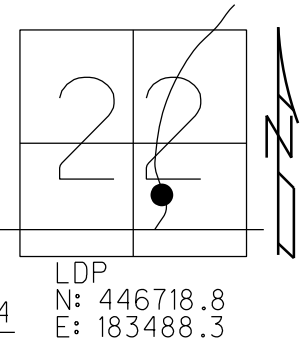


RECORD: P.I.
STA. 115+00.00
 $\Delta = 11^\circ 58' \text{ RT}$
FD P.K./WASHER
4/13/02, MB
SET P.K./WASHER
5/31/02, DCH
FD P.K./WASHER
REF3
6/2/16, JFO
UNCOVERED 1" DOWN
5/23/17, JFO
FD PK/W DOWN 1"
REF3
4/12/24, JAM

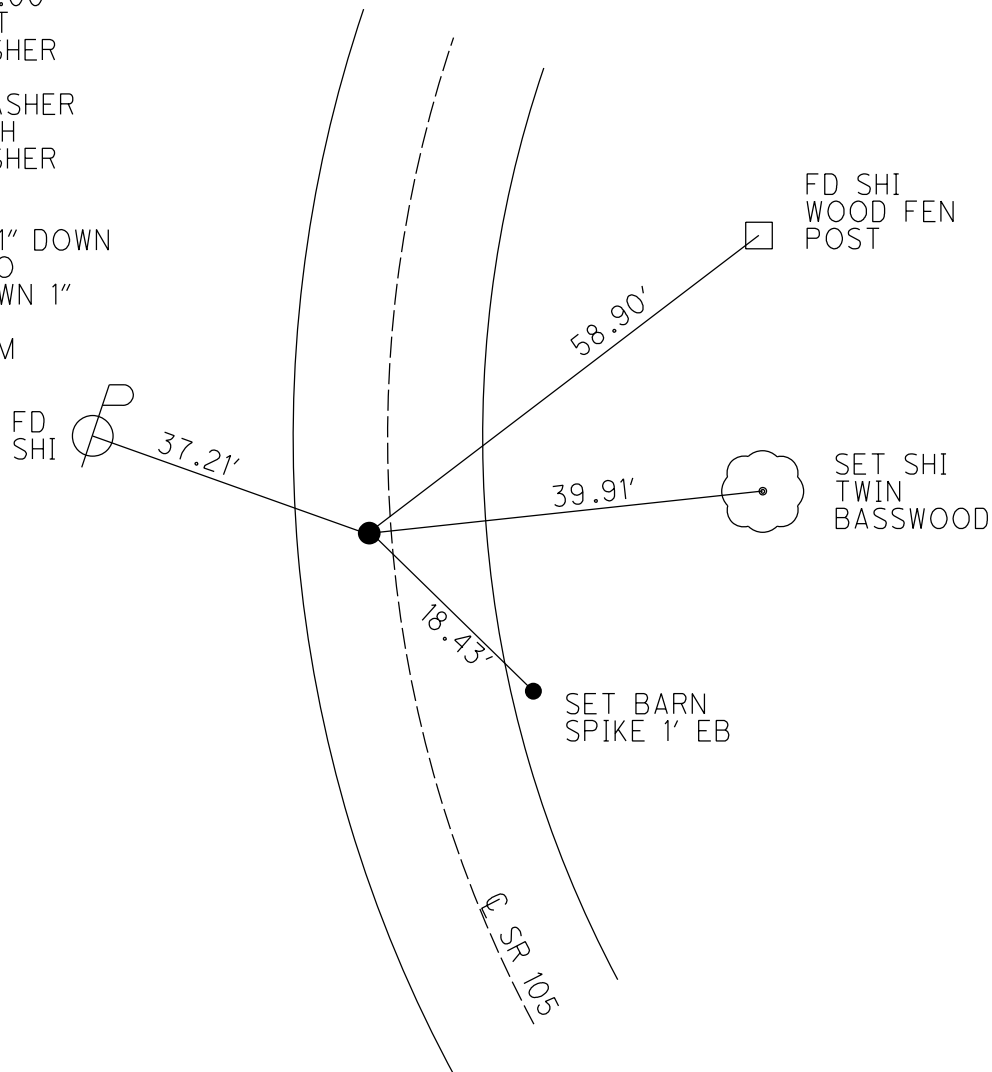

O.D.O.T. DISTRICT 2 SURVEY OFFICE (USE ONLY)


PERSONNEL _____ REFERENCE NO. 3 SHEET 10 OF 28
 NOTES RHOADES DATE 9/9/16 ROUTE WOOD
 H.C. O'DONNELL WEATHER CLOUDY COUNTY WOOD
 R.C. RHOADES TEMP. 82° TOWNSHIP CENTER
 SECTION 22
 T 5 N R 11 E

TYPE MONUMENT P.K./WASHER
 ON SURFACE - ~~BELOW~~ ON
 LEFT - C-PAV'T - ~~RIGHT~~ 3.2'
6.4' TO LT EDGE PAVEMENT
 S.L.M. 114+55

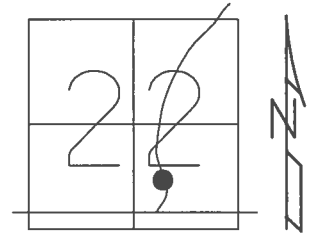

GRID: NORTHING: 624613.823 EASTING: 1672340.0574


RECORD: P.I.
 STA. 115+00.00
 $\Delta = 11^\circ 58' \text{ RT}$
 FD P.K./WASHER
 4/13/02, MB
 SET P.K./WASHER
 5/31/02, DCH
 FD P.K./WASHER
 REF3
 6/2/16, JFO
 UNCOVERED 1" DOWN
 5/23/17, JFO

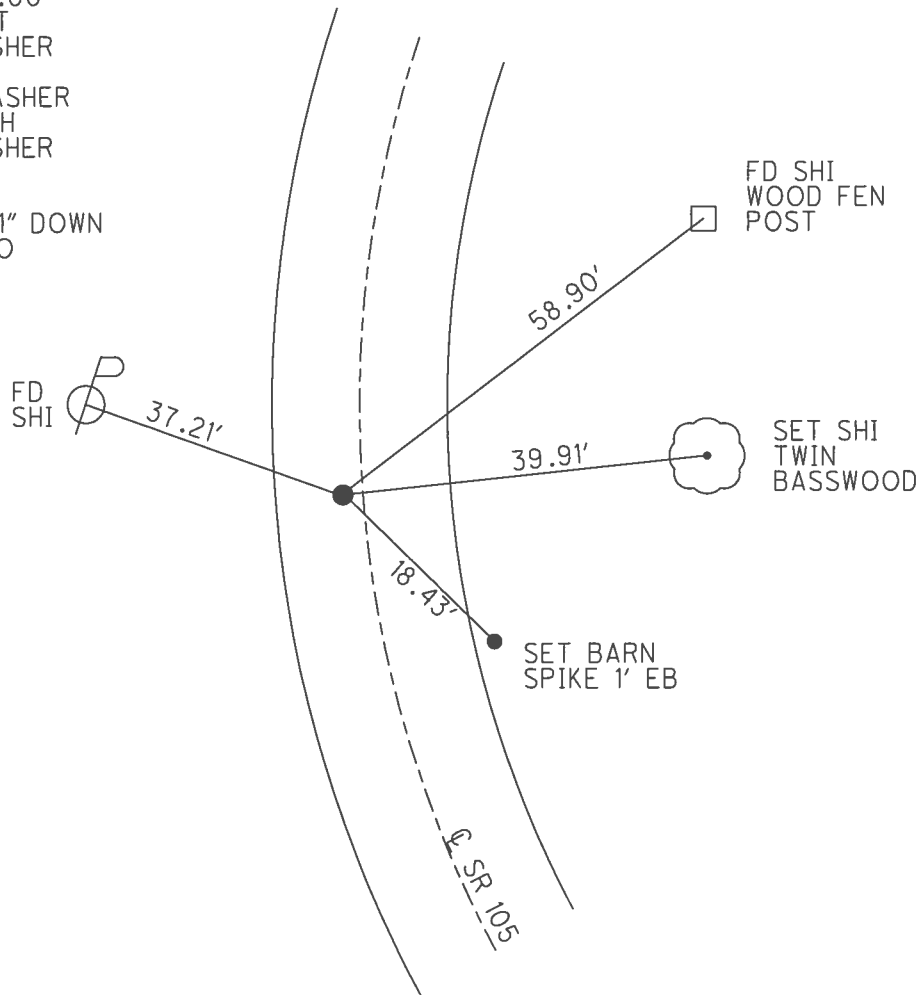

O.D.O.T. DISTRICT 2 SURVEY OFFICE (USE ONLY)


PERSONNEL _____ REFERENCE NO. 3 SHEET 10 OF 21
 NOTES MOSER DATE 4/13/02 ROUTE WOOD
 H.C. HUSS WEATHER CLOUDY COUNTY WOOD
 R.C. BARNHISEL TEMP. 60° TOWNSHIP CENTER
 SECTION 22
 T 5 N R 11 E

TYPE MONUMENT P.K./WASHER
 ON SURFACE - ~~BELOW~~ ON
 LEFT - C-PAV'T - ~~RIGHT~~ 3.2'
6.4' TO RT EDGE PAVEMENT
 S.L.M. 114+55

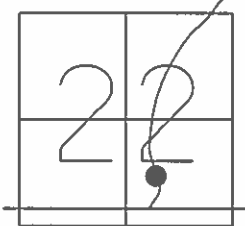

GRID: NORTHING: _____ EASTING: _____

RECORD: P.I.
 STA. 115+00.00
 $\Delta = 11^\circ 58' \text{ RT}$
 SET P.K./WASHER
 5/31/02, DCH

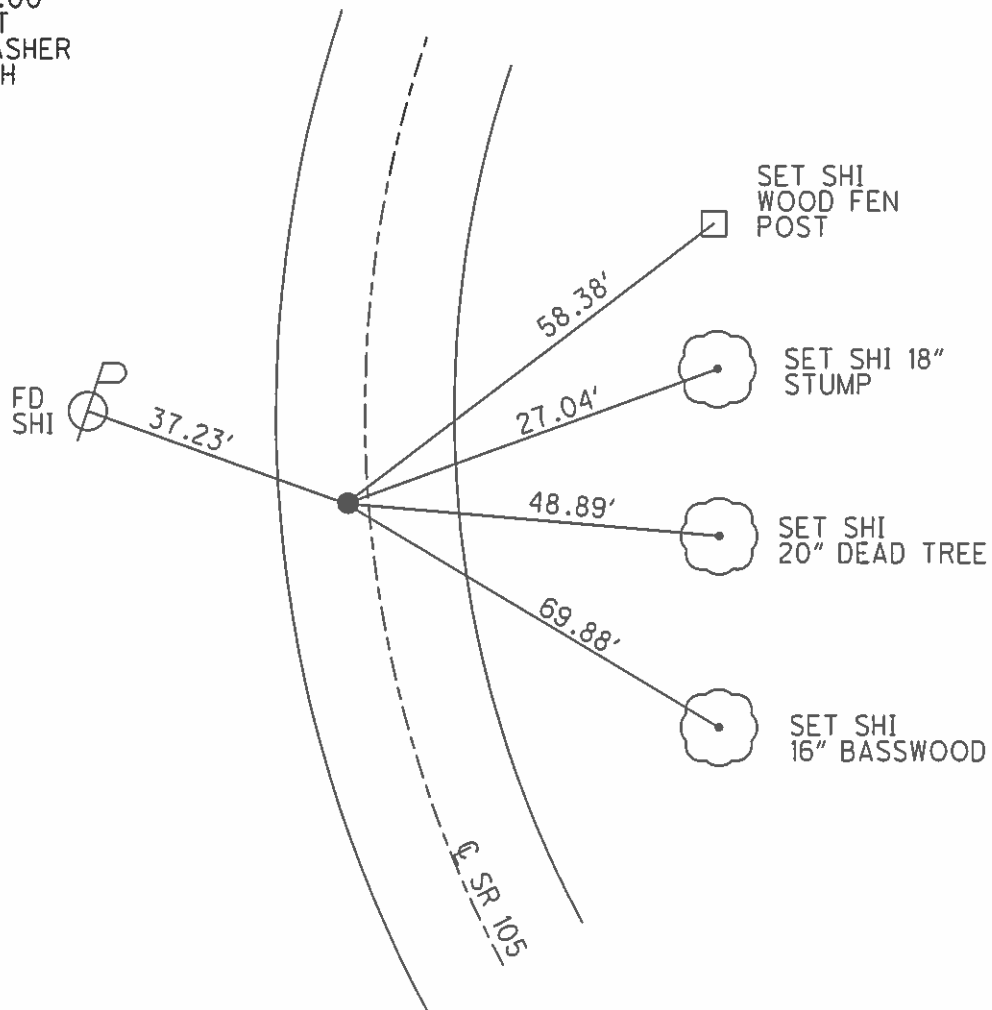

O.D.O.T. DISTRICT 2 SURVEY OFFICE

PERSONNEL

REFERENCE NO. 3

SHEET 8 OF 57

NOTES LONG

H.C. VANDUSEN

R.C. BARNHISEL

DATE 8-15-91

WEATHER clear

TEMP. +85°

ROUTE 105

COUNTY WOOD

TOWNSHIP CENTER

SECTION 22

T 5 N R 11 E


TYPE MONUMENT PK NAIL

ON SURFACE - BELOW YES

LEFT- & PAW'T. - RIGHT 3.4'


G.O. TO RT EDGE PAVEMENT

S.L.M. 114+55

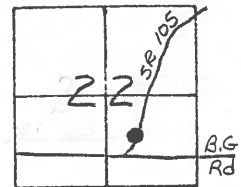


SET PK & WASHER
4-8-92
BVD

RECORD
P.I. #2 STA. 115+100.00
 $\Delta = 11^{\circ}-58'-RT$

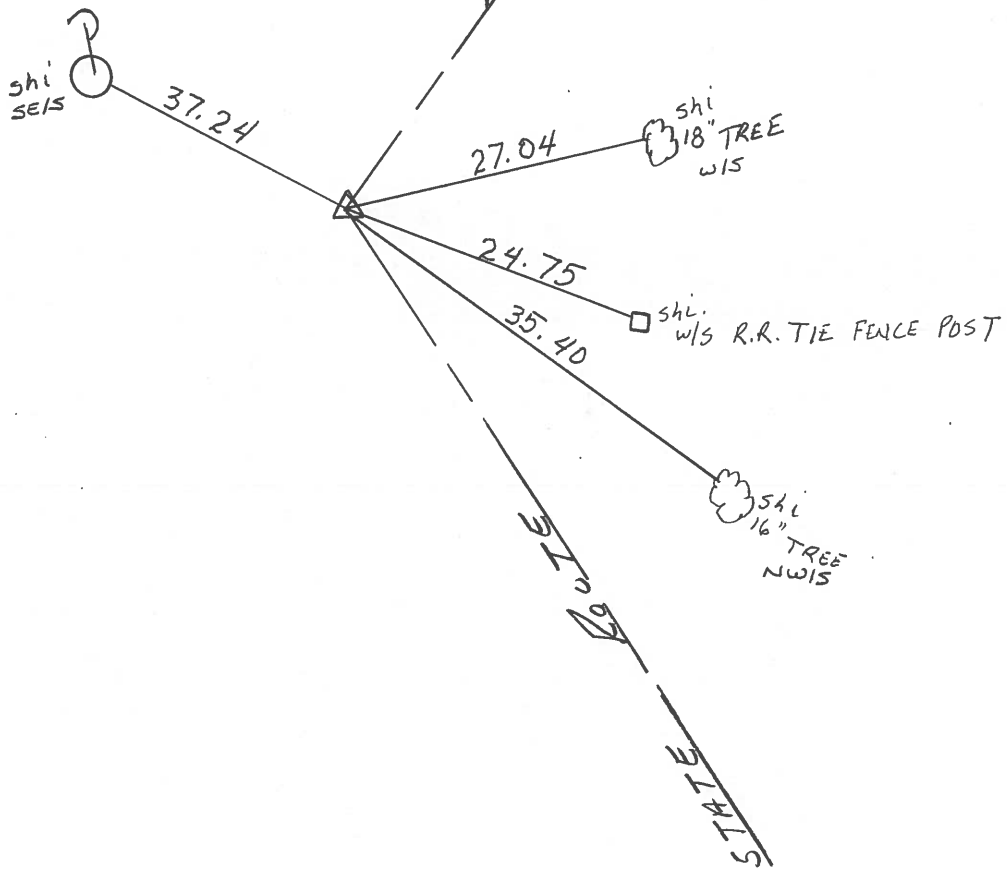

Q.D.O.T. DISTRICT 2 SURVEY OFFICE

SHEET _____ OF _____

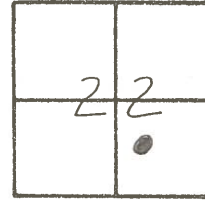
County WOOD S.R. 105Township CENTERSection 22T N, R EPersonnel HOFFMANHOUSEHOLDERLOEHRKE# 3Date 4-19-82Weather CLEARTemp. +65°

P.I. #2 STA. 115+00.00

 $\Delta = 11^{\circ} - 58' - \text{RT.}$

5.9' - TO WEST EDGE PAUT.

13.5' - TO EAST EDGE PAUT.

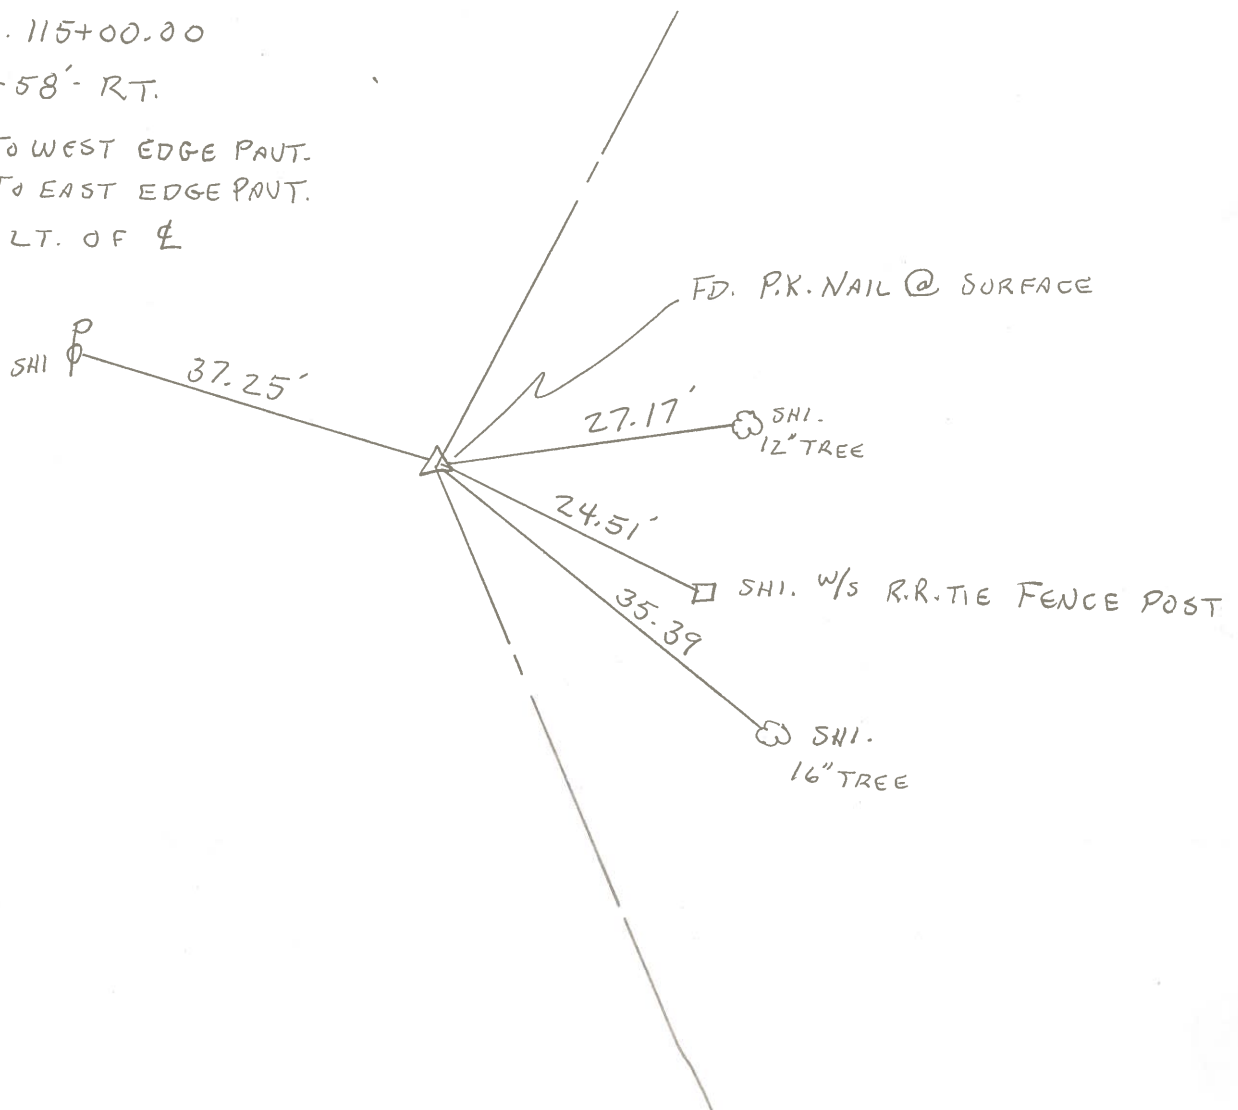3.8' LT. OF $\angle$ 

PERSONNEL	TITLE	PERSONNEL	TITLE
Stone	Notes		
Dennis	H.C.		
Curtis	R.C.		
Brannan	RA		

COUNTY Wood DATE 28 Aug. 72

S. R. #105 WEATHER Warm

SEC. 22 TEMP. 78°

DESCRIPTION Reference to Control Points JOB NO. _____

LEFT CENTER LINE RIGHT

