

O.D.O.T. DISTRICT 2 SURVEY OFFICE (USE ONLY)

PERSONNEL

REFERENCE NO. 4

SHEET 12 OF 30

NOTES ASTON

DATE 4/12/24

ROUTE SR 105

H.C. MILLER

WEATHER CLOUDY

COUNTY WOOD

R.C. NIESE

TEMP. 30°

TOWNSHIP CENTER

SECTION 22

DWG BY _____ PID NO PID

T 5 N R 11 E

TYPE MONUMENT P.K./ WASHER

ON SURFACE - BELOW ON

OFFSET Q PAVEMENT 0.4' LT : RT

9.5' TO RT EDGE PAVEMENT


STATION: 116+27

HORZ.DATUM: LDP: WOOD


GEOID: 18

GRID: NORTHING: 624778.638

EASTING: 1672388.494

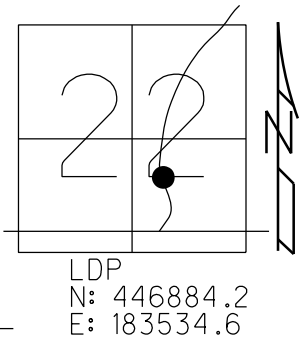


RECORD: P.I.
STA. 116+71.85
 $\Delta = 2^\circ 31' 40''$ RT
FD P.K./WASHER
4/13/02, MB
SET P.K./WASHER
5/31/02, DCH
FD P.K./WASHER
REF 4 16/2/16, JFO
UNCOVERED 1 1/2" DOWN
5/23/17, JFO
FD RUST SPOT
REF 4
4-12-24, TDN

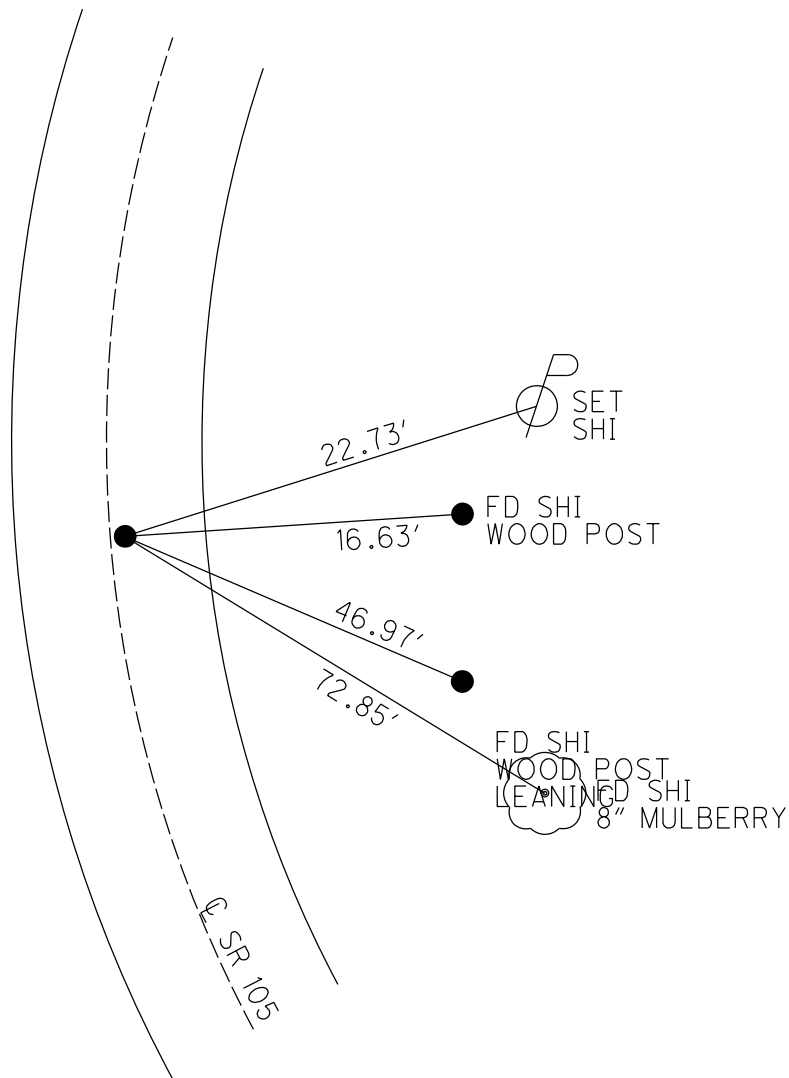

O.D.O.T. DISTRICT 2 SURVEY OFFICE (USE ONLY)


PERSONNEL	REFERENCE NO. <u>4</u>	SHEET <u>11</u> OF <u>28</u>
NOTES <u>RHOADES</u>	DATE <u>9/9/16</u>	ROUTE <u>SR 105</u>
H.C. <u>O'DONNELL</u>	WEATHER <u>CLOUDY</u>	COUNTY <u>WOOD</u>
R.C. <u>RHOADES</u>	TEMP. <u>82°</u>	TOWNSHIP <u>CENTER</u>
		SECTION <u>22</u>
		T <u>5</u> N R <u>11</u> E

TYPE MONUMENT P.K./WASHER
 ON SURFACE - ~~BELOW~~ ON
~~LEFT~~ - C PAV'T - RIGHT 0.4'
9.5' TO RT EDGE PAVEMENT
 S.L.M. 116+27

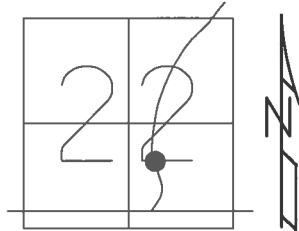

GRID: NORTHING: 624778.638 EASTING: 1672388.494

RECORD: P.I.
 STA. 116+71.85
 $\Delta = 2^\circ 31' 40''$ RT
 FD P.K./WASHER
 4/13/02, MB
 SET P.K./WASHER
 5/31/02, DCH
 FD P.K./WASHER
 REF 4/16/2/16, JFO
 UNCOVERED 1 1/2" DOWN
 5/23/17, JFO

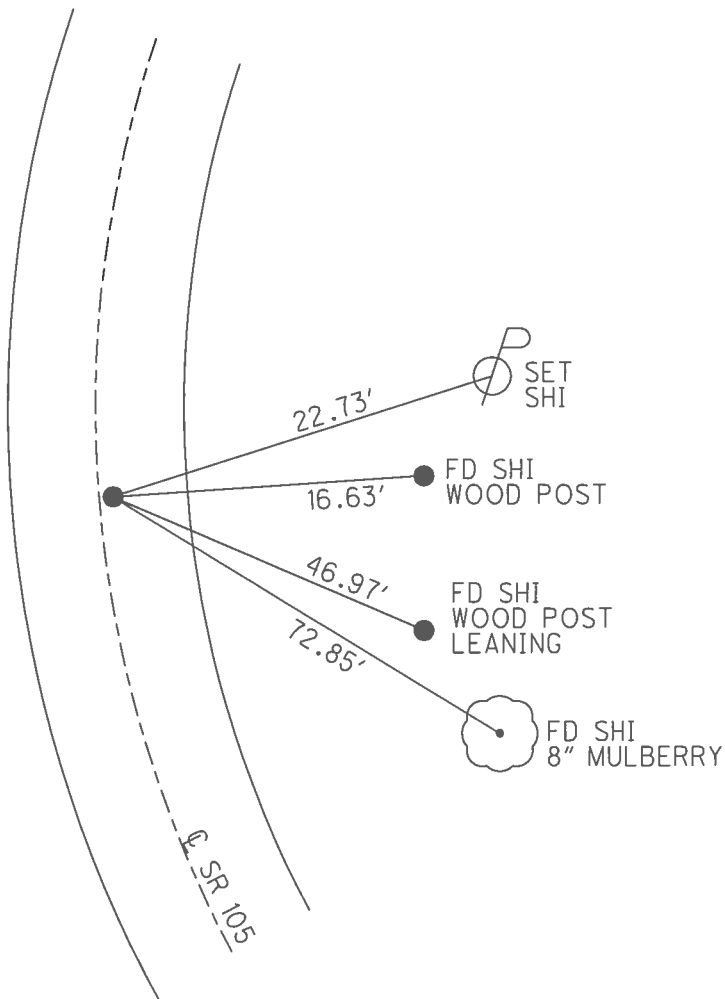

O.D.O.T. DISTRICT 2 SURVEY OFFICE (USE ONLY)

PERSONNEL

REFERENCE NO. 4

SHEET 11 OF 21

NOTES

MOSER

DATE

4/13/02

ROUTE

SR 105

H.C.

HUSS

WEATHER

CLOUDY

COUNTY

WOOD

R.C.

BARNHISEL

TEMP.

60°

TOWNSHIP

CENTER

SECTION

22

T 5 N R 11 E

TYPE MONUMENT P.K./WASHER

ON SURFACE - ~~BELOW~~ ON


~~LEFT~~ - CL PAV'T - RIGHT 0.4'

9.5' TO RT EDGE PAVEMENT OFF PVMT.


S.L.M. 116+27

GRID: NORTHING:

EASTING:

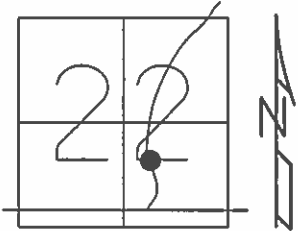

RECORD: P.I.
STA. 116+71.85
 $\Delta = 2^\circ 31' 40''$ RT
SET P.K./WASHER
5/31/02, DCH

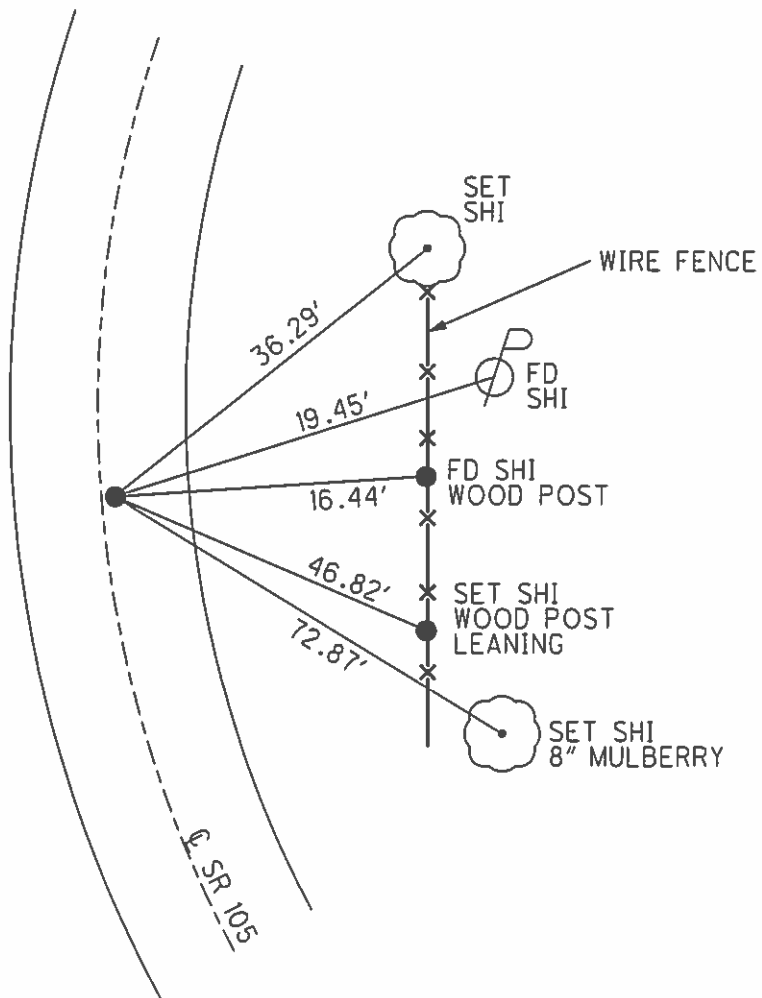

O.D.O.T. DISTRICT 2 SURVEY OFFICE

PERSONNEL

REFERENCE NO. 4

SHEET 9 OF 57

NOTES LONG

H.C. VAN DUSEN

R.C. BARN HISEL

DATE 8-15-91

WEATHER clear

TEMP. 85°

ROUTE 105

COUNTY WOOD

TOWNSHIP CENTER

SECTION 22

T 5 N R 11 E


TYPE MONUMENT PK NAIL

ON SURFACE - BELOW Yes

~~LEFT~~ - C PAV'T. - RIGHT 0.5

9.8 TO RT EDGE PAVEMENT


S.L.M. 116+27

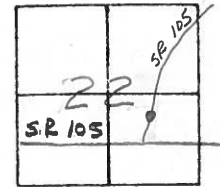

SET PK & WASHER
4-8-92
BVD

RECORD:

P.I. #3 STA. 116+71.85
 $\Delta = 2^\circ - 31' - 40''$ RT.

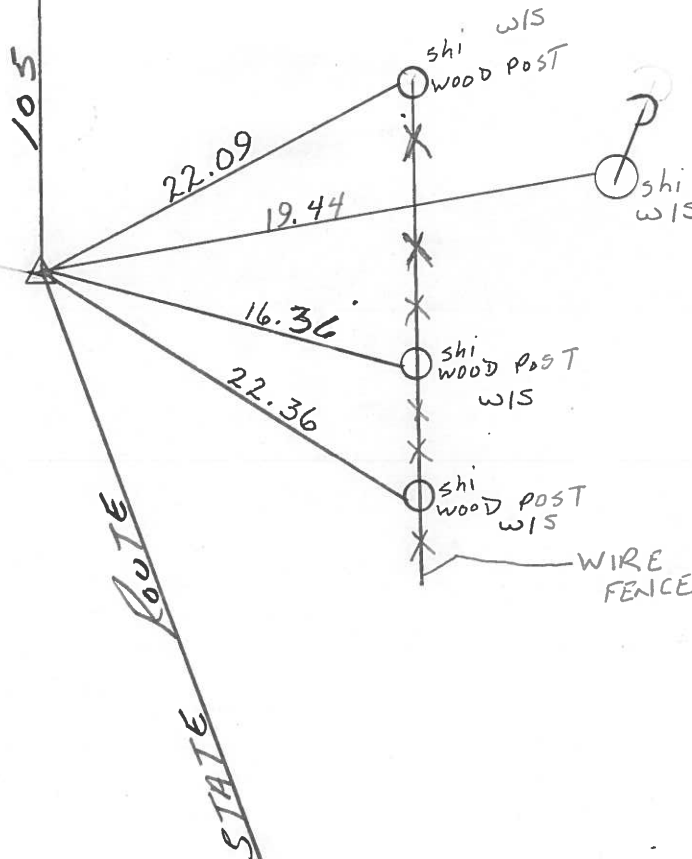

SHEET _____ OF _____

Date 4-19-82

Weather CLEAR

Temp. +65°

22	.


N

HOUSEHOLDER

LOEHRKE

#4

SET P.K. & WASHER
5-24-82 S.W.H.

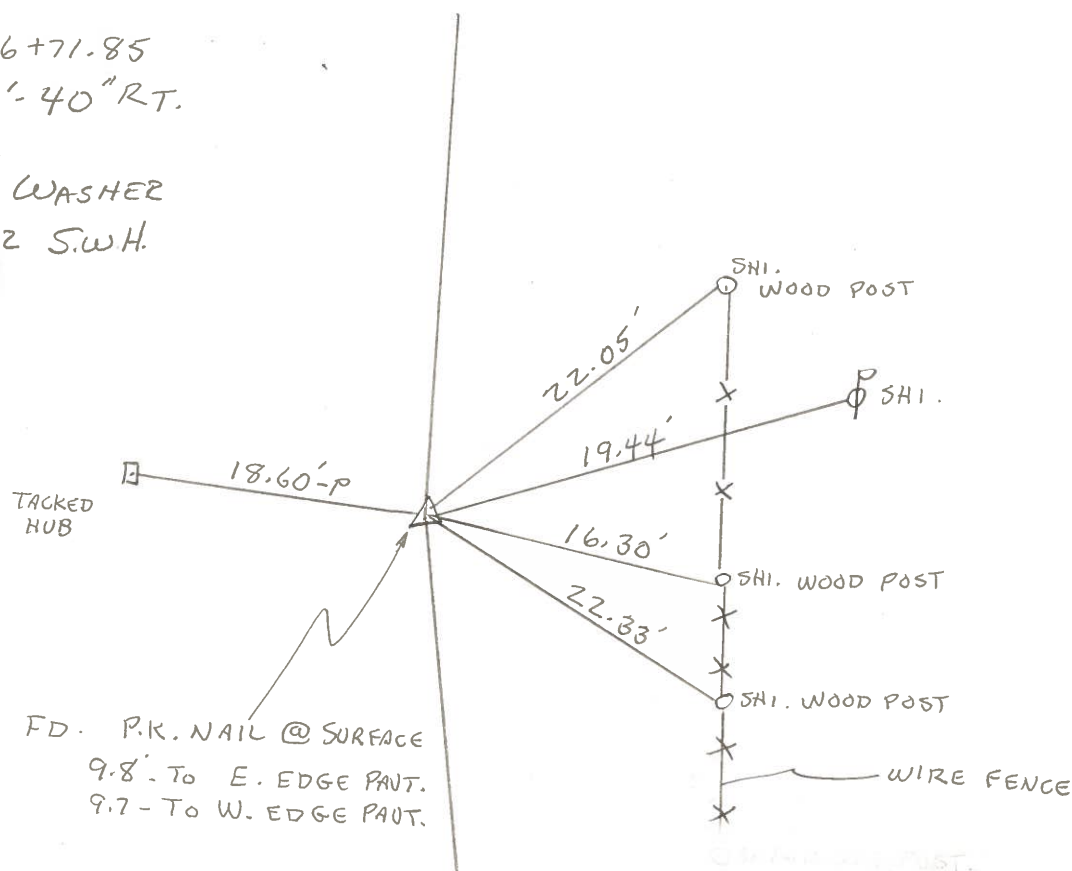

PERSONNEL	TITLE	PERSONNEL	TITLE	COUNTY	DATE
<u>Stone</u>	<u>Notes</u>			<u>Wood</u>	<u>28 Aug. 72</u>
<u>Dennis</u>	<u>H.C.</u>			S. R. <u>#105</u>	WEATHER <u>Warm</u>
<u>Curtis</u>	<u>R.C.</u>			SEC. <u>22</u>	TEMP. <u>78°</u>
<u>Brannen</u>	<u>RD</u>				
DESCRIPTION	<u>References to Control Points</u>			JOB NO.	
	LEFT	CENTER LINE	RIGHT		

