

O.D.O.T. DISTRICT 2 SURVEY OFFICE (USE ONLY)

PERSONNEL

REFERENCE NO. 6

SHEET 13 OF 28

NOTES ASTON

DATE 4/22/2024

ROUTE SR 105

H.C. MILLER

WEATHER BREEZY

COUNTY WOOD

R.C. NIESE

TEMP. 30°

TOWNSHIP CENTER

SECTION 22

DWG BY _____ PID NO PID

T 5 N R 11 E

TYPE MONUMENT MAG/ WASHER

ON SURFACE - BELOW ON

OFFSET Q PAVEMENT 0.6' ± : RT

9.5' TO RT EDGE PAVEMENT


STATION: 120+91

HORZ.DATUM: LDP:WOOD


GEOID: 18

GRID: NORTHING: 625206.738

EASTING: 1672567.627

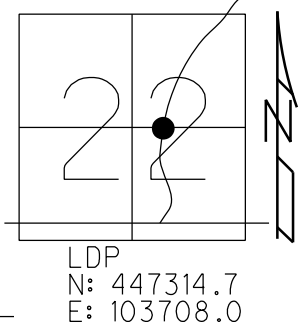


RECORD: P.I.
STA. 121+36.38
 $\Delta = 1^\circ 54'$ RT
FD P.K./WASHER
4/15/02, MB
SET P.K./WASHER
6/12/02, DCH
FD
P.K./WASHER
REF6
6/2/16, JFO
SET 1" MAG/WASHER
NEWREF6
6/20/17, JFO
FD 1" MAG/W
REF6
4-22-24, TDN

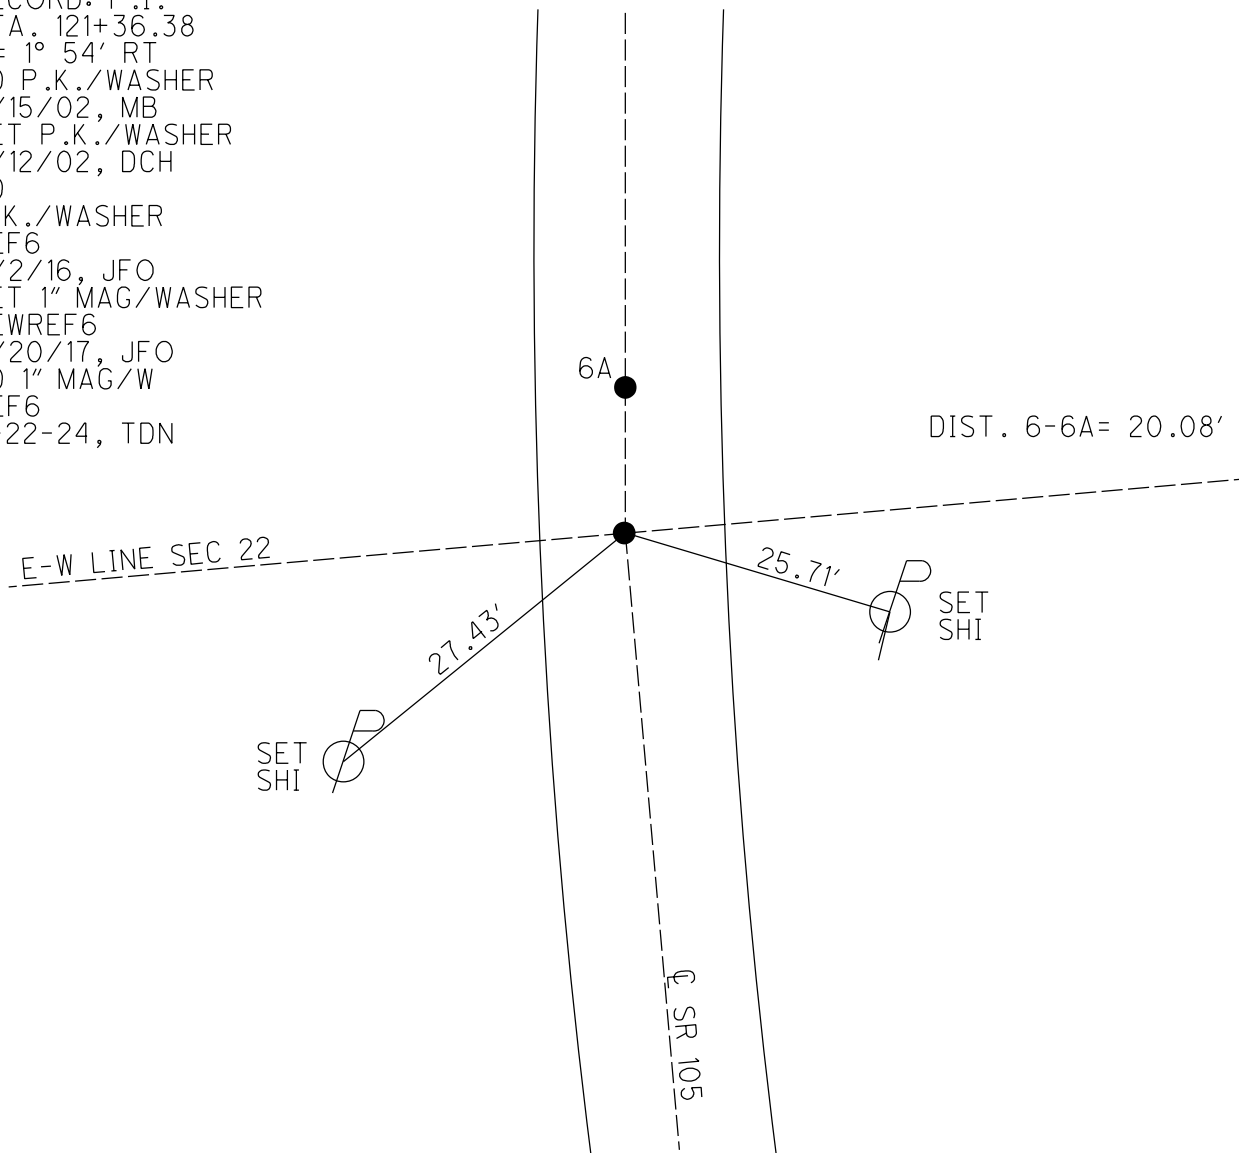

O.D.O.T. DISTRICT 2 SURVEY OFFICE (USE ONLY)


PERSONNEL	REFERENCE NO. <u>6</u>	SHEET <u>13</u> OF <u>28</u>
NOTES	DATE <u>9/9/16</u>	ROUTE <u>SR 105</u>
H.C. <u>RHOADES</u>	WEATHER <u>CLOUDY</u>	COUNTY <u>WOOD</u>
R.C. <u>RHOADES</u>	TEMP. <u>82°</u>	TOWNSHIP <u>CENTER</u>
		SECTION <u>22</u>
		<u>T 5 N R 11 E</u>

TYPE MONUMENT P.K./WASHER
 ON SURFACE - ~~BELOW~~ ON
~~LEFT~~ - C PAV'T - RIGHT 0.6'
9.5' TO RT EDGE PAVEMENT
 S.L.M. 120+91

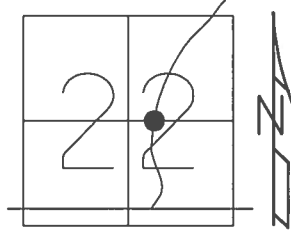

GRID: NORTHING: 625206.738 EASTING: 1672567.627

RECORD: P.I.
 STA. 121+36.38
 $\Delta = 1^\circ 54'$ RT
 FD P.K./WASHER
 4/15/02, MB
 SET P.K./WASHER
 6/12/02, DCH
 FD
 P.K./WASHER
 REF6
 6/2/16, JFO
 SET 1" MAG/WASHER
 NEWREF6
 6/20/17, JFO

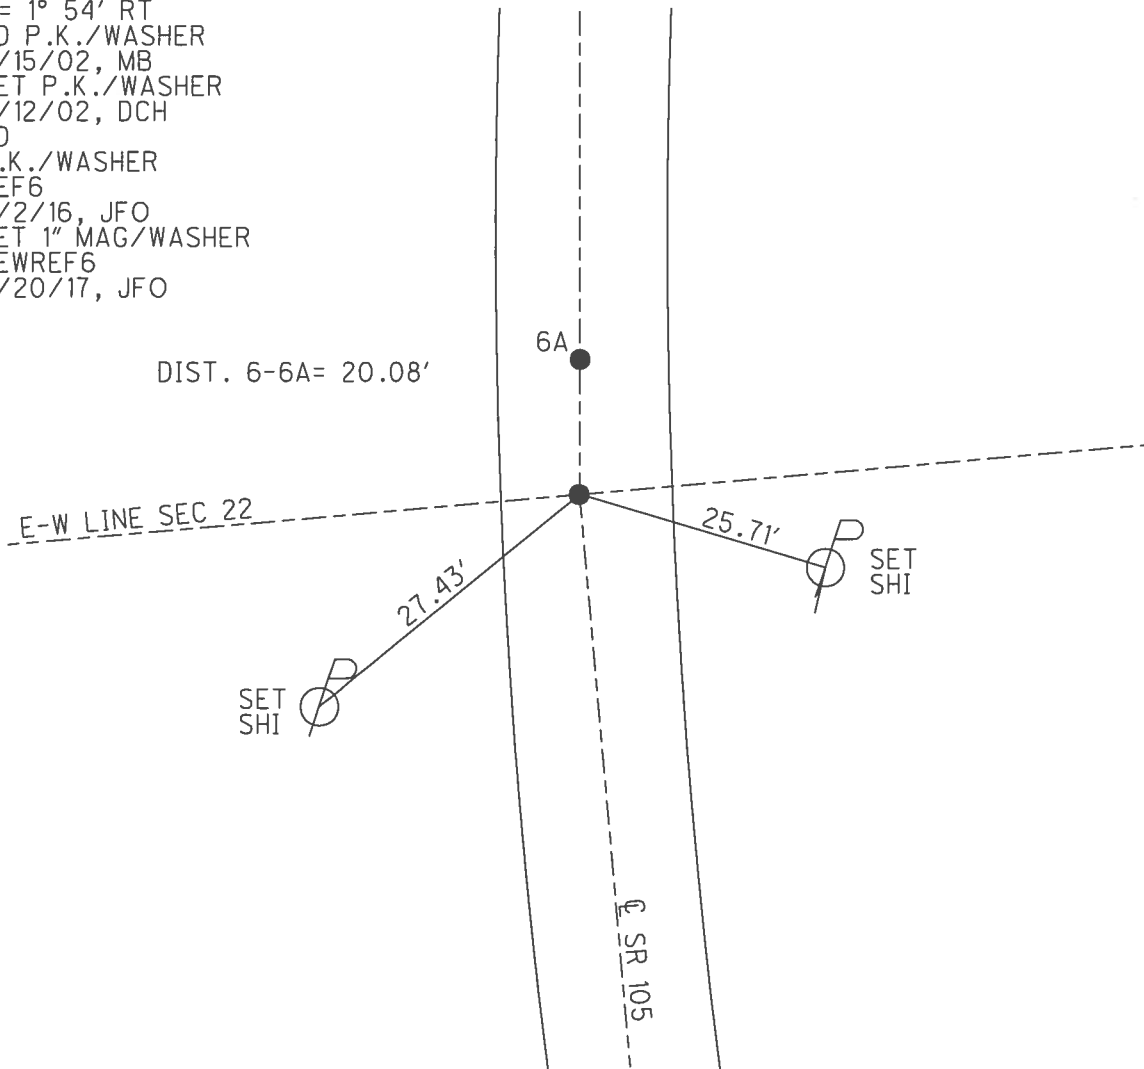


O.D.O.T. DISTRICT 2 SURVEY OFFICE (USE ONLY)

PERSONNEL _____ REFERENCE NO. 6 SHEET 13 OF 21


NOTES MOSER DATE 4/15/02 ROUTE SR 105
H.C. CANTERBURY WEATHER CLEAR COUNTY WOOD
R.C. BARNHISEL TEMP. 65° TOWNSHIP CENTER
SECTION 22
T 5 N R 11 E

TYPE MONUMENT P.K./WASHER
ON SURFACE - ~~BELOW~~ ON
~~LEFT~~ - Q PAV'T - RIGHT 0.6'
9.5' TO RT EDGE PAVEMENT
S.L.M. 120+91

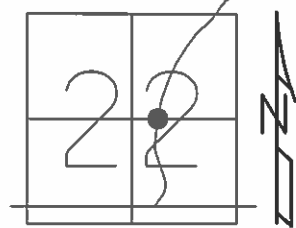

GRID: NORTHING: _____ EASTING: _____

RECORD: P.I.
STA. 121+36.38
 $\Delta = 1^\circ 54'$ RT
SET P.K./WASHER
6/12/02, DCH

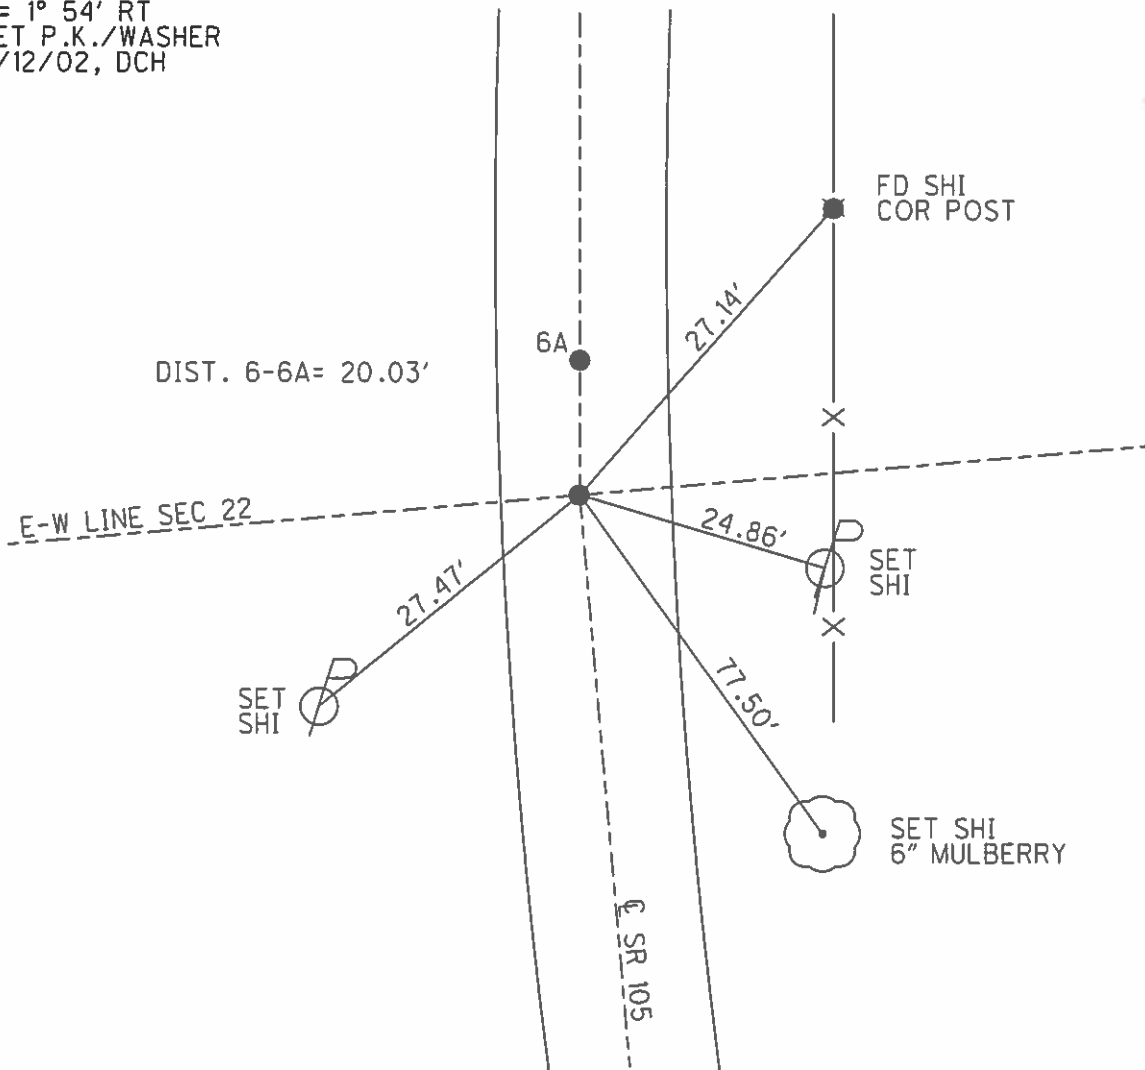

O.D.O.T. DISTRICT 2 SURVEY OFFICE

PERSONNEL _____

REFERENCE NO. 6

SHEET 11 OF 57

NOTES LONG

H.C. VAN DUSEN

R.C. _____

DATE 8-15-91

WEATHER CLEAR

TEMP. 85°

ROUTE 105

COUNTY WOOD

TOWNSHIP CENTER

SECTION 22

T 5 N R 11 E


TYPE MONUMENT P.K.'S & WASHER'S

ON SURFACE - ~~BELOW~~ YES

LEFT - C PAV'T. - RIGHT 0.7' PT 1.0' B

9.5 TO RT EDGE PAVEMENT

S.L.M. 120+91

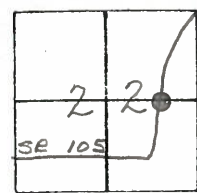


SET PK & WASHER
4-8-92
BVD

POINT "B"
ORIGINAL UNKNOWN
POSSIBLE OFFSETS

A=6
B=6A

RECORD
PI. #5
121+36.38
Δ=1°54'-00" RT

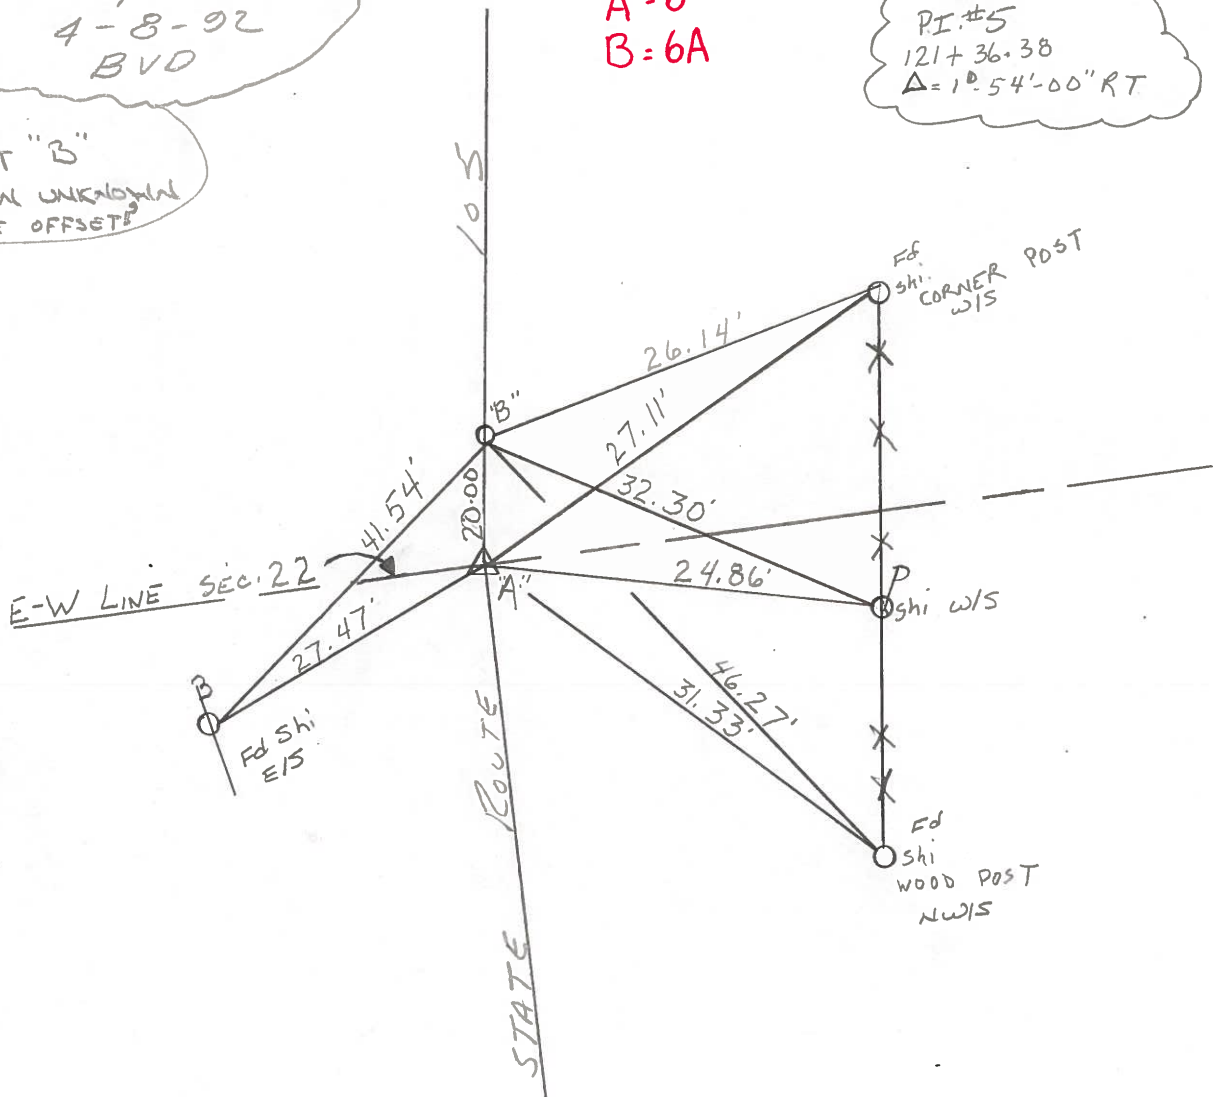

County WOOD S.R. 105

Township CENTER

Section 22

T, N, R E

Personnel HOFFMAN

HOUSEHOLDER


LOEHRKE

#6

Date 4-19-82

Weather CLEAR

Temp. +65°

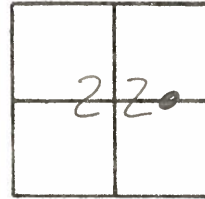

P.I. #5


121 + 36.38

$\Delta = 1^{\circ} 54' - 00''$ RT.

Pt. "A" - SET P.K. / WASHER
5-24-82 S.W.H.

DID NOT RESET P.T. "B"
BELIEVE IT TO BE AN
OFFSET LINE

A = 6
B = 6A

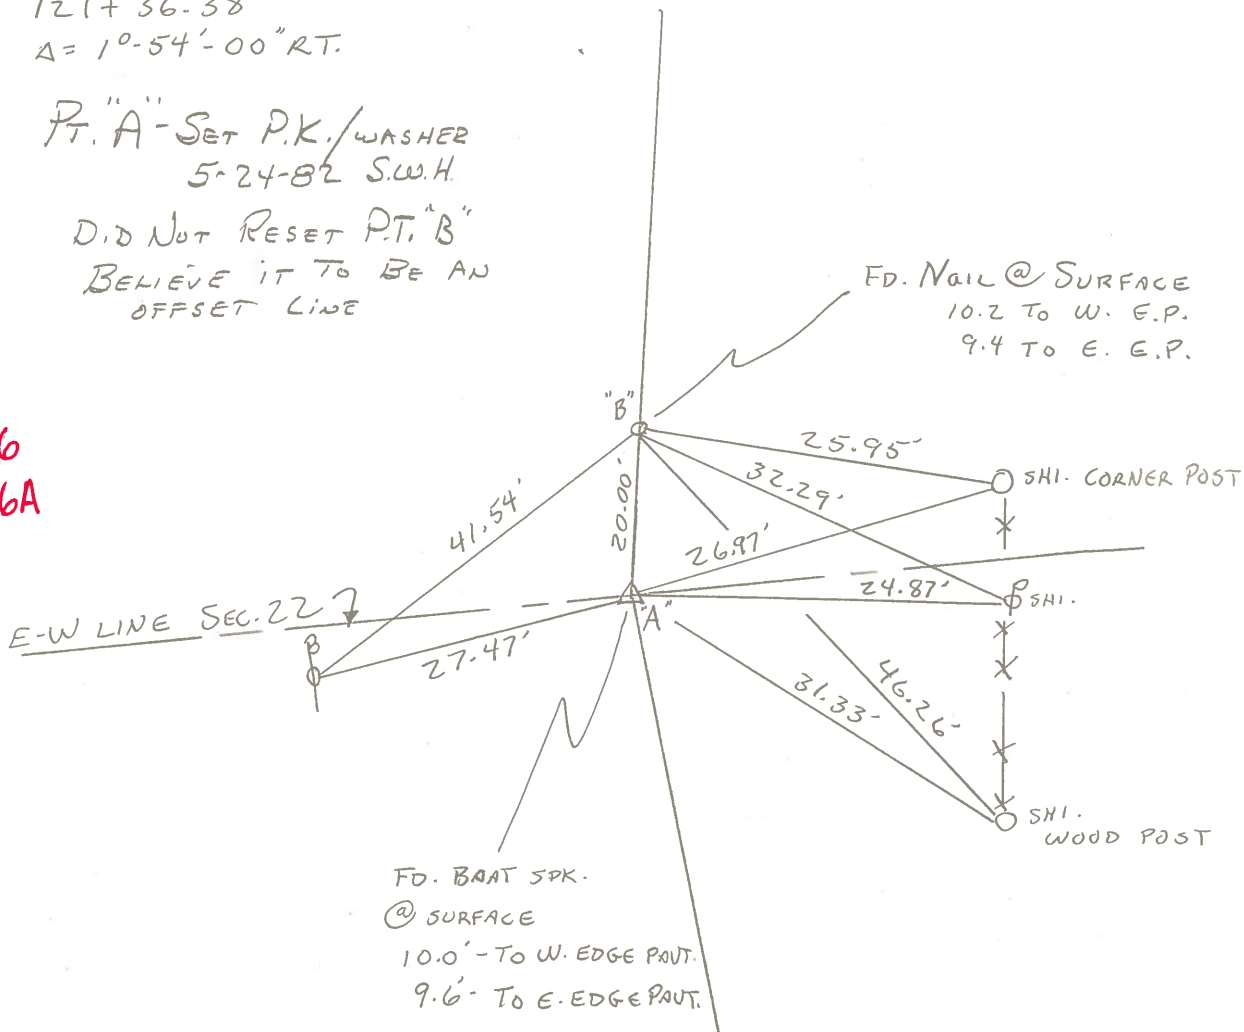

PERSONNEL	TITLE	PERSONNEL	TITLE	COUNTY	DATE
Stone	Notes			Wood	28 Aug. 72
Dennis	H.C.			S. R. #105	WEATHER Worms
Curtis	R.C.			SEC. 22	TEMP. 78°
Brannon	PD				

DESCRIPTION References to Control Points JOB NO. _____

LEFT CENTER LINE RIGHT

121+36.48
PI #5

E-W Sec 22

9.8' - to W. Edge Pnt.

9.3' - to E. Edge Pnt.

COPIED

shiner

63.53'

21.79'

21.63'

Set Boat Spt.

Sta. 121+36.48

$\Delta = 1^{\circ}54'$ Rt.

shiner

6

118+10.85
PI #4

shiner

41.83'

27.99'

shiner in wood
Fence Post

WIRE FENCE

102.87'

7.5' - to W. Edge Pnt.

11.8' - to E. Edge Pnt.

Set PK No. 1

Sta. 118+10.85

$\Delta = 5^{\circ}24'20''$ Rt.

5